



FED. ROAD DIST. NO.	STATE	PROJ. NO.	FISCAL YEAR	SHEET NO.	TOTAL SHEETS
HAWAII	HAW.	78A-01-02M	2002	10	92

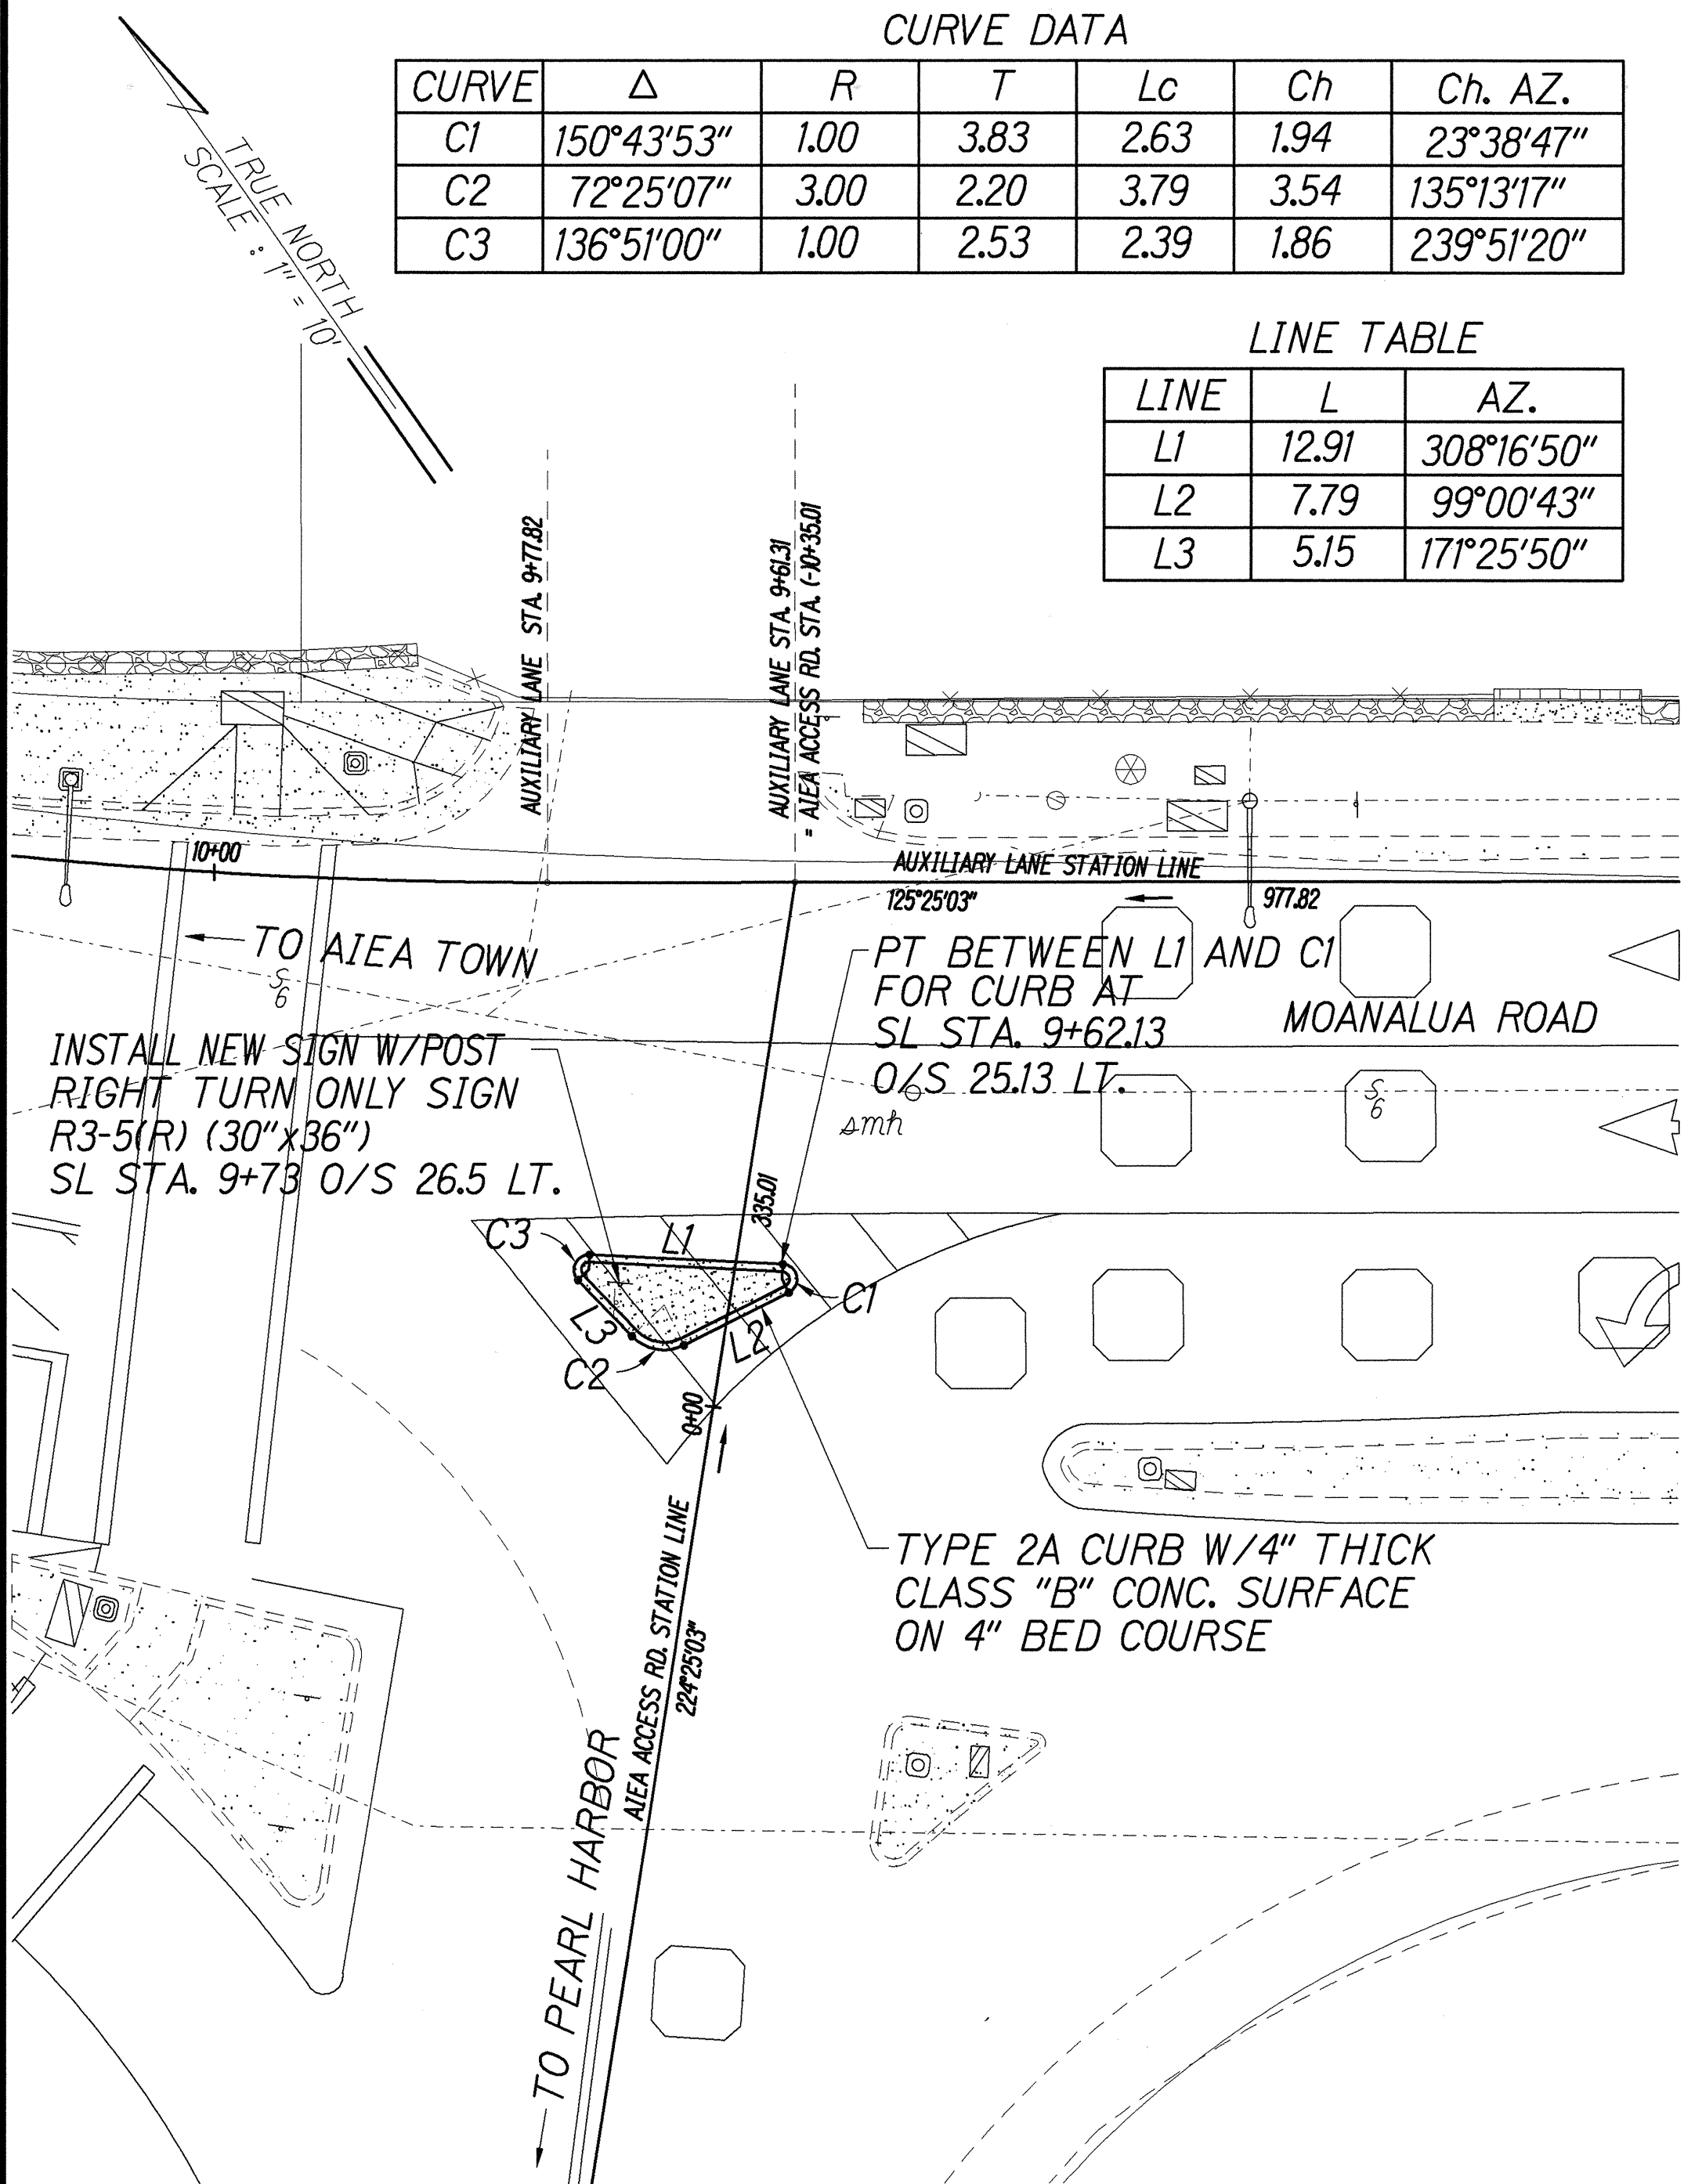


- NOTES:
1. STATIONING REFERS TO
AUXILIARY LANE STATION
LINE.
 2. CURB DIMENSIONS AND DATA
REFER TO OUTSIDE FACE OF
CURB.

DETAIL "A" (SEE SHT. C-3)
SCALE: 1" = 10'-0"

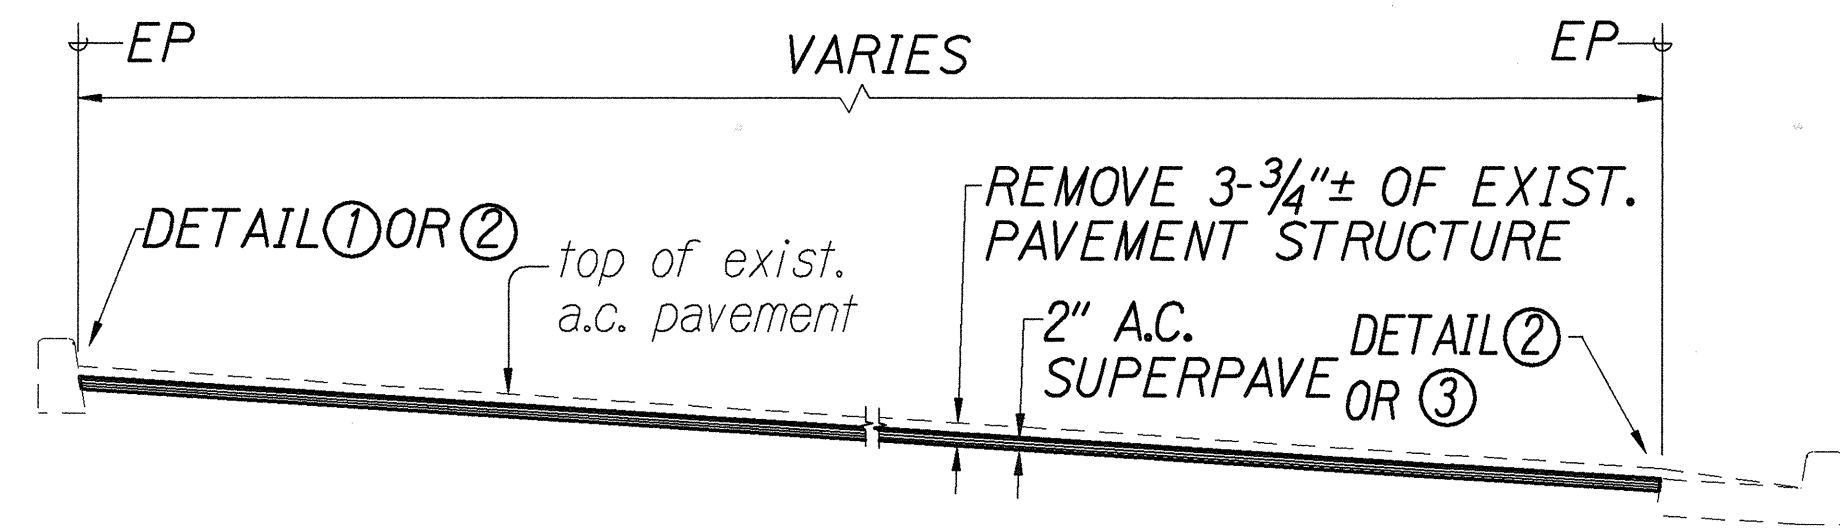


TYPICAL SECTION
SCALE: 3/8" = 1'-0"

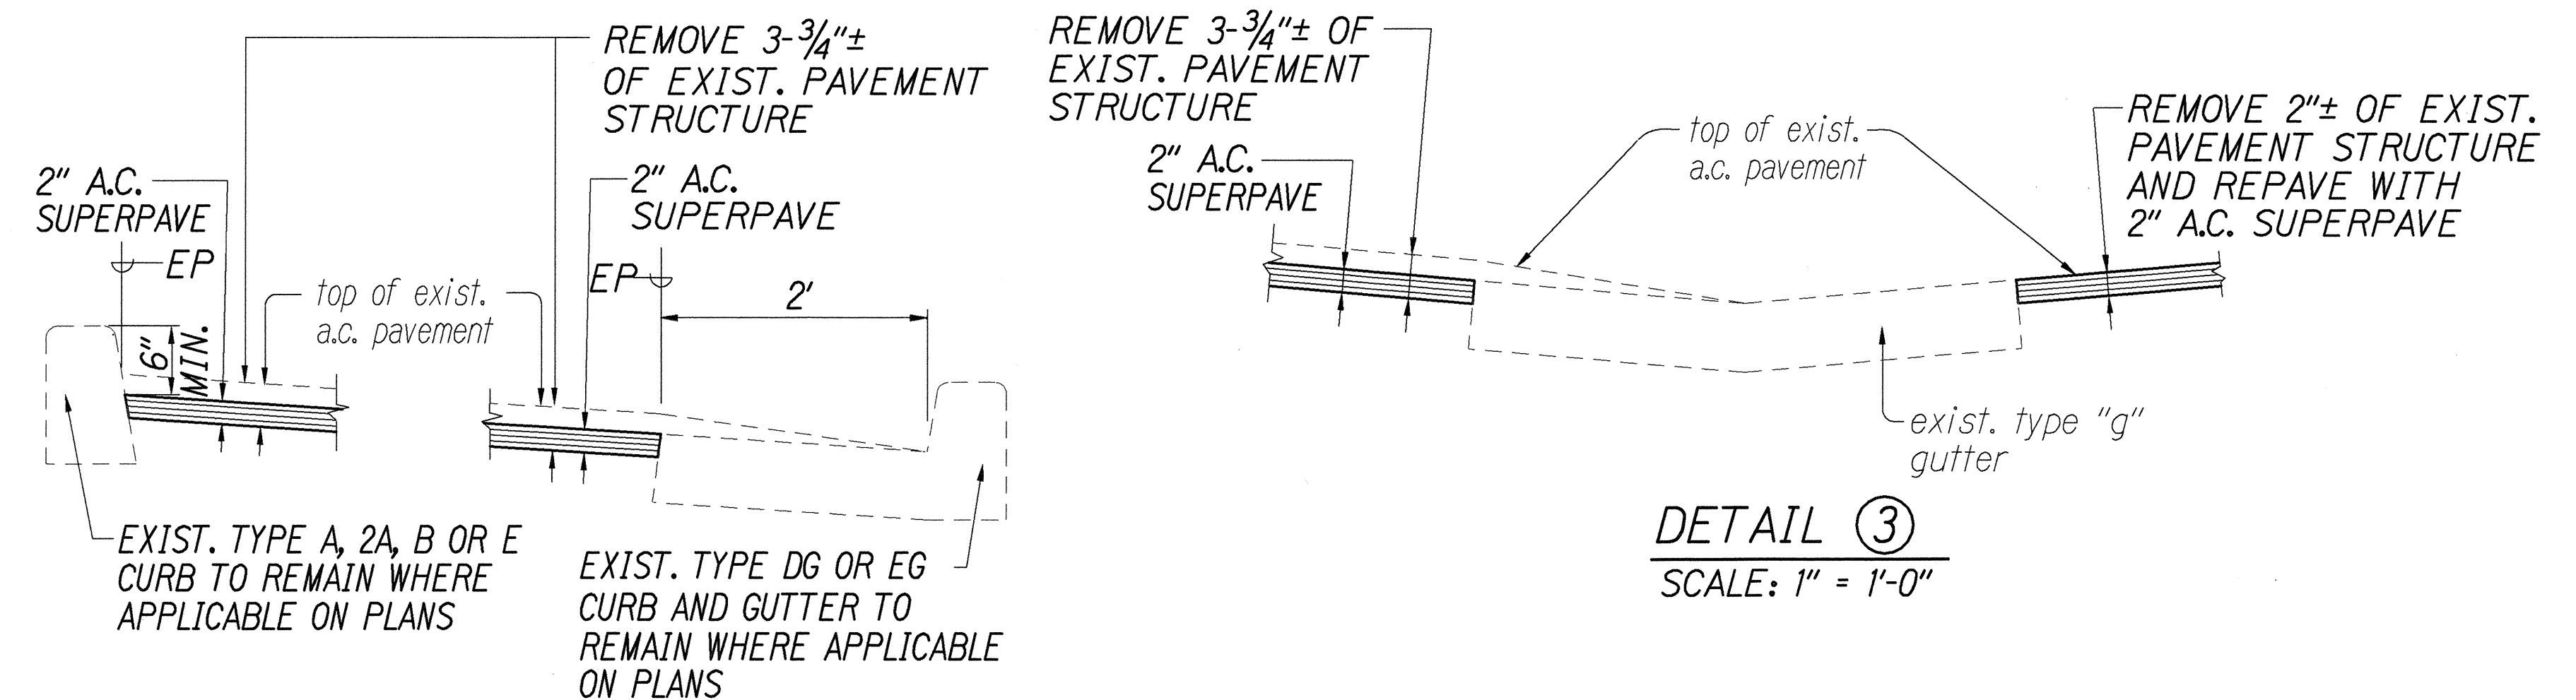


DETAIL ①
SCALE: 1" = 1'-0"

DETAIL ②
SCALE: 1" = 1'-0"


DETAIL ③
SCALE: 1" = 1'-0"

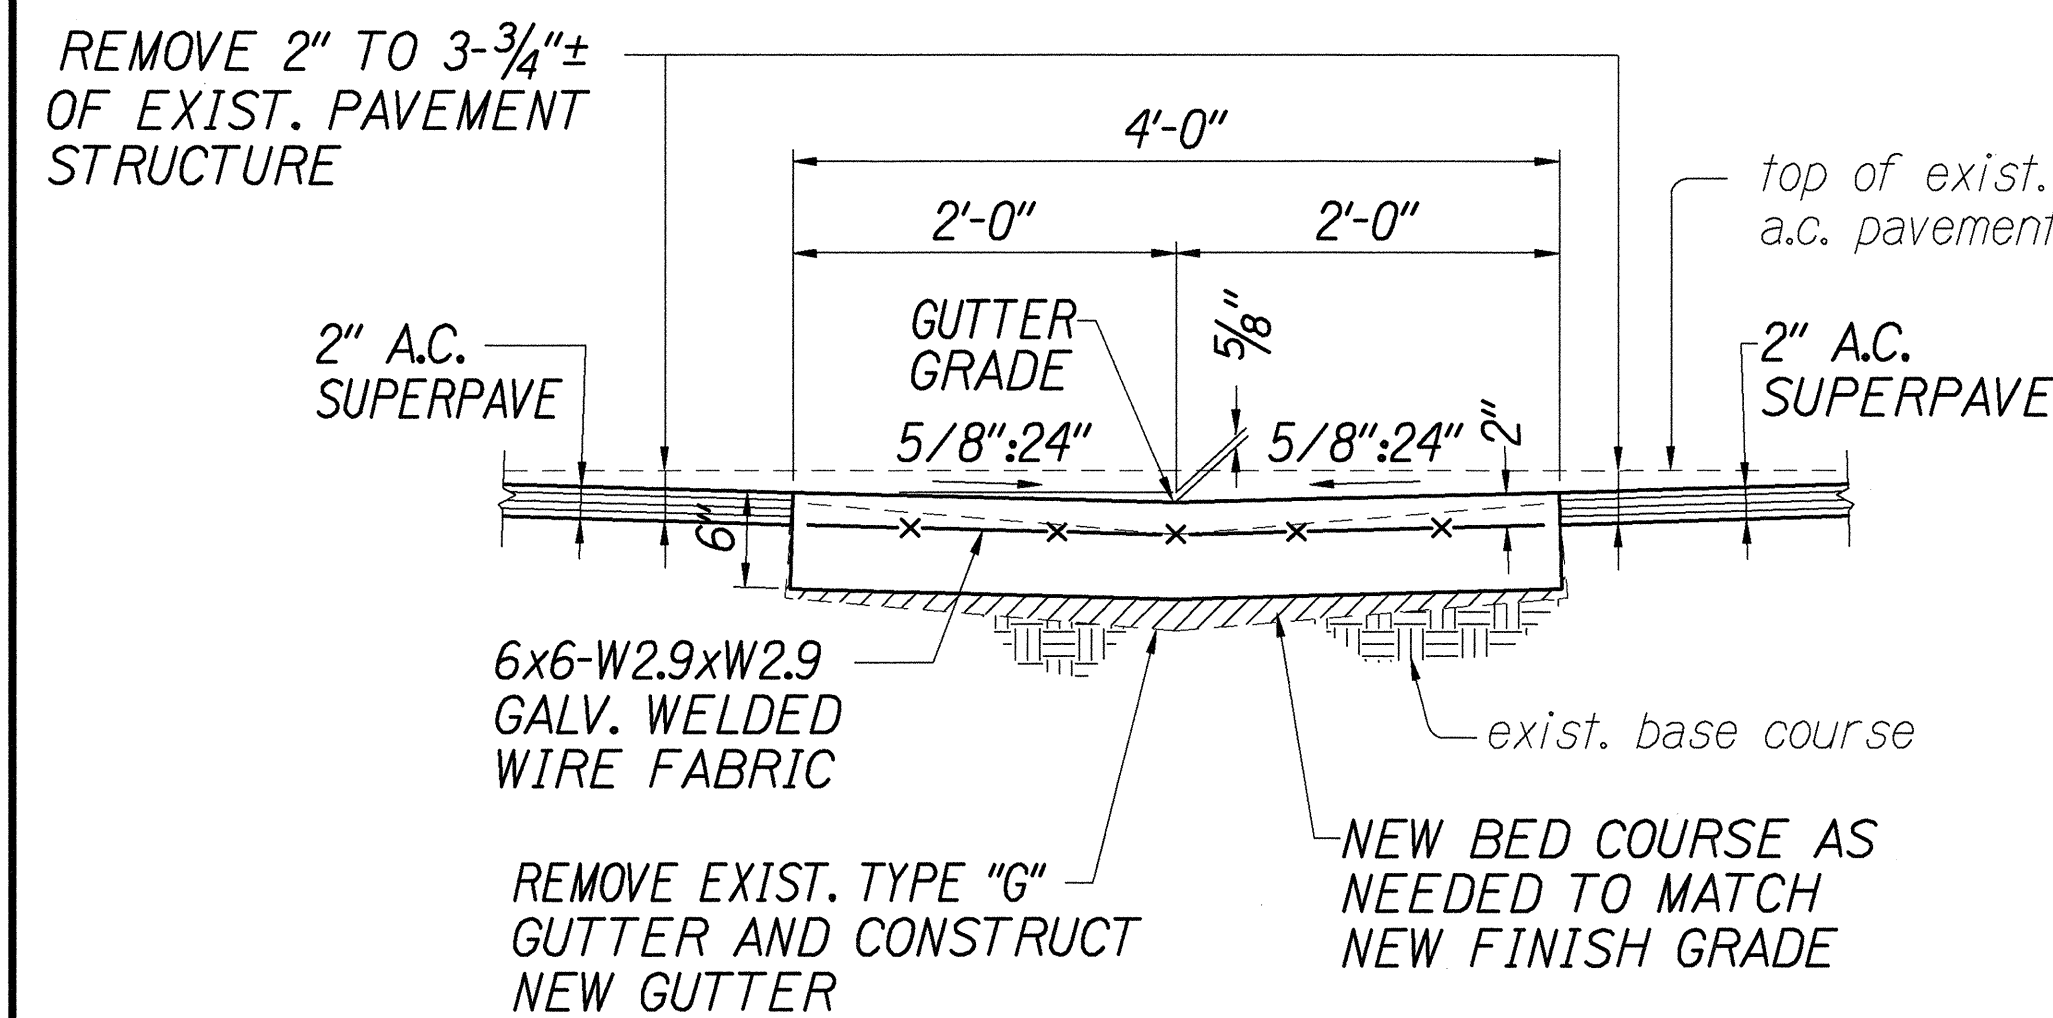

THRU GUTTER DETAIL
SCALE: 1" = 1'-0"

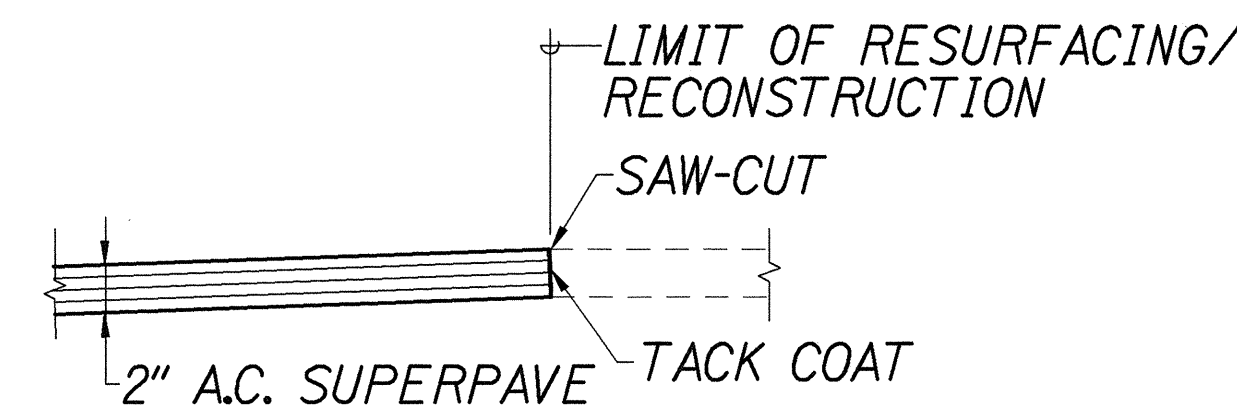


CONNECTION TO EXISTING A.C. PAVEMENT
NOT TO SCALE

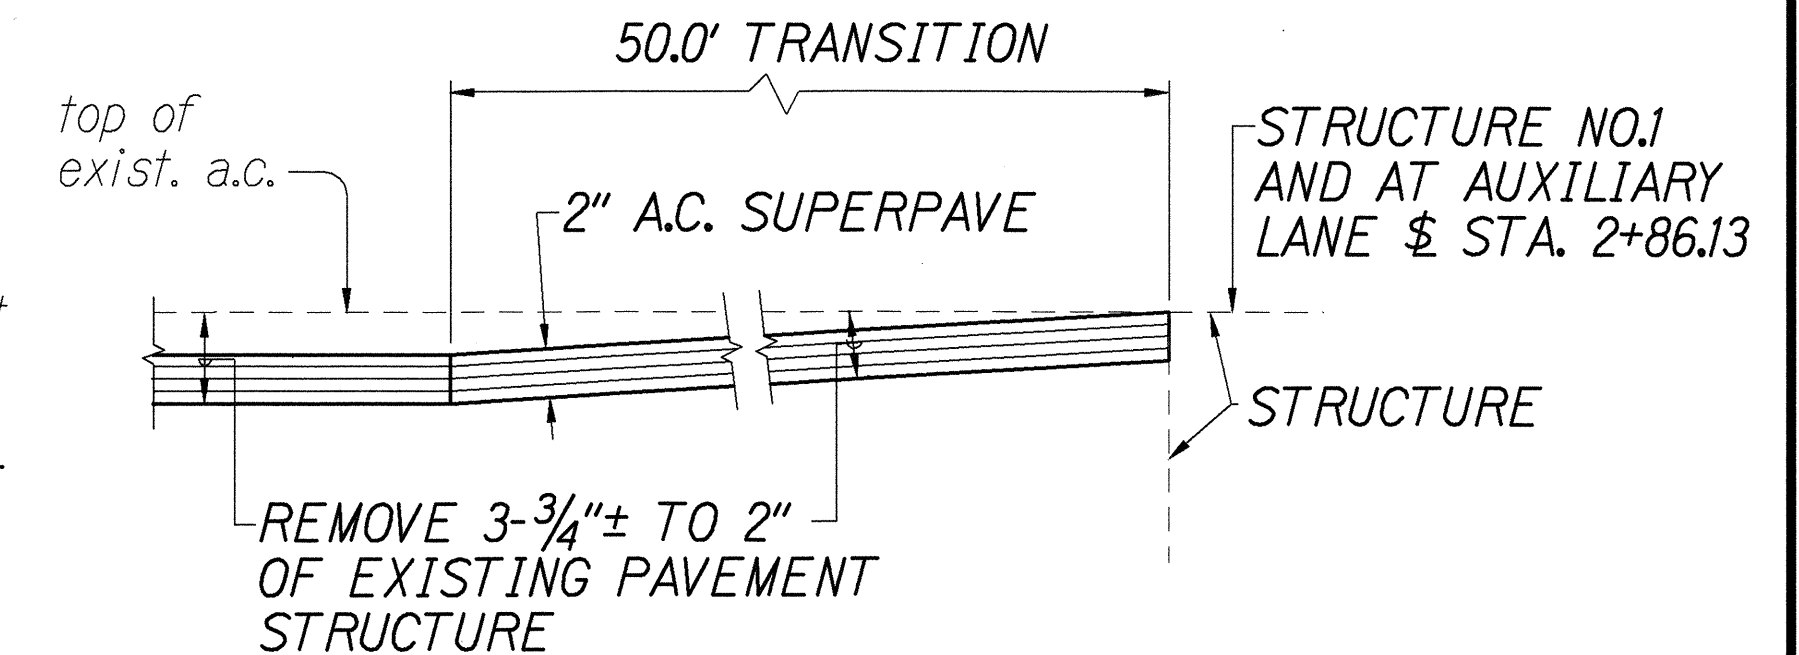

STRUCTURE TRANSITION DETAIL
NOT TO SCALE

ORIGINAL PLAN	SURVEY PLOTTED BY	DATE
NOTE BOOK	DRAWN BY	
DESIGNED BY	TRACED BY	
CHECKED BY	CHECKED BY	

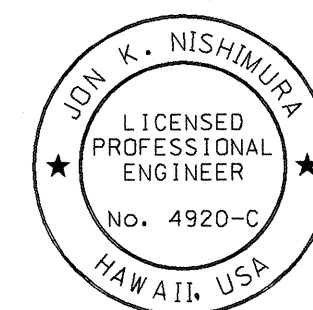

THIS WORK WAS PREPARED BY
ME OR UNDER MY SUPERVISION.

FUKUNAGA & ASSOCIATES, INC.

STATE OF HAWAII
DEPARTMENT OF TRANSPORTATION
HIGHWAYS DIVISION

**MISCELLANEOUS ROADWAY DETAILS
AND PAVEMENT SECTIONS DETAILS**

MOANALUA FREEWAY LIGHTING IMPROVEMENTS
KAMEHAMEHA HIGHWAY TO HI HALAWA INTERCHANGE

PROJ. NO. 78A-01-02M
Oahu, Hawaii

Scale: As Noted Date: May 2002