



FED. ROAD DIST. NO.	STATE	PROJ. NO.	FISCAL YEAR	SHEET NO.	TOTAL SHEETS
HAWAII	HAW.	78A-01-02M	2002	16	92

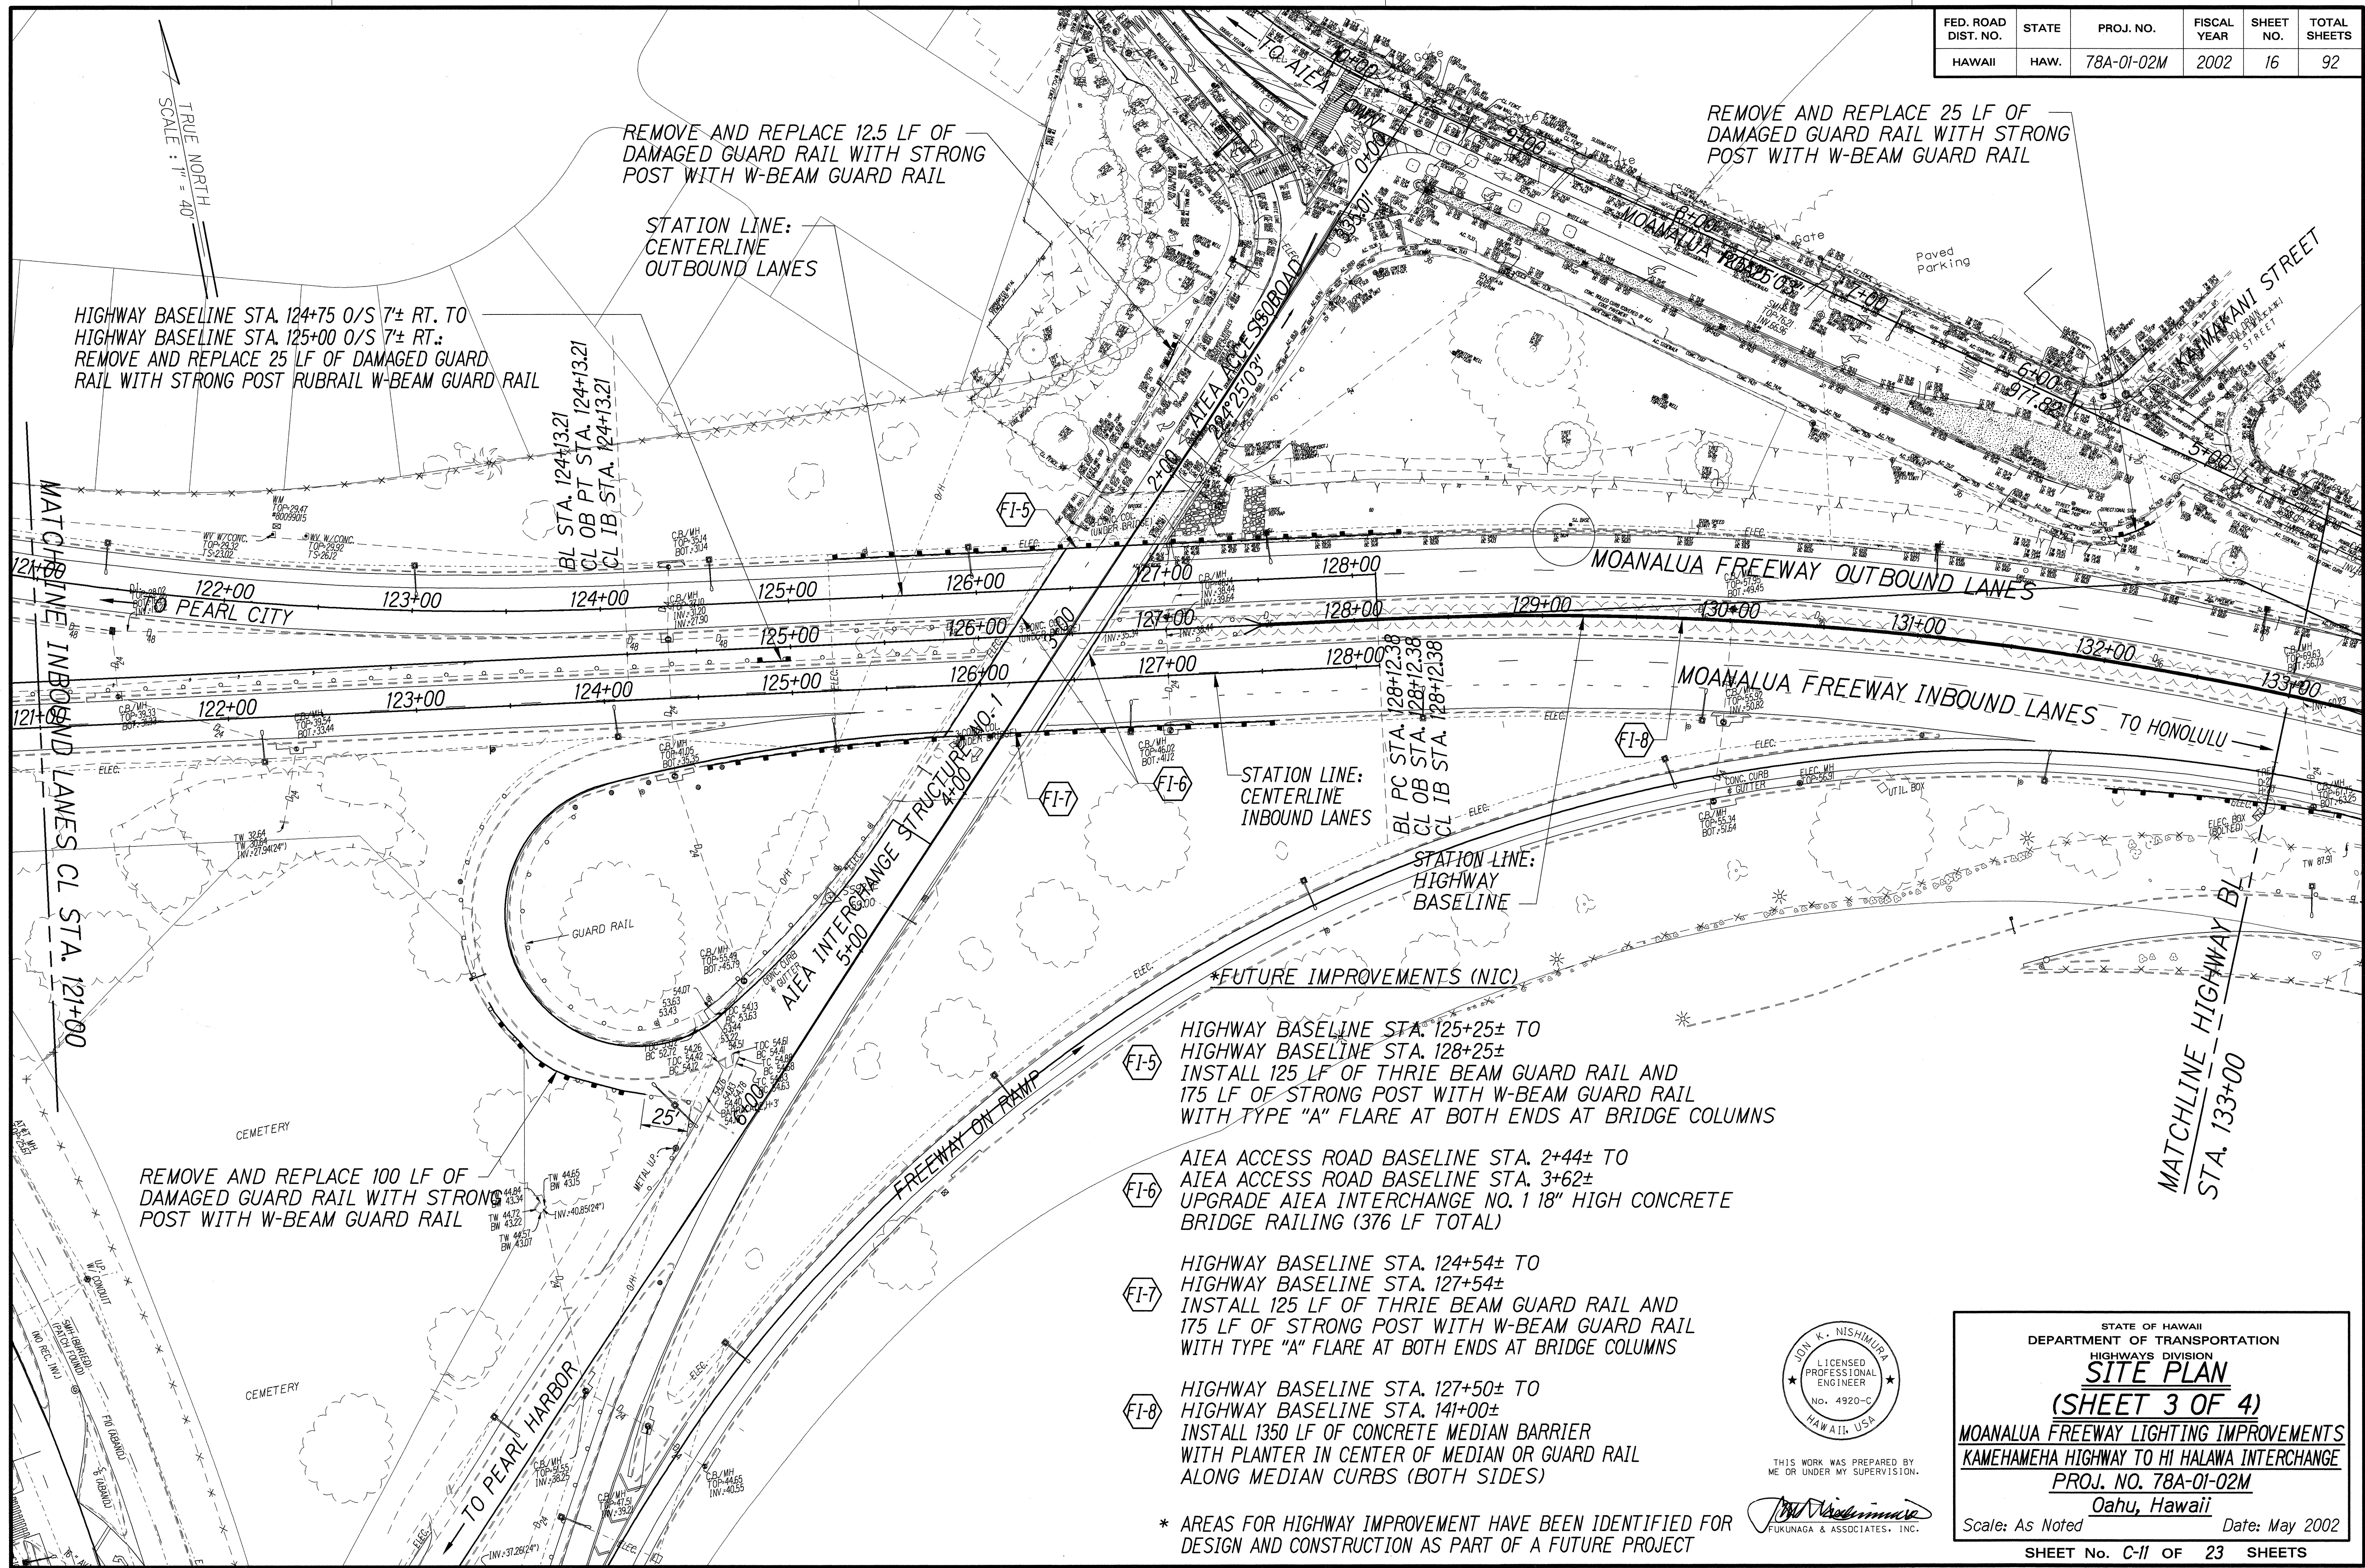

ORIGINAL PLAN	DATE
SURVEY PLOTTED BY	
DESIGNED BY	
NOTED BY	
CHECKED BY	
DATE	

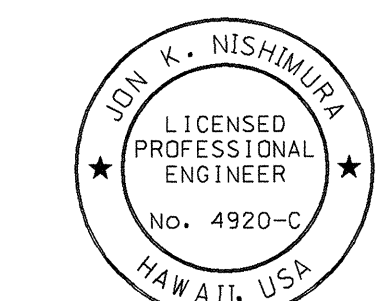

THIS WORK WAS PREPARED BY ME OR UNDER MY SUPERVISION.

John K. Nishimura
FUKUNAGA & ASSOCIATES, INC.

STATE OF HAWAII
DEPARTMENT OF TRANSPORTATION
HIGHWAYS DIVISION
SITE PLAN
(SHEET 3 OF 4)
MOANALUA FREEWAY LIGHTING IMPROVEMENTS
KAMEHAMEHA HIGHWAY TO HI HALAWA INTERCHANGE
PROJ. NO. 78A-01-02M
Oahu, Hawaii
Scale: As Noted Date: May 2002
SHEET No. C-11 OF 23 SHEETS

* AREAS FOR HIGHWAY IMPROVEMENT HAVE BEEN IDENTIFIED FOR DESIGN AND CONSTRUCTION AS PART OF A FUTURE PROJECT

