




FED. ROAD DIST. NO.	STATE	PROJ. NO.	FISCAL YEAR	SHEET NO.	TOTAL SHEETS
HAWAII	HAW.	HWY-0-05-05M	2010	ADD.7	18

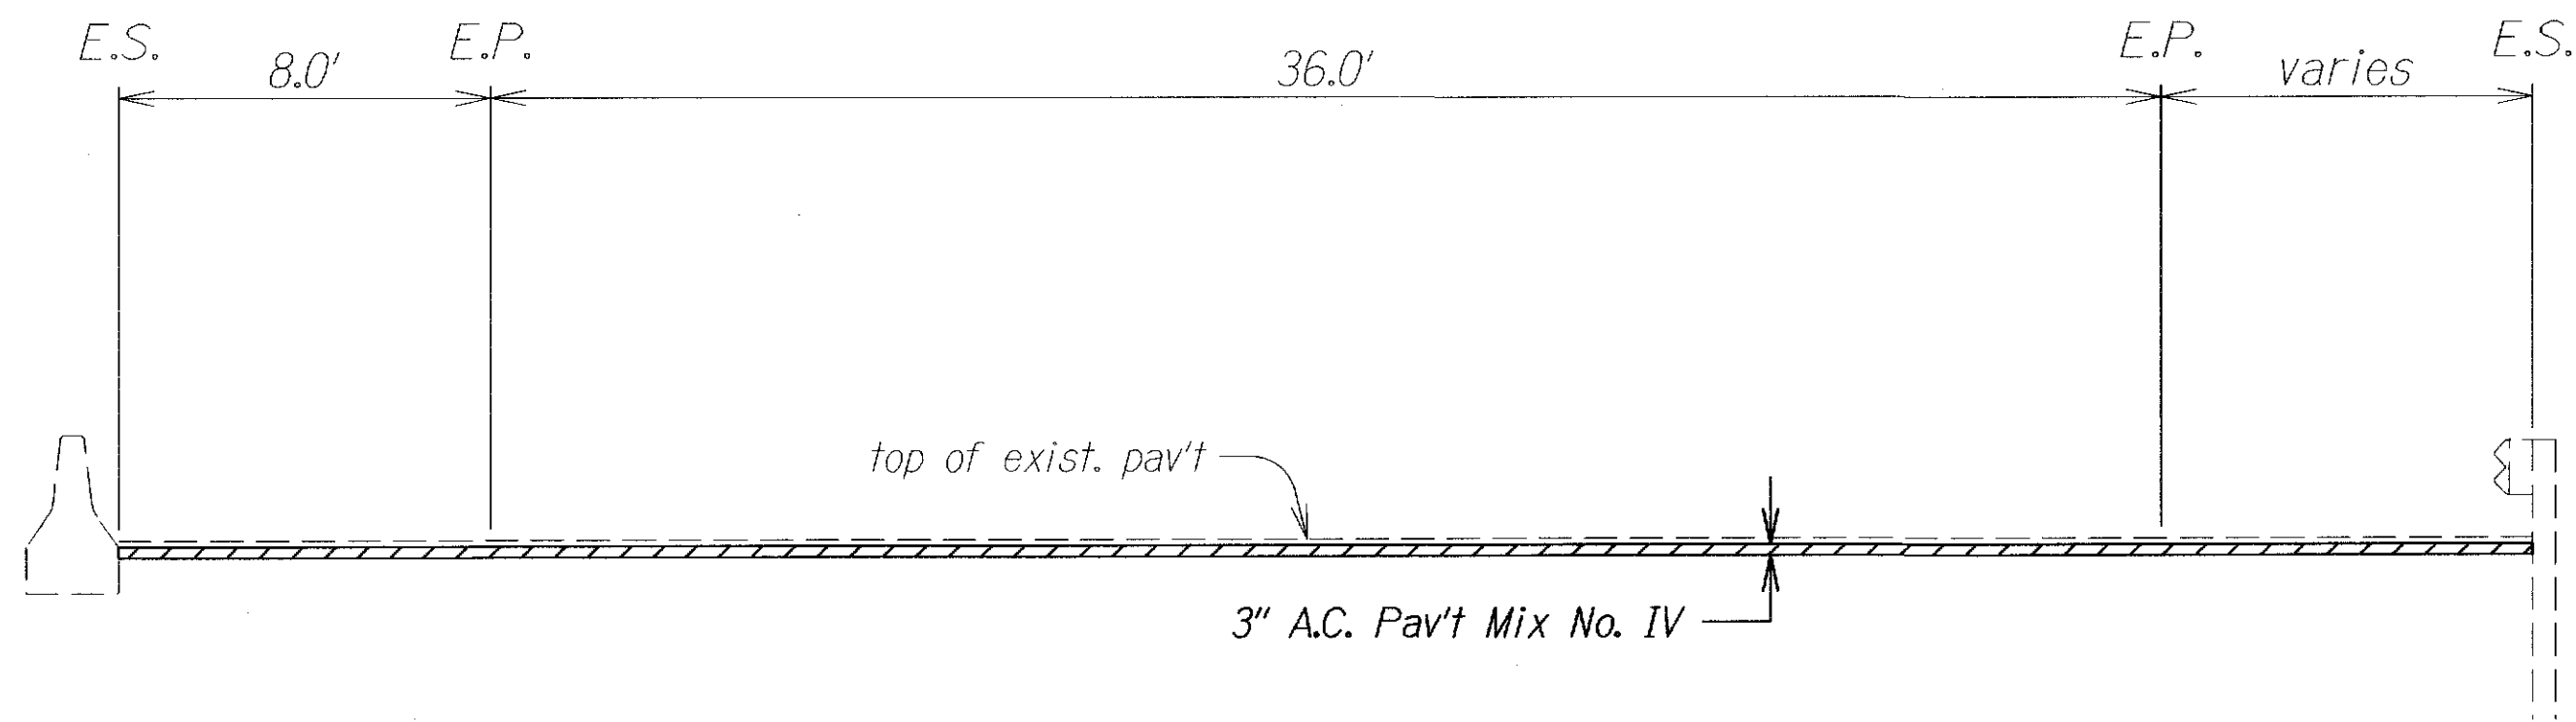


MOANALUA FREEWAY
Sta. 147+00 to Sta. 141+50

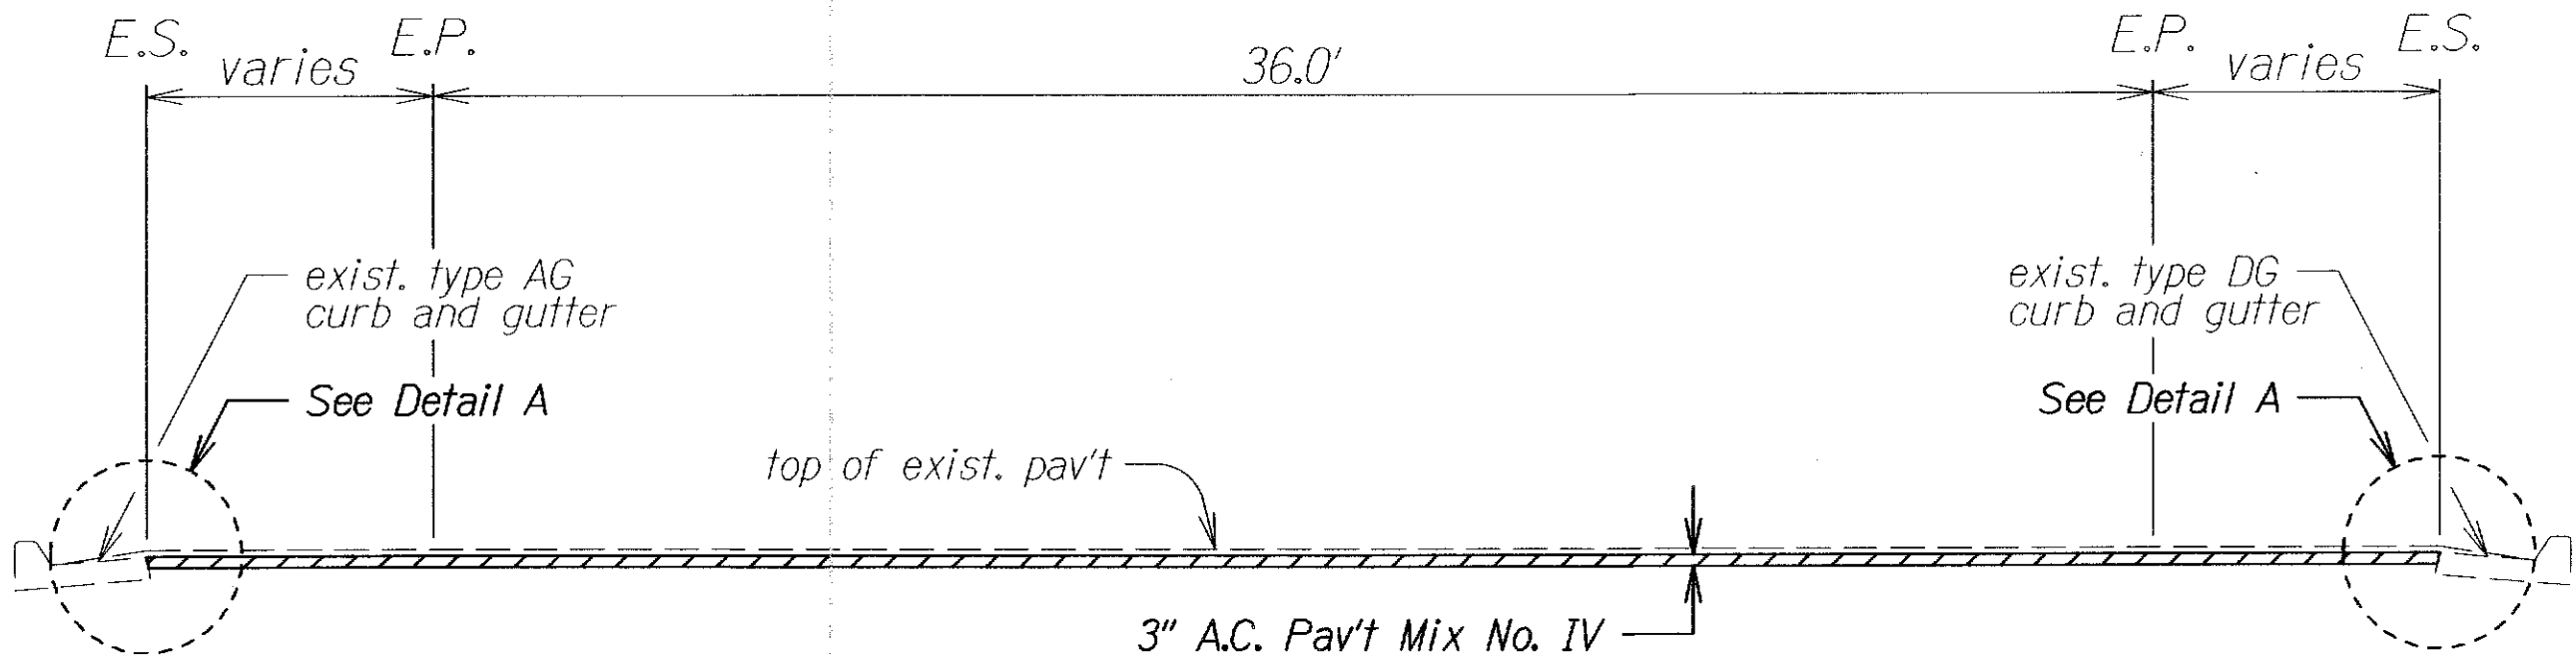


MOANALUA FREEWAY
Sta. 141+50 to Sta. 139+00

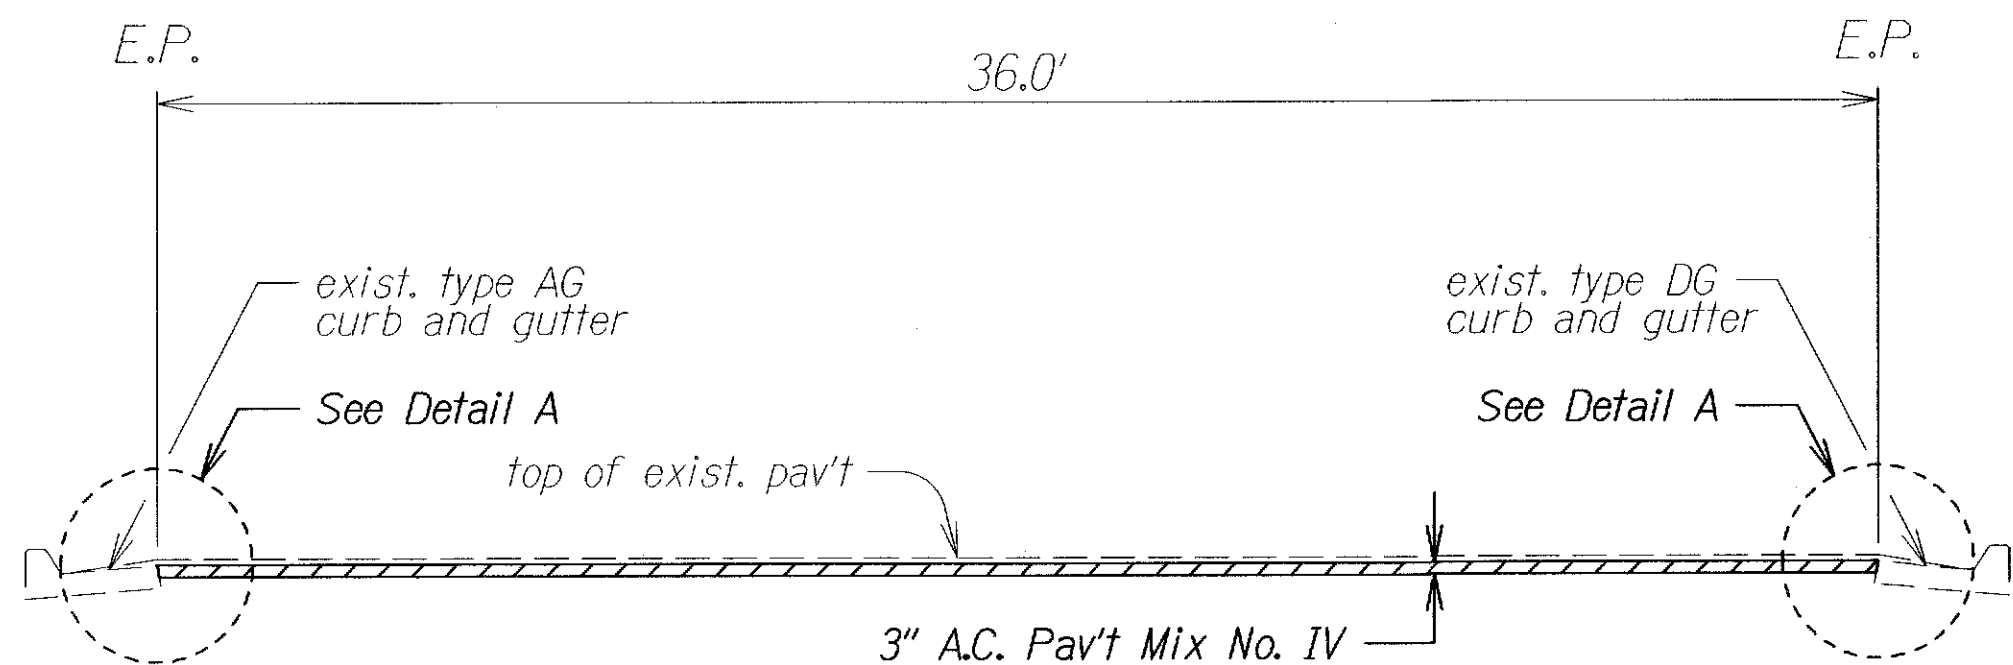


MOANALUA FREEWAY
Sta. 139+00 to Sta. 137+50

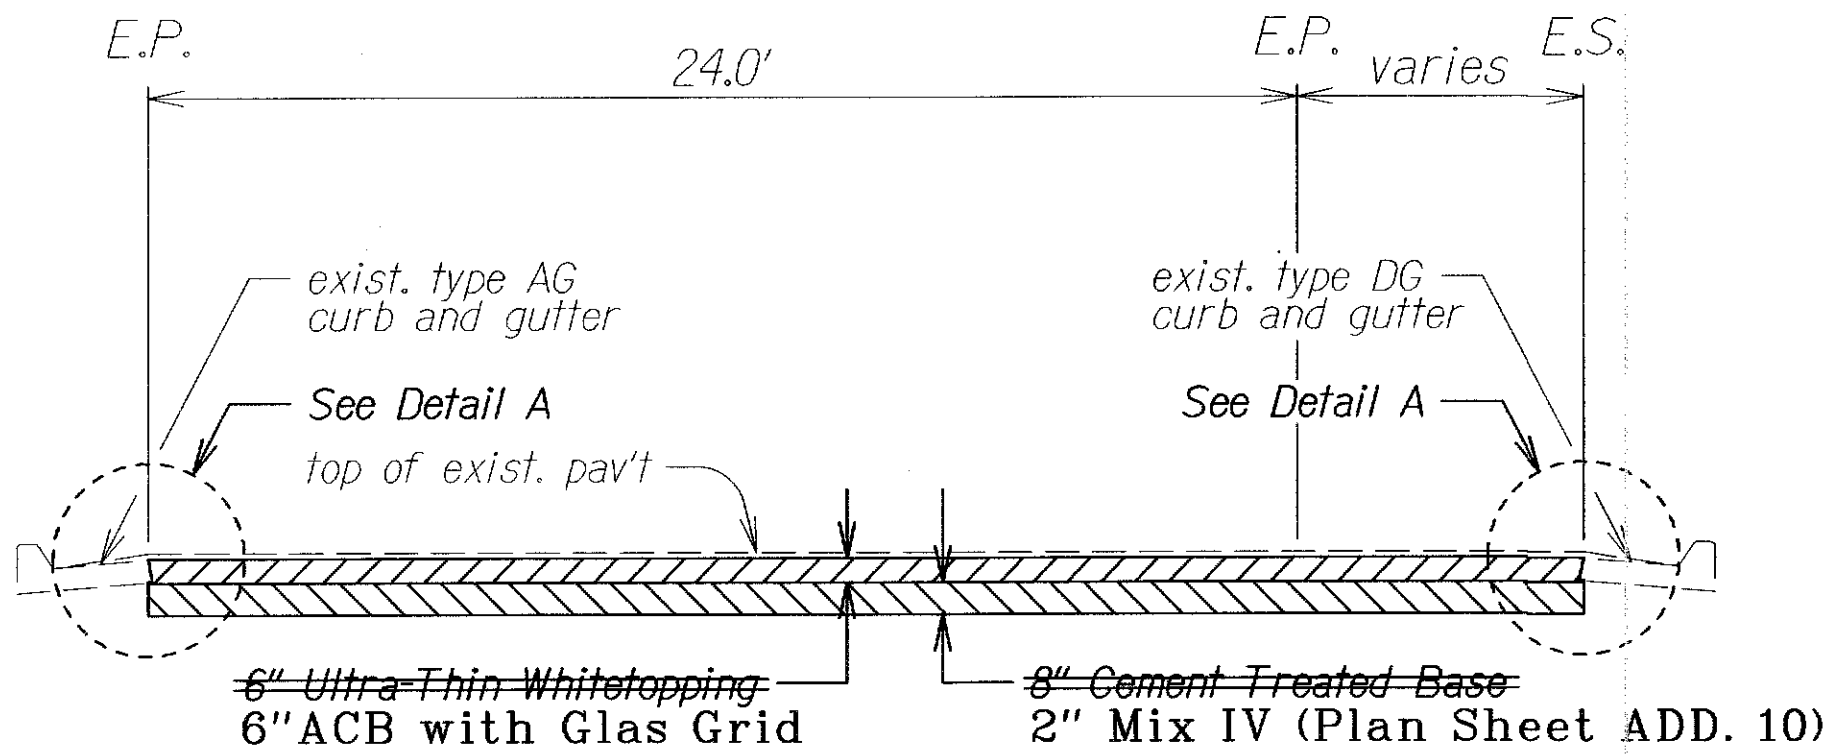


MOANALUA FREEWAY
Sta. 137+50 to Sta. 125+50

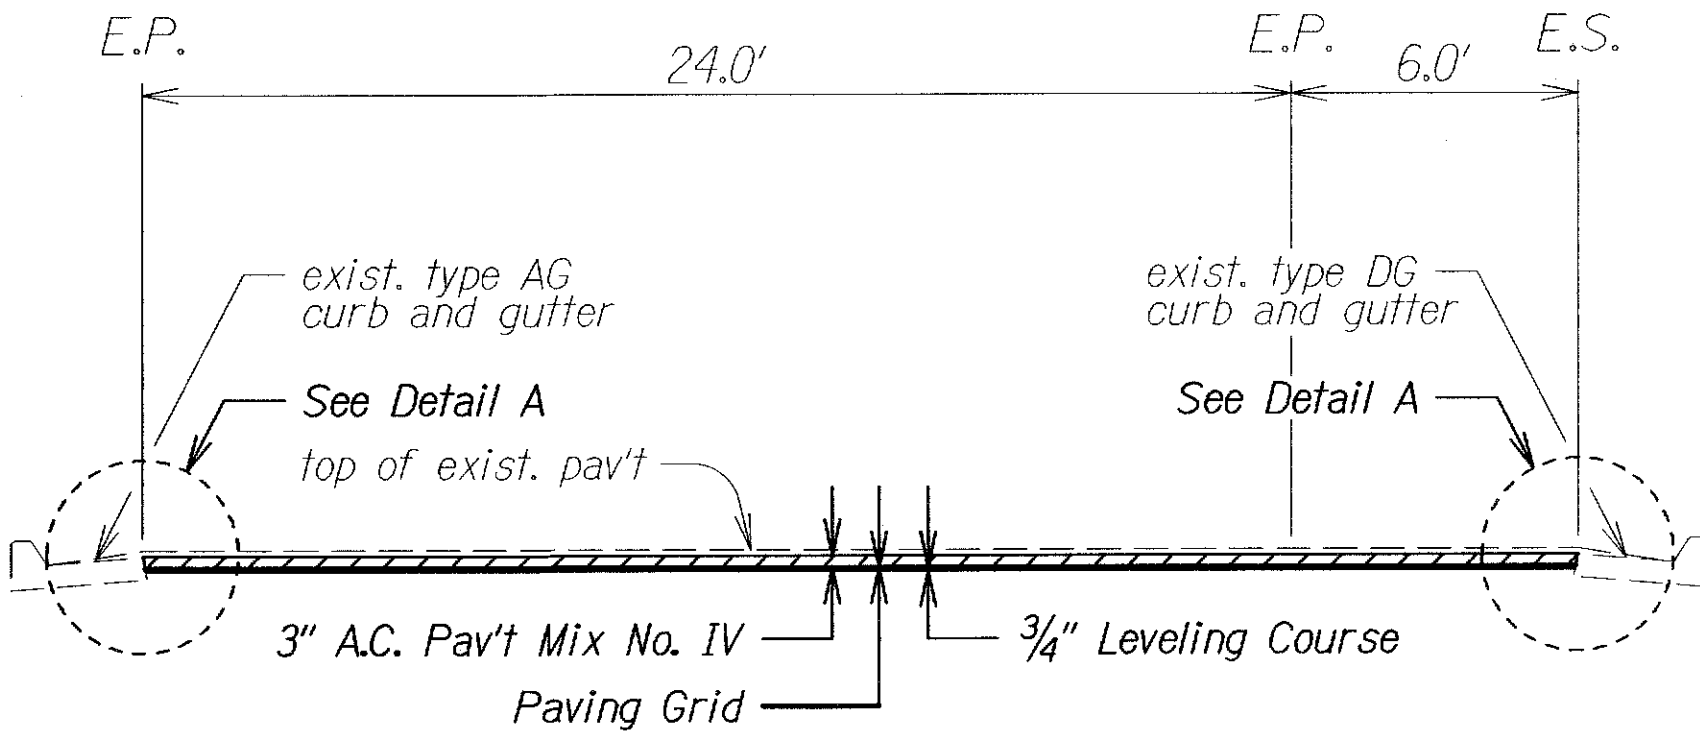


MOANALUA FREEWAY
Sta. 125+50 to Sta. 120+00

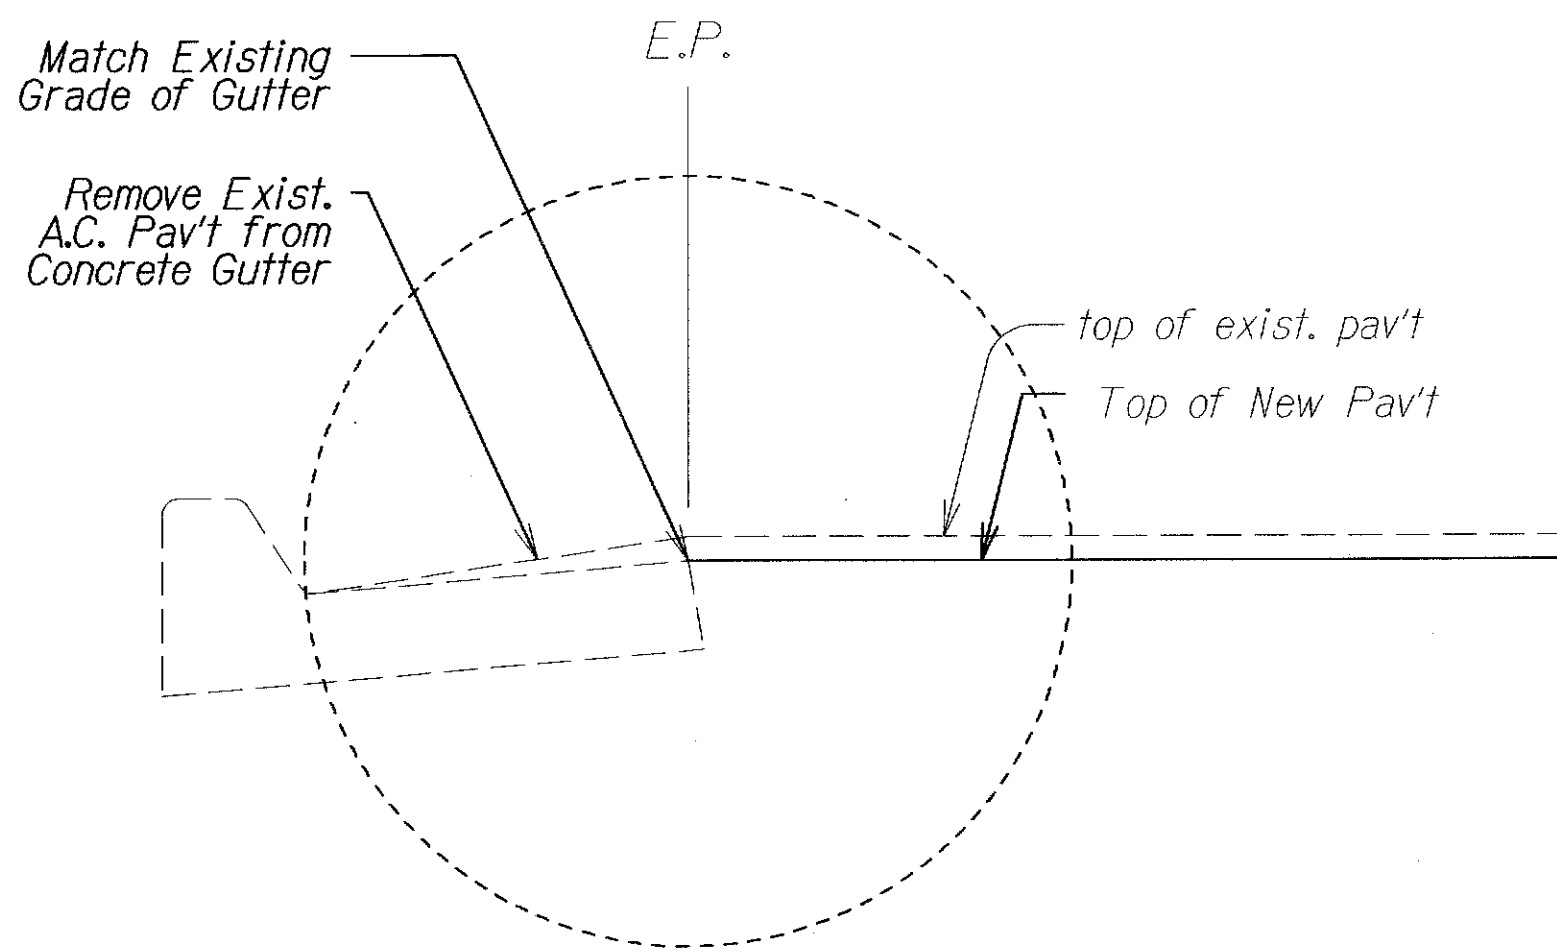

DETAIL A

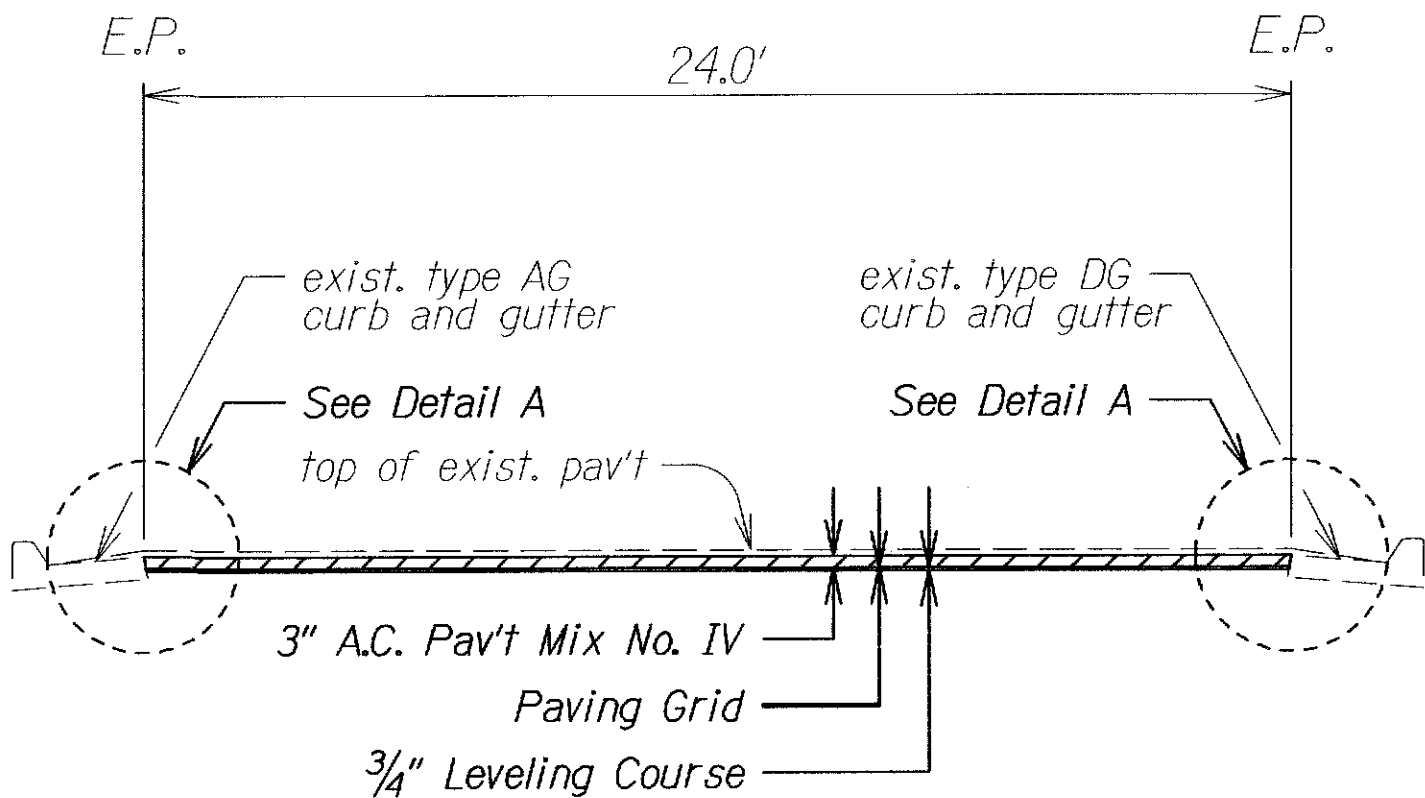

MOANALUA FREEWAY
Sta. 120+00 to Sta. 117+50

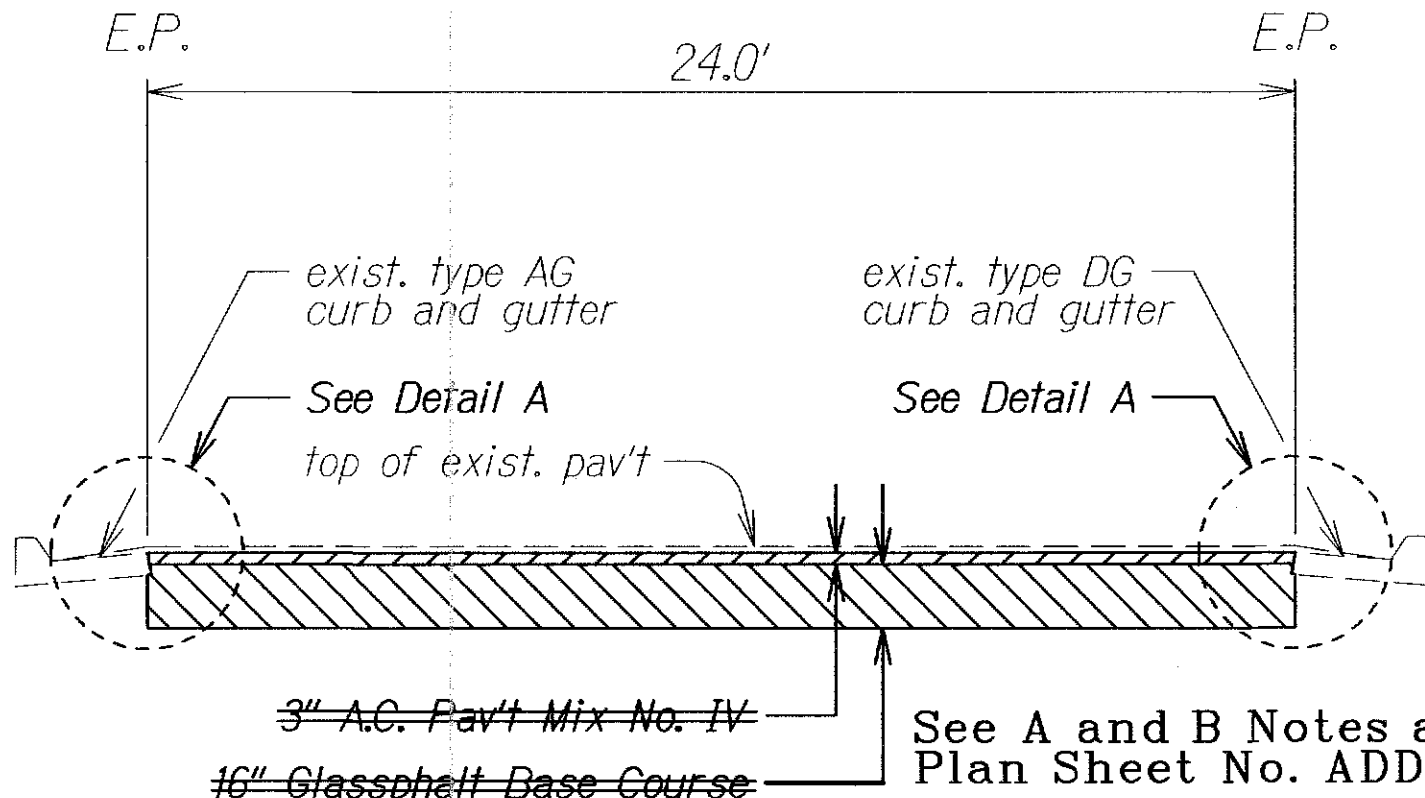

MOANALUA FREEWAY
Sta. 117+50 to Sta. 114+75

LEGEND FOR AS-BUILT POSTINGS	
	Quiggly line for as-built deletion
	Double line for as-built deletion
	Text for as-built posting

6/23/10	Removed Note on Detail A
DATE	REVISION

STATE OF HAWAII
DEPARTMENT OF TRANSPORTATION
HIGHWAYS DIVISION

TYPICAL SECTIONS

MOANALUA FREEWAY RESURFACING
Milepost 0.00 to Milepost 0.74
Project No. HWY-0-05-05M


Scale: 1/4" = 1' Date: April, 2010

SHEET No. 1 OF 2 SHEETS


"AS-BUILT"

ADD.7


FED. ROAD DIST. NO.	STATE	PROJ. NO.	FISCAL YEAR	SHEET NO.	TOTAL SHEETS
HAWAII	HAW.	HWY-0-05-05M	2010	8	18

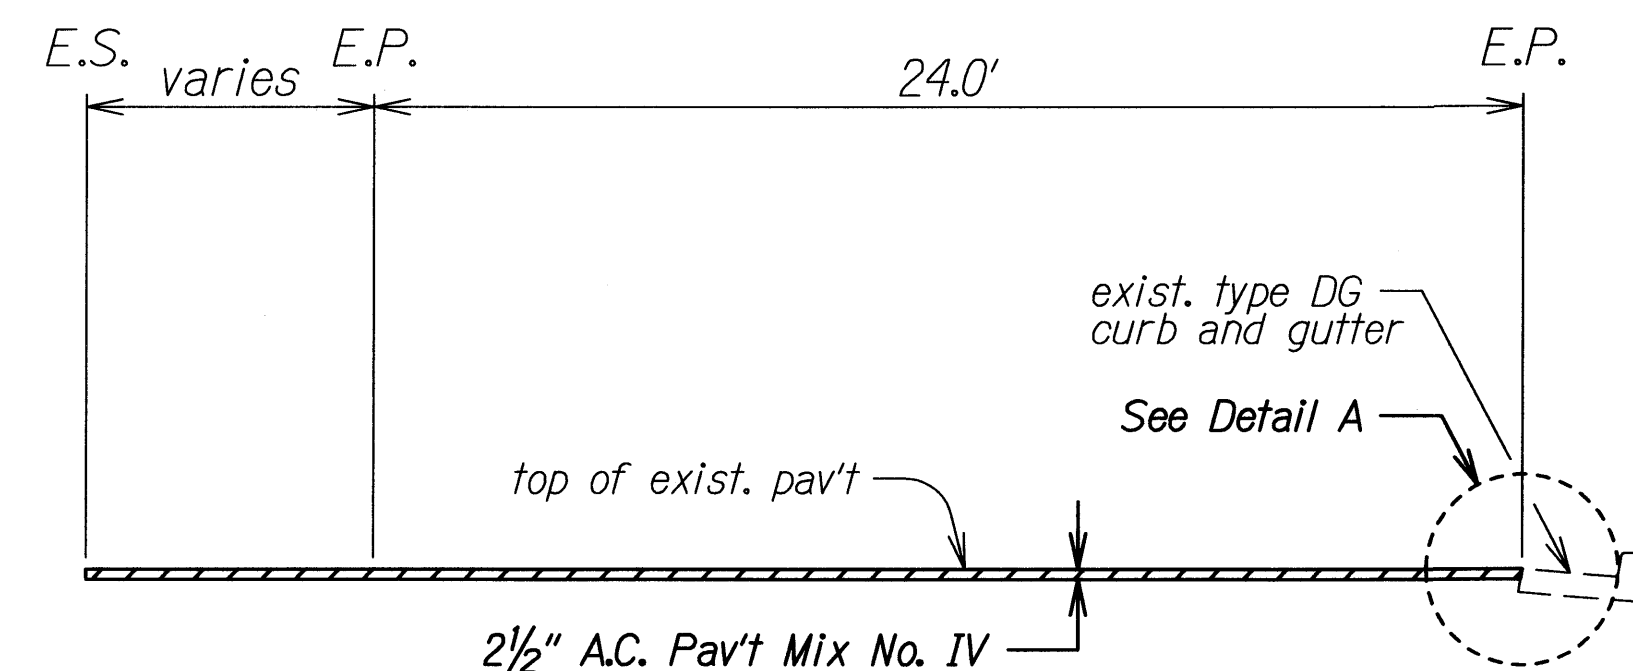


MOANALUA FREEWAY
Sta. 108+90 to Sta. 109+60

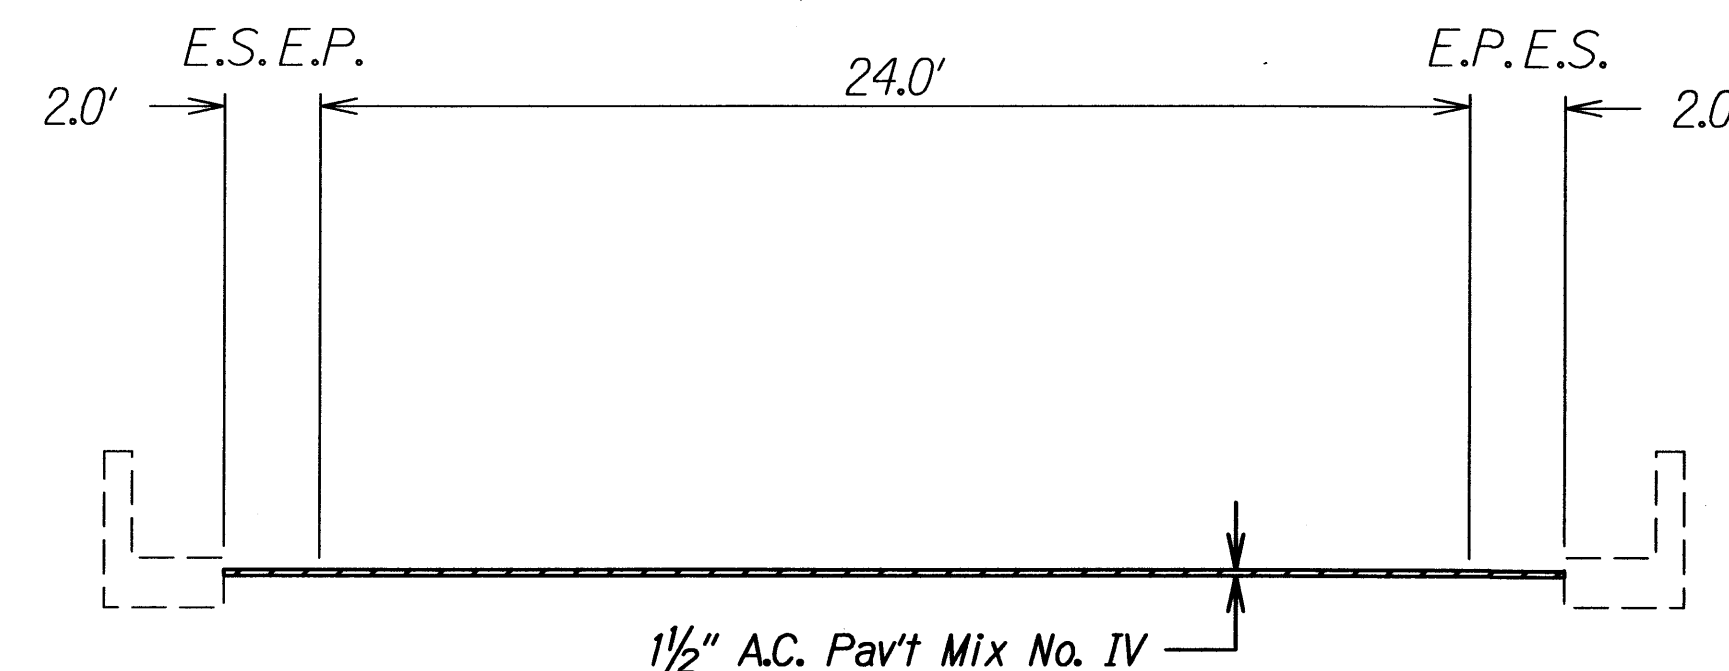


MOANALUA FREEWAY
Sta. 109+60 to Sta. 119+84

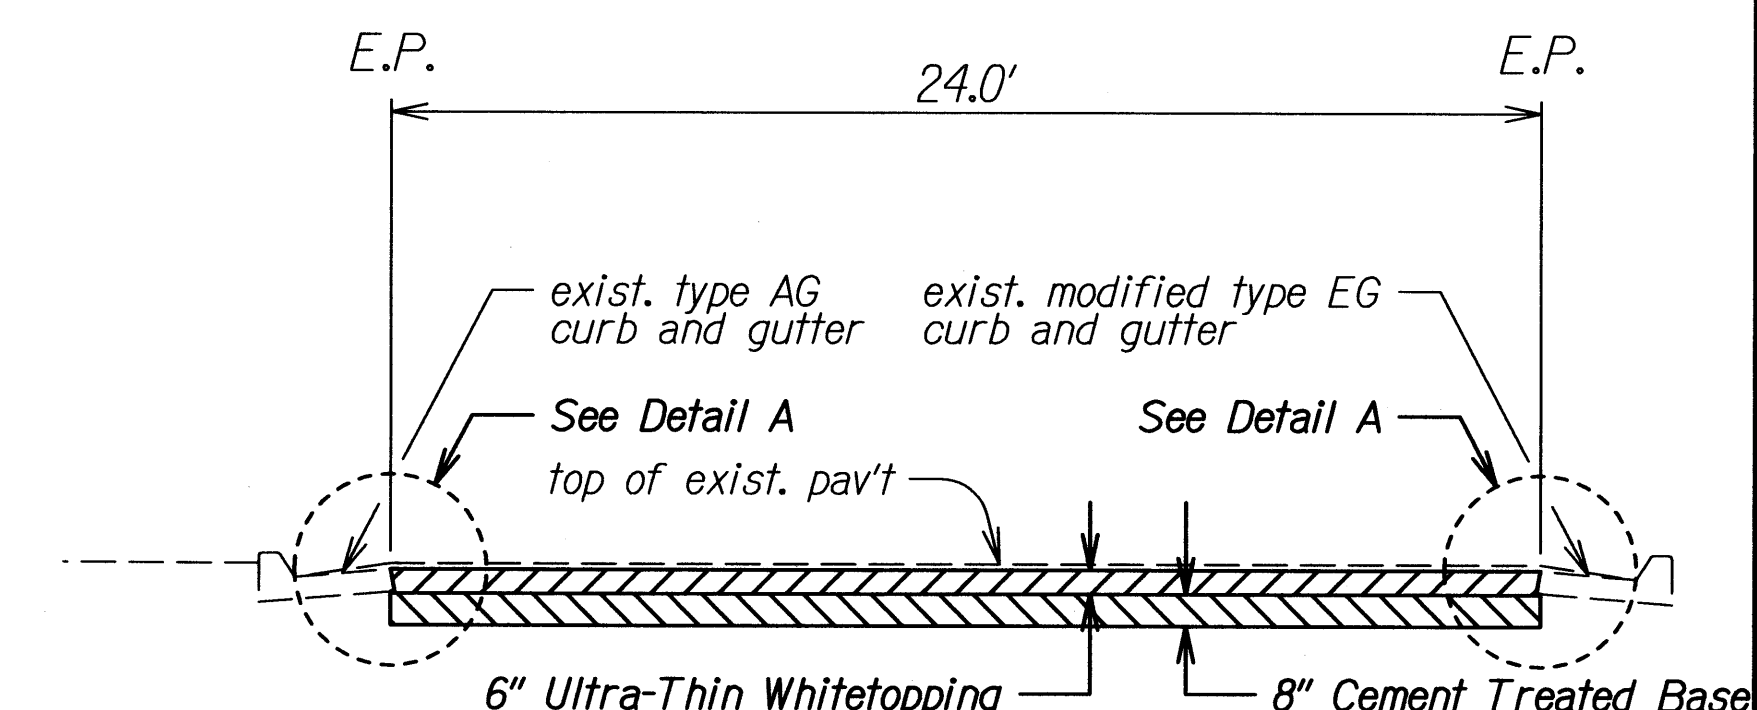


MOANALUA FREEWAY
Sta. 119+84 to Sta. 125+00

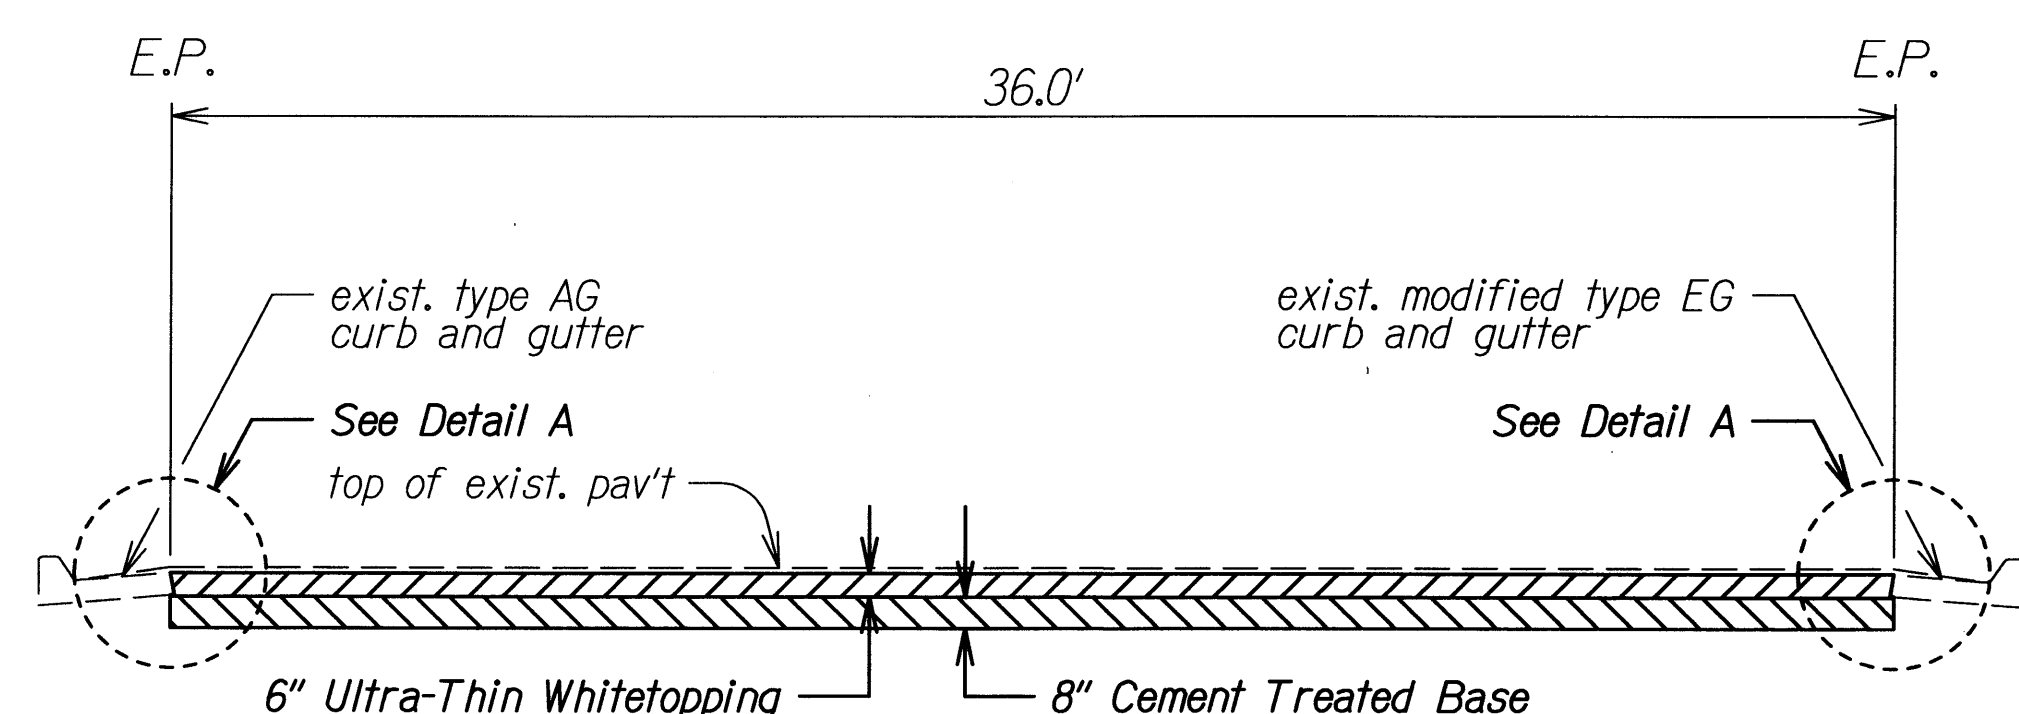


MOANALUA FREEWAY
Sta. 125+00 to Sta. 131+00

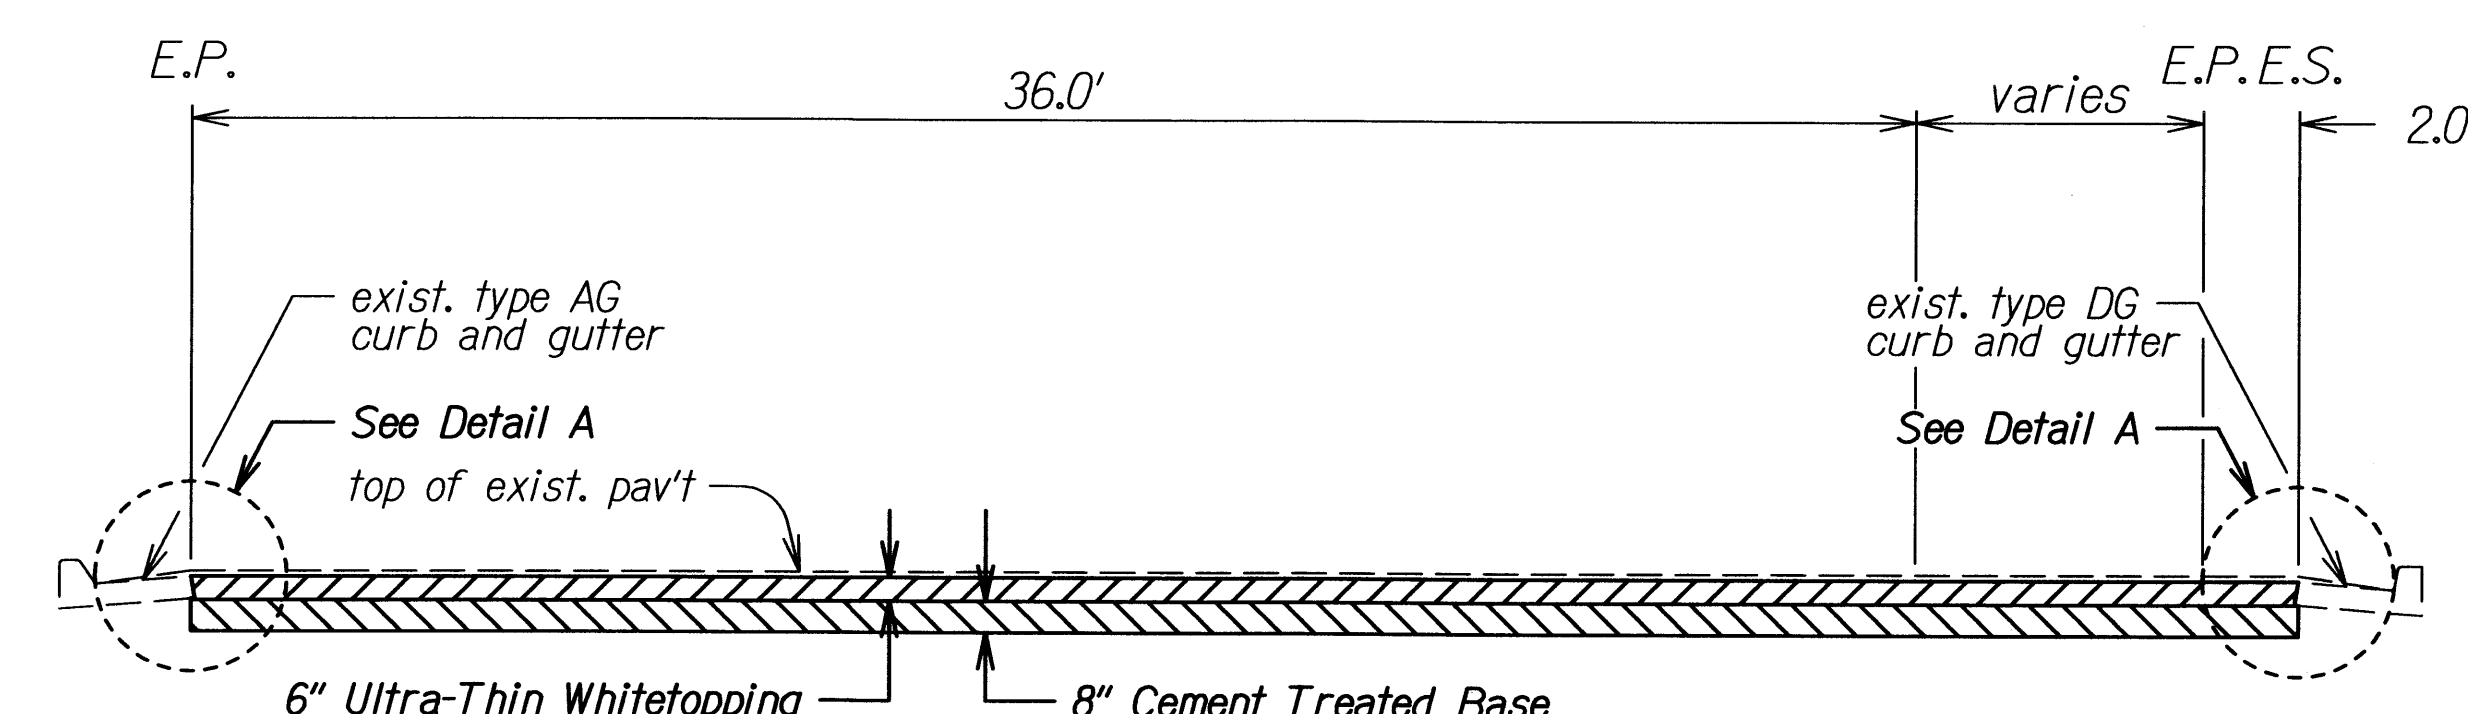

MOANALUA FREEWAY
Sta. 131+00 to Sta. 137+50

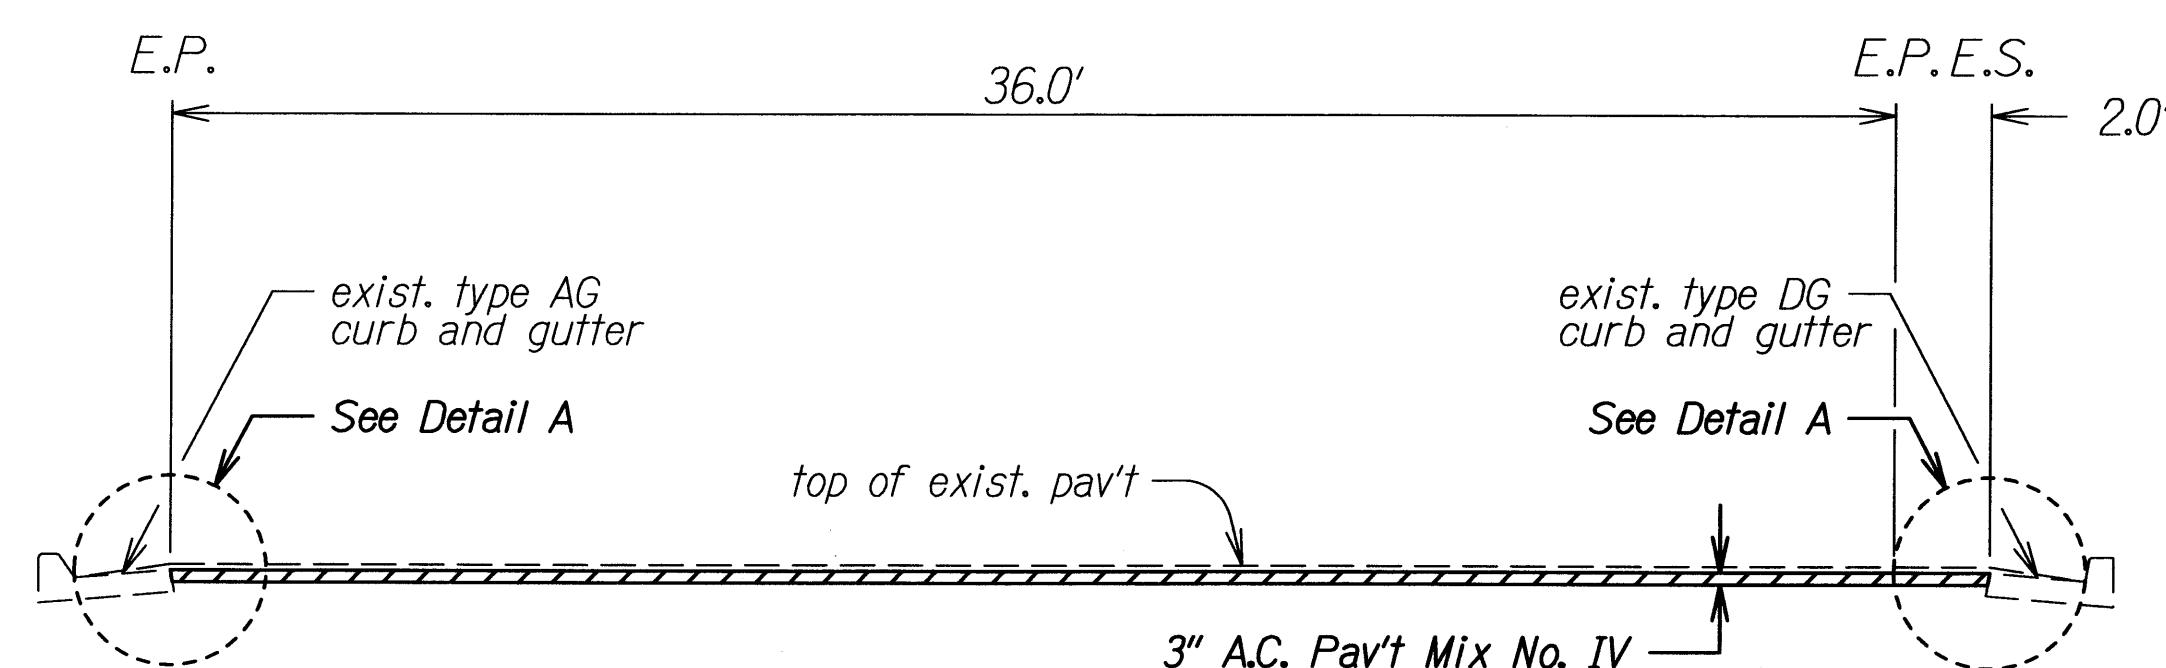

MOANALUA FREEWAY
Sta. 137+50 to Sta. 141+50

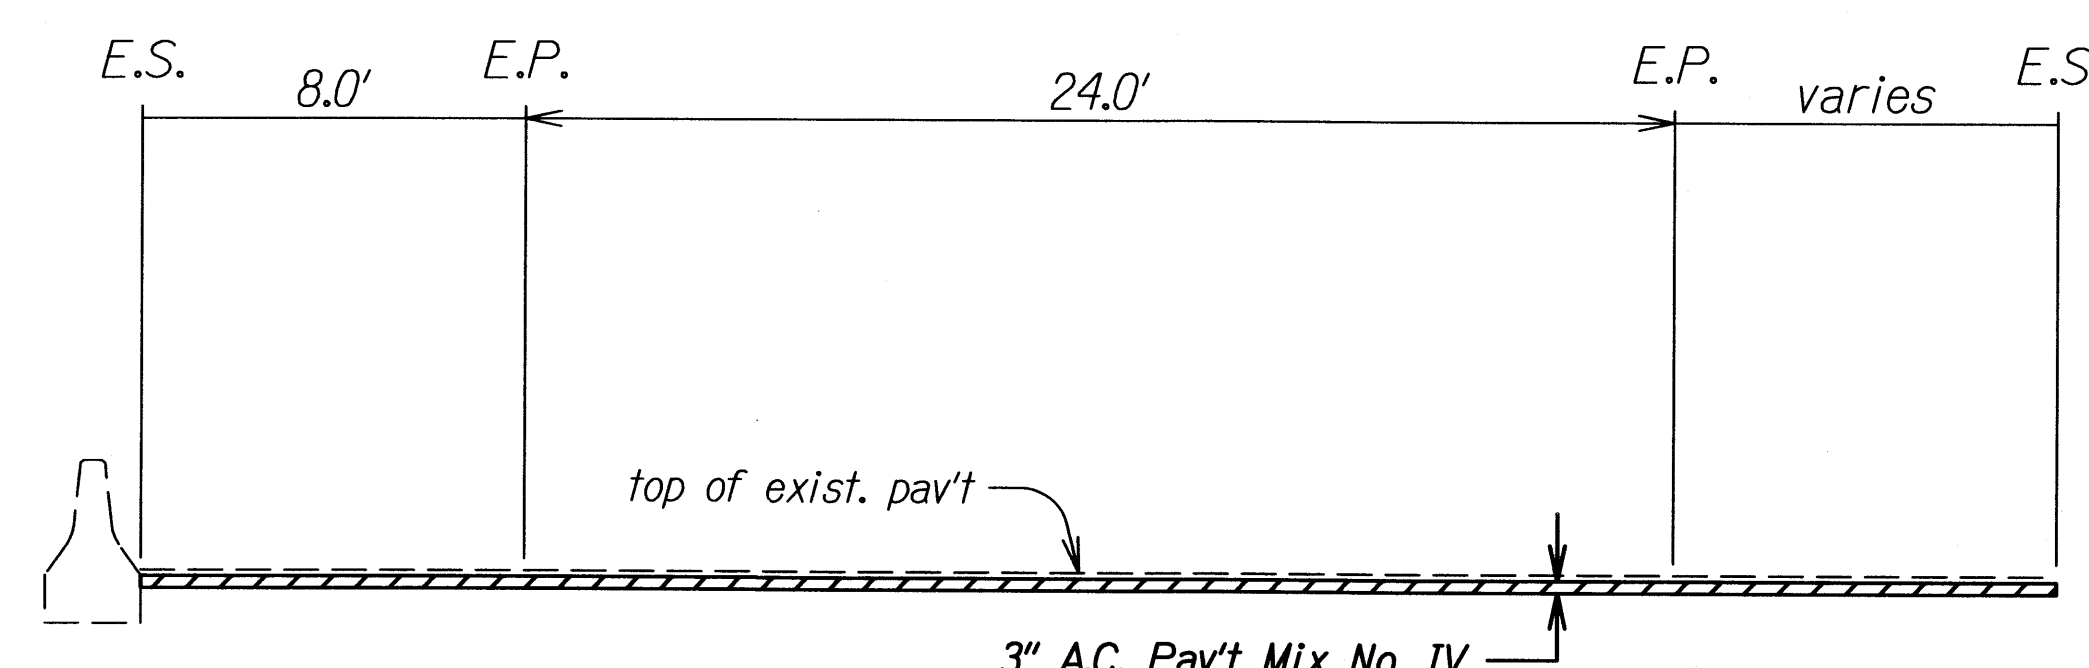

MOANALUA FREEWAY
Sta. 141+50 to Sta. 147+00

TYPICAL SECTION (INBOUND)

SURVEY PLOTTED BY	DATE
DRAWN BY	
TRACED BY	
QUANTITIES BY	
CHECKED BY	

STATE OF HAWAII
DEPARTMENT OF TRANSPORTATION
HIGHWAYS DIVISION

TYPICAL SECTIONS

MOANALUA FREEWAY RESURFACING
Milepost 0.00 to Milepost 0.74
Project No. HWY-0-05-05M

Scale: 1/4" = 1' Date: April, 2010

SHEET No. 2 OF 2 SHEETS