
·	
INDEX TO DRAWINGS	
SHEET NO.	DESCRIPTION
	TITLE SHEET
2	TRAFFIC SIGNAL SYSTEM
3 - 6	MISCELLANEOUS DETAILS
·	
	· · · · · · · · · · · · · · · · · · ·


DEPARTMENT OF TRANSPORTATION
HIGHWAYS DIVISION
HONOLULU, HAWAII

"AS BUILT"
PLANS FOR
INSTALLATION OF TRAFFIC SIGNALS
AT
FORT SHAFTER OVERPASS
AND
KAUA STREET INTERSECTION

PROJECT NO. BD 67-380

DISTRICT OF HONOLULU ISLAND OF OAHU

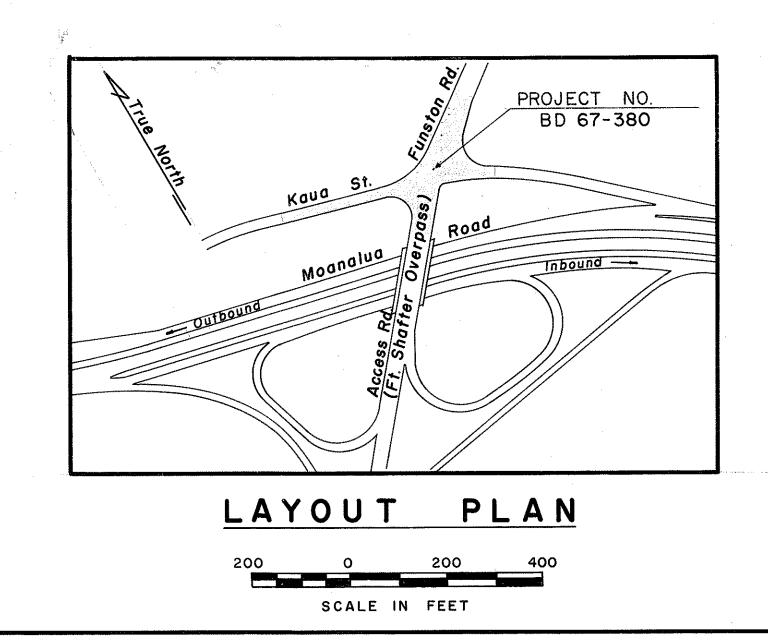

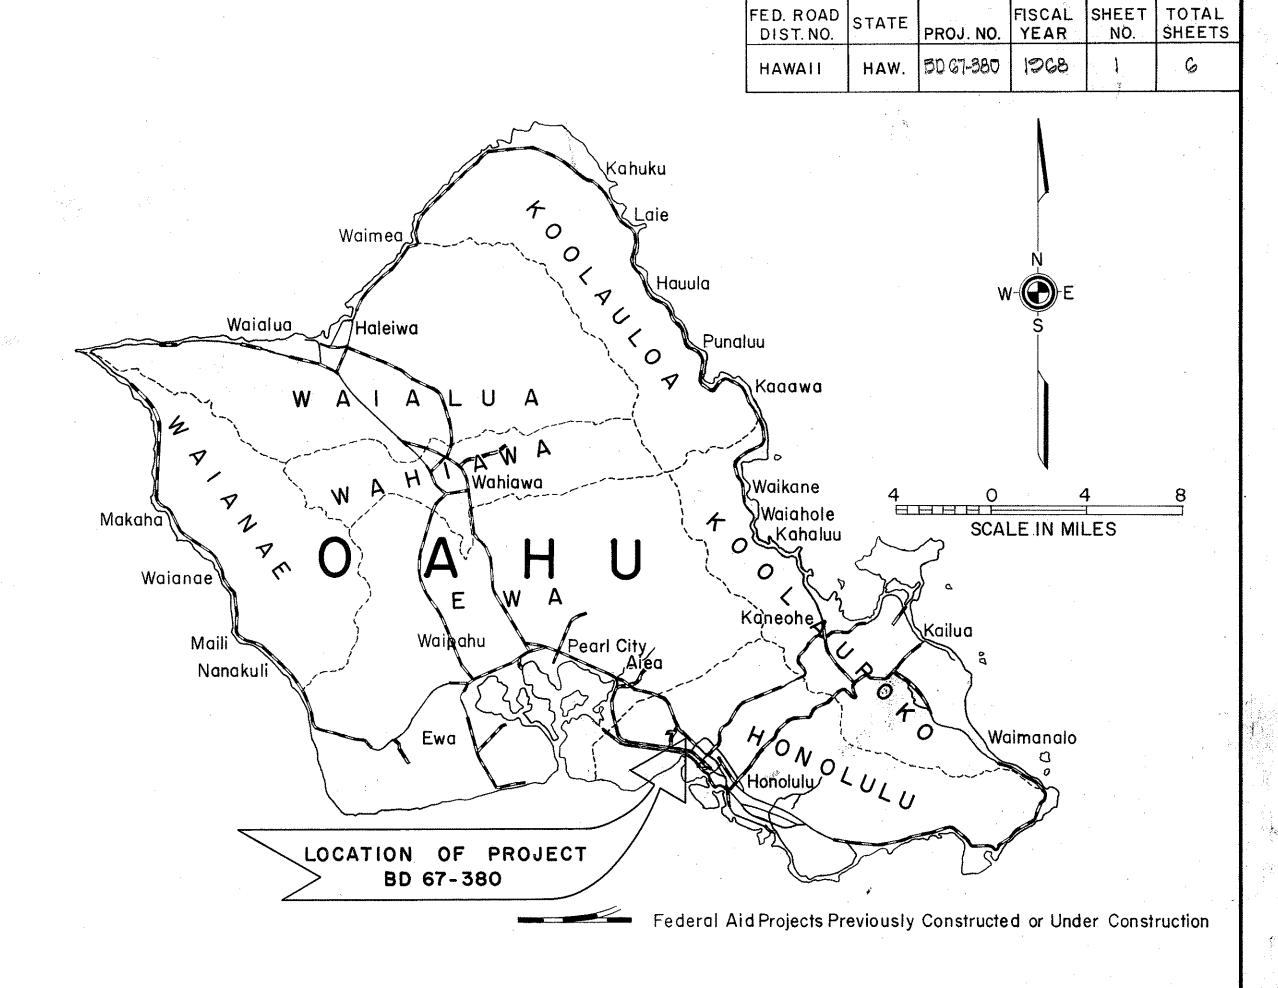

NOTE:

ALL CHANGES MADE DURING CONSTRUCTION HAVE BEEN NOTED IN RED ON THESE TRACINGS AND CHECKED BY:

PROJECT ENGINEER

DATE

DEPARTMENT OF TRANSPORTATION
STATE OF HAWAII

APPROVED:

John Hill Chiliften 3/22/68

EMDLA. OF TRANSPORTATION DATE