
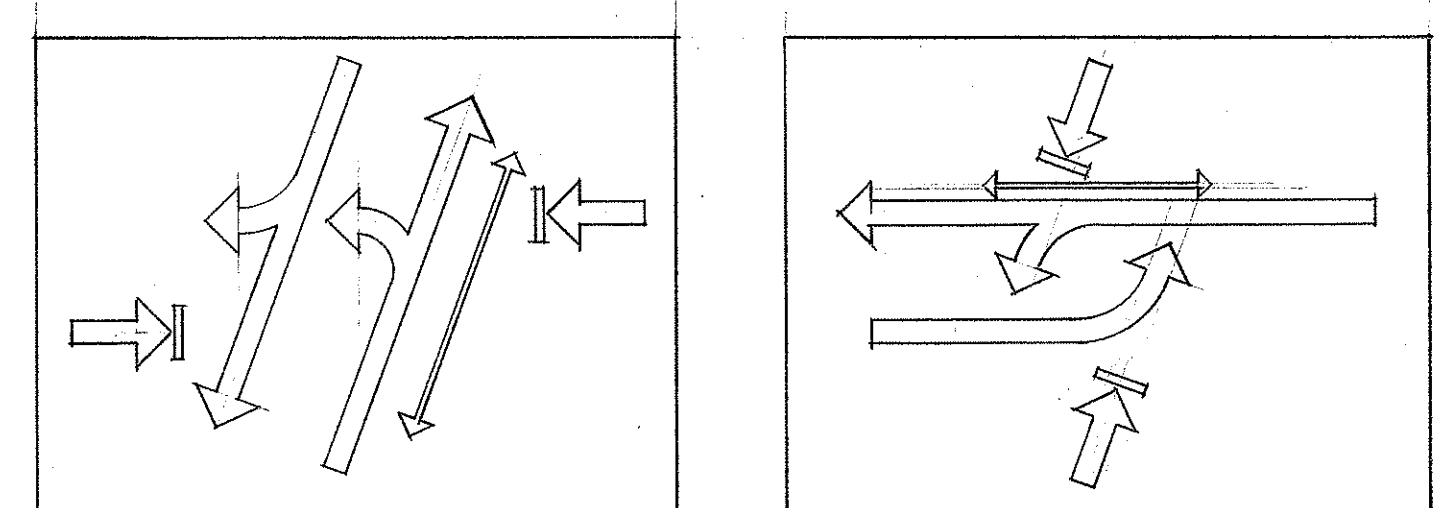


FED. ROAD DIST. NO.	STATE	PROJ. NO.	FISCAL YEAR	SHEET NO.	TOTAL SHEETS
HAWAII	HAW.	BD 67-380	1968	2	6

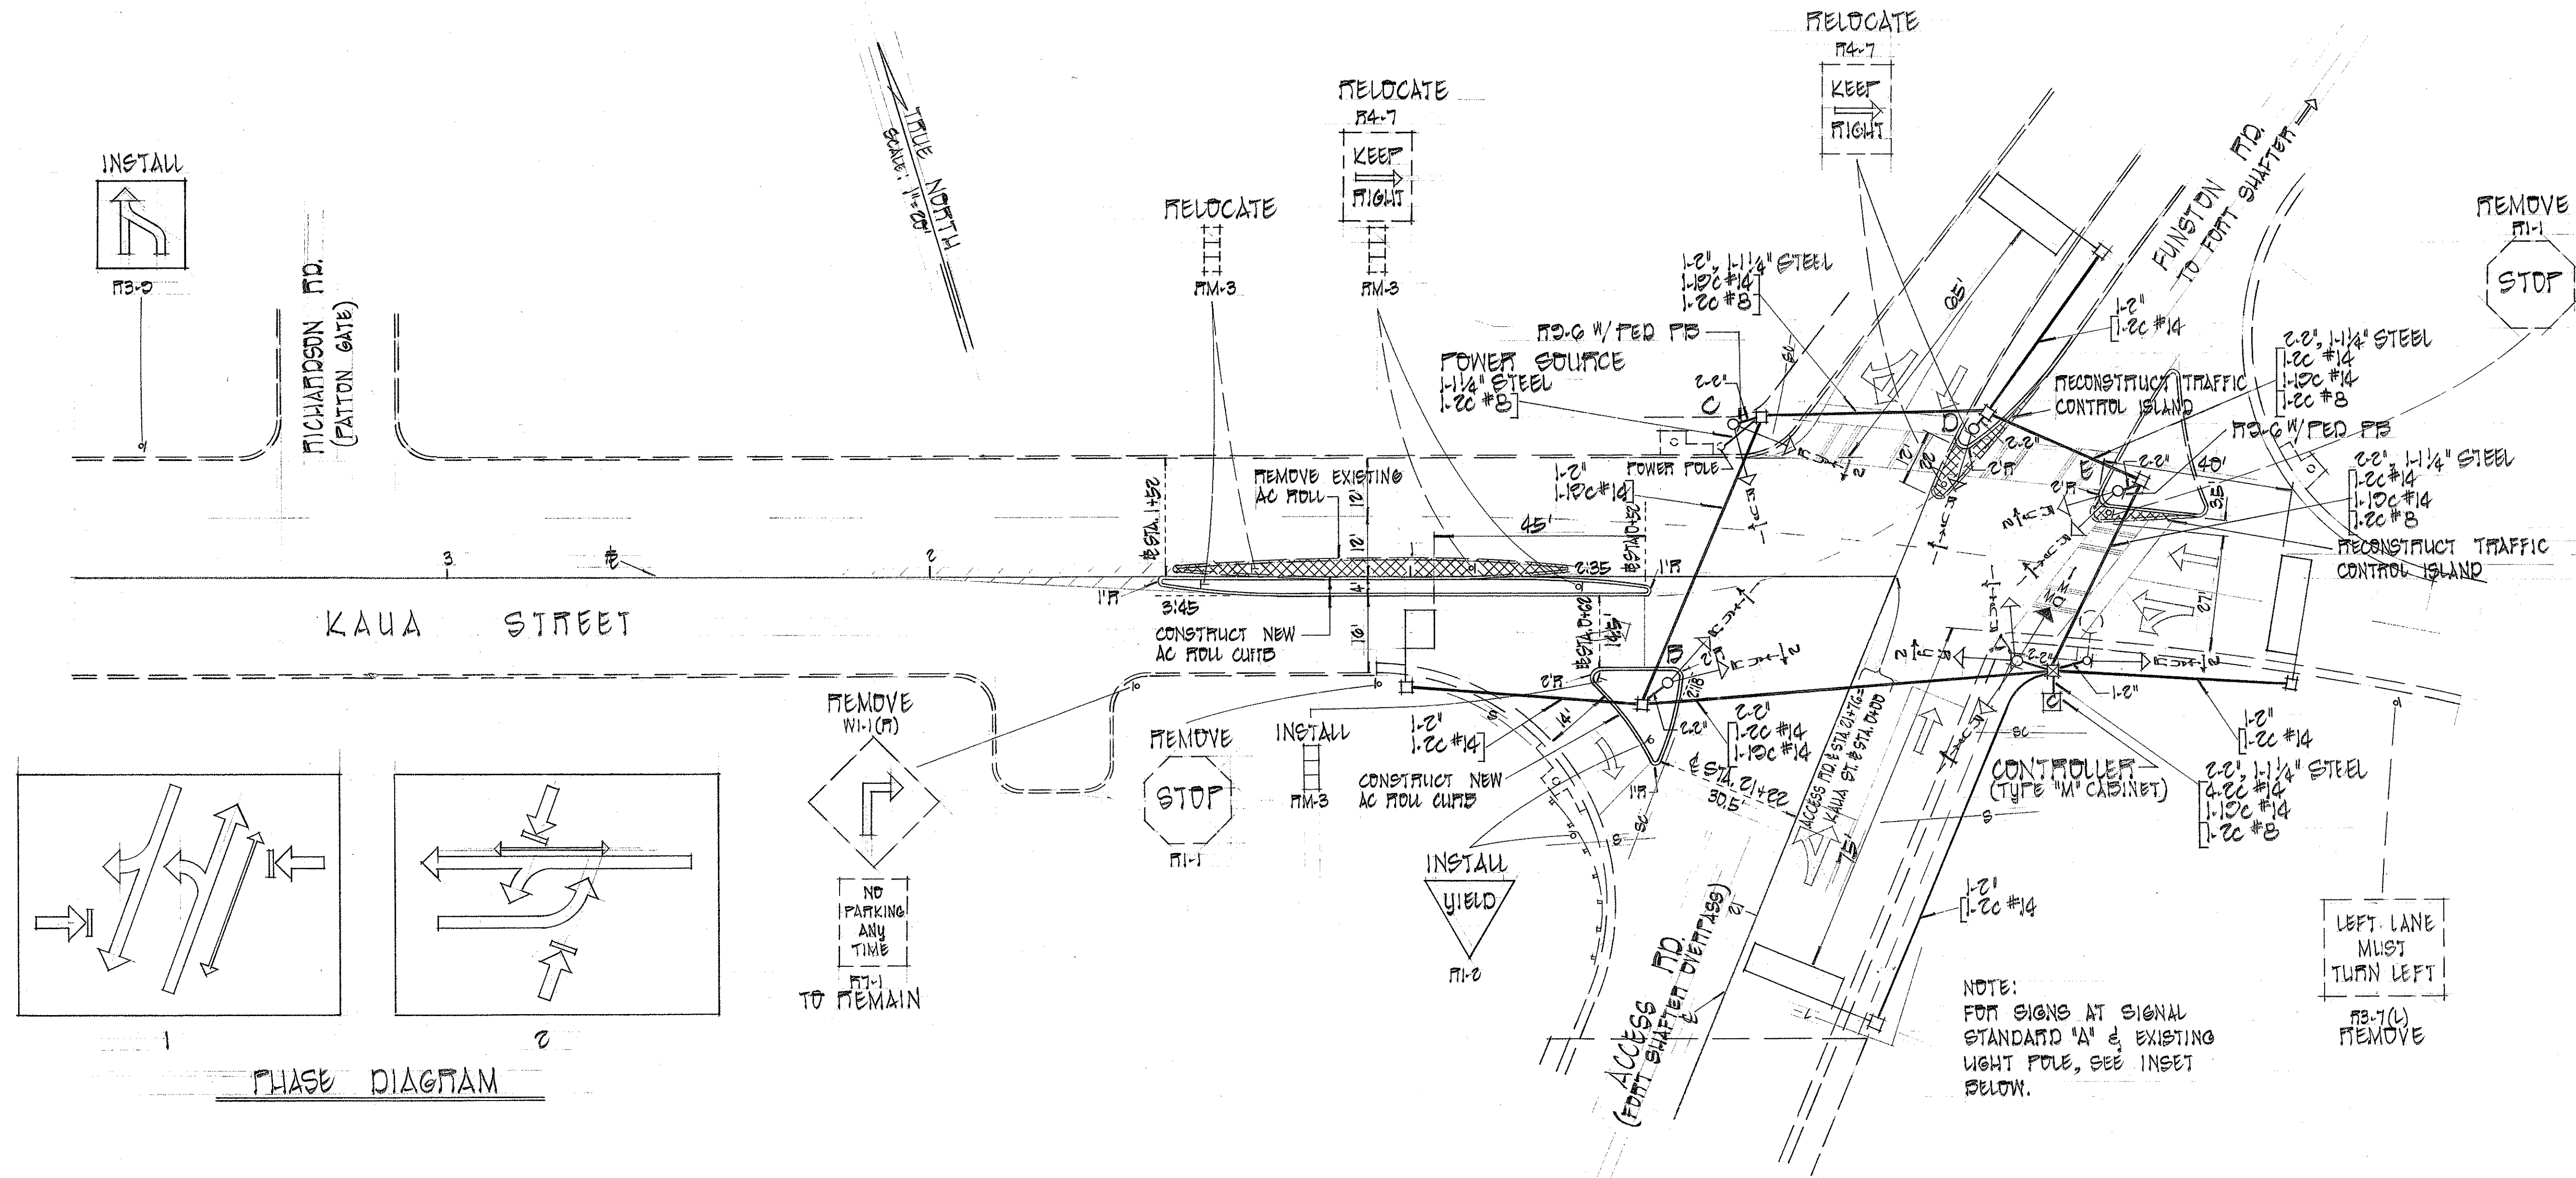


PHASE DIAGRAM

LEGEND

- → NEW TRAFFIC SIGNAL STANDARD & 12" LENS ASSEMBLY.
- → NEW TRAFFIC SIGNAL STANDARD & "DW-W" PEDESTRIAN SIGNAL.
- NEW VEHICLE LOOP DETECTOR.
- ⊠ NEW TYPE "A" PULLBOX.
- ⊠ NEW TYPE "B" PULLBOX.
- ⊠ NEW CONTROLLER.
- 1-1/4" STEEL NEW RIGID STEEL CONDUIT.
- 1-2" NEW RIGID STEEL OR POLYVINYL CHLORIDE CONDUIT. NO. & SIZE AS INDICATED. CONDUITS UNDER ROADWAYS SHALL BE ENCASED IN CONCRETE.
- EXISTING POWER POLE.
- EXISTING HIGHWAY LIGHTING STANDARD.
- SC — EXISTING UNDERGROUND UTILITIES
- S — SIGNAL COMP. CABLE
- L — SPRINKLER SYSTEM
- V — HIGHWAY LIGHTING CABLE

GENERAL NOTES

1. LOCATION OF EXISTING UNDERGROUND STRUCTURES SUCH AS CULVERTS, PIPELINES, CONDUITS, CABLES, ETC., AS SHOWN ON THE PLANS ARE APPROXIMATE ONLY; OTHER EXISTING UTILITIES MAY NOT BE SHOWN. THE CONTRACTOR SHALL CHECK AND VERIFY THE LOCATION OF SAME.
2. THE EXACT LOCATION OF TRAFFIC SIGNAL STANDARDS, CONTROLLER BASE, PULLBOXES AND CONDUITS SHALL BE DETERMINED IN THE FIELD BY THE ENGINEER.
3. EXISTING SIGNS NOT INCORPORATED IN THE COMPLETED SYSTEM SHALL BE REMOVED AND STOCKPILED AS DIRECTED BY THE ENGINEER.
4. PAVEMENT MARKINGS BY OTHERS.

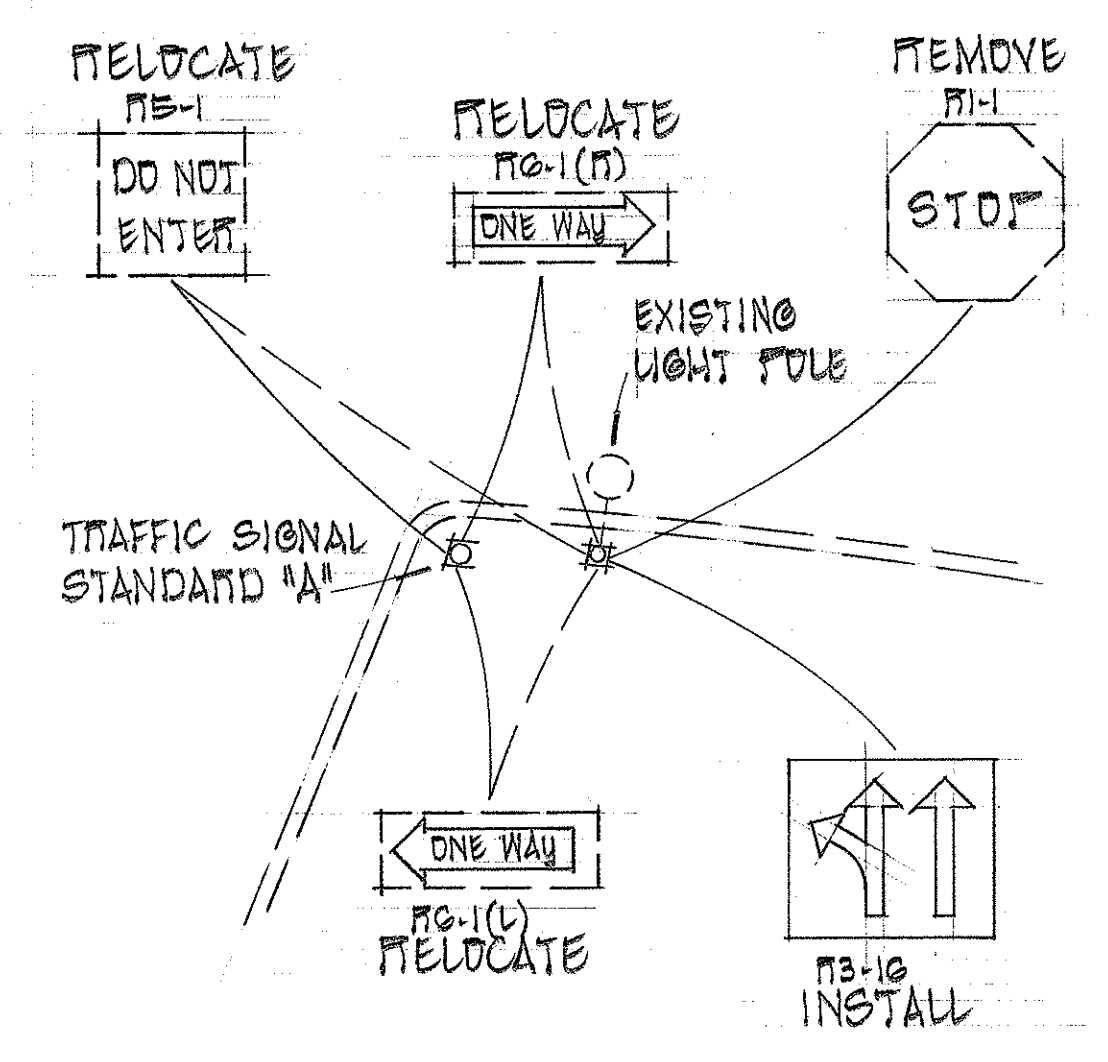

INSET: NOT TO SCALE
SIGNS AT SIGNAL STANDARD "A"
AND EXISTING LIGHT POLE

STATE OF HAWAII
DEPARTMENT OF TRANSPORTATION
HIGHWAYS DIVISION

TRAFFIC SIGNAL SYSTEM
FORT SHAFTER OVERPASS
AND
KAUA ST. INTERSECTION

Project No. BD 67-380
Scale: As Shown March 1968
SHEET No. 2 OF 6 SHEETS

DATE	DESIGNED BY	CHECKED BY
PLAN	DESIGNED BY	CHECKED BY
NOTE BOOK	DESIGNED BY	CHECKED BY
NO.	DESIGNED BY	CHECKED BY