INDEX		ТО	DRAWINGS		
SHEET NO.	DESCRIPTION				
	TIT	LE	SHEE	T	
2	PLA	NS	AND	DETAILS	
					' '- u '.
				-	
				·	
, , , , , ,			<u> </u>		

				<u> </u>	
••••••••••••••••••••••••••••••••••••••					
	 		·	***************************************	



STATE OF HAWAII

OF TRANSPORTATION DEPARTMENT HIGHWAYS DIVISION

HONOLULU, HAWAII
"AS - BUILT"
PLANS FOR

MISCELLANEOUS DRAINAGE IMPROVEMENTS


AT

PUULOA INTERCHANGE

(LOT T.M.K. NO. 1-1-48:38)

PROJECT NO. 78A - 01-77

DISTRICT OF HONOLULU ISLAND OF OAHU

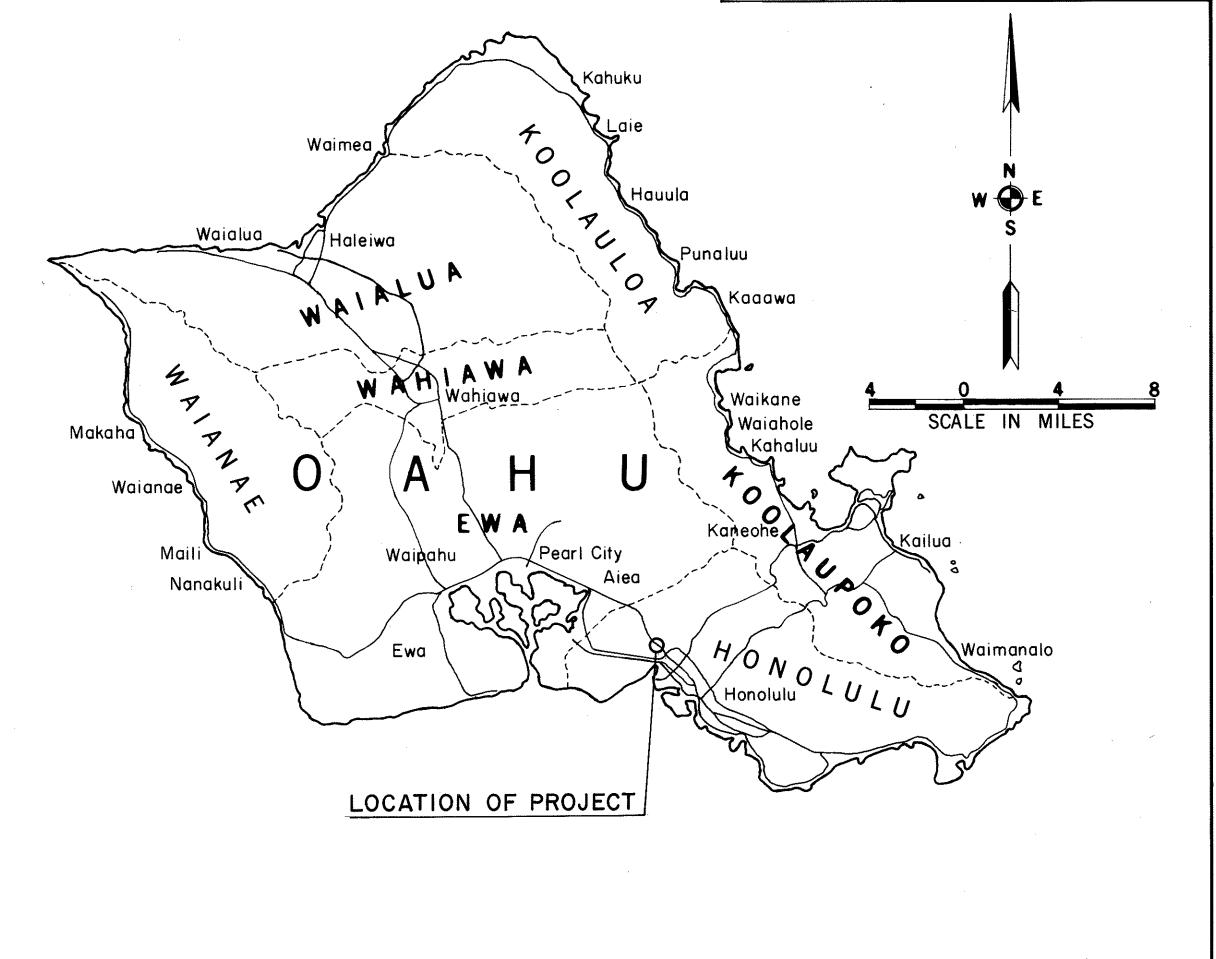

NO CHANGES WERE MADE DURING CONSTRUCTION ON THESE PLANS EXCEPT CHANGES IN THE ORIGINAL THEORETICAL QUANTITIES. FOR ACTUAL QUANTITIES, REFER TO PROJECT LEDGER AND/OR COMPUTATION BOOK.

FED. ROAD DIST. NO.

STATE PROJ. NO.


HAW. 78A-01-77 1976

TOTAL SHEETS

FISCAL SHEET YEAR NO.

Phillest J. Alexante PROJECT ENGINEER

DATE

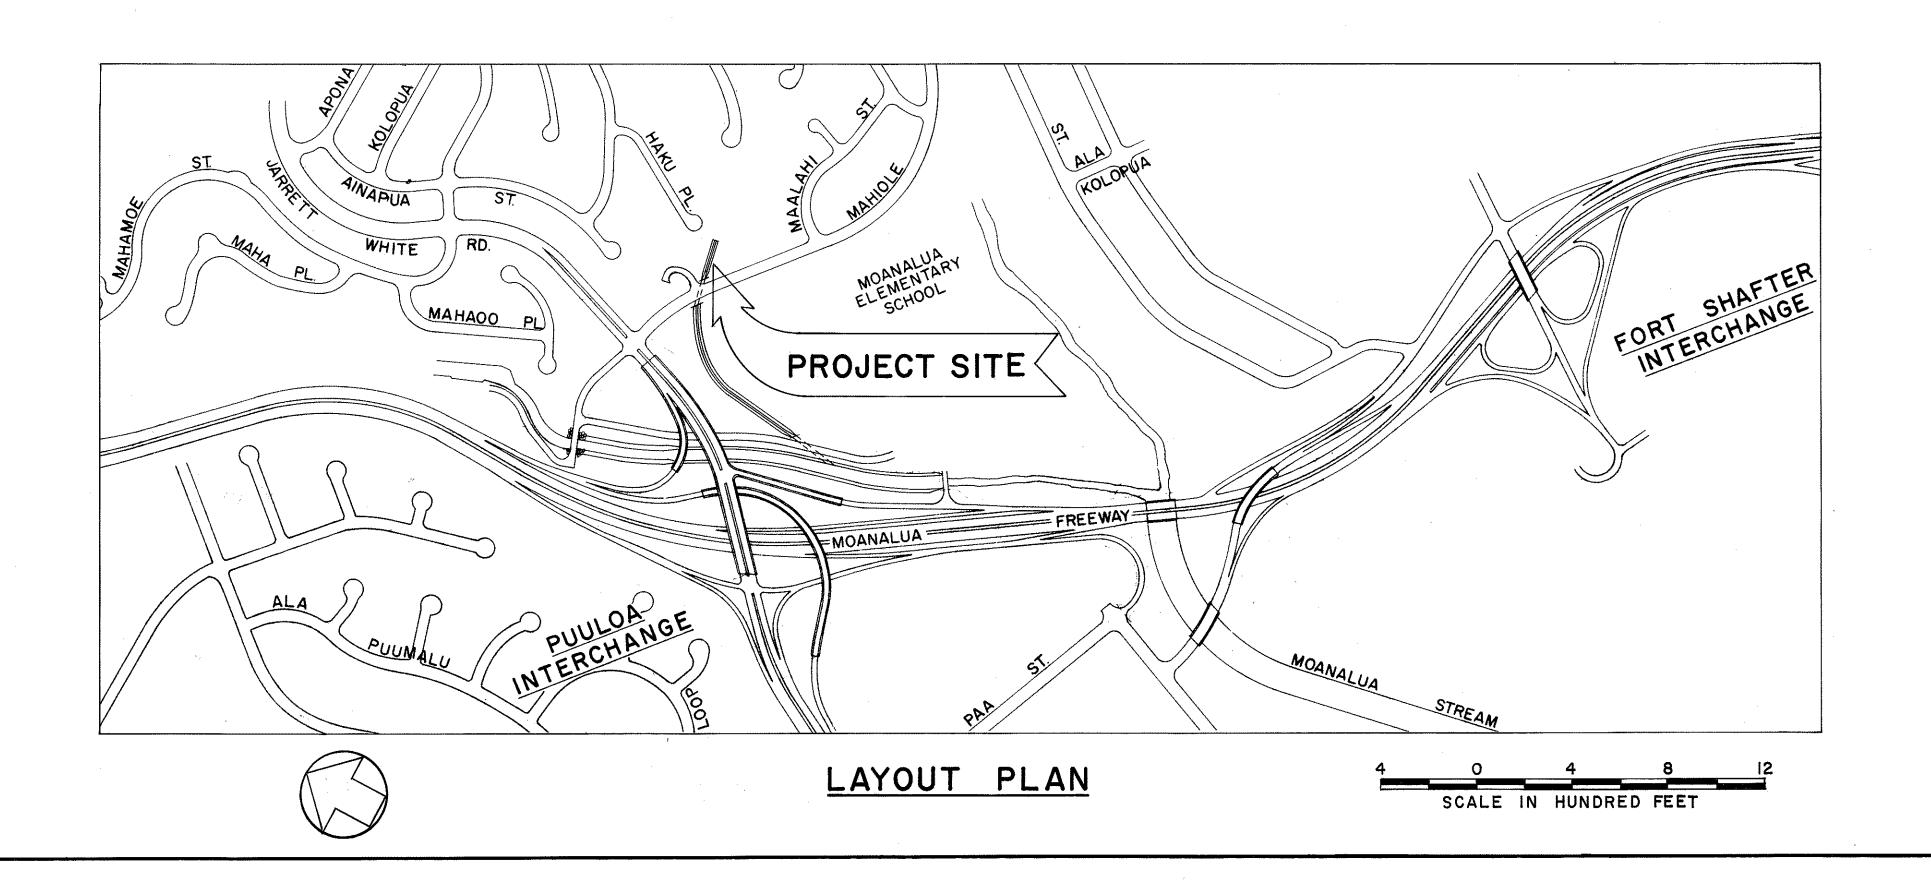

DEPARTMENT OF TRANSPORTATION STATE OF HAWAII