


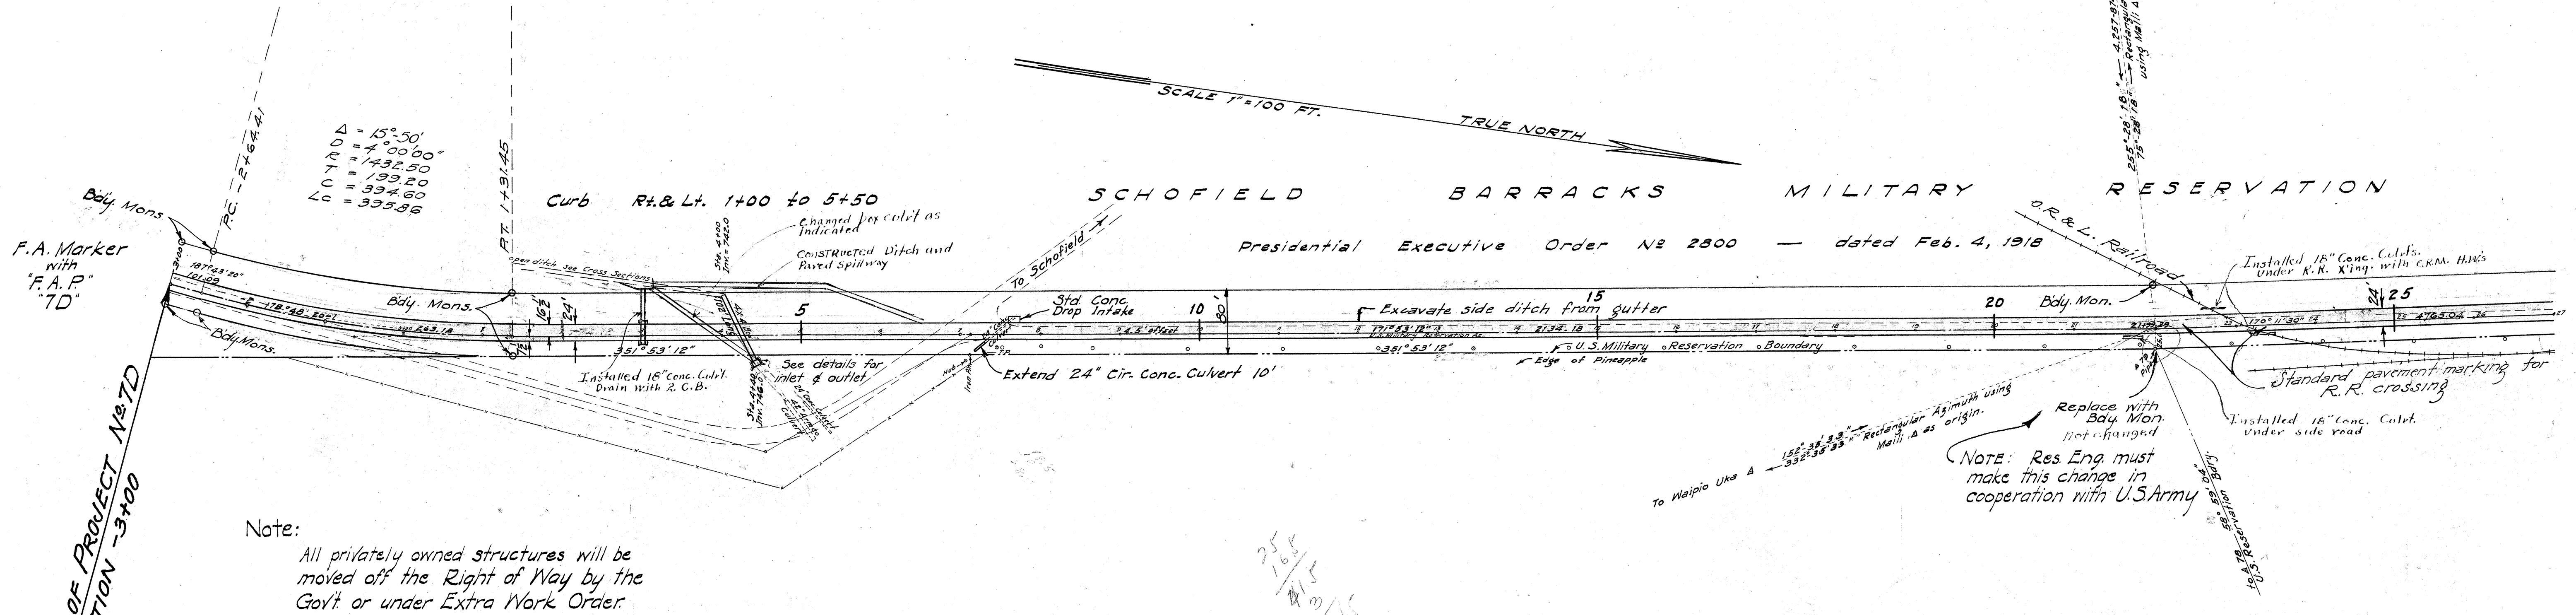



Note:

All privately owned structures will be moved off the Right of Way by the Gov't or under Extra Work Order.




Note:


All notations in red ink indicate changes during construction.

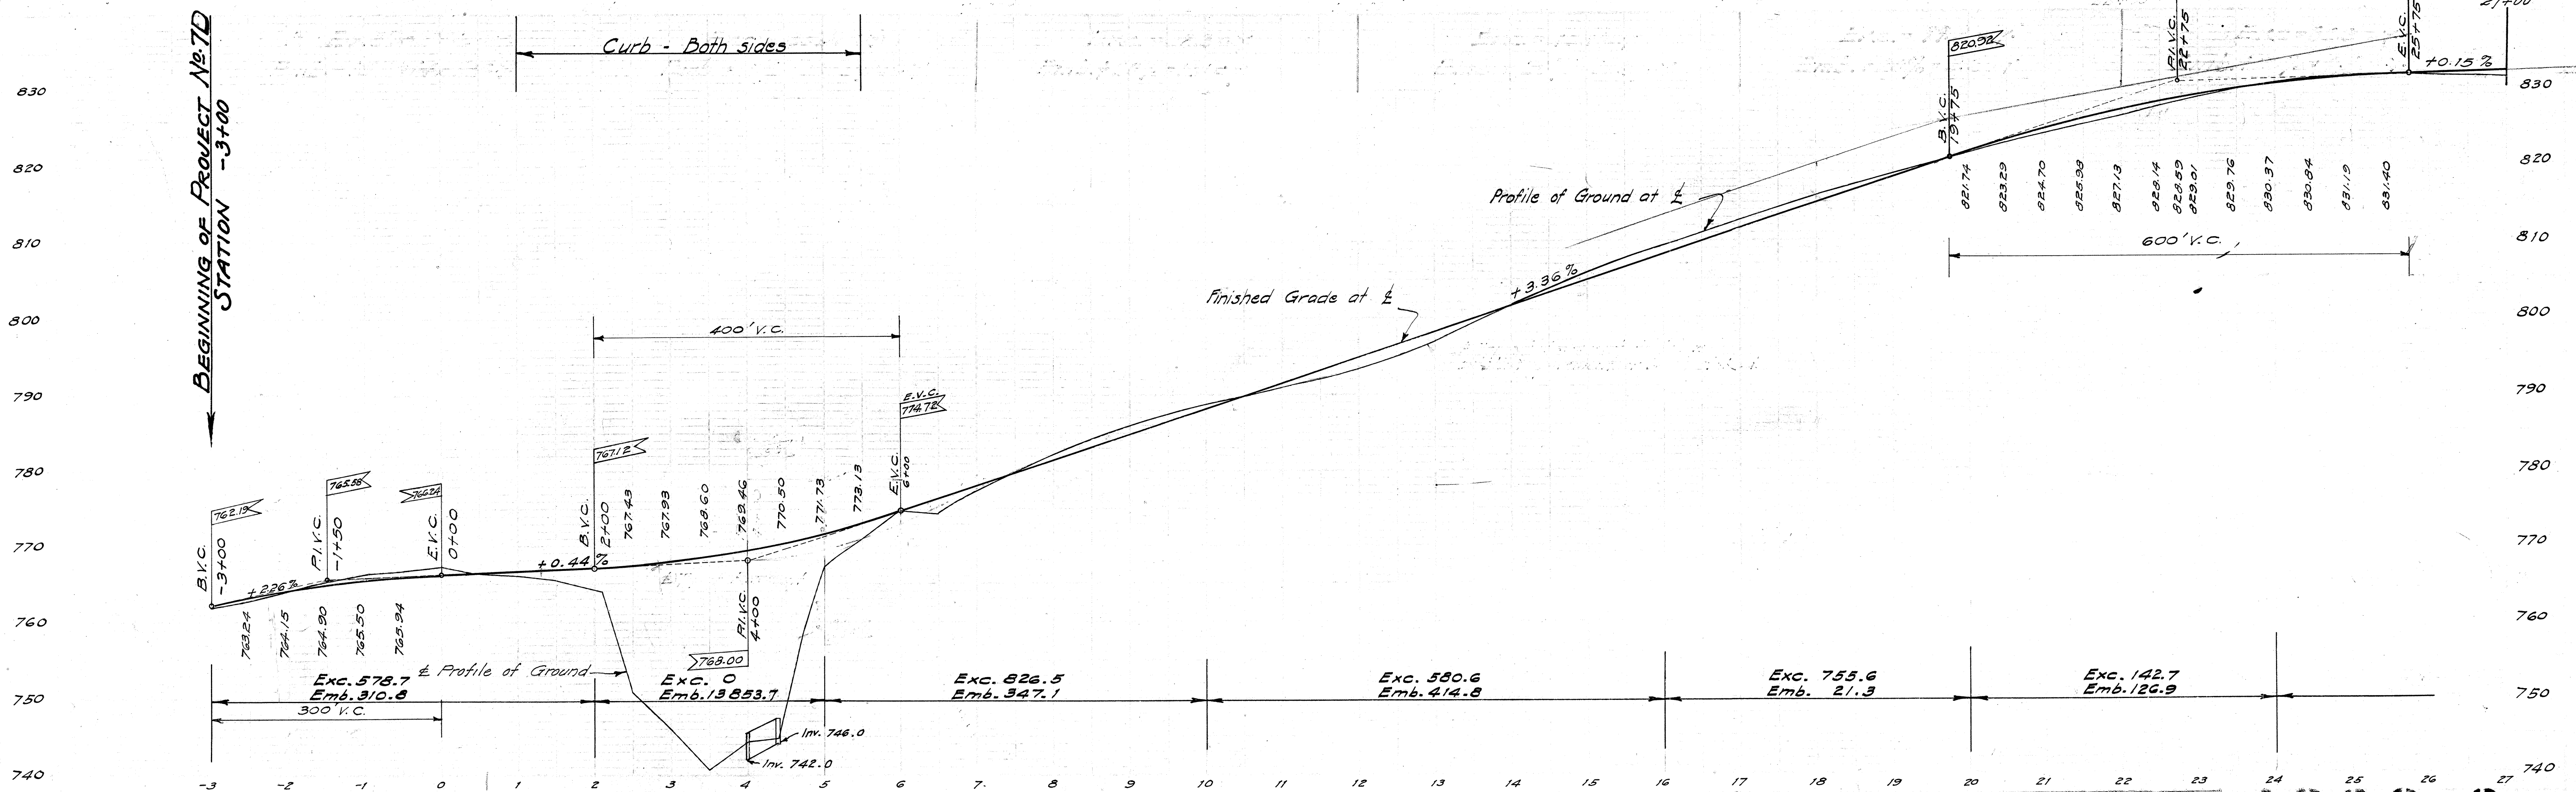



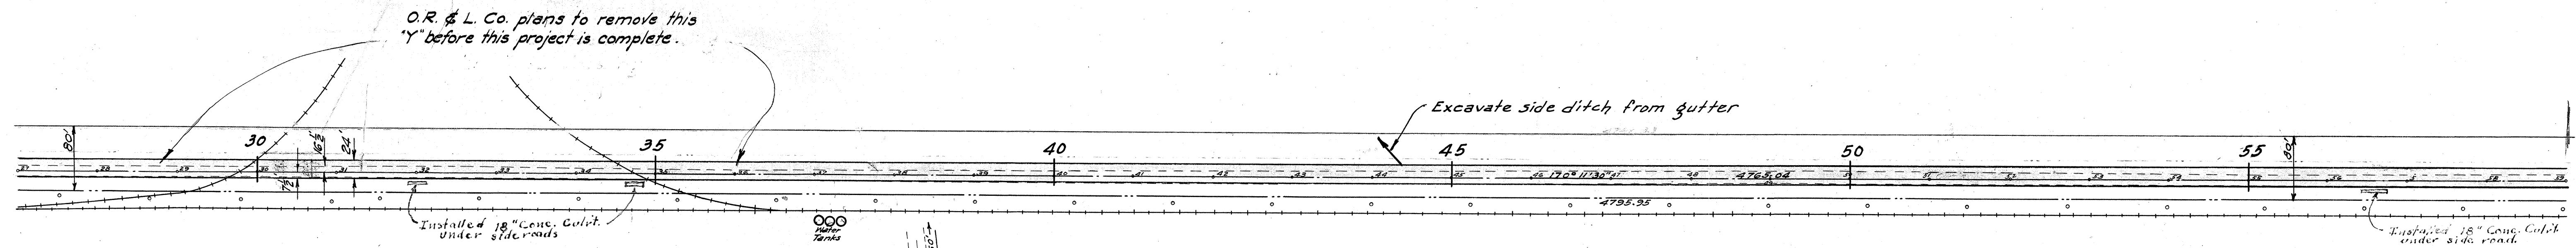


SCHOFIELD BARRACKS MILITARY RESERVATION
 Presidential Executive Order No 2800
 dated Feb. 4, 1918.

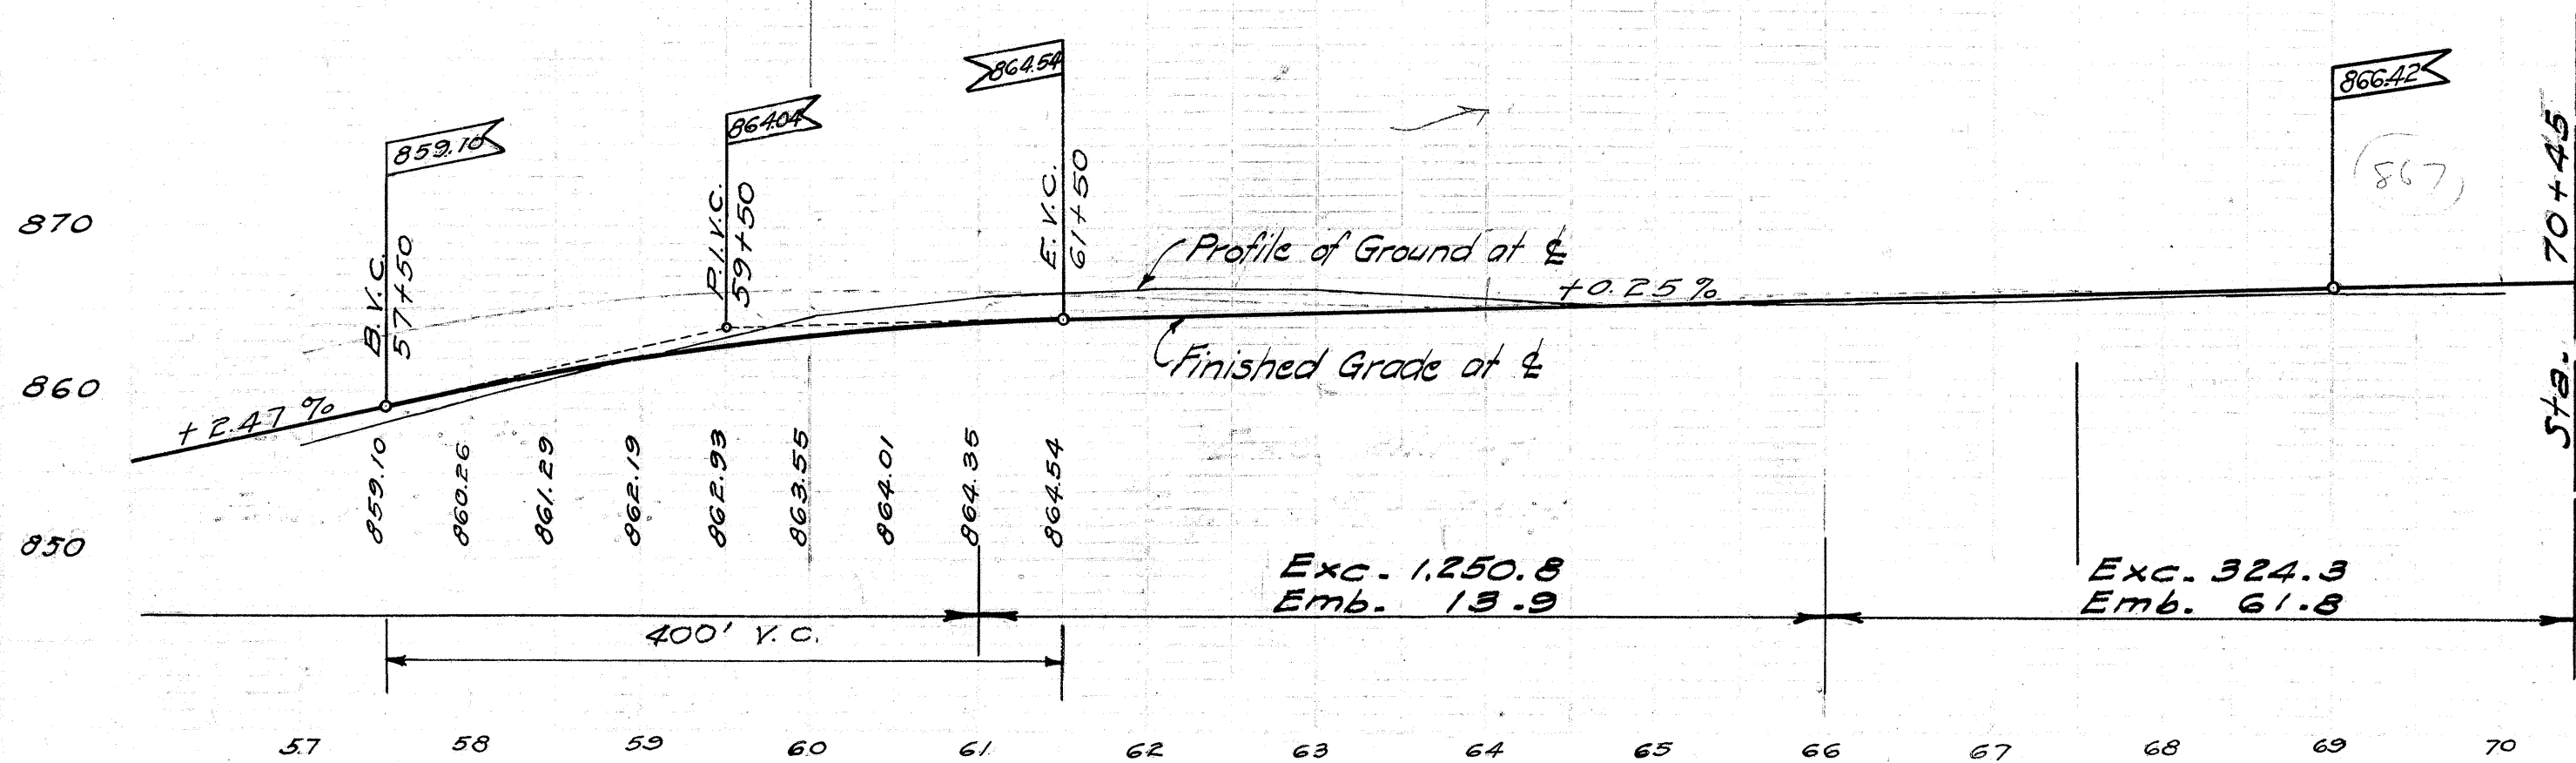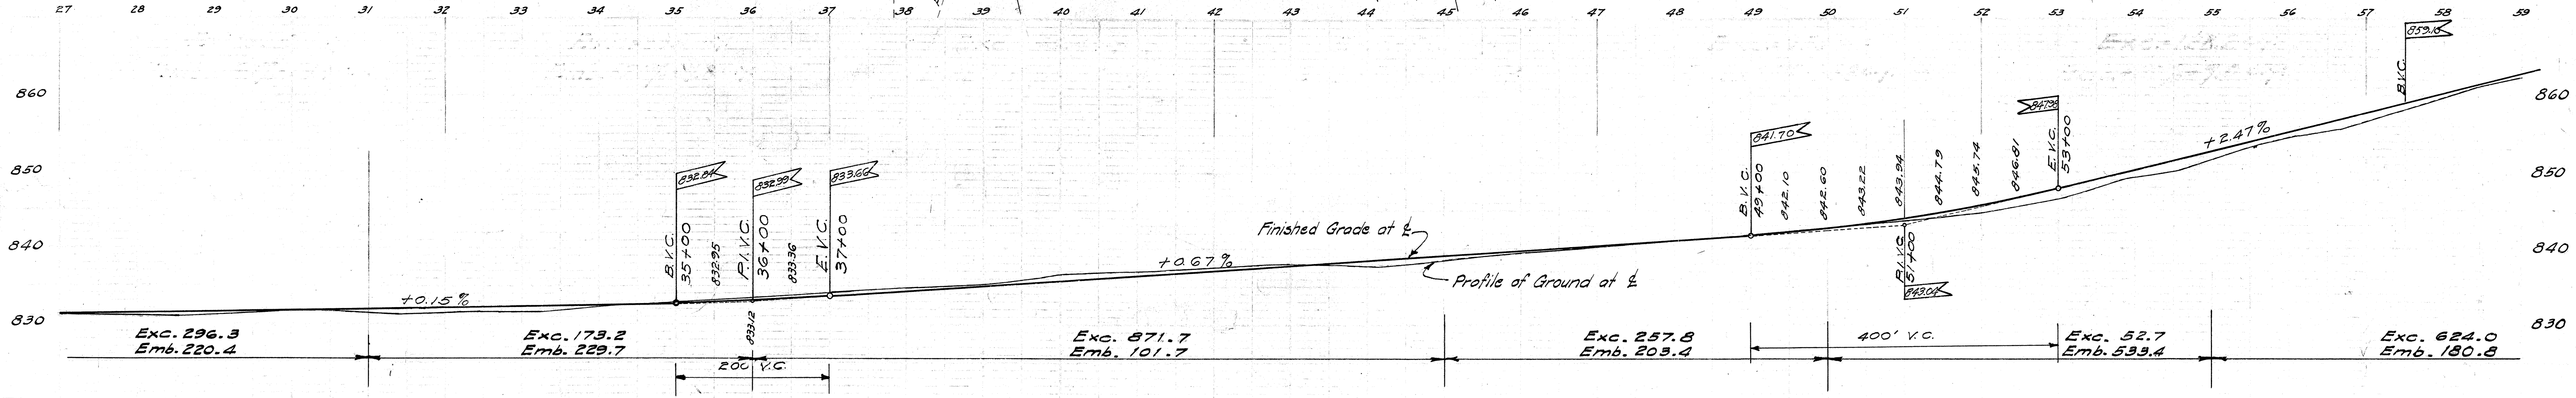
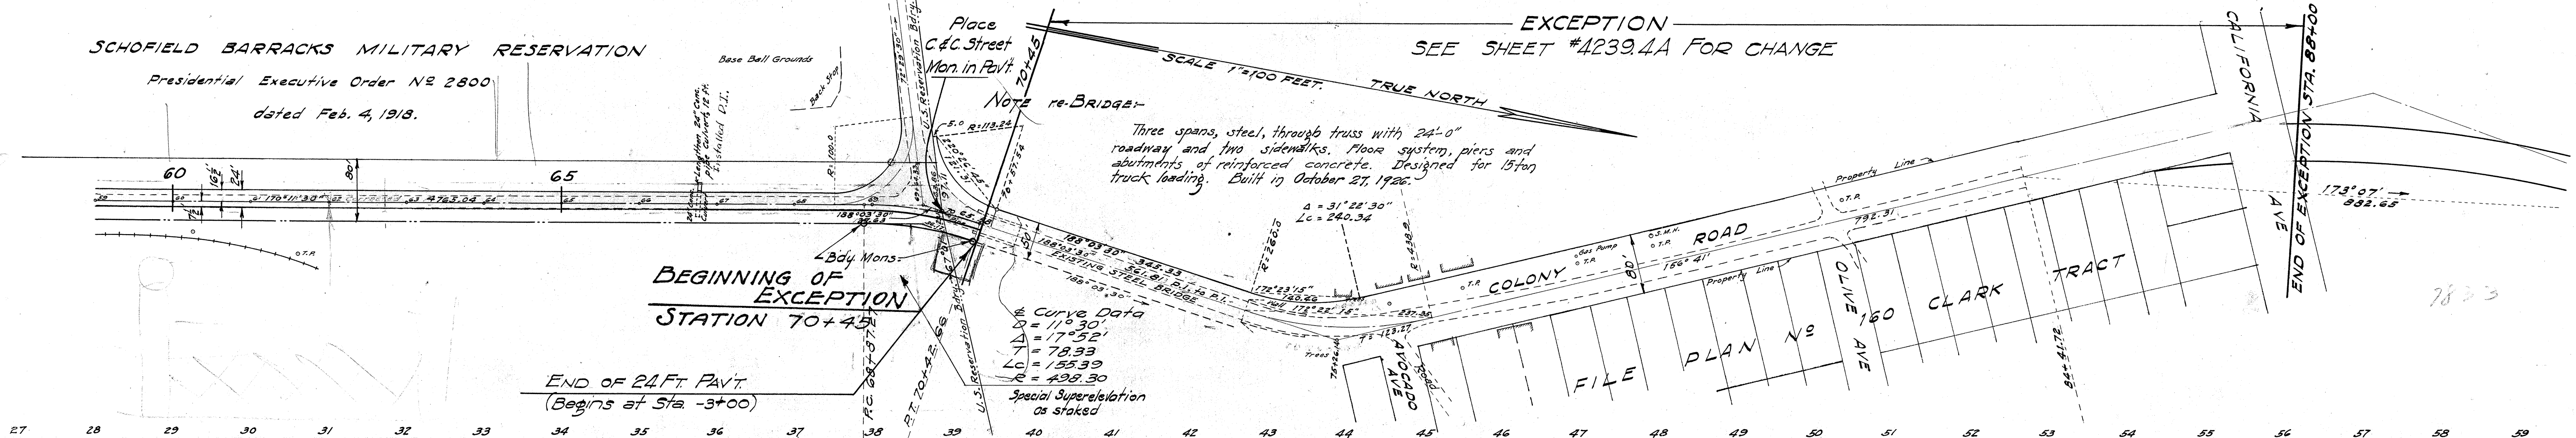


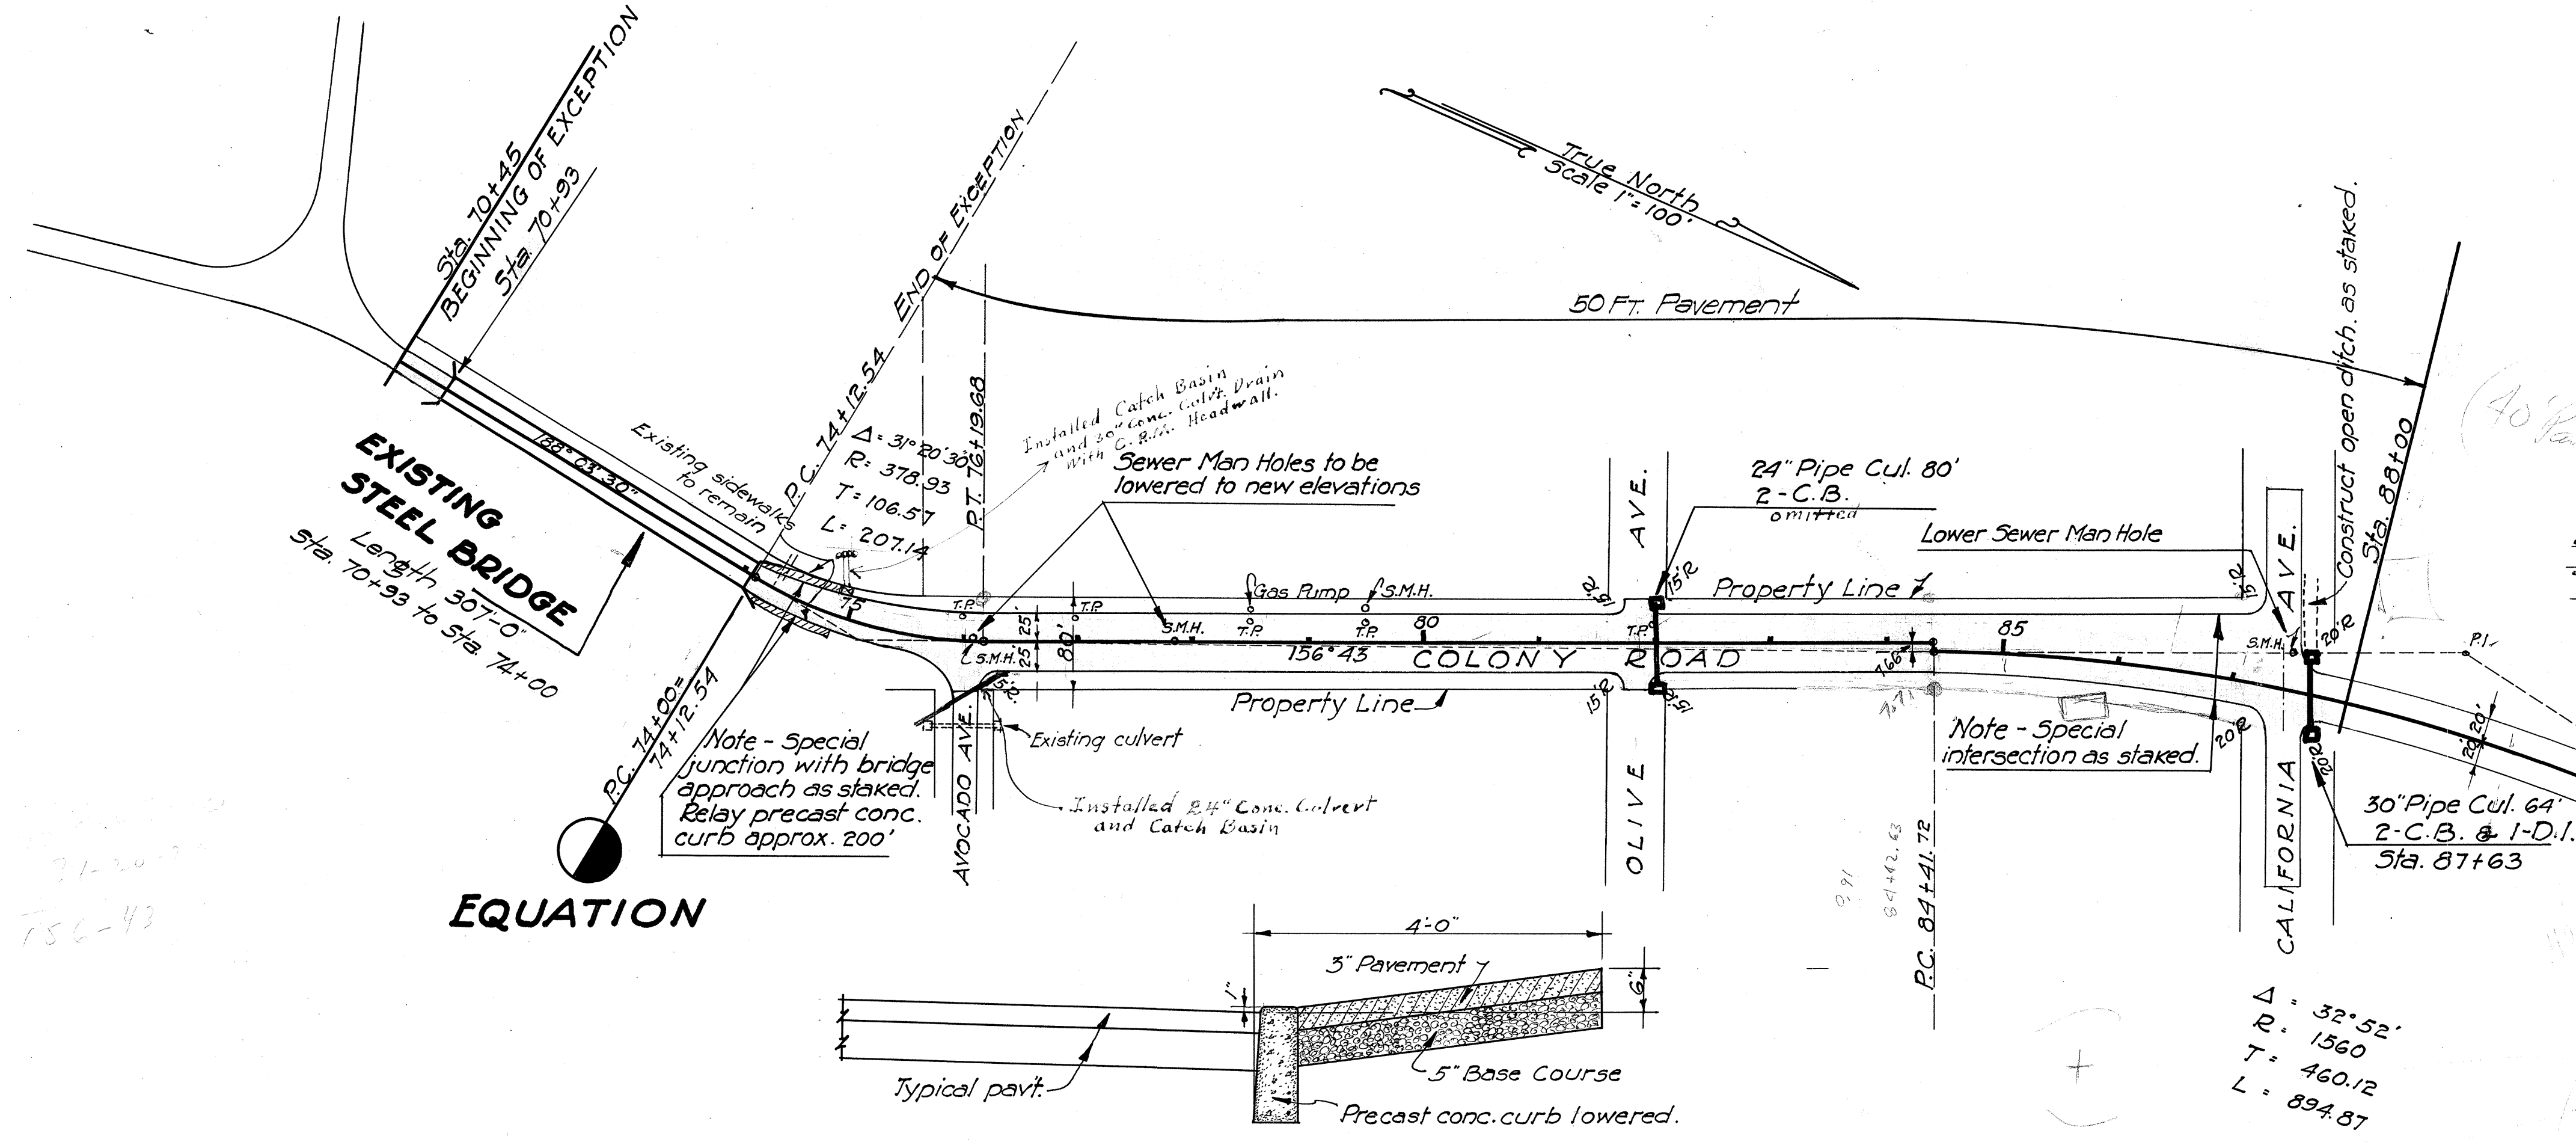

EQUATION

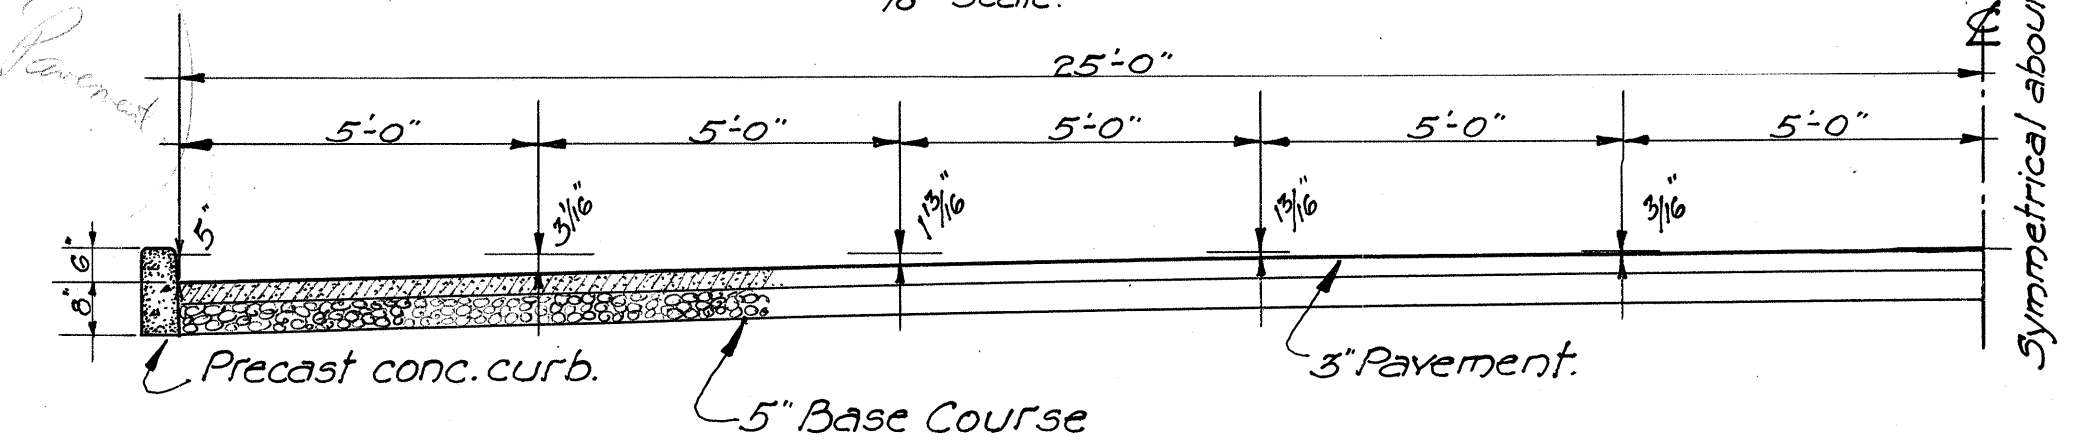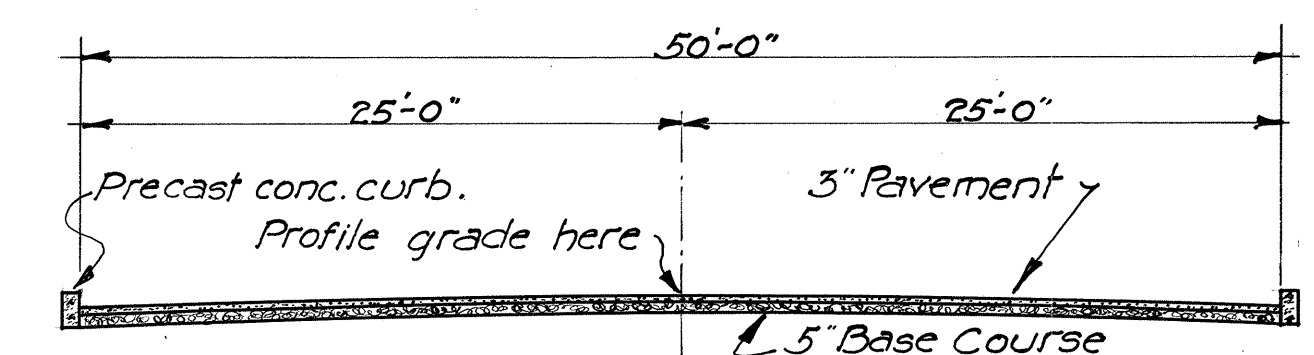
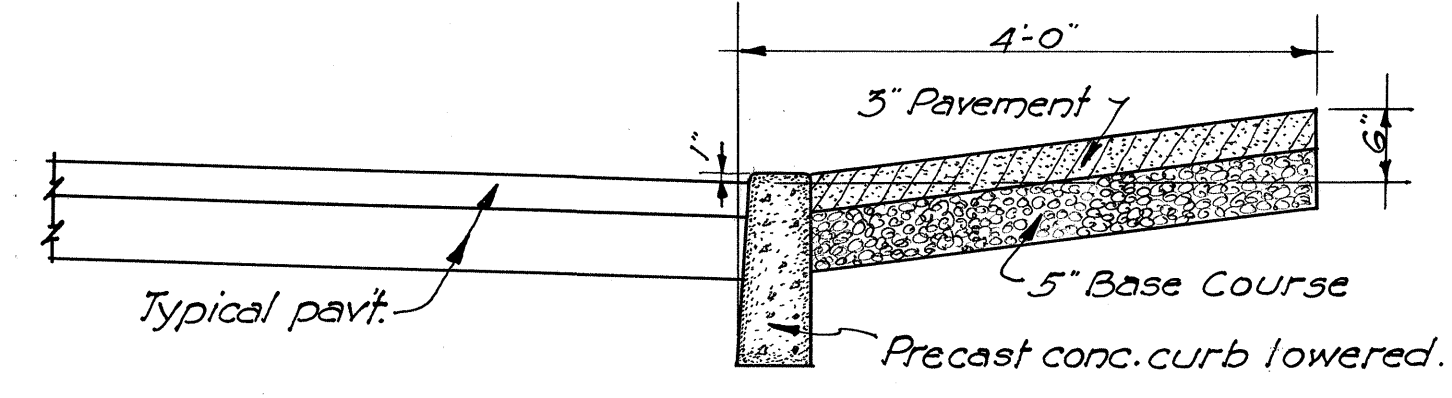


Note - The above roadway section is typical for Sta. 76+00 to Sta. 84+00. Pavement widths at intersections to be as staked out by the Res. Engr. Paving on side roads to extend to property line of Colony Road.

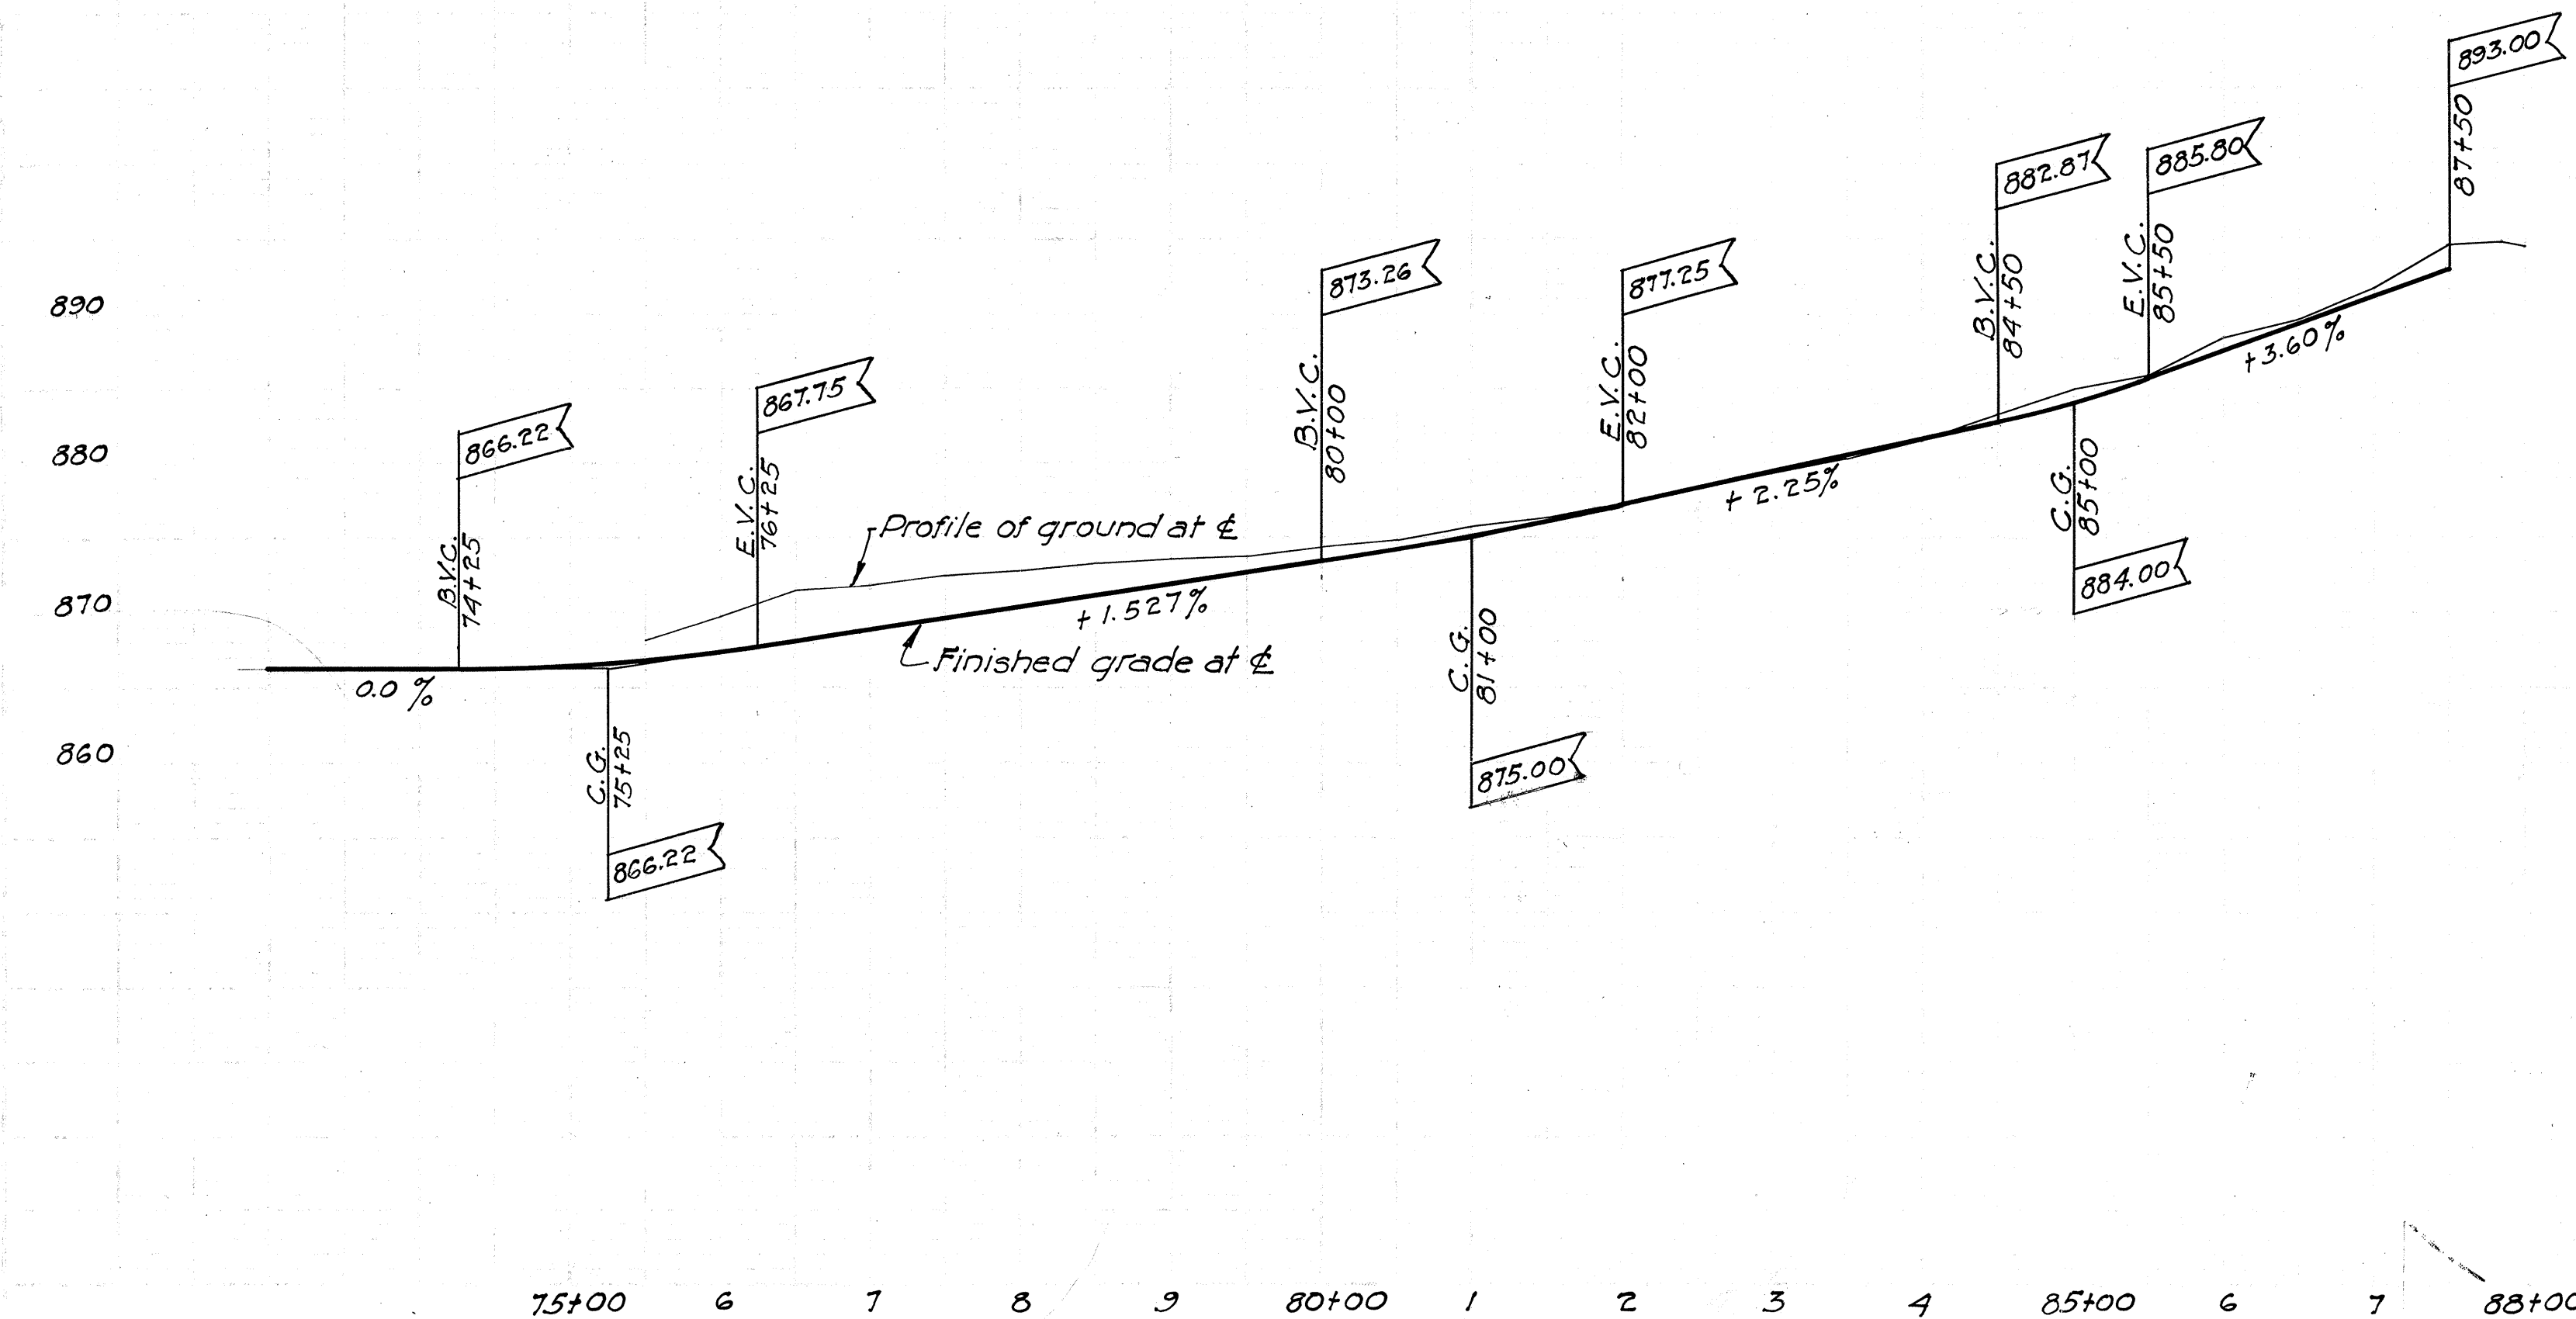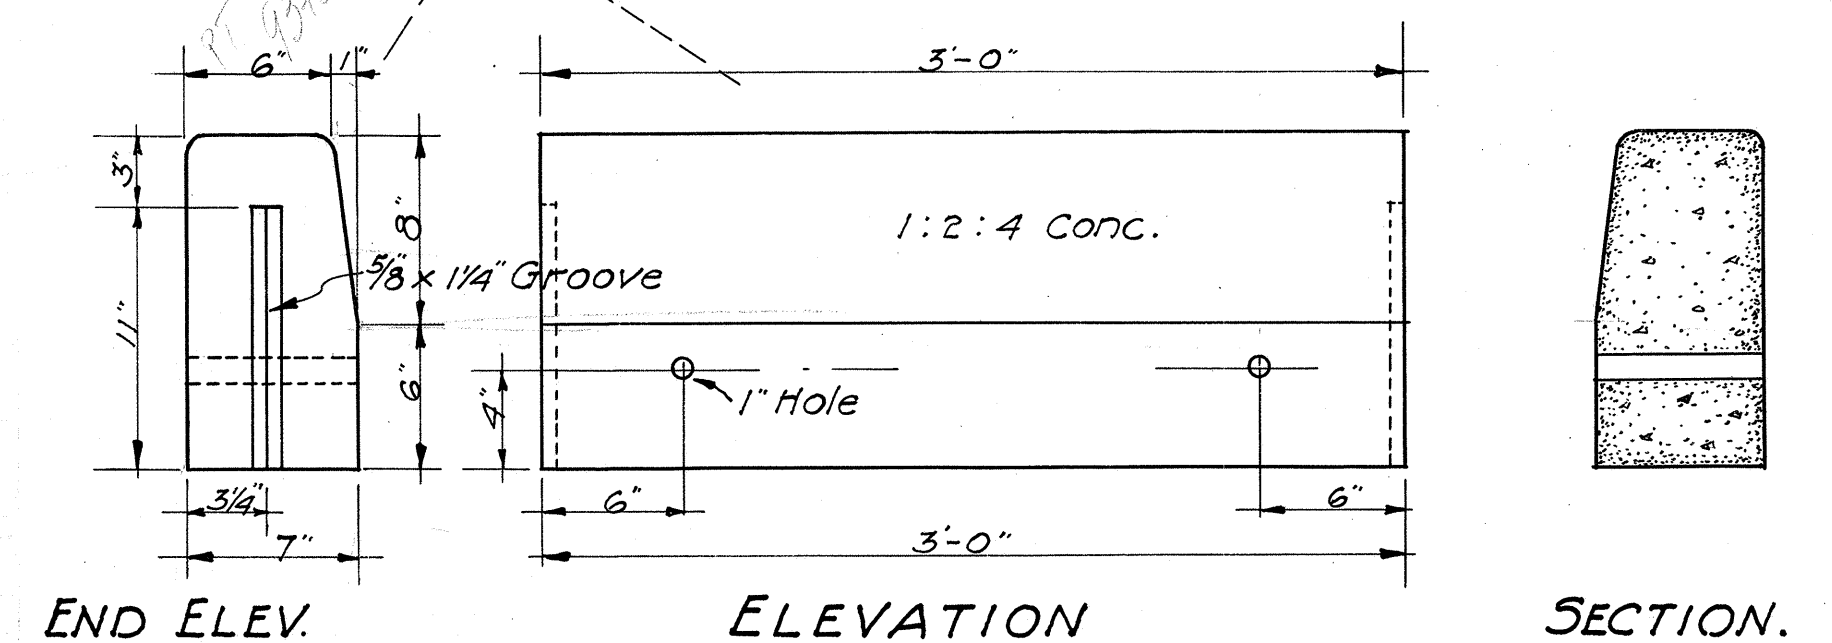



FED. ROAD DIST. NO.	STATE	FED. AID PROJ. NO.	FISCAL YEAR	SHEET NO.	TOTAL SHEETS
HAWAII	HAW	7-B	1931	3	11

FED. ROAD DIST. NO.	STATE	FED. AID PROJ. NO.	FISCAL YEAR	SHEET NO.	TOTAL SHEETS
HAWAII	HAW	7-D	1932	5	28

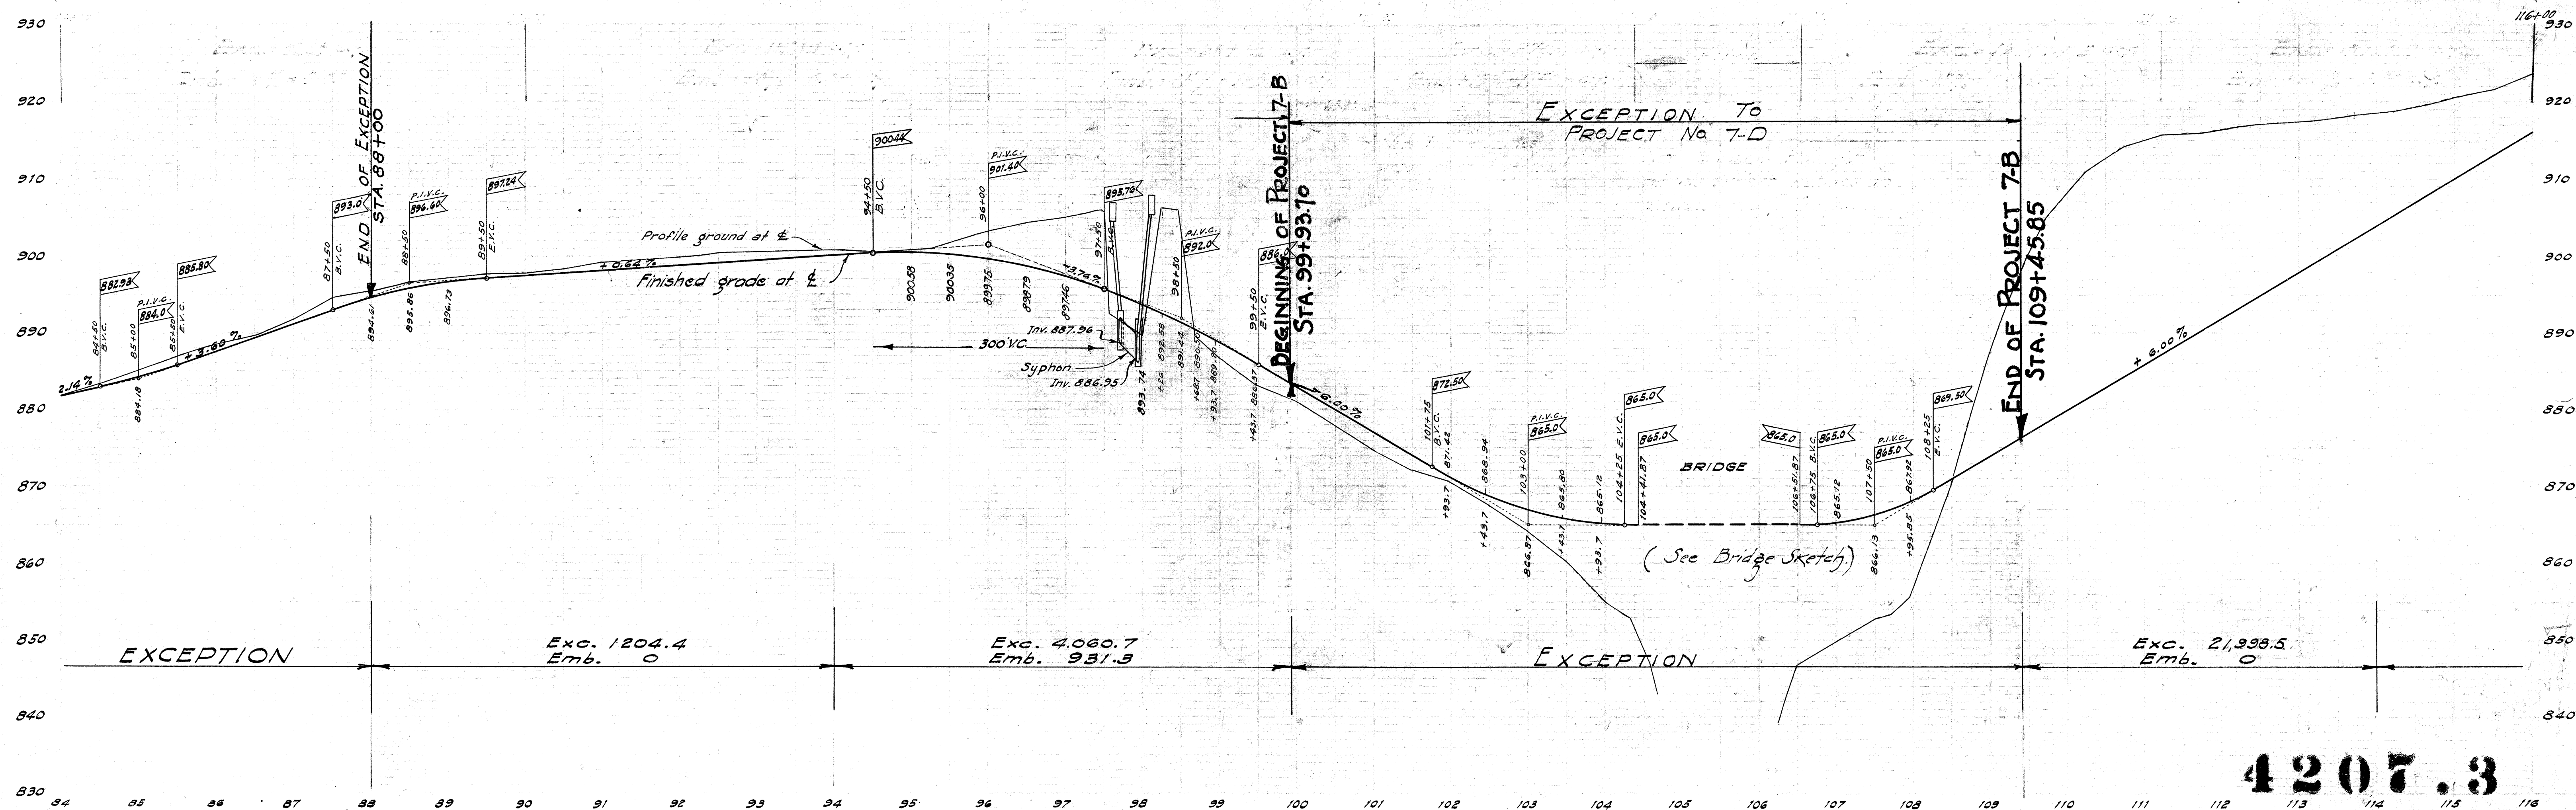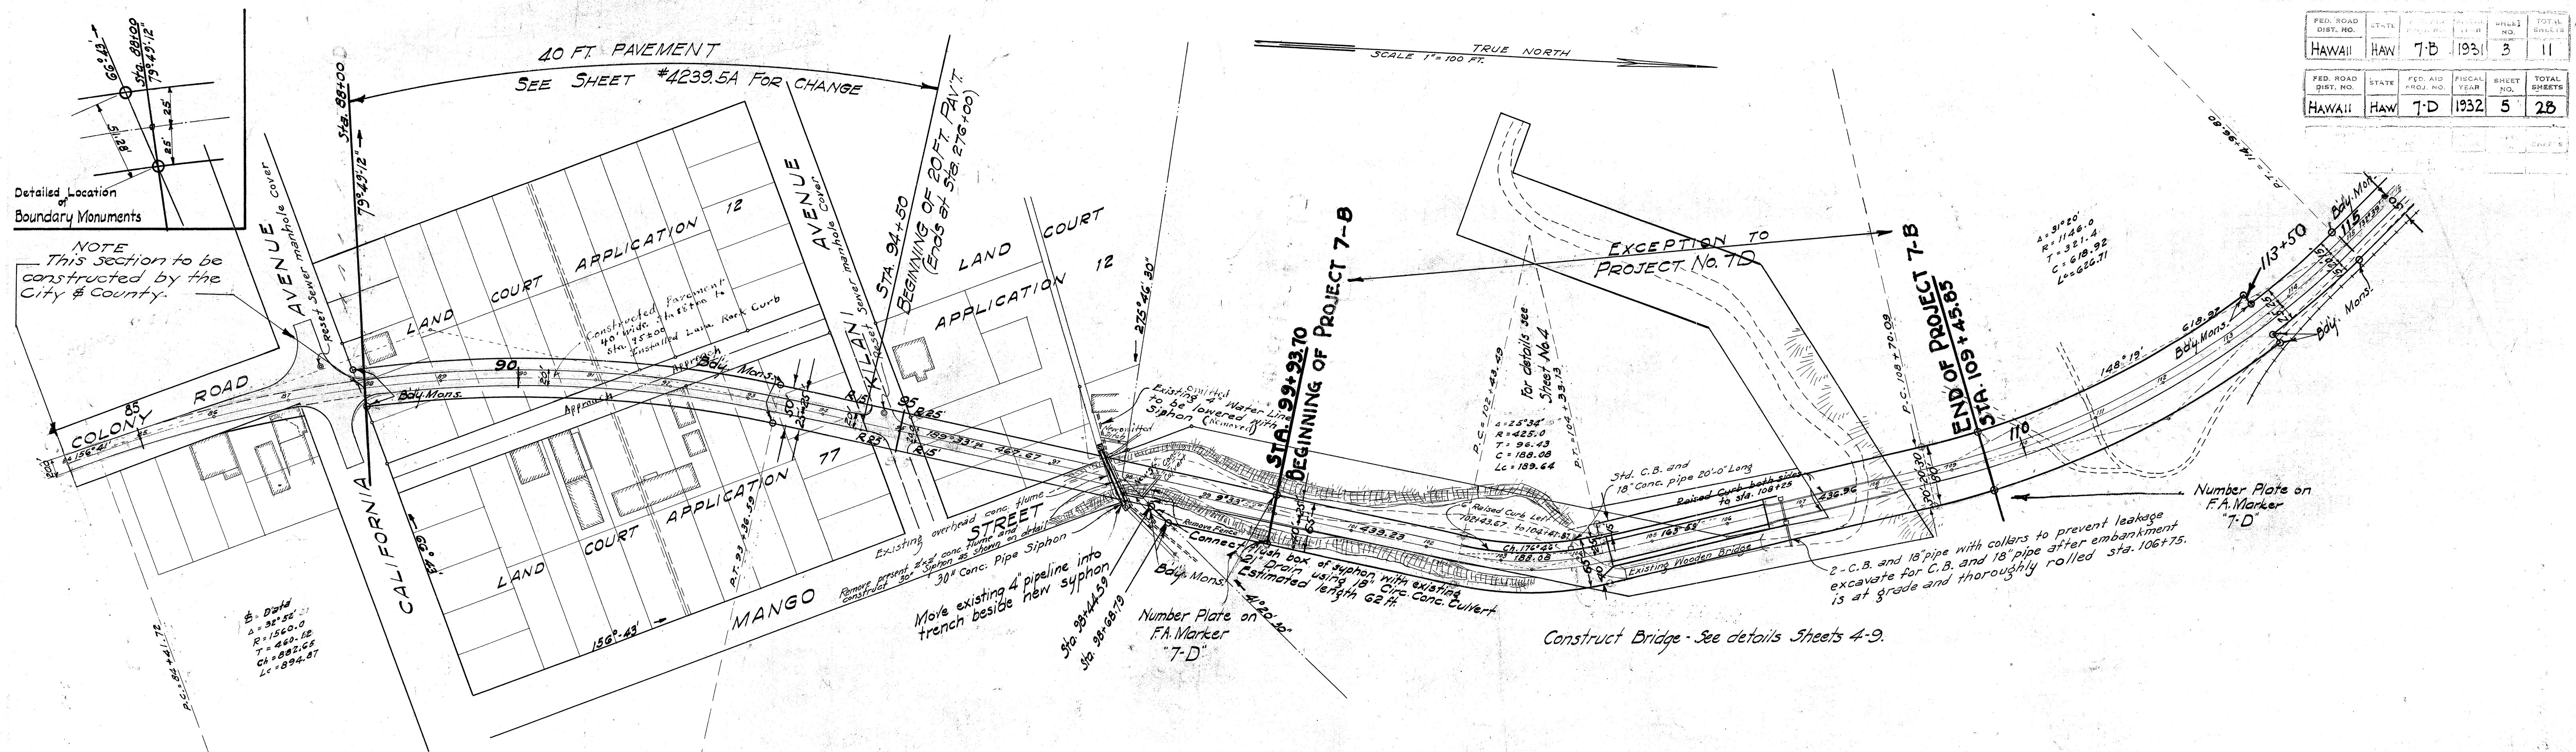

4207.3
113 114 115
4239.5


DD 12-16

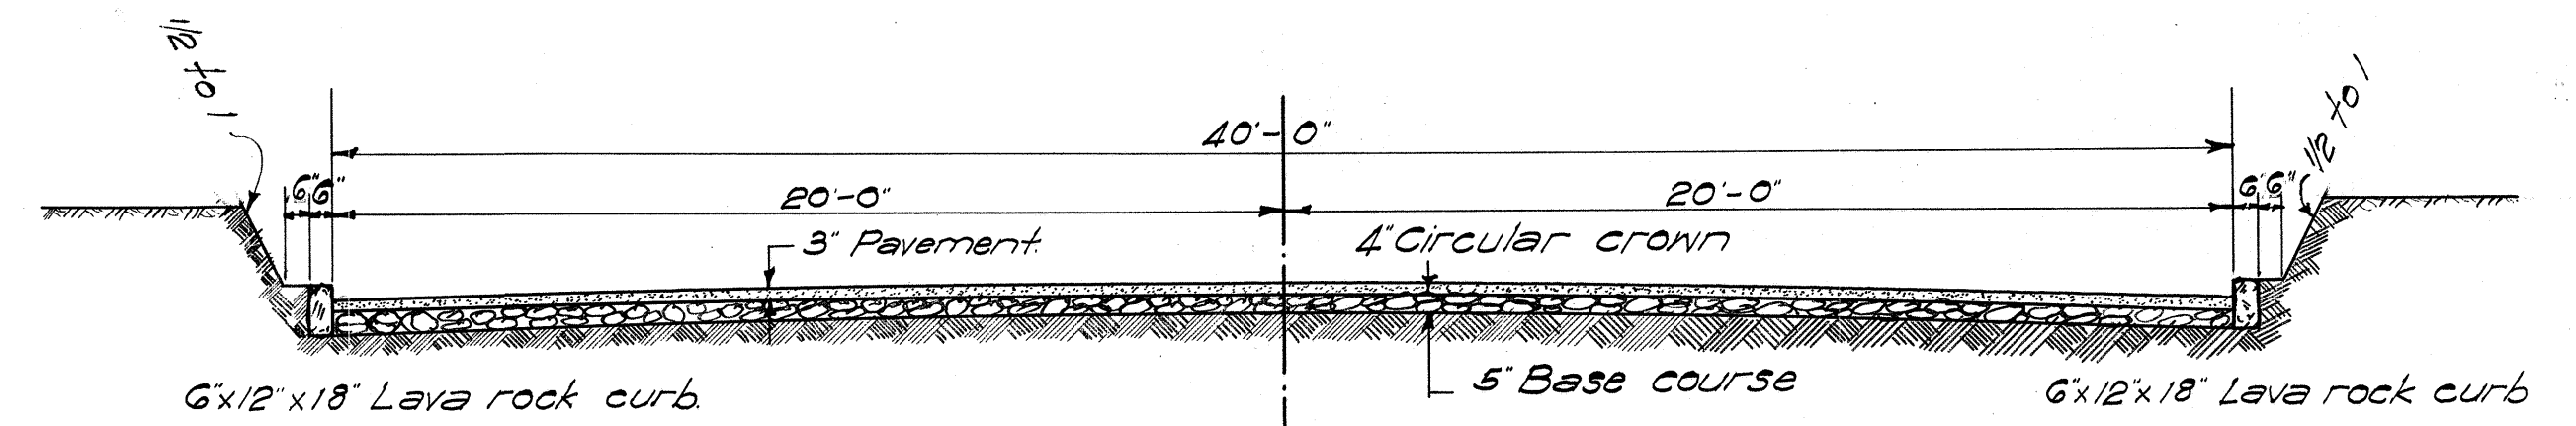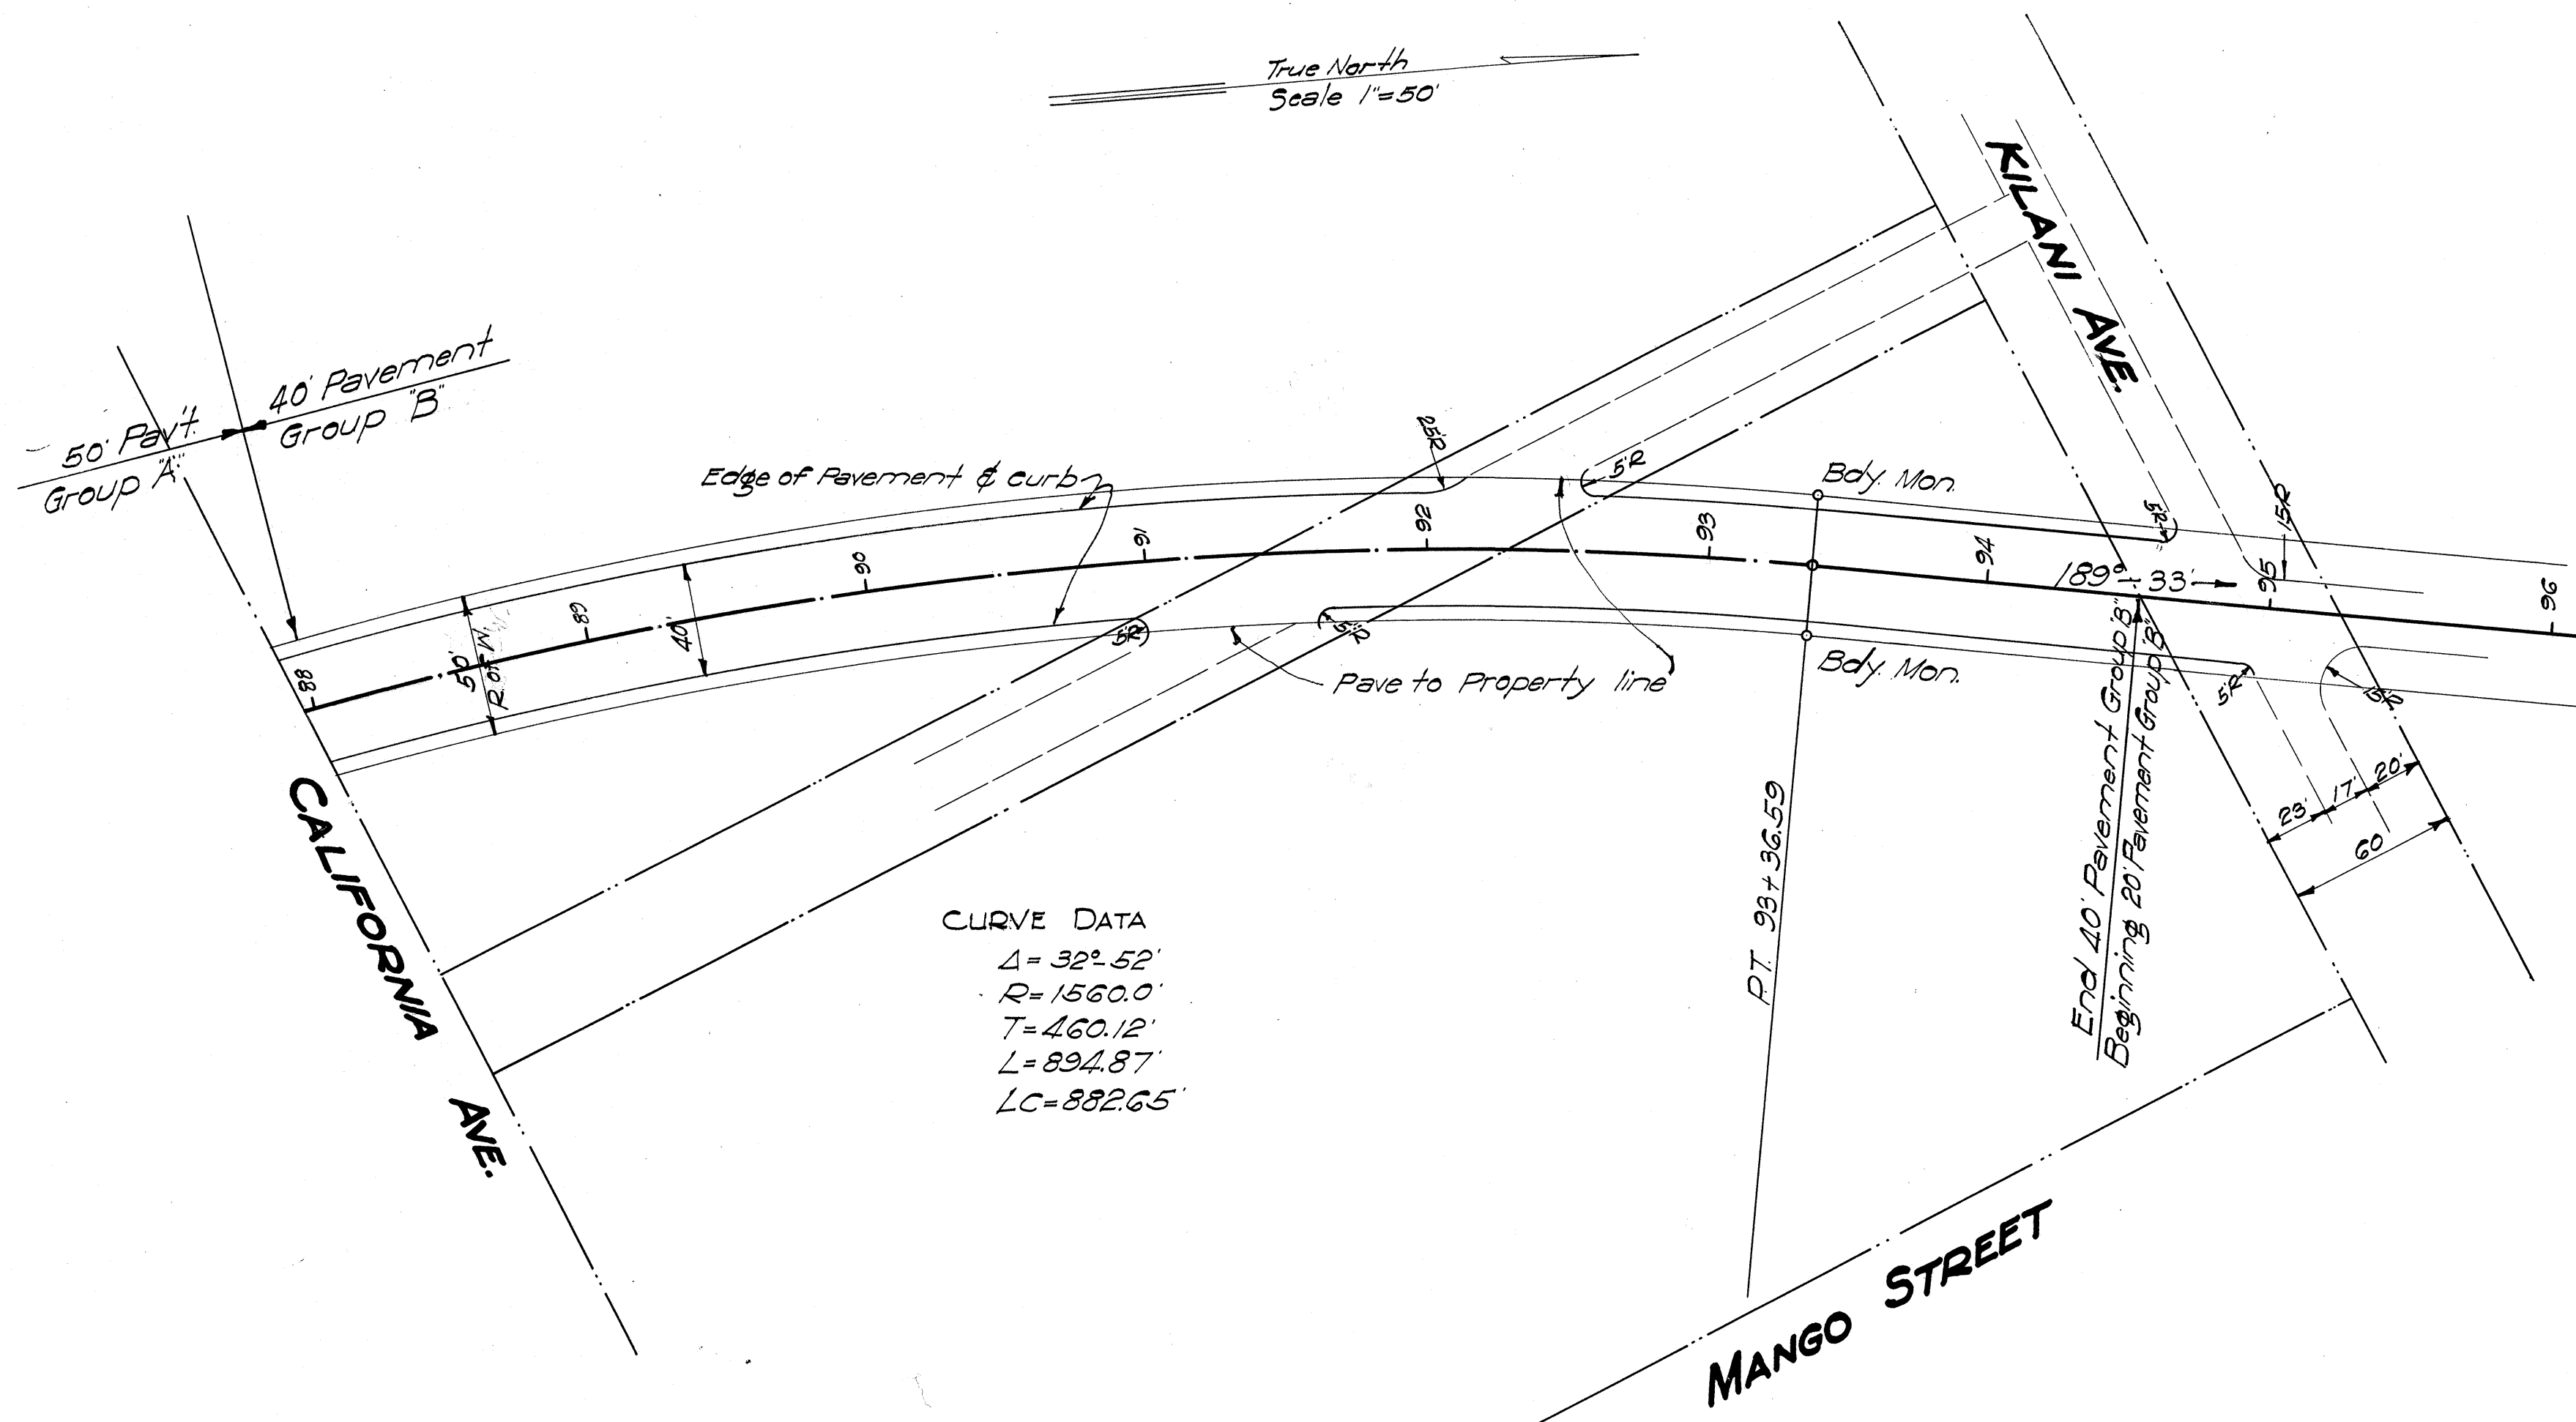



TYPICAL ROAD SECTION FOR PAVEMENT 40 FT. WIDE

Scale 1/4"=1'-0"



Entire 40 Ft. is in cut section. See Sheet #2 for Pavement base course notes.


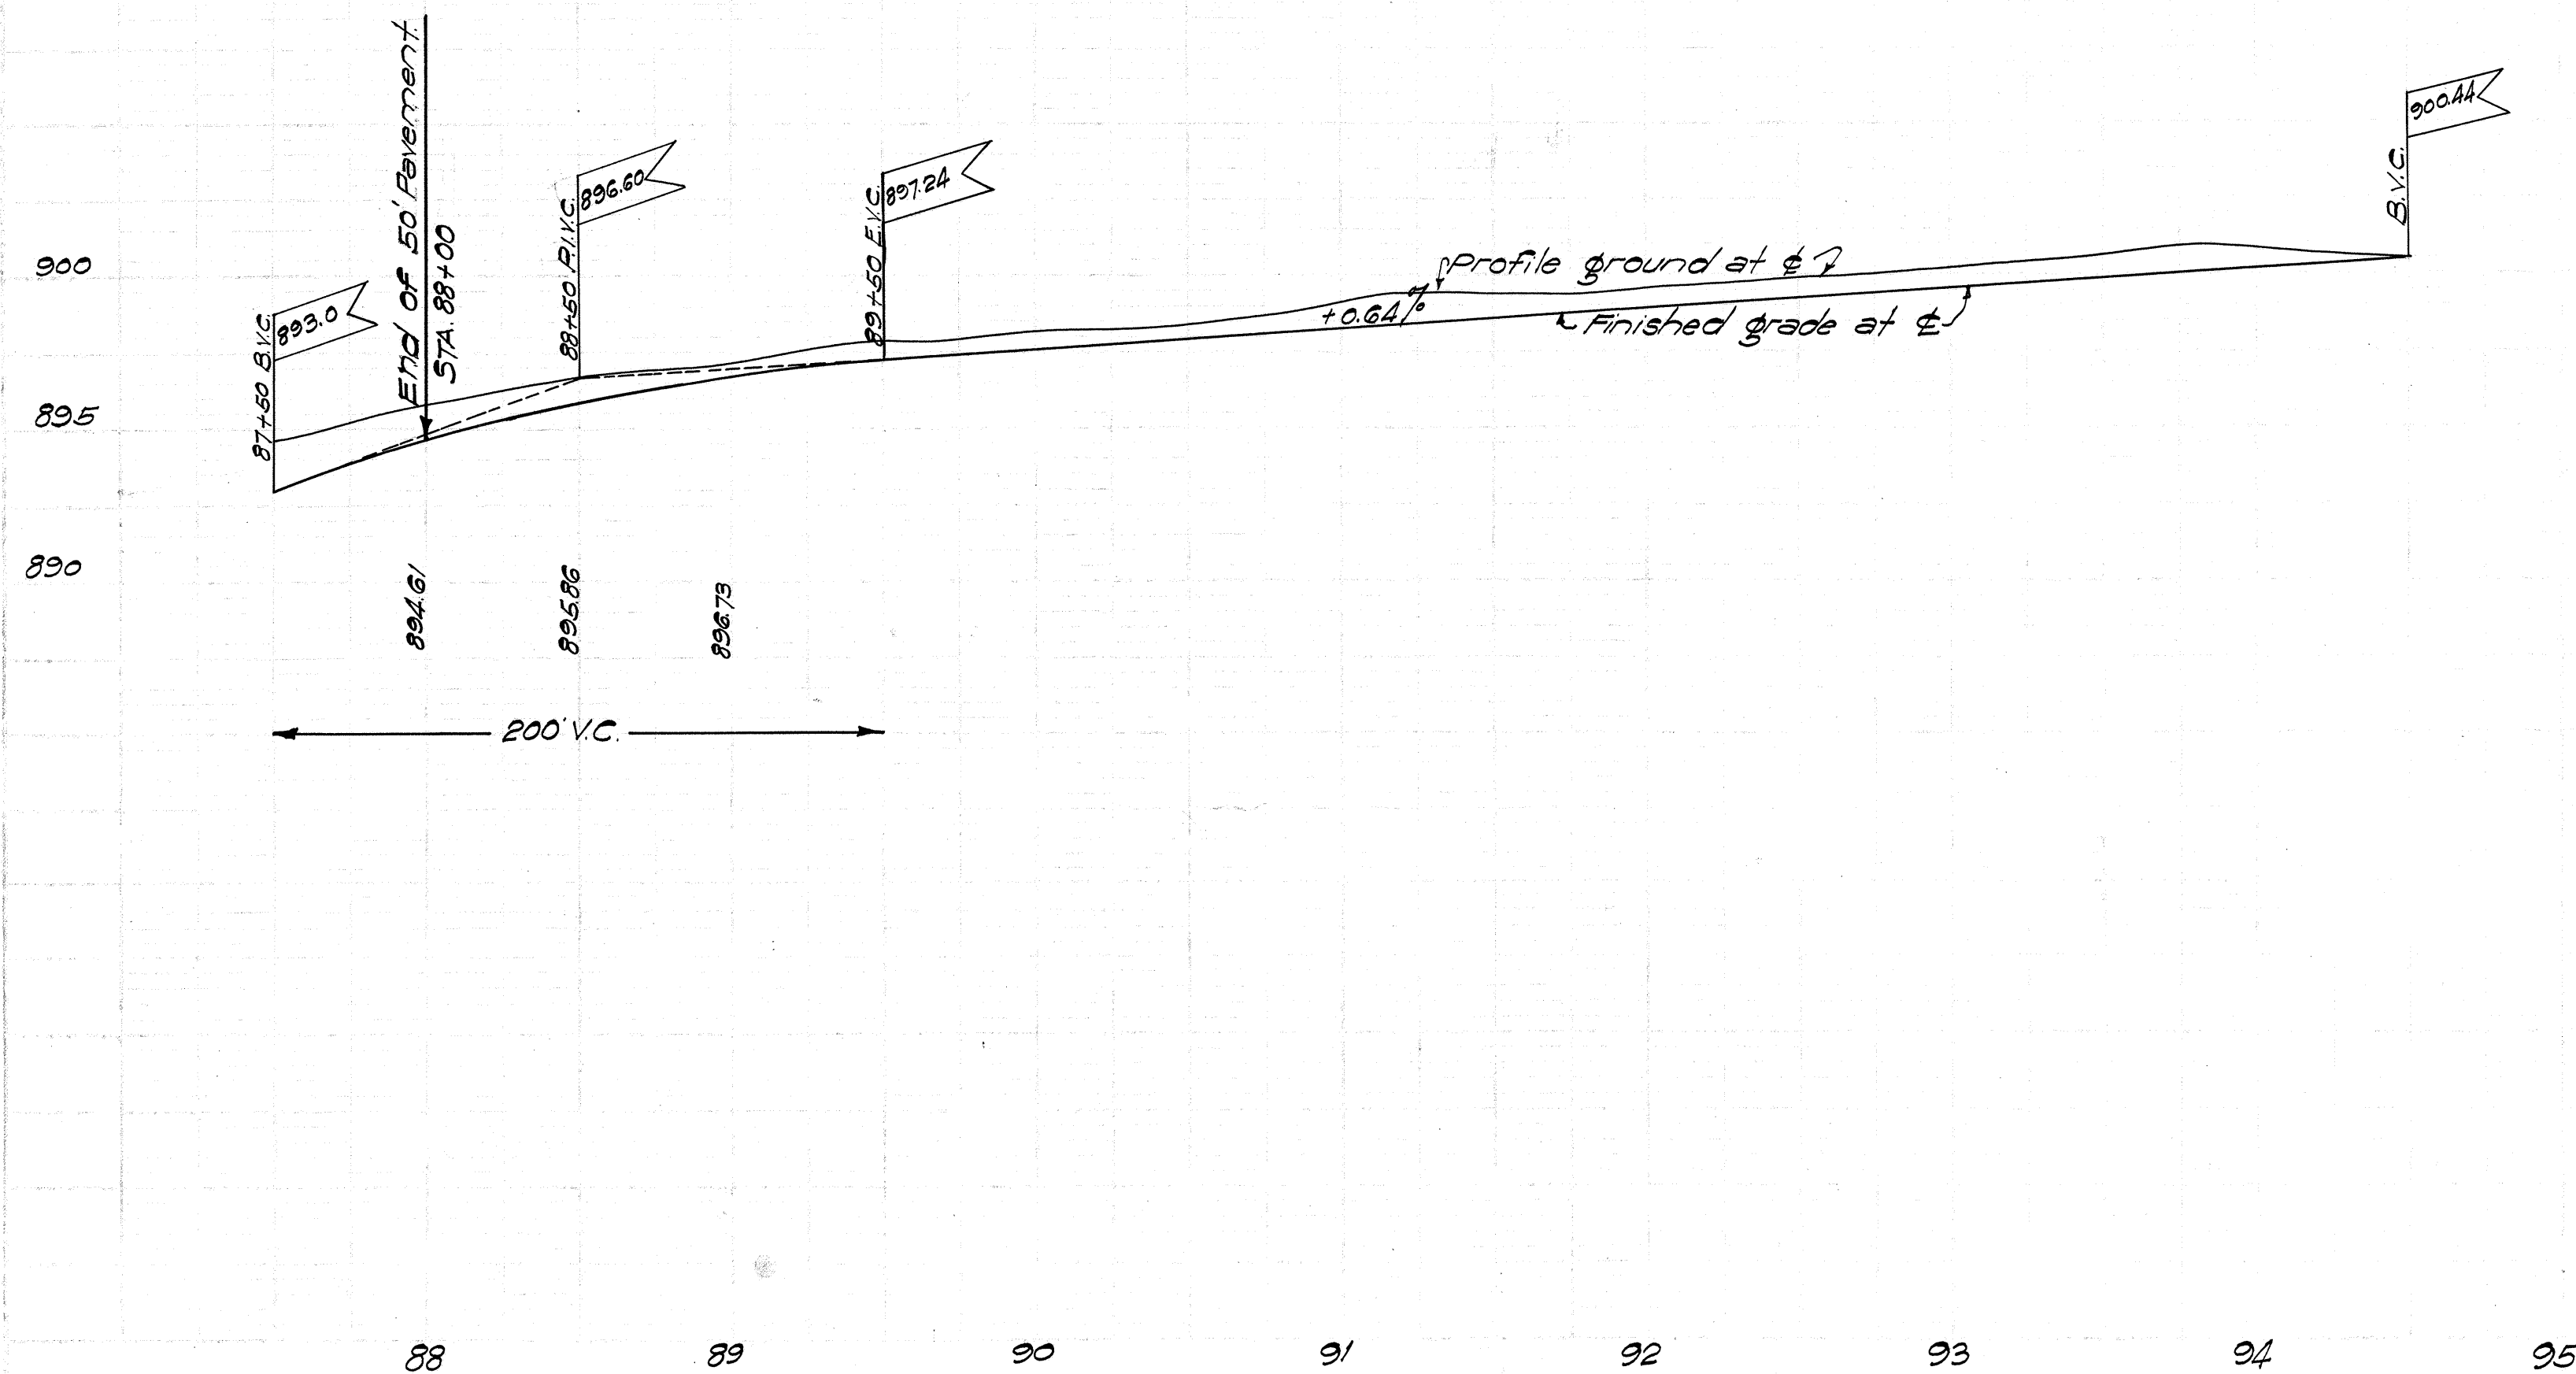


FED. ROAD DIST. NO.	STATE	FED. AID PROJ. NO.	FISCAL YEAR	SHEET NO.	TOTAL SHEETS
HAWAII	HAW	7-D	1932	6	28

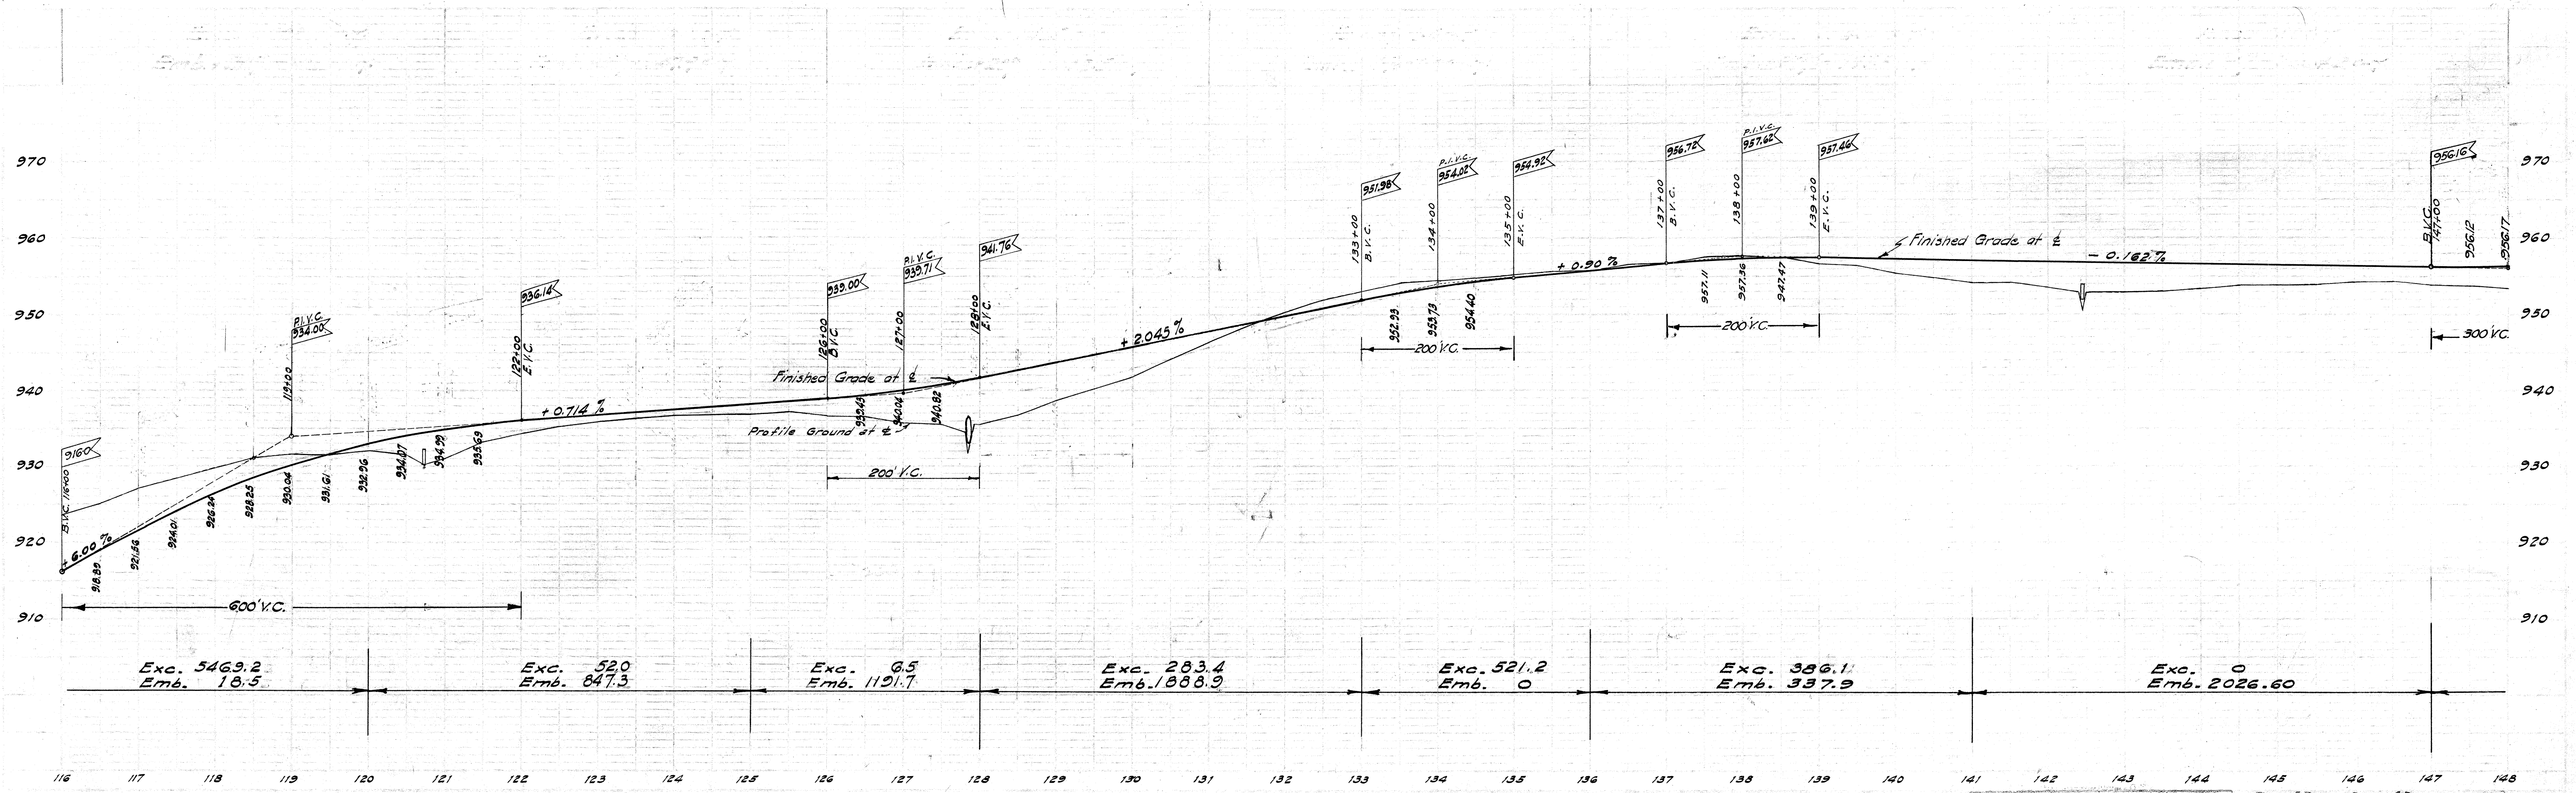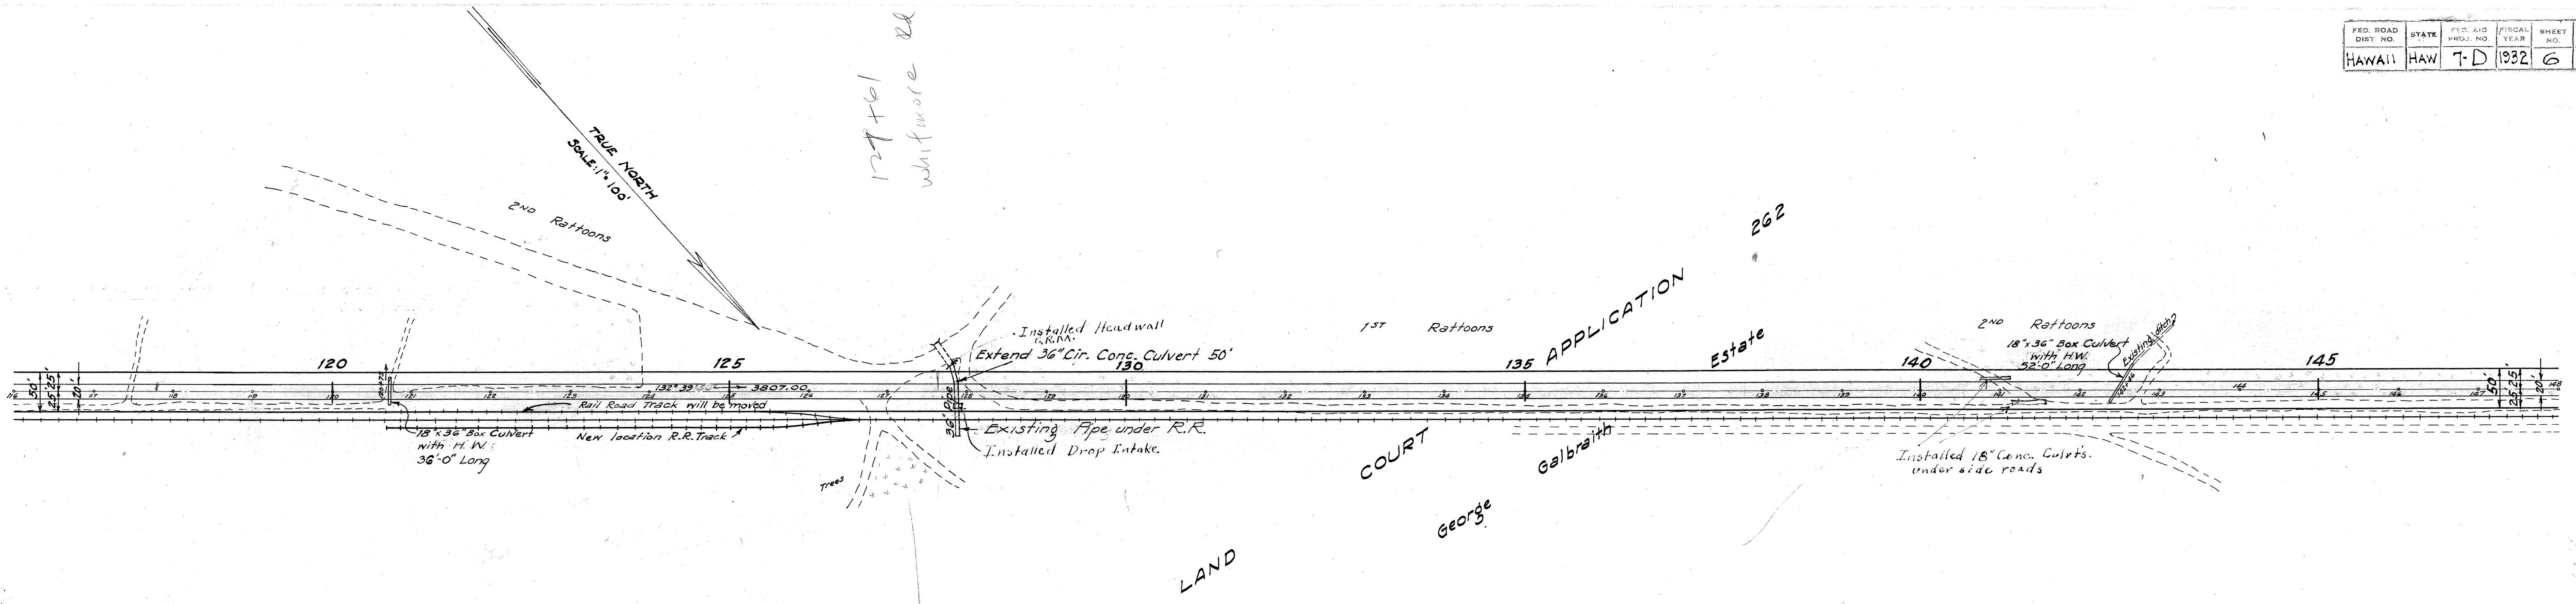

FED. ROAD DIST. NO.	STATE	FED. AID PROJ. NO.	FISCAL YEAR	SHEET NO.	TOTAL SHEETS
HAWAII	HAW	1-D	1932	8	28

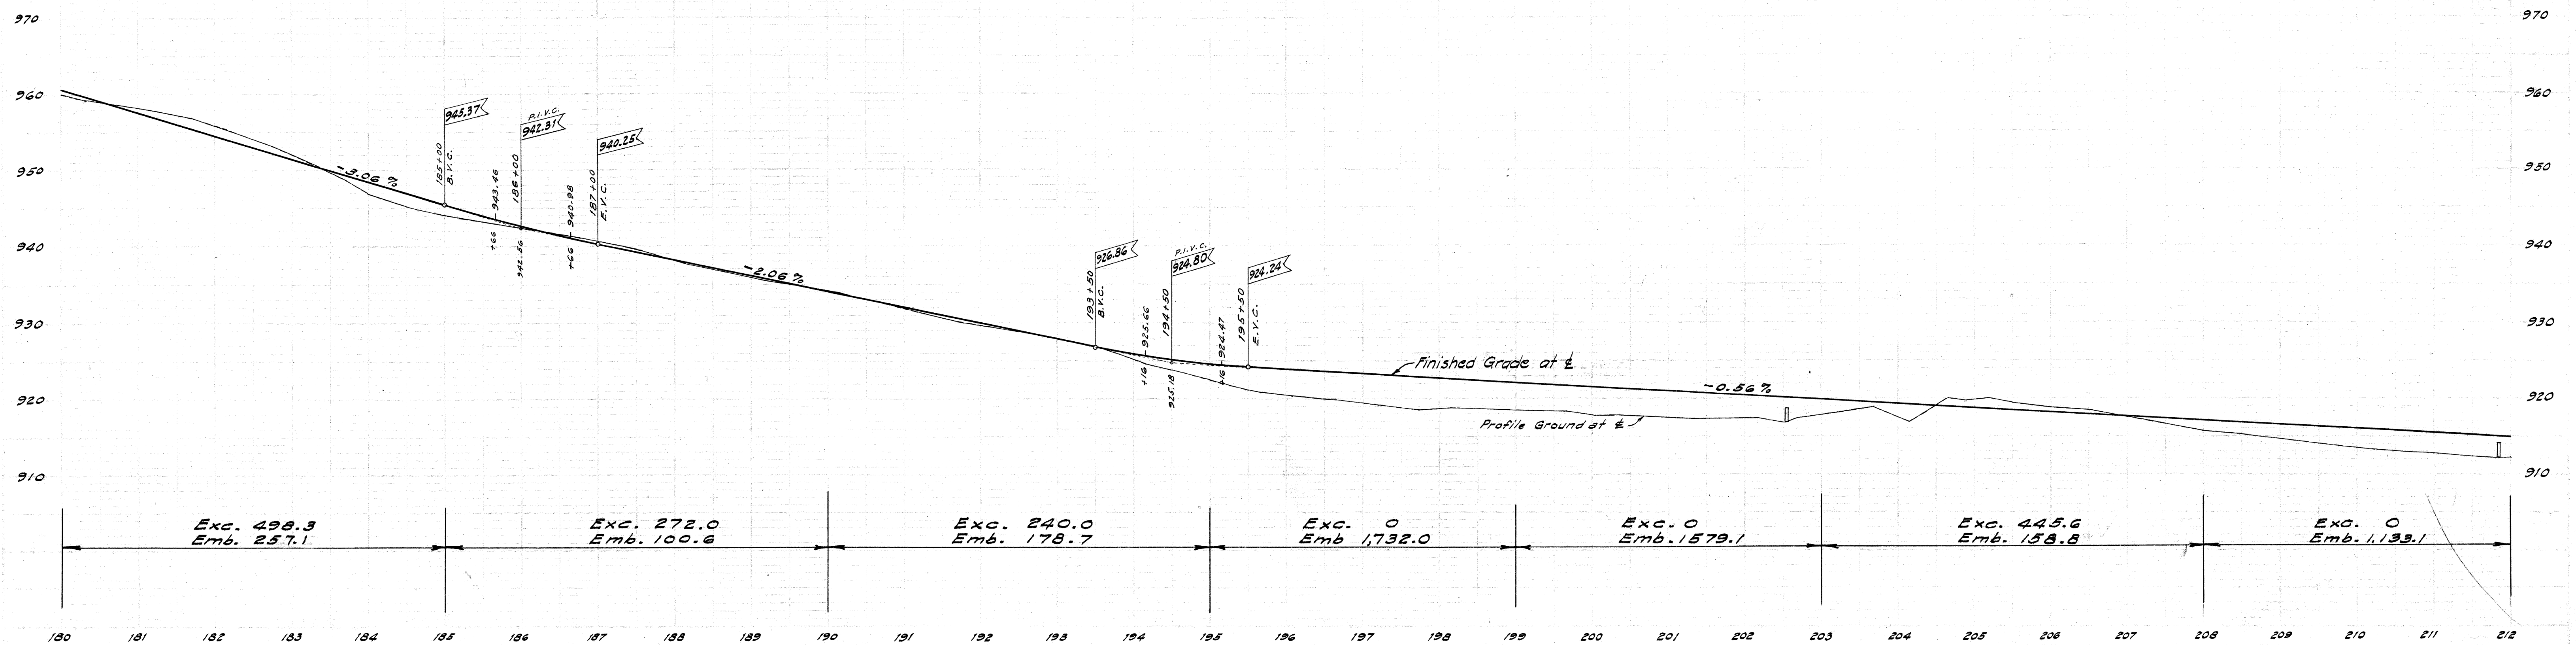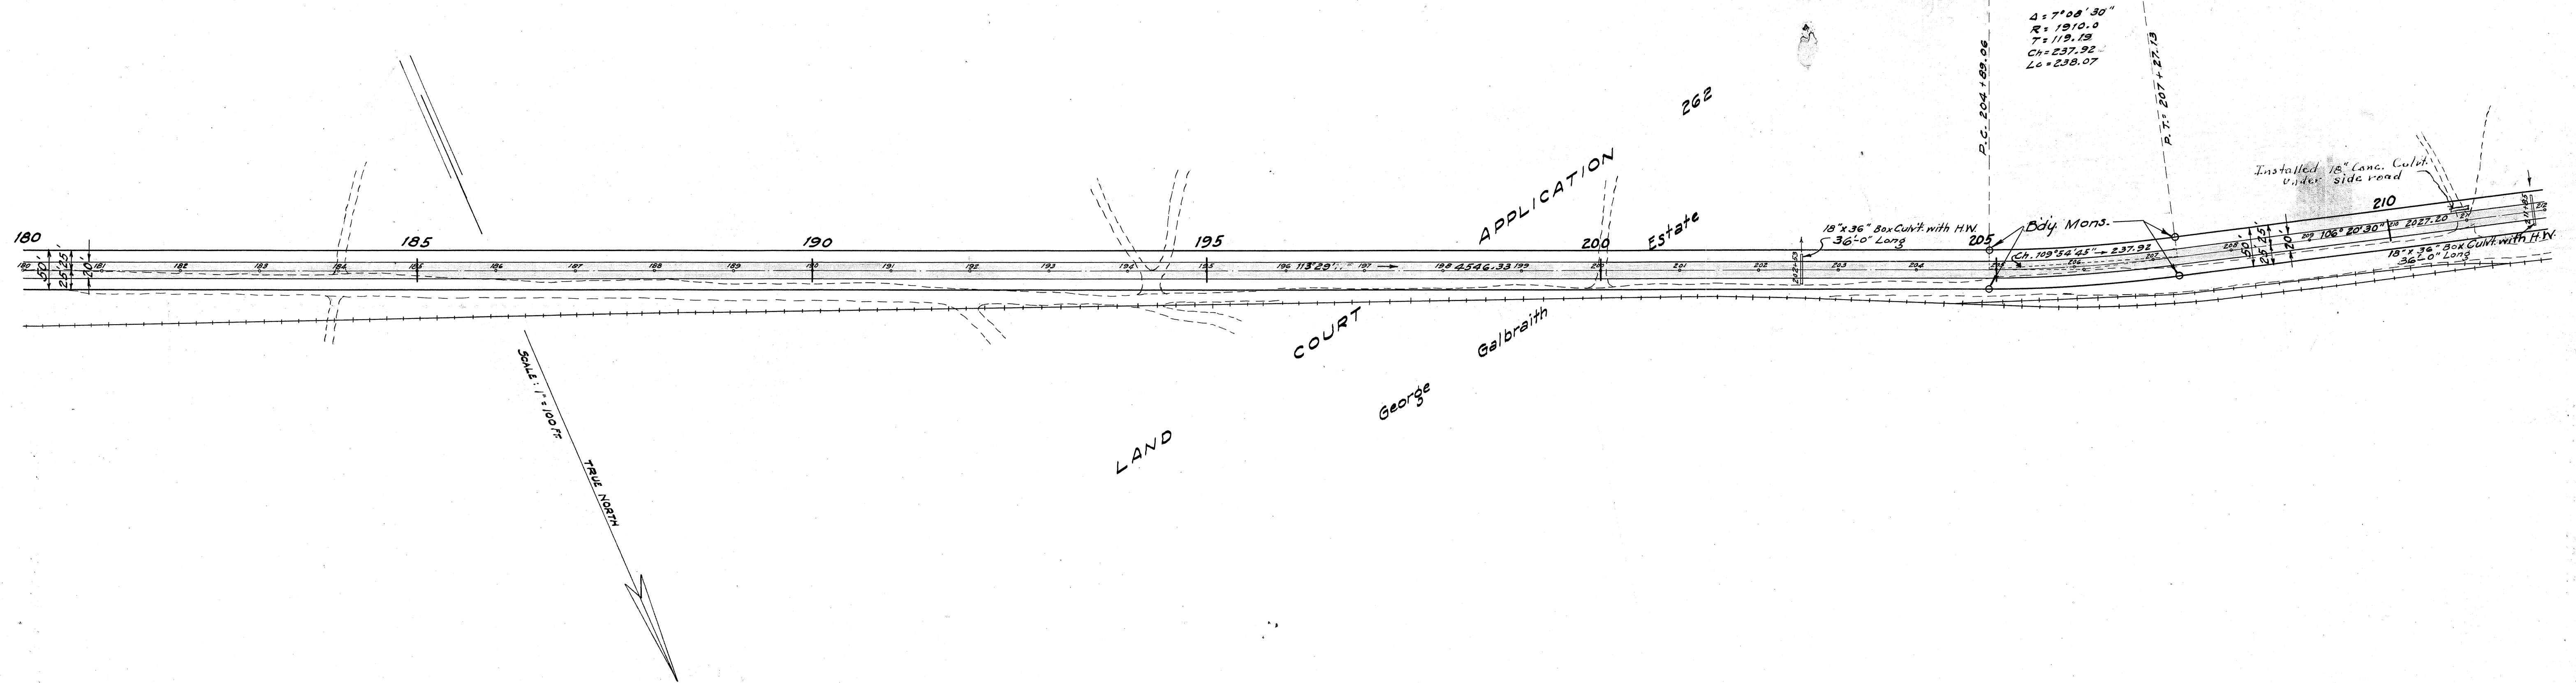

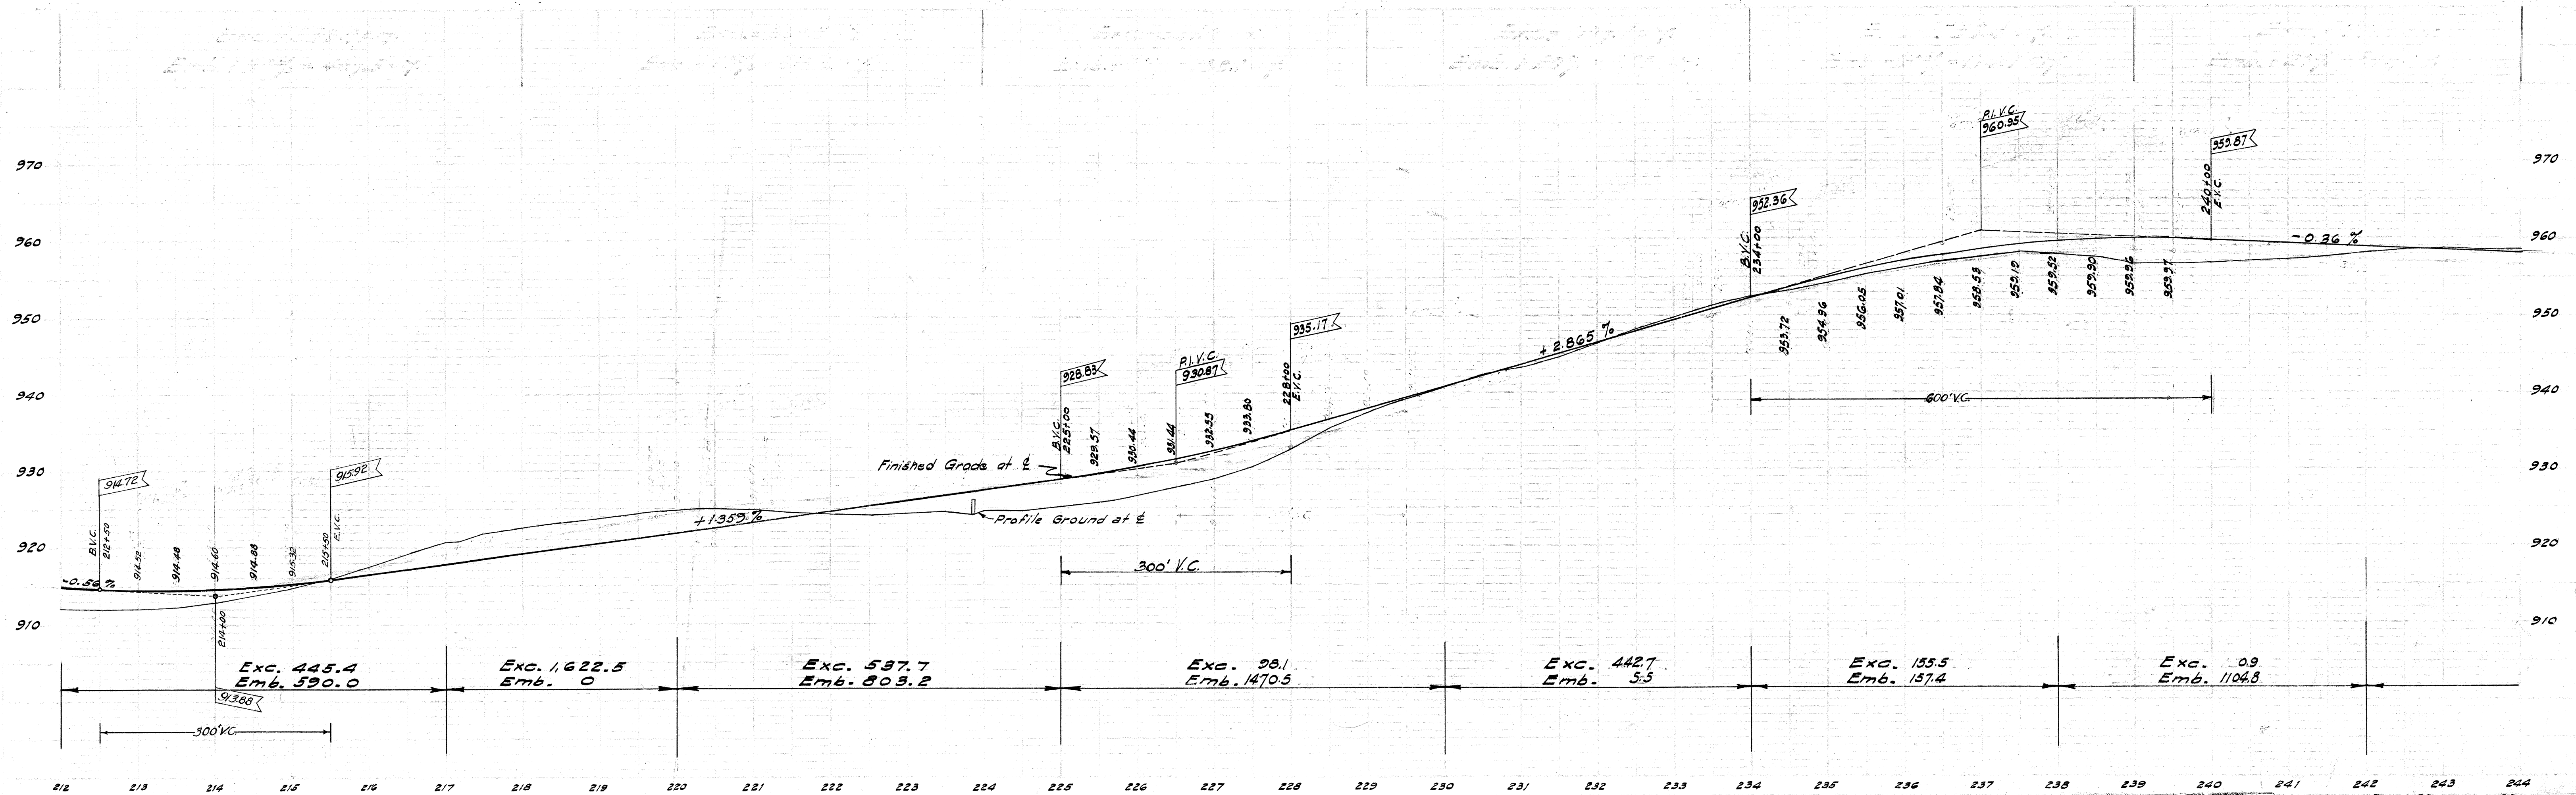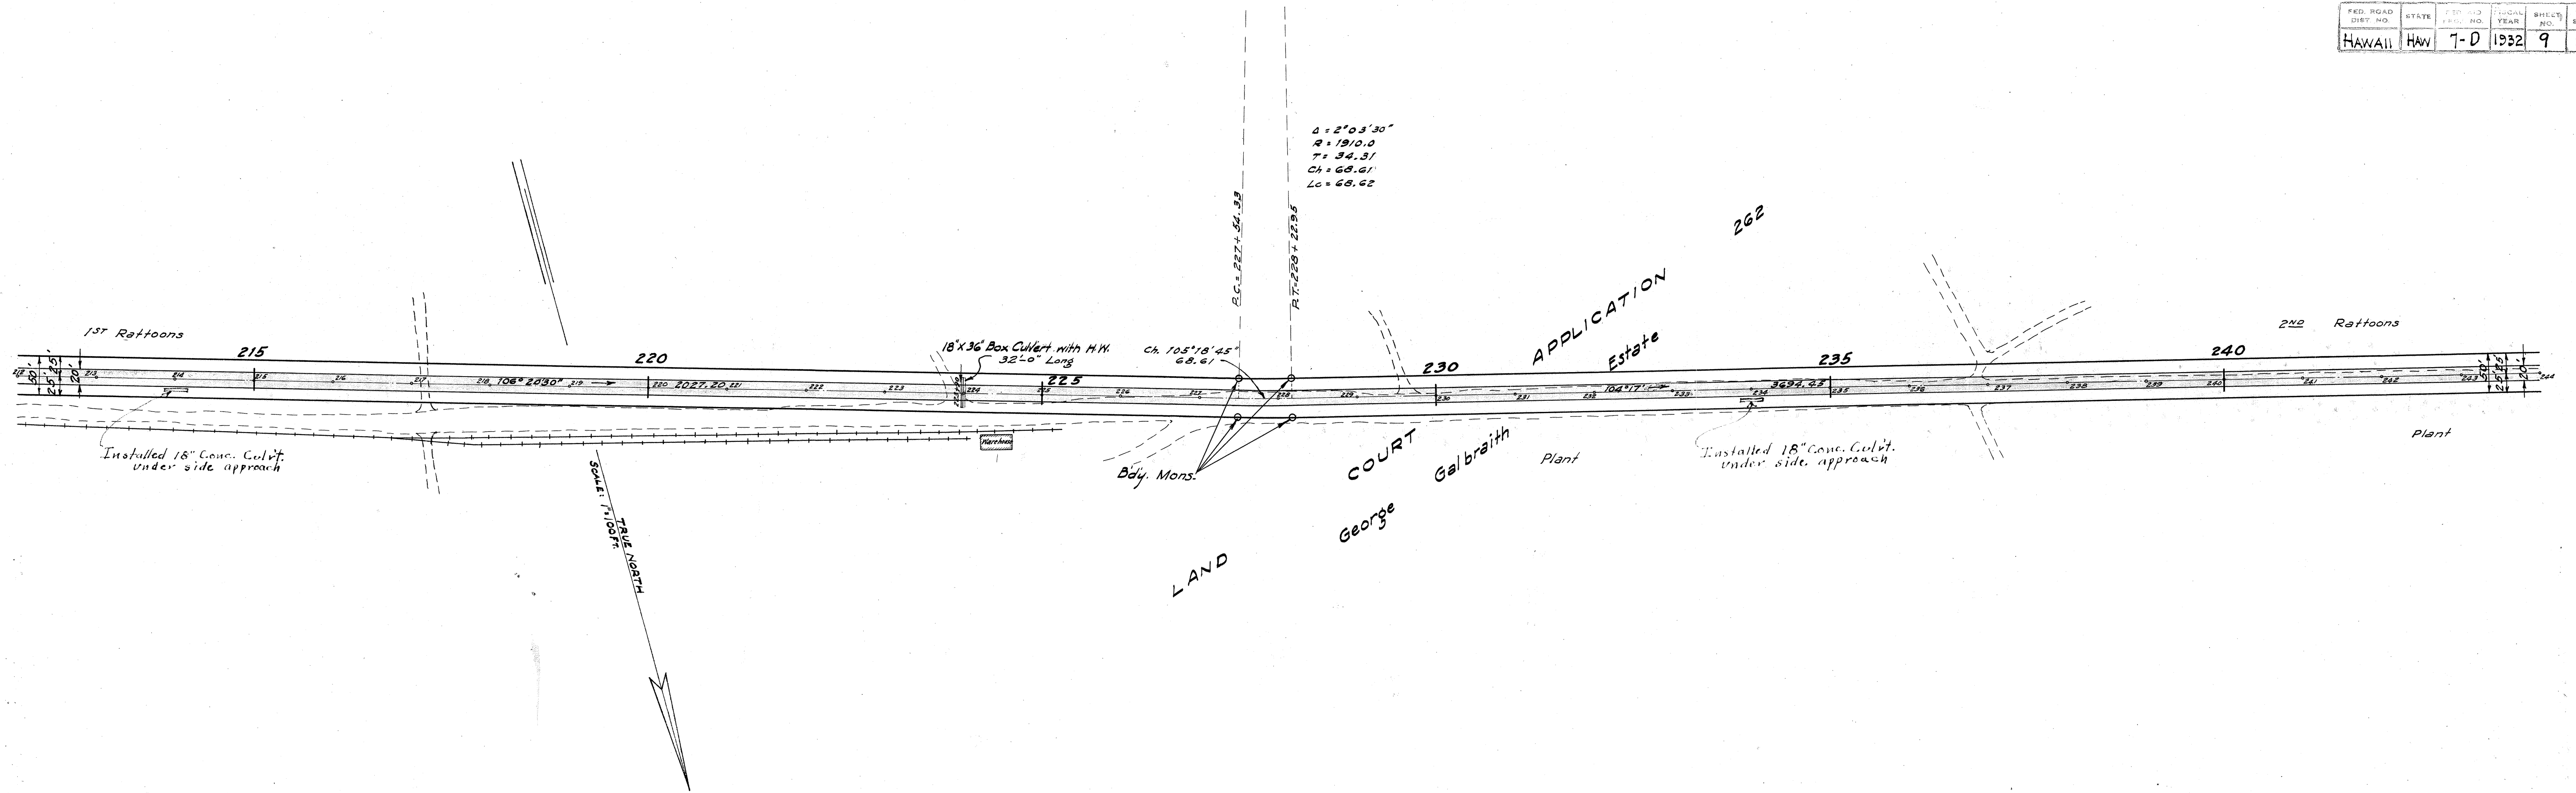

FED. ROAD DIST. NO.	STATE	FED. AID PROJ. NO.	FISCAL YEAR	SHEET NO.	TOTAL SHEETS
HAWAII	HAW	7-D	1932	10	28

