


INDEX TO DRAWINGS	
SHEET NO.	DESCRIPTIONS
1	Title Sheet
2	Typical Road Section & Details
3-10	Plan & Profile
11	Detail 30" Syphon
12-13	Standard Details
14-28	Road Cross Sections

TERRITORY OF HAWAII
TERRITORIAL HIGHWAY DEPARTMENT
HONOLULU T.H.


PLANS OF
KAMEHAMEHA HIGHWAY
FEDERAL AID PROJECT NO. 7 D
WAHIAWA DISTRICT
OAHU T.H.

 
SCALE			
PLAN		1 INCH =	100 FEET 200
PROFILE	HORIZONTAL	1 INCH =	100 FEET
	VERTICAL	1 INCH =	10 FEET
CROSS SECTION	HORIZONTAL	1 INCH =	5 FEET
	VERTICAL	1 INCH =	5 FEET

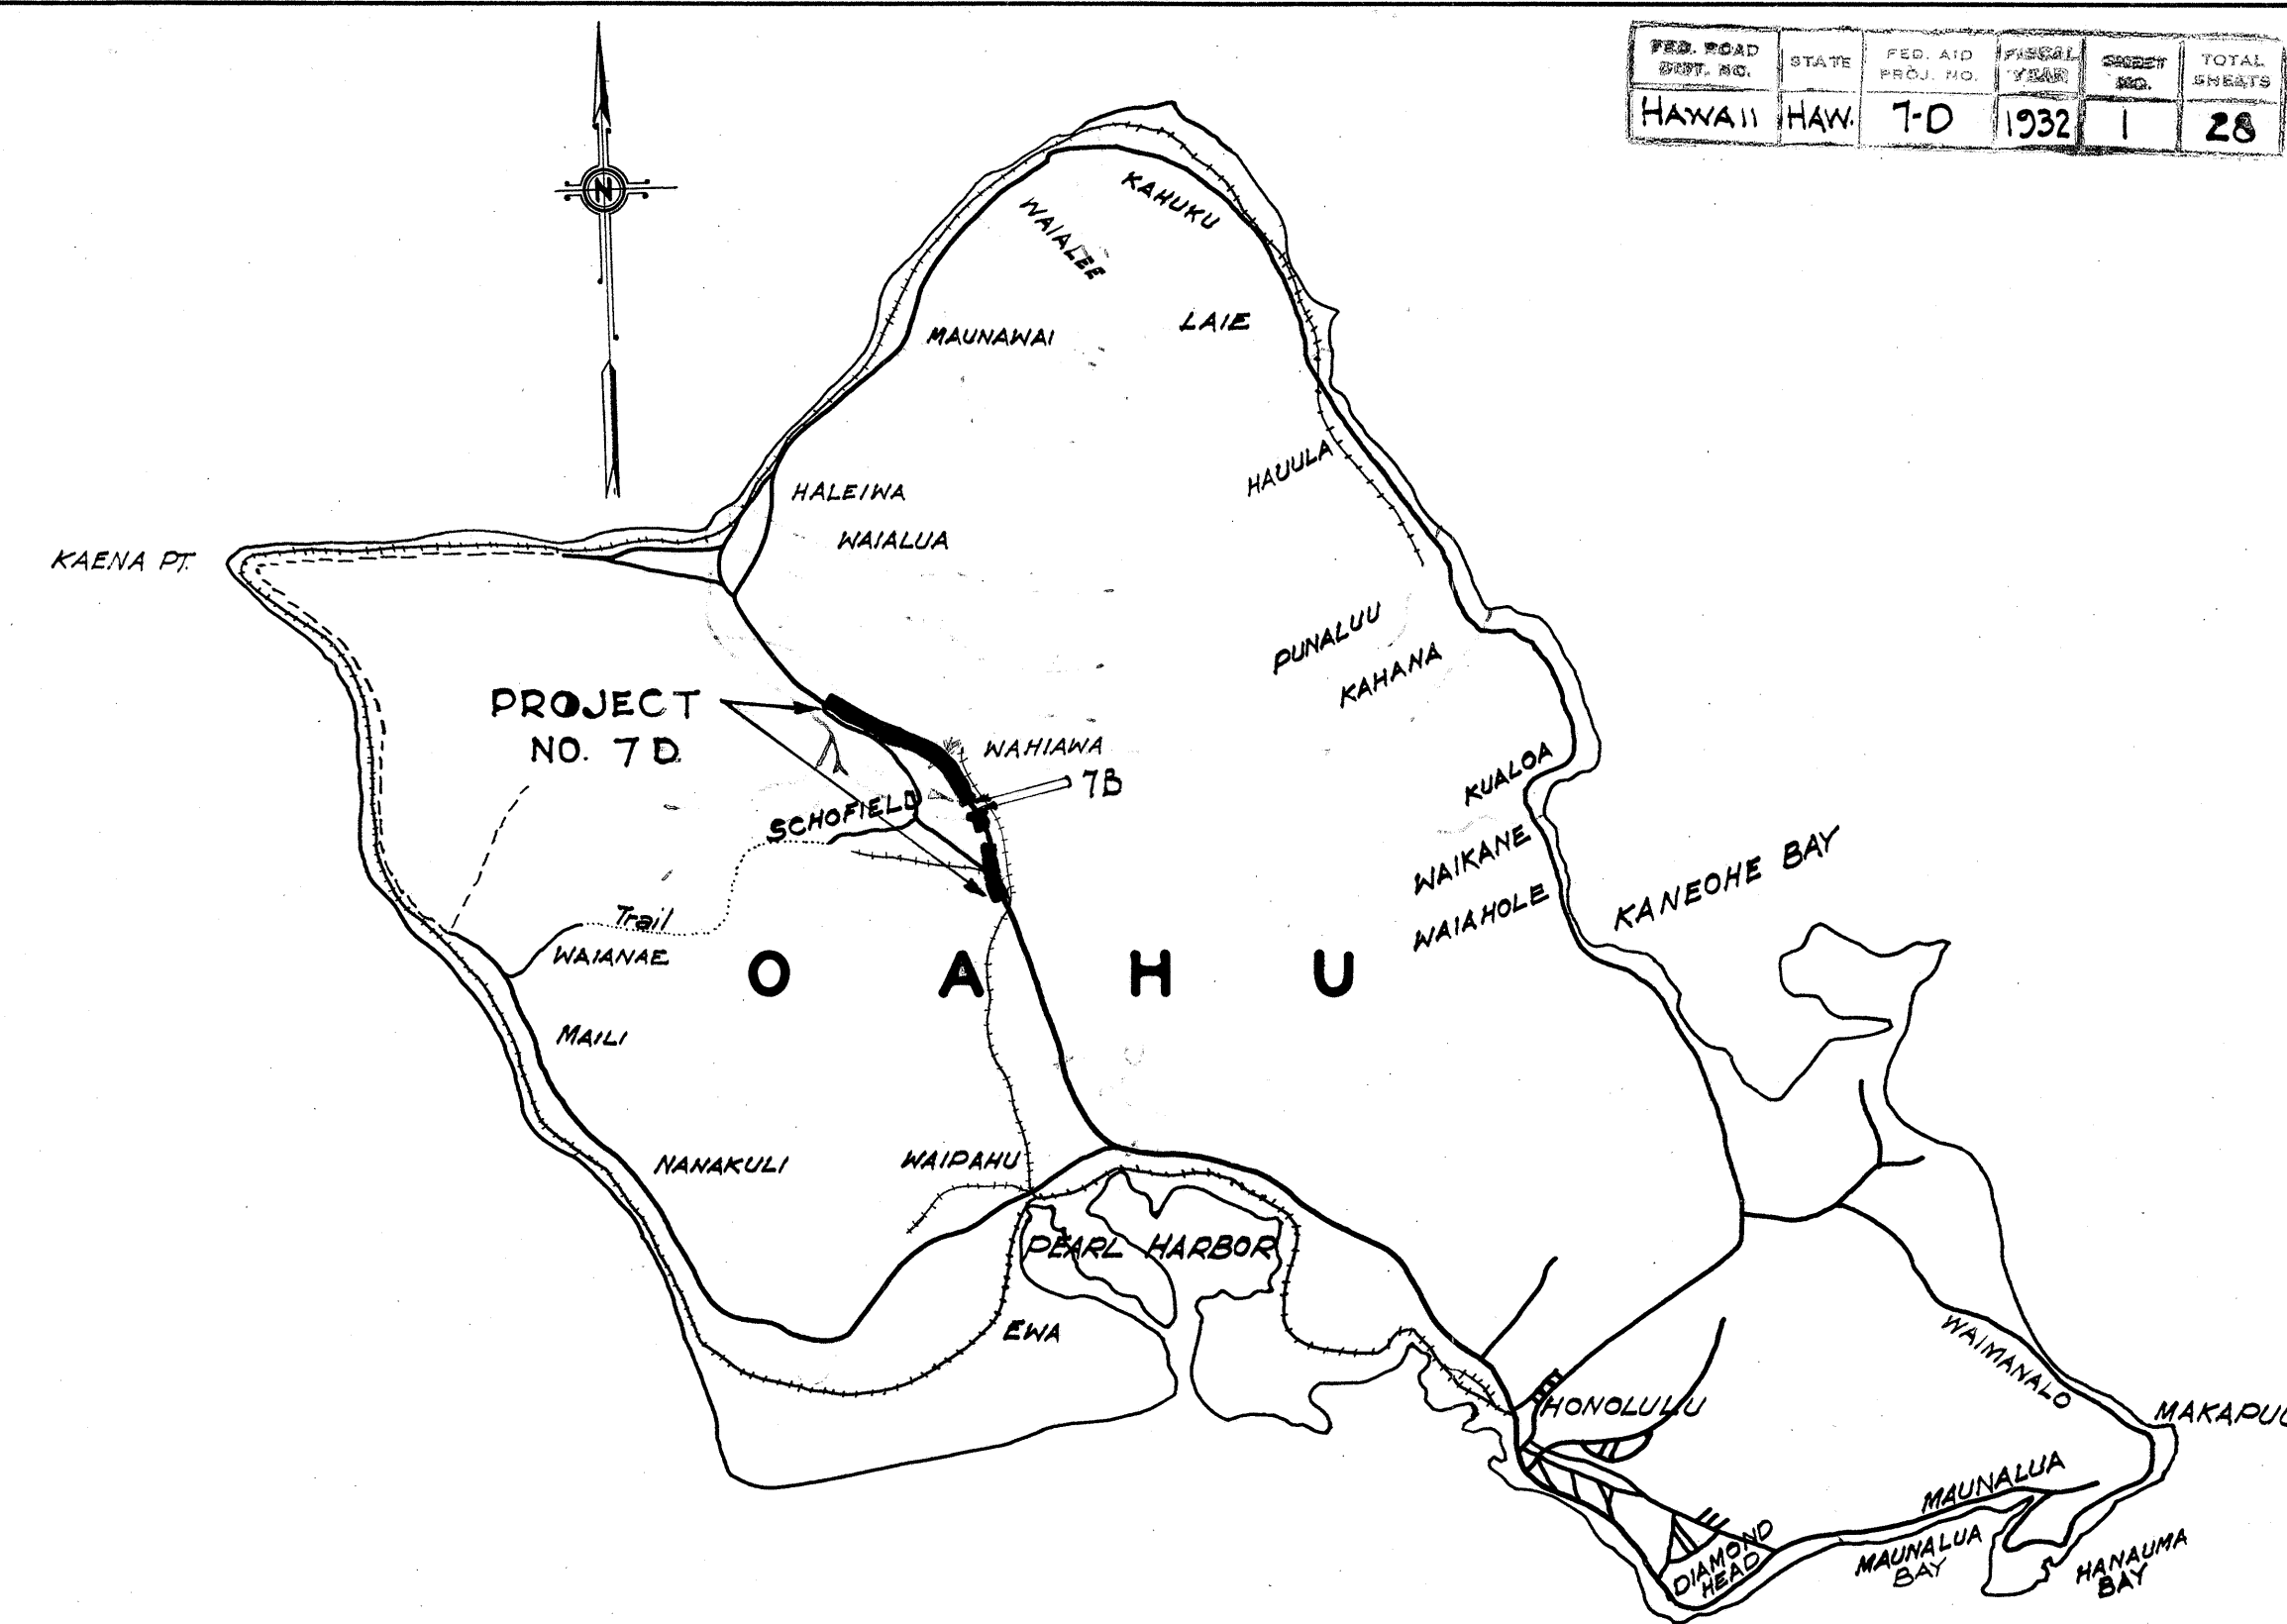

NOTE:

Group A is to be built with \$880,000 Fund
Group B is to be built with Terr. Fund & Federal Aid

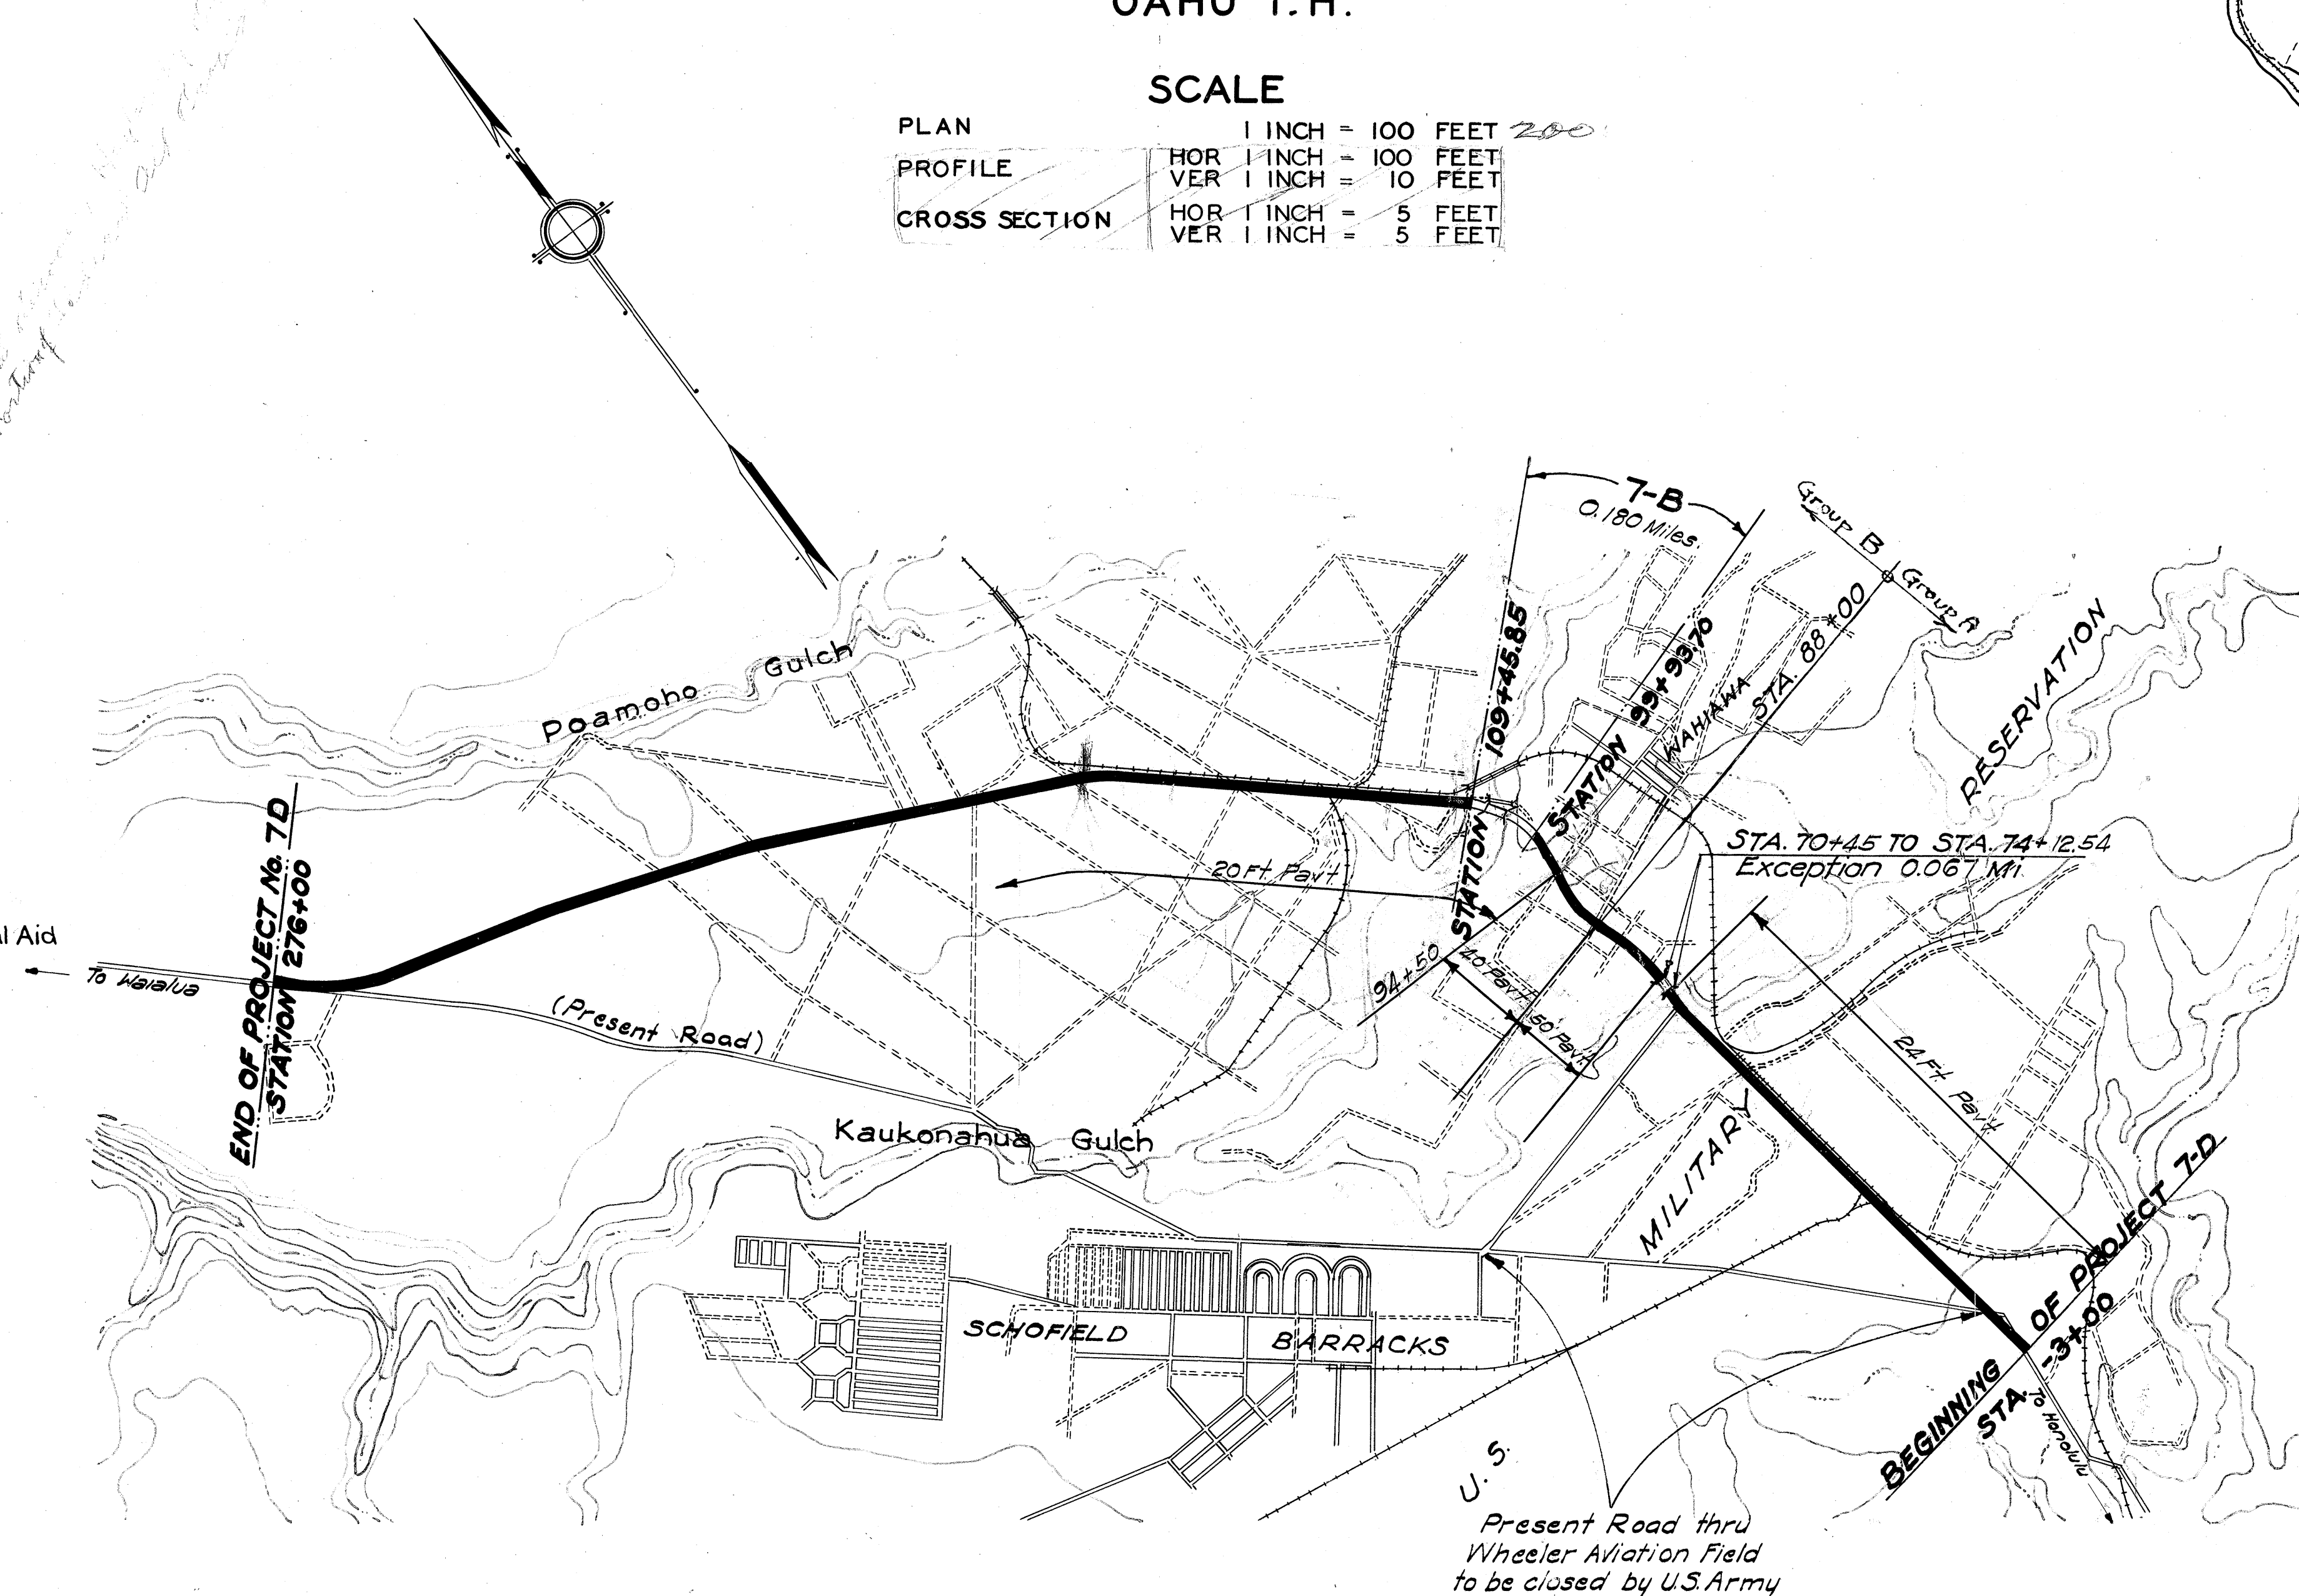

CONVENTIONAL SIGNS	
EXISTING	TO BE CONSTRUCTED
 ROAD WAY	 RIGHT OF WAY & PAVEMENT
 BRIDGE	 BRIDGE
 RAIL ROAD	 CATCH BASIN & DRAIN
 FENCE	 DRAIN WITH HEADWALL
 DRAINS	 STD. MONUMENT
 BUILDINGS	

LAYOUT OF PROJECT

SCALE 1 INCH = 1667 FT.

	GROSS	EXCEPTION	NET
GROUP "A"	1.721 Miles	0.067 Miles	1.654 Miles
GROUP "B"	3.560 "	0.180 "	3.380 "
ENTIRE PROJECT	5.281 "	0.247 "	5.034 "

All elevation are from U.S.G.S. datum 00 = mean tide.
Face of all poles shall be at least 11'-0" from edge of pavement
Any pole moves shall be made by their respective owners.

RECOMMENDED FOR APPROVAL
 2-20-38

 PRINCIPAL HIGHWAY ENGINEER
 Bureau of Public Roads

RECOMMENDED FOR APPROVAL

CHIEF ENGINEER Bureau of Public Roads

APPROVED

DIRECTOR Bureau of Public Roads

APPROVED

Leysman H. Bigelow.

2/15/32

TERRITORIAL HIGHWAY ENGINEER