

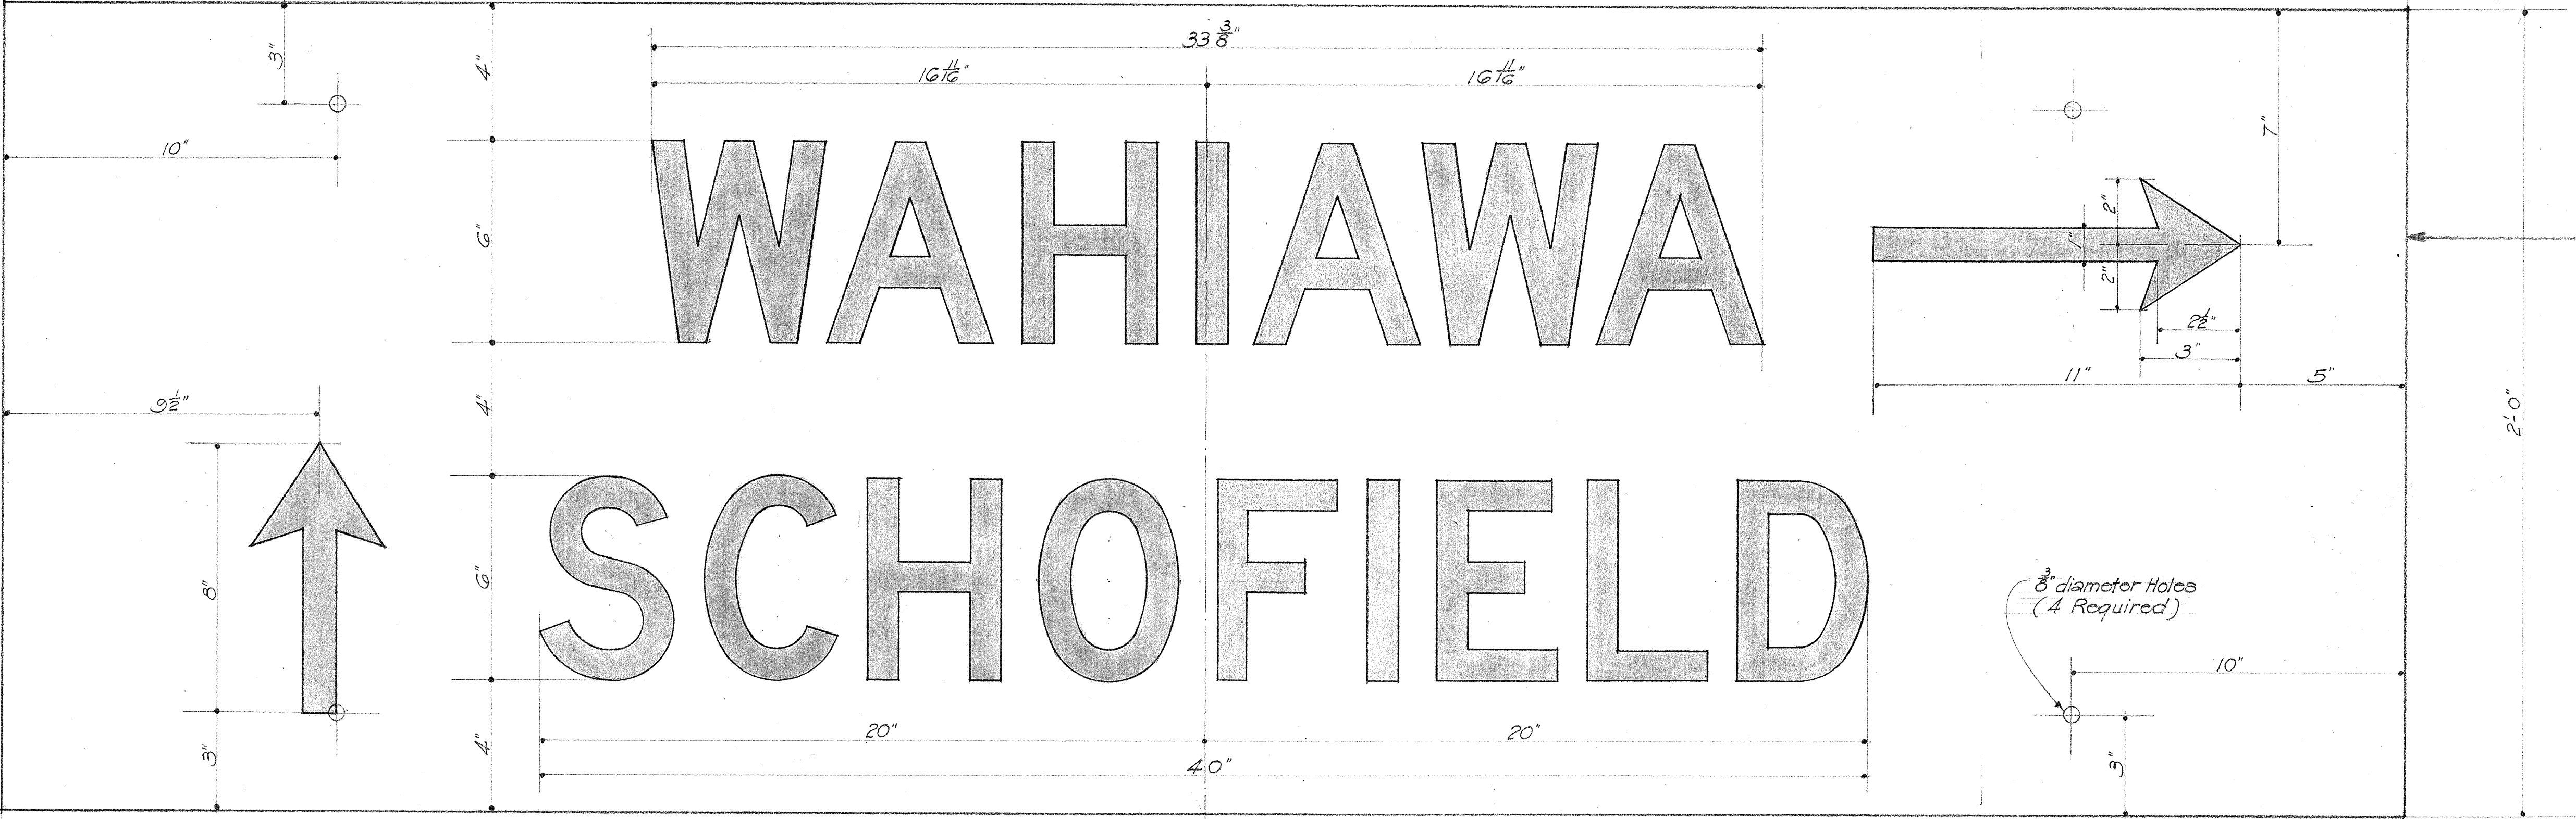


FED. ROAD DIST. NO.	STATE	FED. AID PROJ. NO.	FISCAL YEAR	SHEET NO.	TOTAL SHEETS
HAWAII	HAW.	DA-WR 8 (3)	1947	33	134

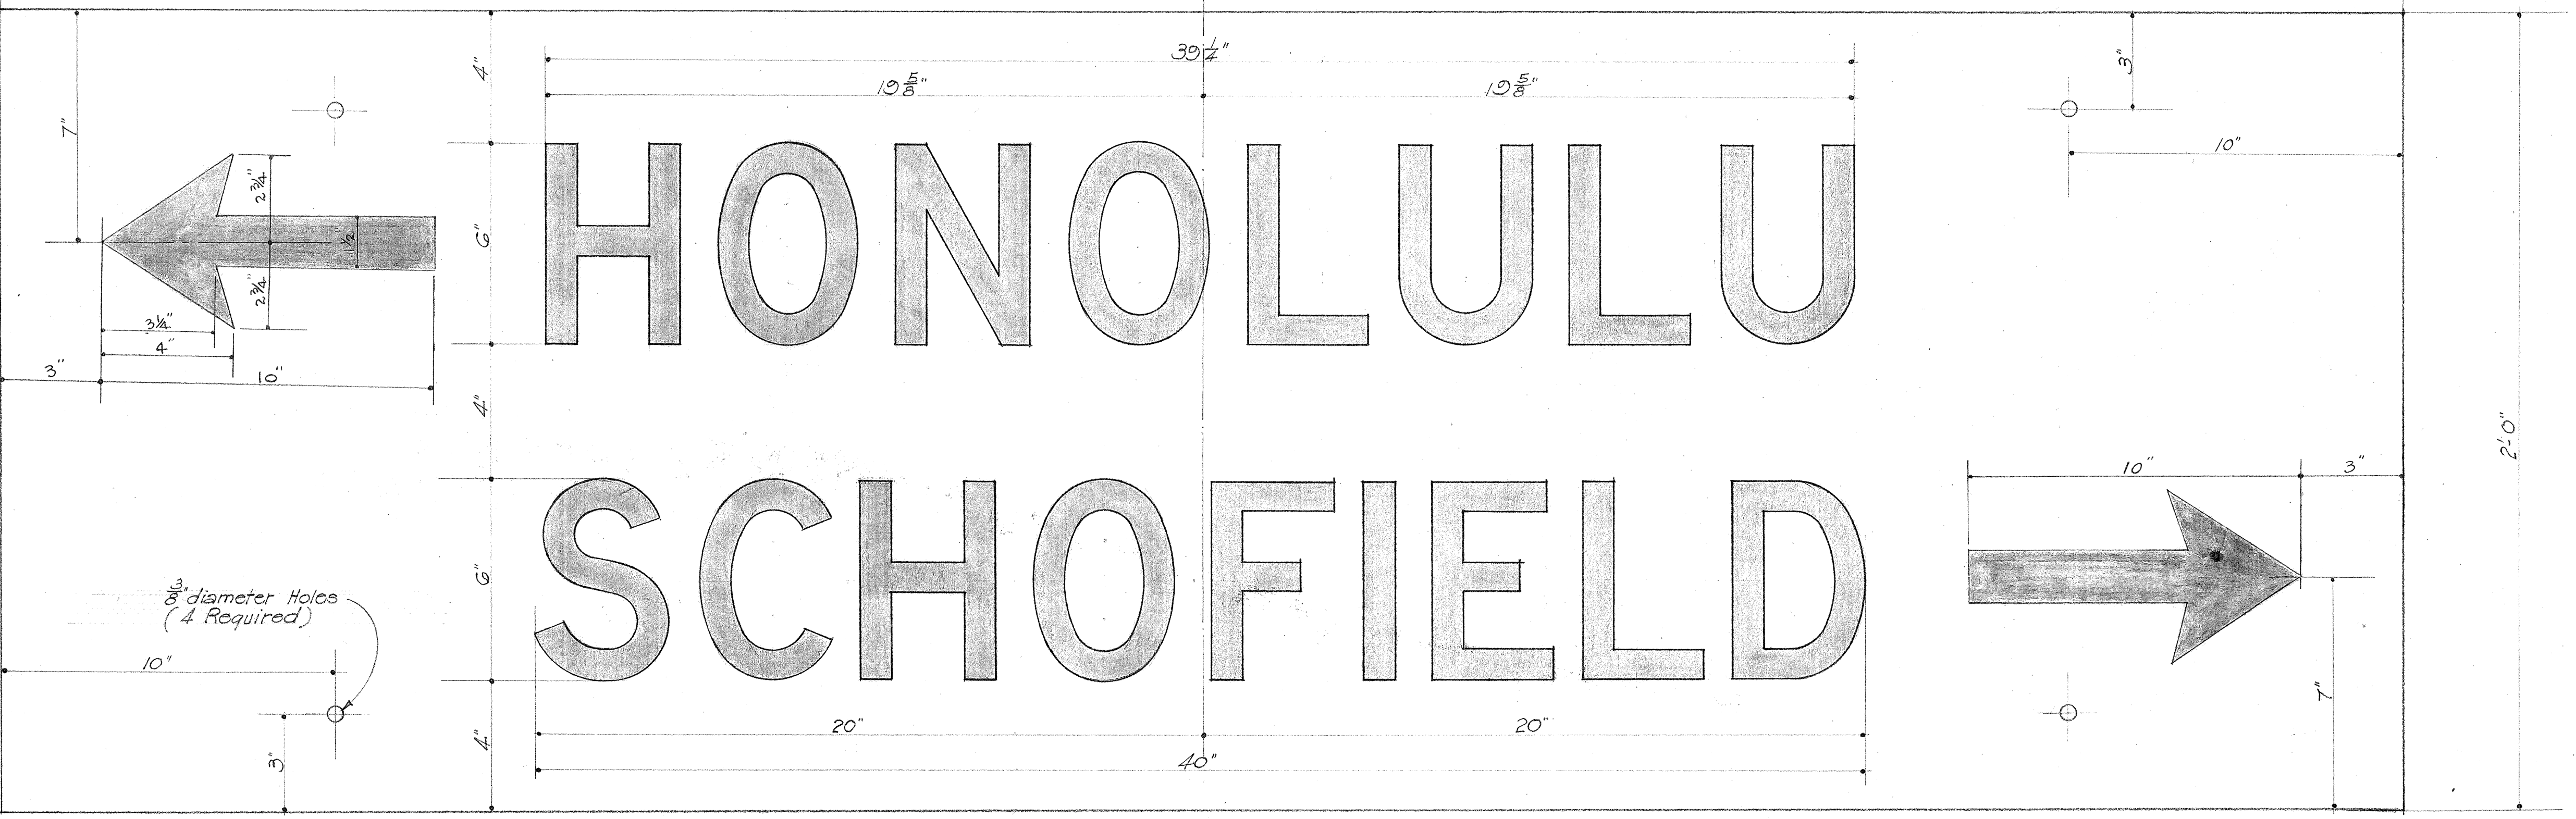

VOID (SUPERSEDED)
SEE SHEET No. 5245-34 A

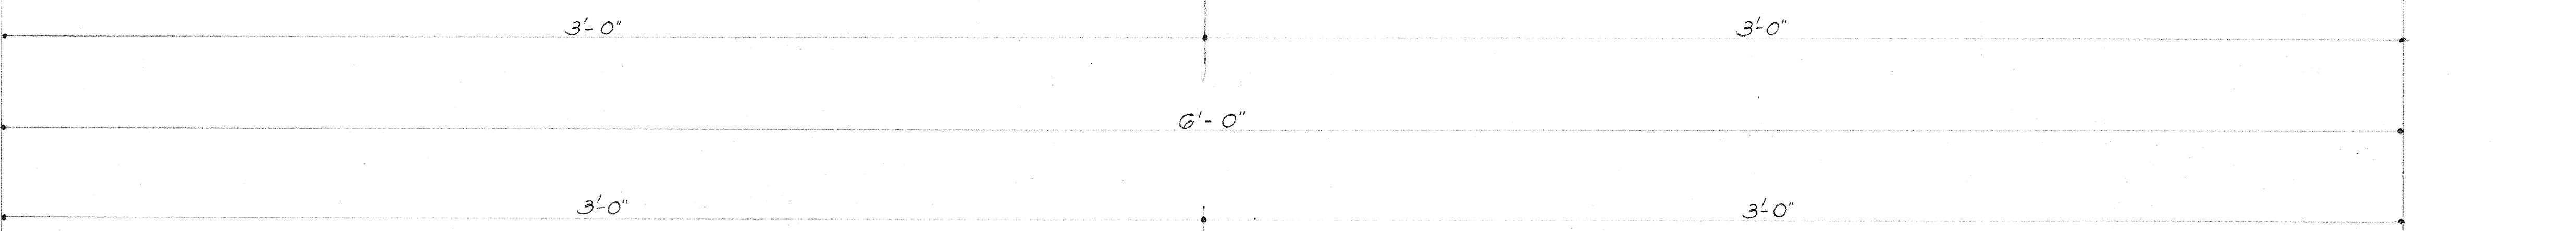


- NOTES:
1. Signs are to be lettered in accordance with Standard Alphabets for Highway Signs approved by A.A.S.H.O. published by Public Roads Administration 1945 using G Series "D" Letters.
 2. 3/8" diameter holes are to be made in locations shown before signs are painted.

TERRITORIAL HIGHWAY DEPARTMENT
TERRITORY OF HAWAII
DIRECTIONAL SIGNS
SCHOFIELD ACCESS ROADS
HAWAII PROJECT NO. DA-WR 8 (3)
Scale: 3/4 Actual Size

SURVEY PLOTTED BY	DATE
DESIGNED BY	"
TRACED BY	"
NOTED BY	"
QUANTITIES CHECKED BY	"
CHECKED BY	"
No.	

FED. ROAD DIST. NO.	STATE	FED. AID PROJ. NO.	FISCAL YEAR	SHEET NO.	TOTAL SHEETS
HAWAII	HAW.	DA-WR-88	1947	34 A	

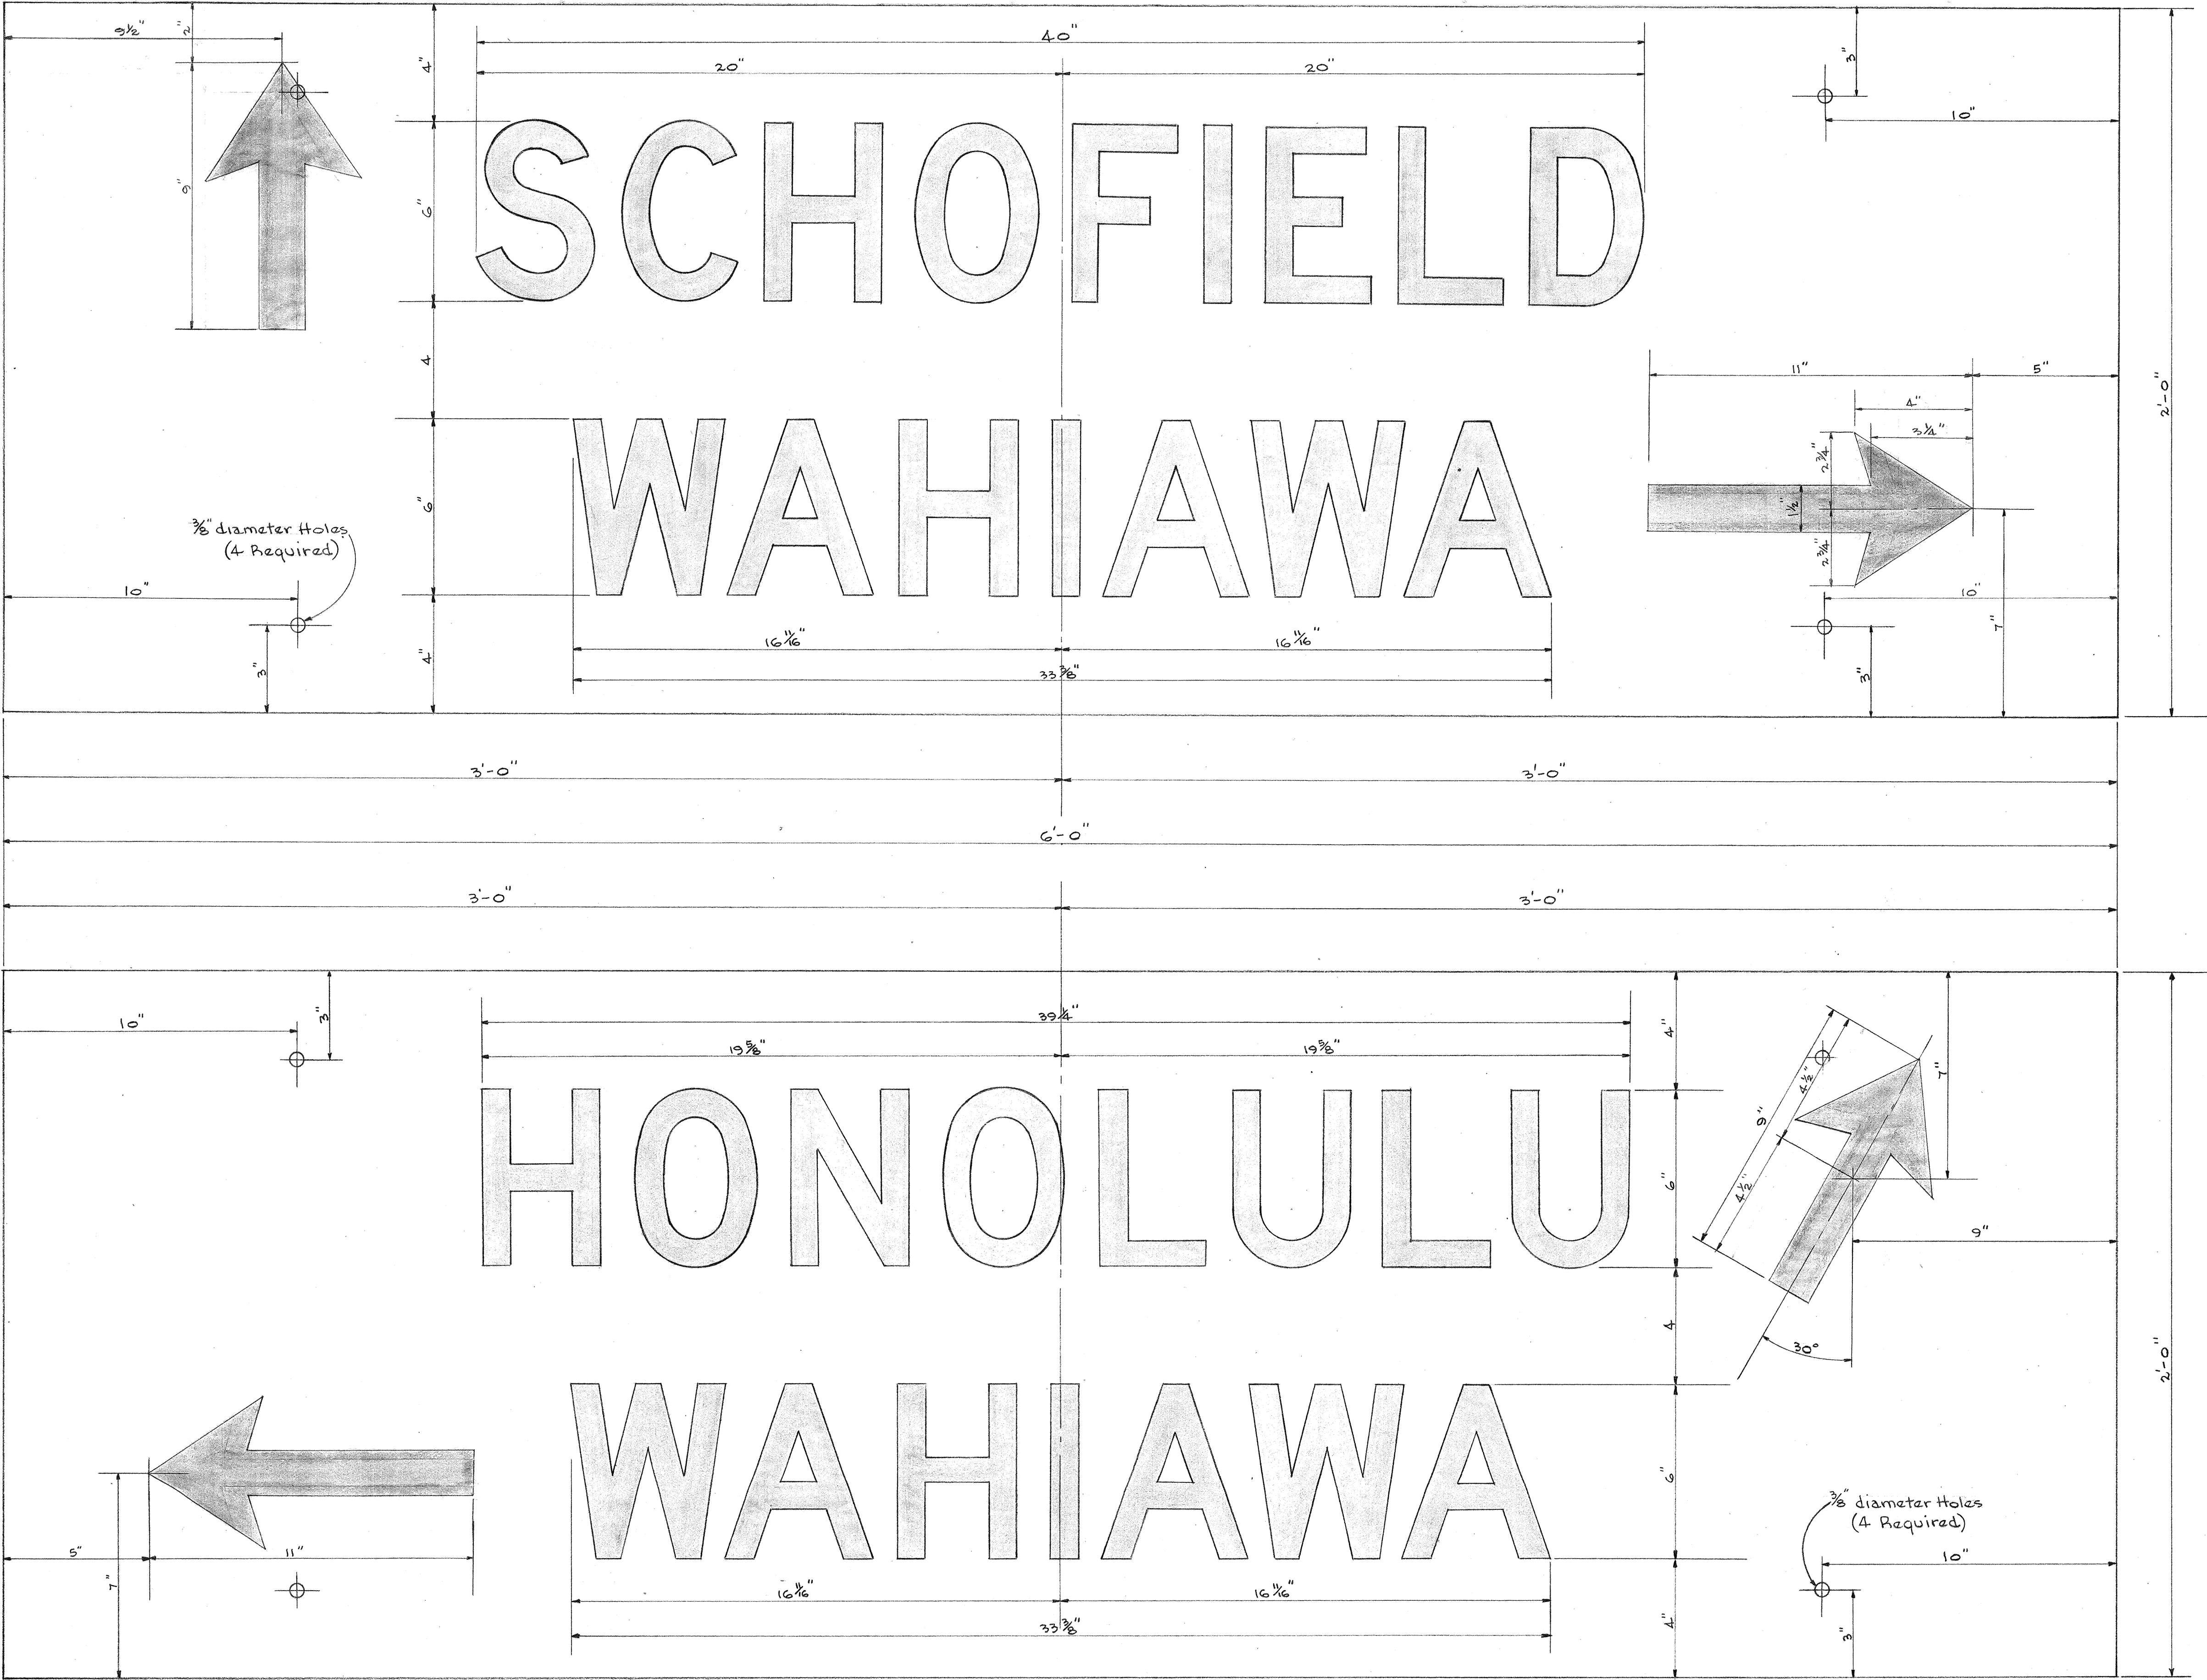

THIS SIGN SUPERSEDES DIRECTIONAL SIGN
 "WAHIAWA - SCHOFIELD"
 ON SHEET NO. 5245.33

- NOTES:
- Signs are to be lettered in accordance with Standard Alphabets for Highway Signs approved by A.A.S.H.O. published by Public Roads Administration 1945 using "G" Series "D" Letters.
 - $\frac{3}{8}$ " diameter holes are to be made in location shown before signs are painted.

THIS SIGN SUPERSEDES DIRECTIONAL SIGN
 "WAHIAWA - HONOLULU"
 ON SHEET NO. 5245.34

TERRITORIAL HIGHWAY DEPARTMENT
 TERRITORY OF HAWAII

DIRECTIONAL SIGNS
 SCHOFIELD ACCESS ROADS
 HAWAII PROJECT No. DA-WR 8 (?)
 SCALE: $\frac{1}{2}$ ACTUAL SIZE

SHEET No OF SHEETS

5245.34A

THIS SHEET SUPERSEDES SHT. No. 5245.34

DECEMBER 8, 1947

ORIGINAL PLAN	DATE
SURVEY PLOTTED BY	
DRAWN BY	
TRACED BY	
QUANTITIES CHECKED BY	
CHECKED BY	
No.	