

See respective authorities concerning utilities shown before starting construction near same.
See Special Provisions.

Army buildings within New Highway Right-of-Way at Wheeler Field Corner Cutoff to be razed and materials stored as directed for removal by Army. See Special Provisions. Buildings are shown (A) to (J)

Install Type "B" Conc. Curb for Traffic Islands and Medial Strips as shown.


Adjust WRIGHT GATE as shown and relocate Gate House and Provost Marshall Bldg as directed. (Payment to be included in item of ADJUSTING WRIGHT GATE. See Special Provisions.

Intersection Detail Supplementary Sheets will be furnished prior to Construction.

Construct Chain-Link Fence at Φ Medial Strip Sht. No 5245.9

NOTE: FOR DETAILS OF INTERSECTIONS INCLUDING WARNING CAUTION, REGULATORY AND DIRECTIONAL SIGNS, AND TRAFFIC CONTROL SIGNALS AT KAMEHAMEHA HIGHWAY AND WRIGHT AVE. AND ALSO AT KAMEHAMEHA HIGHWAY-WILIKINA DRIVE - WILSON BRIDGE, SEE SHTS NO 5245.S4 AND 5245.S5.

FED. ROAD DIST. NO.	STATE	FED. AID PROJ. NO.	FISCAL YEAR	SHEET NO.	TOTAL SHEET
HAWAII	HAW.	DA-WR 2 (3)	1947	25	134

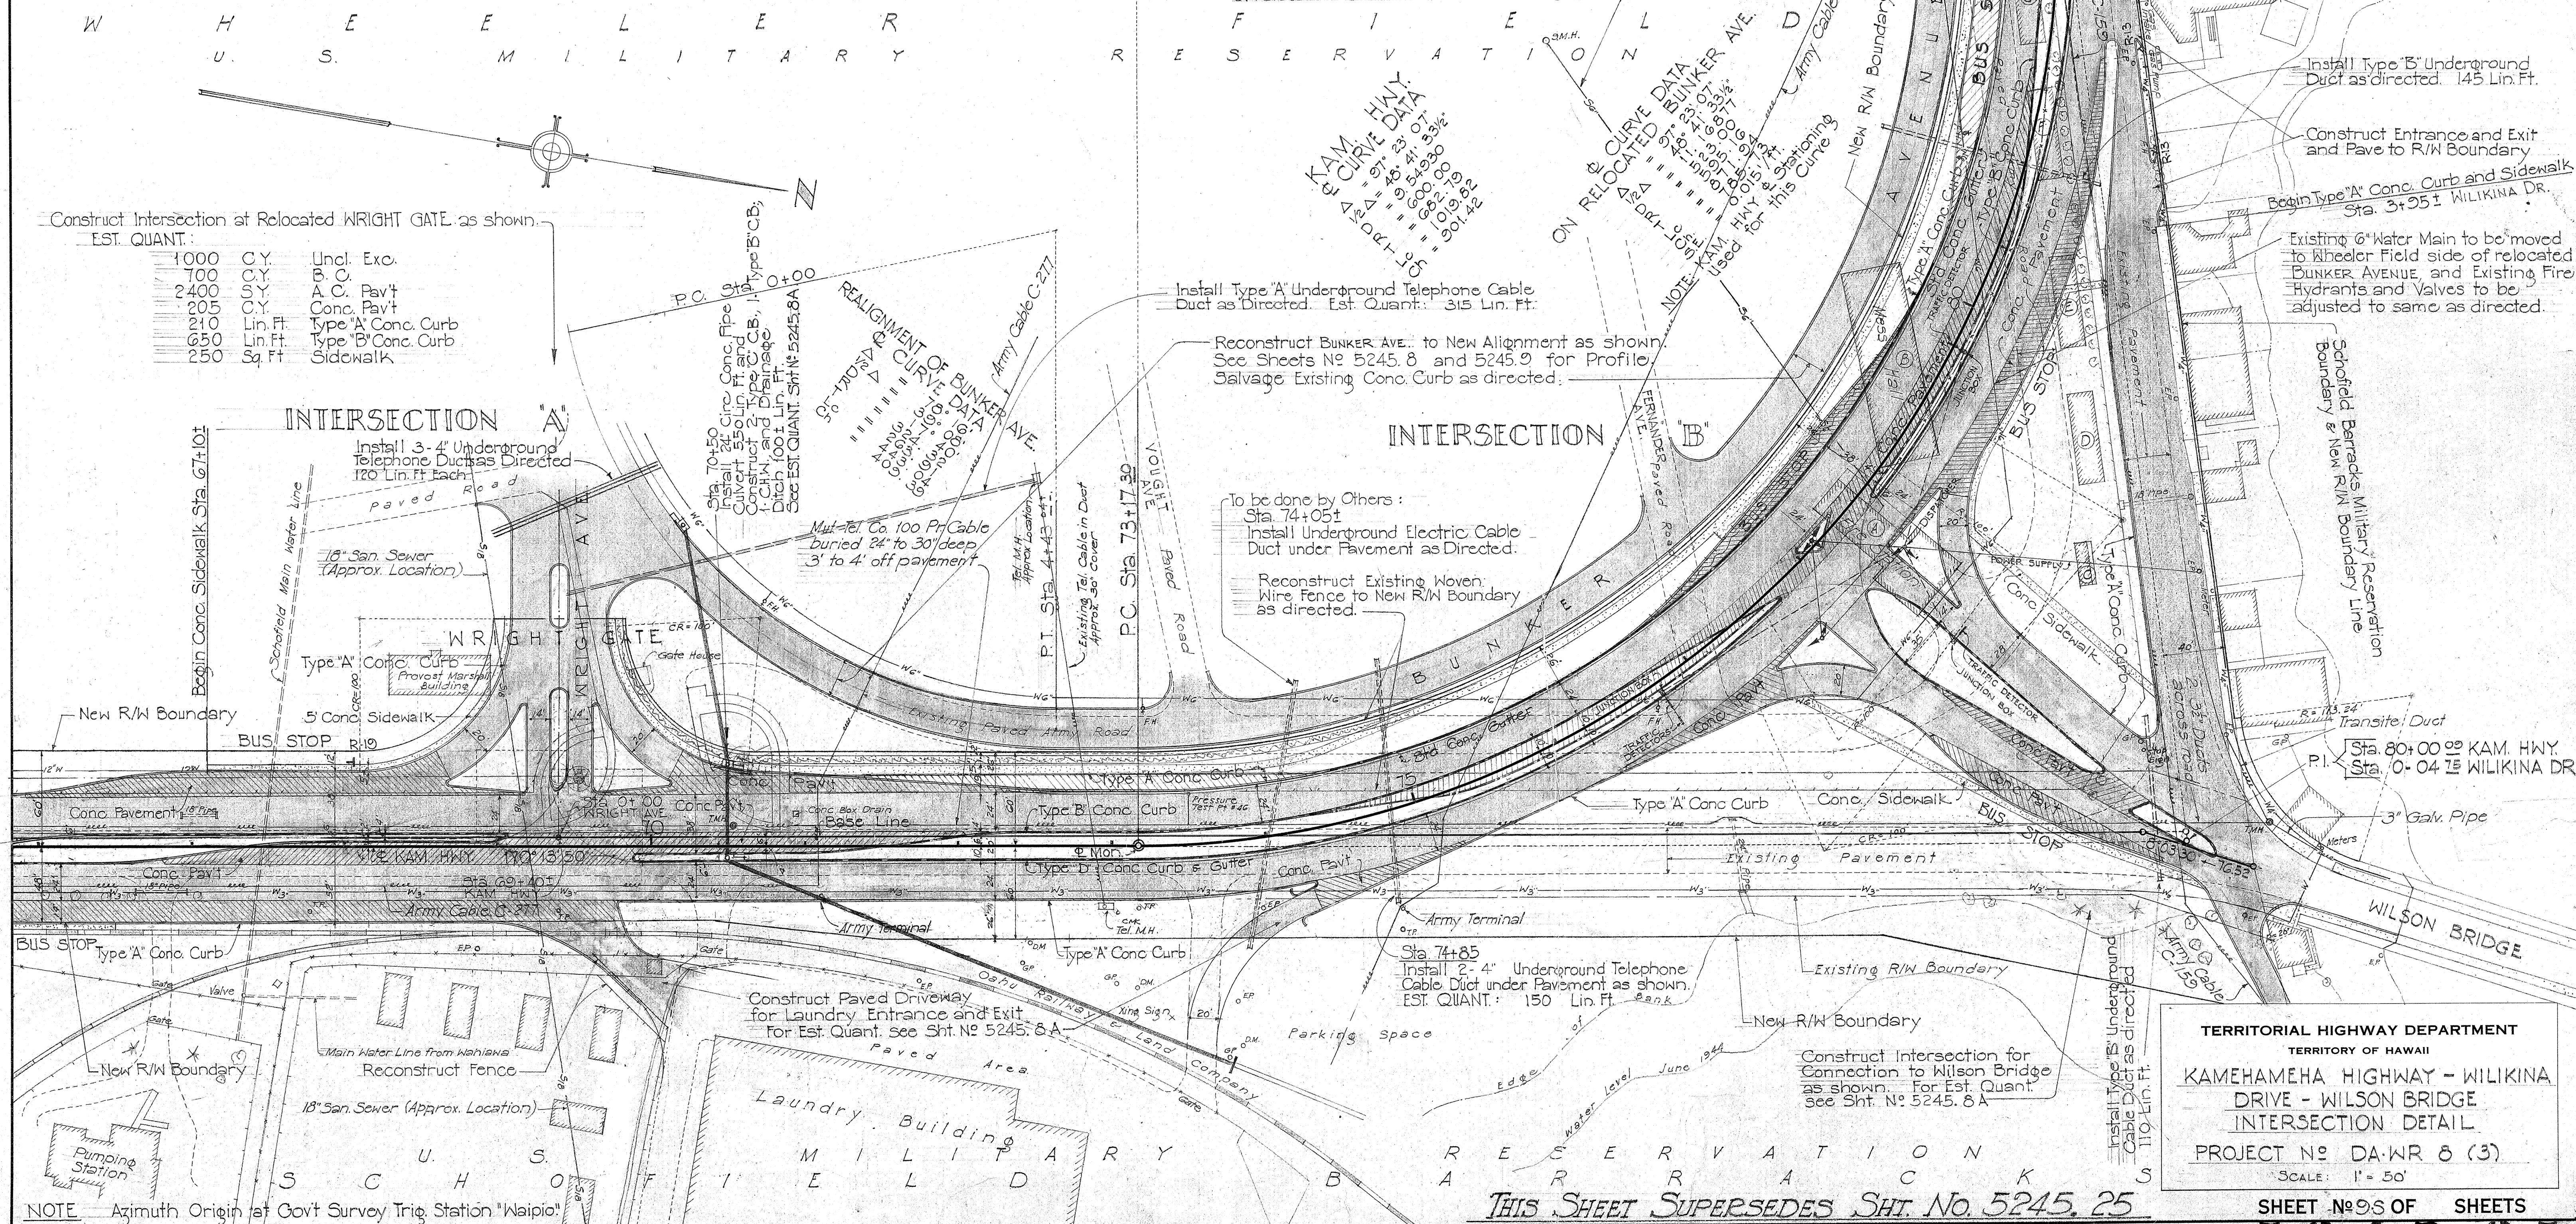

Revised: July 1946

ORIGINAL	SURVEY PLOTTED BY	DATE
PLAN	DESIGNED BY	
	DRAWN BY	
	TRACED BY	
NOTE BOOK	QUANTITIES BY	
	QUANTITIES CHECKED BY	
No.	CHECKED BY	

NOTE Azimuth Origin at Gov't Survey Trig. Station "Waipio"

THIS SHEET SUPERSEDES SHT. No. 5245. 25

TERRITORIAL HIGHWAY DEPARTMENT
TERRITORY OF HAWAII
KAMEHAMEHA HIGHWAY - WILIKINA
DRIVE - WILSON BRIDGE
INTERSECTION DETAIL
PROJECT NO. DA-WR 8 (3)
SCALE: 1" = 50'

SHEET No 9.5 OF SHEETS

FOIA b 7

3243.2

FED. ROAD DIST. NO.	STATE	FED. AID PROJ. NO.	FISCAL YEAR	SHEET NO.	TOTAL SHEETS
HAWAII	HAW.	DA-WR 8 (3)	1947	26A	134

ORIGINAL PLAN	DESIGNED BY	DATE
NOTE BOOK	TRACED BY	
	QUANTITIES BY	
	CHECKED BY	
	CHECKED BY	

LEGEND

- TYPE "A" CONC. CURBS
- TYPE "B" CONC. CURBS
- A.C. PAVEMENT
- CONC. PAVEMENT

NOTE:
FOR DRAINAGE STRUCTURE LAYOUT
SEE SHEETS NO. 5245.16 & 5245.17.


TERRITORIAL HIGHWAY DEPARTMENT
TERRITORY OF HAWAII
WEST END
WRIGHT AVENUE CONNECTION
KUNIA SPUR
PROJECT NO. DA-WR 8 (3)


Scale: 1" = 20'

SHEET NO. OF SHEETS

THIS SHEET SUPERSEDES SHT. NO. 5245.26

5245.26A

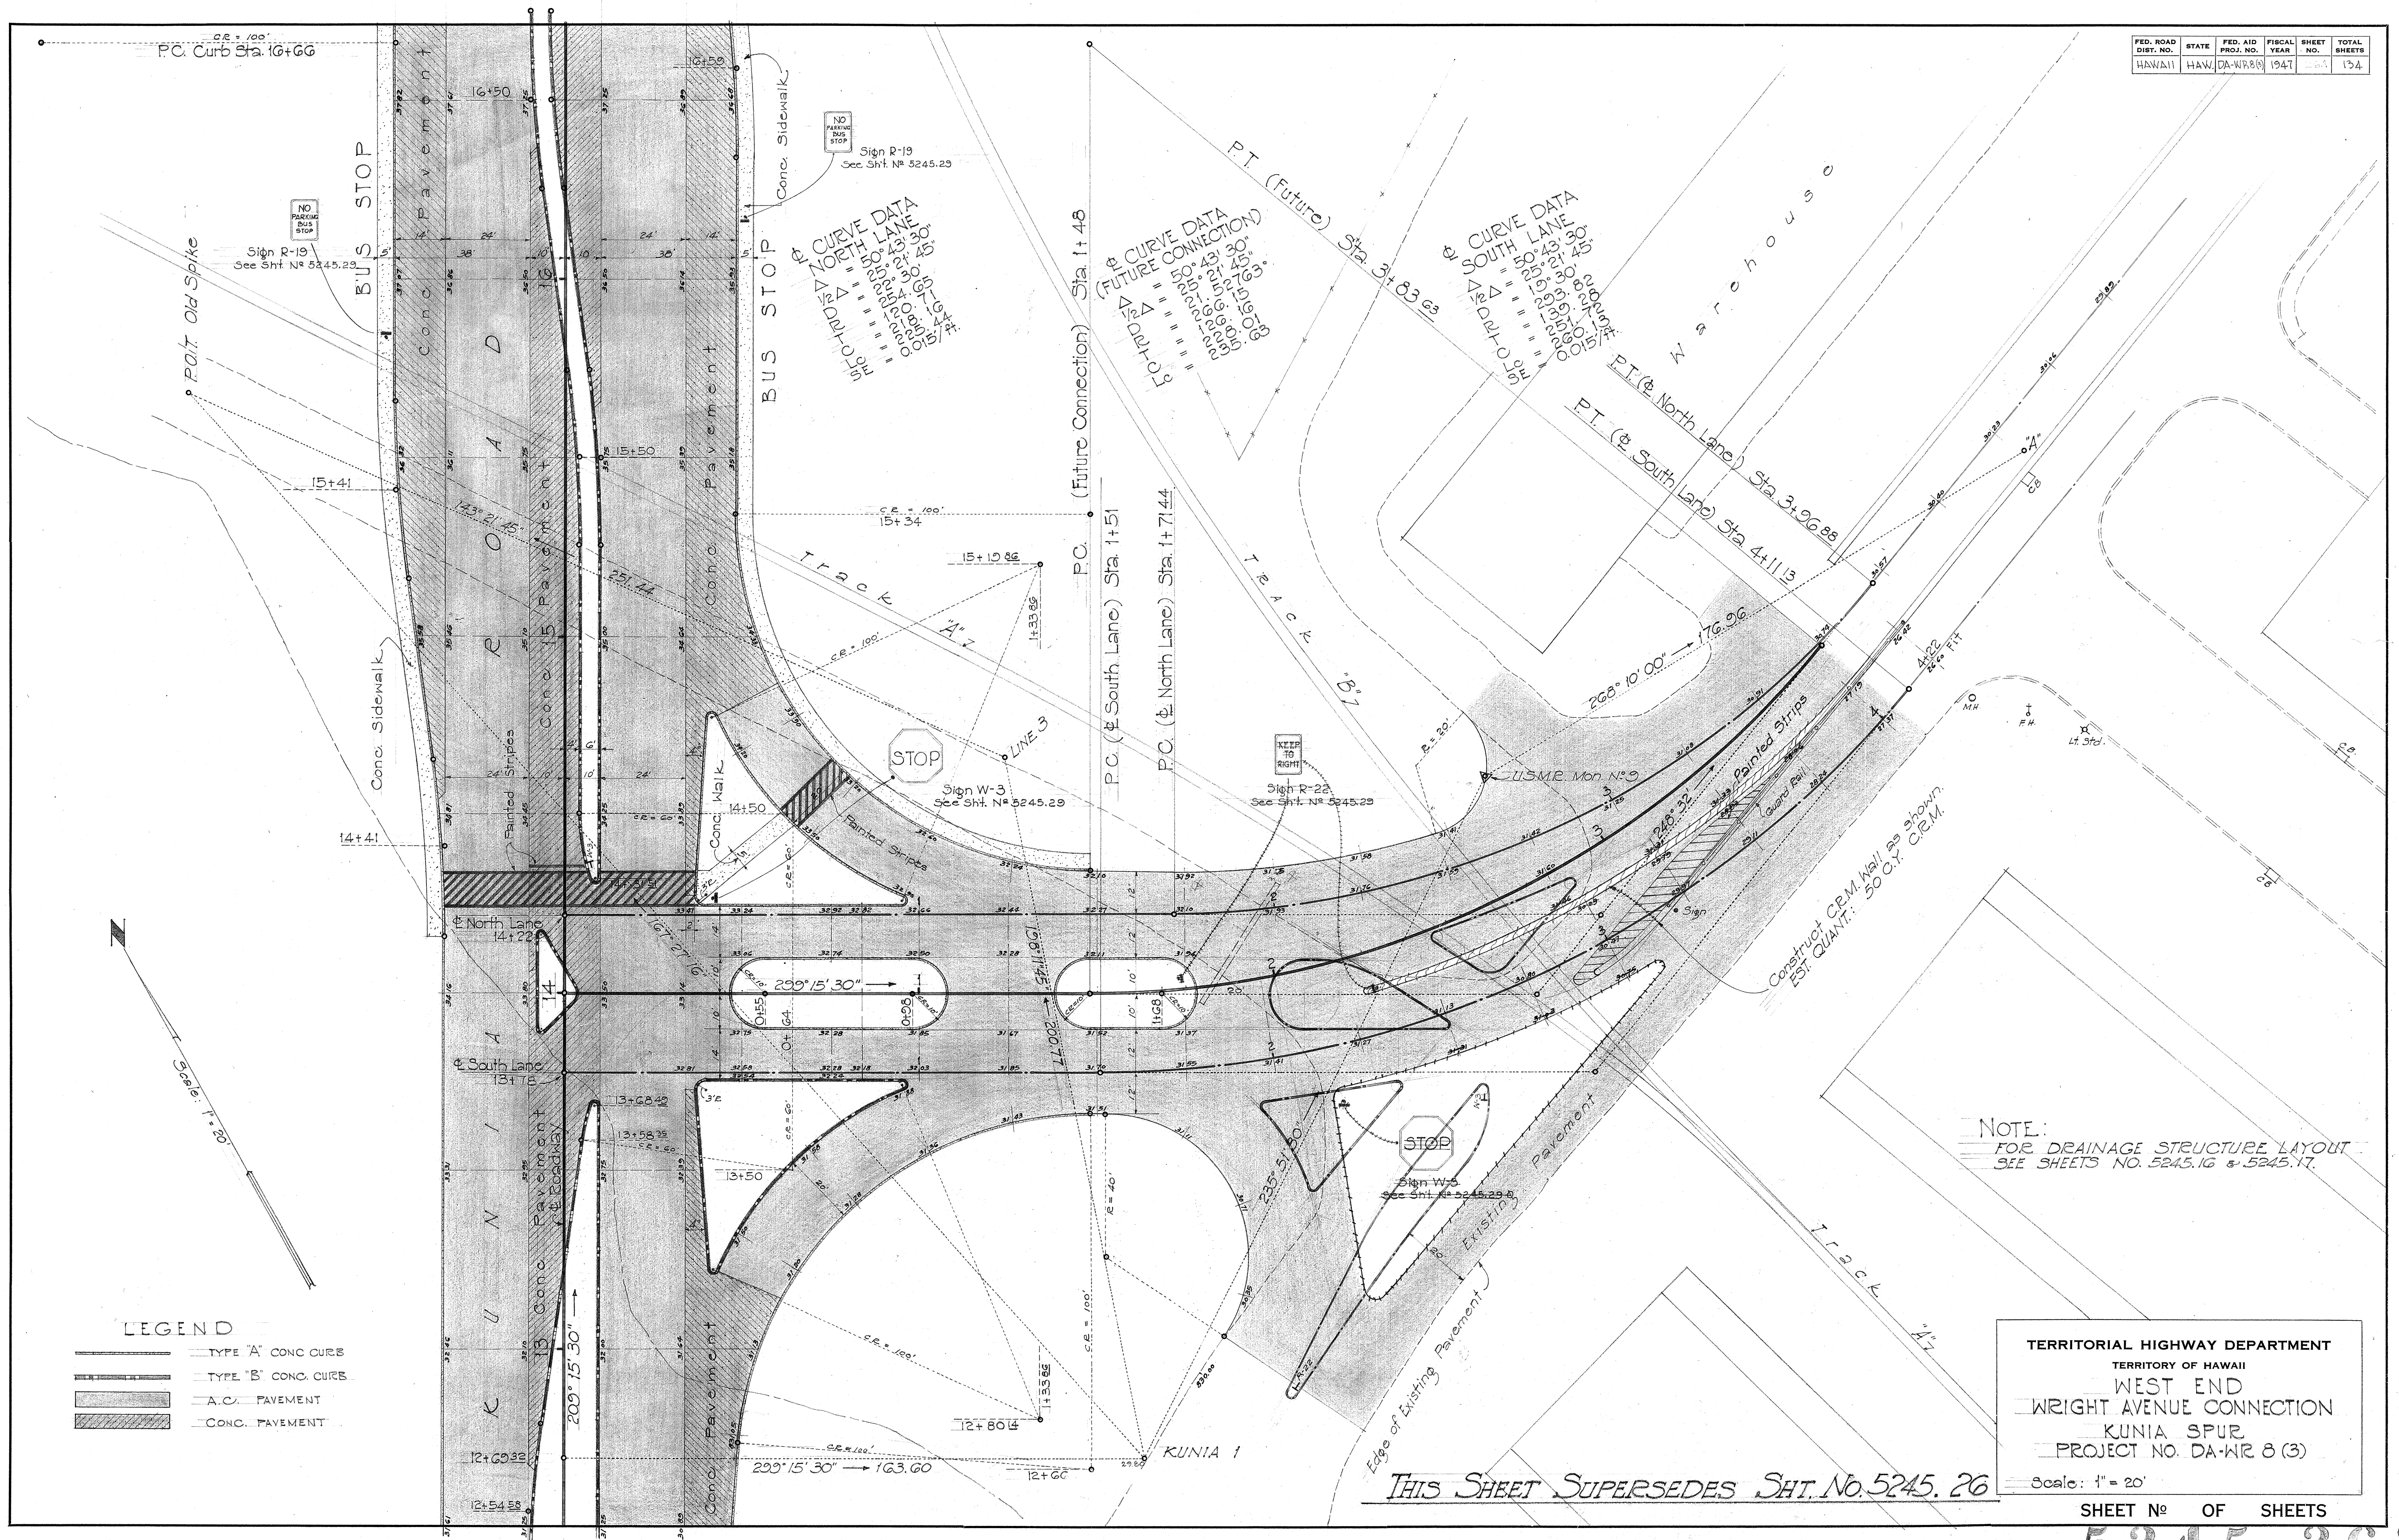

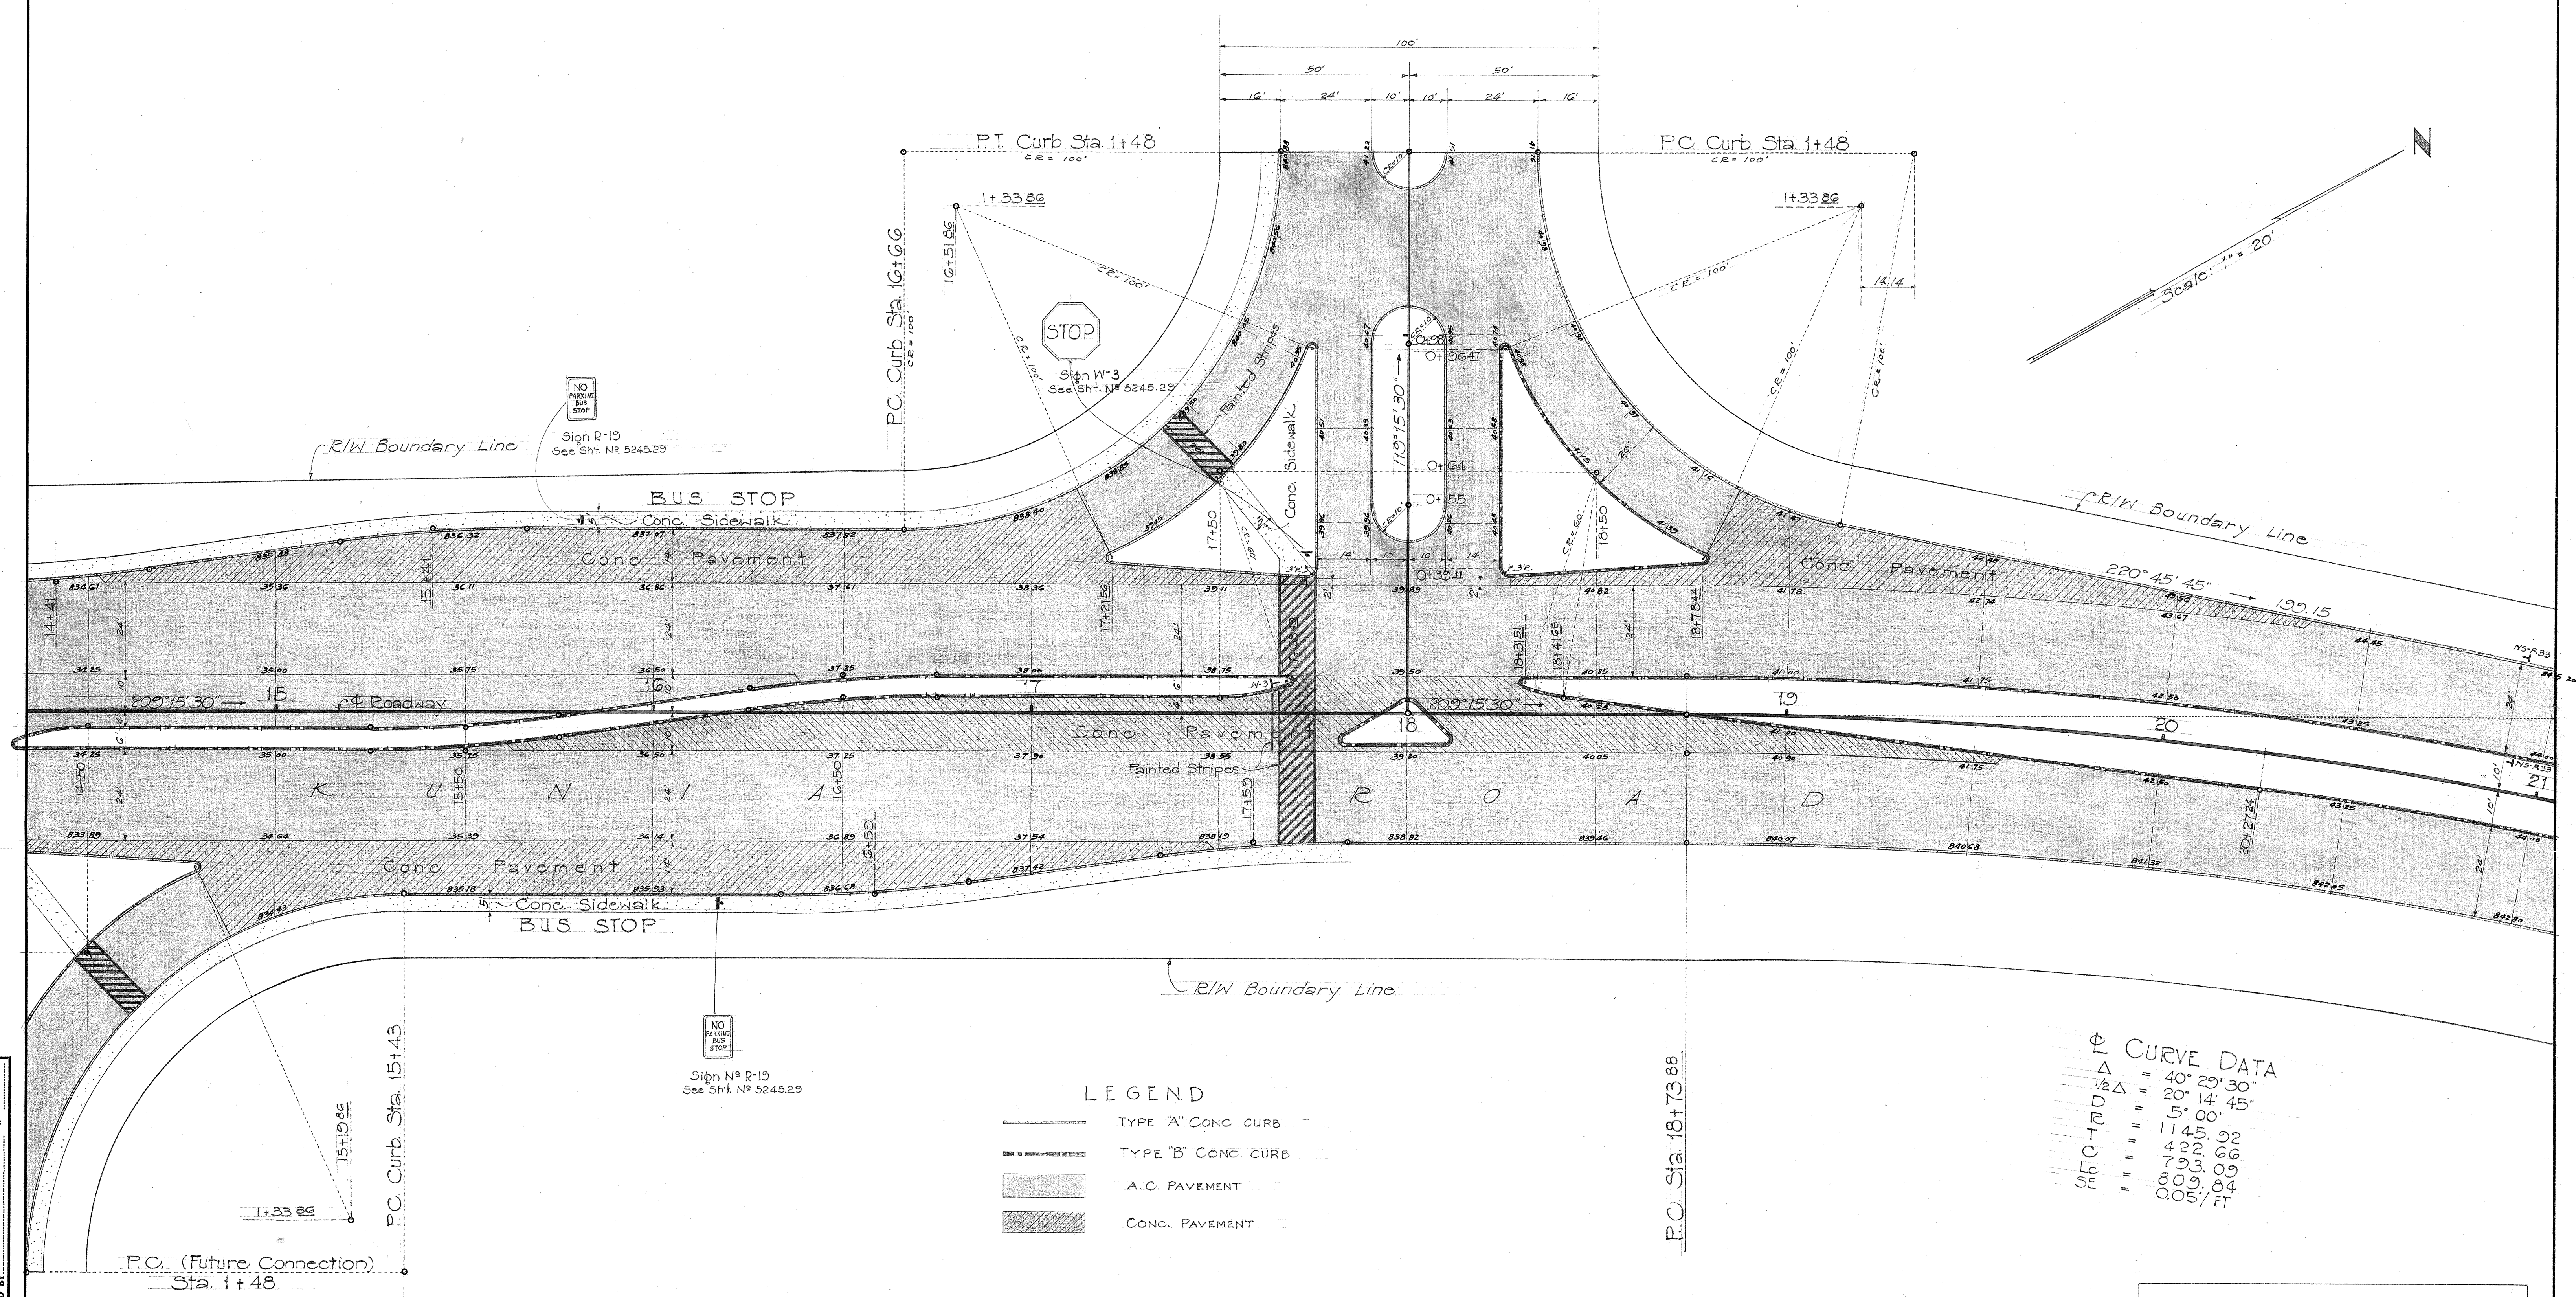

LEGEND

- TYPE "A" CONC CURB
- TYPE "B" CONC CURB
- A.C. PAVEMENT
- CONC. PAVEMENT

Φ CURVE DATA

Δ	= 40° 25' 30"
1/2 Δ	= 20° 14' 45"
Δ	= 5° 00'
LC	= 1145.92
LS	= 422.66
LE	= 793.09
SE	= 809.84
SP	= 0.05/FT

NOTE:
FOR DRAINAGE STRUCTURE LAYOUT
SEE SHEET NO. 5245.17

THIS SHEET SUPERSEDES SHT. NO. 5245.27

TERRITORIAL HIGHWAY DEPARTMENT
TERRITORY OF HAWAII
INTERSECTION DETAIL
STA. 18+00
KUNIA SPUR
PROJECT NO. DA-WR 8 (3)
Scale: 1" = 20'

SHEET NO. OF SHEETS

5245.27A

SURVEY PLOTTED BY	DATE
DESIGNED BY	
TRACED BY	
QUANTITIES BY	
NOTE BOOK	
CHECKED BY	
No.	