


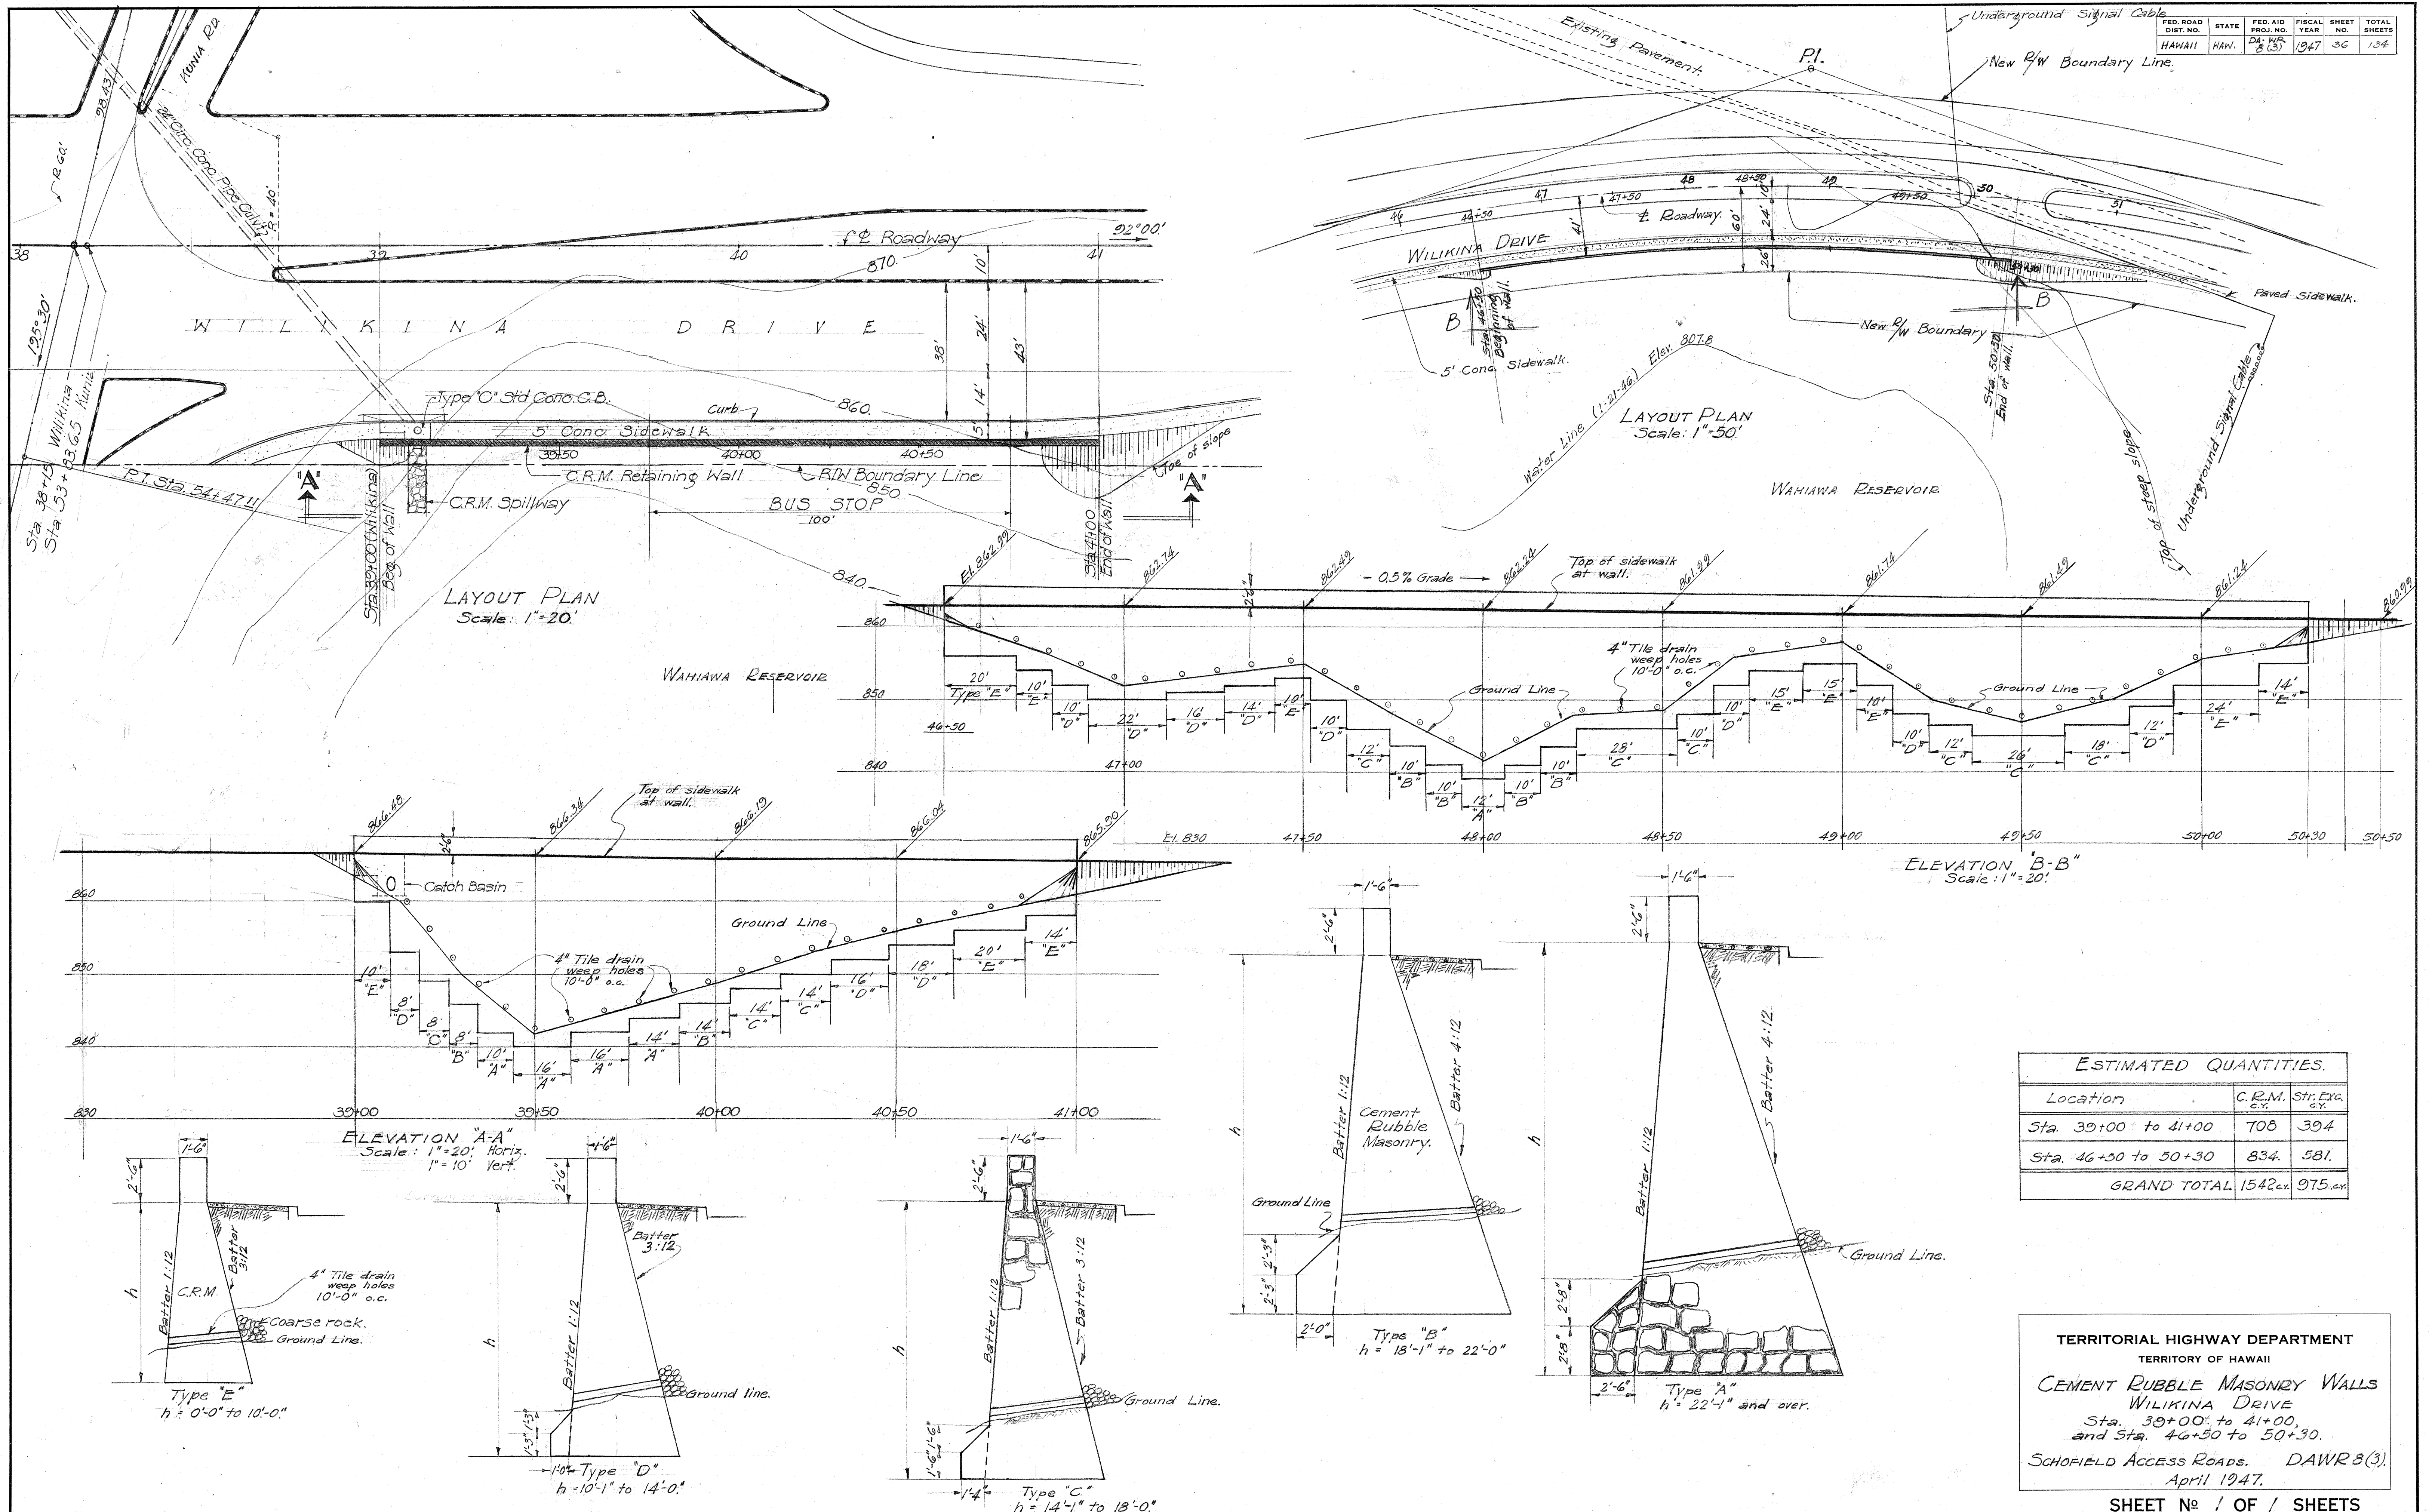

ESTIMATED QUANTITIES.		
Location	C.R.M. c.y.	Str. Exc. c.y.
Sta. 39+00 to 41+00	708	394
Sta. 46+30 to 50+30	834	581
GRAND TOTAL	1542 _{ex}	975 _{av}

TERRITORIAL HIGHWAY DEPARTMENT
TERRITORY OF HAWAII
CEMENT RUBBLE MASONRY WALLS
WILIKINA DRIVE
Sta. 39+00 to 41+00,
and Sta. 46+50 to 50+30.
SCHOFIELD ACCESS ROADS. DAWR 8(3).
April 1947.