

INDEX TO DRAWINGS	
SHEET NO.	DESCRIPTION
1	Title Sheet
2	Typical Road Section(21-A)
3	Typical Road Section(21-B)


FED. ROAD DIST. NO.	STATE	FED. AID PROJ. NO.	FISCAL YEAR	SHEET NO.	TOTAL SHEETS
HAWAII	HAW	DF-082-1(1)	1958	1	3

TERRITORY OF HAWAII
TERRITORIAL HIGHWAY DEPARTMENT
HONOLULU, OAHU, T. H.


PLANS FOR
THE RECONSTRUCTION & RESURFACING OF PORTION
OF KAMEHAMEHA HIGHWAY BETWEEN KAMEHAMEHA
HIGHWAY-KAUKONAHUA ROAD JUNCTION
& WEED JUNCTION NO.2 (OLD F.A.P. NOS. 21-A & 21-B)
FEDERAL AID PROJECT NO. DF-082-1(1)

DISTRICT OF WAIALUA
ISLAND OF OAHU

SCALE: AS NOTED

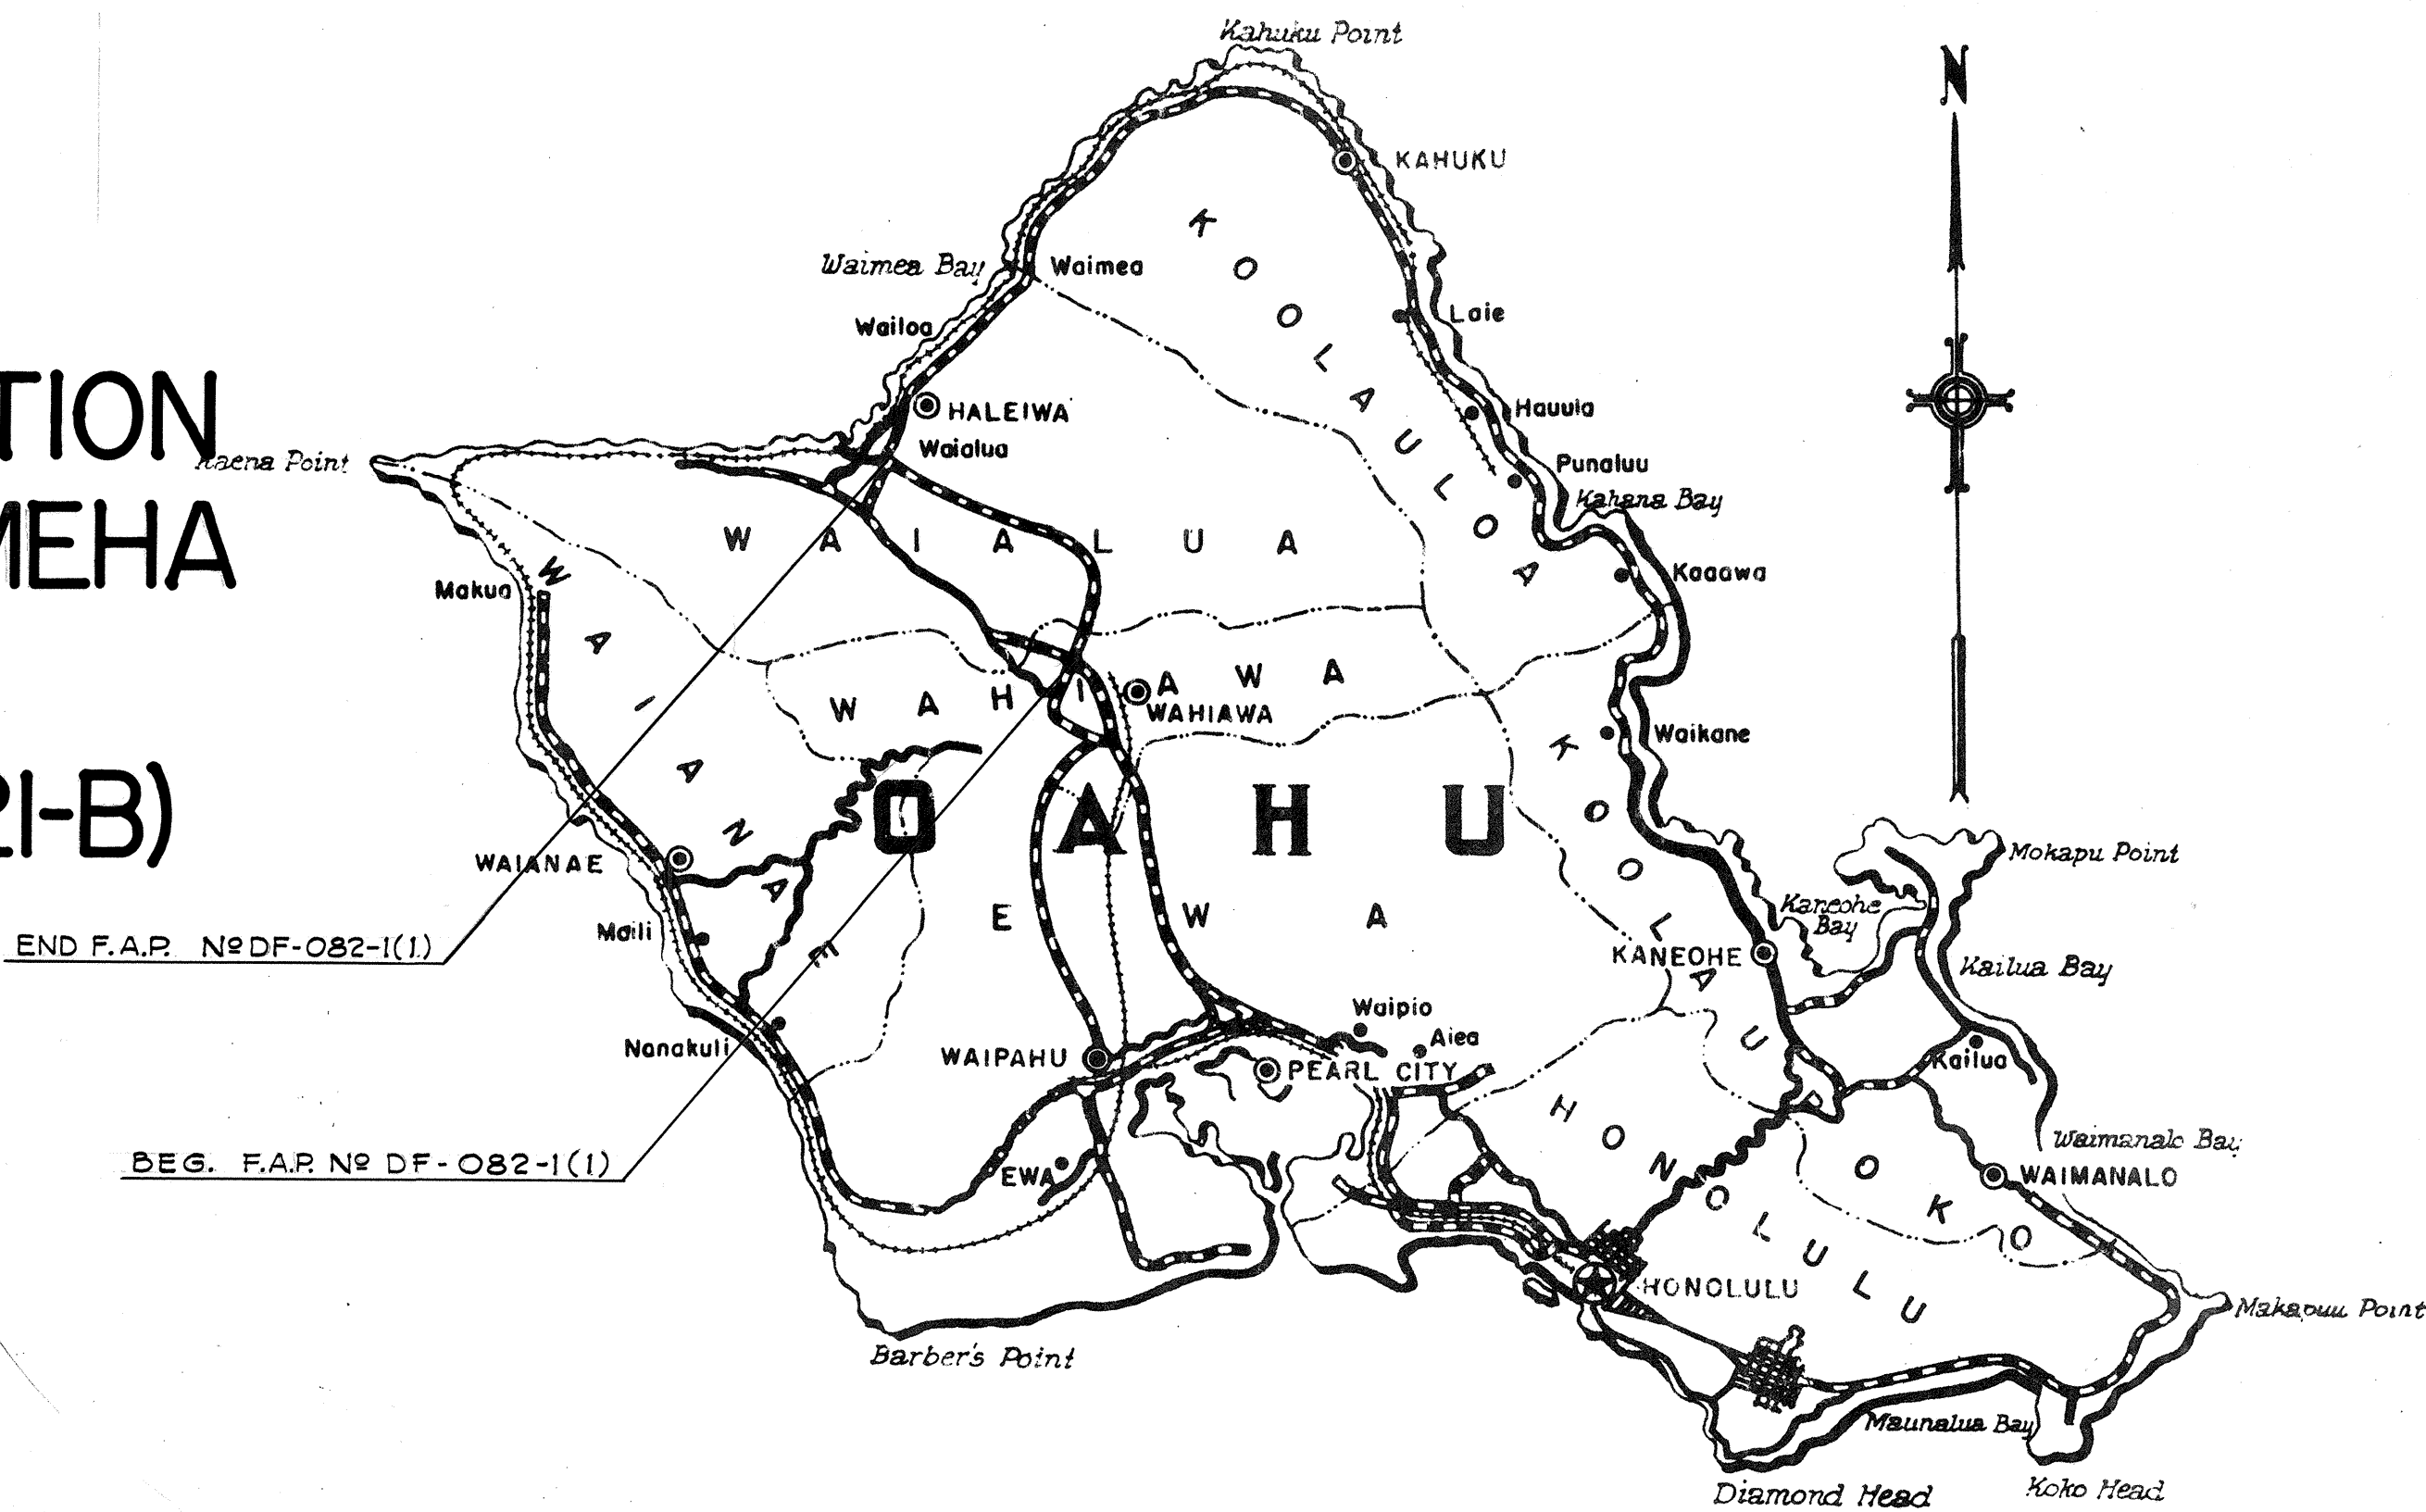

Federal Aid Projects Previously Constructed Or Under Construction

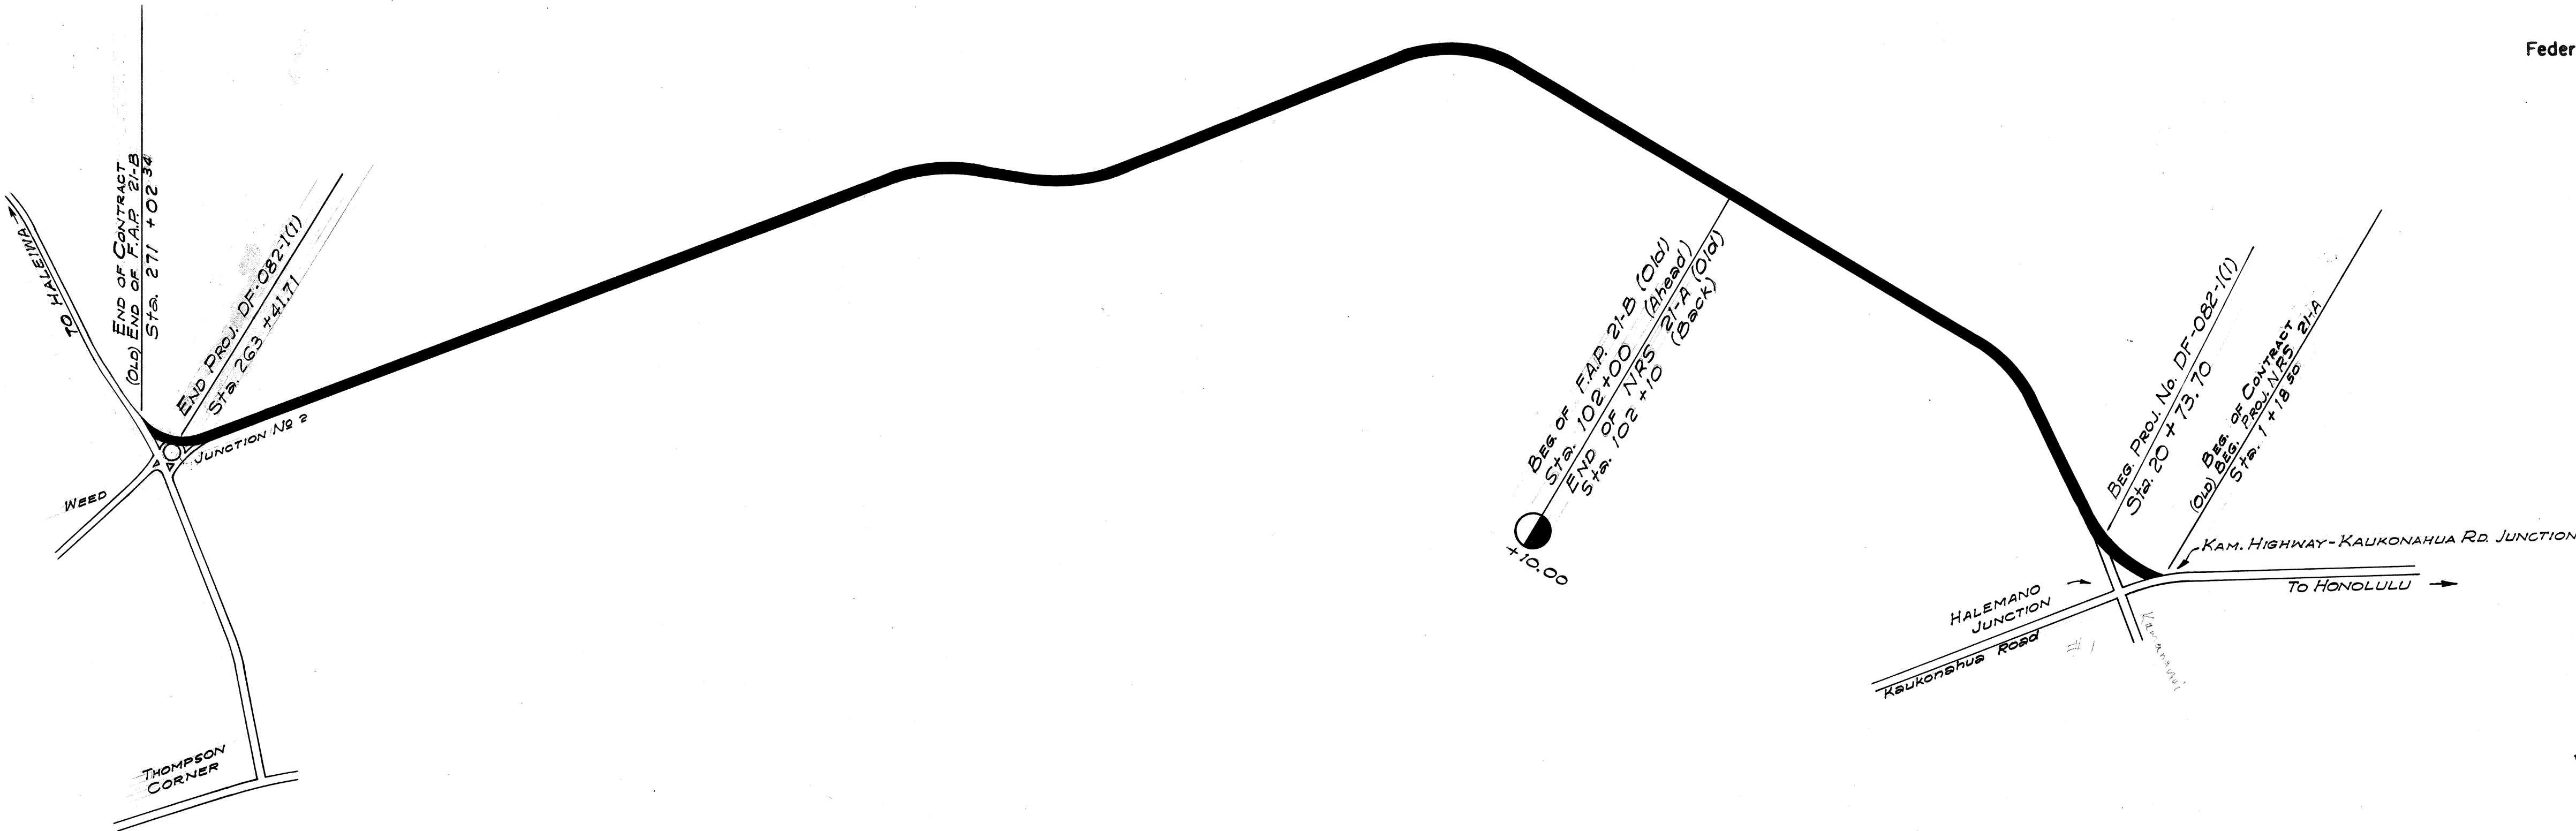

LAYOUT OF PROJECT
Scale 1/20,000
GROSS & NET LENGTH 6.651 MI.

APPROVED: DATE 10/3/58
TERRITORIAL HIGHWAY ENGINEER

DEPARTMENT OF COMMERCE
BUREAU OF PUBLIC ROADS
APPROVED:
DIVISION ENGINEER DATE

ORIGINAL PLAN	DATE
DRAWN BY	
CHECKED BY	
QUANTITIES CHECKED BY	
CHECKED BY	