

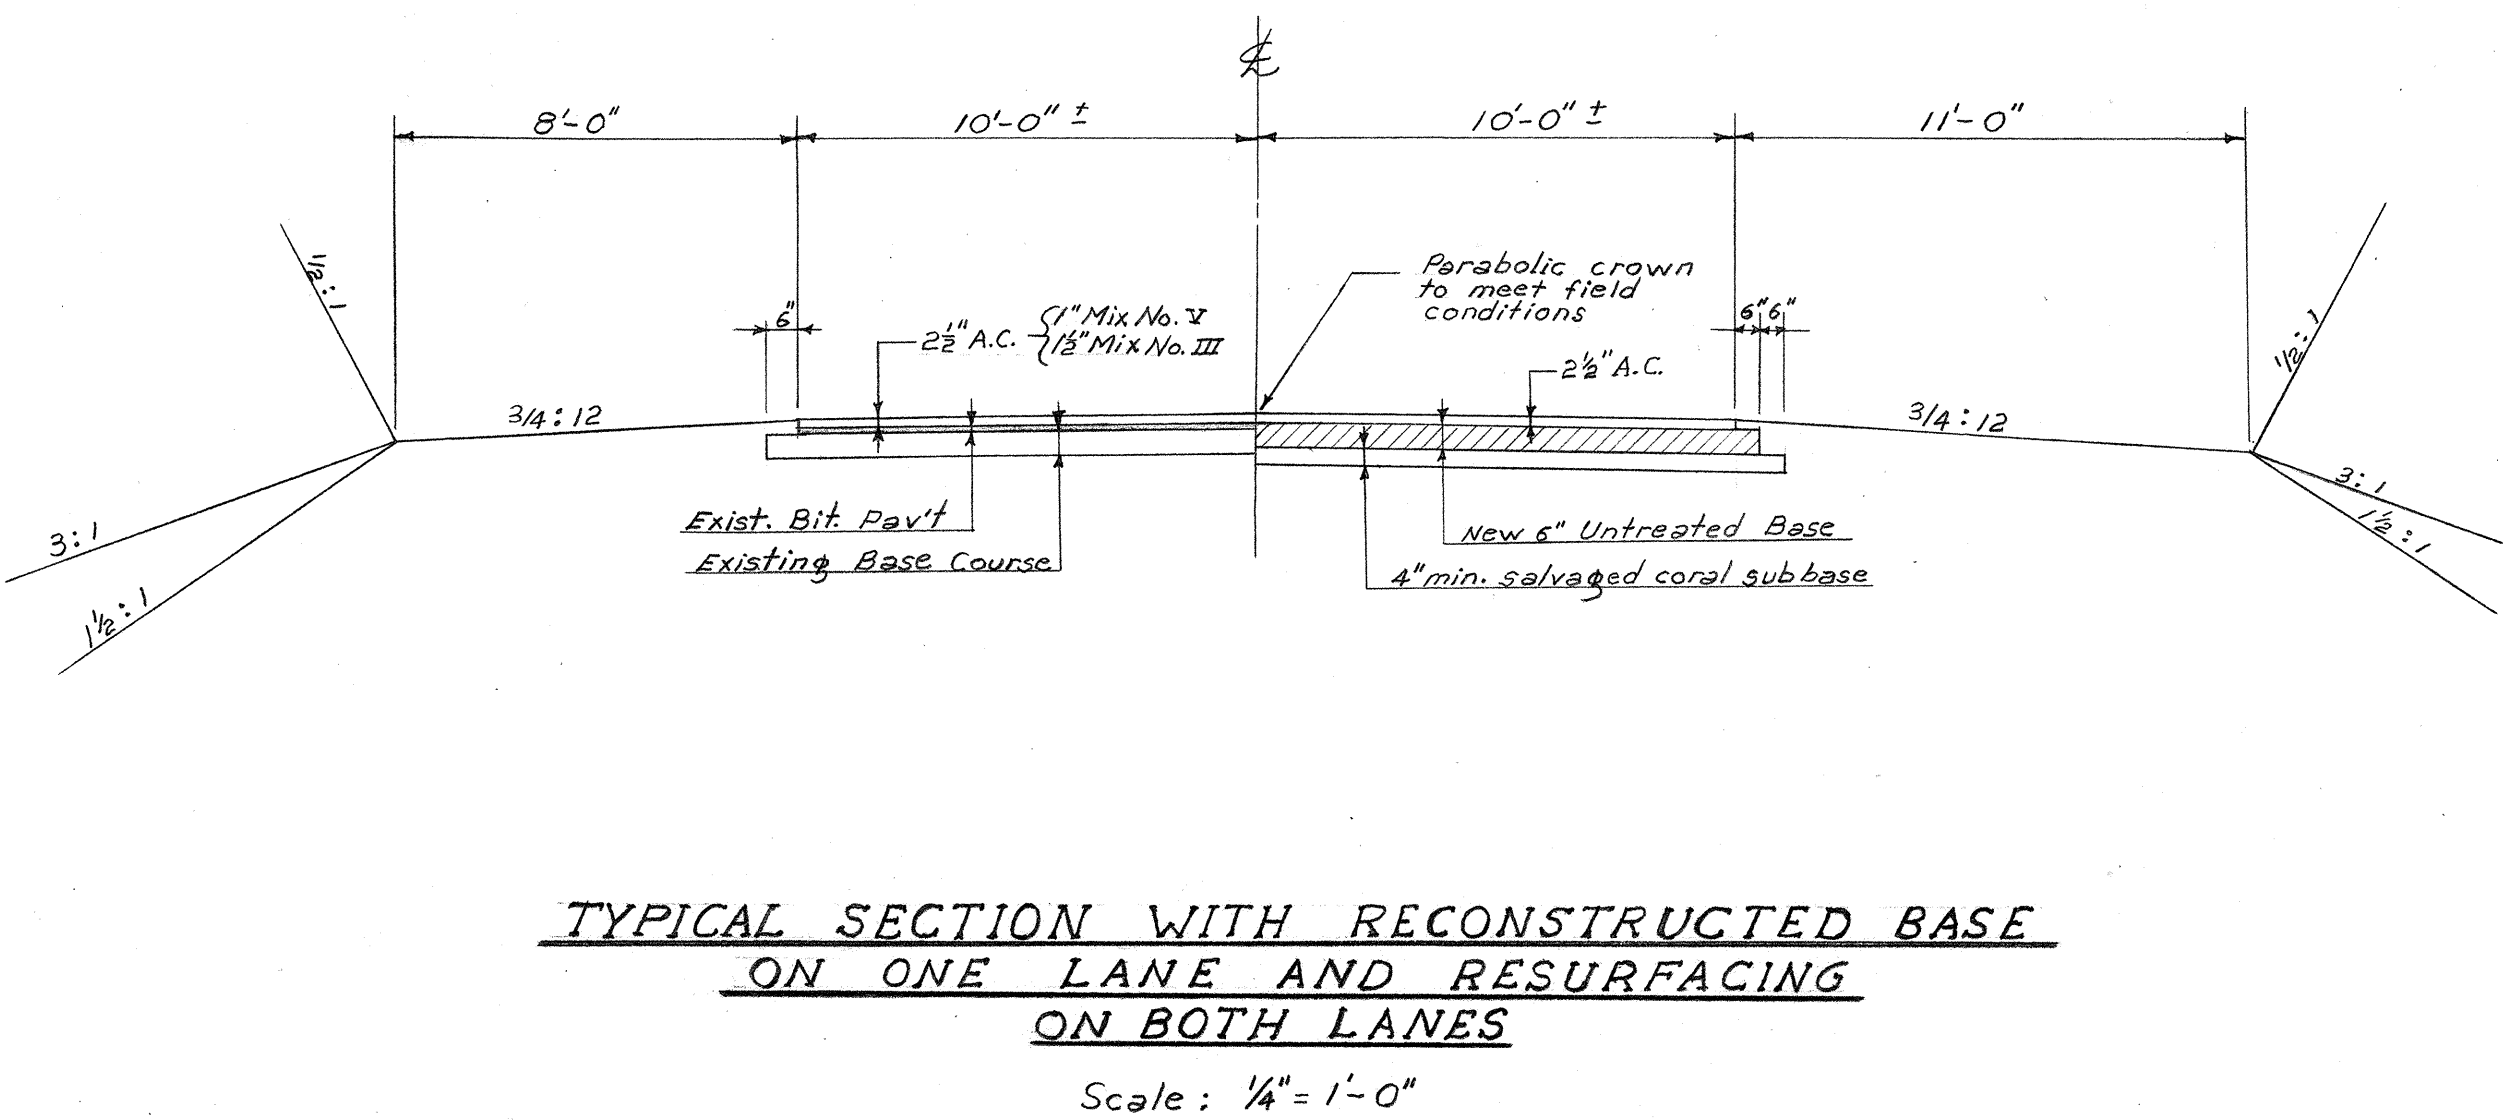
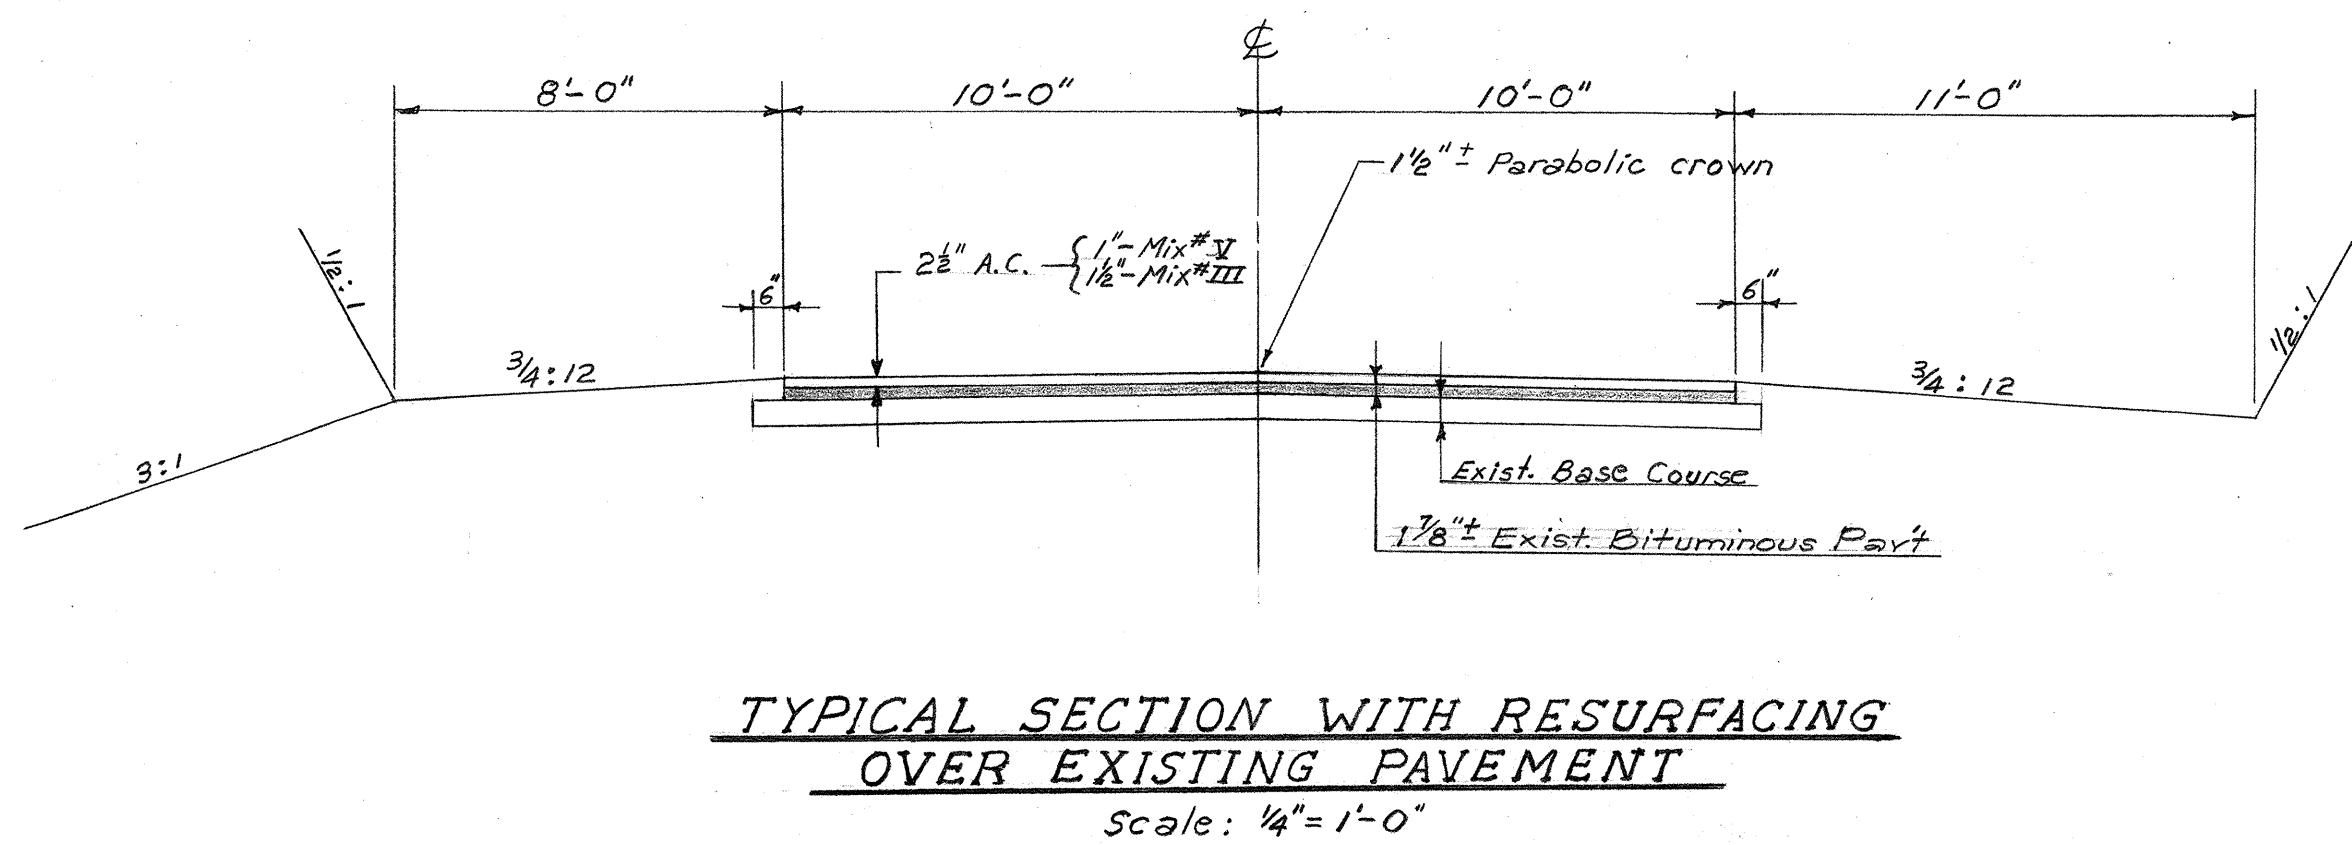


FED. ROAD DIST. NO.	STATE	FED. AID PROJ. NO.	FISCAL YEAR	SHEET NO.	TOTAL SHEETS
HAWAII	HAW	DF-082-1(1)	1958	2	3

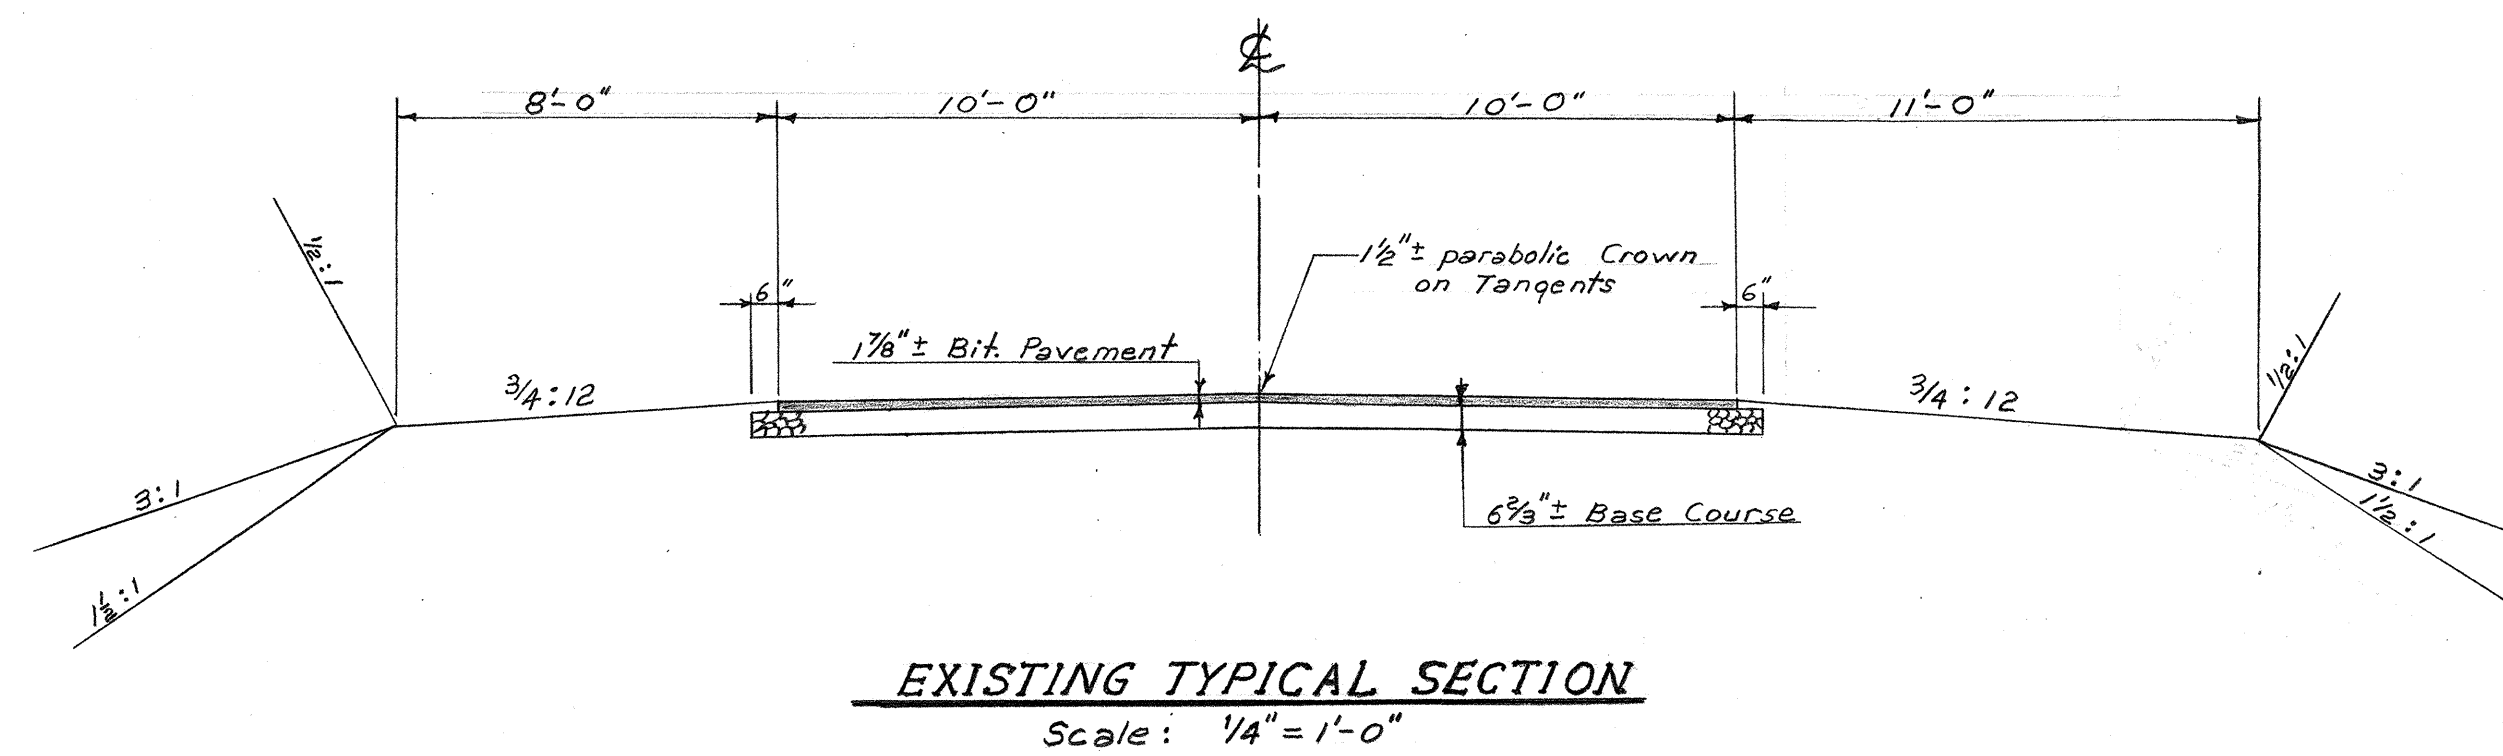

NOTE:

- Contractor shall provide smooth riding connection to existing pavt at Beginning & End of Project, and at Side Road connections.
- Work on shoulders to be done by others.

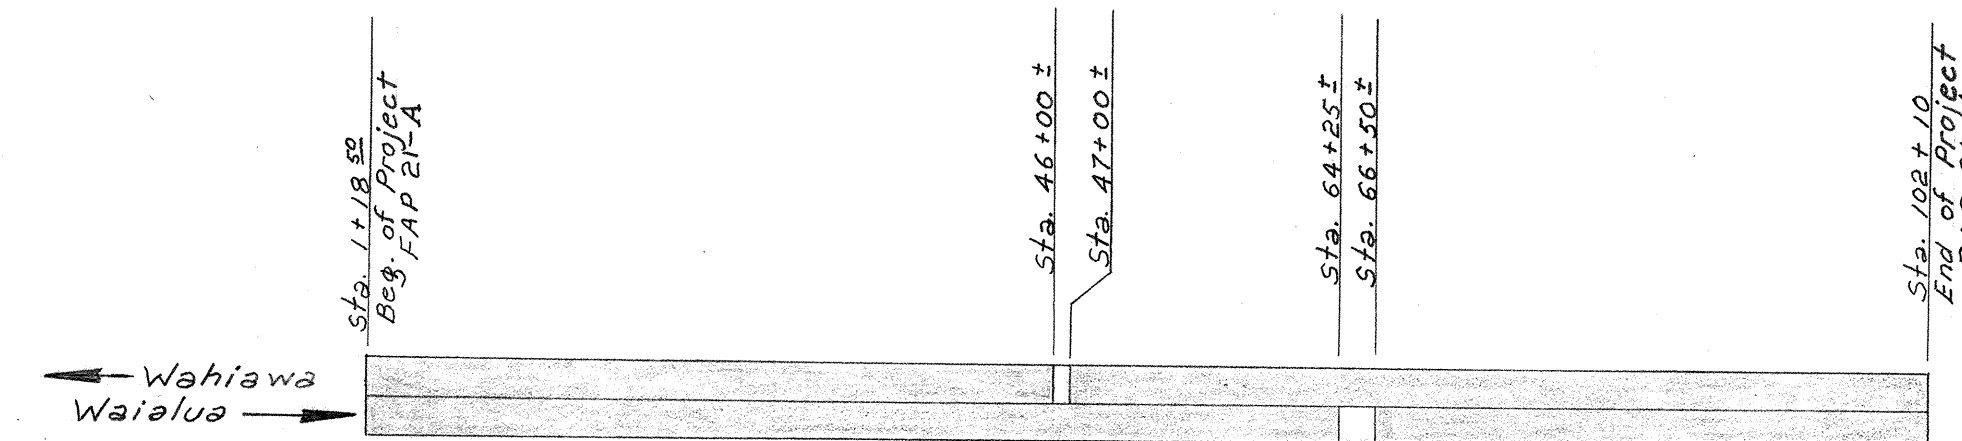

LEGEND

- Section to be resurfaced only.
- Section requiring new base course and resurfacing.

TERRITORIAL HIGHWAY DEPARTMENT
TERRITORY OF HAWAII

TYPICAL ROAD SECTIONS
FED. AID PROJ. NO DF-082-1(1)
(OLD PAP 21-A)

SCALE: AS NOTED Oct. 1958

SHEET NO. OF SHEETS

S 8136.2

SURVEY PLOTTED BY	DATE
DESIGNED BY	
DRAWN BY	
CHECKED BY	
QUANTITIES CHECKED BY	
NOTE BOOK	
NO.	