


INDEX TO DRAWINGS	
SHEET NO.	DESCRIPTION
1	TITLE SHEET
2 - 4	PLAN
5	STANDARD DETAILS

STATE OF HAWAII
DEPARTMENT OF TRANSPORTATION
BUREAU OF HIGHWAYS
HONOLULU, HAWAII
"AS-BUILT"
PLANS OF
INTERCONNECTED TRAFFIC SIGNAL SYSTEM
ON KAMEHAMEHA HIGHWAY AT OLIVE AVE.
AND KILANI AVE.- WAHIAWA, OAHU, HAWAII

PROJECT No. A 80-01-60
(OLIVE AVE.)
AND
PROJECT No. B 80-01-60
(KILANI AVE.)

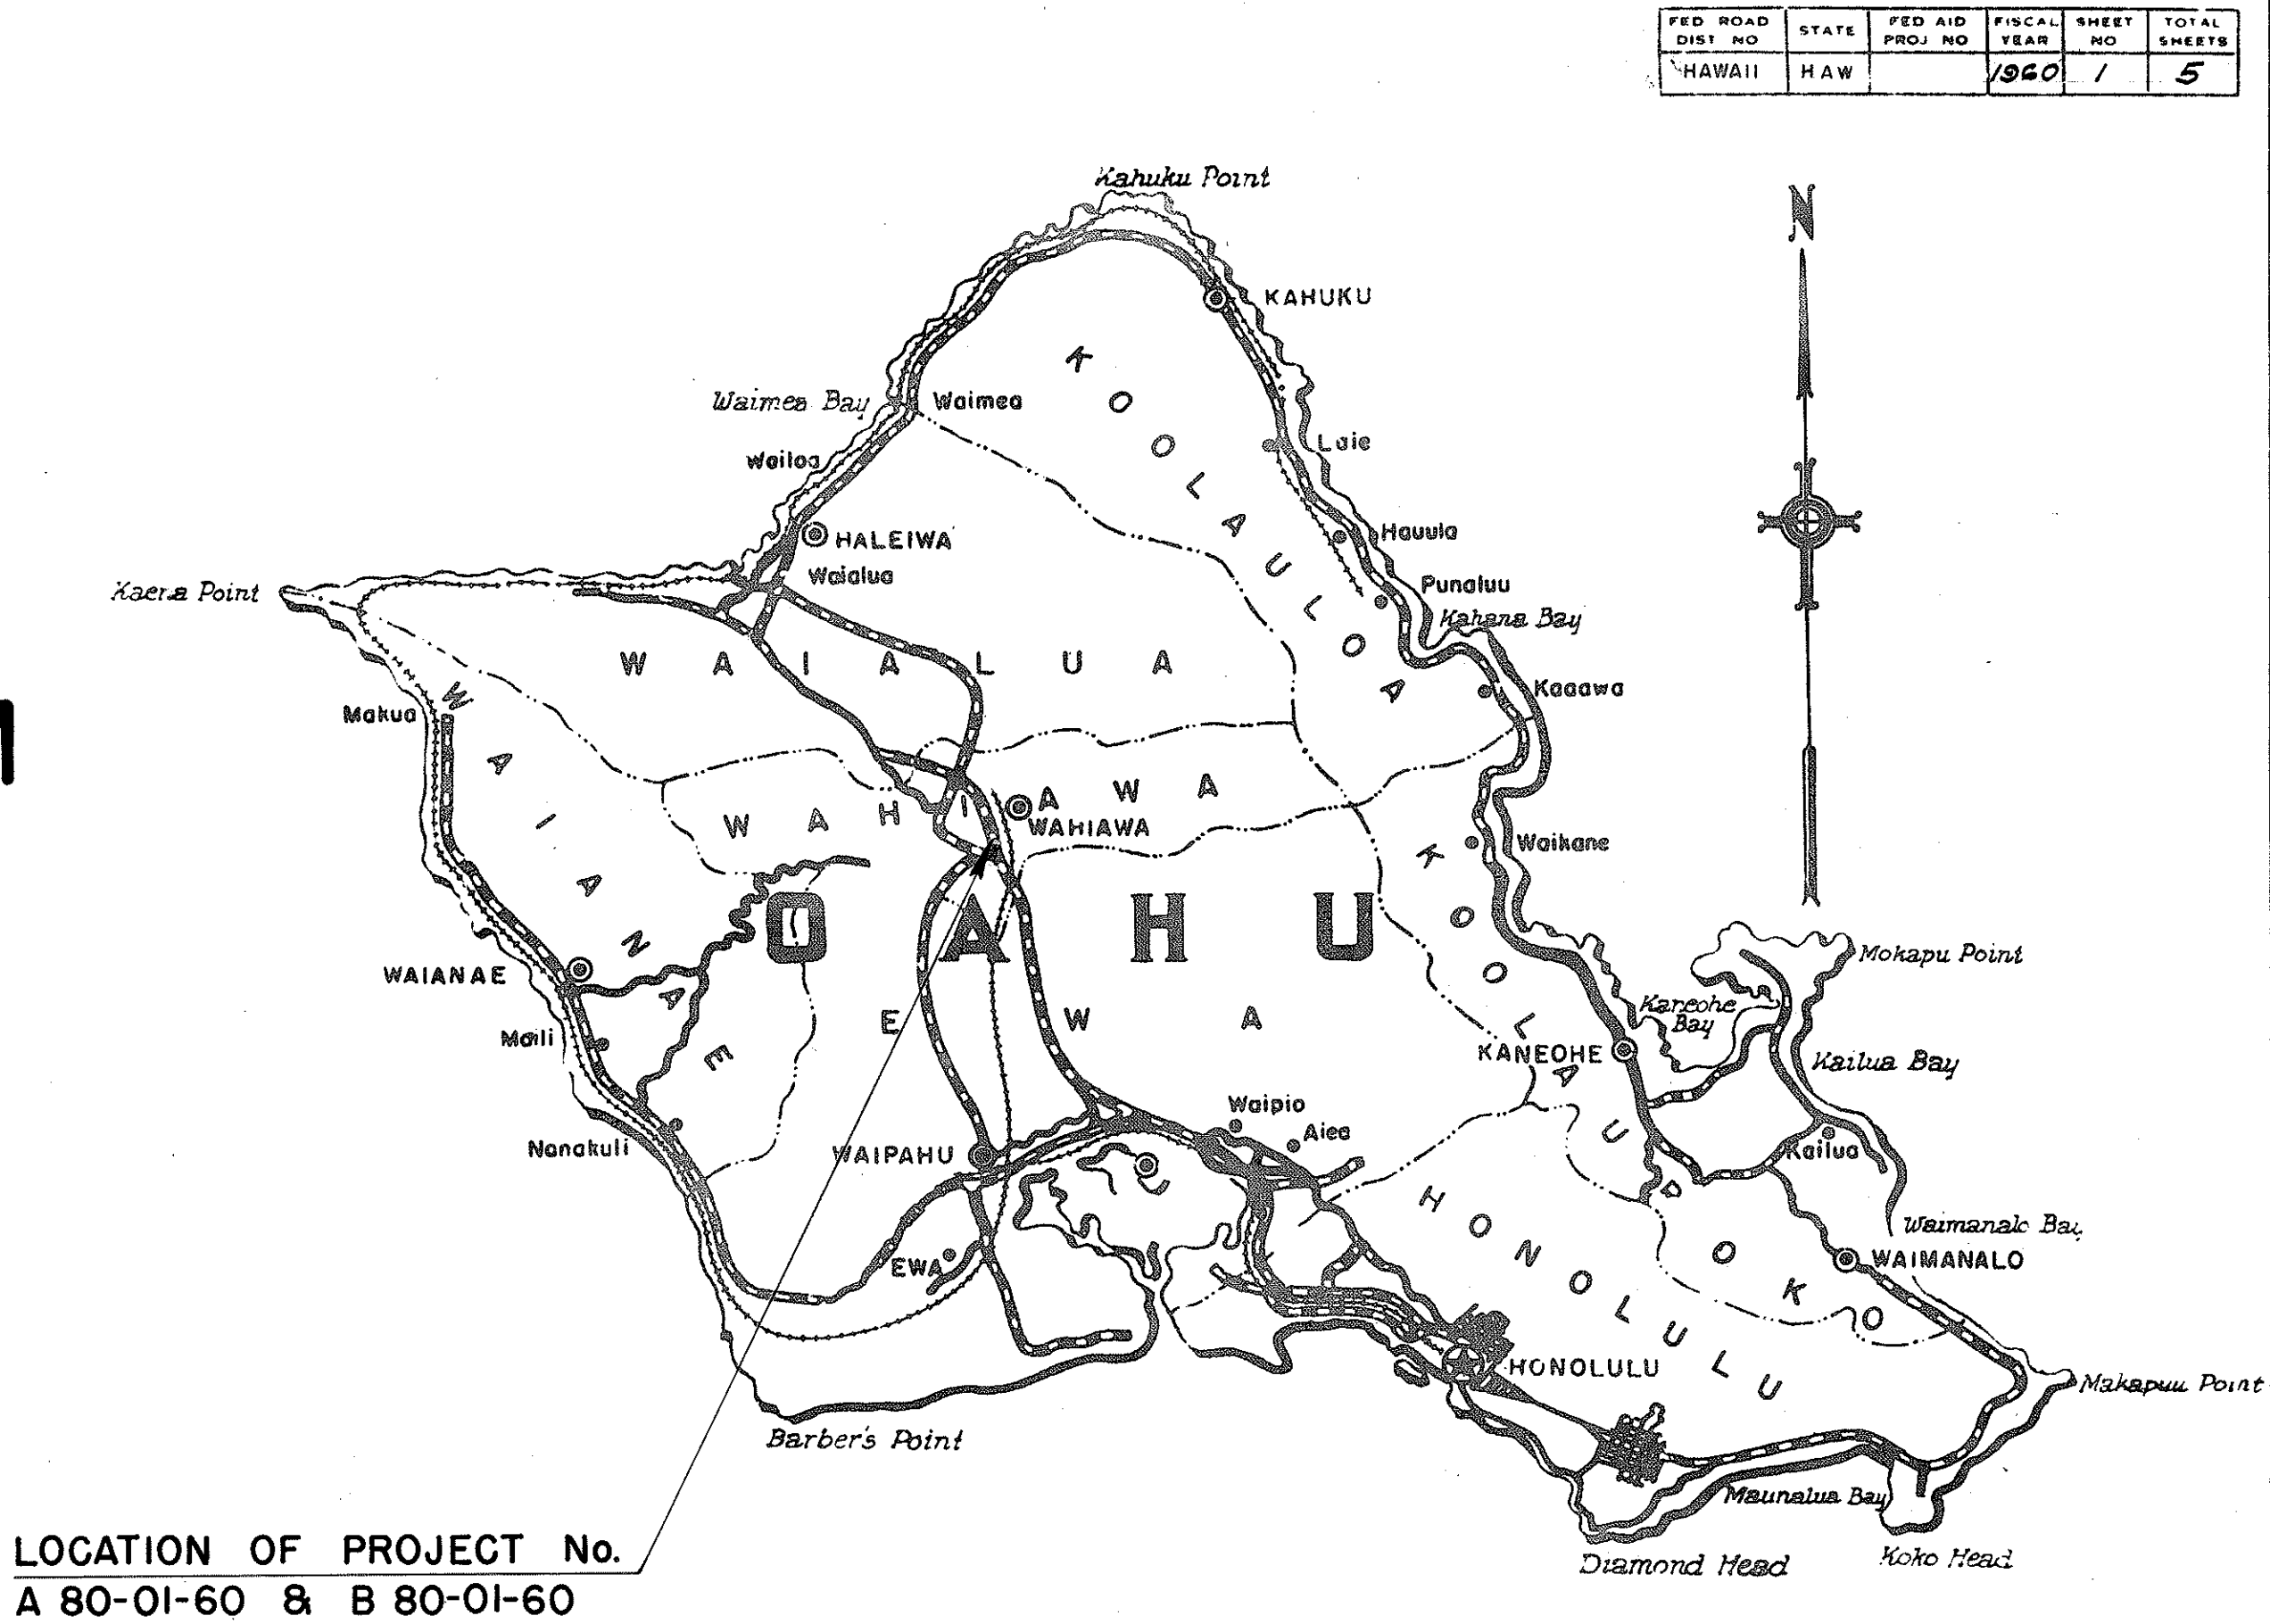

Federal Aid Projects Previously Constructed Or Under Construction

NO CHANGES WERE MADE DURING CONSTRUCTION
ON THESE PLANS EXCEPT CHANGES IN THE
ORIGINAL THEORETICAL QUANTITIES. FOR ACTUAL
QUANTITIES, REFER TO PROJECT LEDGER AND/OR
COMPUTATION BOOK.


R. T. Samsi
for RESIDENT ENGINEER

11-9-81
DATE

APPROVED:
DATE 2/19/60

DIRECTOR OF TRANSPORTATION

ORIGINAL	SURVEY PLOTTED BY	DATE
PLAN	DESIGNED BY	
NOTE BOOK	TRACED BY	
	QUANTITIES BY	
	CHECKED BY	
	CHECKED BY	

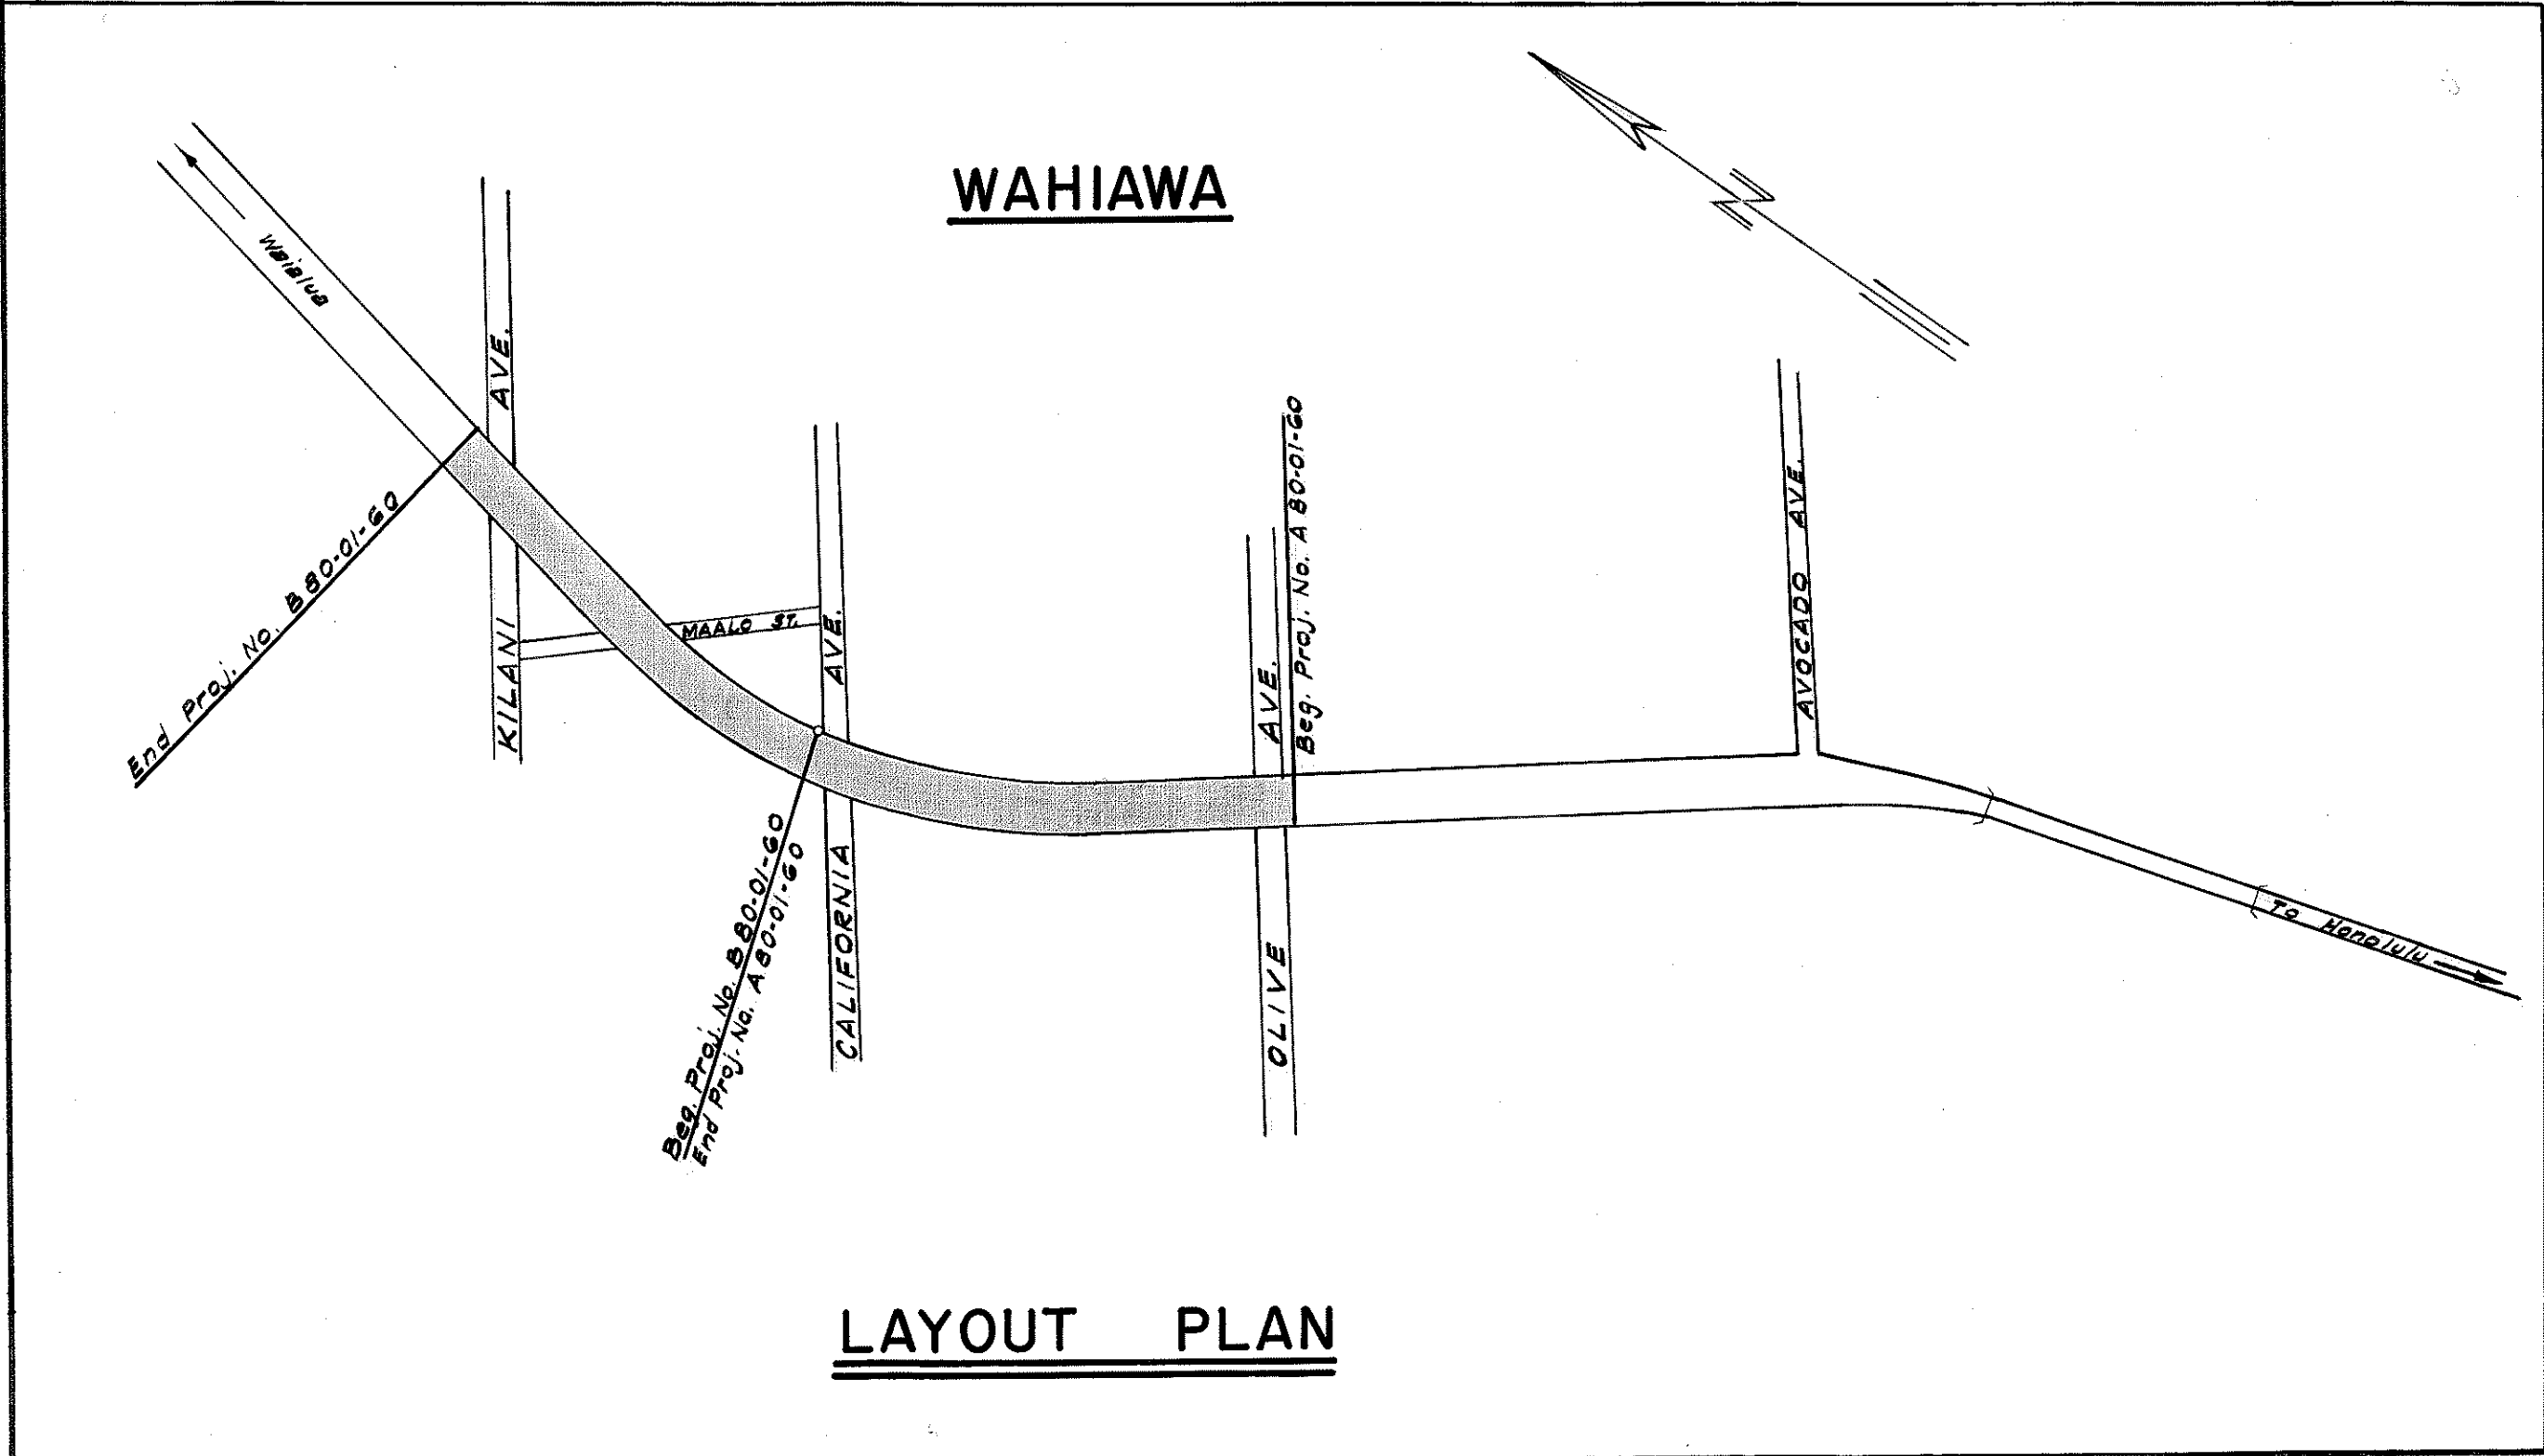

LAYOUT PLAN