11	NDEX TO DRA	WINGS
SHEET NO.	DESCRIPTION	
	TITLE SHEET	
2 - 5	ROADWAY	PLANS
6	PAVEMENT	MARKER DET.
		: 4:
	,	
		,
	ATTO-000-000-000-000-000-000-000-000-000-	

STATE OF HAWAII


DEPARTMENT OF TRANSPORTATION
HIGHWAYS DIVISION


HONOLULU, HAWAII

"AS BUILT"
PLANS FOR

RESURFACING A PORTION OF
KAMEHAMEHA HIGHWAY AND WILIKINA DRIVE
WHEELER AIRFIELD TOWARD KAMANANUI ROAD
PROJECT NO. 99C-02-67

DISTRICT OF WAHIAWA ISLAND OF OAHU

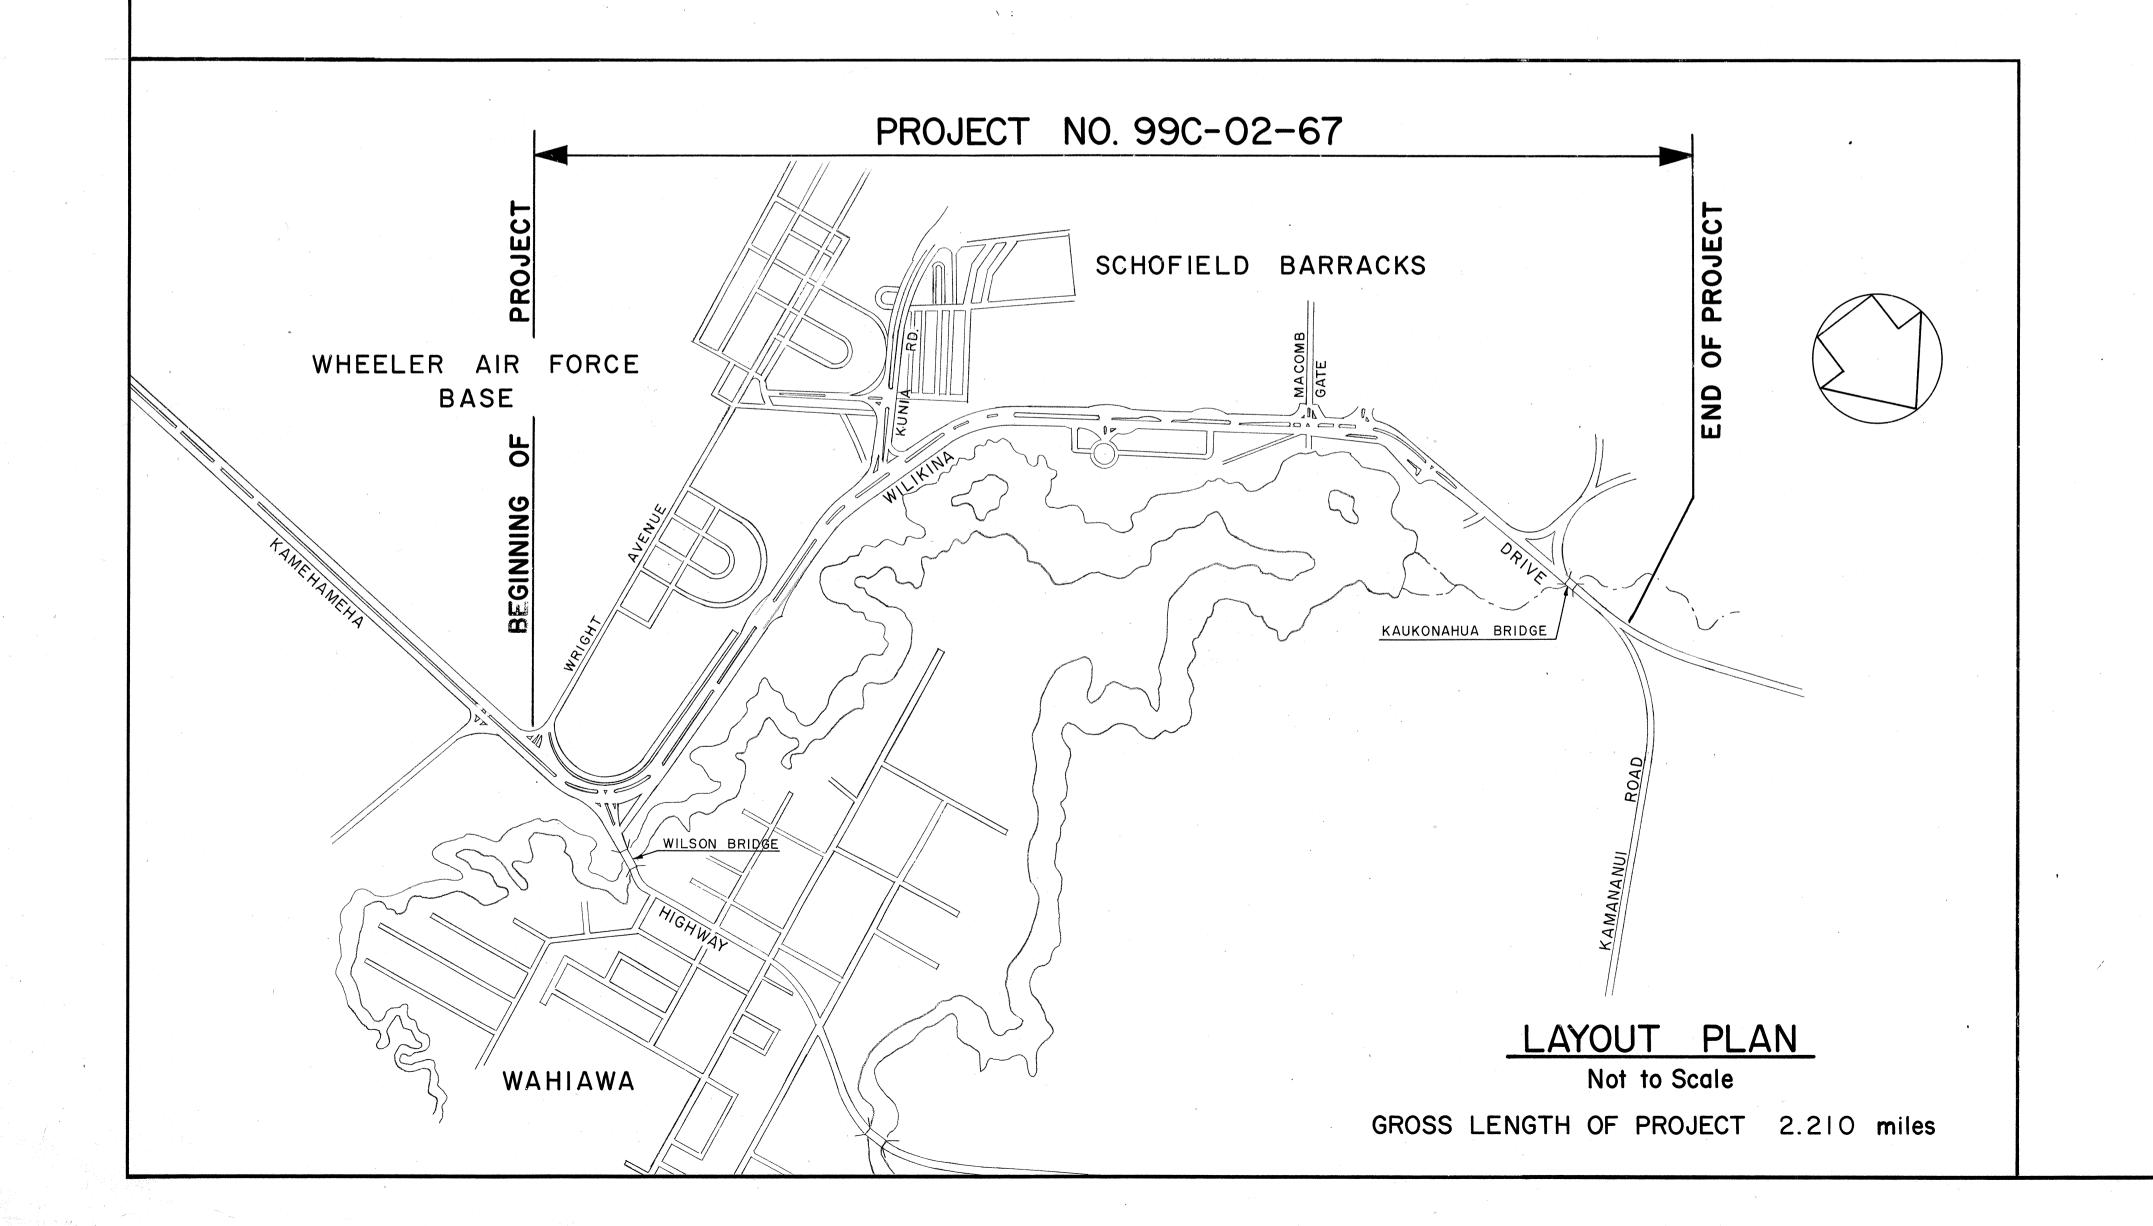

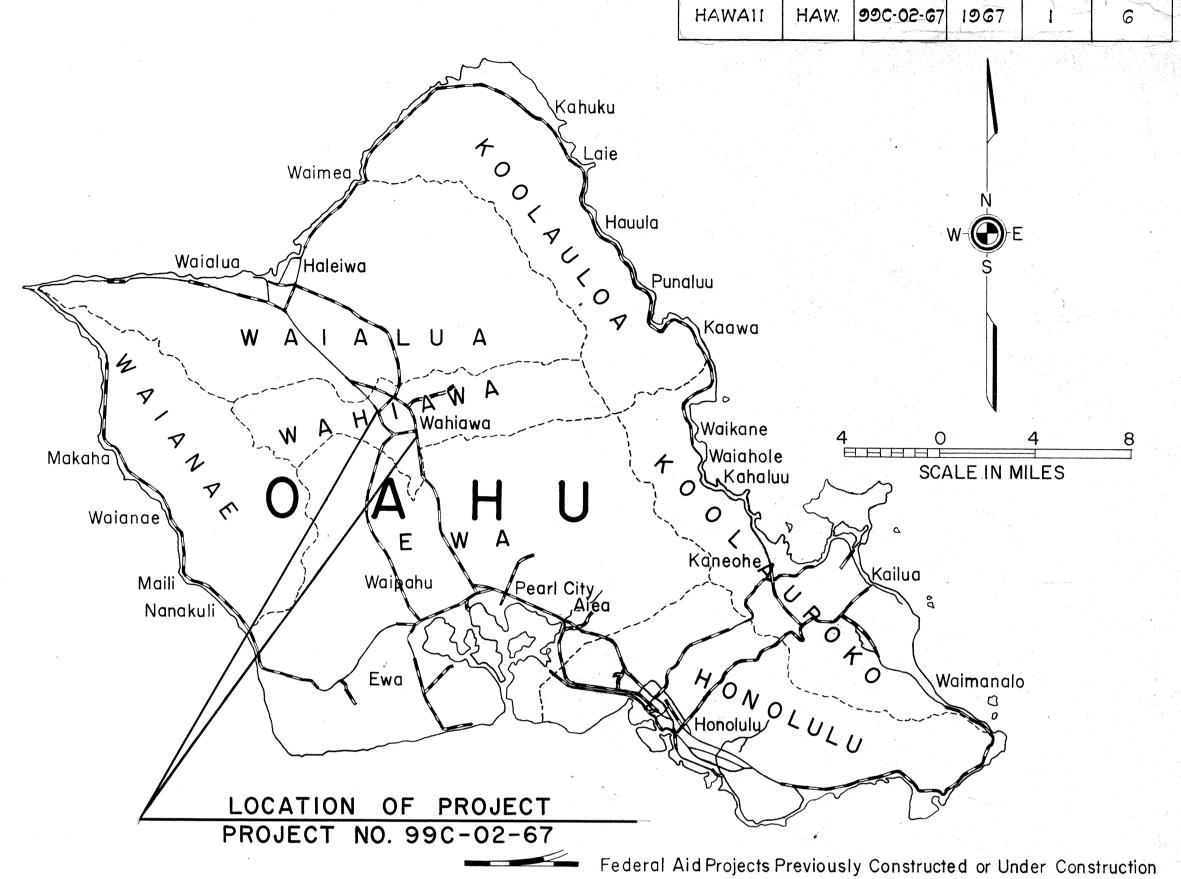

NOTE:

ALL CHANGES MADE DURING CONSTRUCTION HAVE BEEN NOTED ON THESE TRACINGS IN RED AND CHECKED BY:

PROJECT ENGINEER

11-13-67

DATE

DEPARTMENT OF TRANSPORTATION
STATE OF HAWAII

FED. ROAD STATE PROJ. NO. FISCAL SHEET TOTAL SHEETS

APPROVED:

POUR OF TRANSPORTATION DATE