
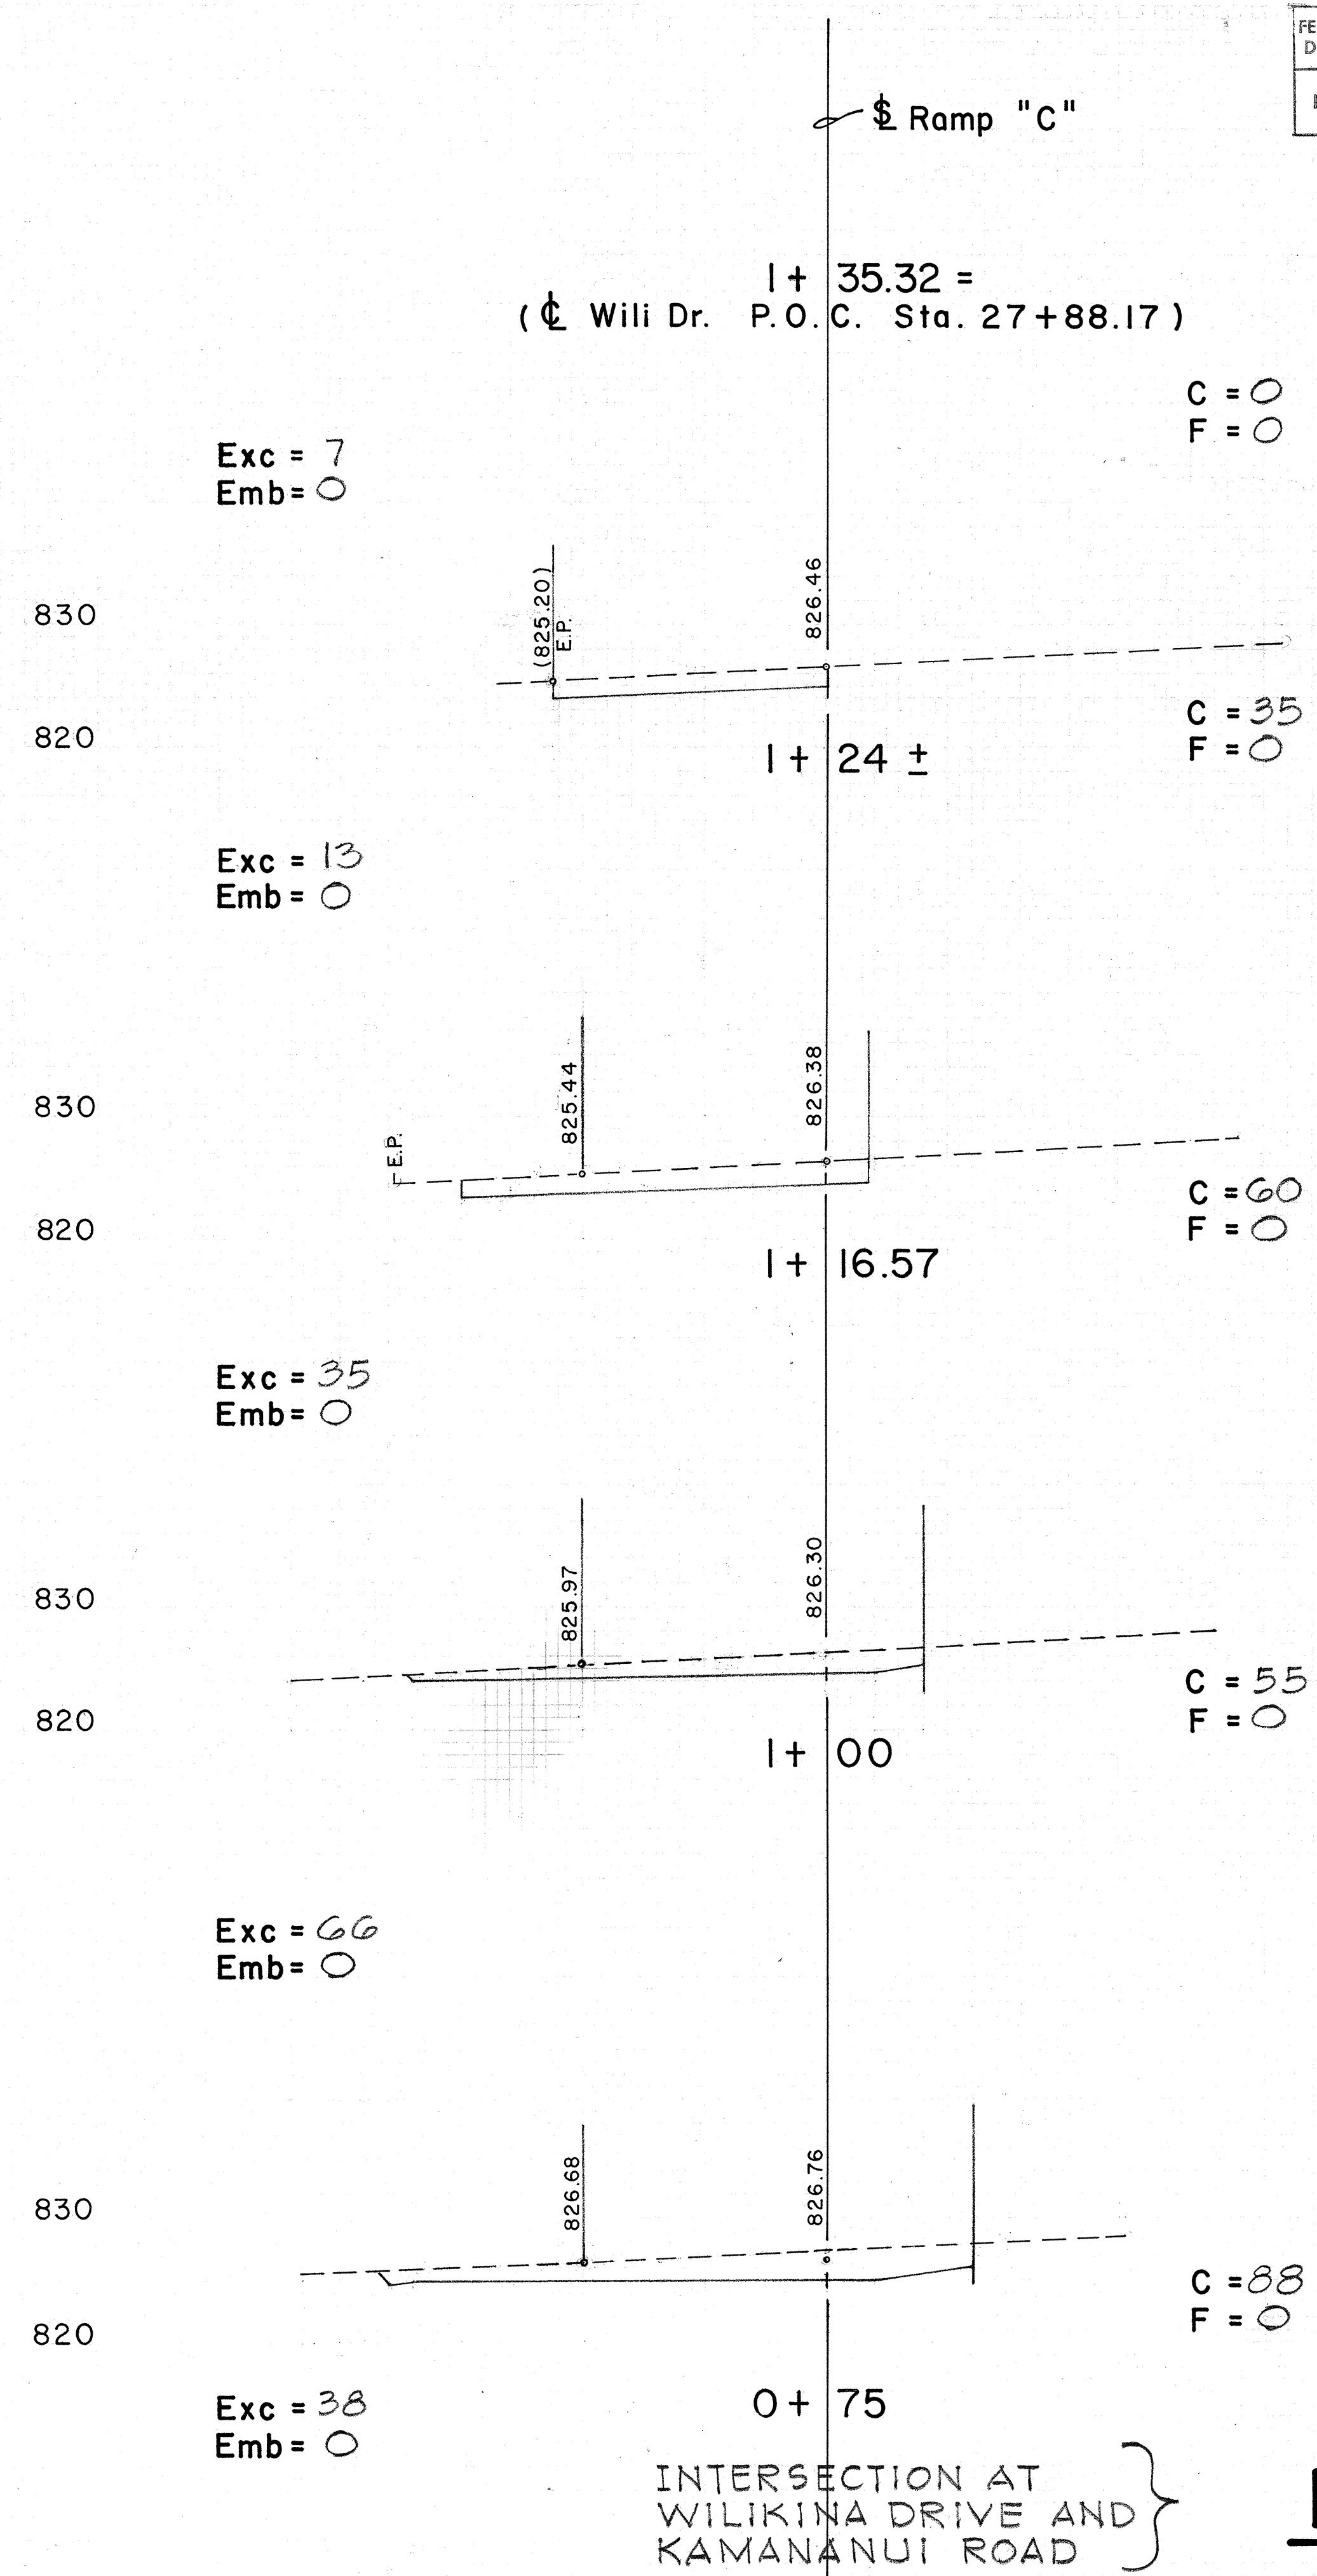


NOTE: Grades shown in parenthesis denote existing grades

FED. ROAD DIST. NO.	STATE	FED. AID PROJ. NO.	FISCAL YEAR	SHEET NO.	TOTAL SHEETS
HAWAII	HAW.	F-099-1(3)	1968	15	16

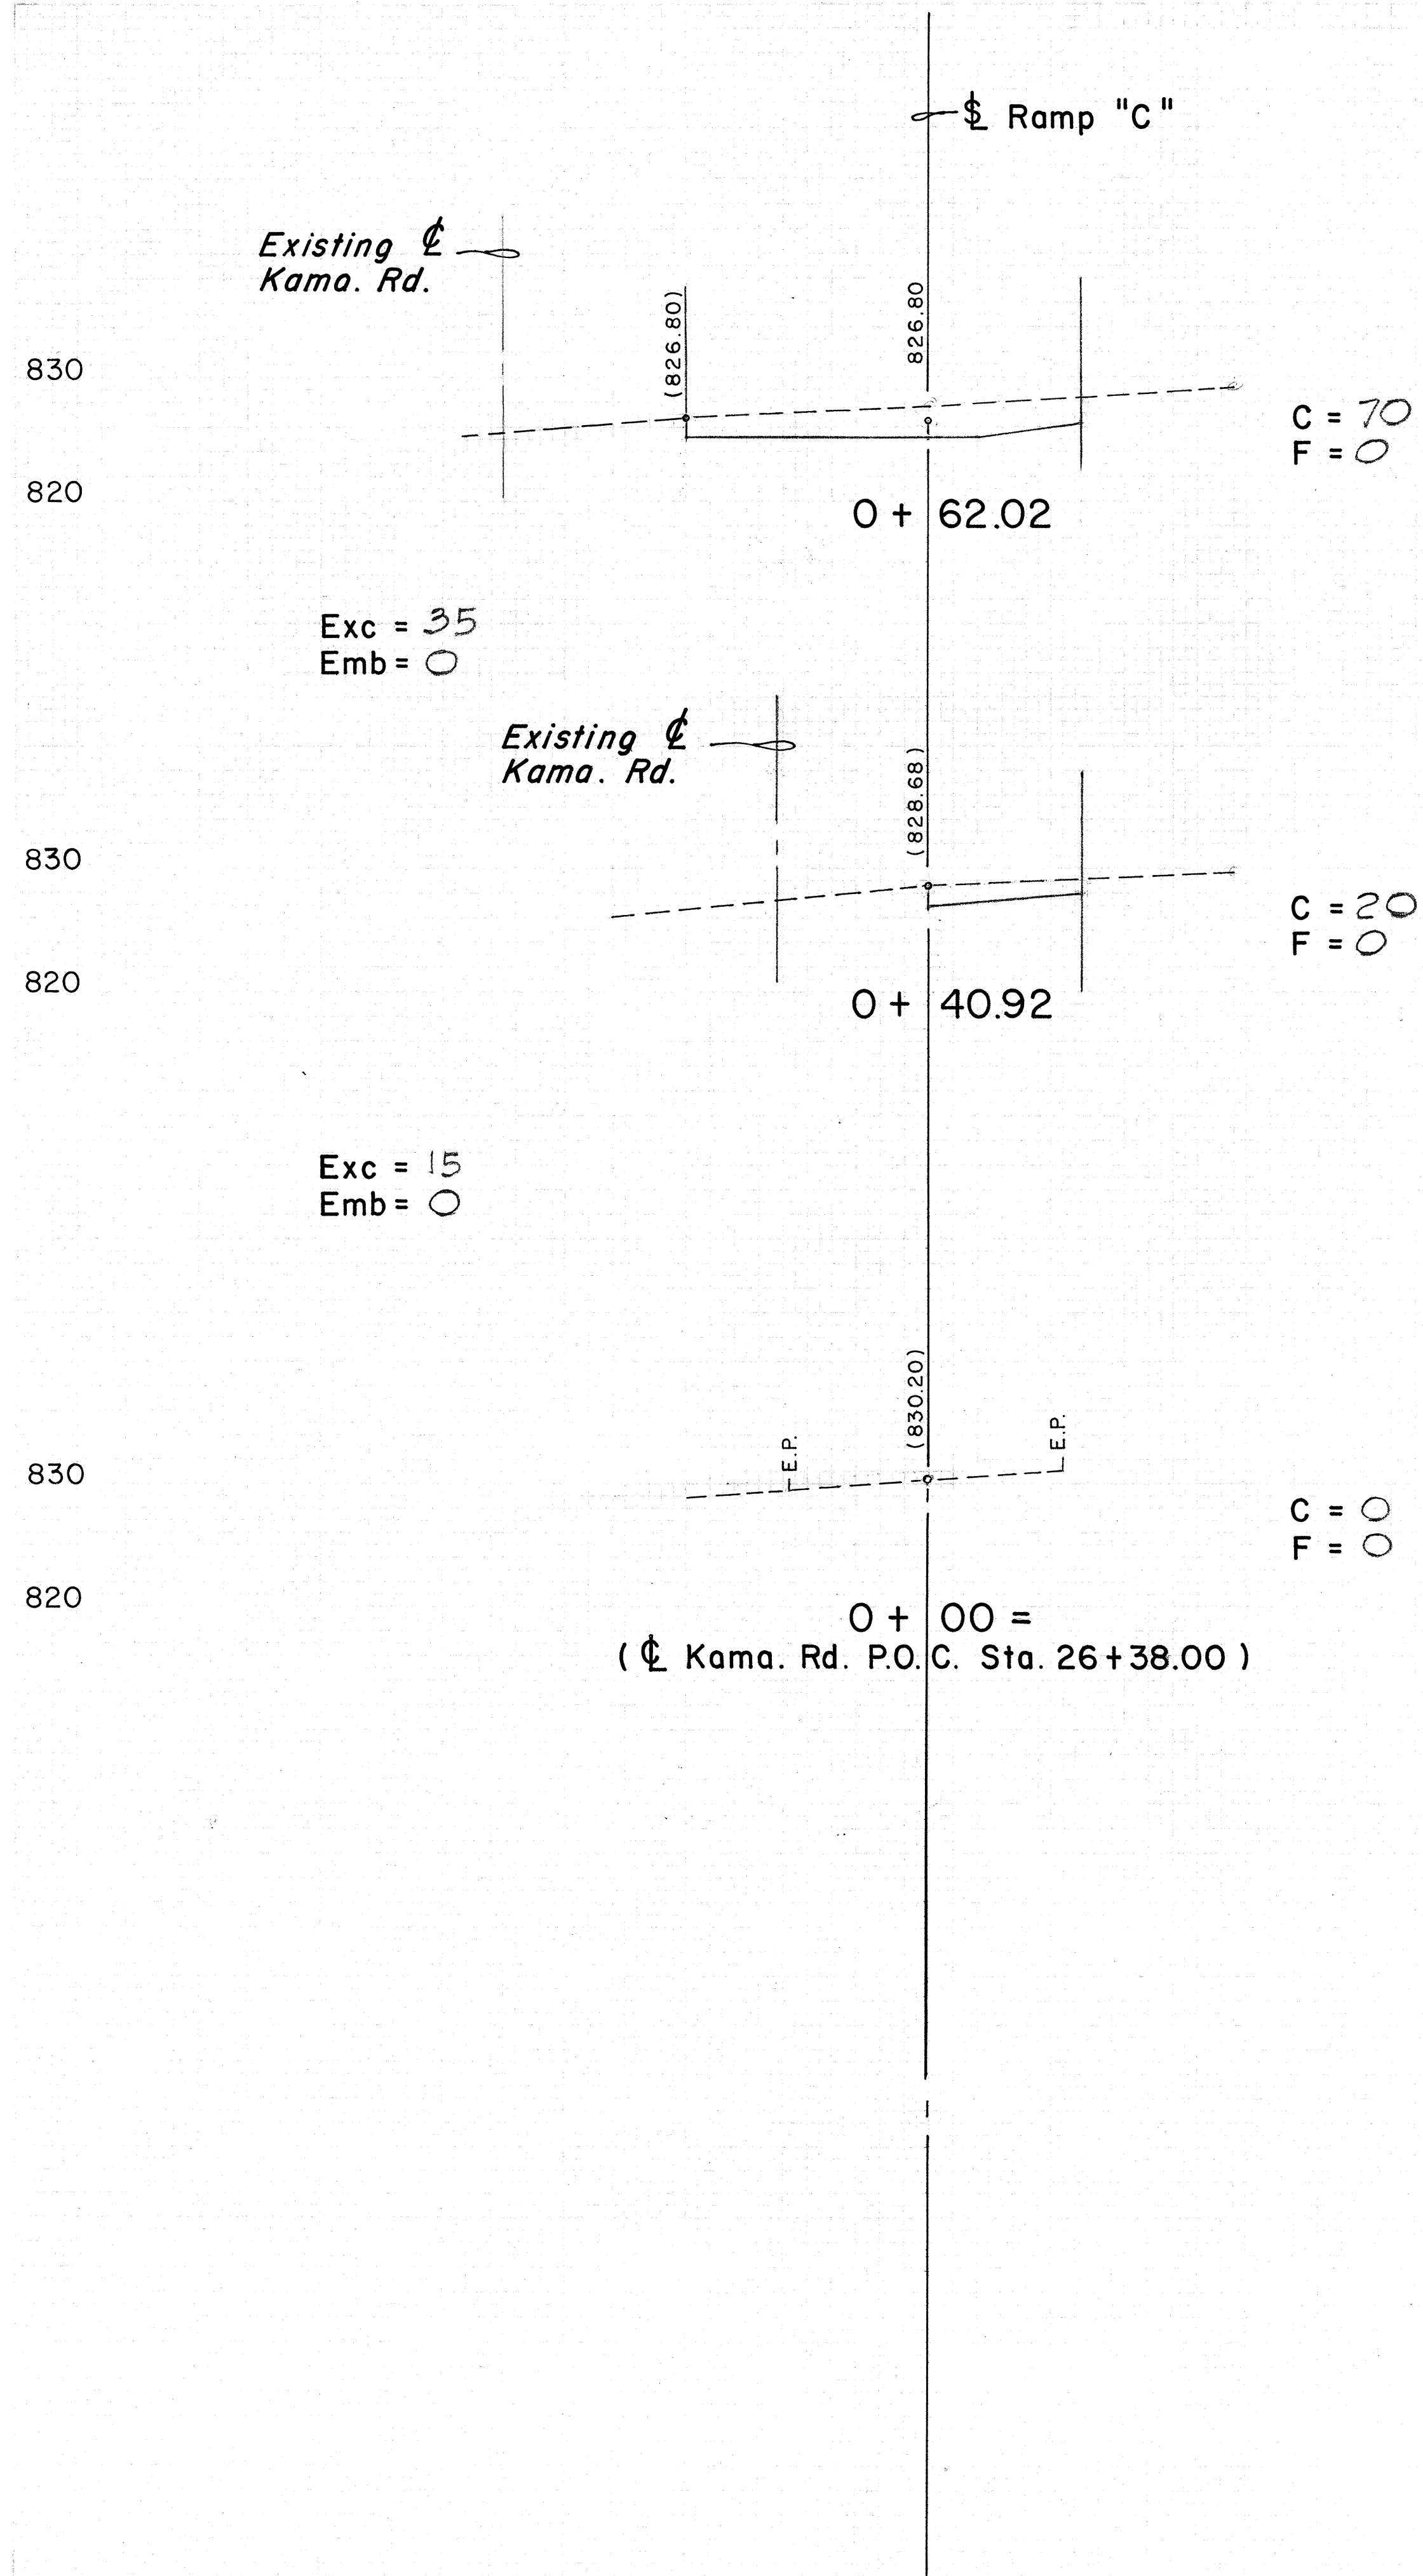

RAMP "C"

FED. ROAD DIST. NO.	STATE	FED. AID PROJ. NO.	FISCAL YEAR	SHEET NO.	TOTAL SHEETS
HAWAII	HAW.	F-099-1(3)	1968	16	16

NOTE: Grades shown in parenthesis denote existing grades.

