


INDEX TO DRAWINGS	
SHEET NO.	DESCRIPTION
1	TITLE SHEET
2	TYPICAL SECTIONS
3-4	PLAN AND PROFILE
5-6	DETAIL PLAN OF ROADWAY
7-13	STANDARD DETAILS
14-16	CROSS SECTIONS

STATE OF HAWAII  
DEPARTMENT OF TRANSPORTATION  
HIGHWAYS DIVISION  
  
PLANS OF  
  
SAFETY IMPROVEMENTS OF INTERSECTIONS AT  
  
KAMEHAMEHA HIGHWAY AND KAMANANUI ROAD;  
  
AND  
  
WILIKINA DRIVE AND KAMANANUI ROAD  
  
FEDERAL AID PROJECT NO. F-099-1(3)

DISTRICT OF WAHIAWA  
ISLAND OF OAHU  
  
" AS BUILT "

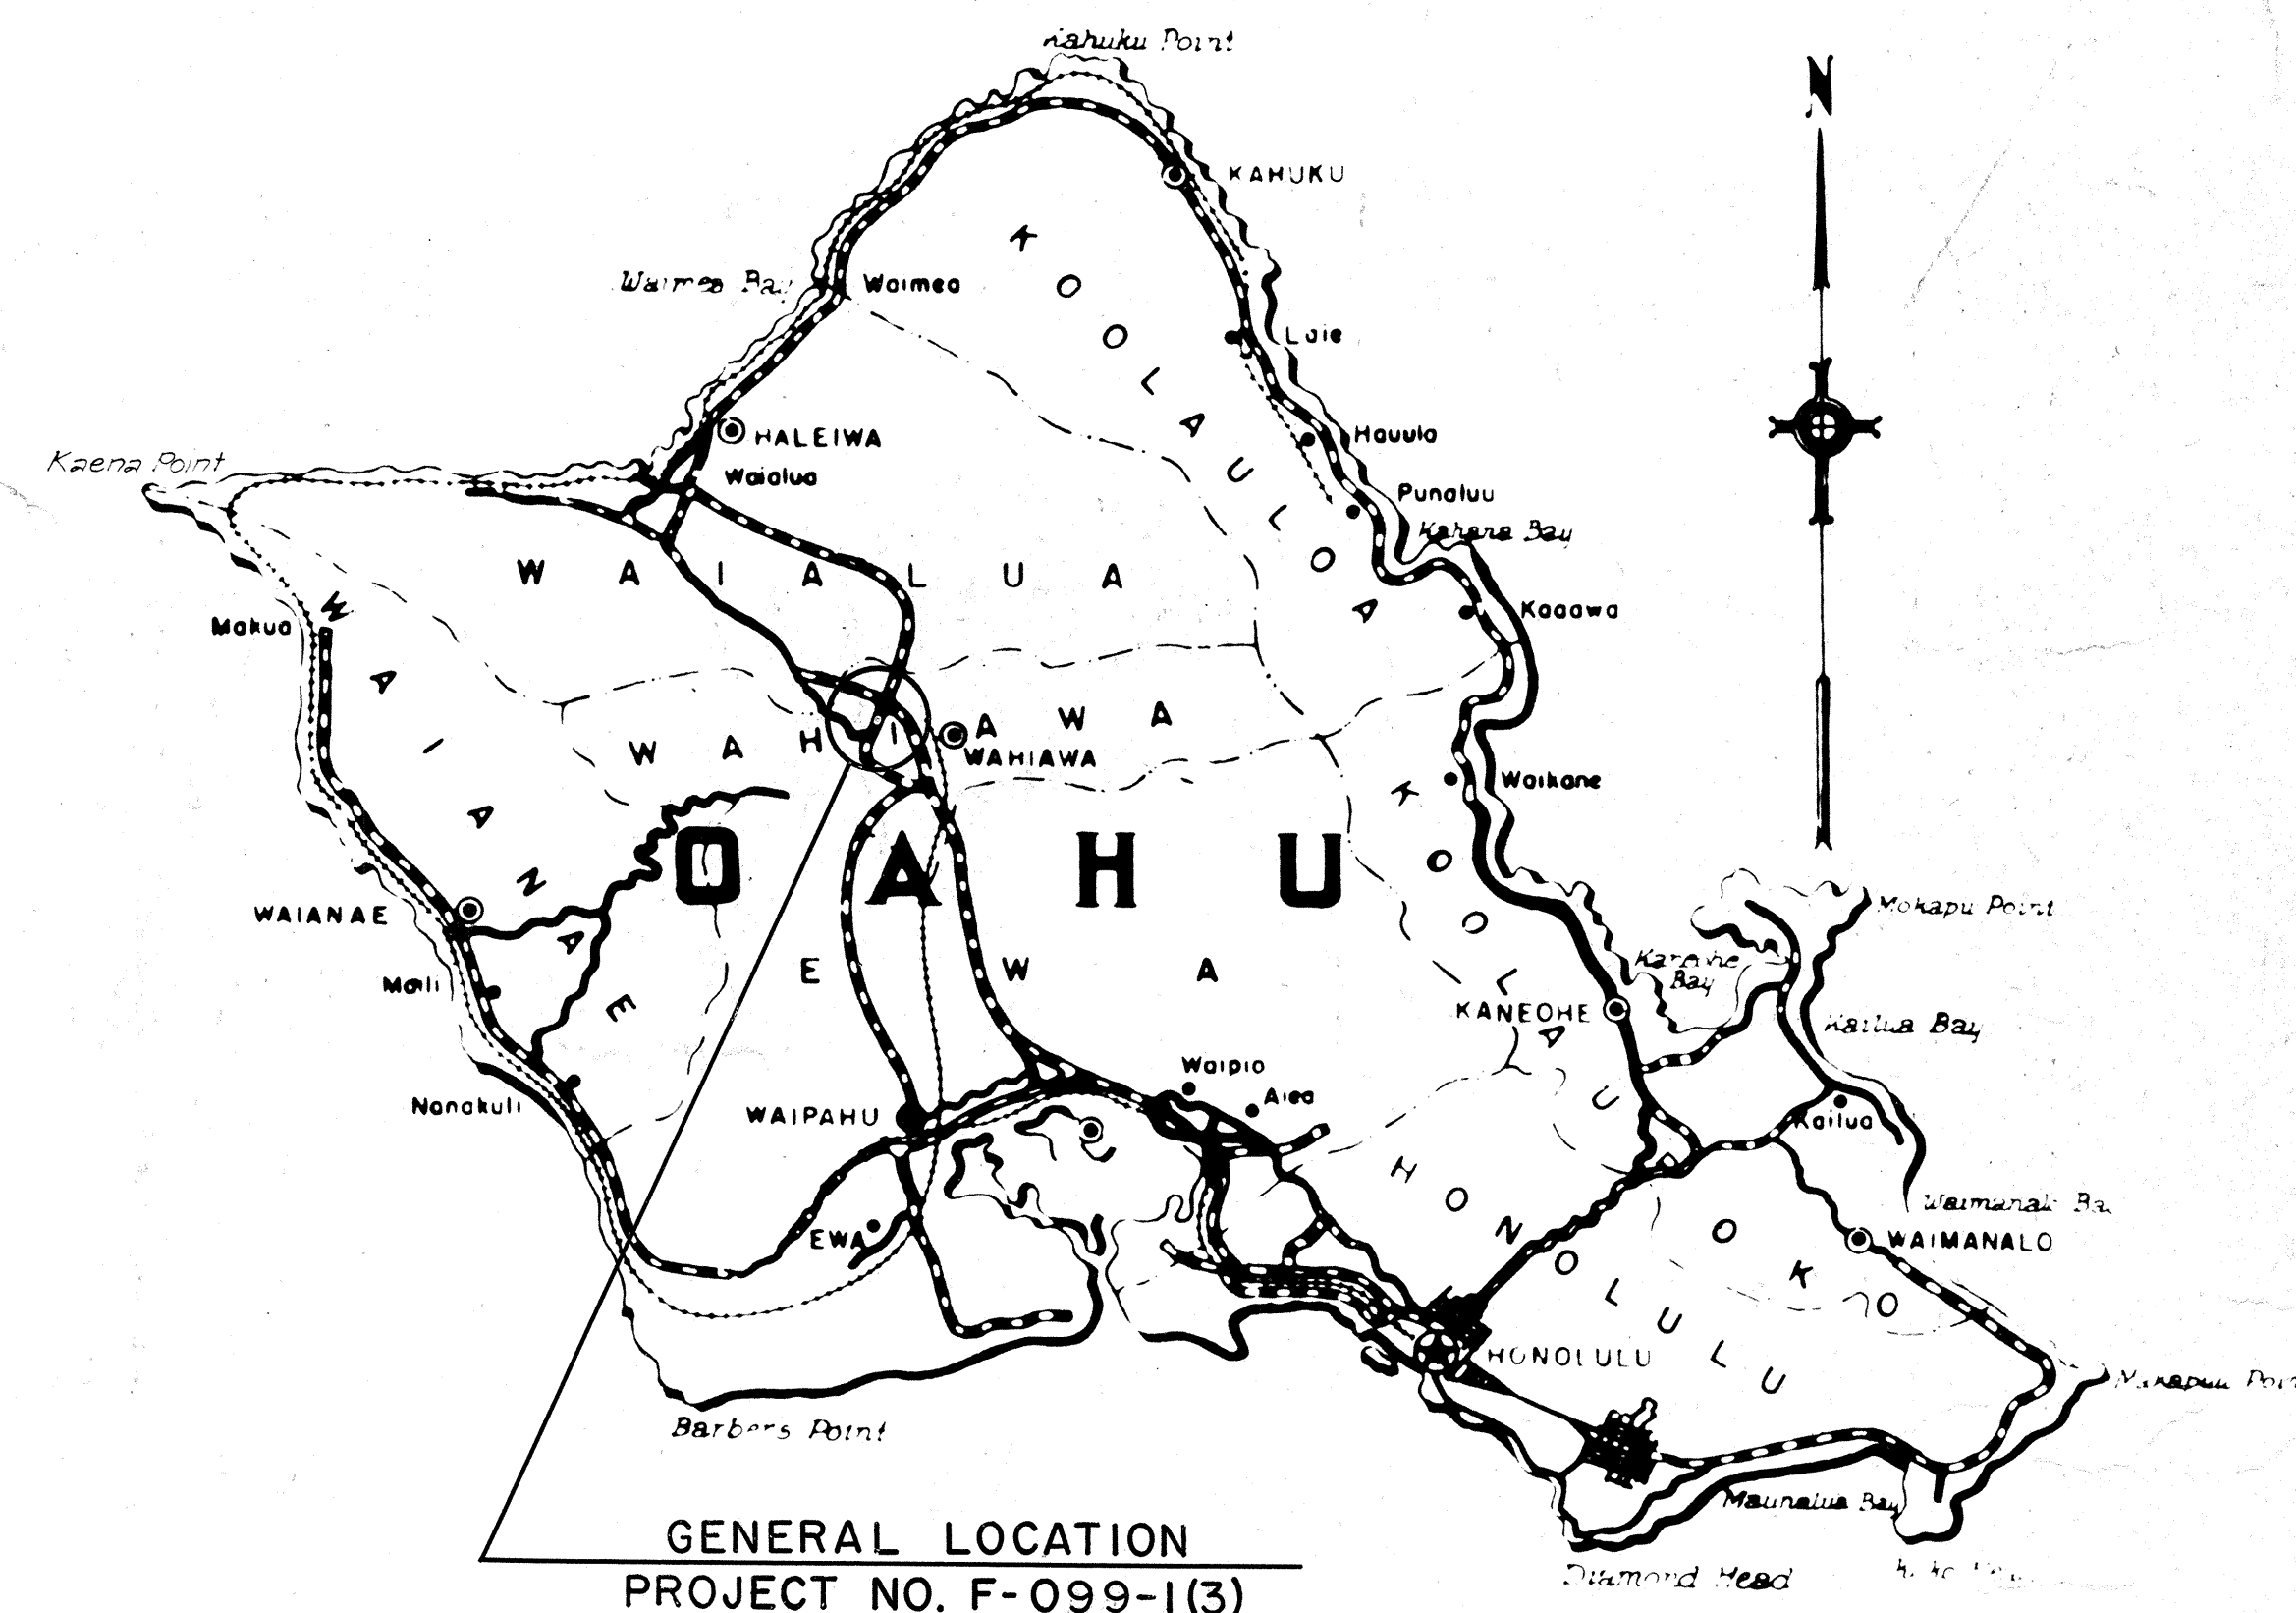

Federal Aid Projects Previously Constructed Or Under Construction

DESIGN CLASSIFICATION	
ADT (1967).....	3360
DESIGN ADT (1987).....	4190
DHVV.....	13%
D.....	65/35
T.....	4%
V.....	35m.p.h.

NOTE:  
ALL CHANGES MADE DURING CONSTRUCTION  
HAVE BEEN NOTED IN RED ON THESE TRACINGS  
AND CHECKED BY:

*Badua*  
PROJECT ENGINEER  
  
*Nov 23 1971*  
DATE

APPROVED DATE *9/29/67*  
  
*John H. Austin*  
DIRECTOR OF TRANSPORTATION

DEPARTMENT OF TRANSPORTATION  
BUREAU OF PUBLIC ROADS  
APPROVED:  
  
*Neil Dillingham*  
FOR DIVISION ENGINEER DATE *7-29-68*

SURVEY PLANNED BY	DATE
DESIGNED BY	
TRACED BY	
QUANTITIES CHECKED BY	
CHECKED BY	

GROSS LENGTH OF PROJECT = 1.256 MI.  
LENGTH OF EXCEPTION = 0.982 MI.  
NET LENGTH OF PROJECT = 0.274 MI.

LAYOUT PLAN