


FED. ROAD DIST. NO.	STATE	PROJ. NO.	FISCAL YEAR	SHEET NO.	TOTAL SHEETS
HAWAII	HAW.	80B-02-68	1968	14	15

DATE: _____ BY: _____
 CHECKED: _____
 SURVEY: _____
 NOTE BOOK: _____
 NO. _____

DATE: _____ BY: _____
 CHECKED: _____
 SURVEY: _____
 NOTE BOOK: _____
 NO. _____




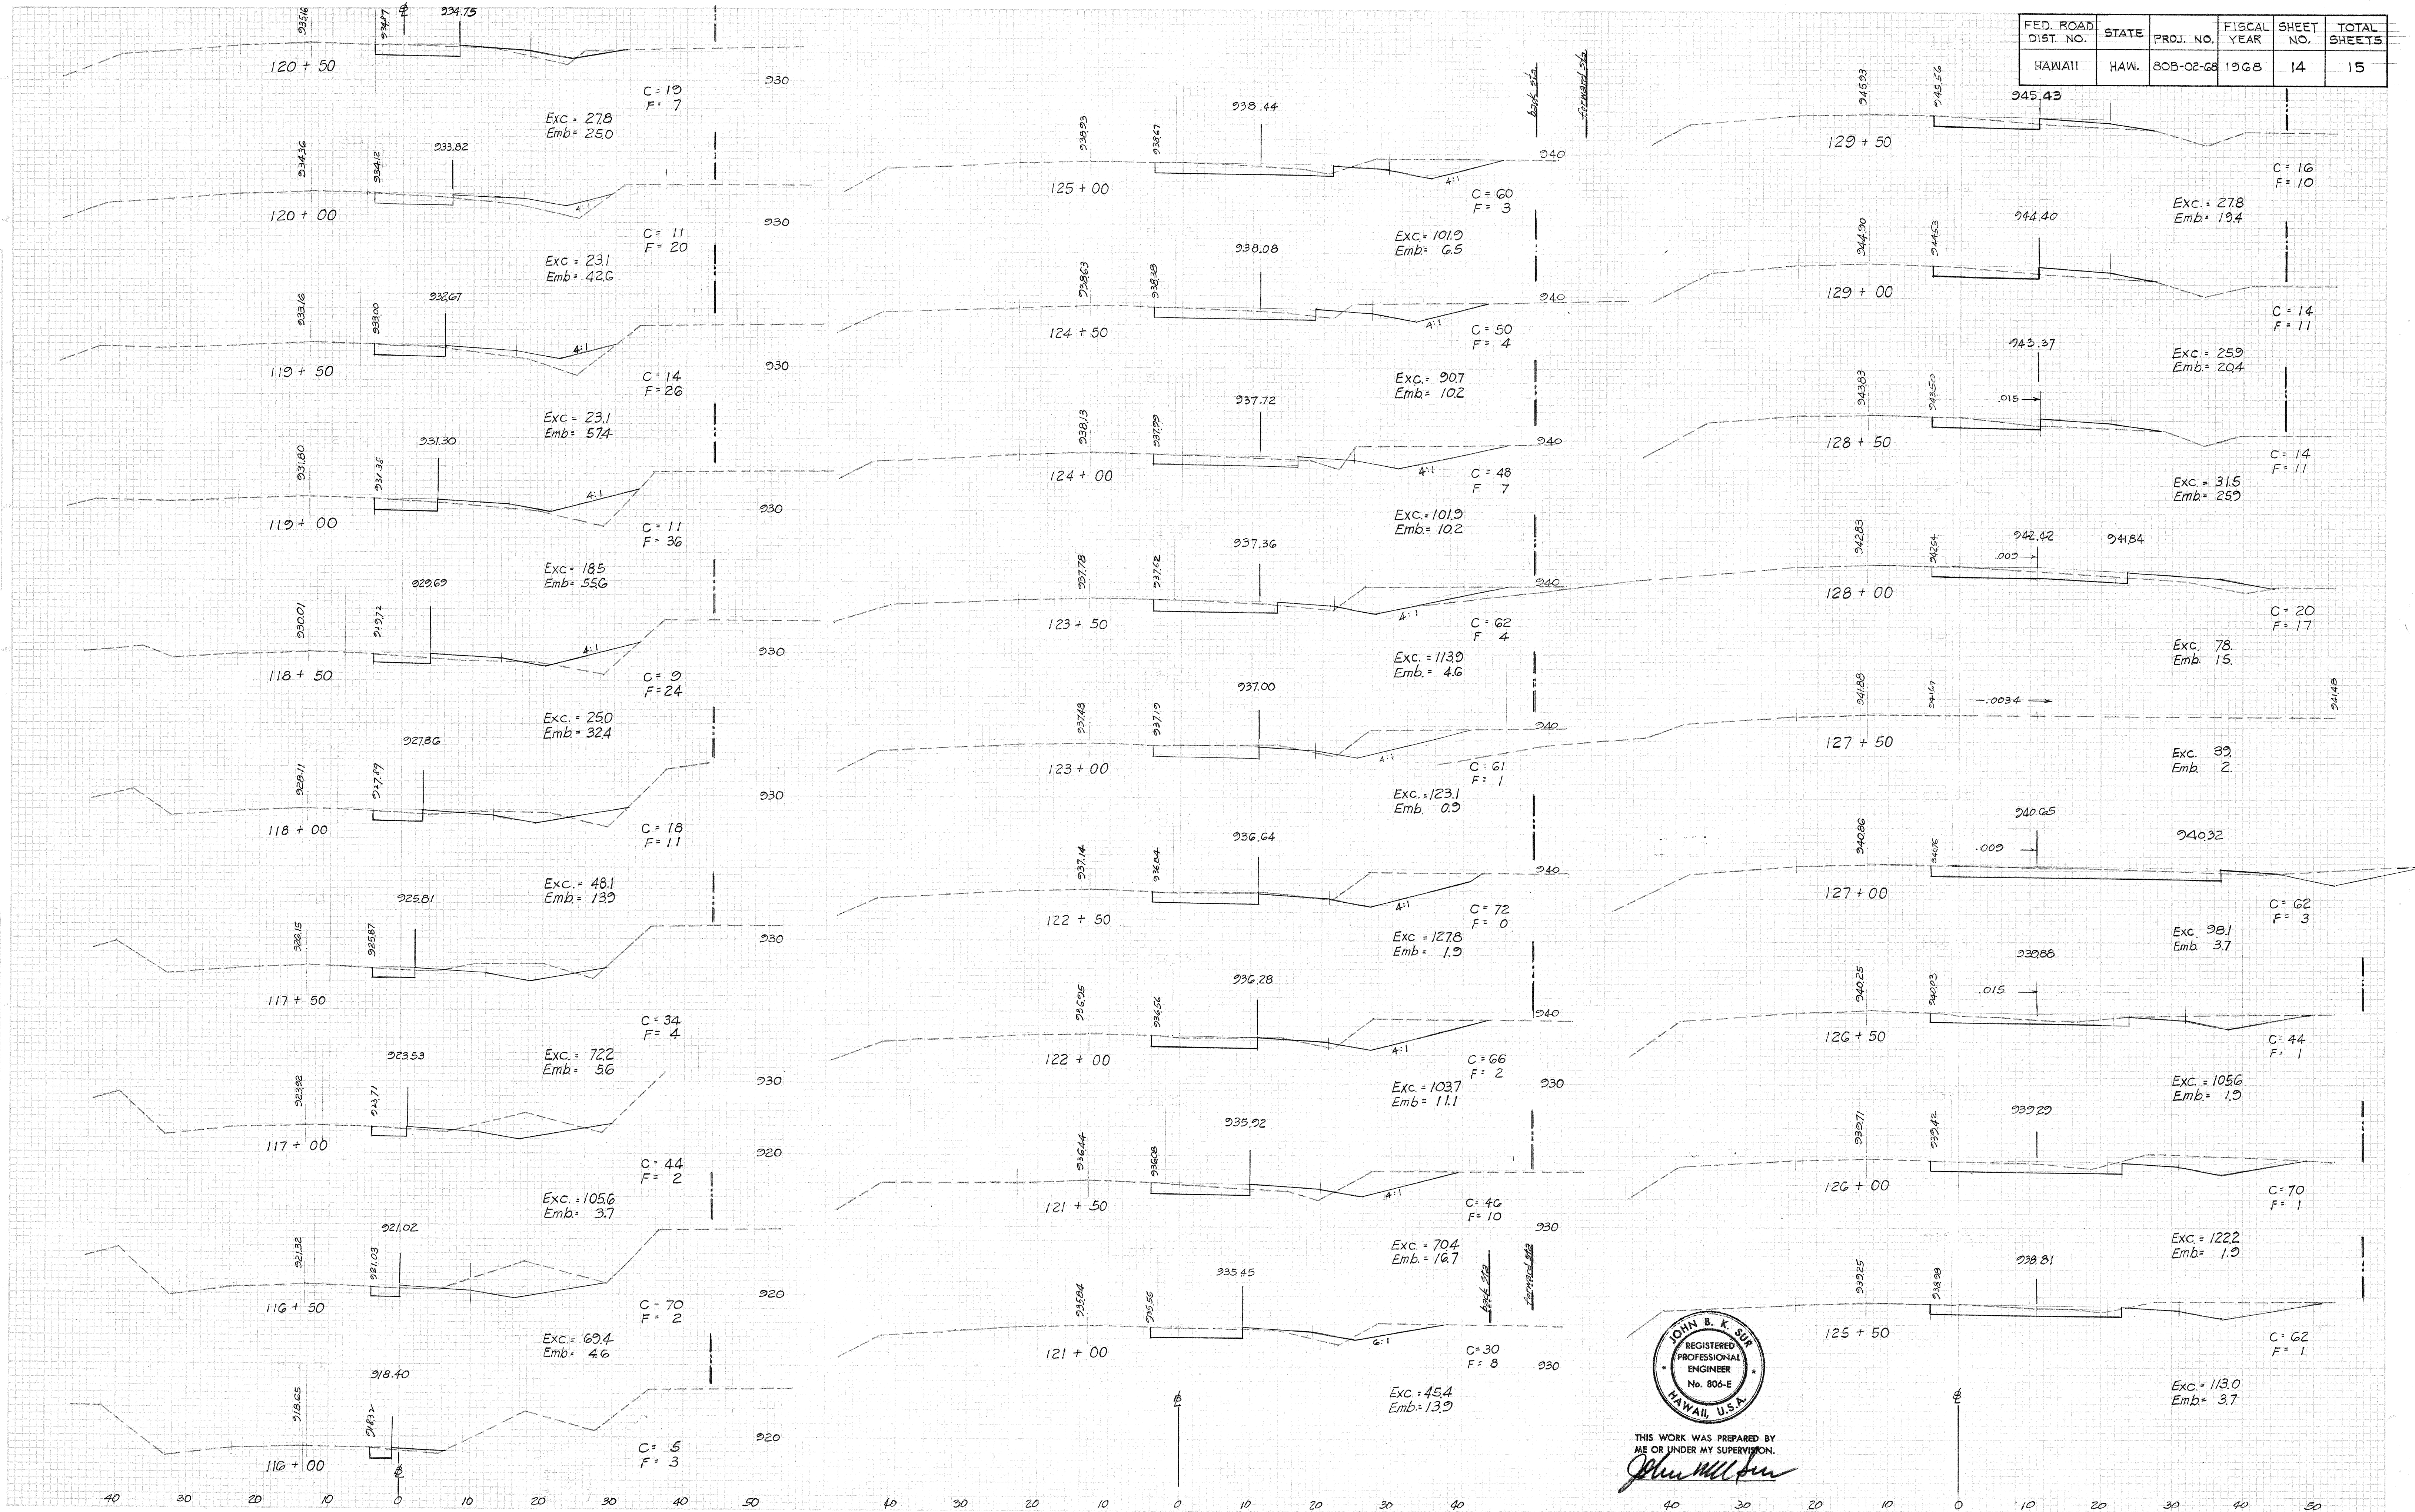


THIS WORK WAS PREPARED BY
 ME OR UNDER MY SUPERVISION.
John B. K. Sun

FED. ROAD DIST. NO.	STATE	PROJ. NO.	FISCAL YEAR	SHEET NO.	TOTAL SHEETS
HAWAII	HAW.	80B-02-68	1968	15	15

FINAL SURVEY
HAWAII
NO. 1000

FINAL SURVEY
HAWAII
NO. 1000

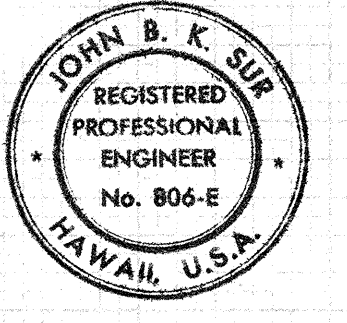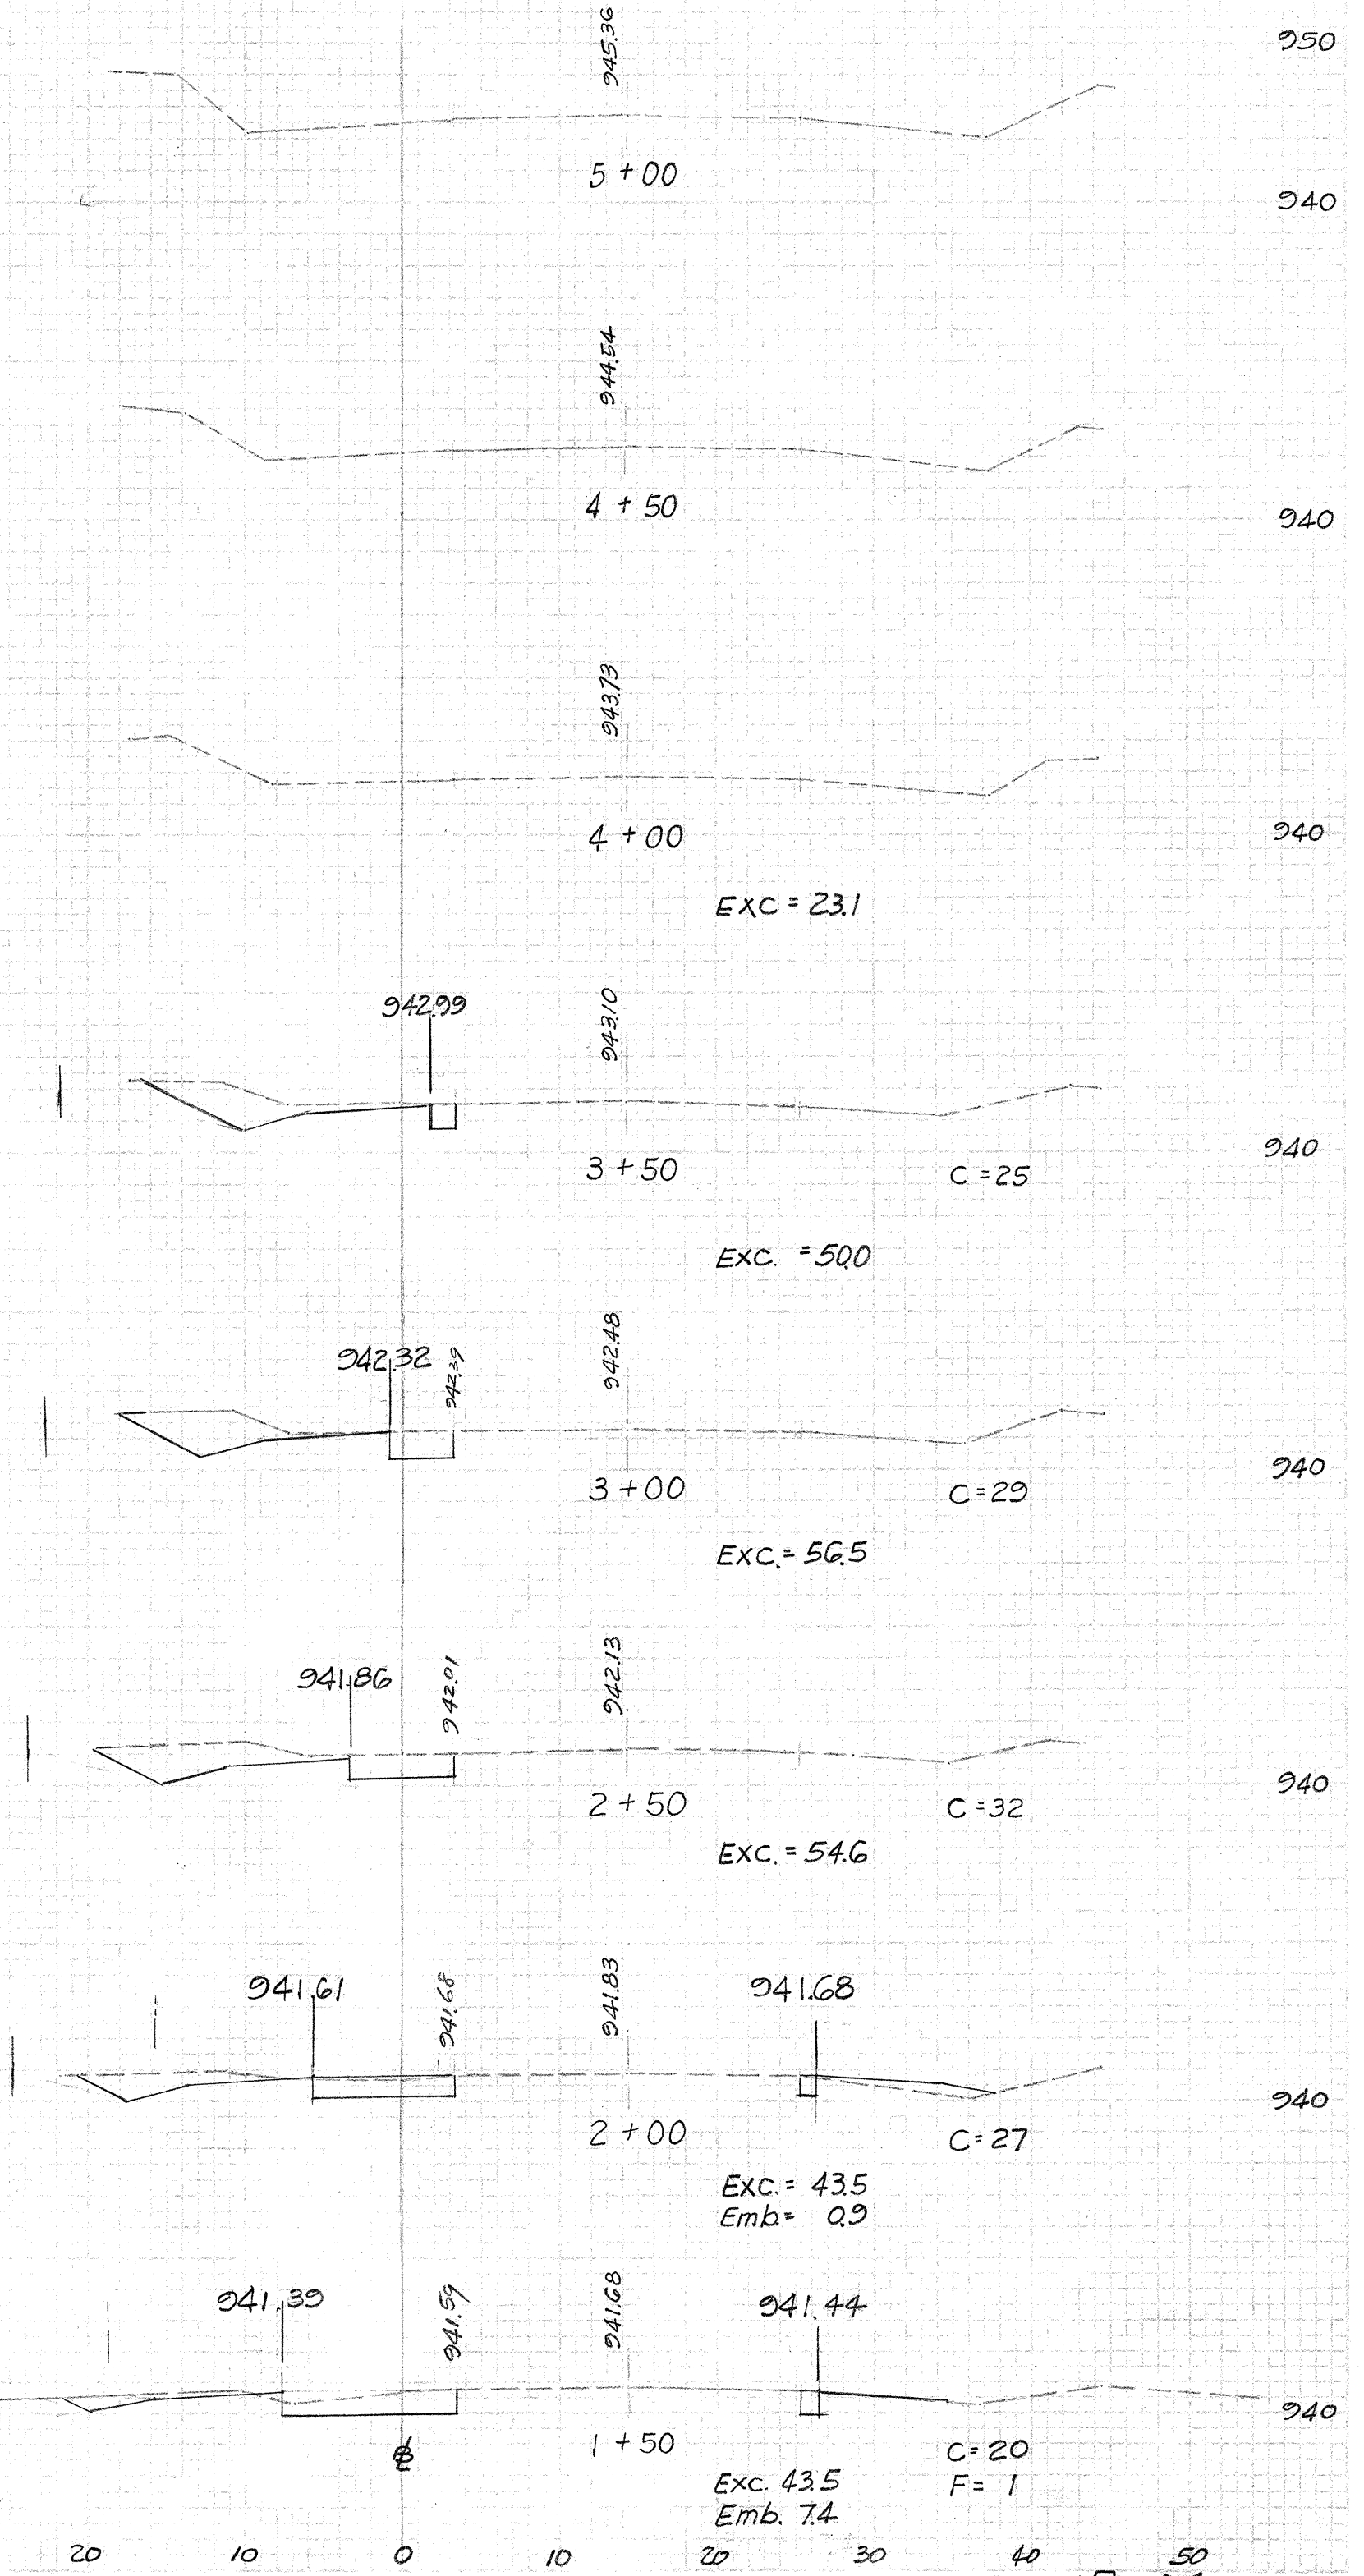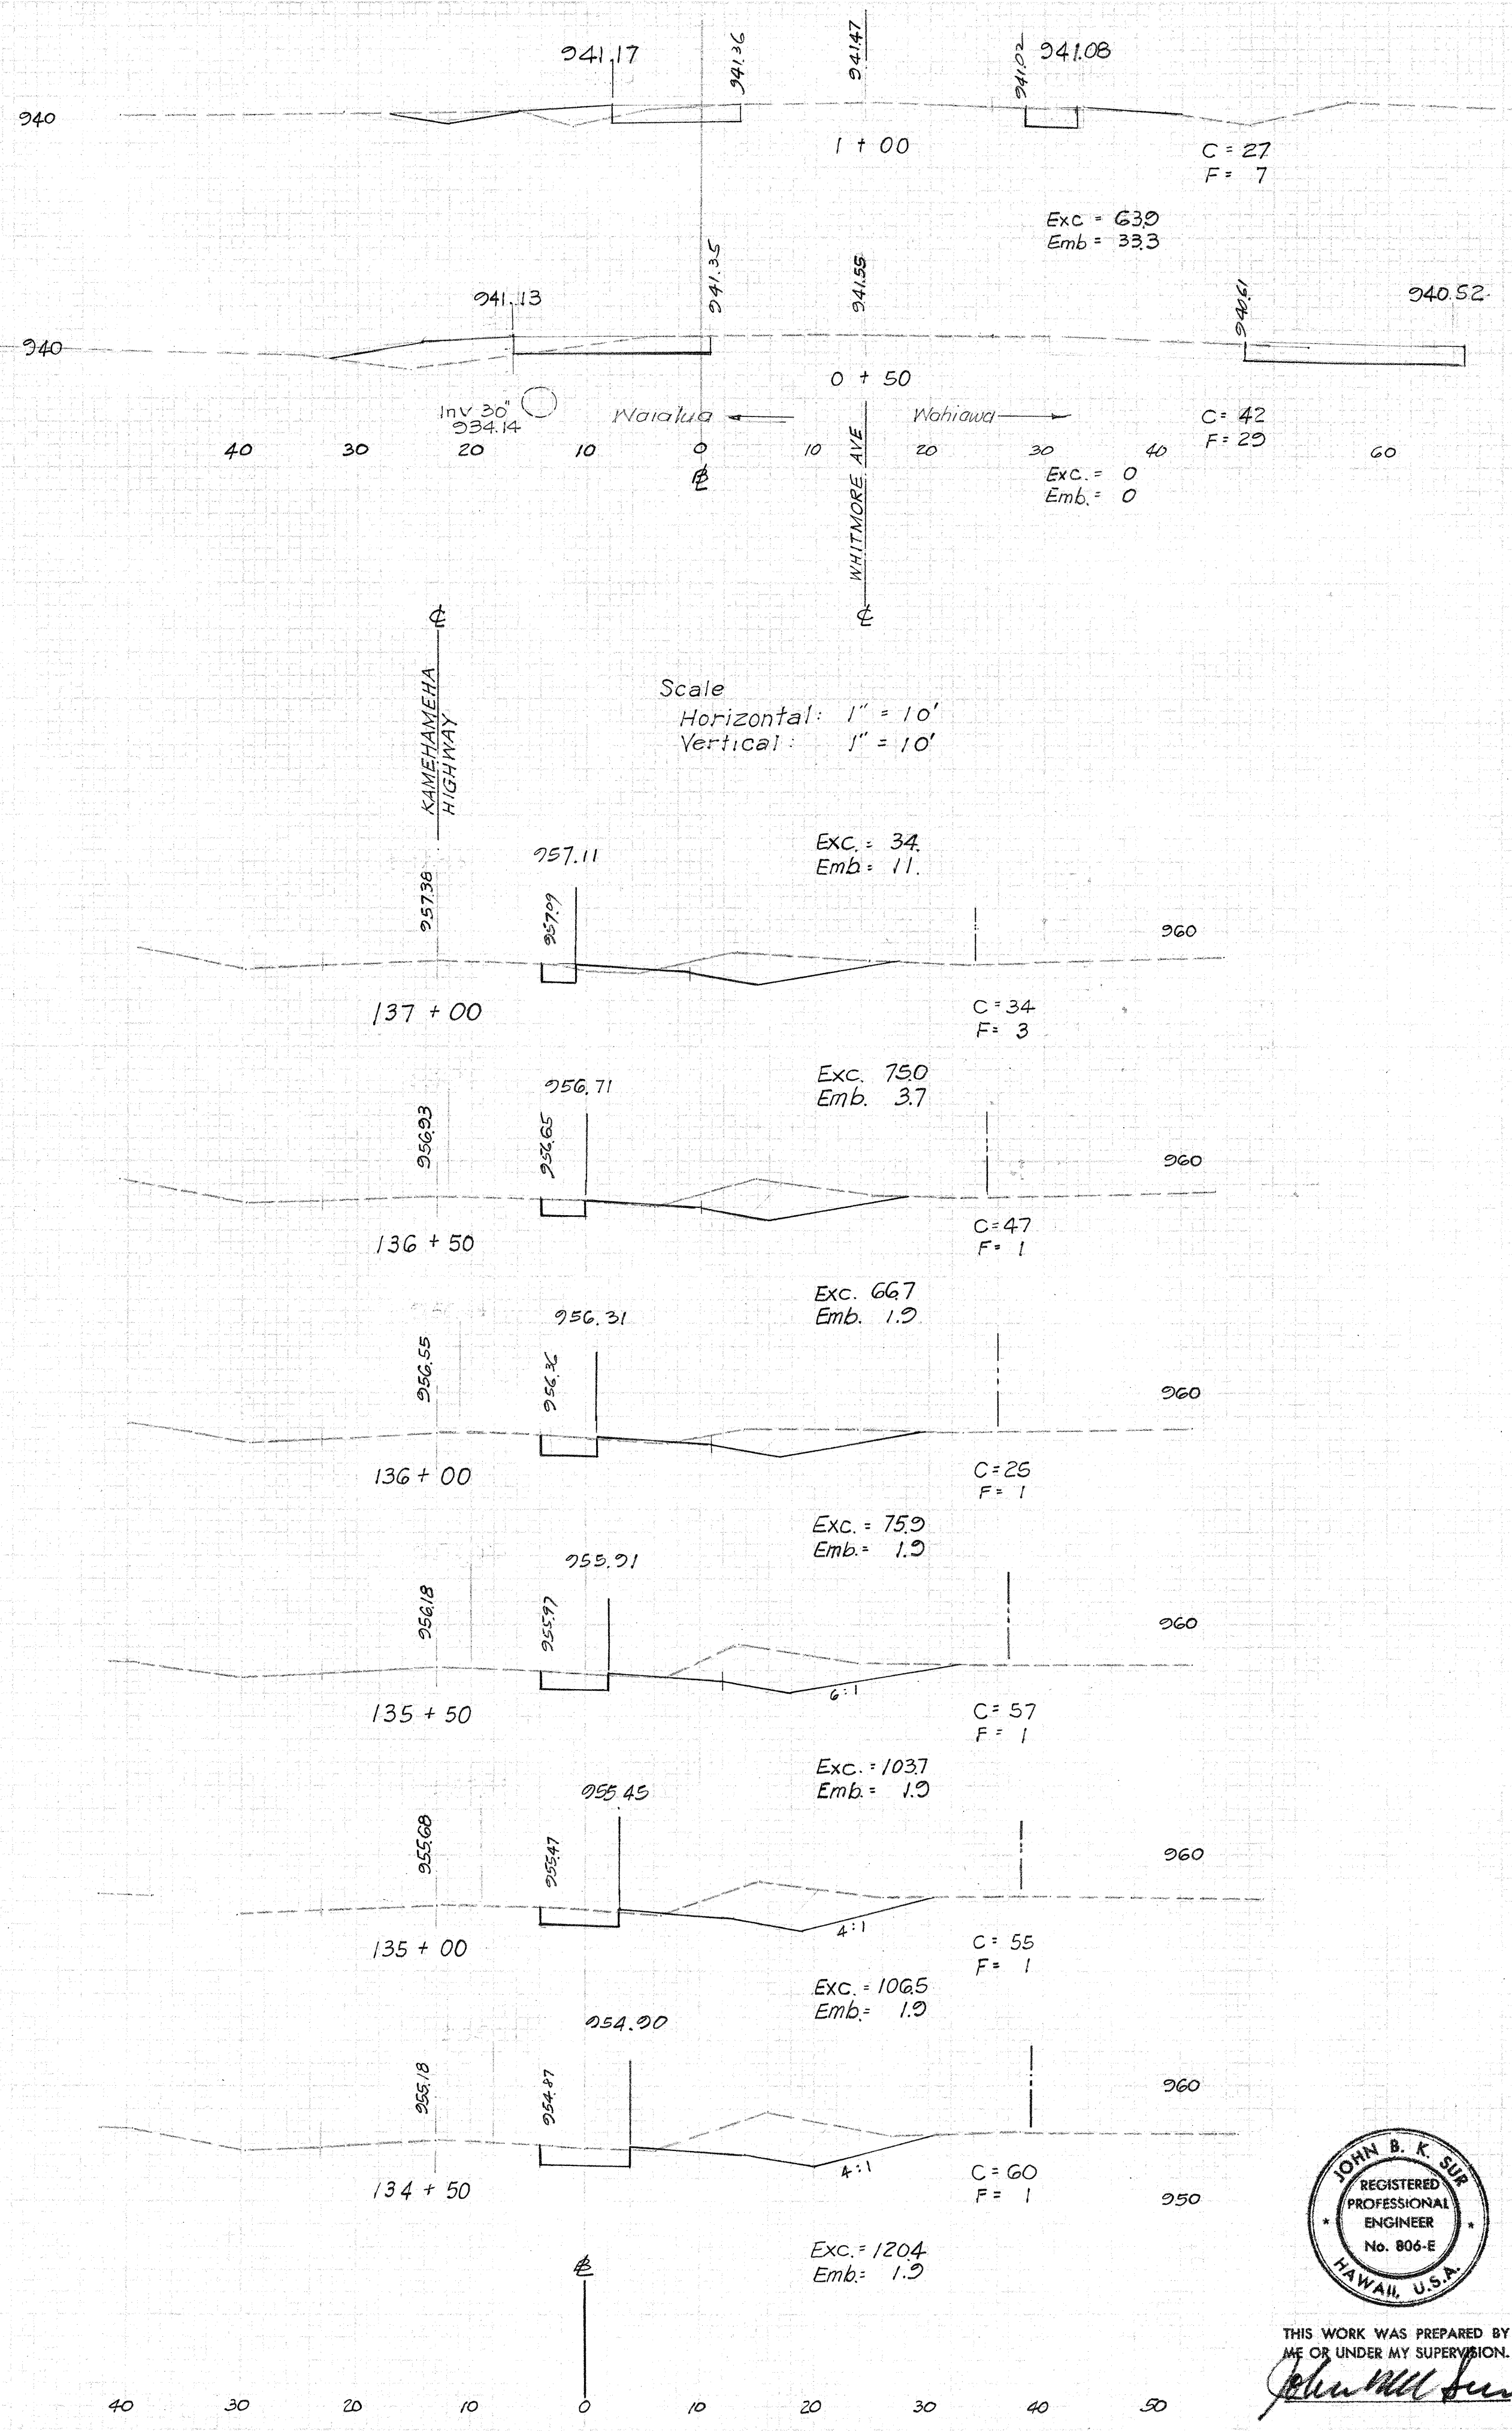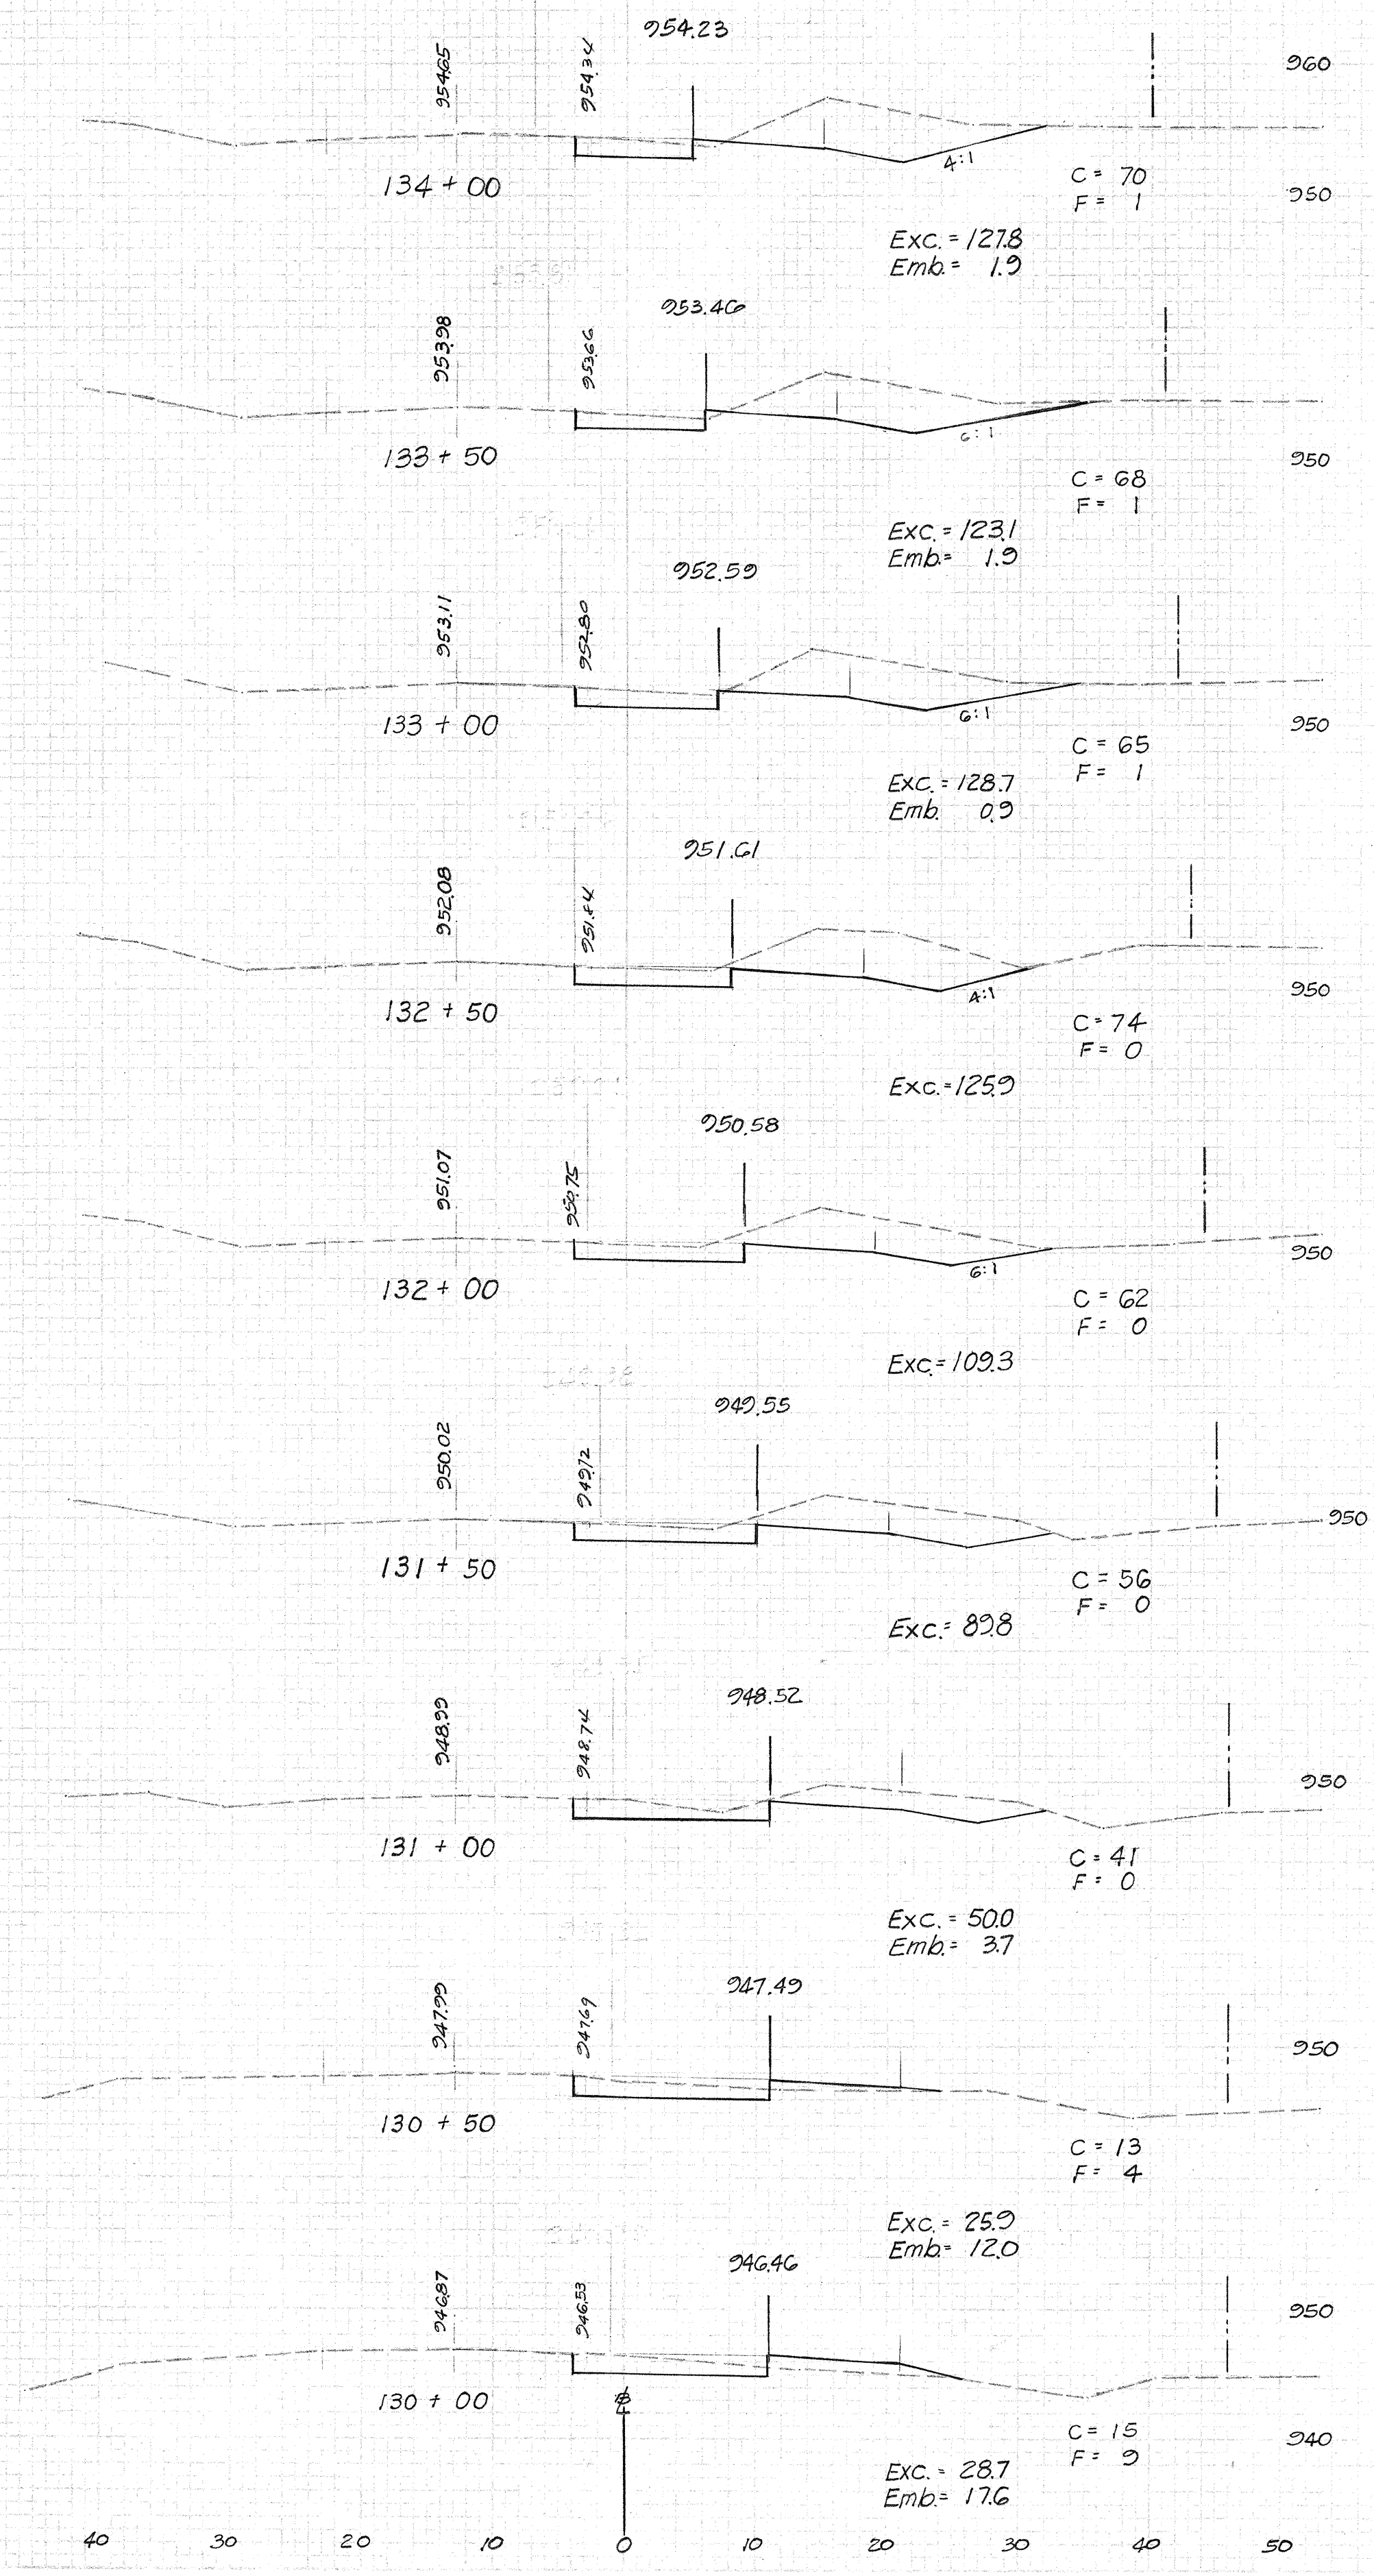

THIS WORK WAS PREPARED BY
ME OR UNDER MY SUPERVISION.
John B. K. Sun