
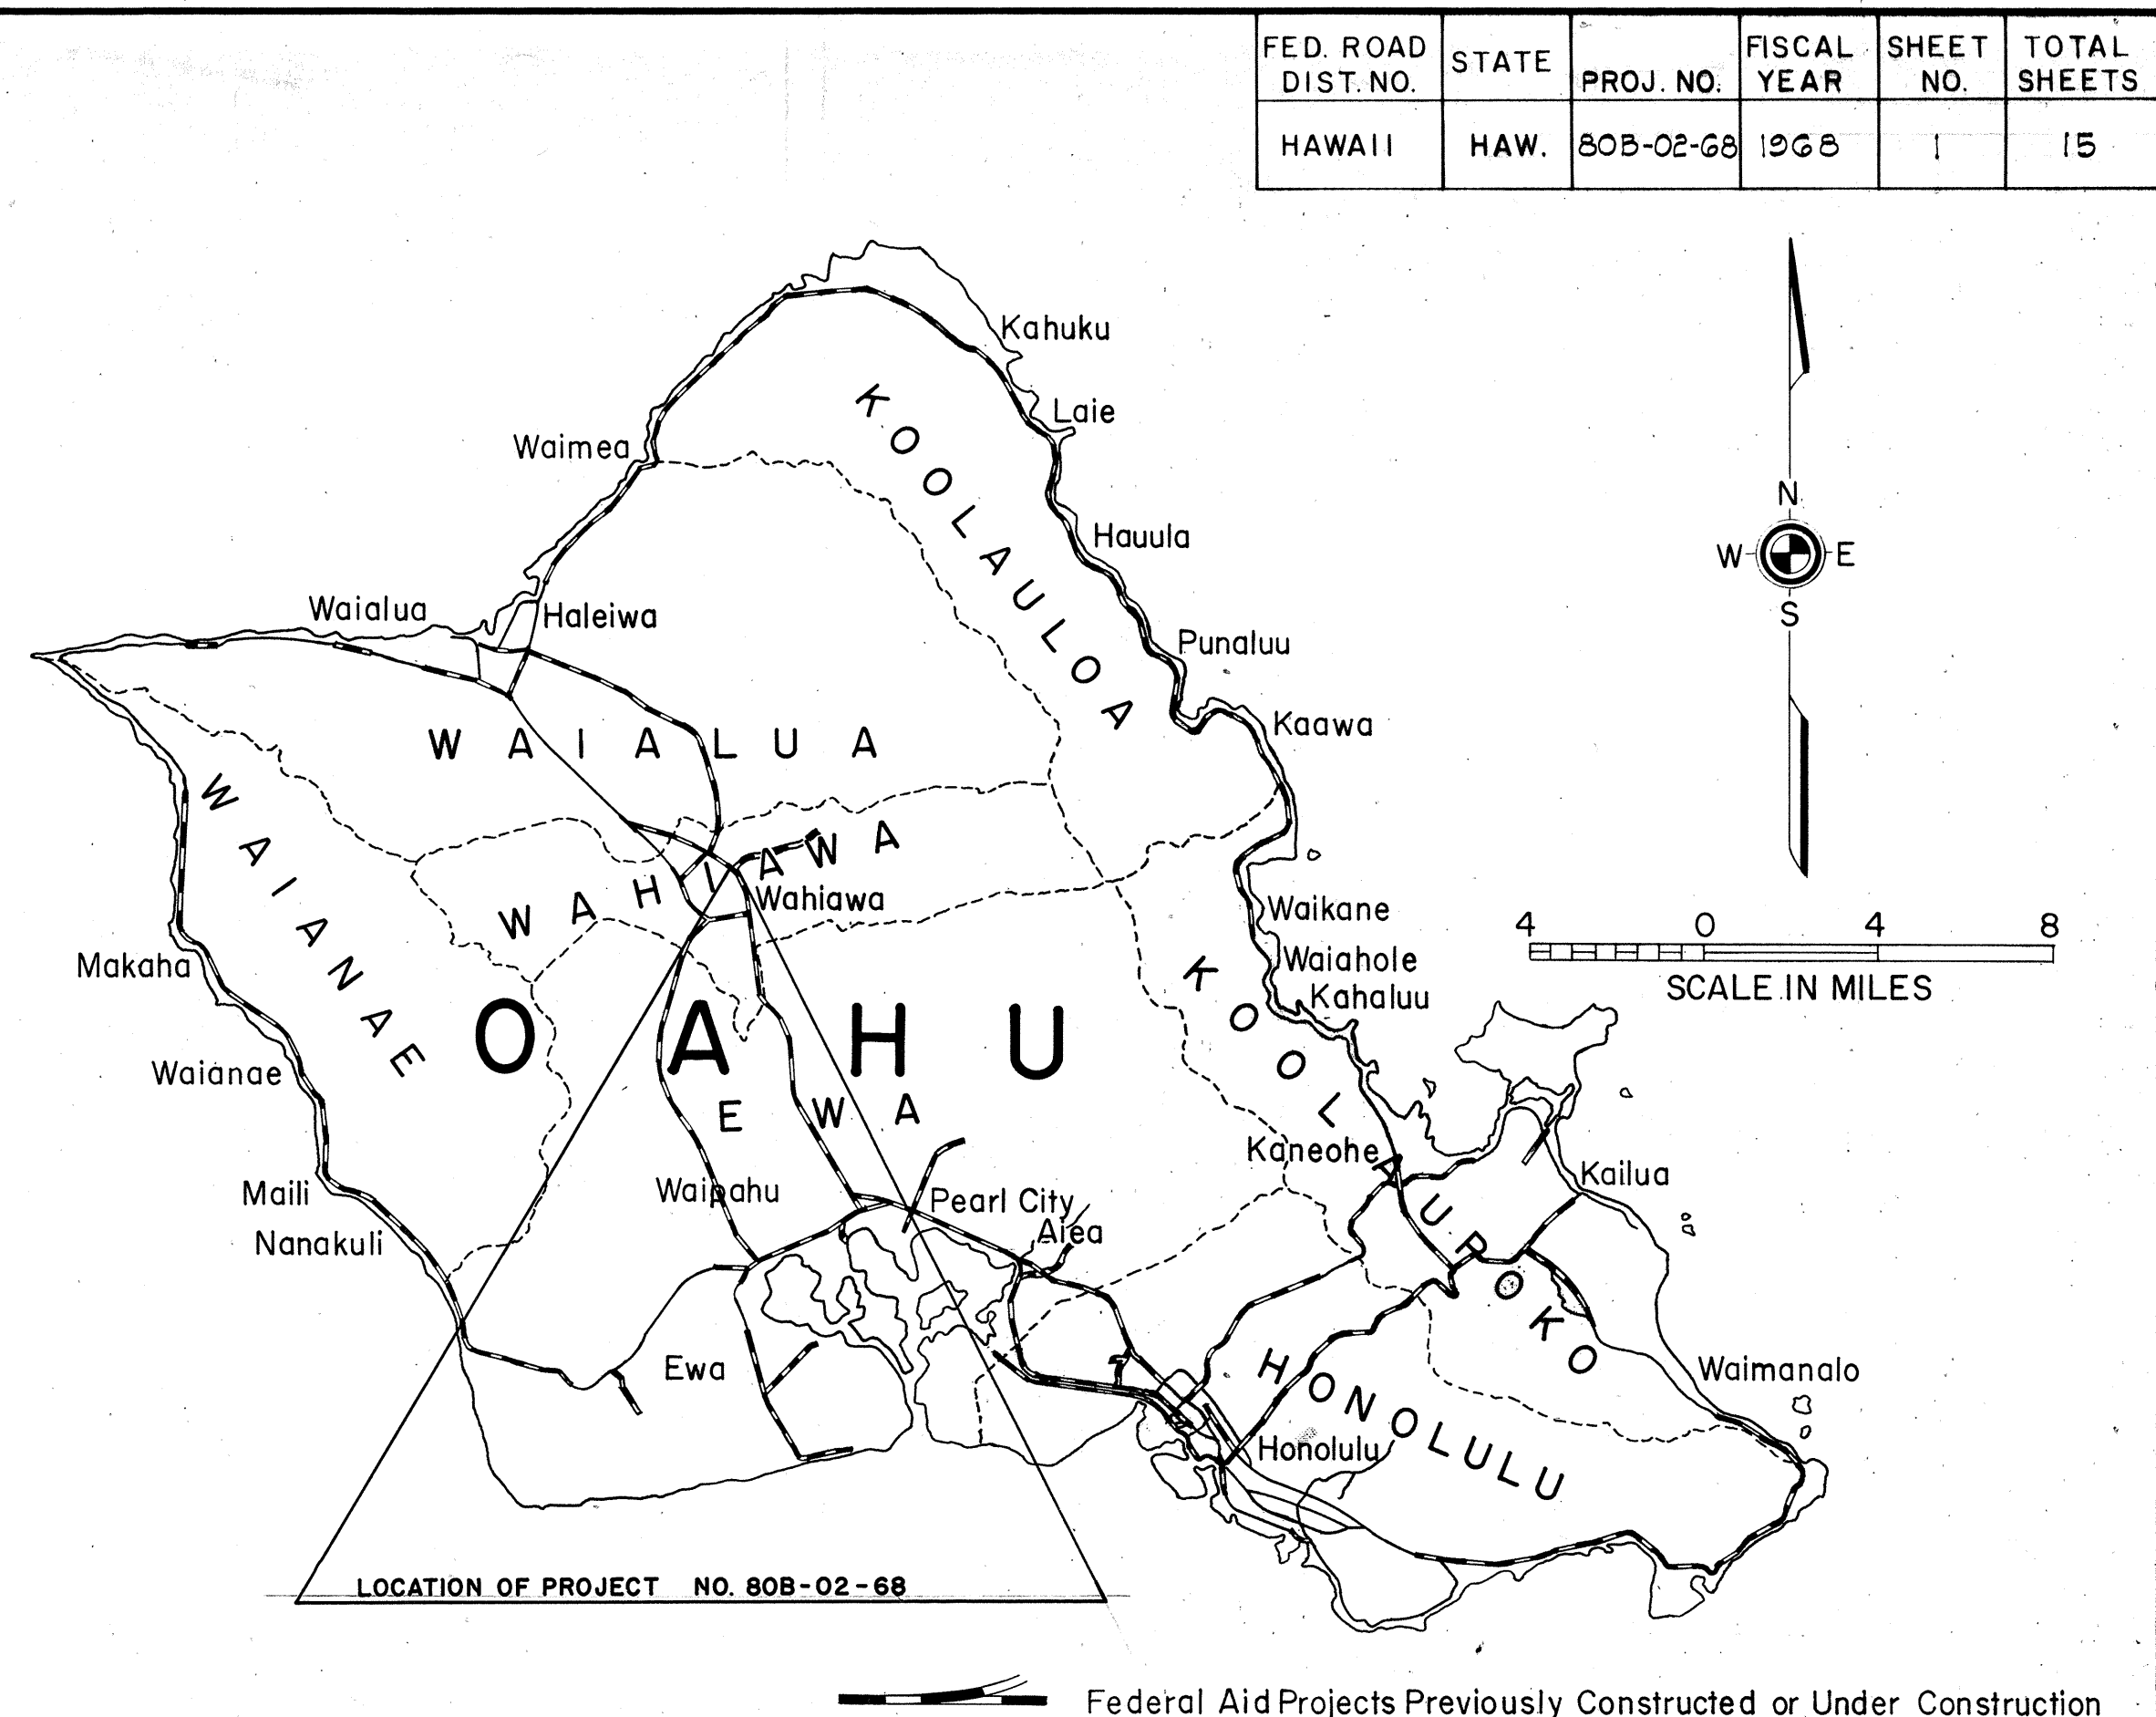


INDEX TO DRAWINGS	
SHEET NO.	DESCRIPTION
1	TITLE SHEET
2	TYPICAL SECTIONS AND GRADE PLAN
3	PLAN AND PROFILE
4	DRAINAGE DETAILS
5	STANDARD DETAILS RAISED PAVEMENT MARKERS
6-11	TRAFFIC SIGNS PLAN AND DETAILS
12,13	HIGHWAY LIGHTING SYSTEM
14,15	CROSS SECTIONS
COB5	PLAN AND PROFILE

STATE OF HAWAII  
DEPARTMENT OF TRANSPORTATION  
HIGHWAYS DIVISION  
HONOLULU, HAWAII  
"AS BUILT"  
**PLAN FOR**  
**INTERSECTION IMPROVEMENT**  
**ON KAMEHAMEHA HIGHWAY**  
**AT WHITMORE AVENUE**  
**PROJECT NO. 80B-02-68**

DISTRICT OF WAHIAWA , ISLAND OF OAHU

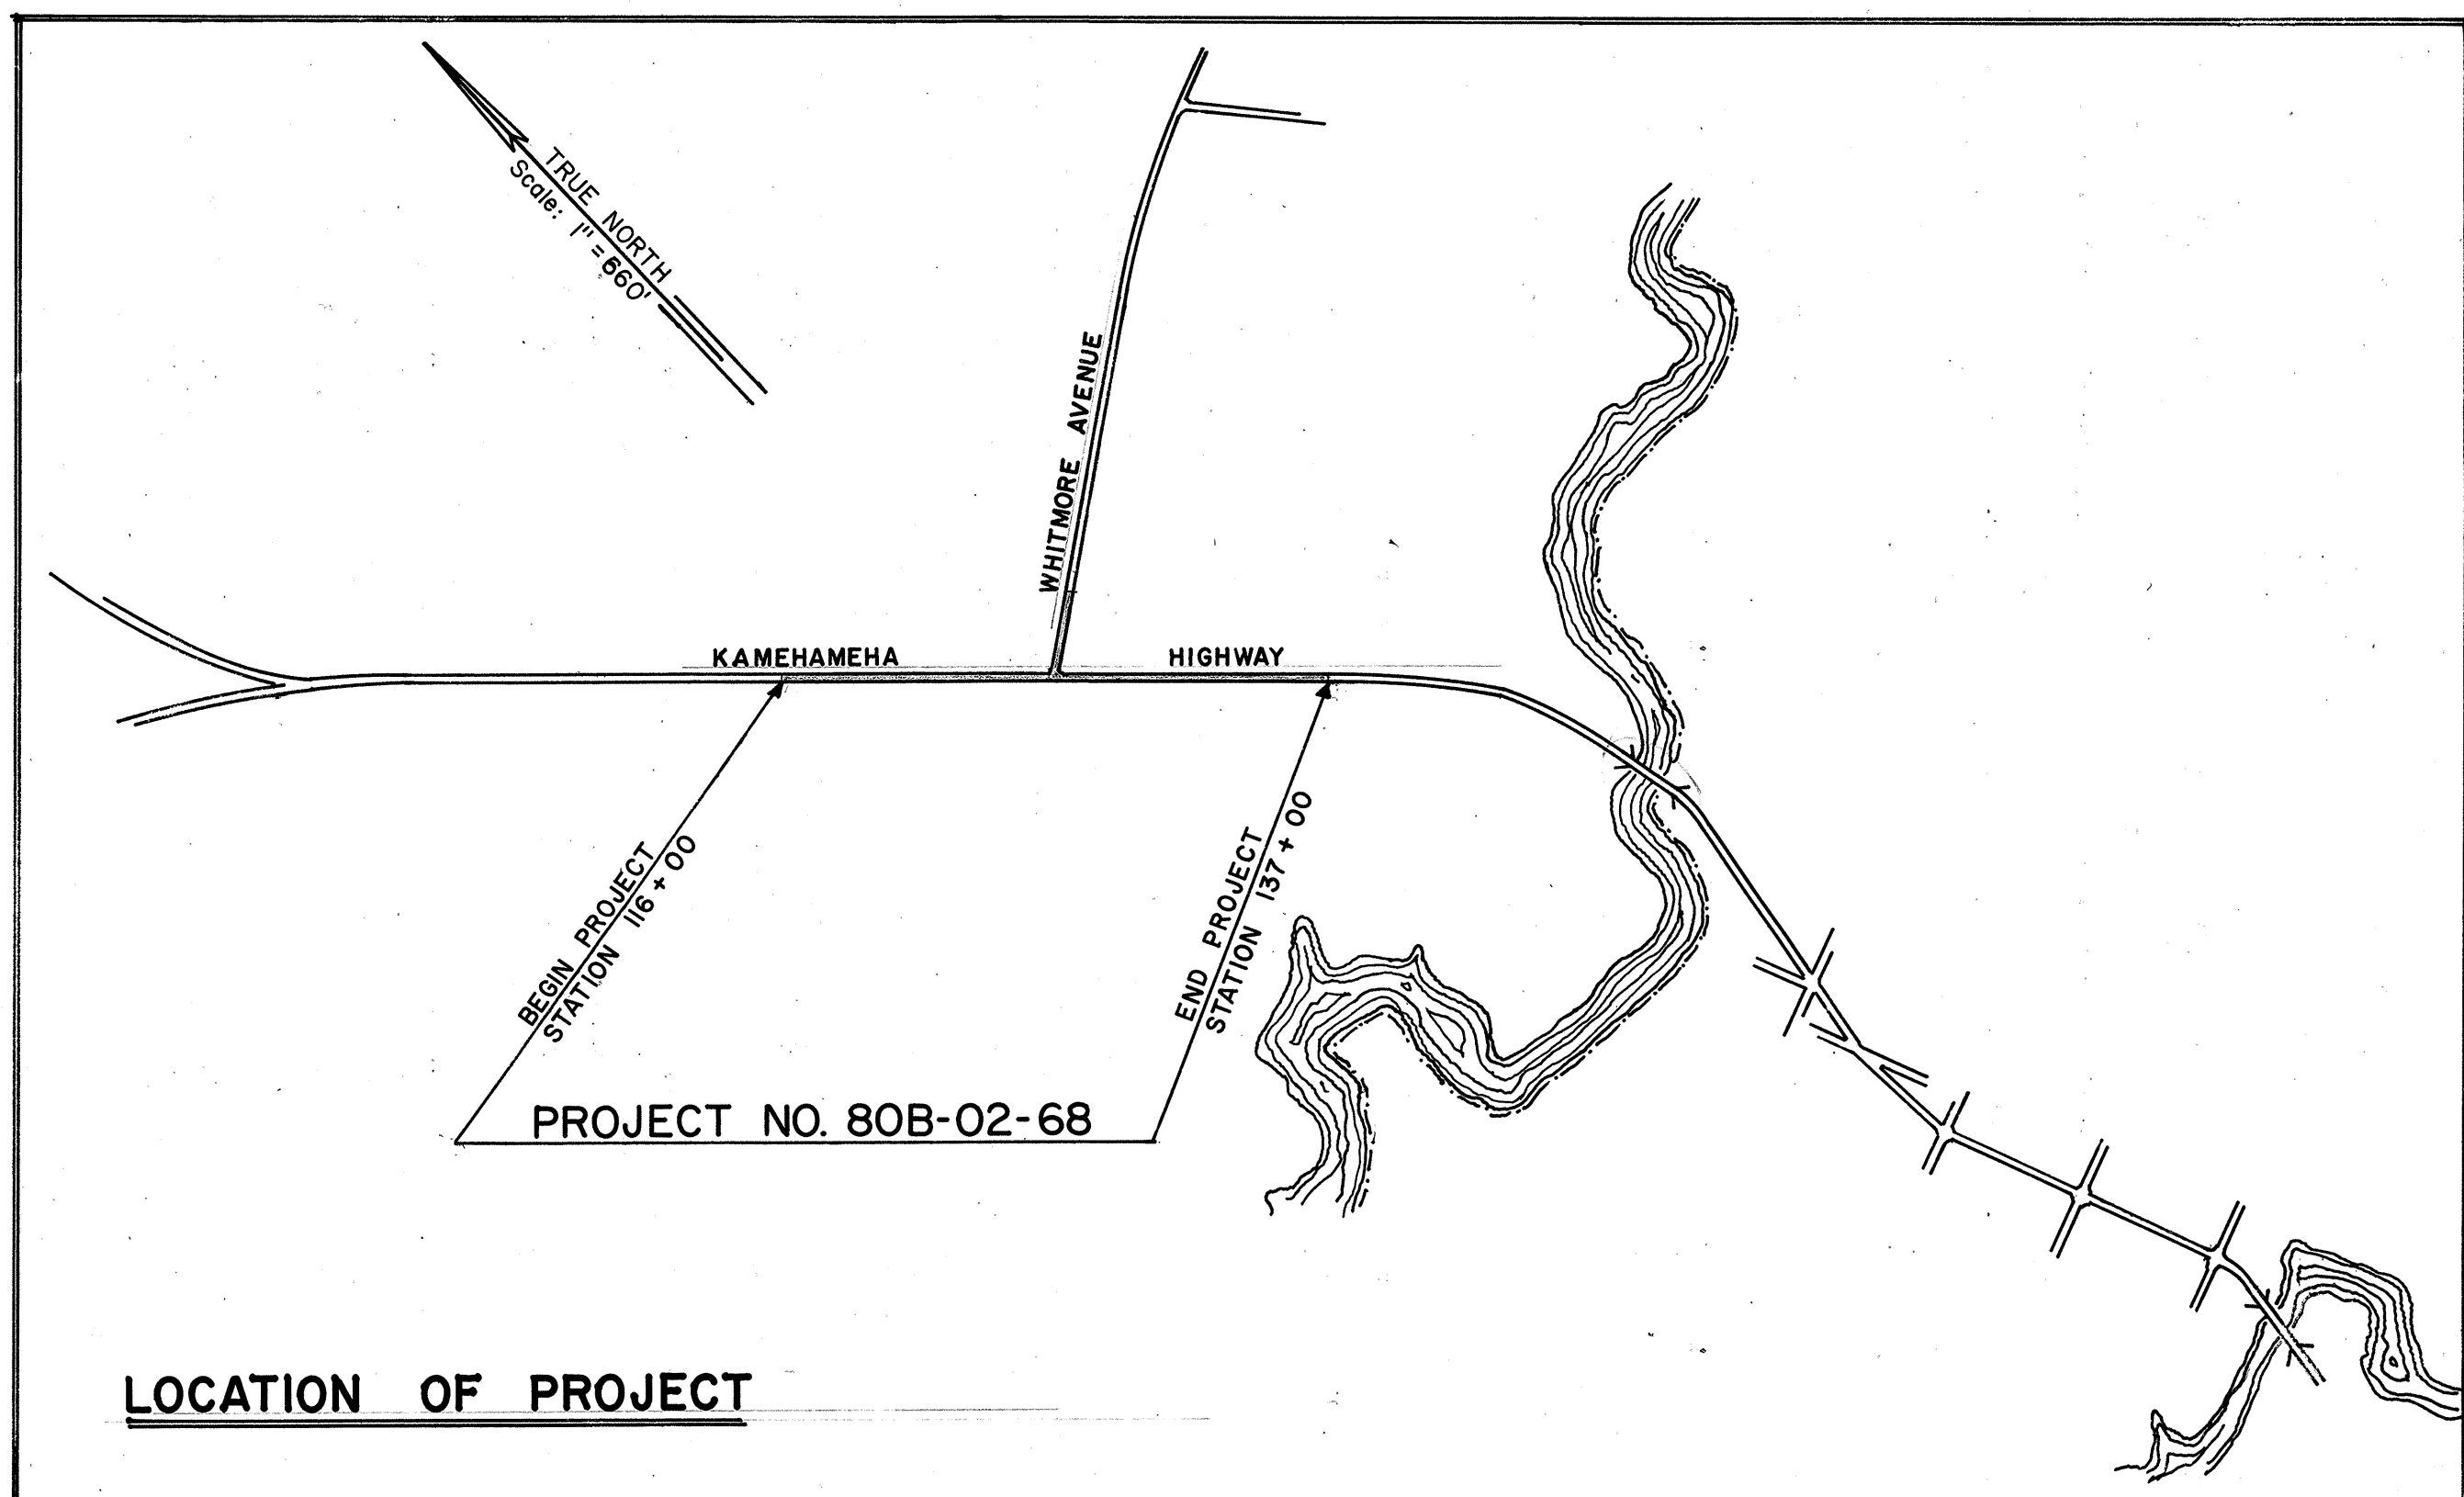

SCALES	
PLAN	1 IN. = 50 FT.
CROSS SECTION	
HOR.	1 IN. = 10 FT.
VERT.	1 IN. = 10 FT.

NOTE:  
ALL CHANGES MADE DURING CONSTRUCTION  
HAVE BEEN NOTED IN RED ON THESE TRACINGS  
AND CHECKED BY.  
For Mike Uyemura  
RESIDENT ENGINEER  
August 18, 1970  
DATE



THIS WORK WAS PREPARED BY  
ME OR UNDER MY SUPERVISION.  
*John B. K. Sur*

DEPARTMENT OF TRANSPORTATION  
STATE OF HAWAII  
APPROVED:  
E. Avery Knight 7/19/68  
for DIR. OF TRANSPORTATION DATE