


FED. ROAD DIST. NO.	STATE	FED. AID PROJ. NO.	FISCAL YEAR	SHEET NO.	TOTAL SHEETST
HAWAII	HAW.	F-080-1(2)	1968	1	19

STATE OF HAWAII
DEPARTMENT OF TRANSPORTATION
HIGHWAYS DIVISION

"AS BUILT" PLANS OF

SAFETY IMPROVEMENTS OF INTERSECTION AT
KAMEHAMEHA HIGHWAY AND KAUKONAHUA ROAD;
FEDERAL AID PROJECT NO. F-080-1(2)

DISTRICT OF WAHIAWA
ISLAND OF OAHU

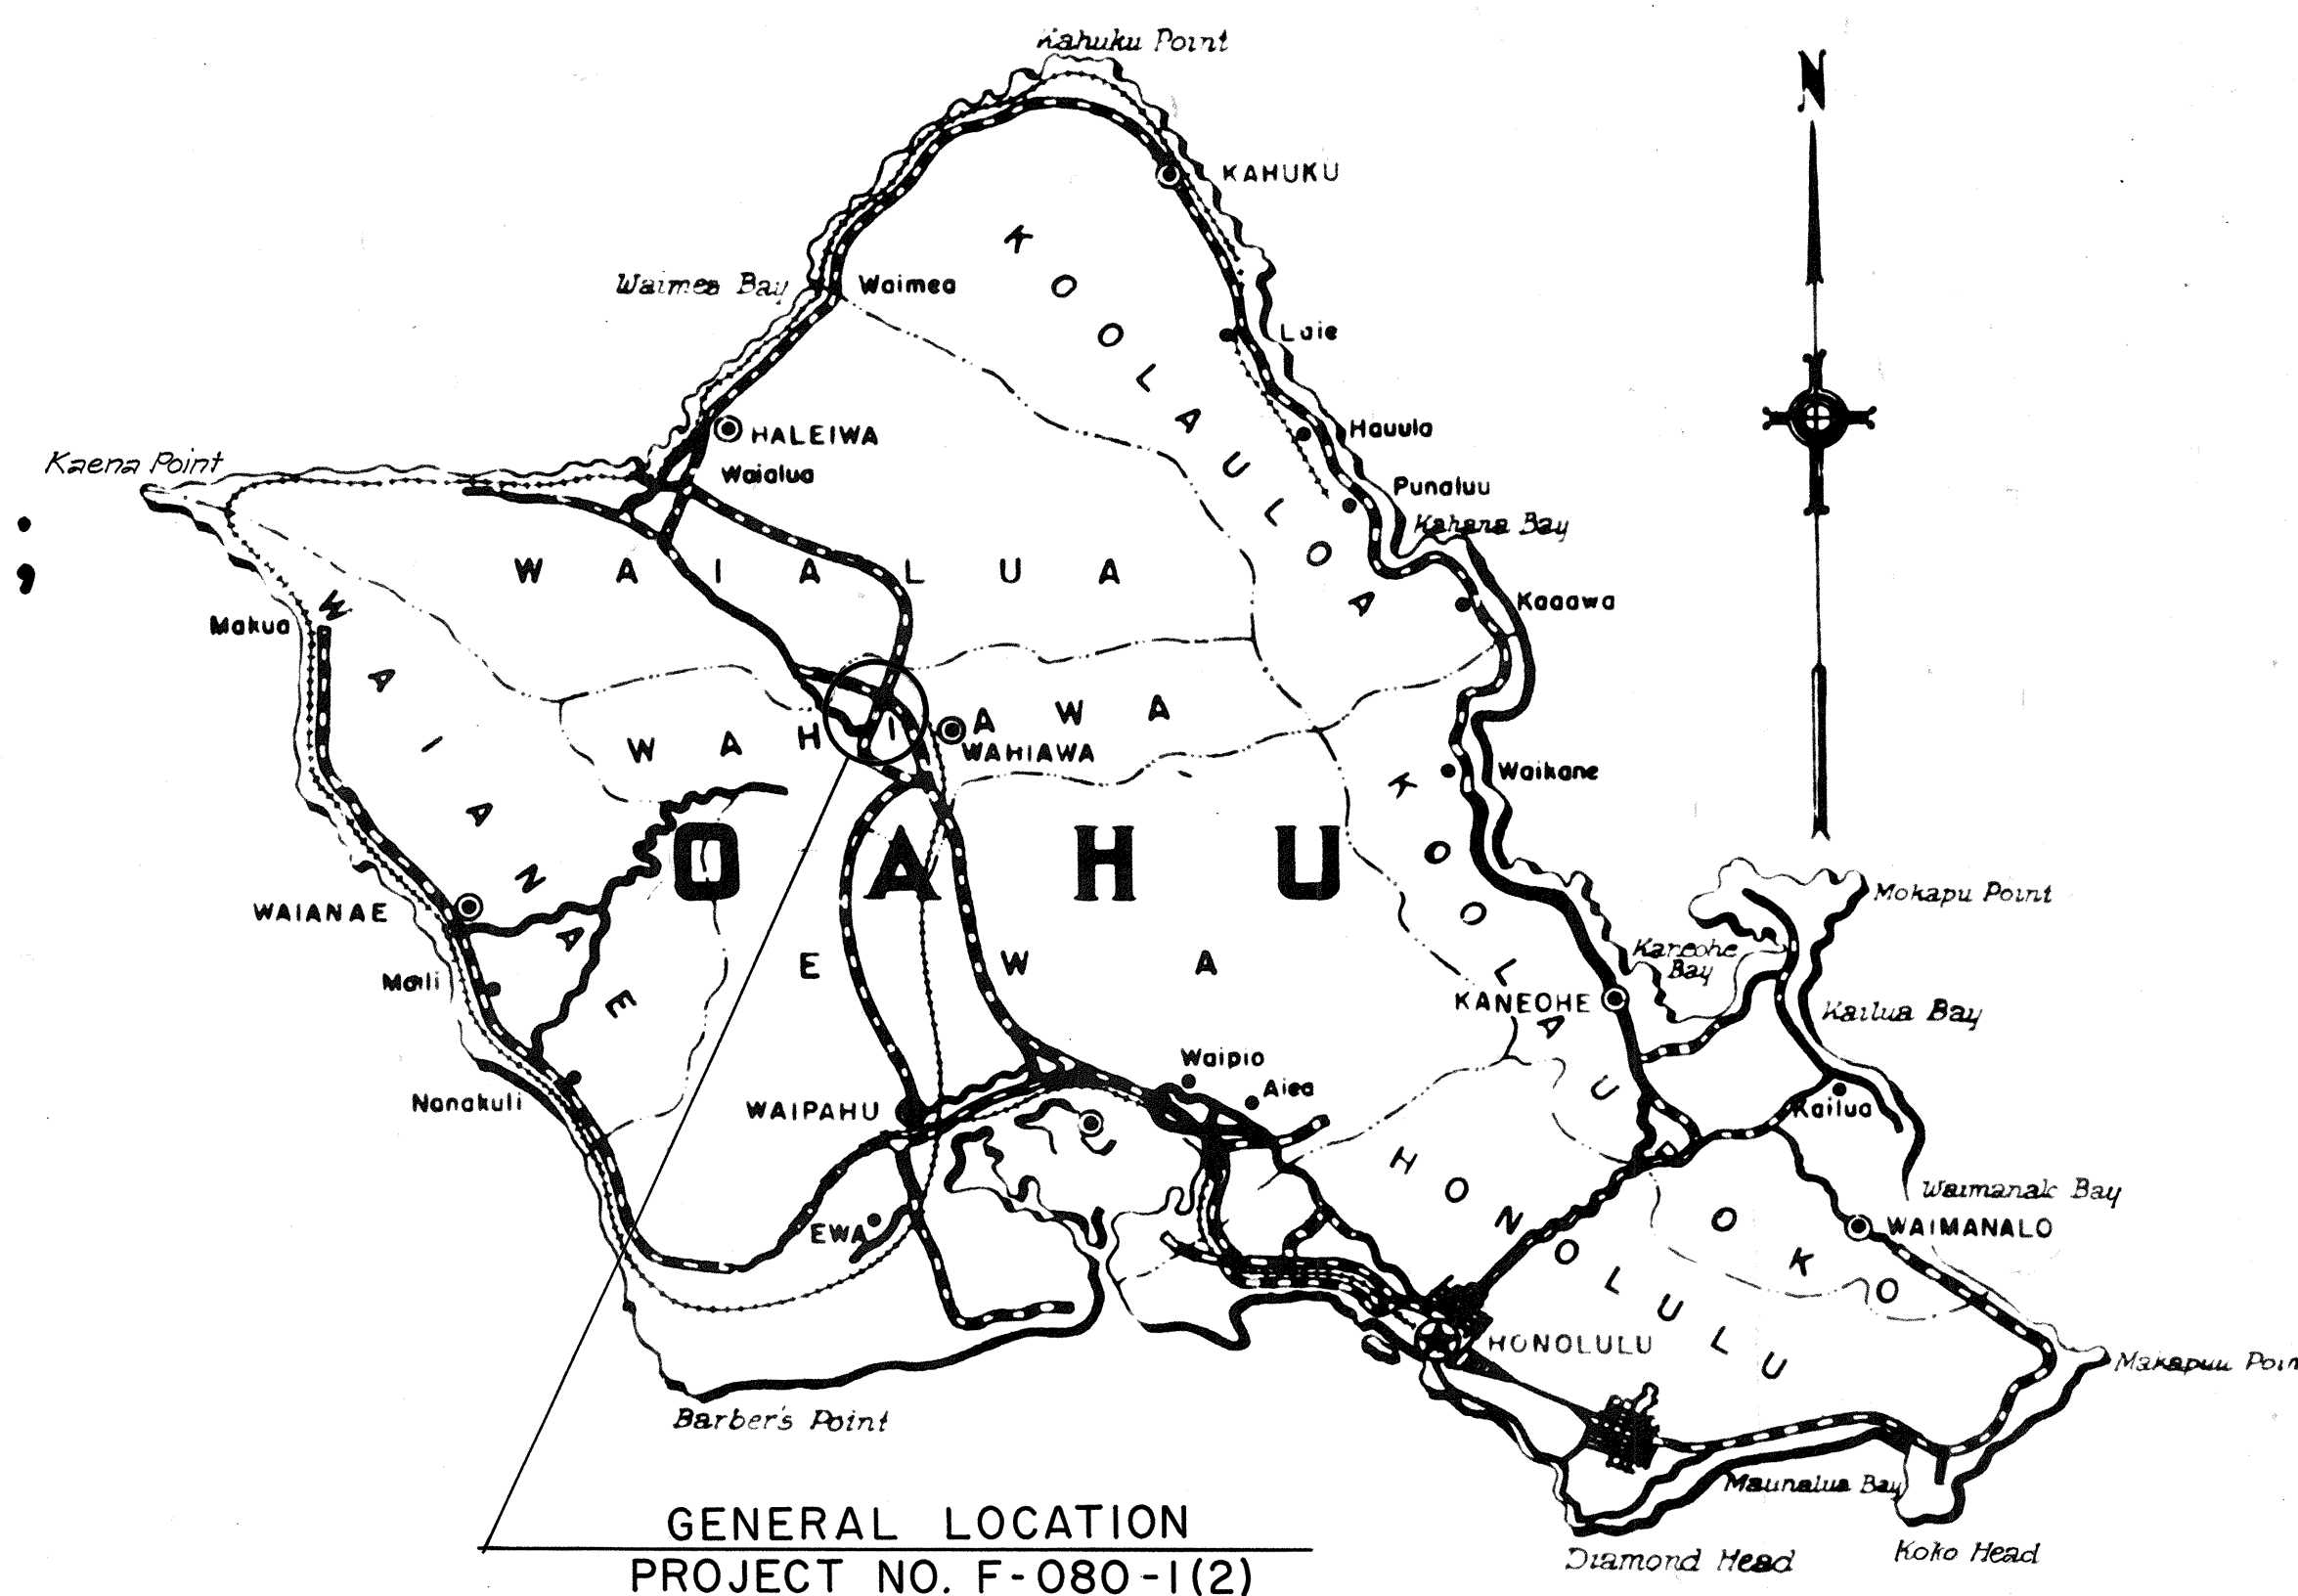

Federal Aid Projects Previously Constructed Or Under Construction

DESIGN CLASSIFICATION

ADT(1967)	7,100
DESIGN ADT (1988)	11,327
DHV	10%
D	60/40
T	3%
V	35 m.p.h.

NOTE:

ALL CHANGES MADE DURING CONSTRUCTION
HAVE BEEN NOTED ON THESE TRACINGS
IN RED AND CHECKED BY:


Mike Uyean
PROJECT ENGINEER
June 1, 1971
DATE

APPROVED: _____ DATE 5/21/68

John H. Ruff
FOR DIRECTOR OF TRANSPORTATION

DEPARTMENT OF TRANSPORTATION
BUREAU OF PUBLIC ROADS

APPROVED: Cannon H. Jones, Area Eng. 8-20-6
FOR DIVISION ENGINEER DATE

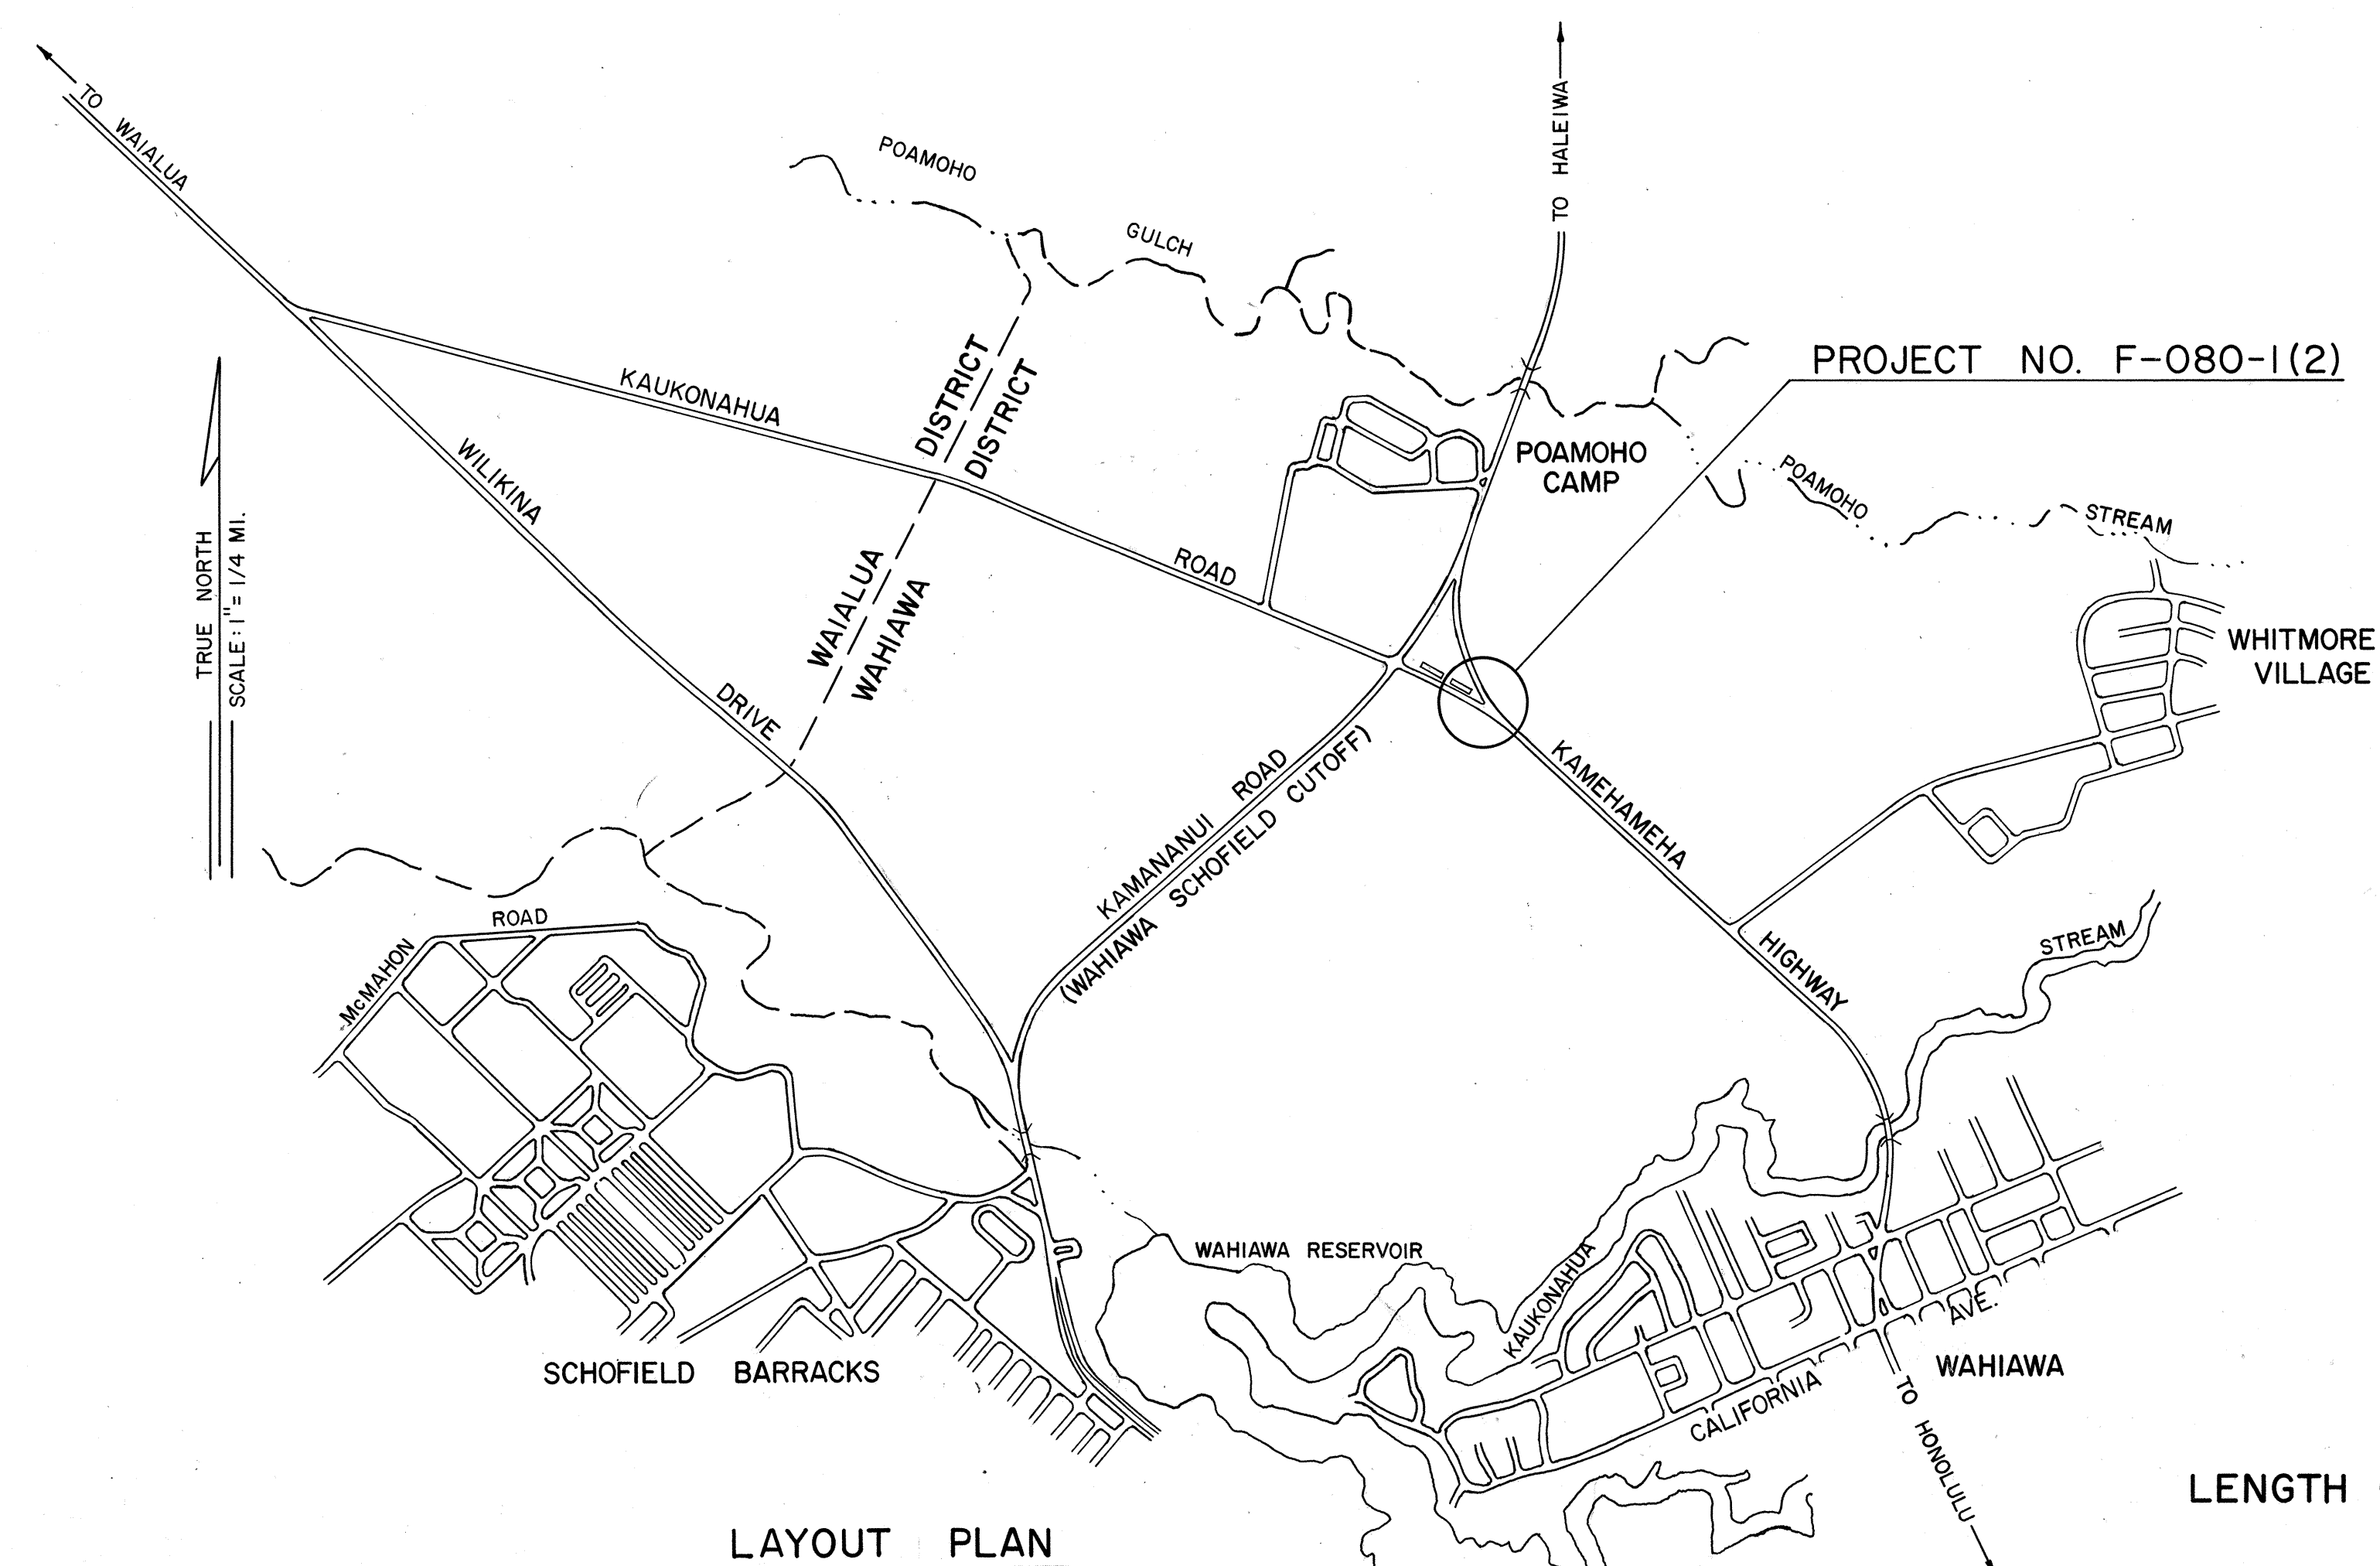

LENGTH OF PROJECT = 0.221 mile

LAYOUT PLAN

ORIGINAL PLAN	SURVEY PLOTTED BY DESIGNED BY DRAWN BY TRACED BY QUANTITIES BY QUANTITIES CHECKED BY CHECKED BY	DATE
	R. Terada	
NOTE BOOK		
No.		