

INDEX TO DRAWINGS	
SHEET NO	DESCRIPTION
1	TITLE SHEET
2 - 3	WILSON BRIDGE DETAILS
4 - 6	KARSTEN THOT BRIDGE DETAILS
7	PROJECT INFORMATION SIGN

STATE OF HAWAII

DEPARTMENT OF TRANSPORTATION

HIGHWAYS DIVISION

HONOLULU, HAWAII

PLANS FOR

REPAIRING AND PAINTING


WILSON BRIDGE - PROJECT NO. 80A-01-70

KARSTEN THOT BRIDGE - PROJECT NO. 80B-03-70


KAMEHAMEHA HIGHWAY

DISTRICT OF WAHIAWA

ISLAND OF OAHU

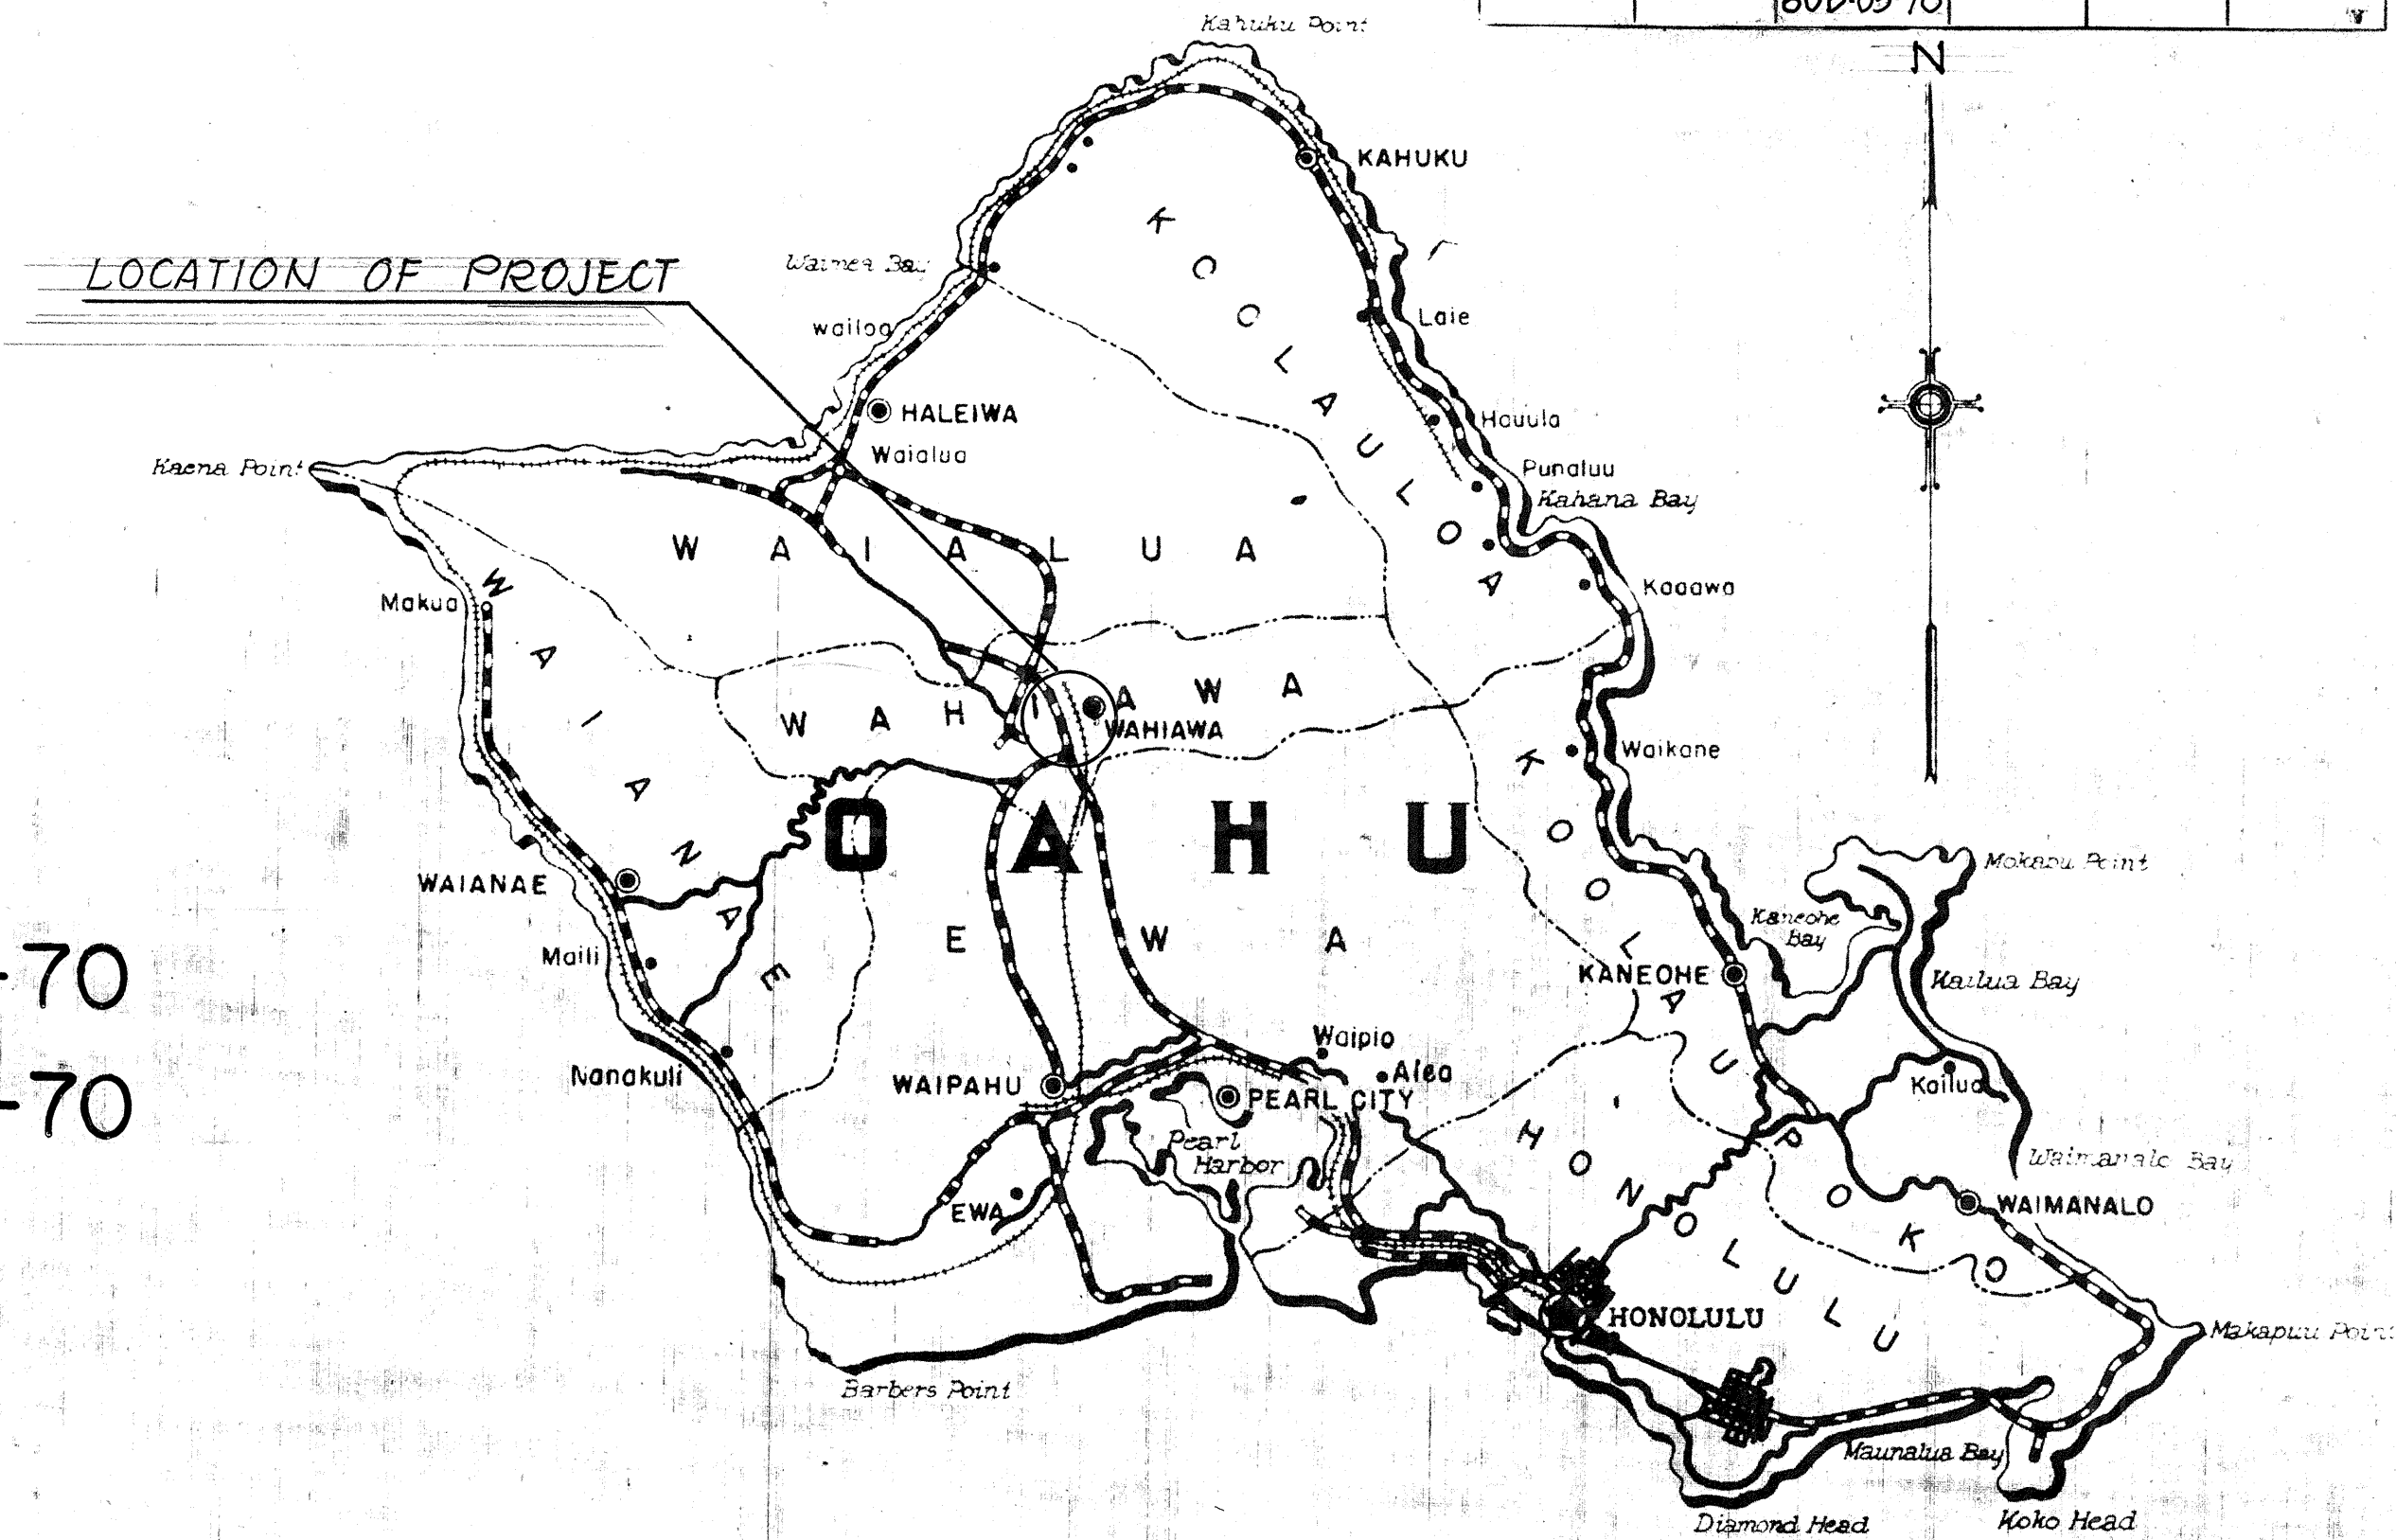

Federal Aid Projects Previously Constructed Or Under Construction

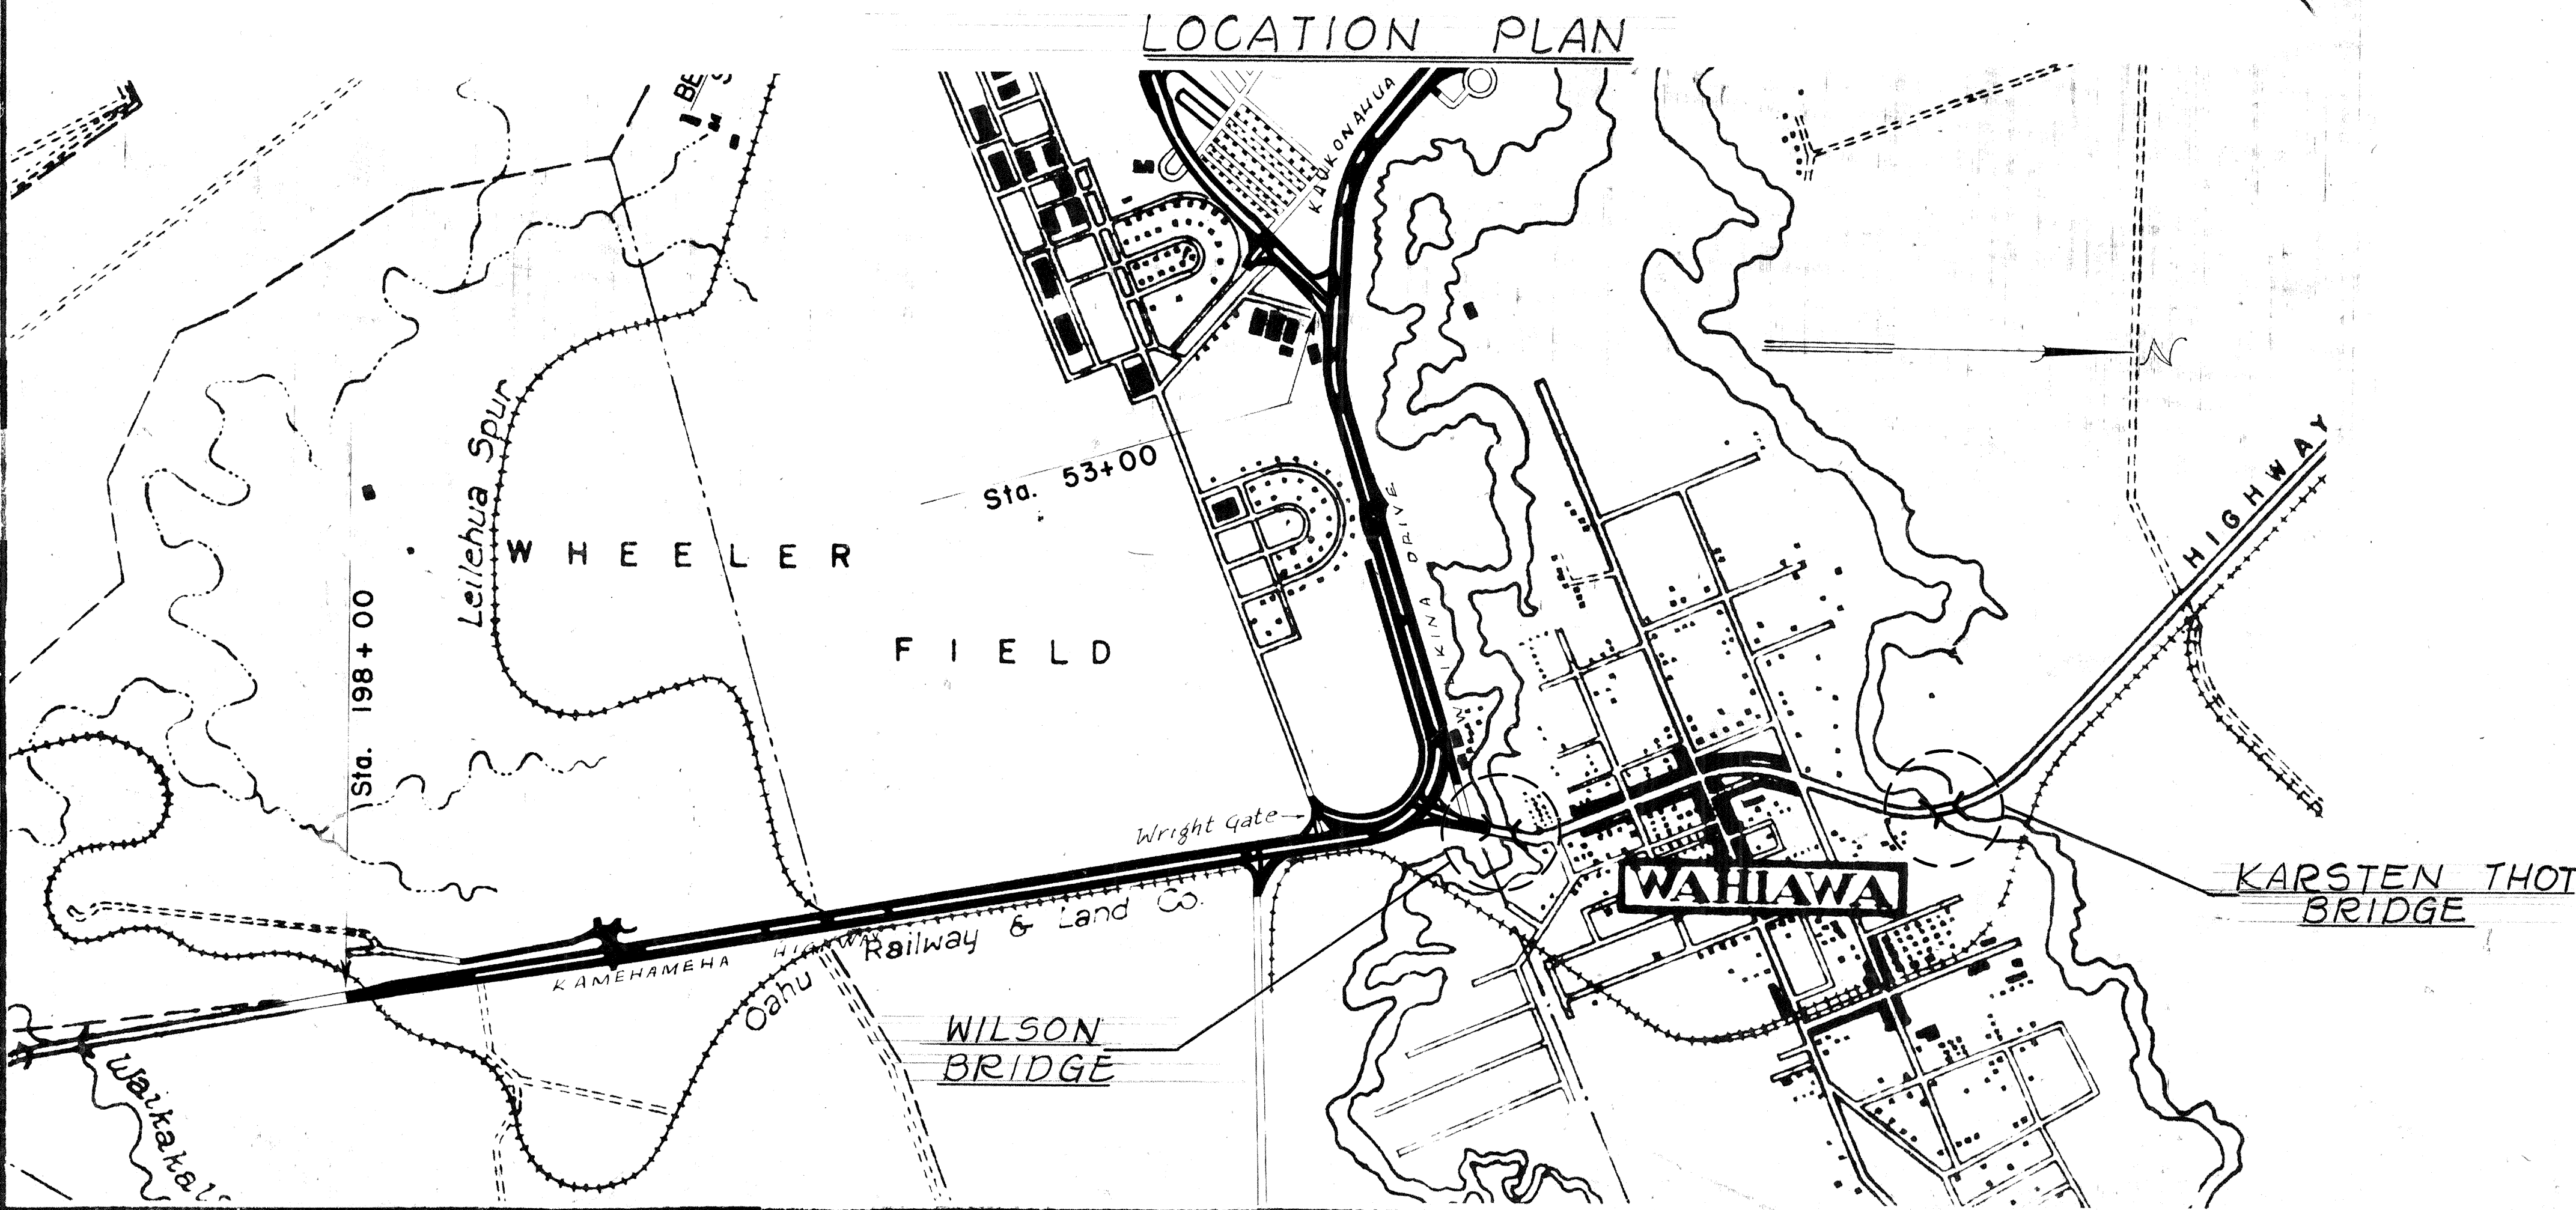

NO AS BUILT CHANGES

DEPARTMENT OF TRANSPORTATION

STATE OF HAWAII

APPROVED:

E. Avery Knight 3/16/70

for DIR. OF TRANSPORTATION DATE