


FED. ROAD DIST. NO.	STATE	FED. AID PROJ. NO.	FISCAL YEAR	SHEET NO.	TOTAL SHEETS
HAWAII	HAW.	BR-F-080-1(7)	1977	61	105

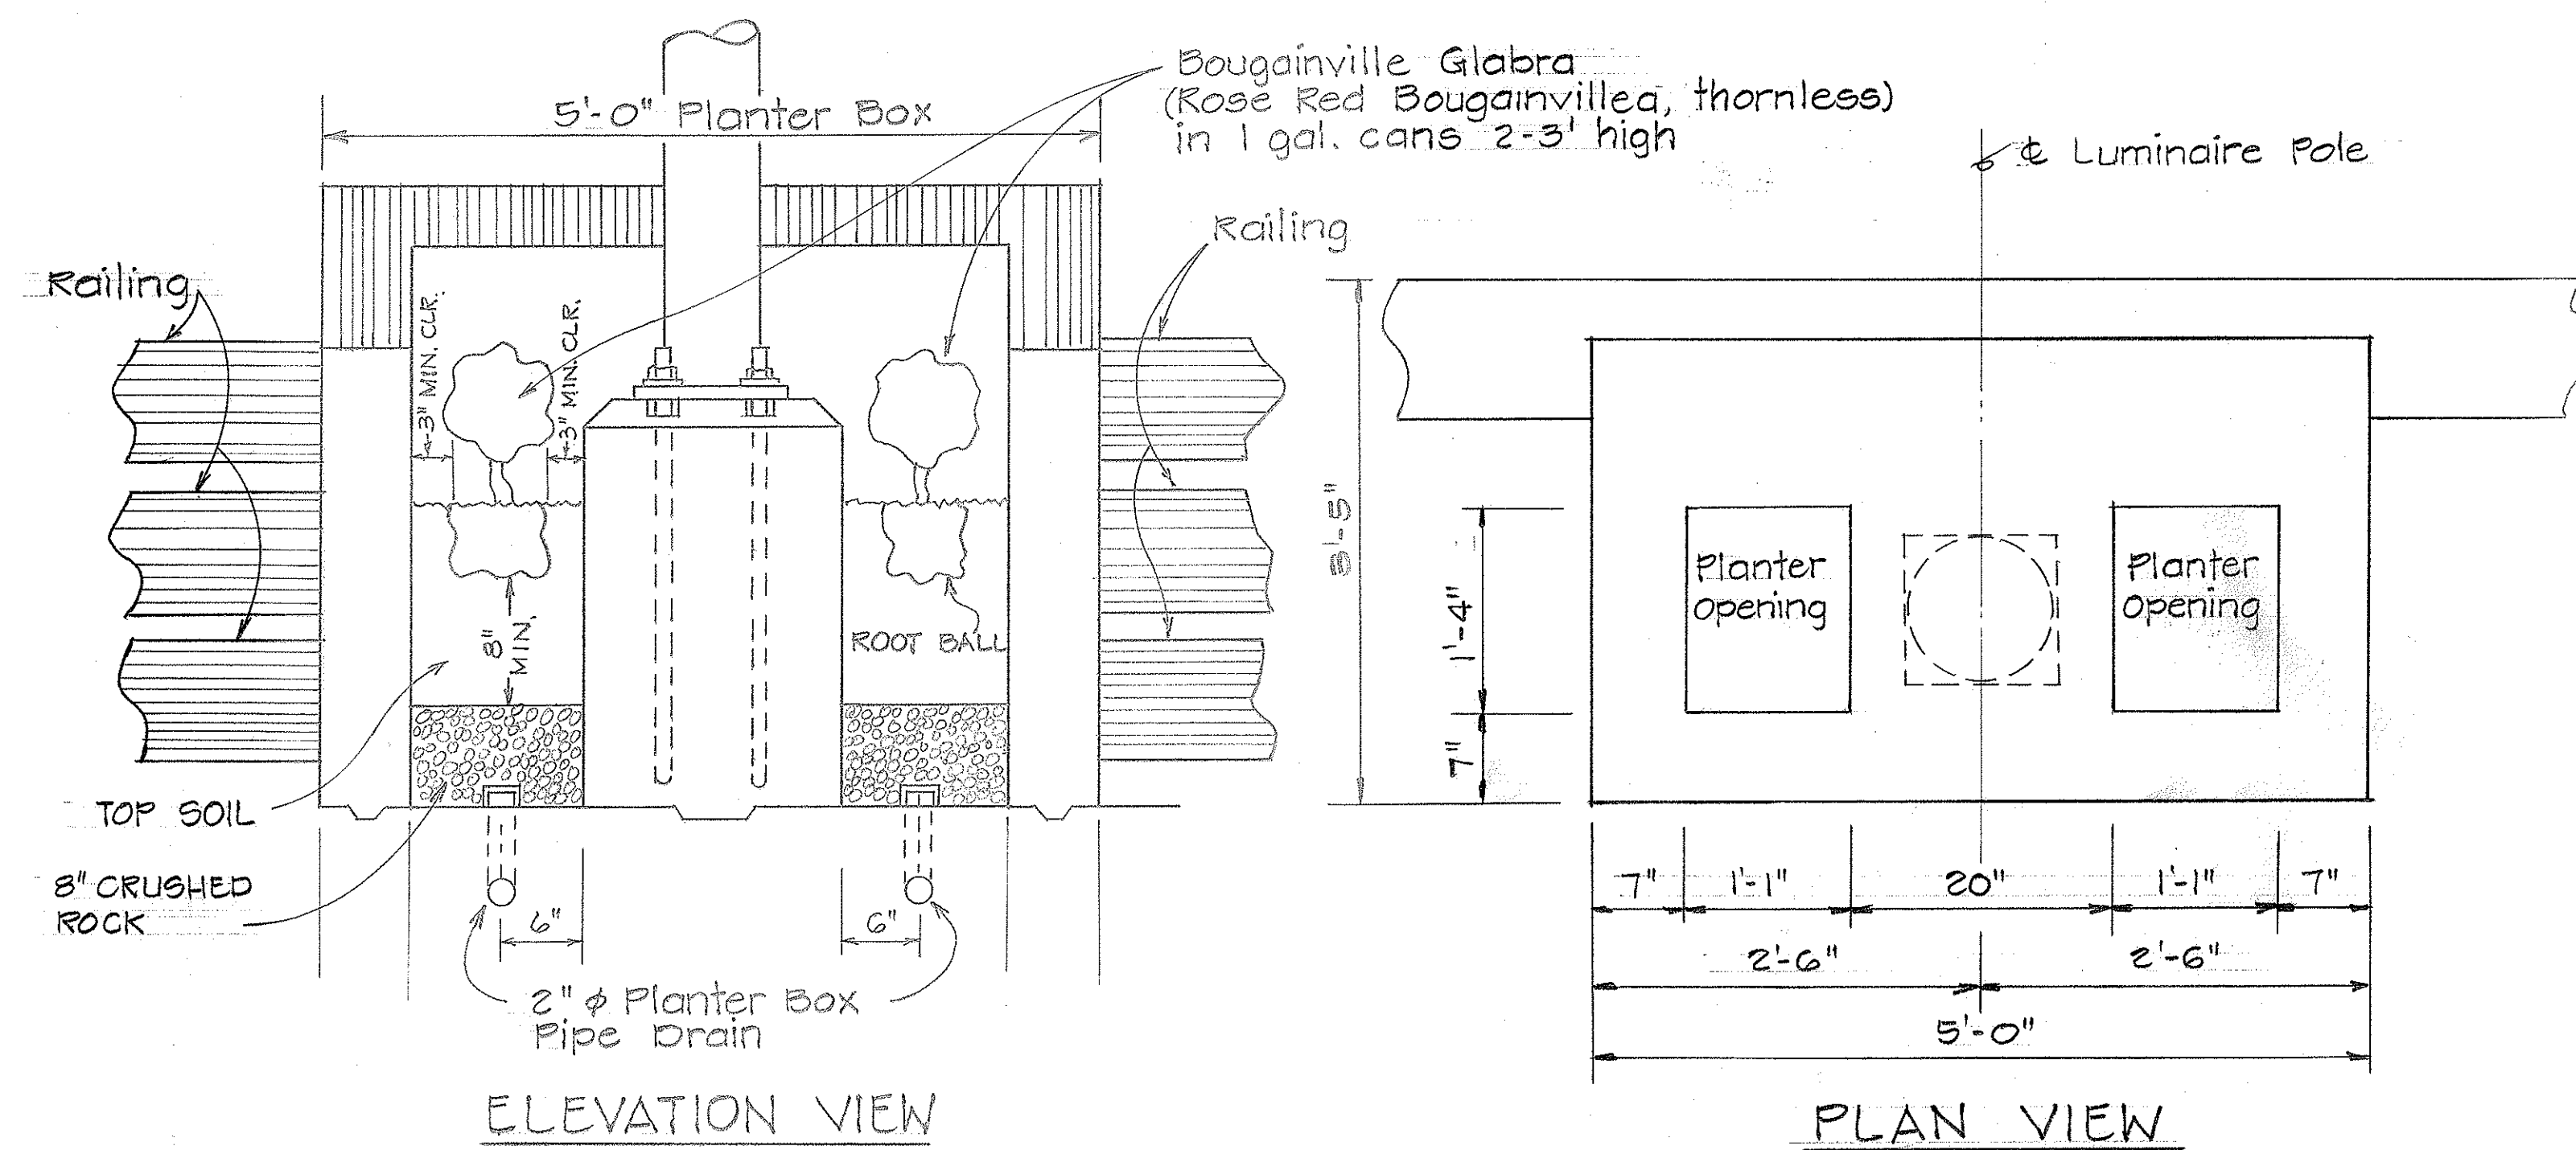

NOTE:

- (1) Top Soil & Crushed Rock shall be incidental to item 619.460 Planting shrubs, Bougainvillea Glabra.
- (2) For additional details, see planter box plans and Sprinkler System Plans.

STATE OF HAWAII DEPARTMENT OF TRANSPORTATION HIGHWAYS DIVISION	
LANDSCAPING	
WILSON BRIDGE AND APPROACHES	
PROJECT NO. BR-F-080-1(7)	
Scale: 1"=1'-0"	DATE: SEPT. 1976
SHEET NO. 1 OF 1 SHEETS	