
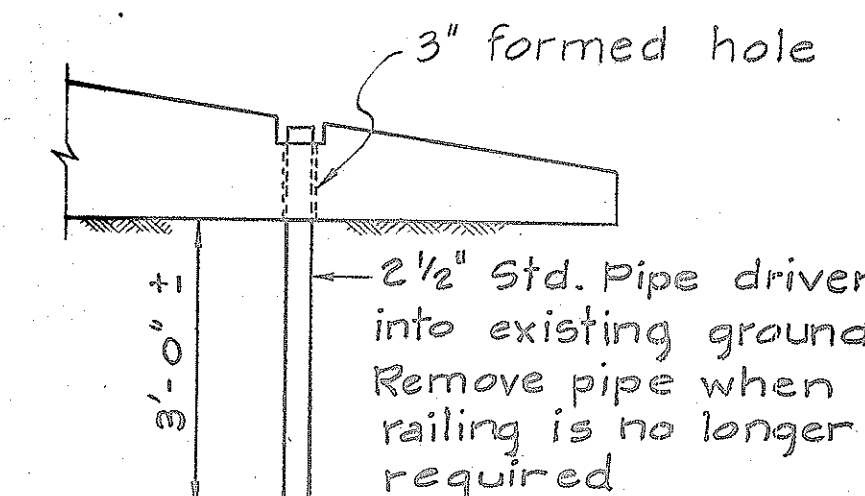
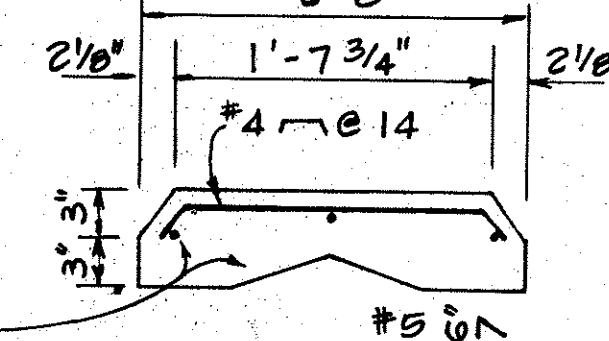
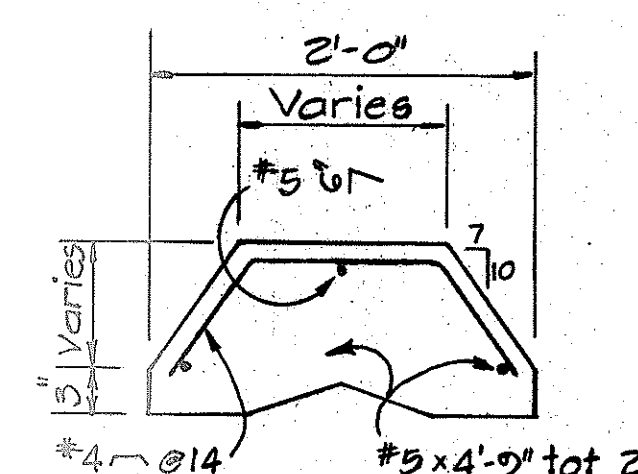
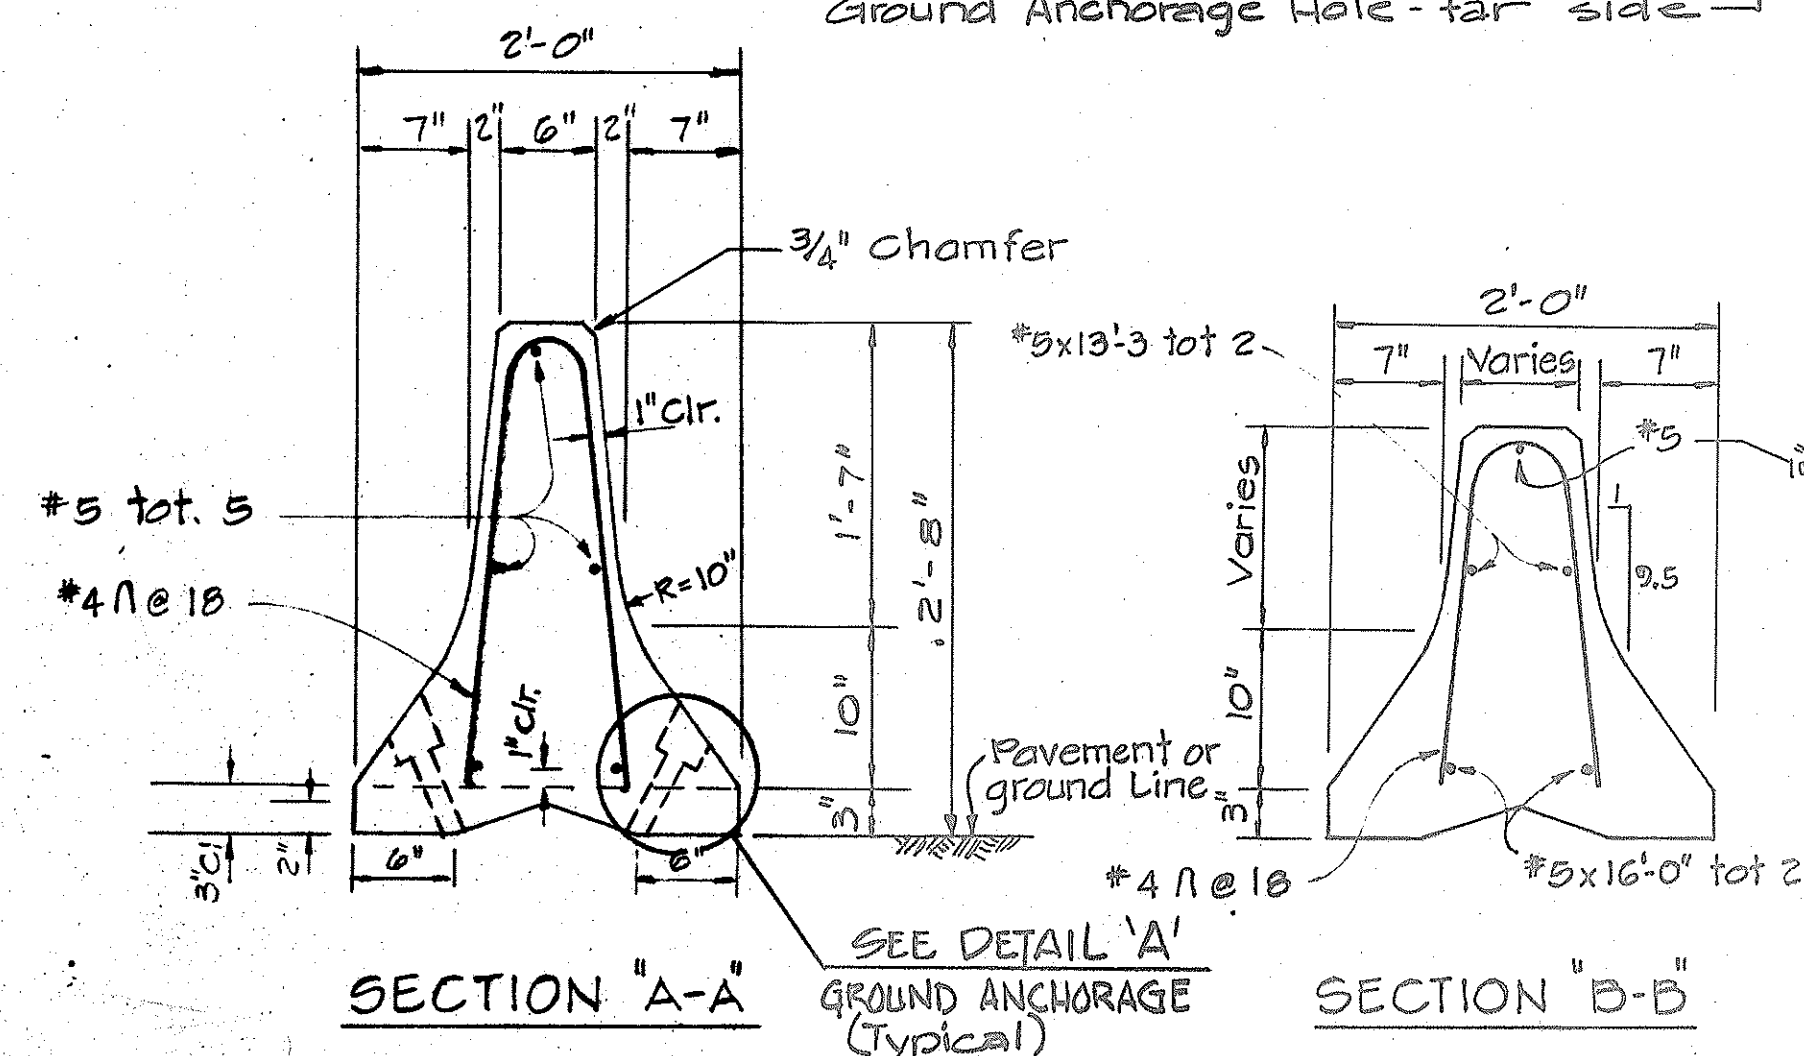





FED. ROAD DIST. NO.	STATE	FED. AID PROJ. NO.	FISCAL YEAR	SHEET NO.	TOTAL SHEETS
HAWAII	HAW.	BR-F-080-1(17)	1977	57	165

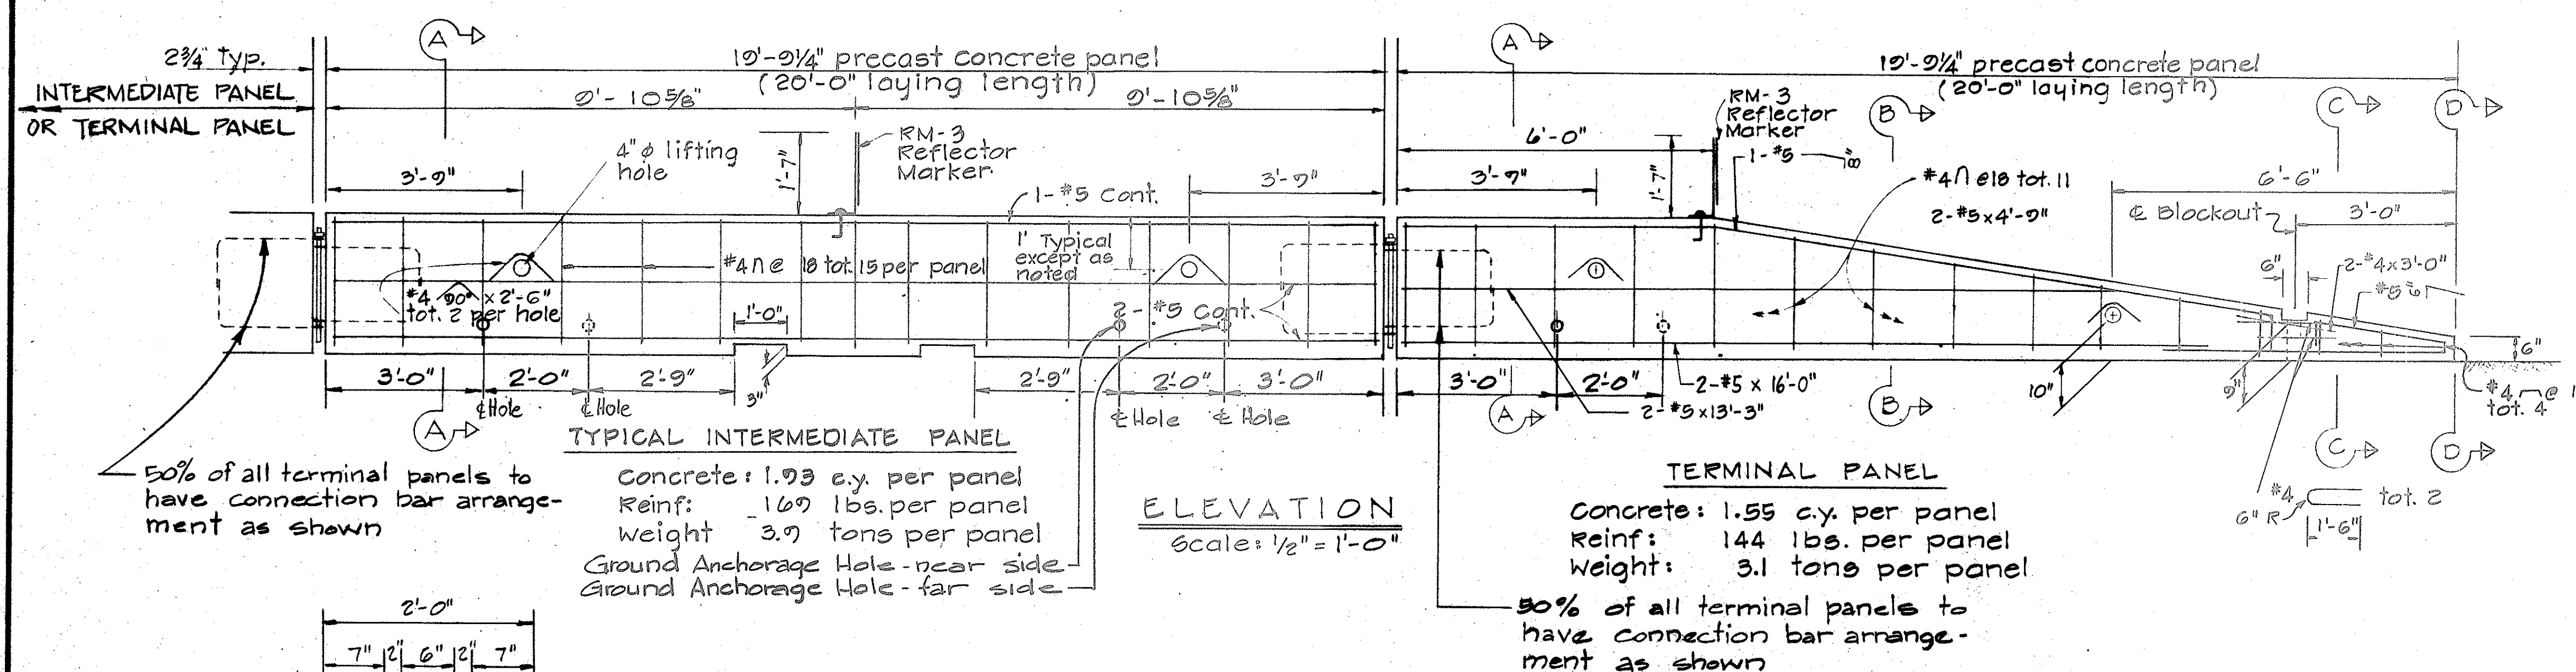

- NOTES

1. For details not shown in Sections BB, C-C, & D-D, see Section A-A.
2. Reflector Marker shall not be paid for separately but shall be considered incidental to "Portable Concrete Guard Rail."
3. Concrete shall be Class "A".
4. All bolts to have cut washers unless otherwise noted.
5. Portable Concrete Guard Rails shall be constructed as shown to accommodate grounding anchorages, however anchoring with steel pins will not be allowed.

SECTIONS
Scale: 1" = 1'-0"

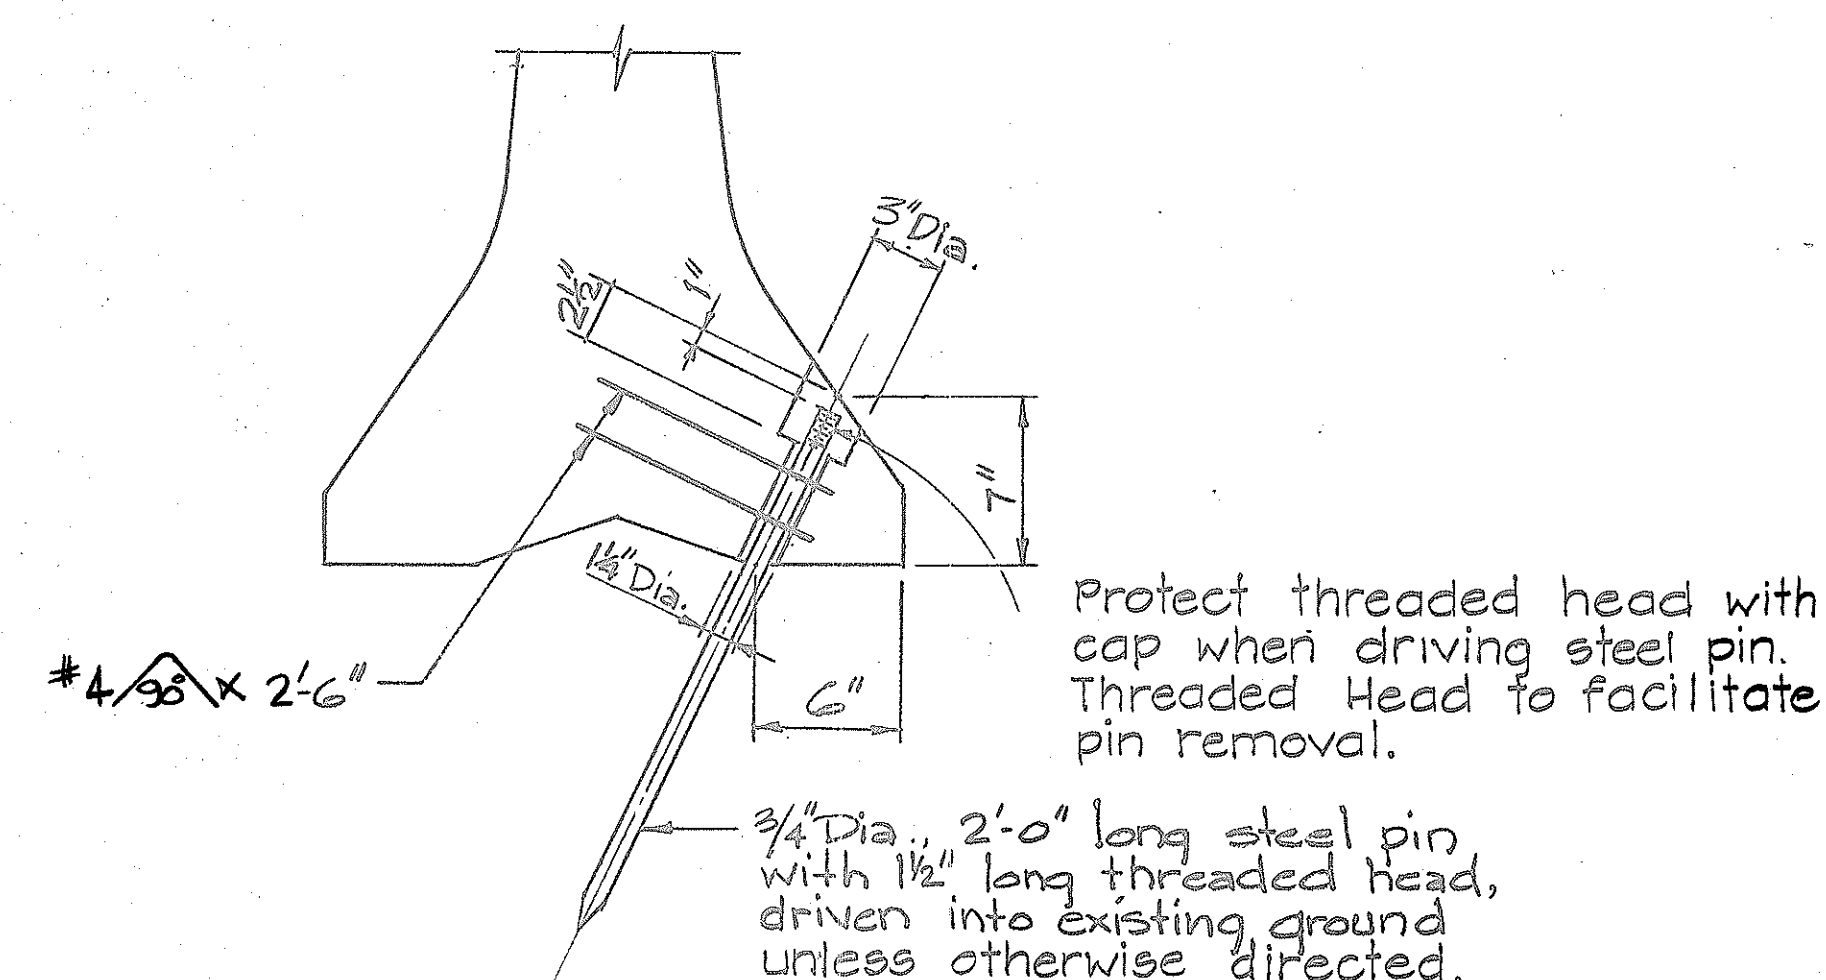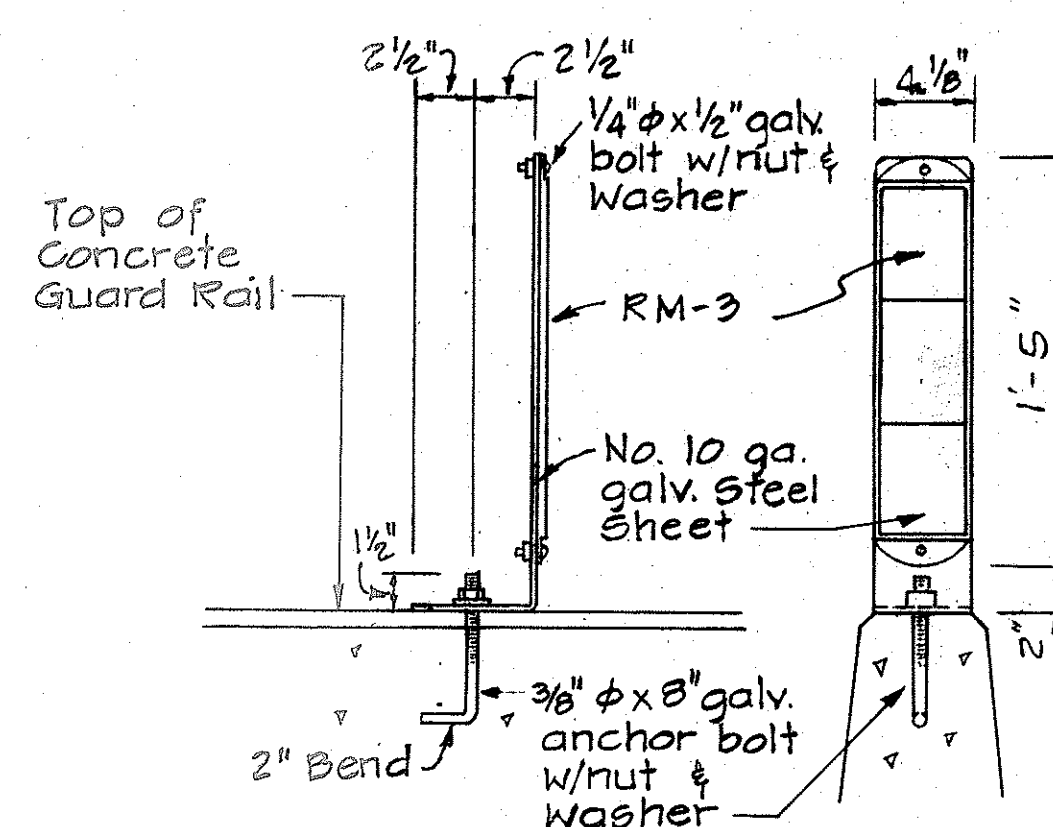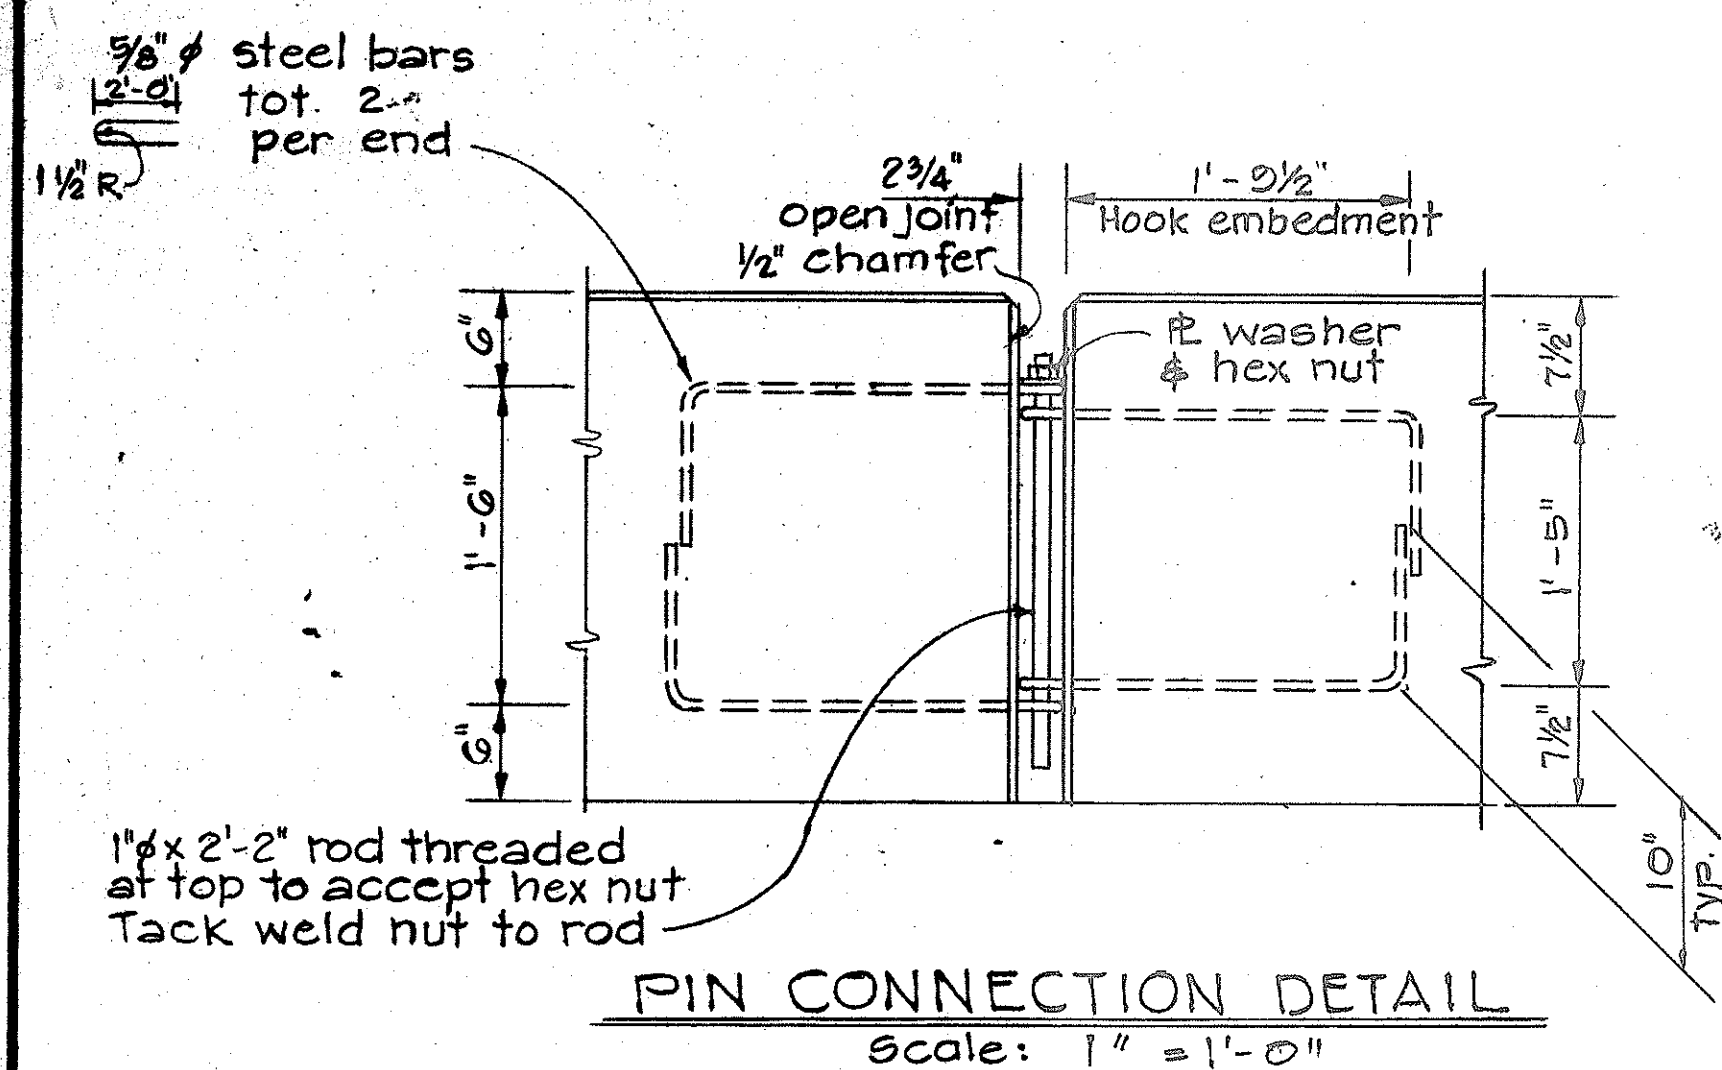

STATE OF HAWAII
DEPARTMENT OF TRANSPORTATION
HIGHWAYS DIVISION

PORTABLE CONCRETE GUARD
RAIL TYPICAL DETAILS

PROJ. No. BR=F-080-1(7)

Scale: As Noted Date: August, 1976

SHEET No. 1 OF 1 SHEETS