



| FED. ROAD DIST. NO. | STATE | PROJ. NO.  | FISCAL YEAR | SHEET NO. | TOTAL SHEETS |
|---------------------|-------|------------|-------------|-----------|--------------|
| HAWAII              | HAW.  | 80B-01-80M | 1980        | 2         | 5            |

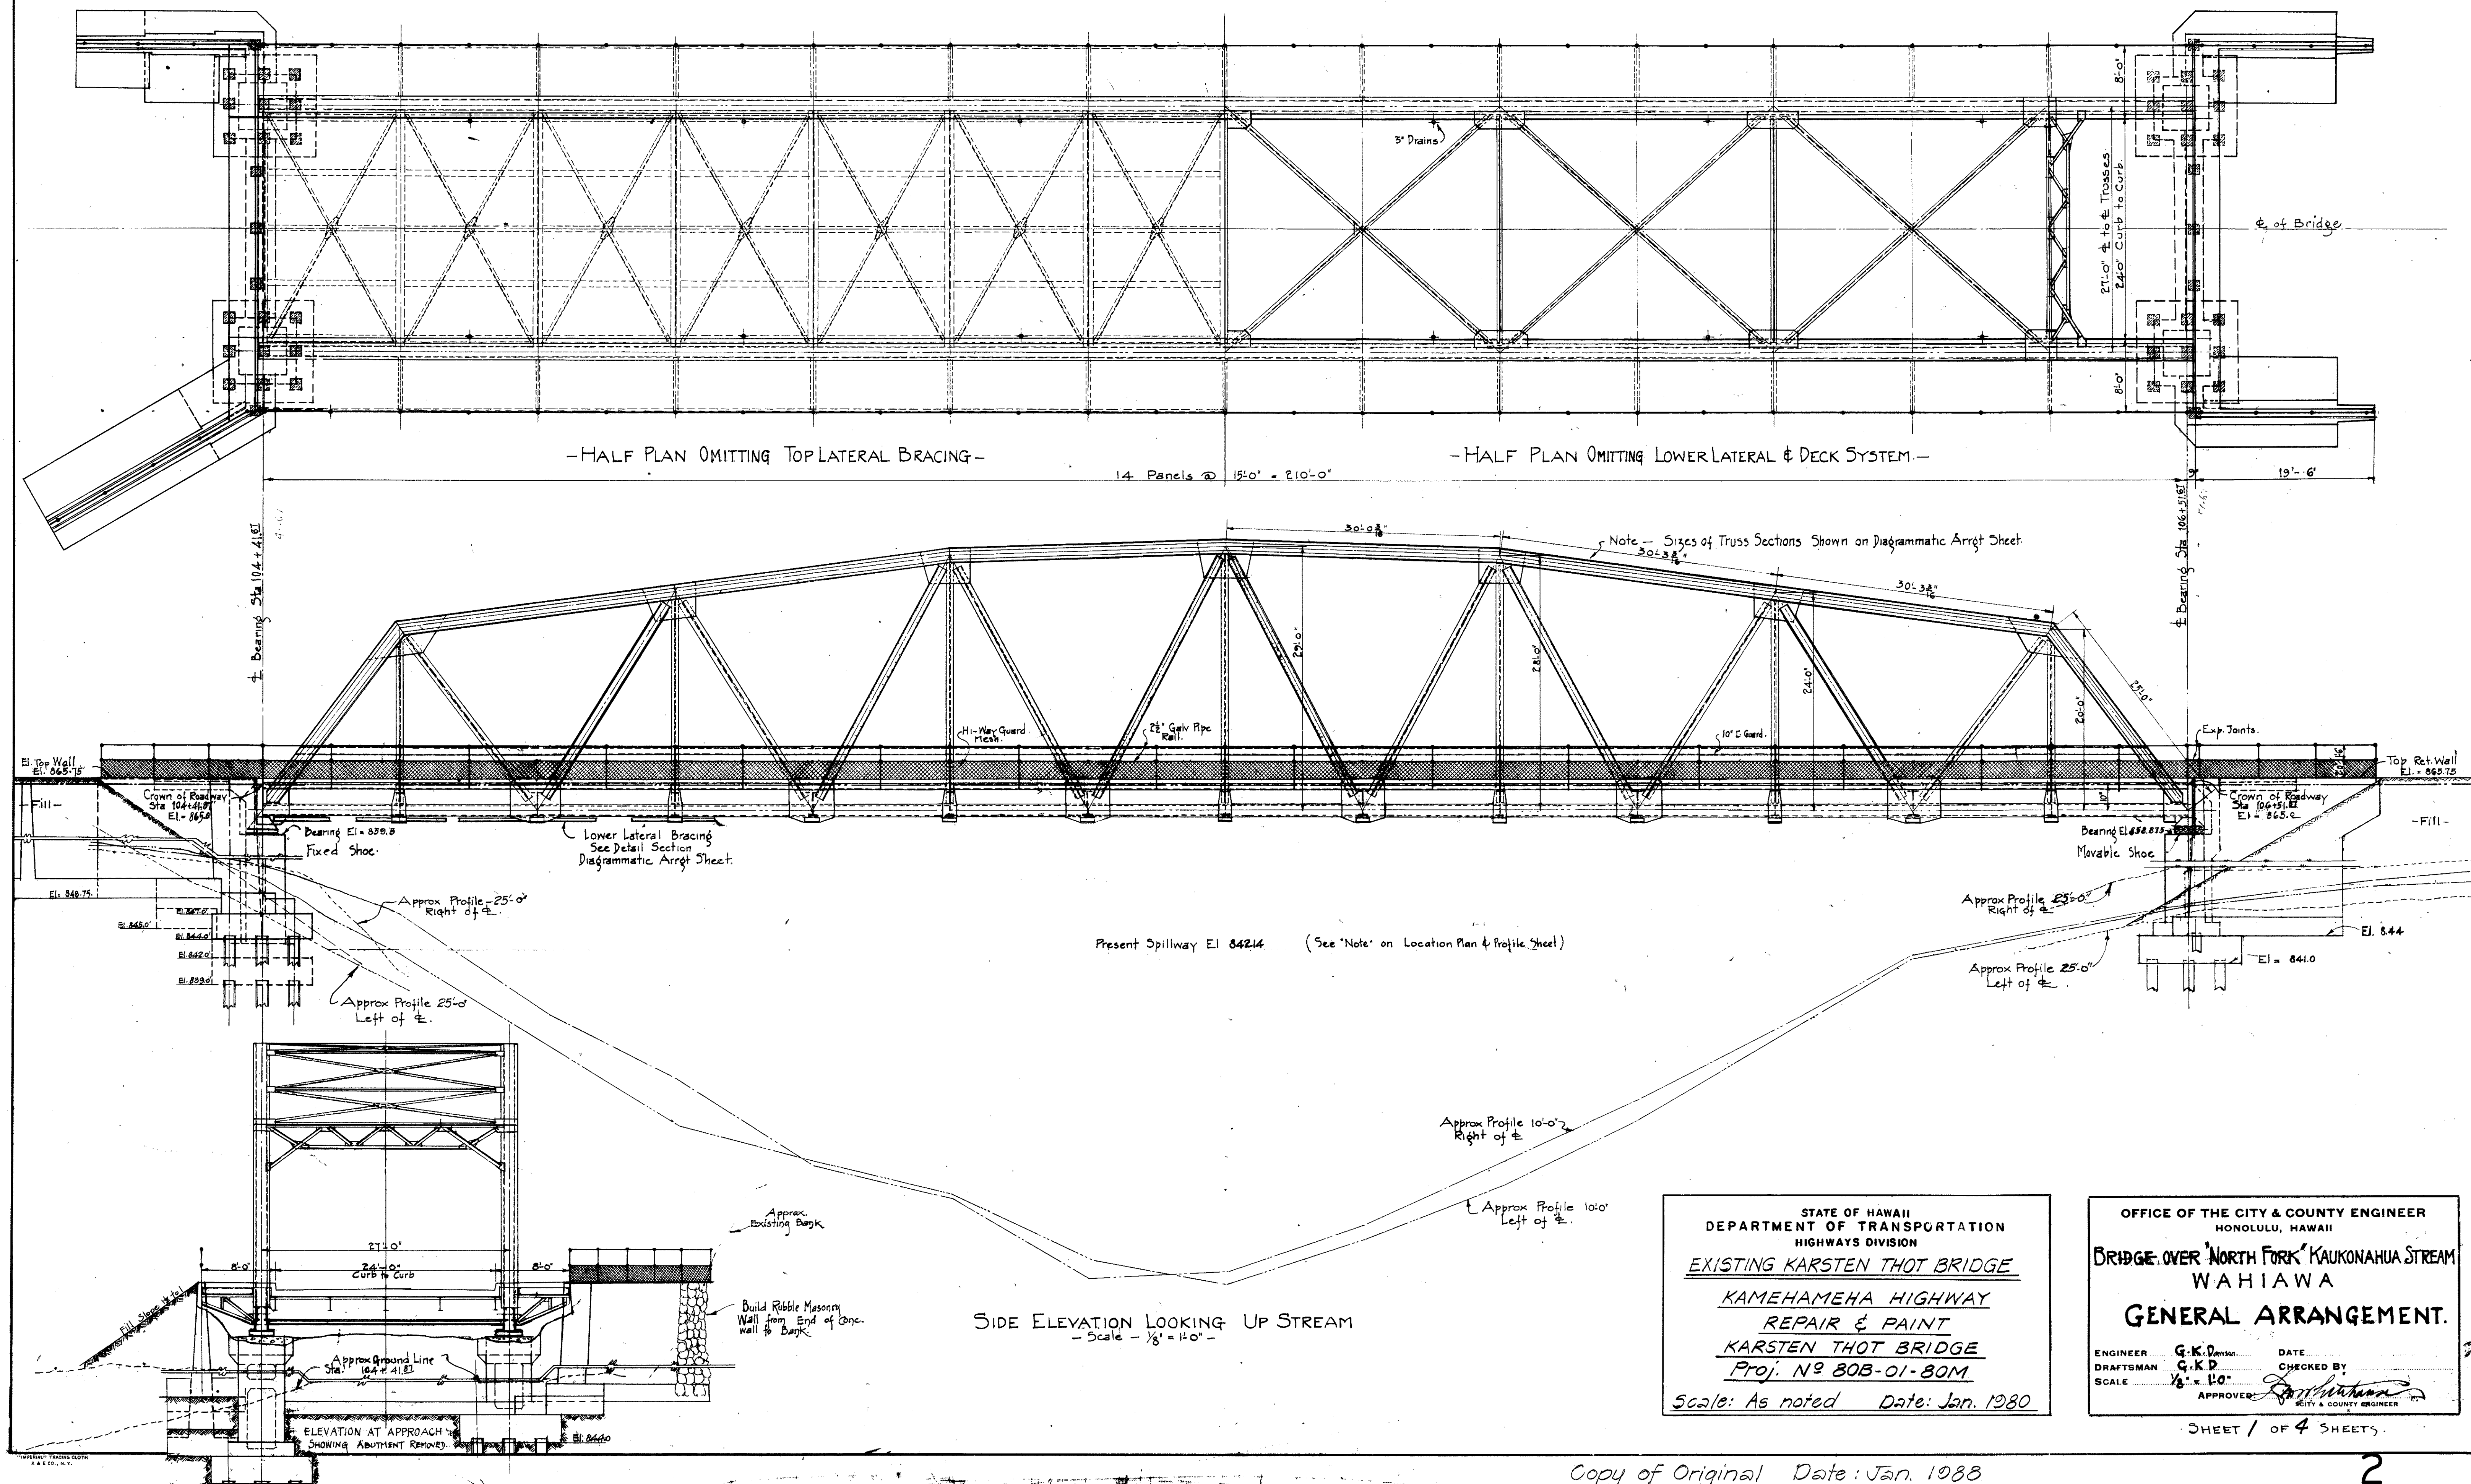


Copy of Original Date: Jan. 1988

| FED. ROAD DIST. NO. | STATE | PROJ. NO.  | FISCAL YEAR | SHEET NO. | TOTAL SHEETS |
|---------------------|-------|------------|-------------|-----------|--------------|
| HAWAII              | HAW.  | 80B-01-80M | 1980        | 3         | 5            |

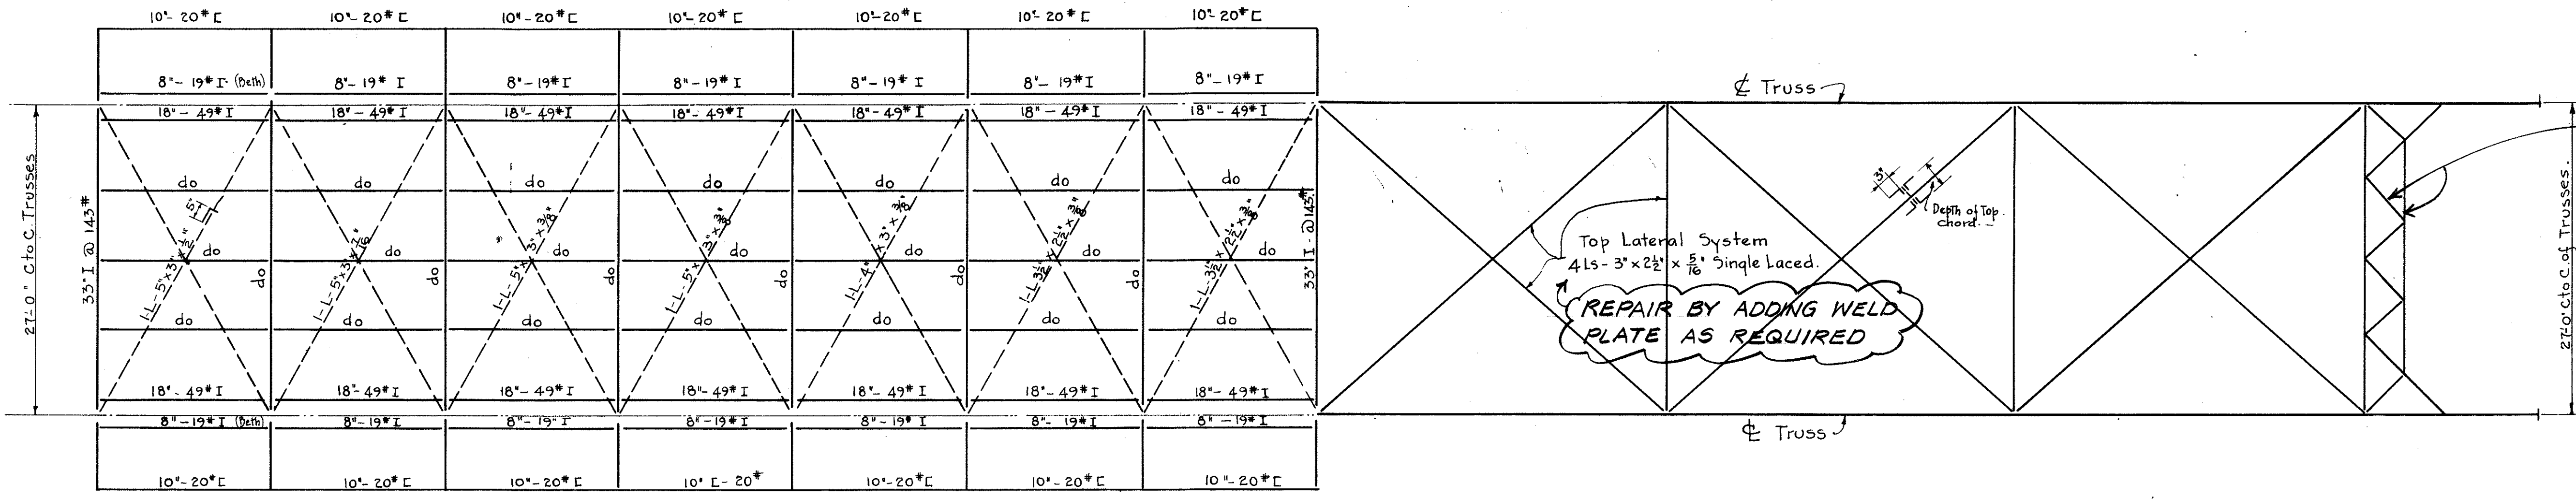


REPAIR BRACING AS REQUIRED


REPAIR BY ADDING WELD PLATE AS REQUIRED

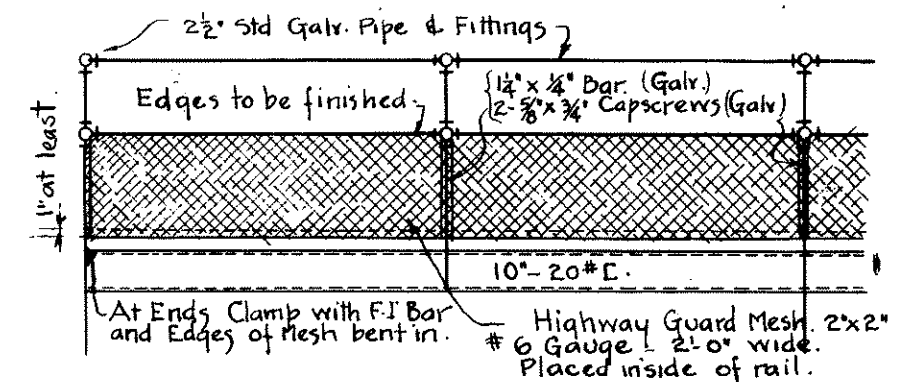




DIAGRAMMATIC ELEVATION OF RAILING SHOWING MESH & METHOD OF FASTENING.

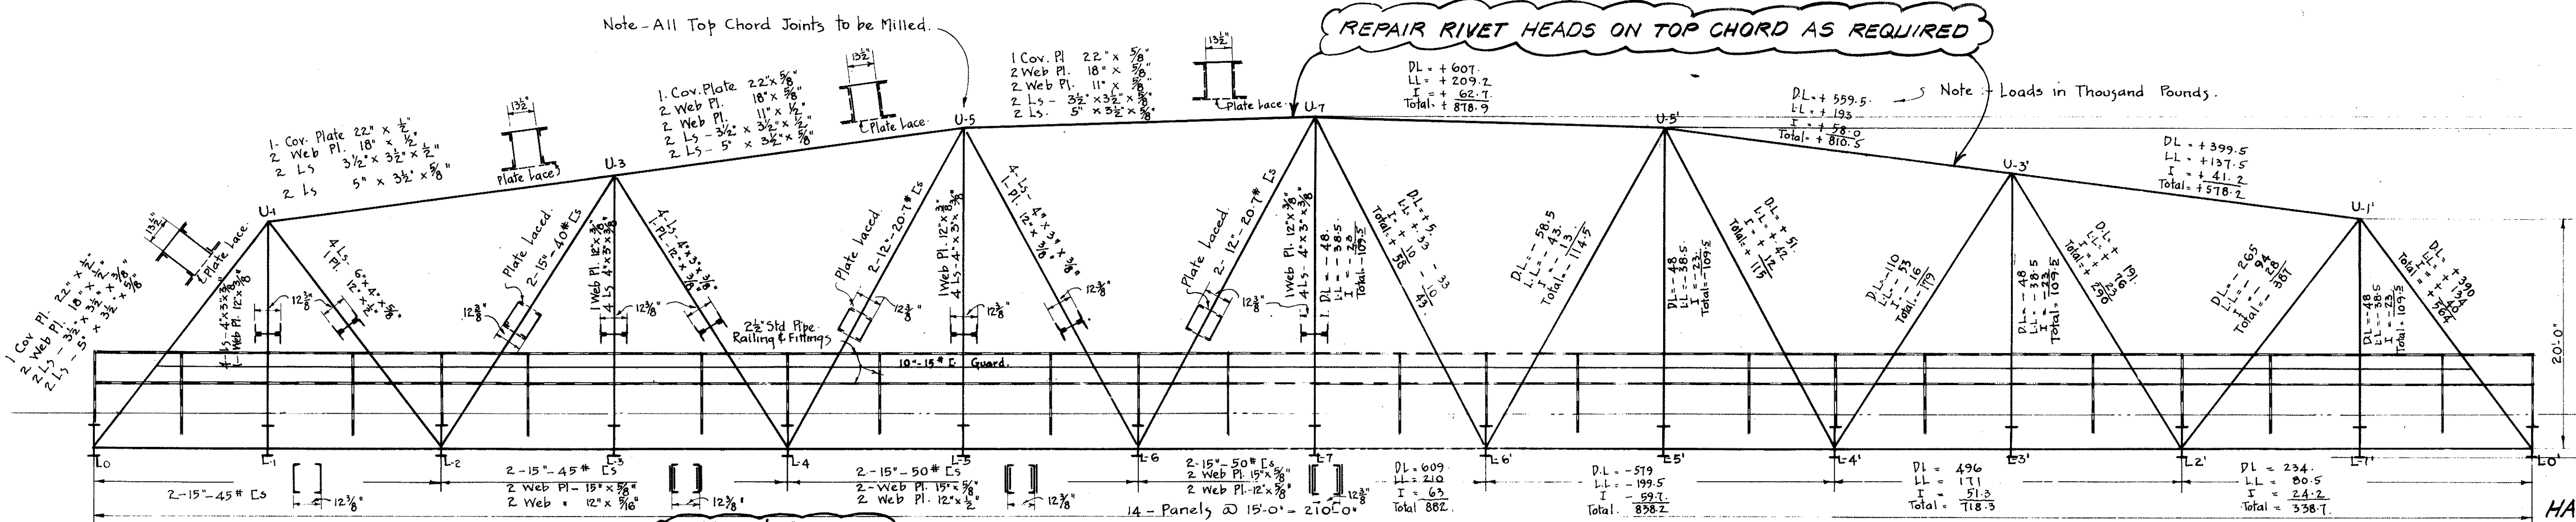

REPAIR RIVET HEADS ON TOP CHORD AS REQUIRED

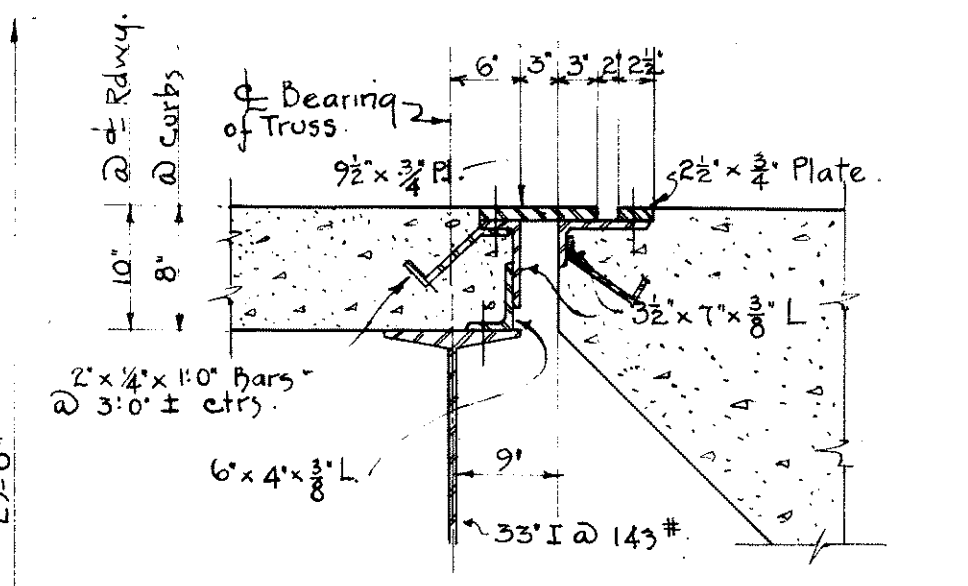

DETAIL AT EXPANSION JOINT AT ABUTMENT. (See Sheet 6.) Use asphaltic Joint at Sidewalk where shown Scale = 3/4" = 1'-0".

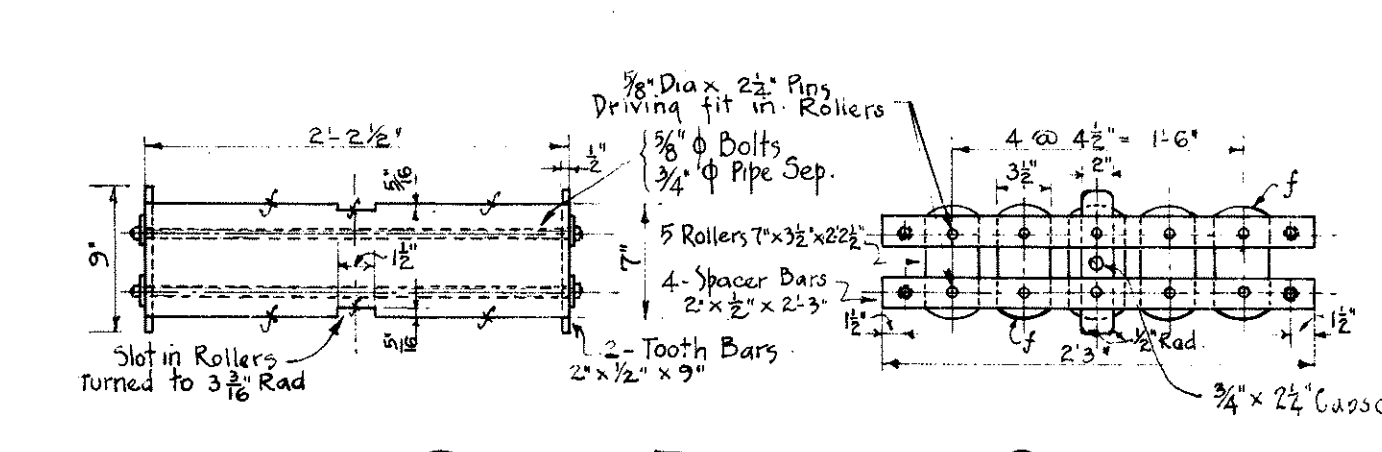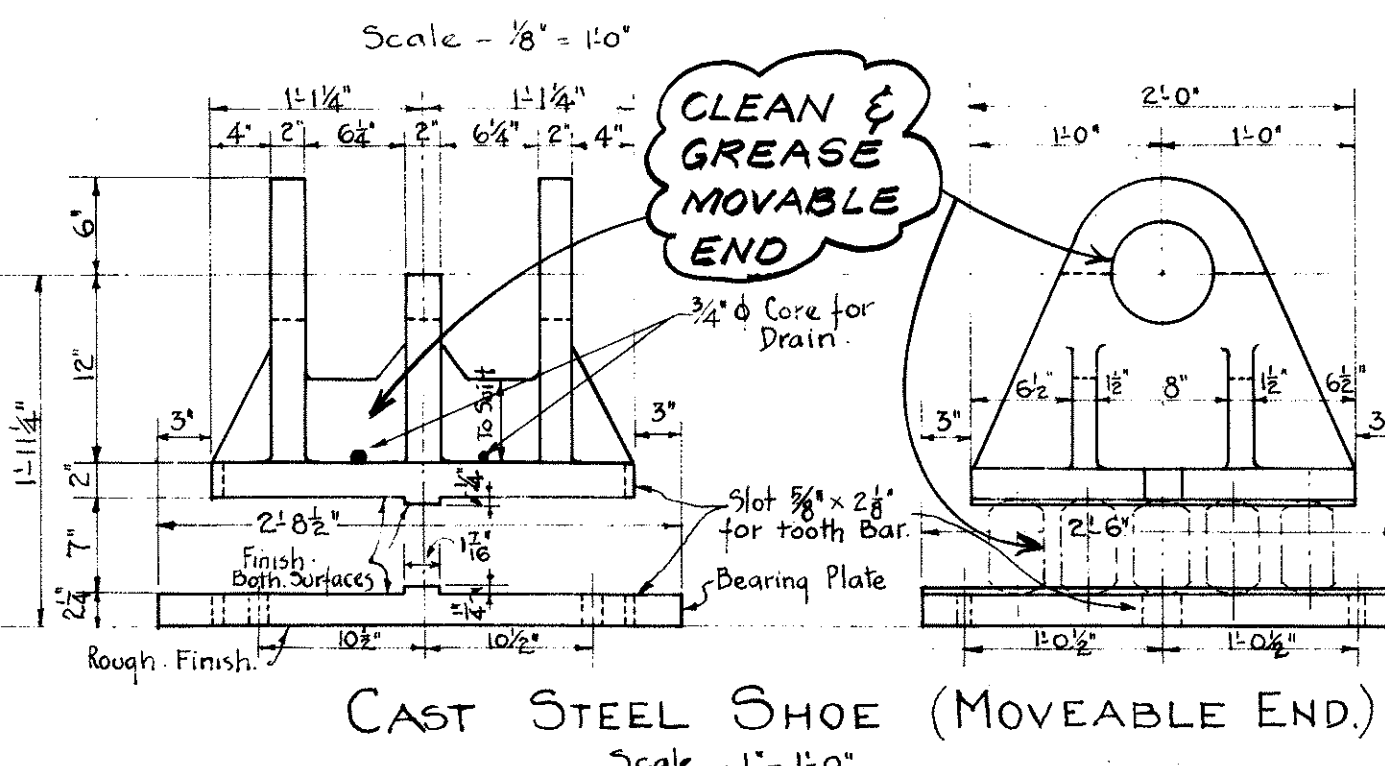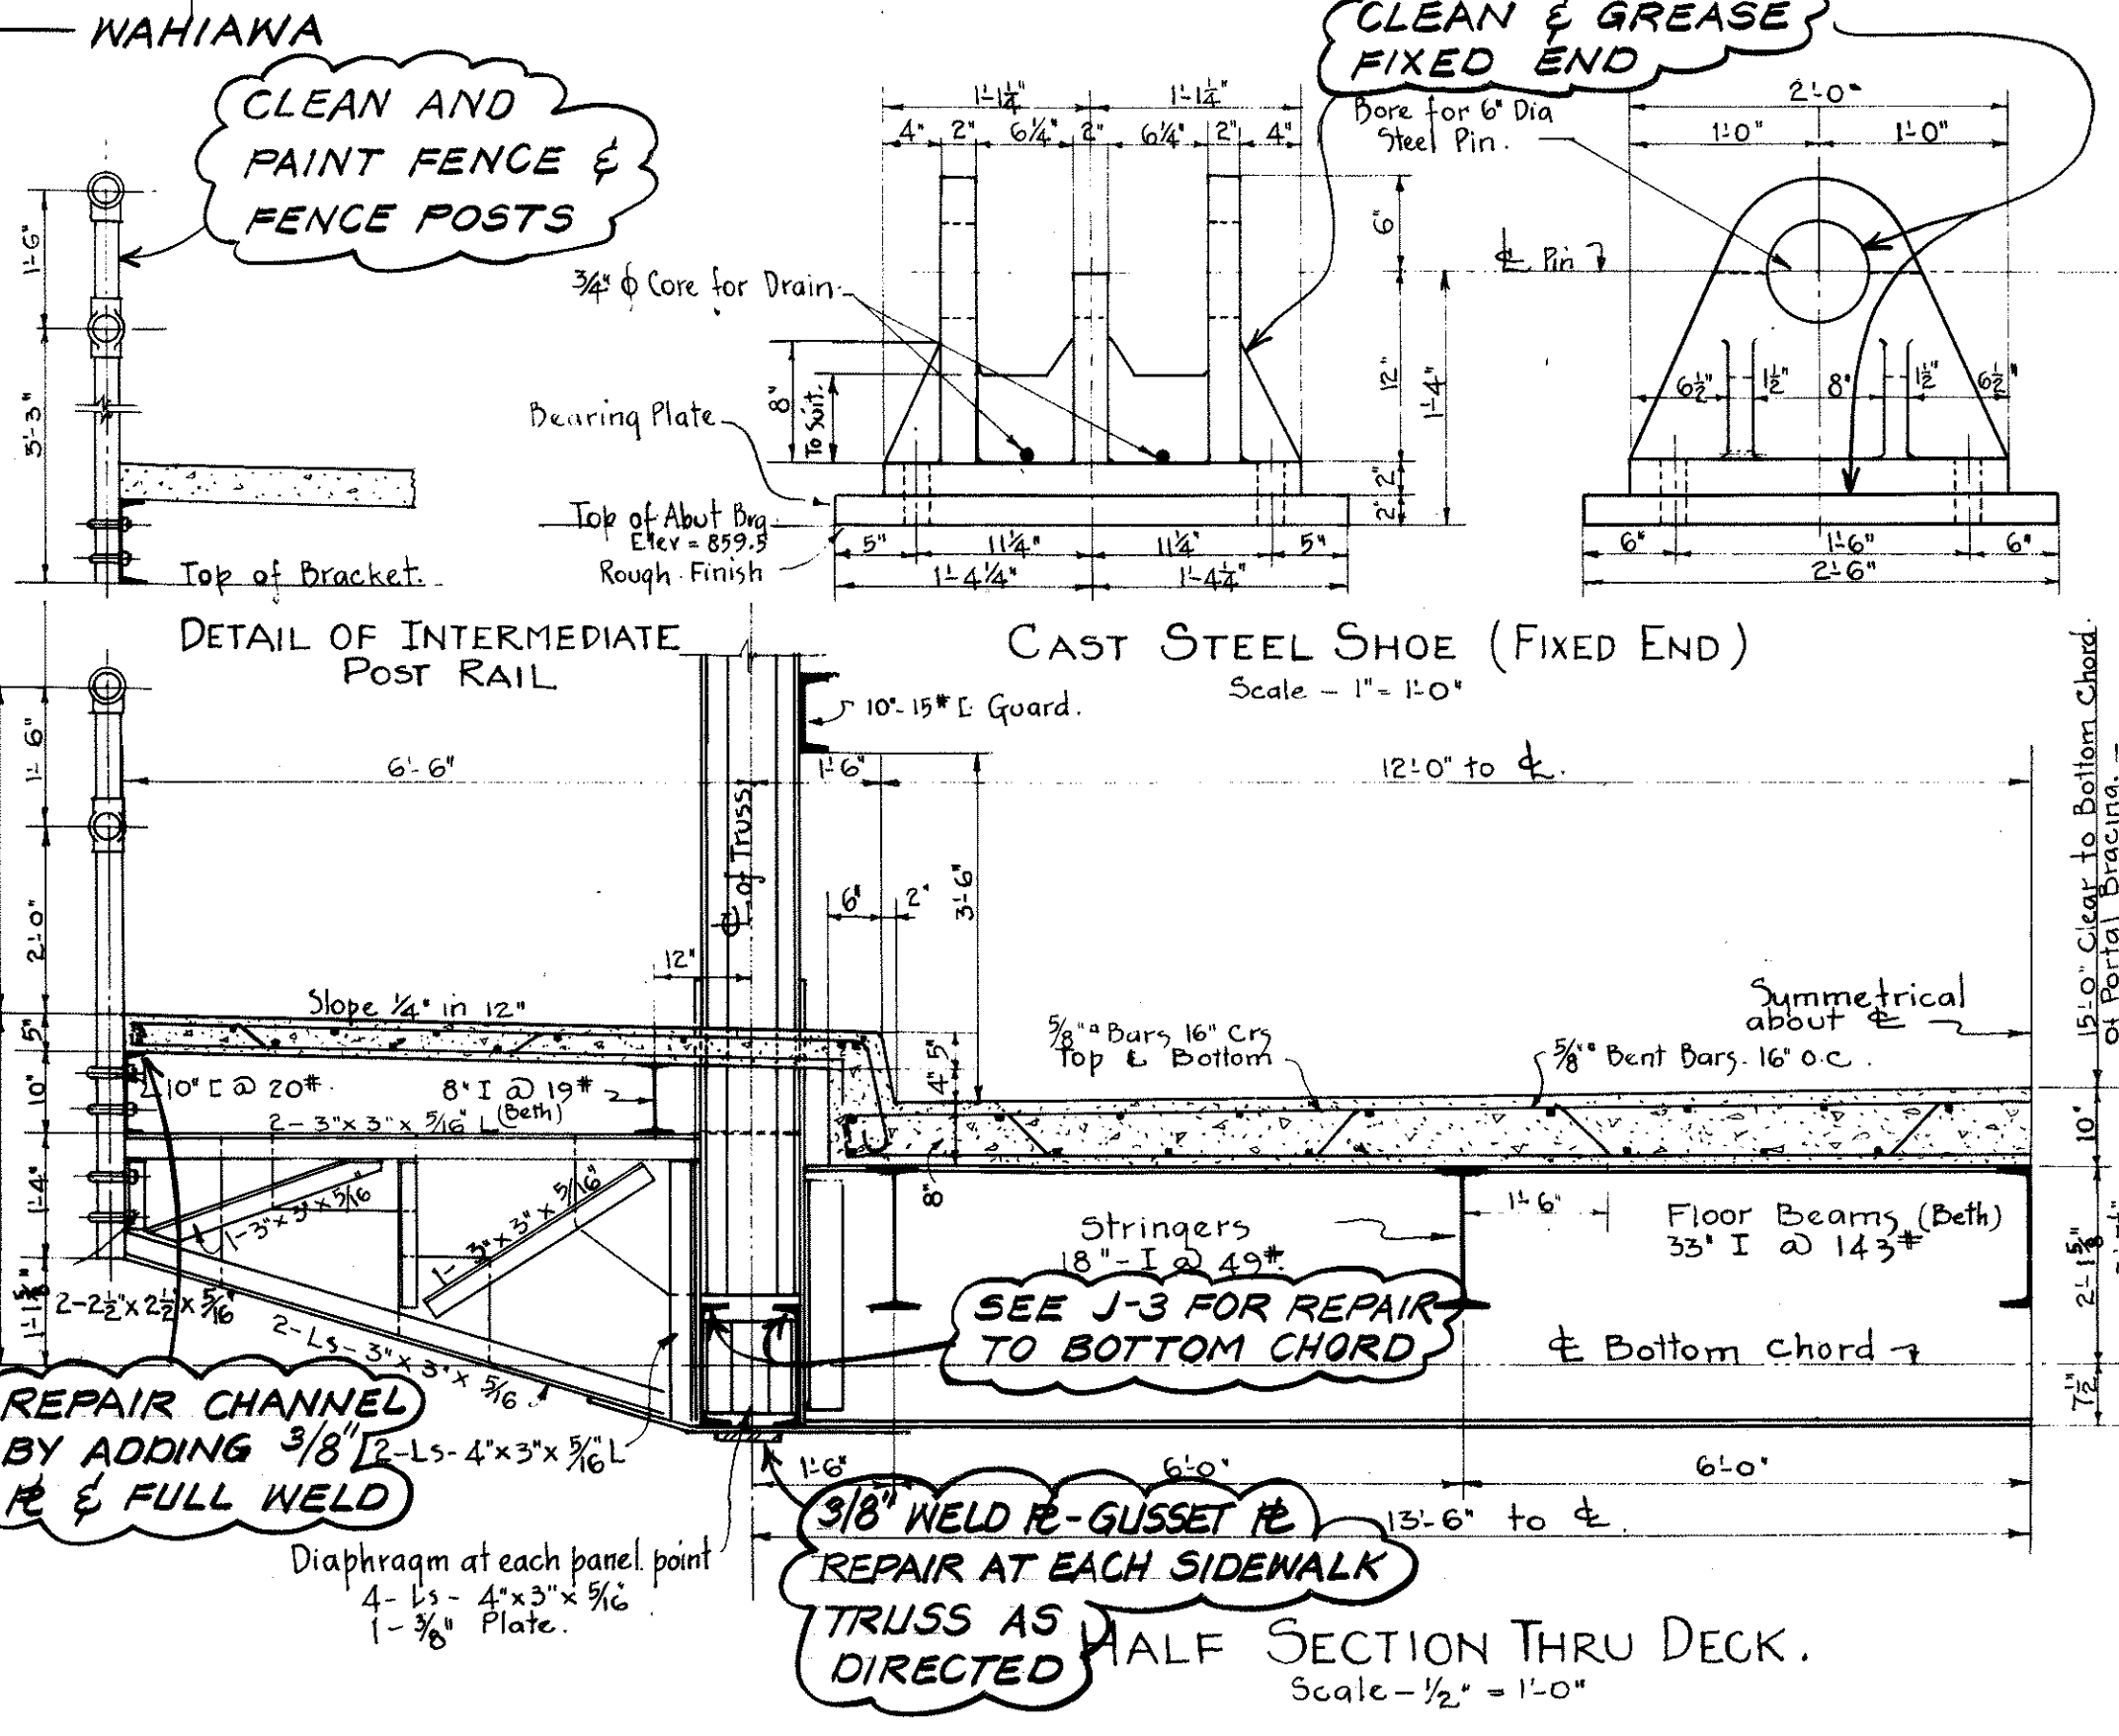


NOTE DENOTES CLEANING OR REPAIR WORK OF EXISTING KARSTEN THOT BRIDGE STRUCTURE.

STATE OF HAWAII  
DEPARTMENT OF TRANSPORTATION  
HIGHWAYS DIVISION  
**TYPICAL REPAIR DETAILS**  
KAMEHAMEHA HIGHWAY  
REPAIR & PAINT  
KARSTEN THOT BRIDGE  
Proj. No 80B-01-80M  
Scale: As noted Date: Jan. 1980

OFFICE OF THE CITY & COUNTY ENGINEER  
HONOLULU, HAWAII  
BRIDGE OVER NORTH FORK "KAUKONAHUA STREAM"  
WAHIAWA  
STRUCTURAL STEEL DESIGN  
ENGINEER G.K. Dawson  
DRAFTSMAN G.K. Dawson  
SCALE As Noted  
APPROVED: [Signature]  
DATE  
CHECKED BY  
CITY & COUNTY ENGINEER


INTERMEDIATE SWAY BRACING.

| FED. ROAD DIST. NO. | STATE | PROJ. NO.  | FISCAL YEAR | SHEET NO. | TOTAL SHEETS |
|---------------------|-------|------------|-------------|-----------|--------------|
| HAWAII              | HAW.  | 80B-01-80M | 780         | 4         | 5            |

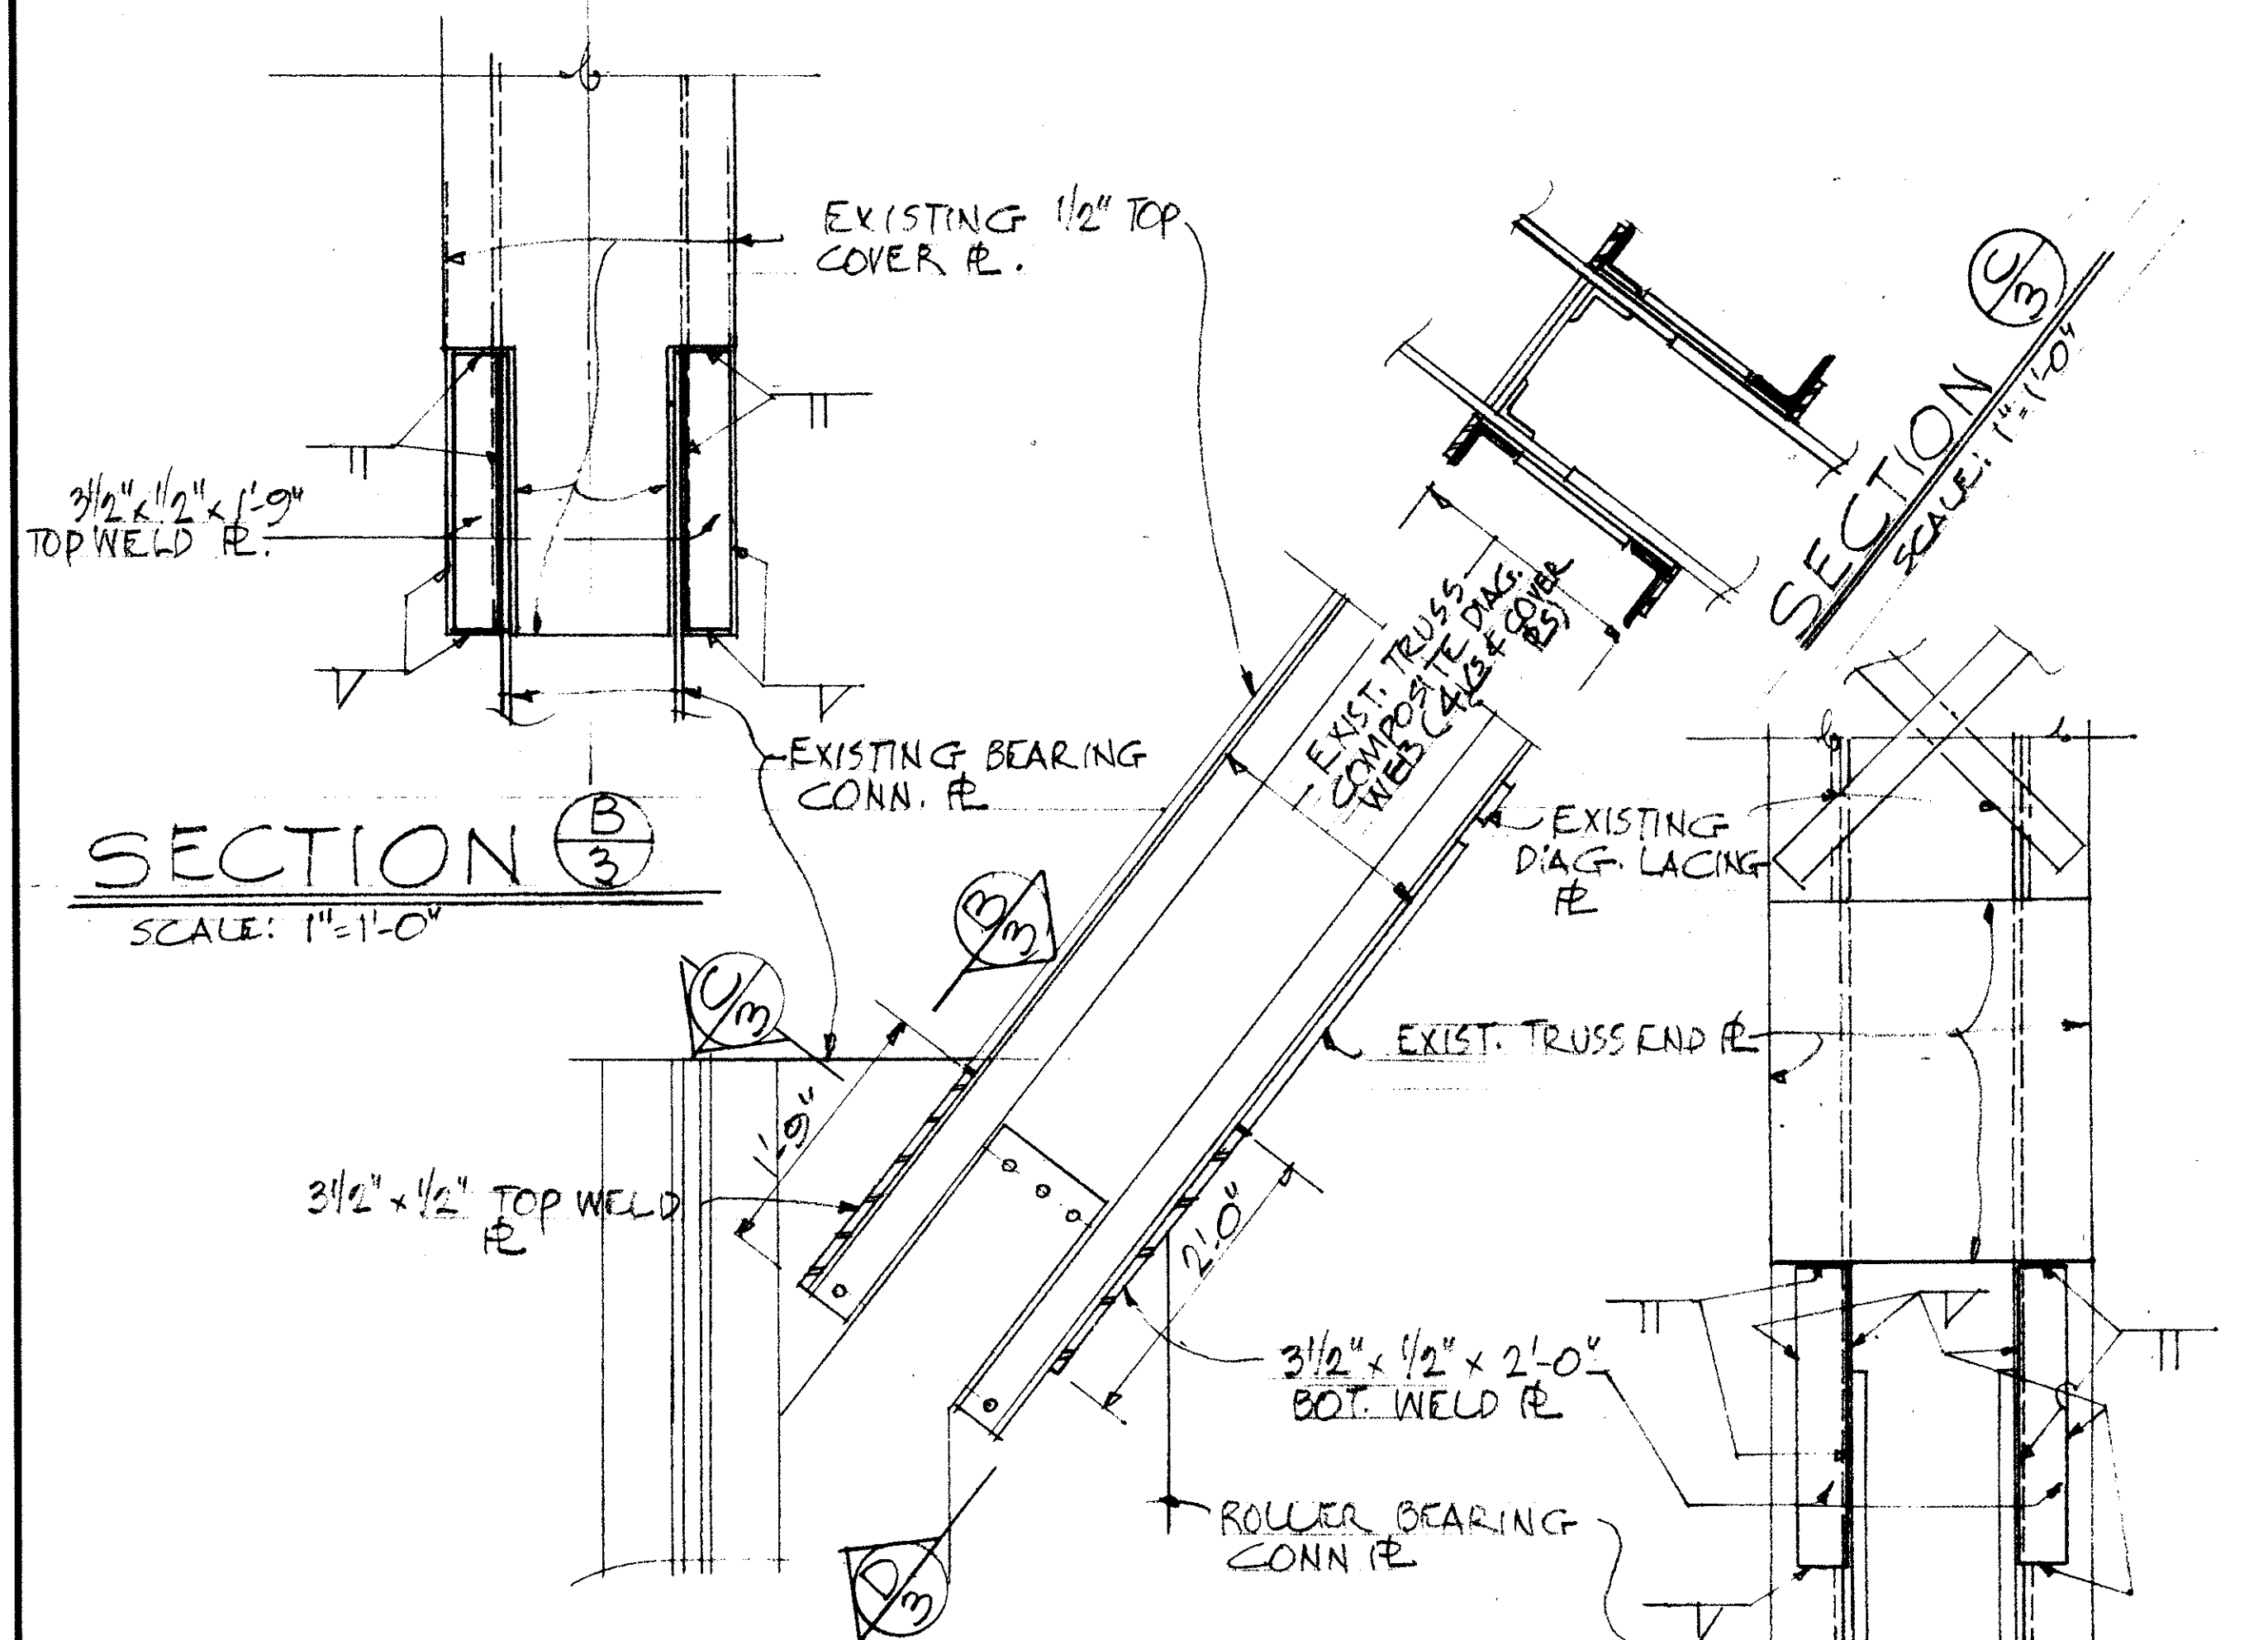


SECTION   
SCALE: 1" = 1'-0"

SECTION  
SCALE: 1"=1'-0"

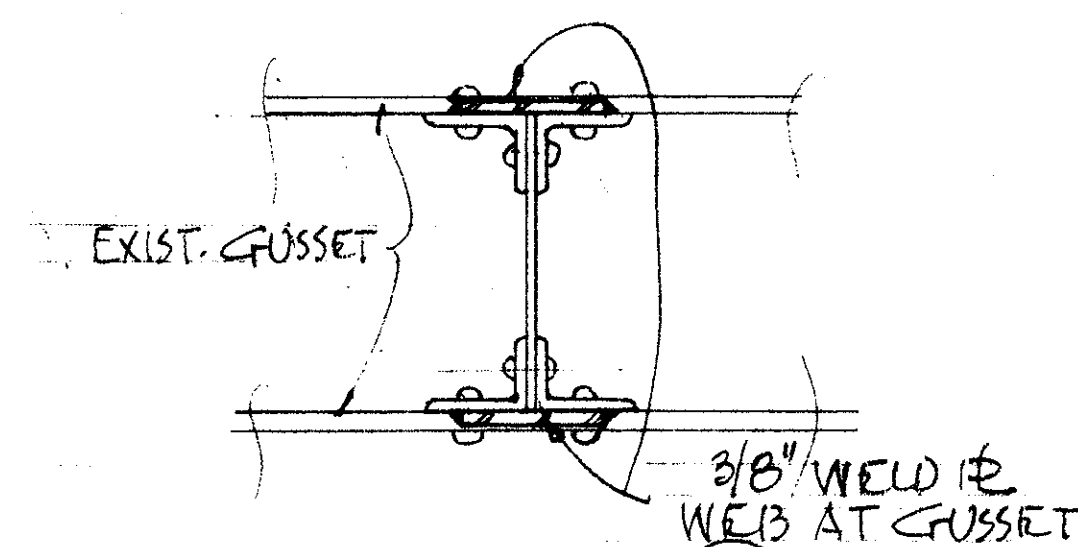


SECTION  $\left( \frac{E}{3} \right)$   
SCALE:  $1\frac{1}{2}'' = 160'$

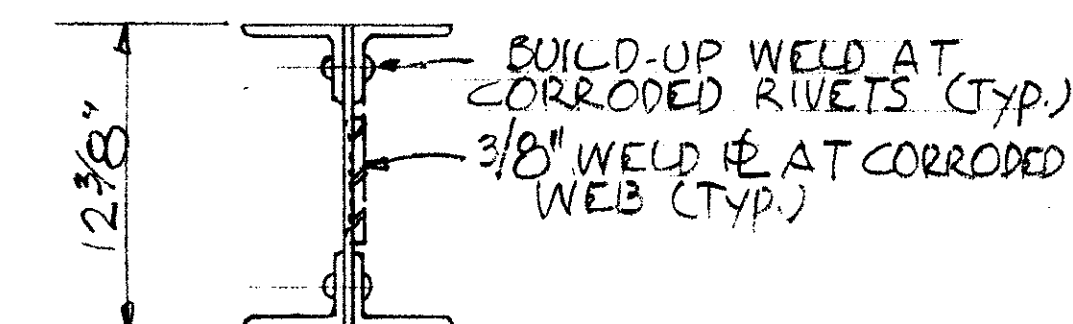


TYPICAL SECTION  $\left(\frac{F}{3}\right)$   
SCALE:  $1\frac{1}{2}" = 1'-0"$

NOTE: REFER TO SHEET #4 FOR DETAILS OF  
REPAIRS TO EXISTING VERTICAL & DIAGONAL  
WEB MEMBERS.

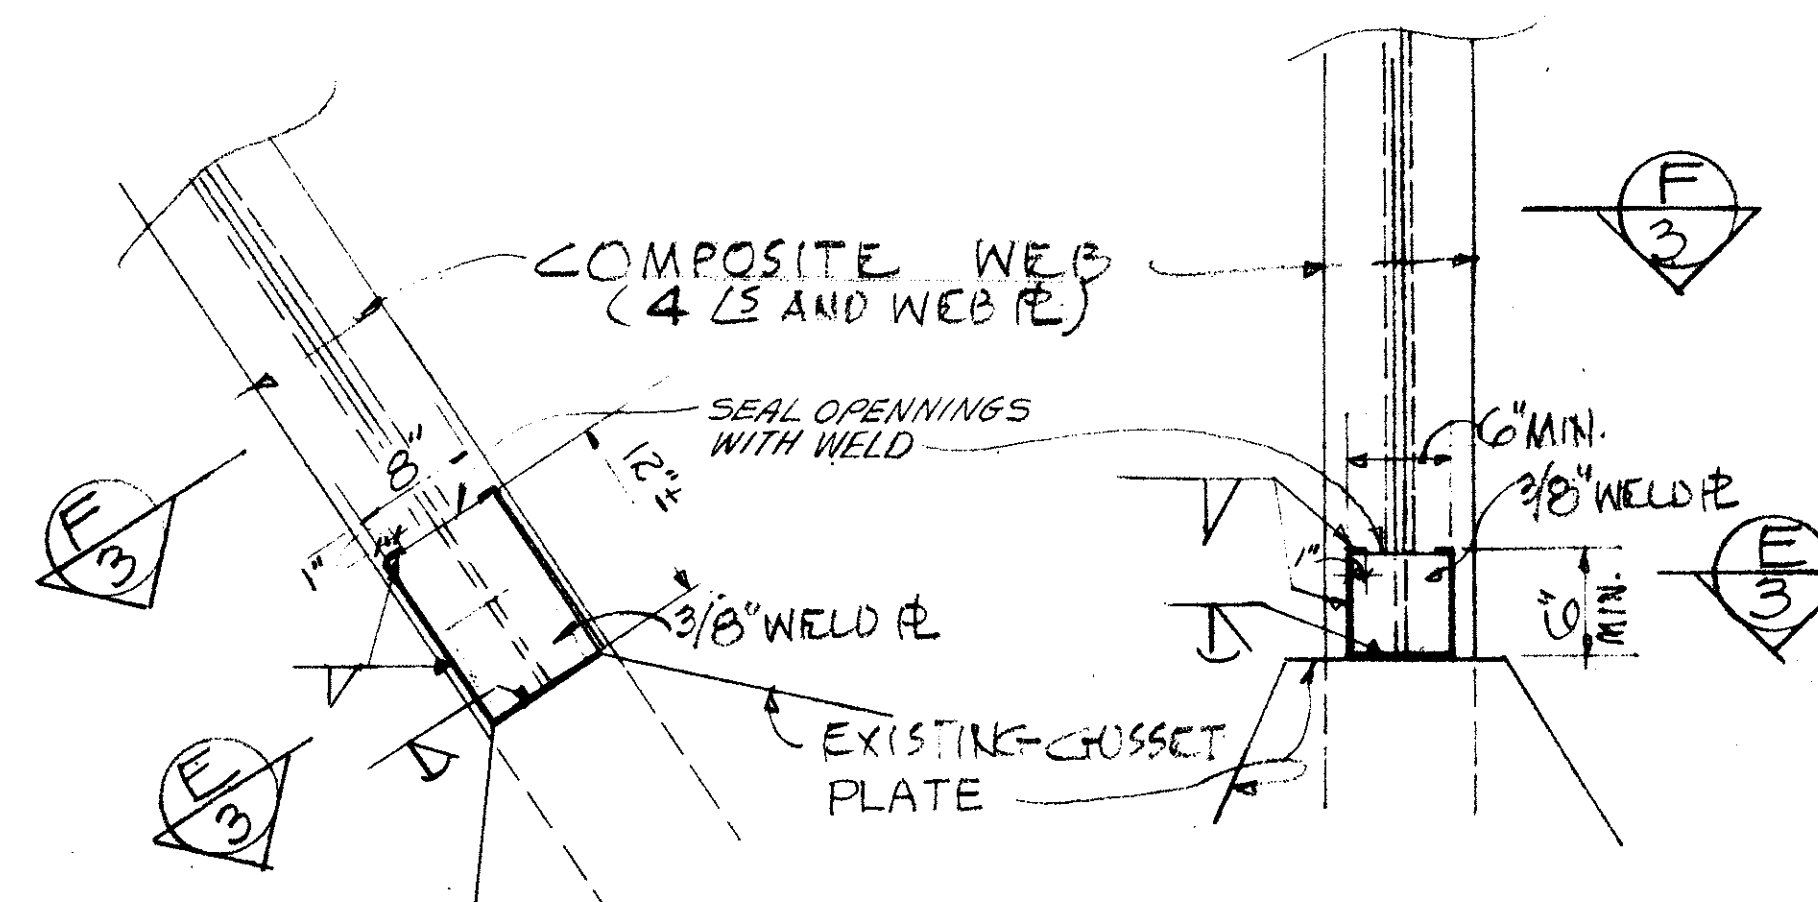

AT DIAGONAL MEMBER      AT VERTICAL MEMBER  
(MOST DIAGONALS HAD BEEN REPAIRED BUT  
ADDITIONAL WELD MAY BE REQUIRED)

ELEVATION • TRUSS COMPOSITE MEMBER  
BASE CONNECTION (4LS AND WEB PL)  
SCALE: 1" = 160"

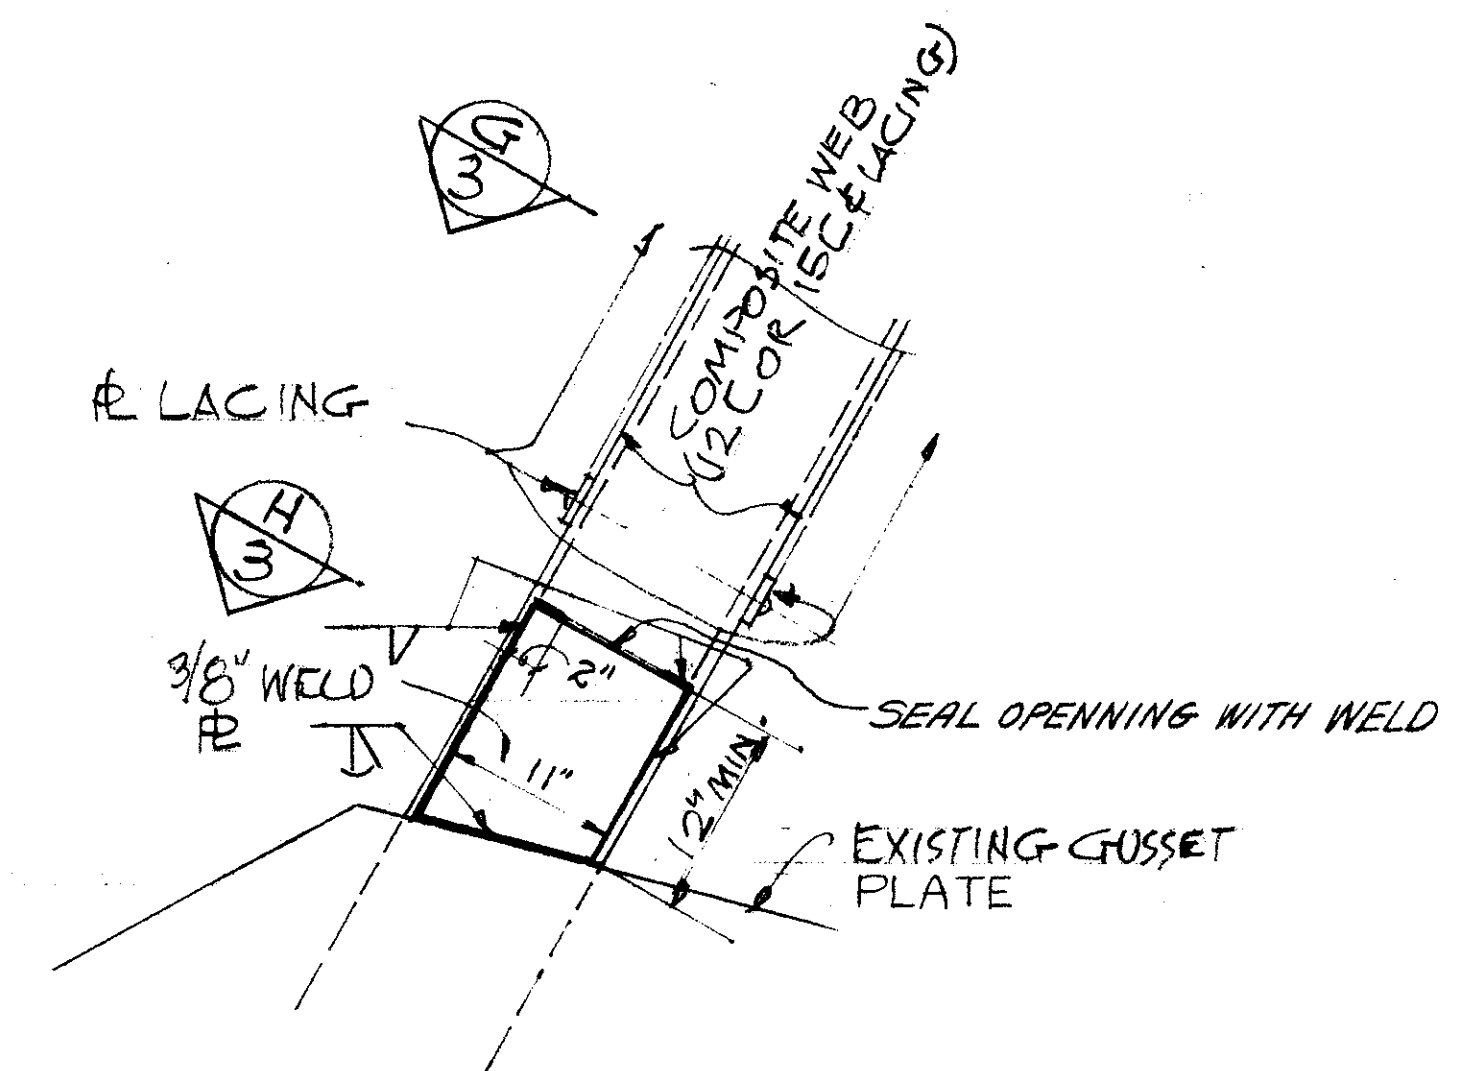


ELEVATION - TRUSS COMPOSITE MEMBER  
BASE CONNECTION (2E AND LACE PLS)  
SCALE: 1" = 1'-0"

CONNECTION DETAIL A  
3


SCALE: 1" = 1'-0"

SECTION D  
3


SCALE: 1" = 1'-0"

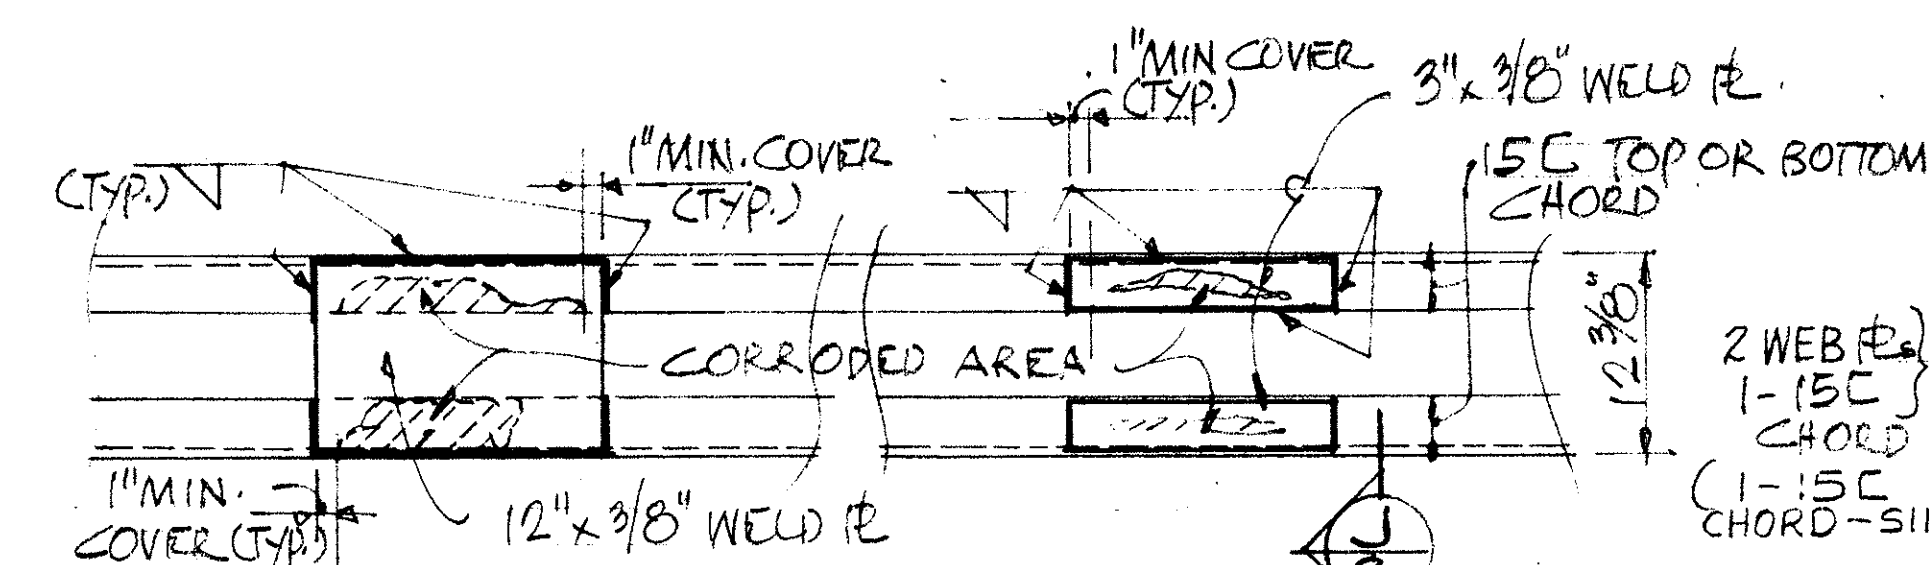


DOUBLE ADJACENT FLANGE      SINGLE FLANGE

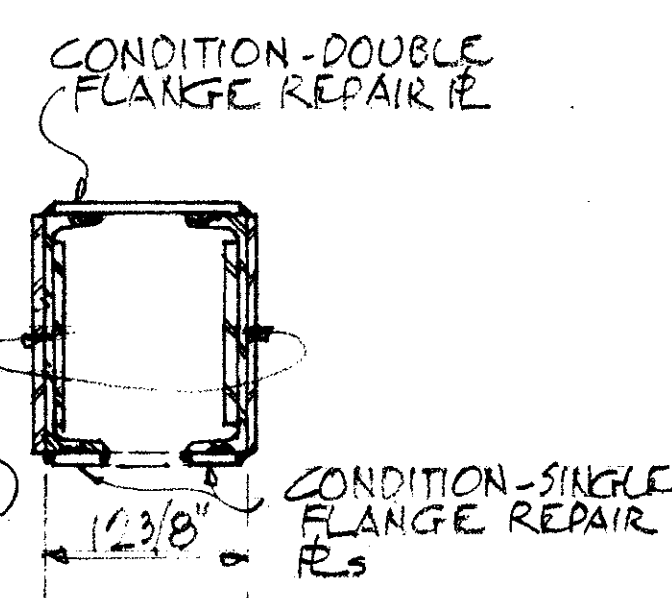

PLAN - TOP OR BOTTOM 15C FLANGE

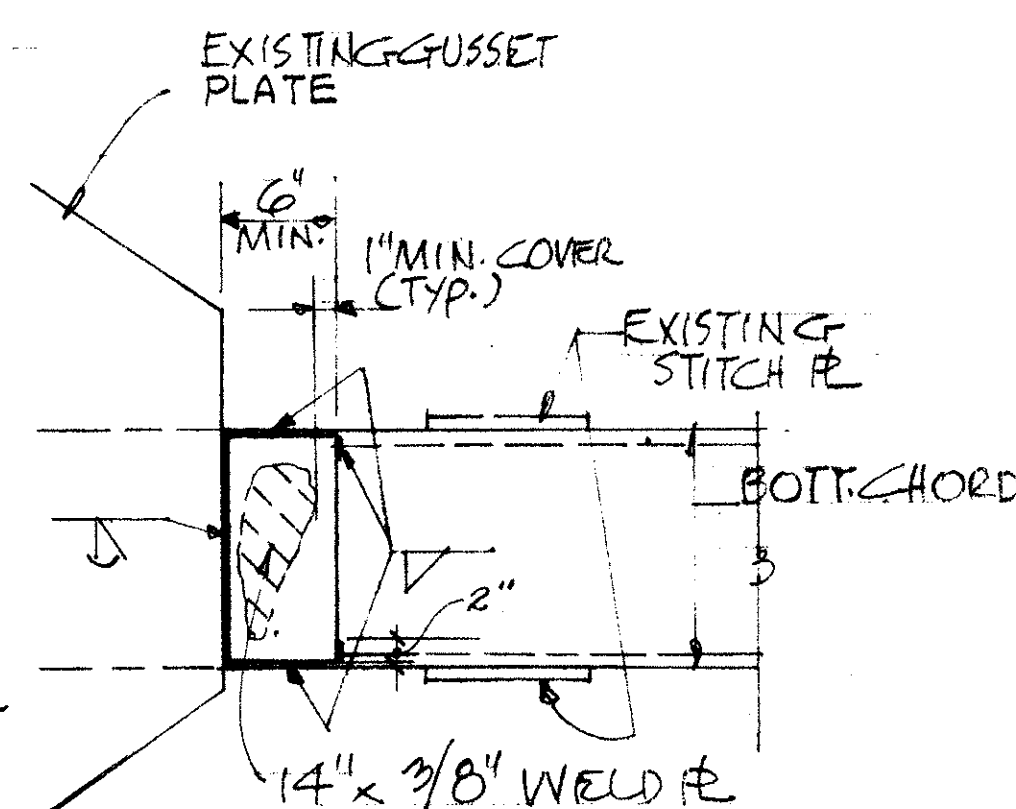

## AT VERTICAL OR DIAGONAL PANEL CONNECTIONS

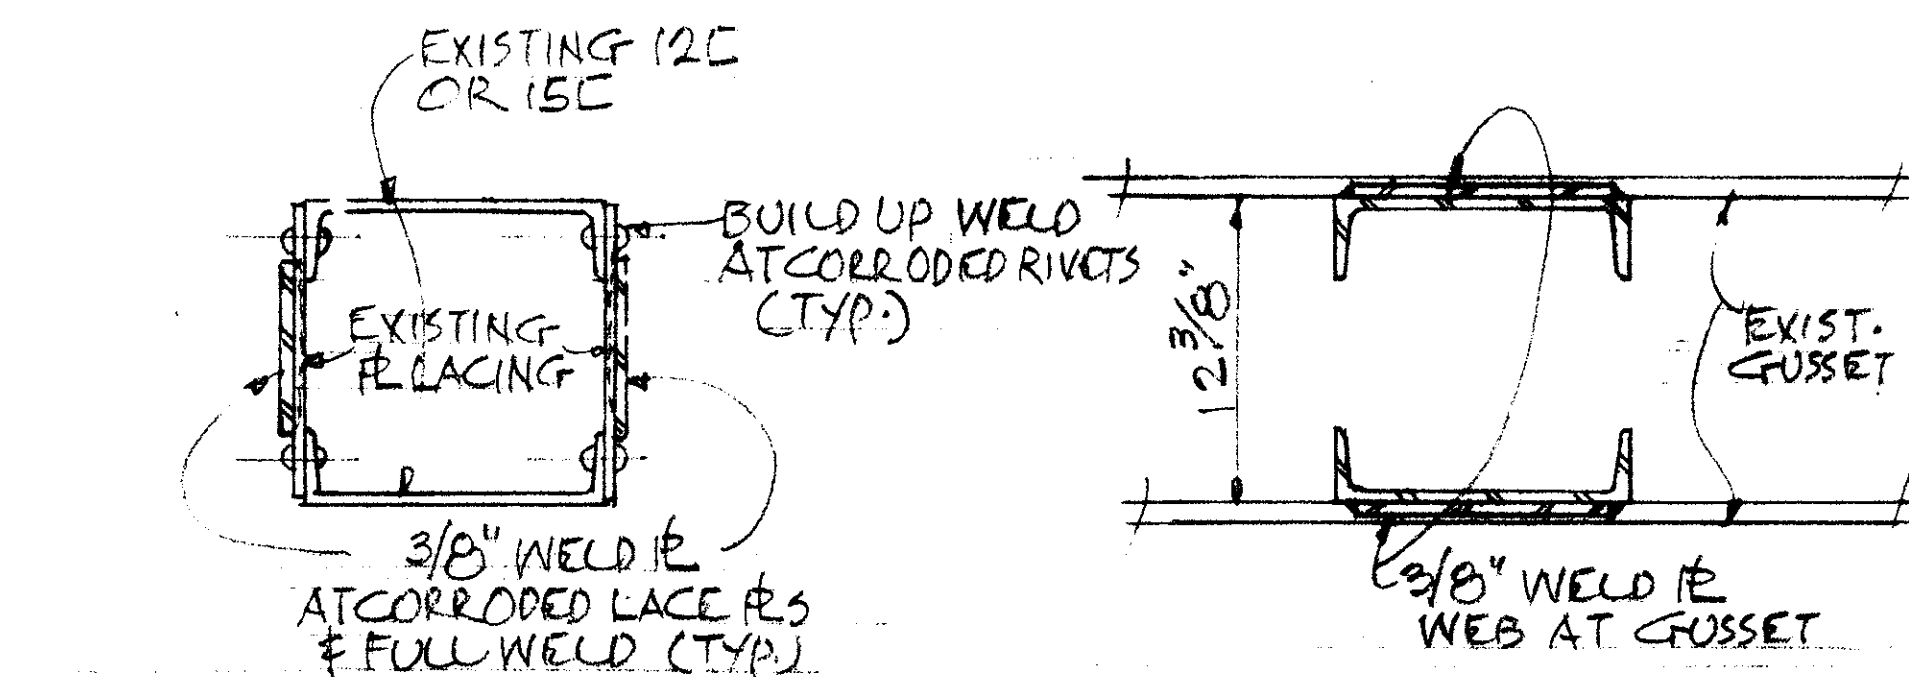

TYPICAL SECTION (G)  
3  
SCALE:  $1\frac{1}{2}" = 150'$

SECTION 

SCALE: 1 1/2" = 1'-0"

TRUSS COMPOSITE BOTTOM CHORD REPAIRS SCALE: 1"=160"

NOTES:

1. REFER TO SHT. #4 REPAIR DETAILS FOR APPLICABLE REPAIR WORKS OR DETAILS NOT COVERED BY THIS SHEET.
2. REFER TO SHT. # 1 EXISTING KERSTEN THOT BRIDGE FOR LOCATIONS OF THE VARIOUS APPLICABLE DETAILS OF THIS DRAWING.

STATE OF HAWAII  
DEPARTMENT OF TRANSPORTATION  
HIGHWAYS DIVISION


TYPICAL REPAIR DETAILS

KAMEHAMEHA HIGHWAY  
REPAIR & PAINT  
KARSTEN THOT BRIDGE  
Proj. No 80B-01-80M


Scale: As Noted      Date: Jan. 1980

**SHEET No. 3 OF 4 SHEETS**


| FED. ROAD DIST. NO. | STATE | PROJ. NO.  | FISCAL YEAR | SHEET NO. | TOTAL SHEETS |
|---------------------|-------|------------|-------------|-----------|--------------|
| HAWAII              | HAW.  | 808-01-80M | 1980        | 5         | 5            |

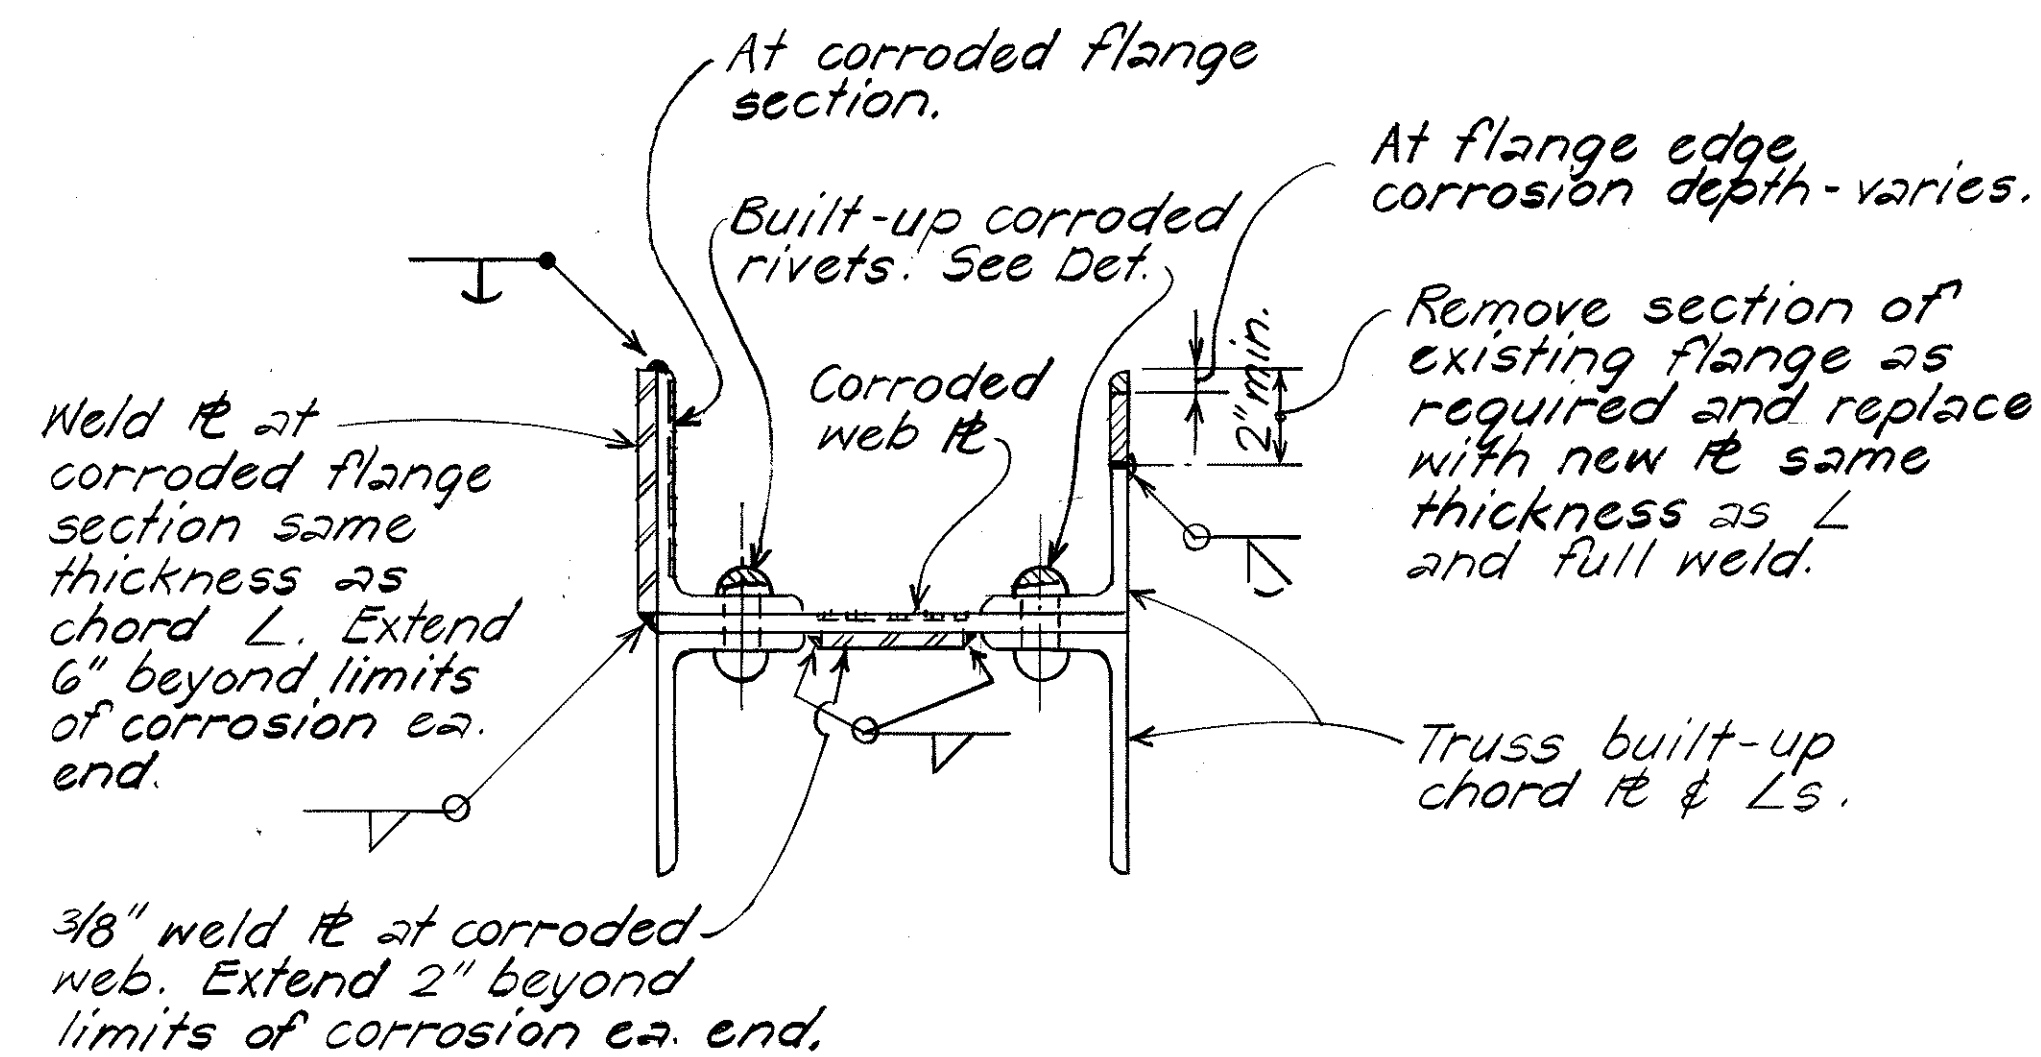


TYPICAL TRUSS REPAIRS  
(VERTICAL & DIAGONAL WEB MEMBERS)  
No Scale

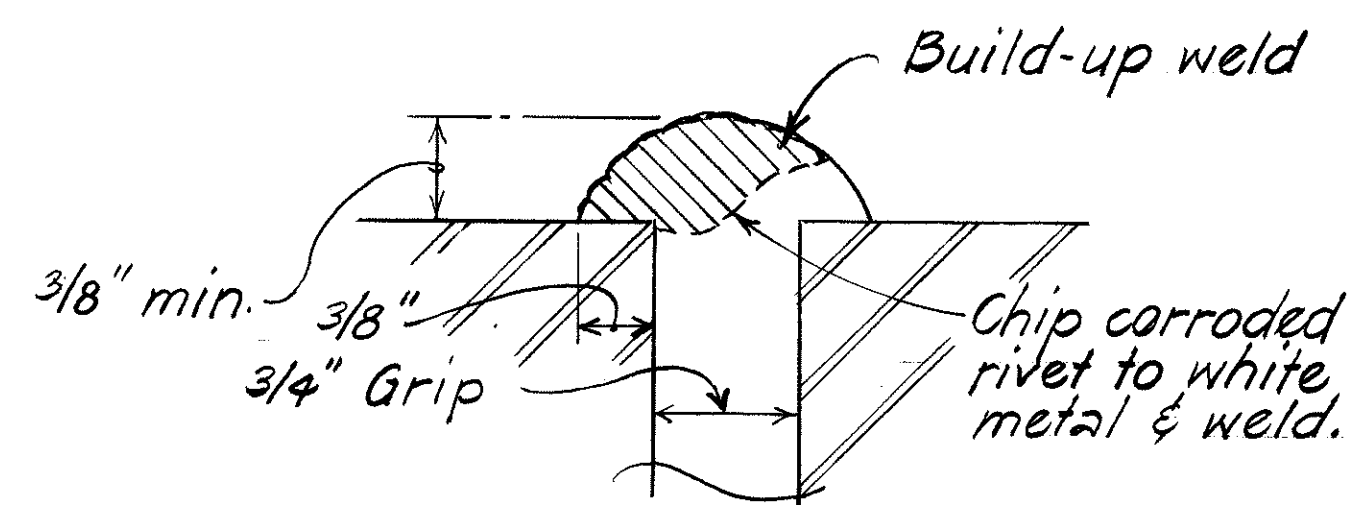

TYPICAL REPAIRS TO CORRODED RIVET HEADS  
Scale: Full Size

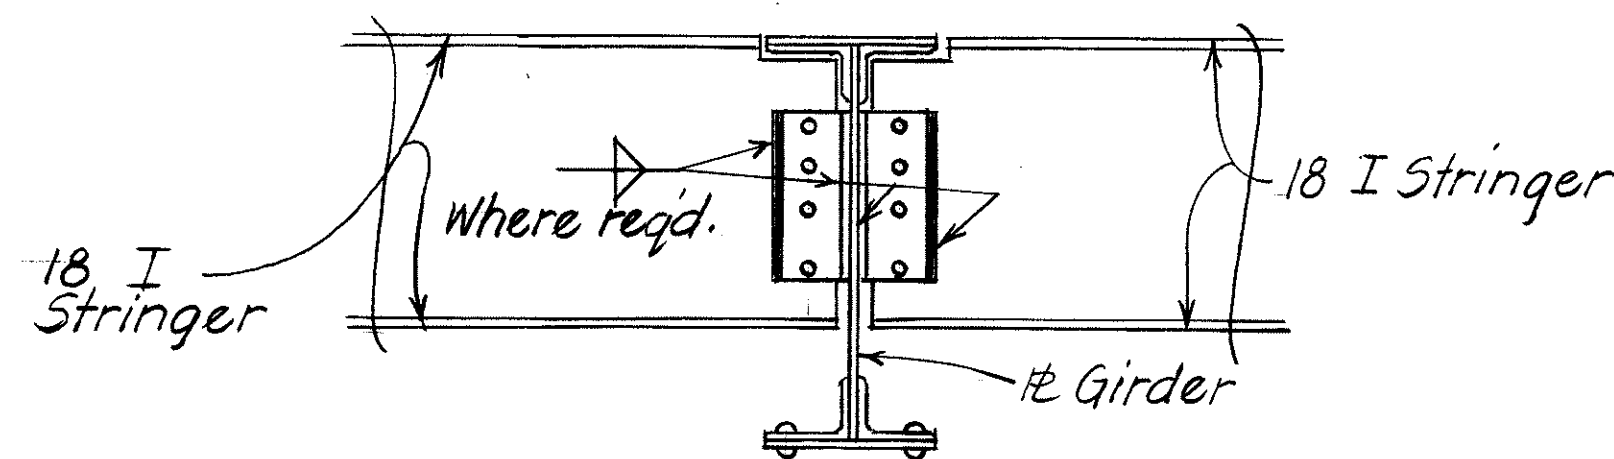

TYPICAL FLOOR STRINGER CONNECTION AT FLANGE GIRDER  
Scale: 1" = 1'-0"

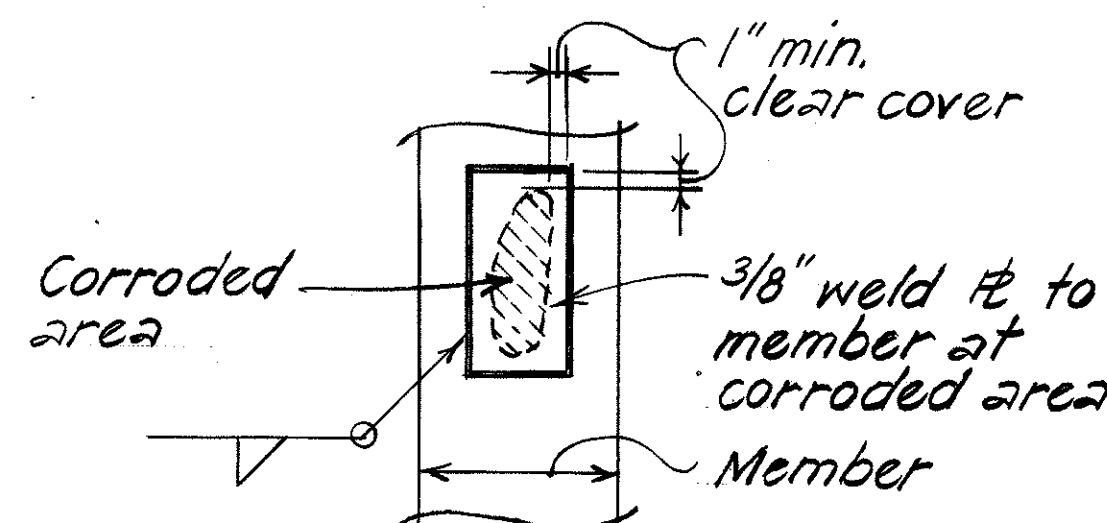

TYPICAL REPAIR TO CORRODED AREA OF OTHER MEMBERS  
No Scale

#### GENERAL NOTES:

1. All structural steel shall be A-36 and all new plates shall be 3/8" minimum thickness unless otherwise shown in the drawings or as directed by the Engineer.
2. All welding shall conform to section 501.03 (D) of the Standard Specifications for Roads and Bridge Construction, 1976 edition, by the Department of Transportation, State of Hawaii. All welding shall be 5/16" unless otherwise shown in the plans or as directed.
3. For vertical and diagonal members which are not badly corroded, the 3/8" plate may not be required as shown. Strengthen connections with fillet weld as directed by the Engineer.
4. Some members had been repaired similar to these details in the past. However additional weld may be needed to strengthen these connections.
5. Repairs shall be made to members as shown and anywhere else on the structure as directed by the Engineer though not specifically indicated on the plans.
6. The Engineer shall be the sole judge in determining the adequacy of the welding connections and repairs.

|               |      |
|---------------|------|
| ORIGINAL PLAN | DATE |
| DESIGNED BY   |      |
| TRACED BY     |      |
| NOTE BOOK     |      |
| QUANTITIES BY |      |
| CHECKED BY    |      |

|                                                                                            |
|--------------------------------------------------------------------------------------------|
| STATE OF HAWAII<br>DEPARTMENT OF TRANSPORTATION<br>LAND TRANSPORTATION FACILITIES DIVISION |
| <u>TYPICAL REPAIR DETAILS</u>                                                              |
| <u>KAMEHAMEHA HIGHWAY</u>                                                                  |
| <u>REPAIR &amp; PAINT</u>                                                                  |
| <u>KARSTEN THOT BRIDGE</u>                                                                 |
| <u>Proj. N° 808-01-80M</u>                                                                 |
| Scale: As Noted Date: Jan. 1980                                                            |
| SHEET NO. 4 OF 4 SHEETS                                                                    |