

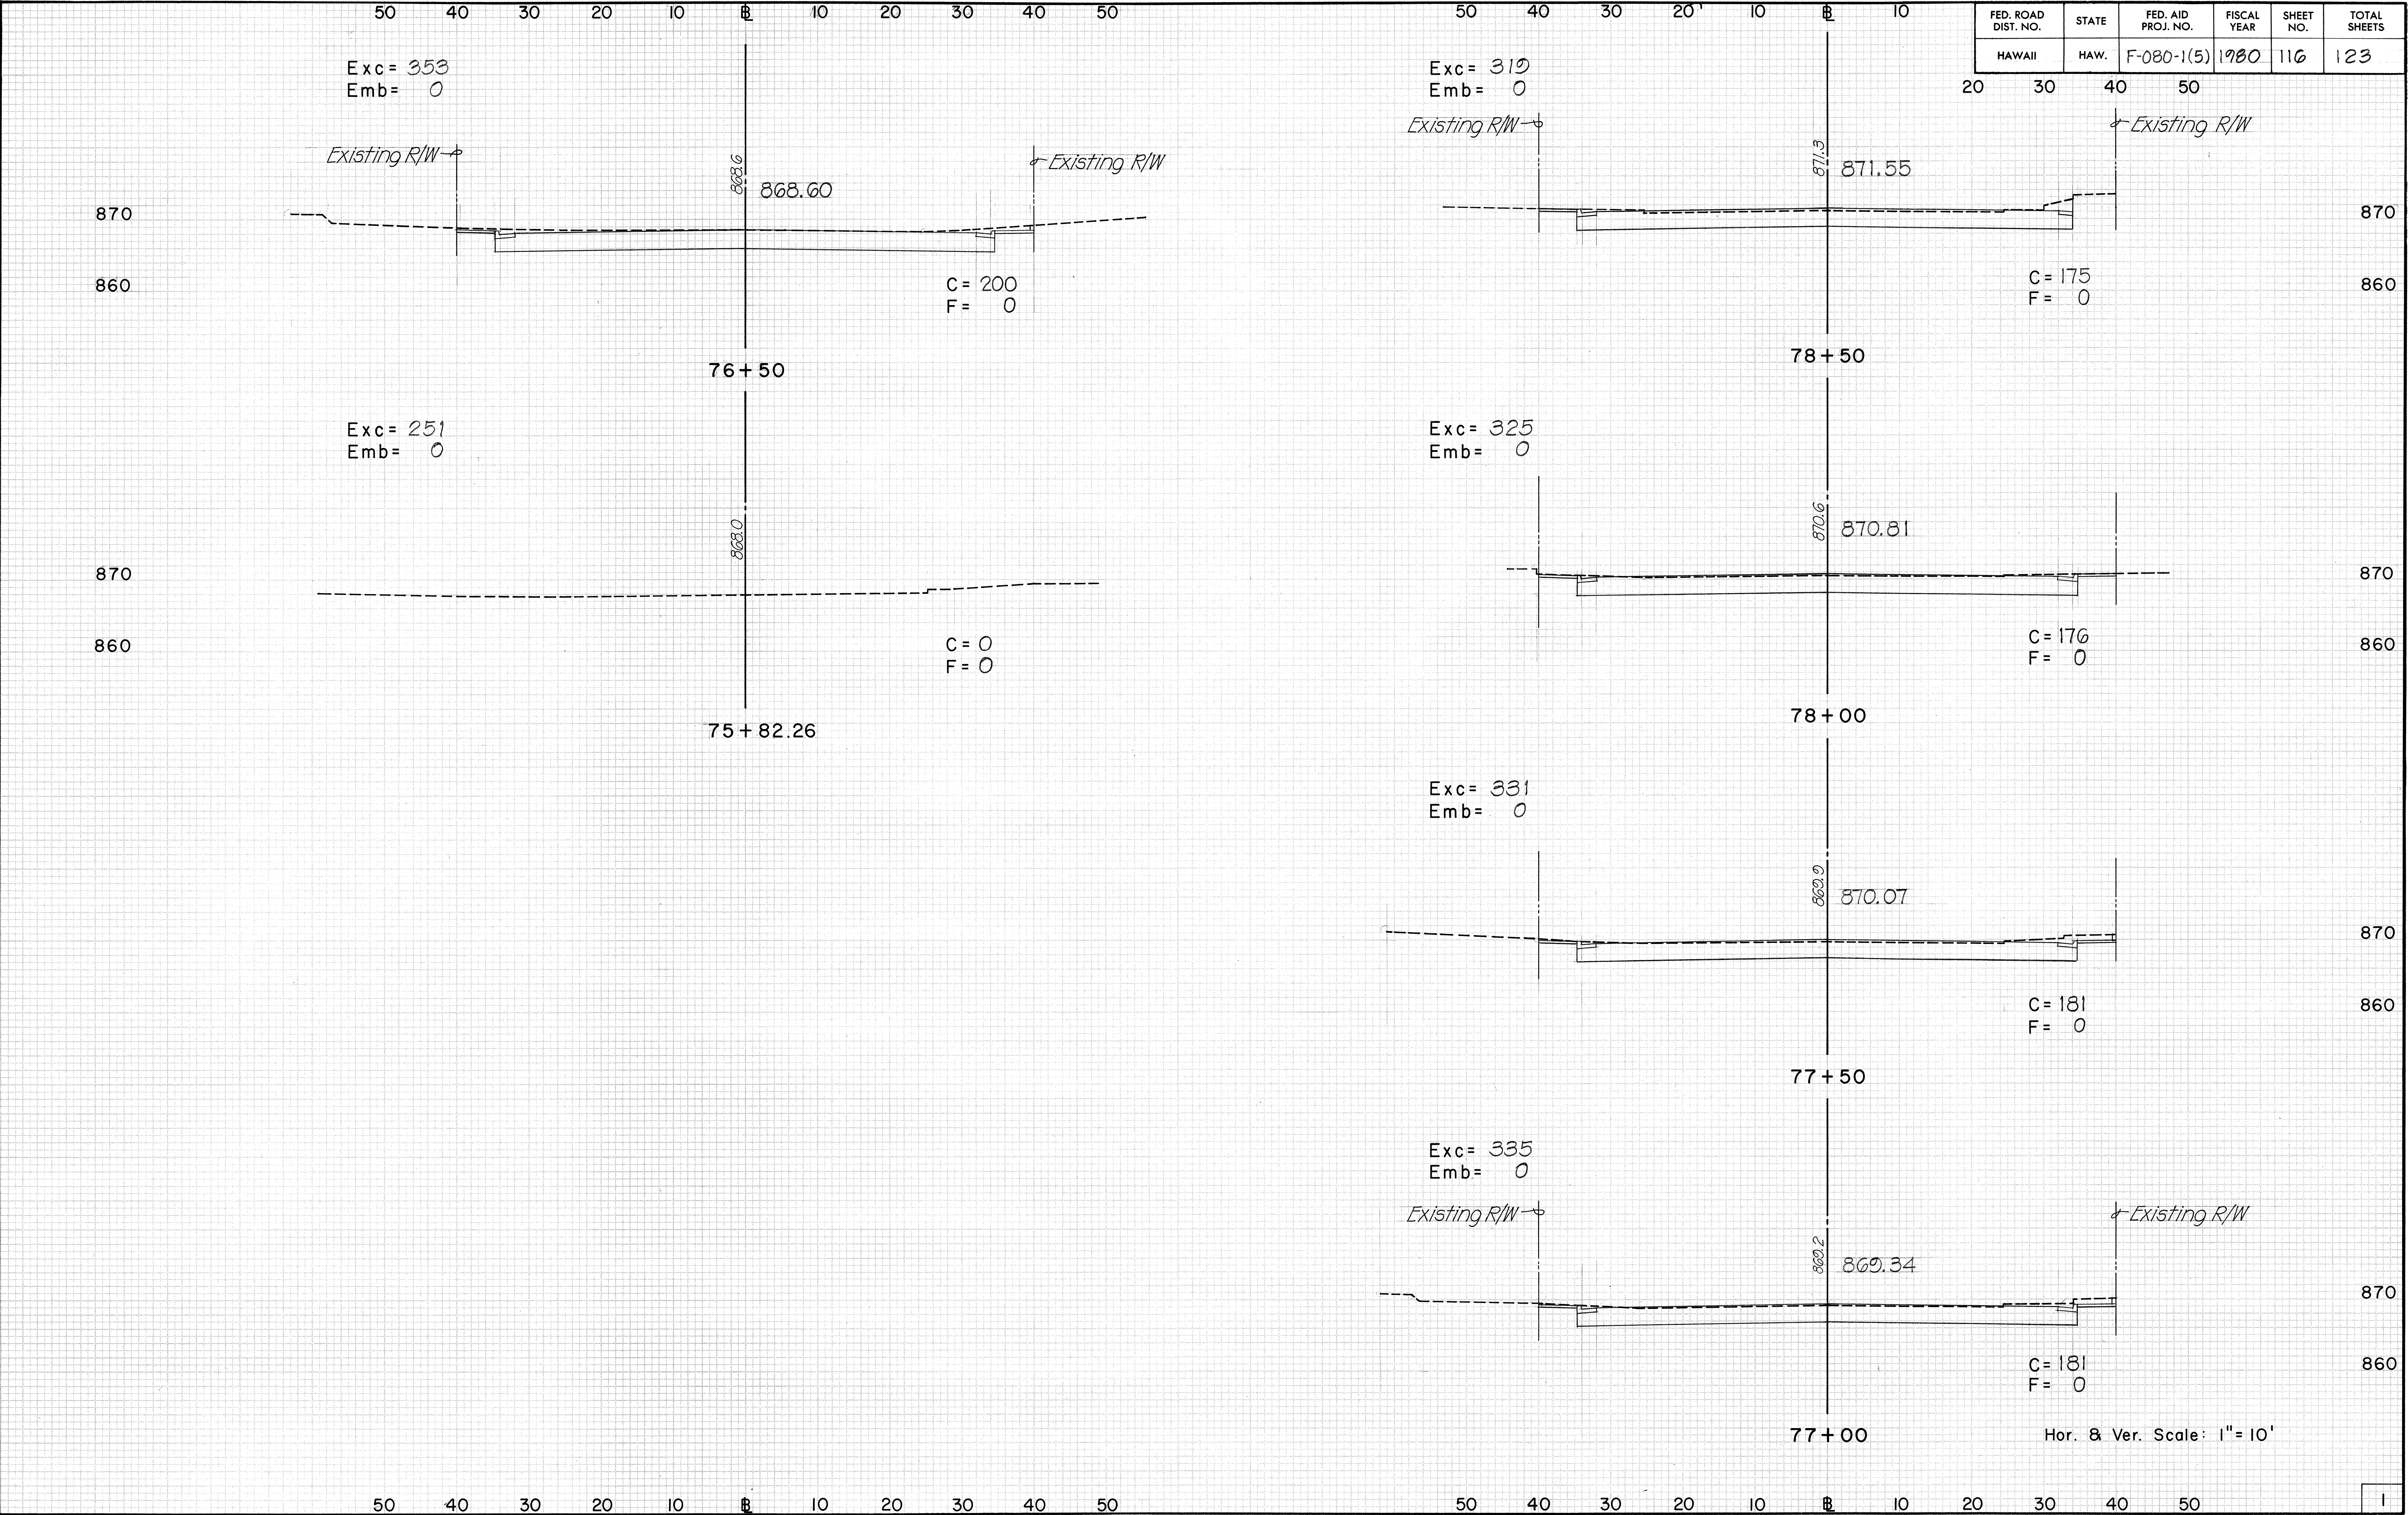


FINAL	SURVEYED	DATE
SURVEY	BY	
NO.	PLOTTED	
	DATE	
	AREAS	
	CHECKED	

ORIGINAL	SURVEYED	DATE
SURVEY	BY	
NO.	PLOTTED	
	DATE	
	AREAS	
	CHECKED	

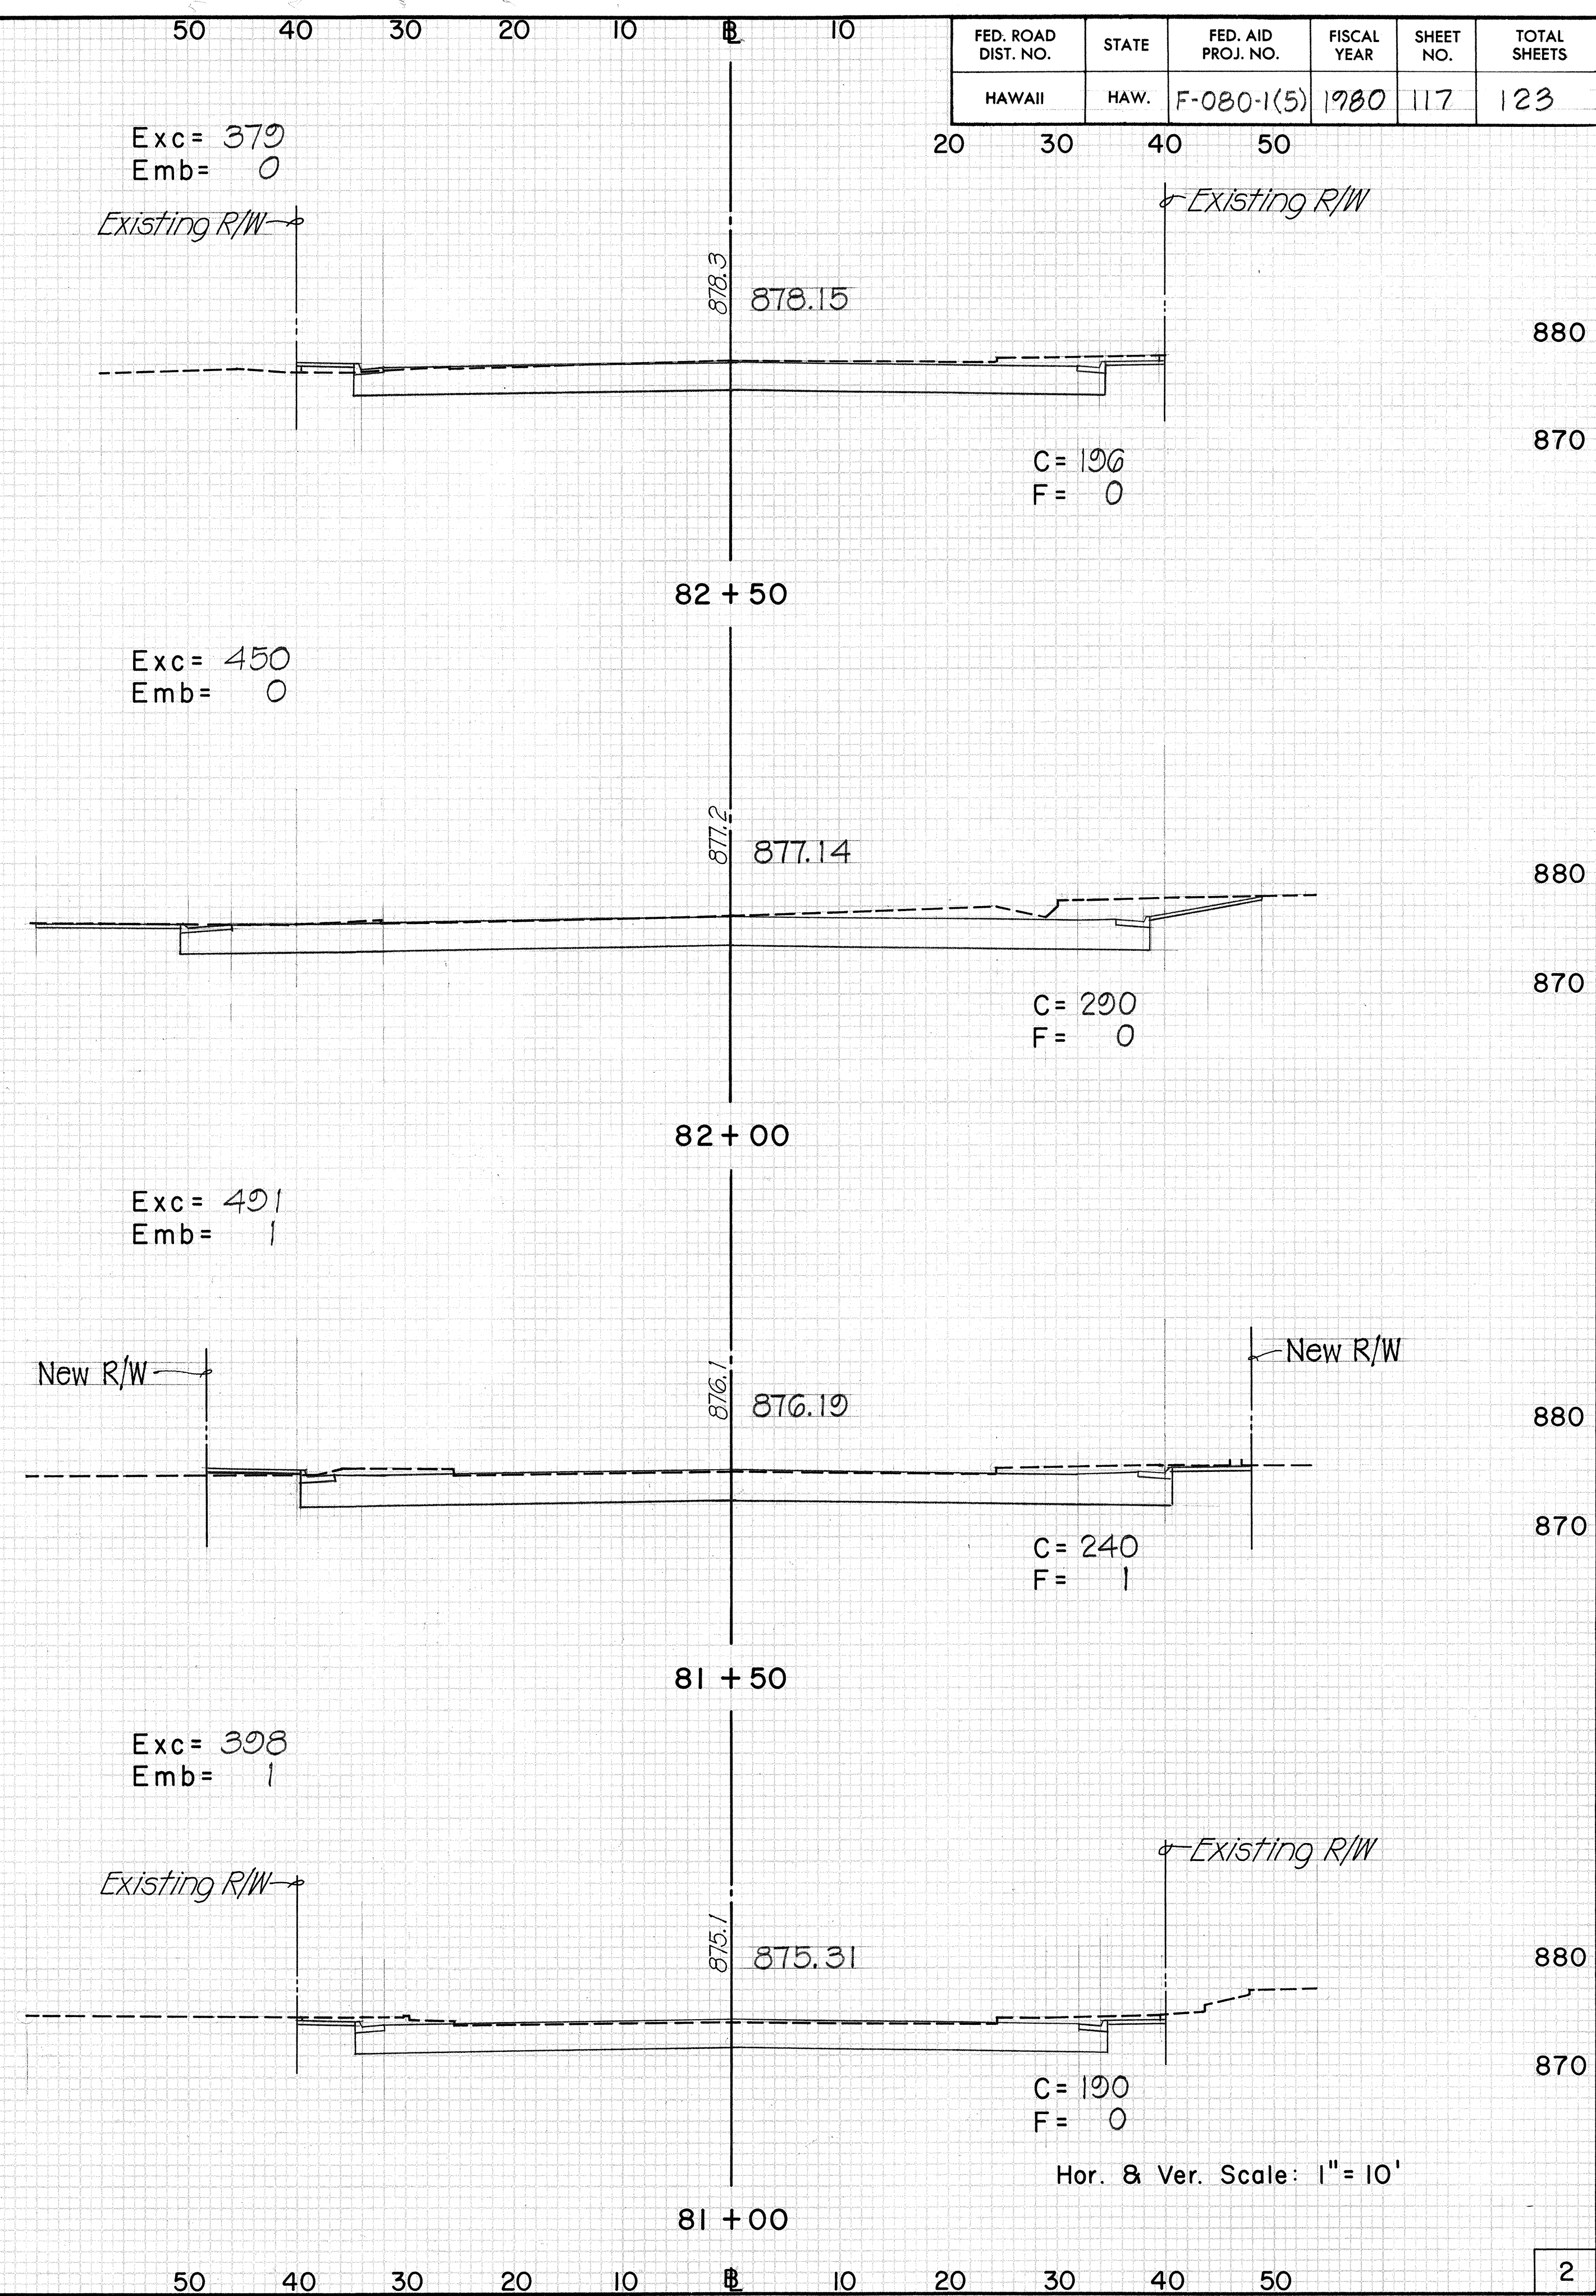

FED. ROAD DIST. NO.	STATE	FED. AID PROJ. NO.	FISCAL YEAR	SHEET NO.	TOTAL SHEETS
HAWAII	HAW.	F-080-1(5)	1980	116	123

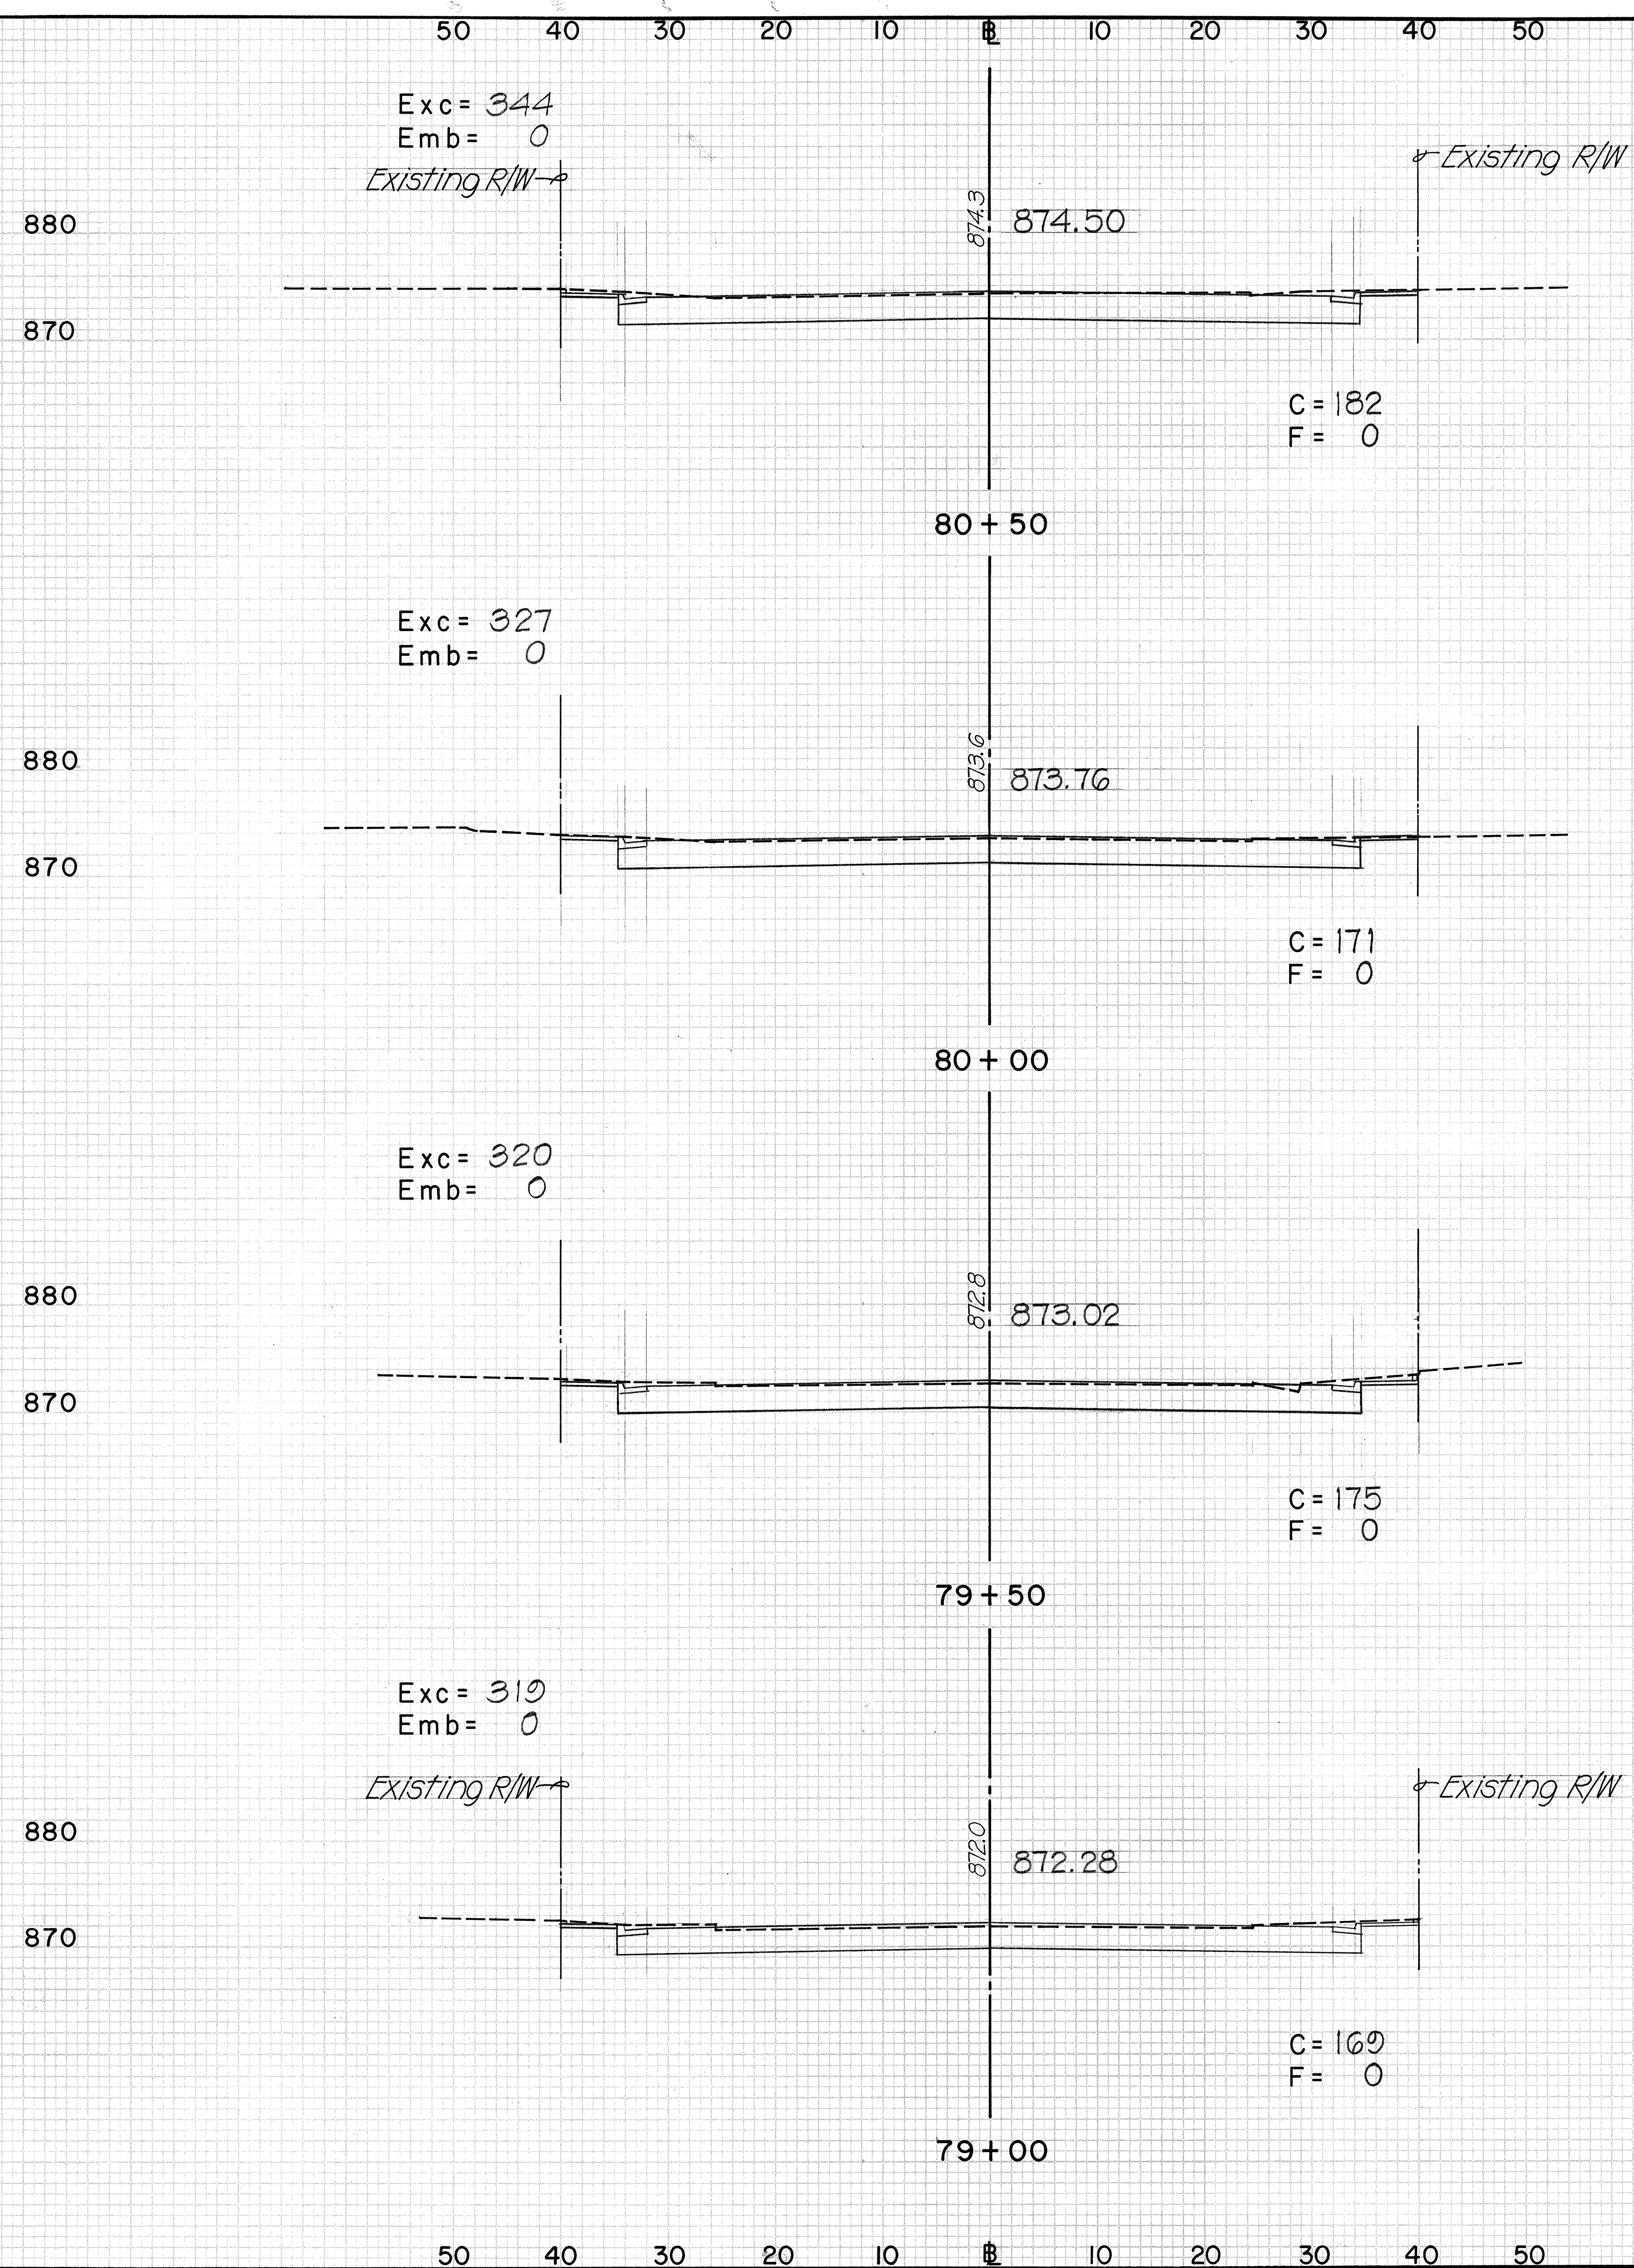


#200-1

FINAL	SURVEYED	BY	DATE
SURVEY	PLOTTED		
NOTE BOOK	REMARKS		
NO.	AREAS CHECKED		

ORIGINAL	SURVEYED	BY	DATE
SURVEY	PLOTTED		
NOTE BOOK	REMARKS		
NO.	AREAS CHECKED		

FED. ROAD DIST. NO.	STATE	FED. AID PROJ. NO.	FISCAL YEAR	SHEET NO.	TOTAL SHEETS
HAWAII	HAW.	F-080-1(5)	1980	118	123


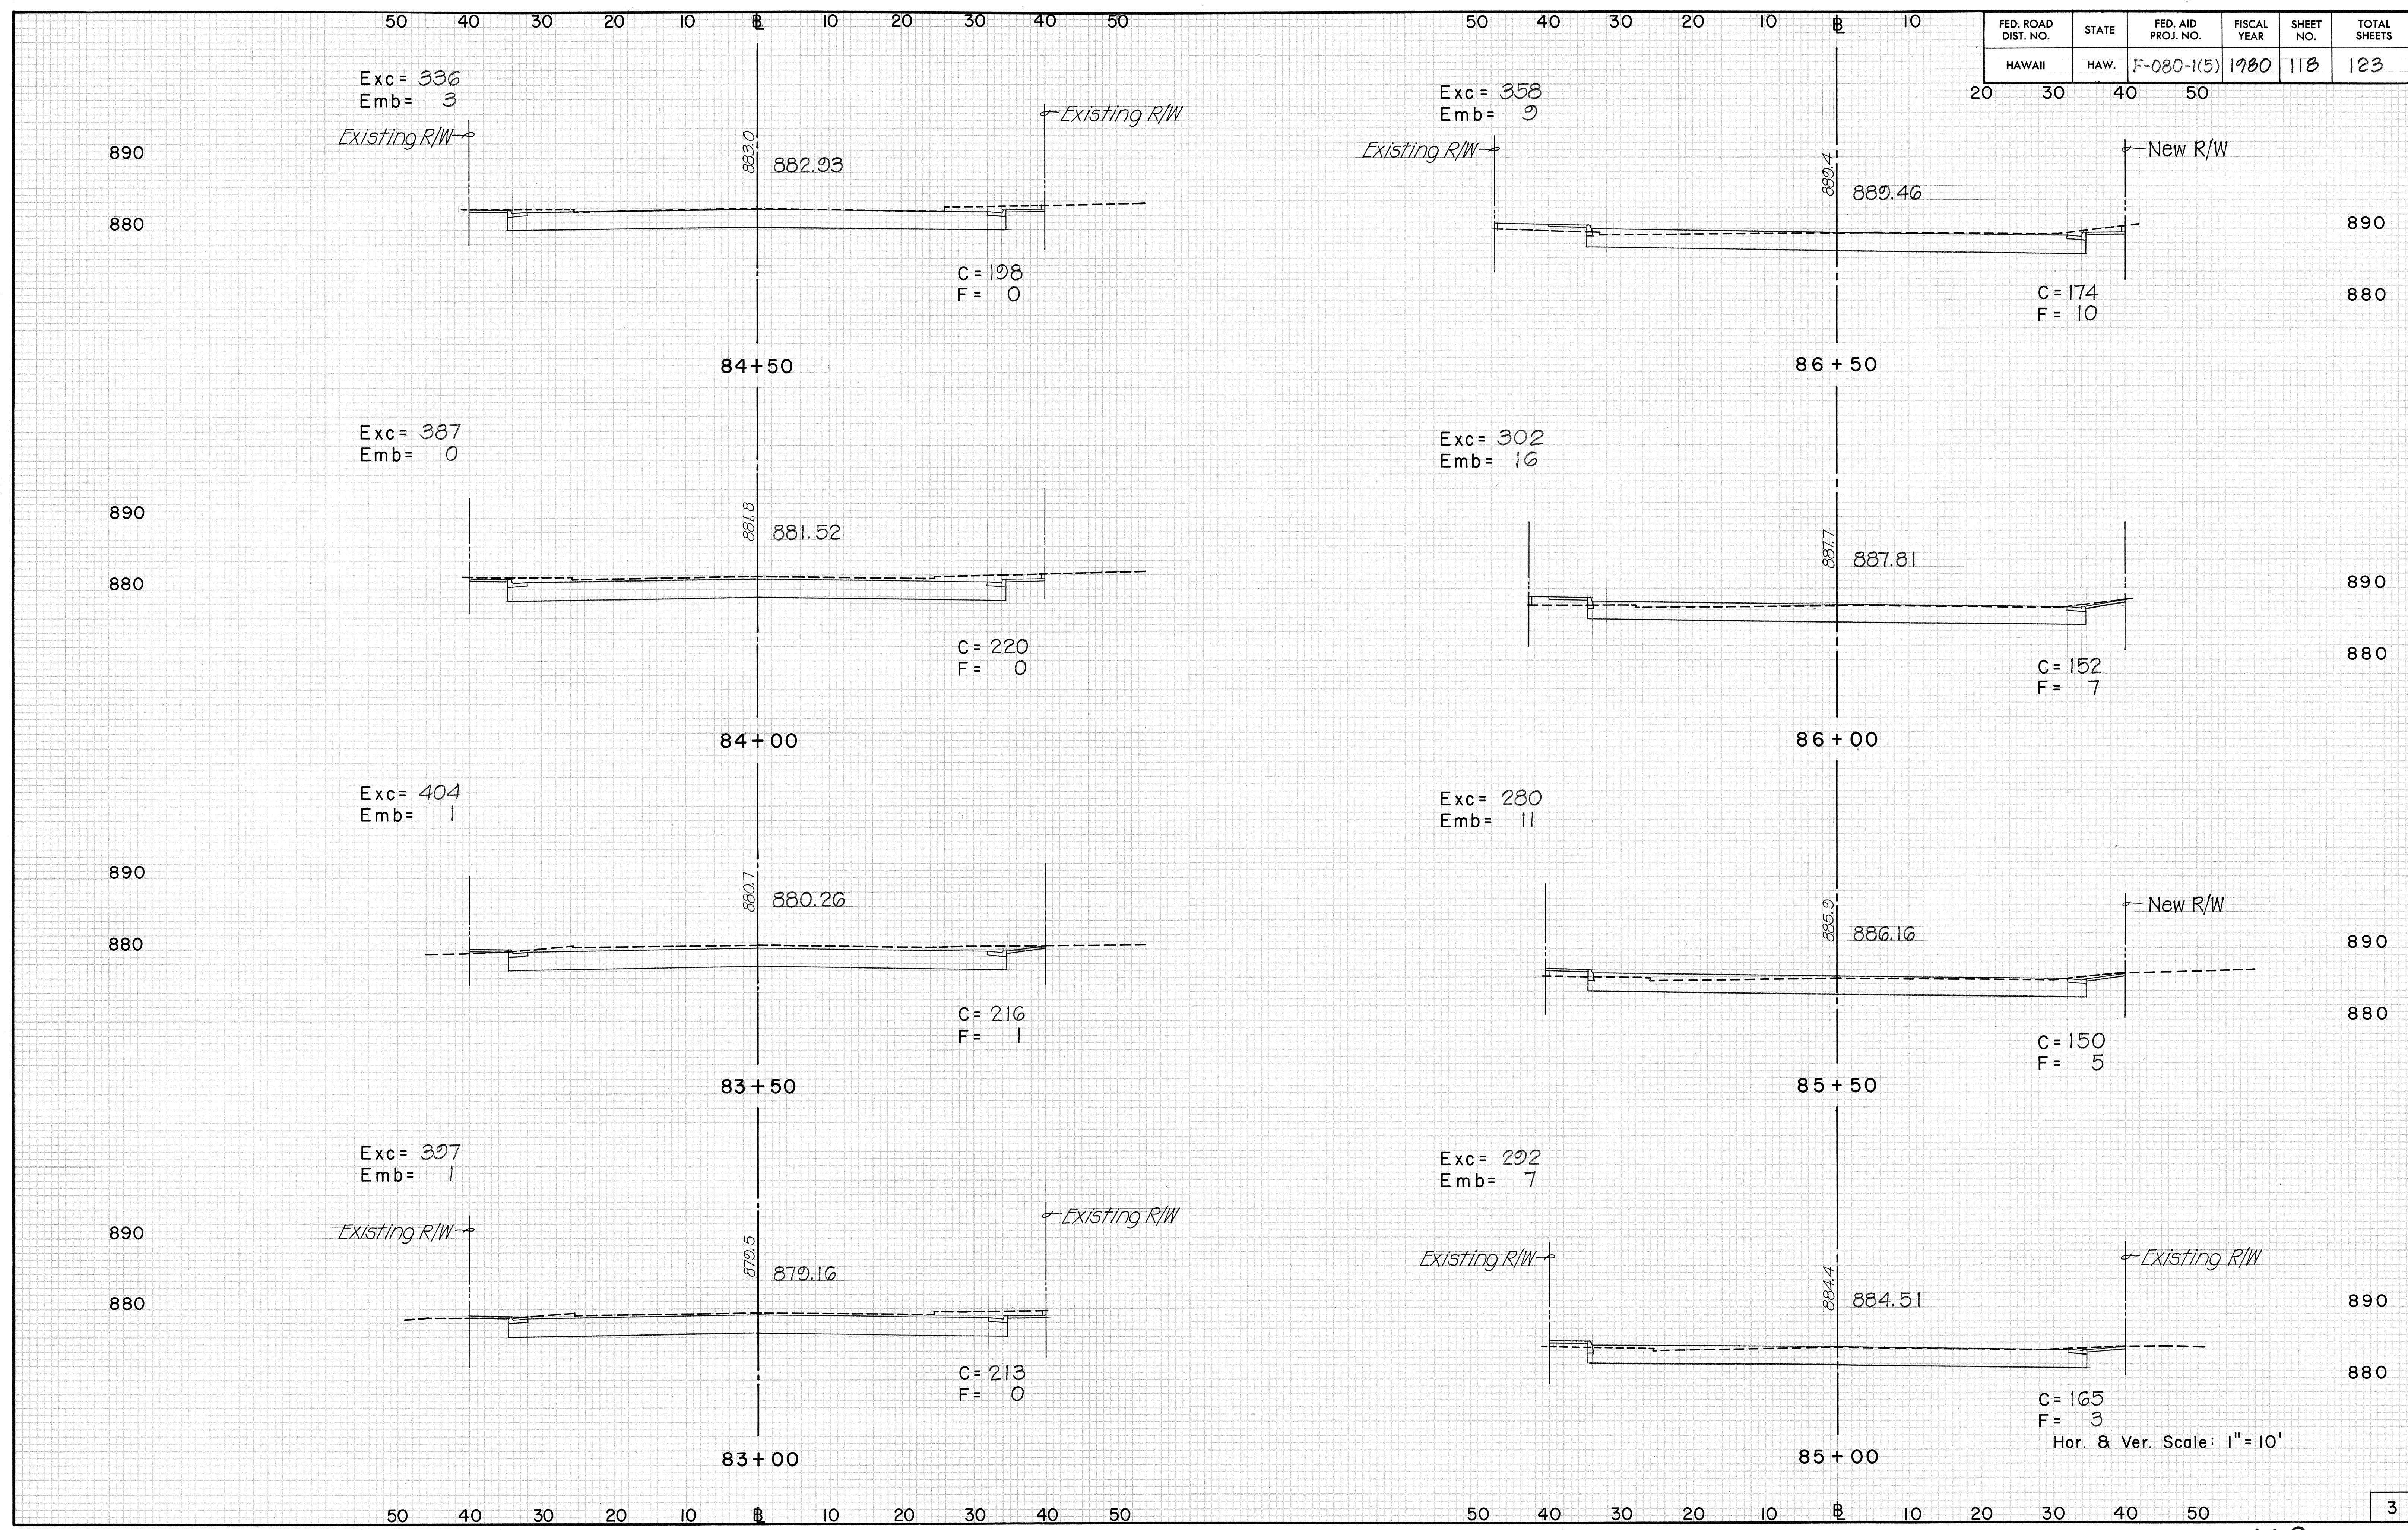


Hor. & Ver. Scale: 1" = 10'

FINAL	SURVEYED	DATE
SURVEY	PLOTTED	DATE
NOTE BOOK	AREAS	AREAS CHECKED
NO.		



ORIGINAL	SURVEYED	DATE
SURVEY	PLOTTED	DATE
NOTE BOOK	AREAS	AREAS CHECKED
NO.		

FED. ROAD DIST. NO.	STATE	FED. AID PROJ. NO.	FISCAL YEAR	SHEET NO.	TOTAL SHEETS
HAWAII	HAW.	F-080-1(5)	1980	119	123

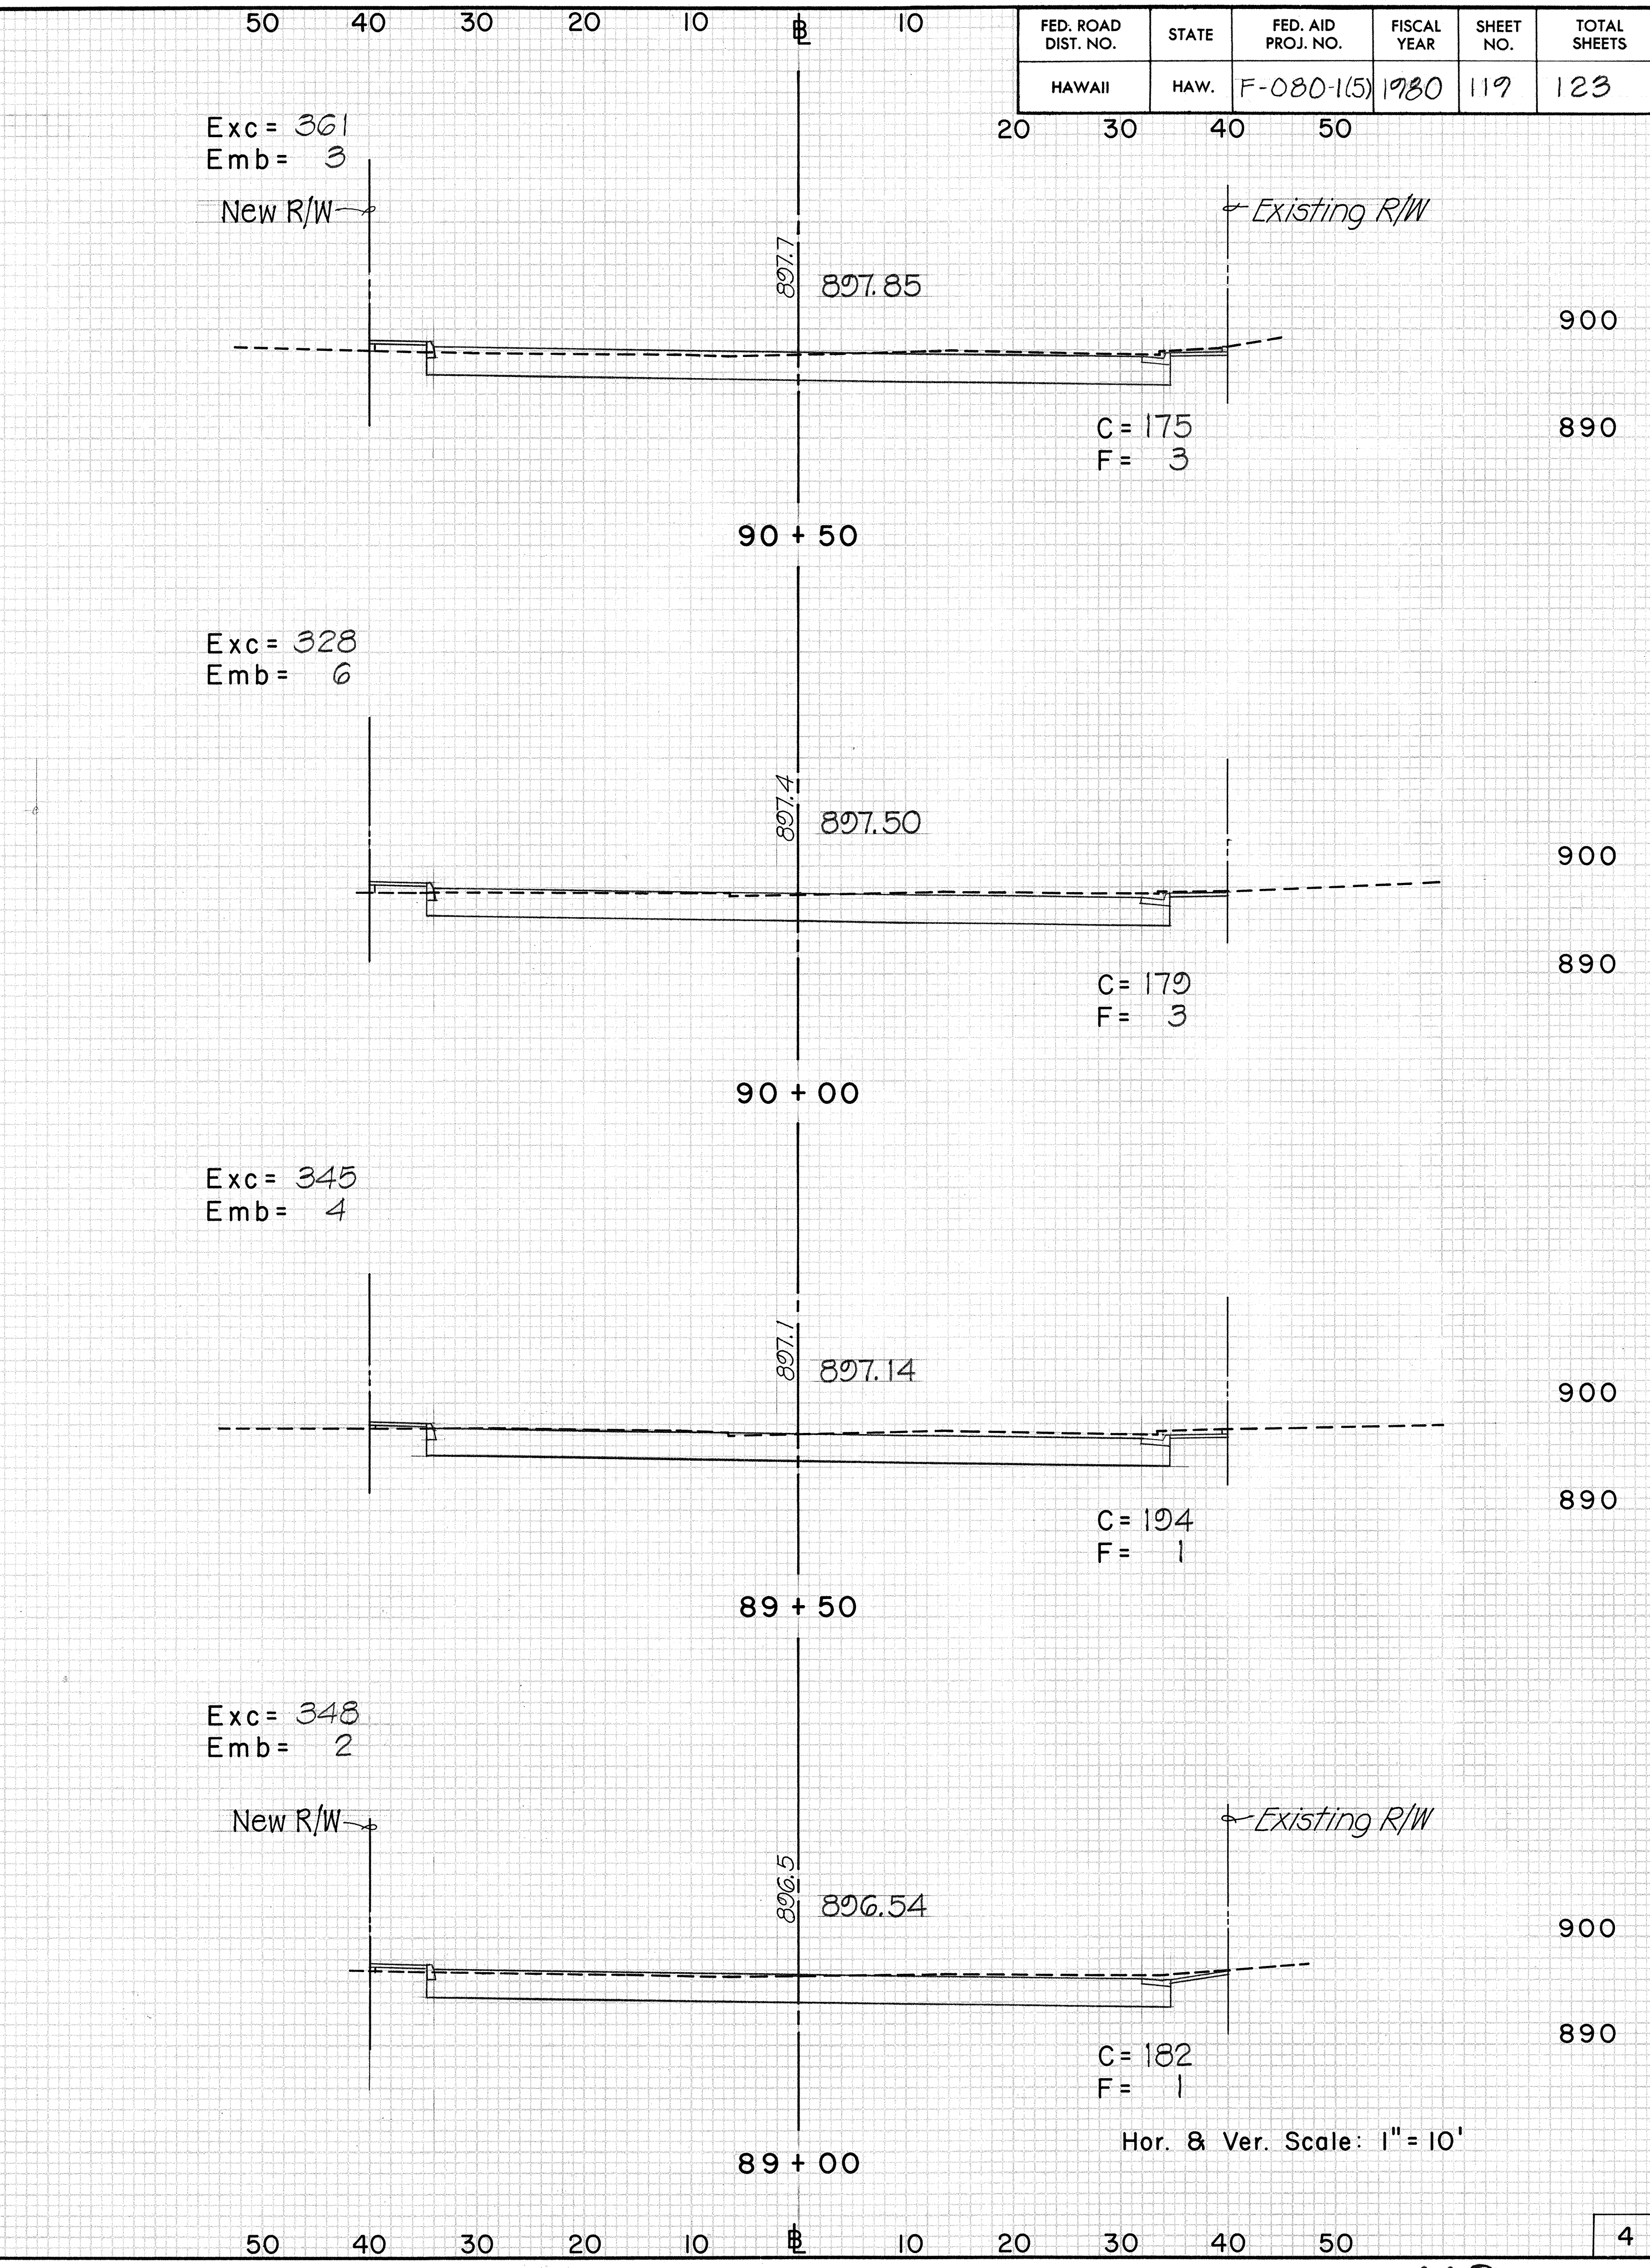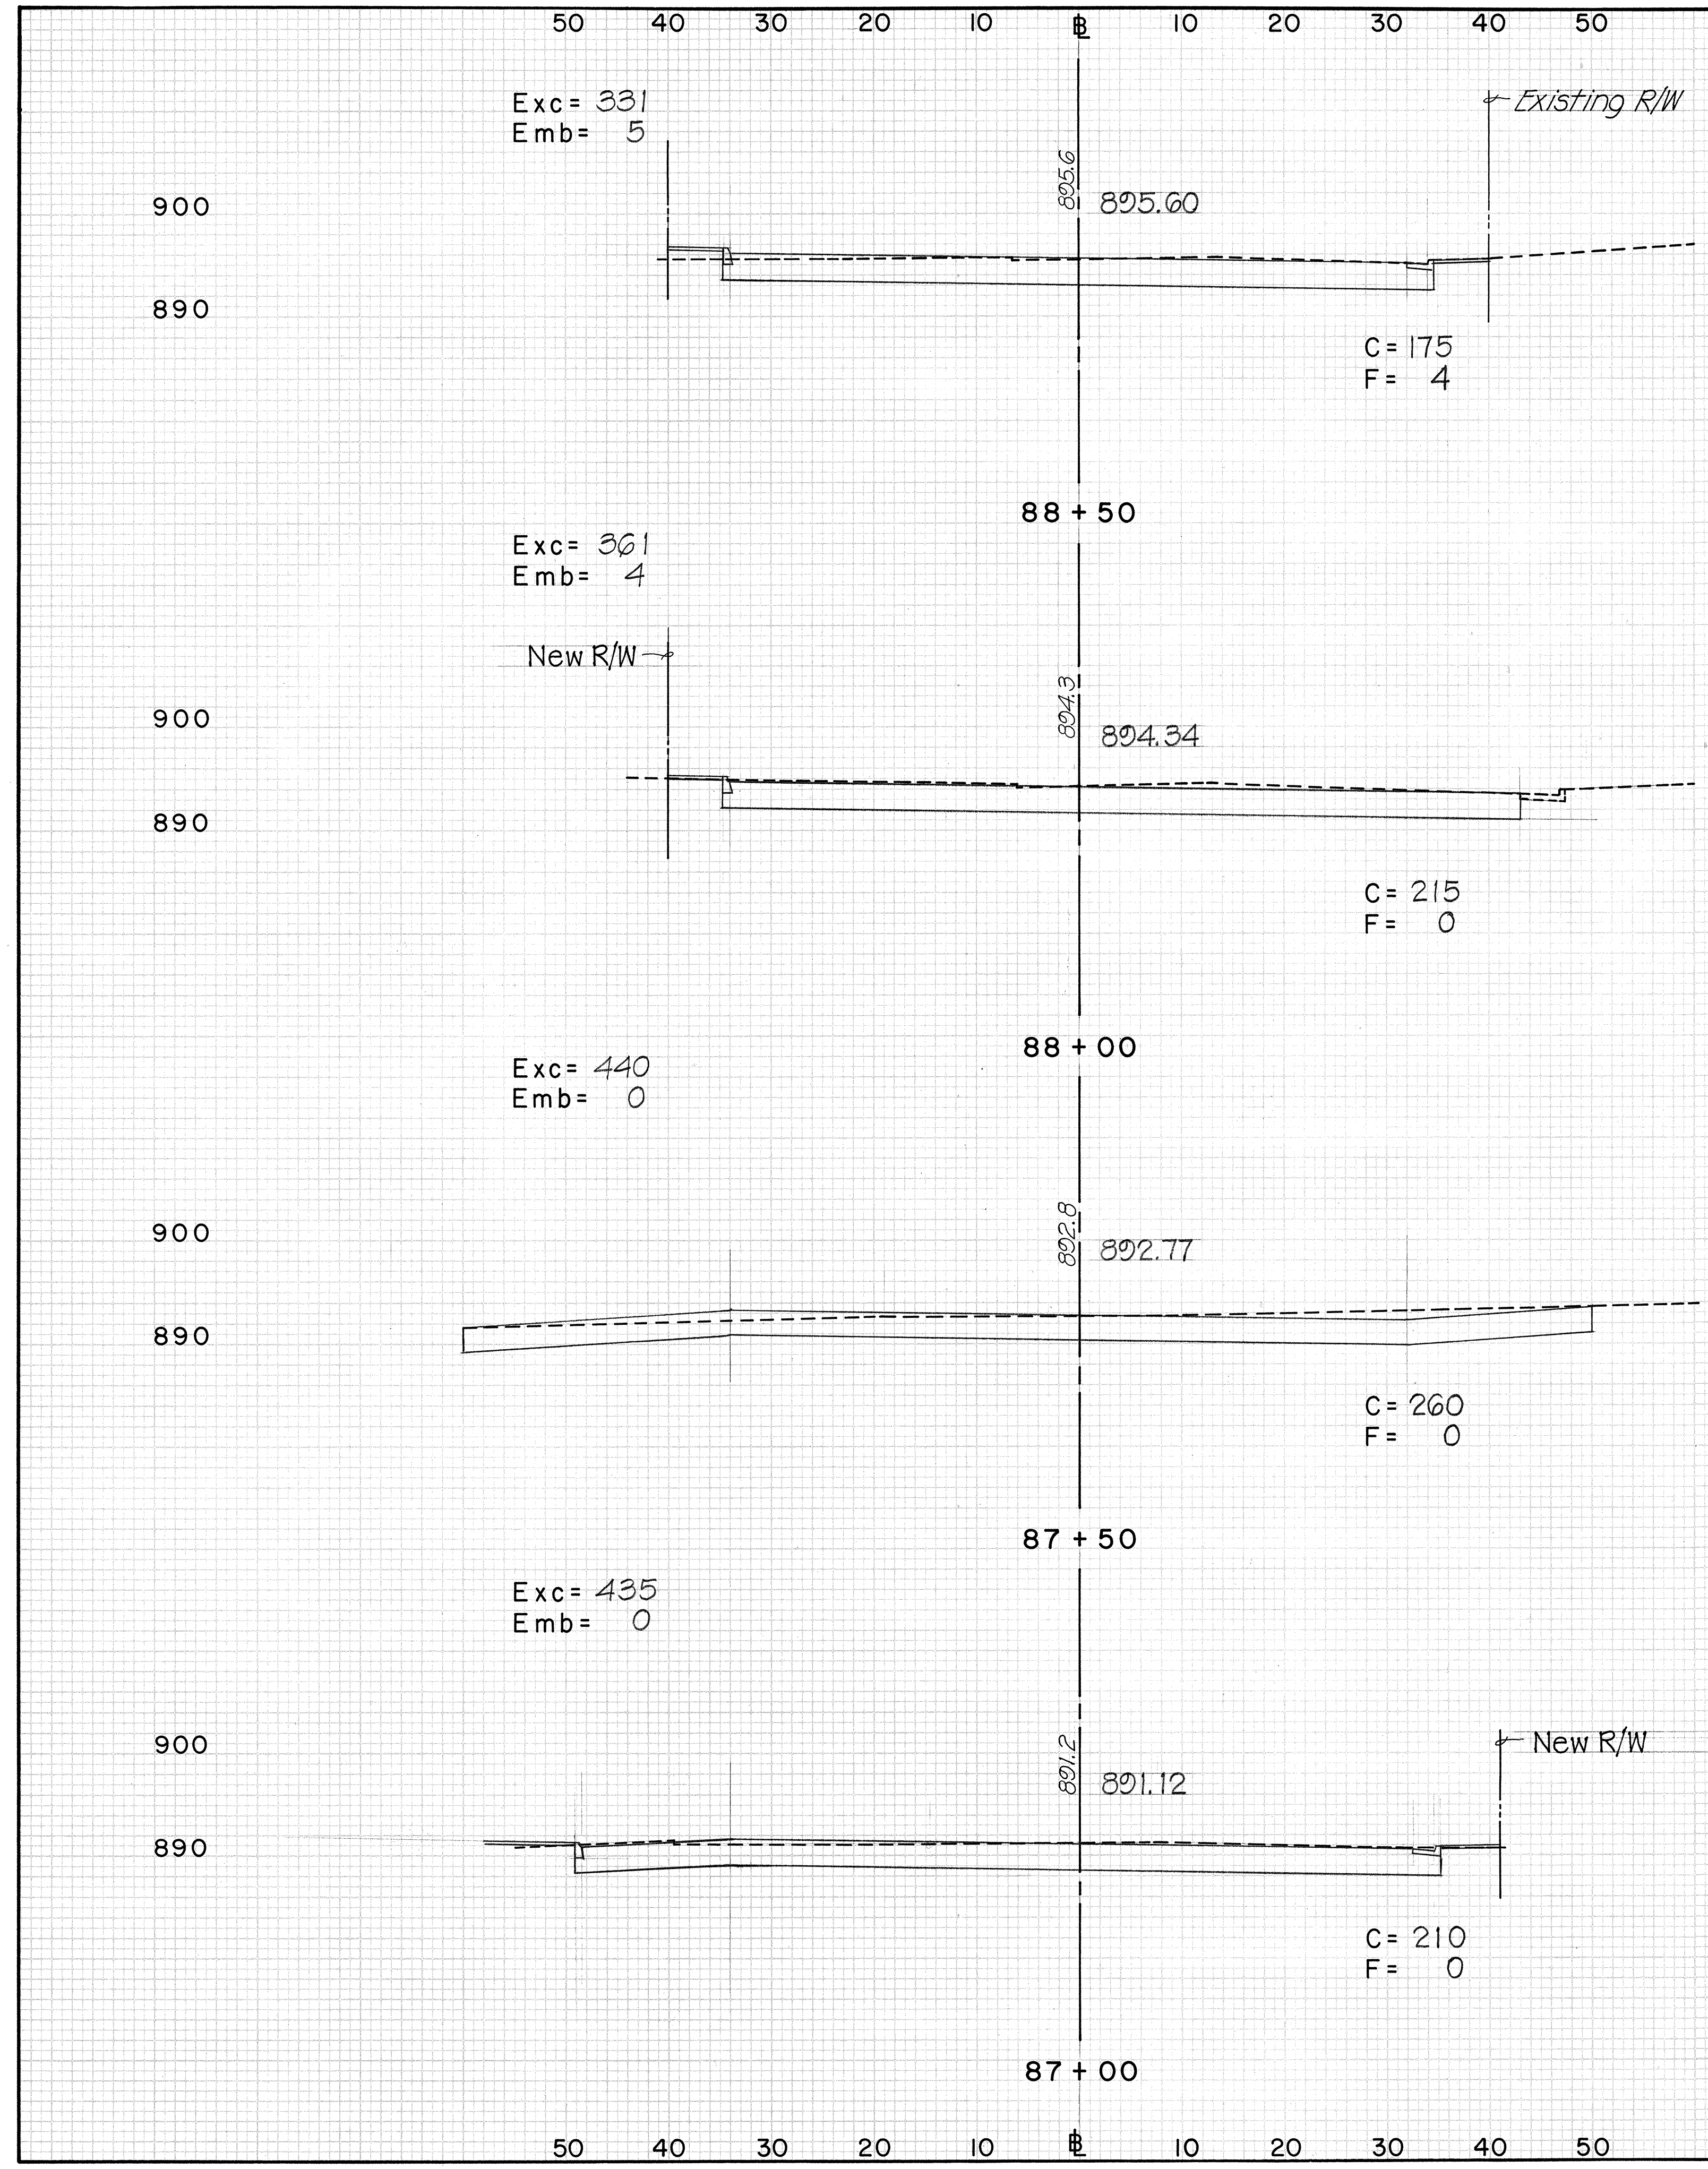



FED. ROAD DIST. NO.	STATE	FED. AID PROJ. NO.	FISCAL YEAR	SHEET NO.	TOTAL SHEETS
HAWAII	HAW.	F-080-1(5)	1980	121	123

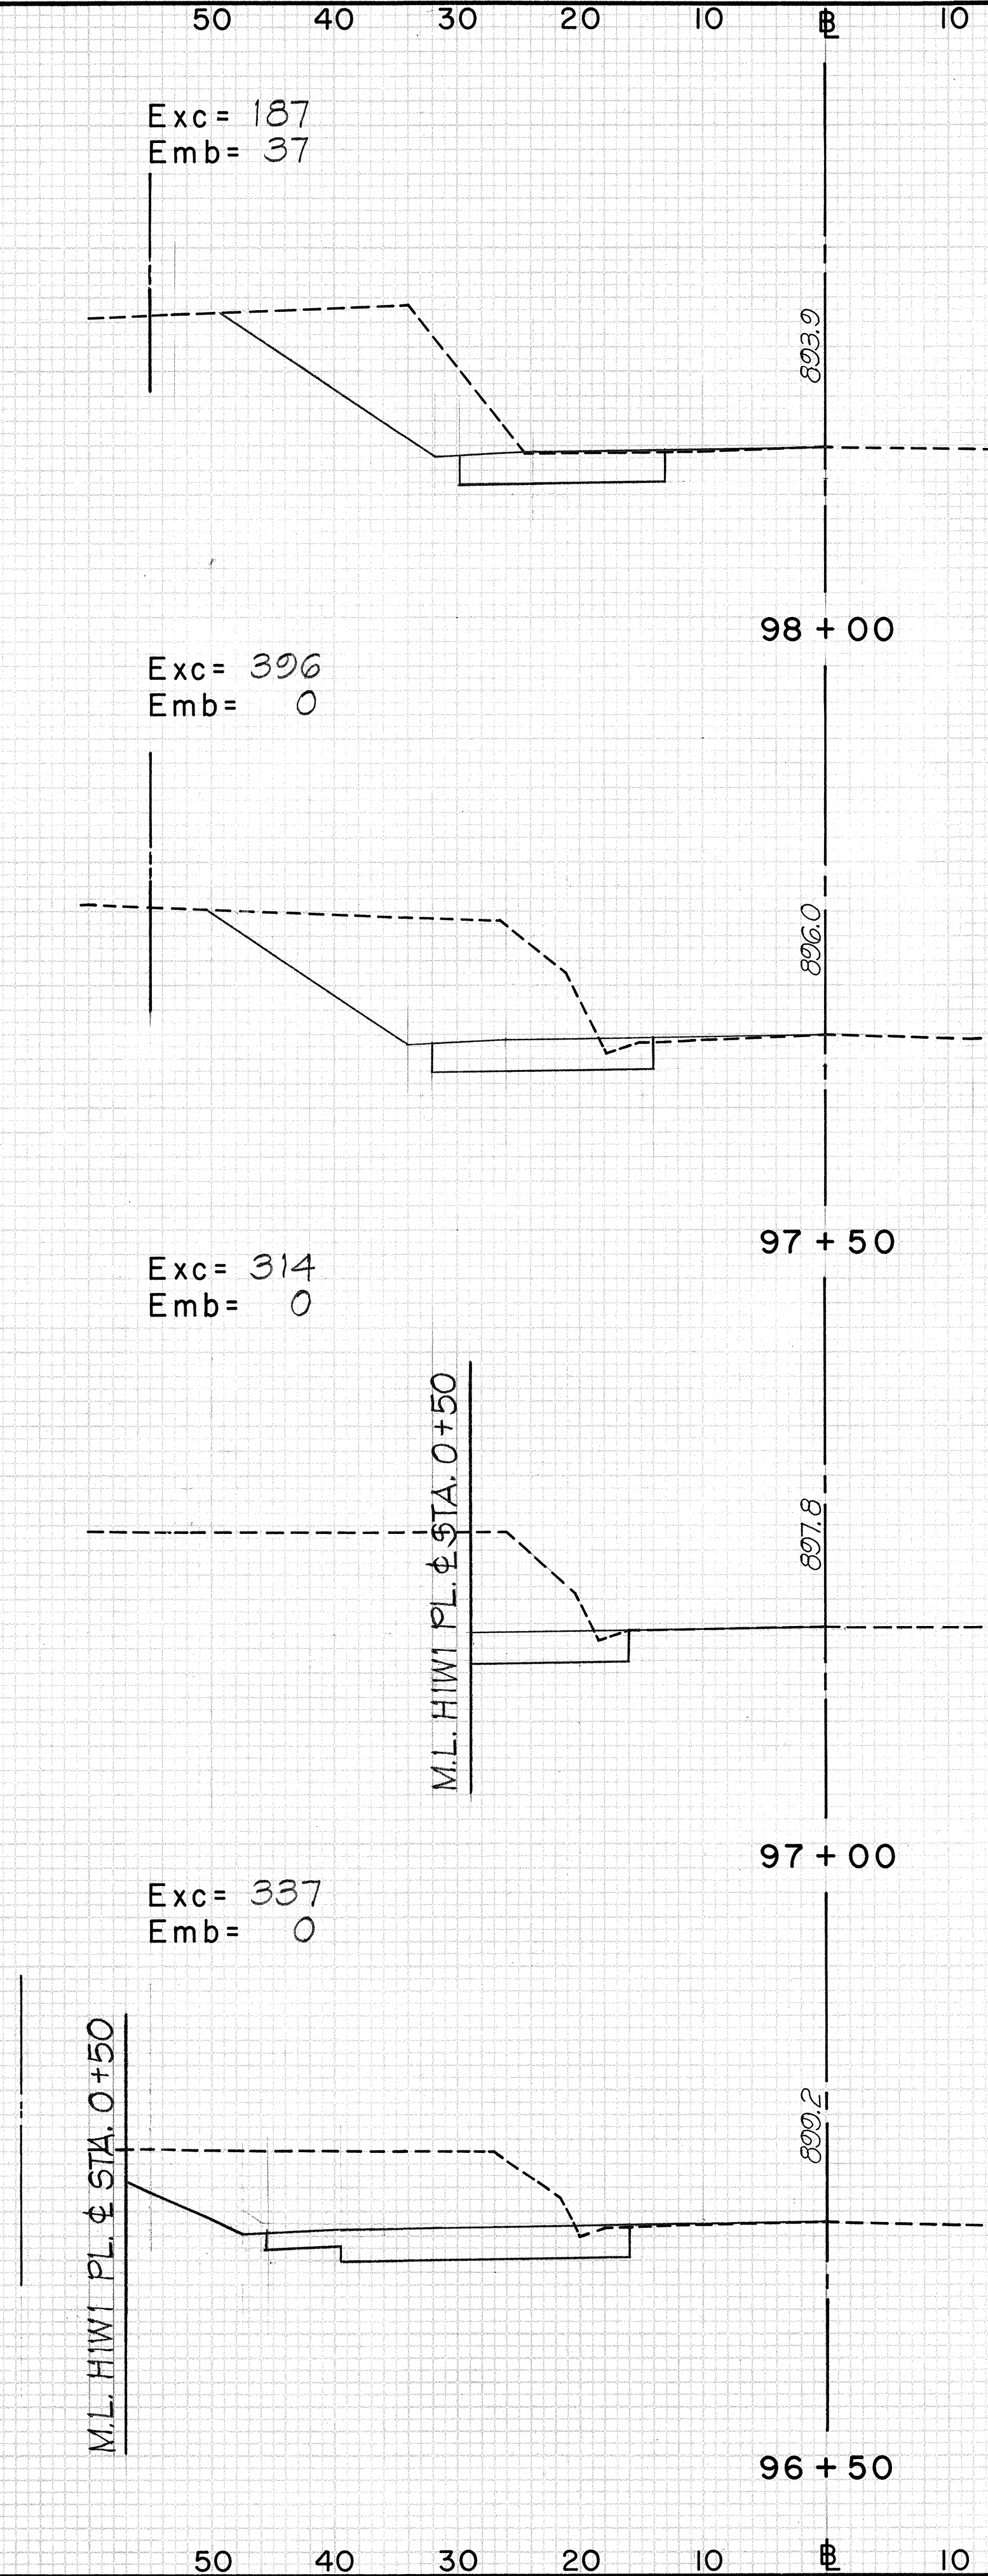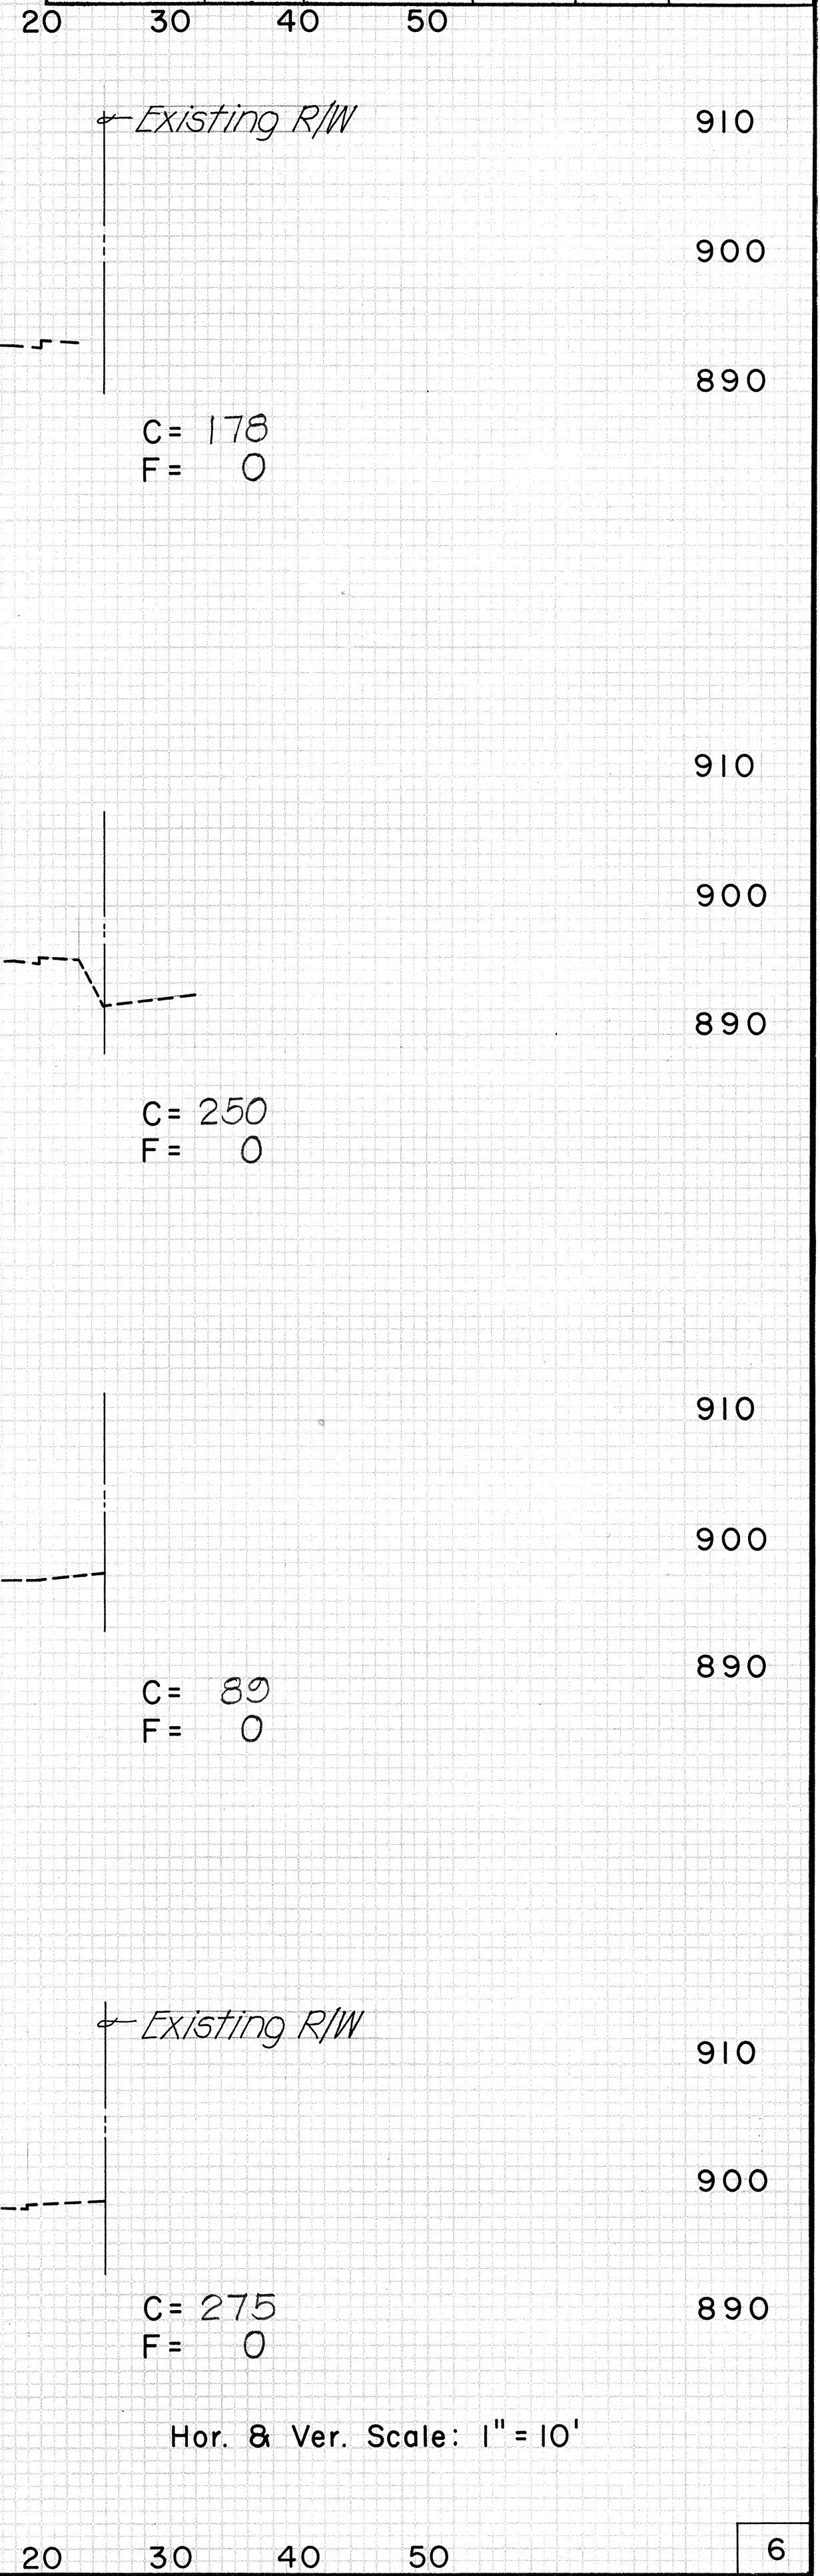

Hor. & Ver. Scale: 1" = 10'

DATE	BY
SURVEYED	PLOTTED
NOTE BOOK	AREAS
NO.	AREAS CHECKED

DATE	BY
SURVEYED	PLOTTED
NOTE BOOK	AREAS
NO.	AREAS CHECKED


FINAL	SURVEYED	DATE
SURVEY	PLOTTED	BY
NOTE BOOK	DATE	
NO.	AREAS CHECKED	

ORIGINAL	SURVEYED	DATE
SURVEY	PLOTTED	BY
NOTE BOOK	DATE	
NO.	AREAS CHECKED	

FED. ROAD DIST. NO.	STATE	FED. AID PROJ. NO.	FISCAL YEAR	SHEET NO.	TOTAL SHEETS
HAWAII	HAW.	F-080-1(5)	1980	122	123

20 30 40 50

Hor. & Ver. Scale: 1" = 10'

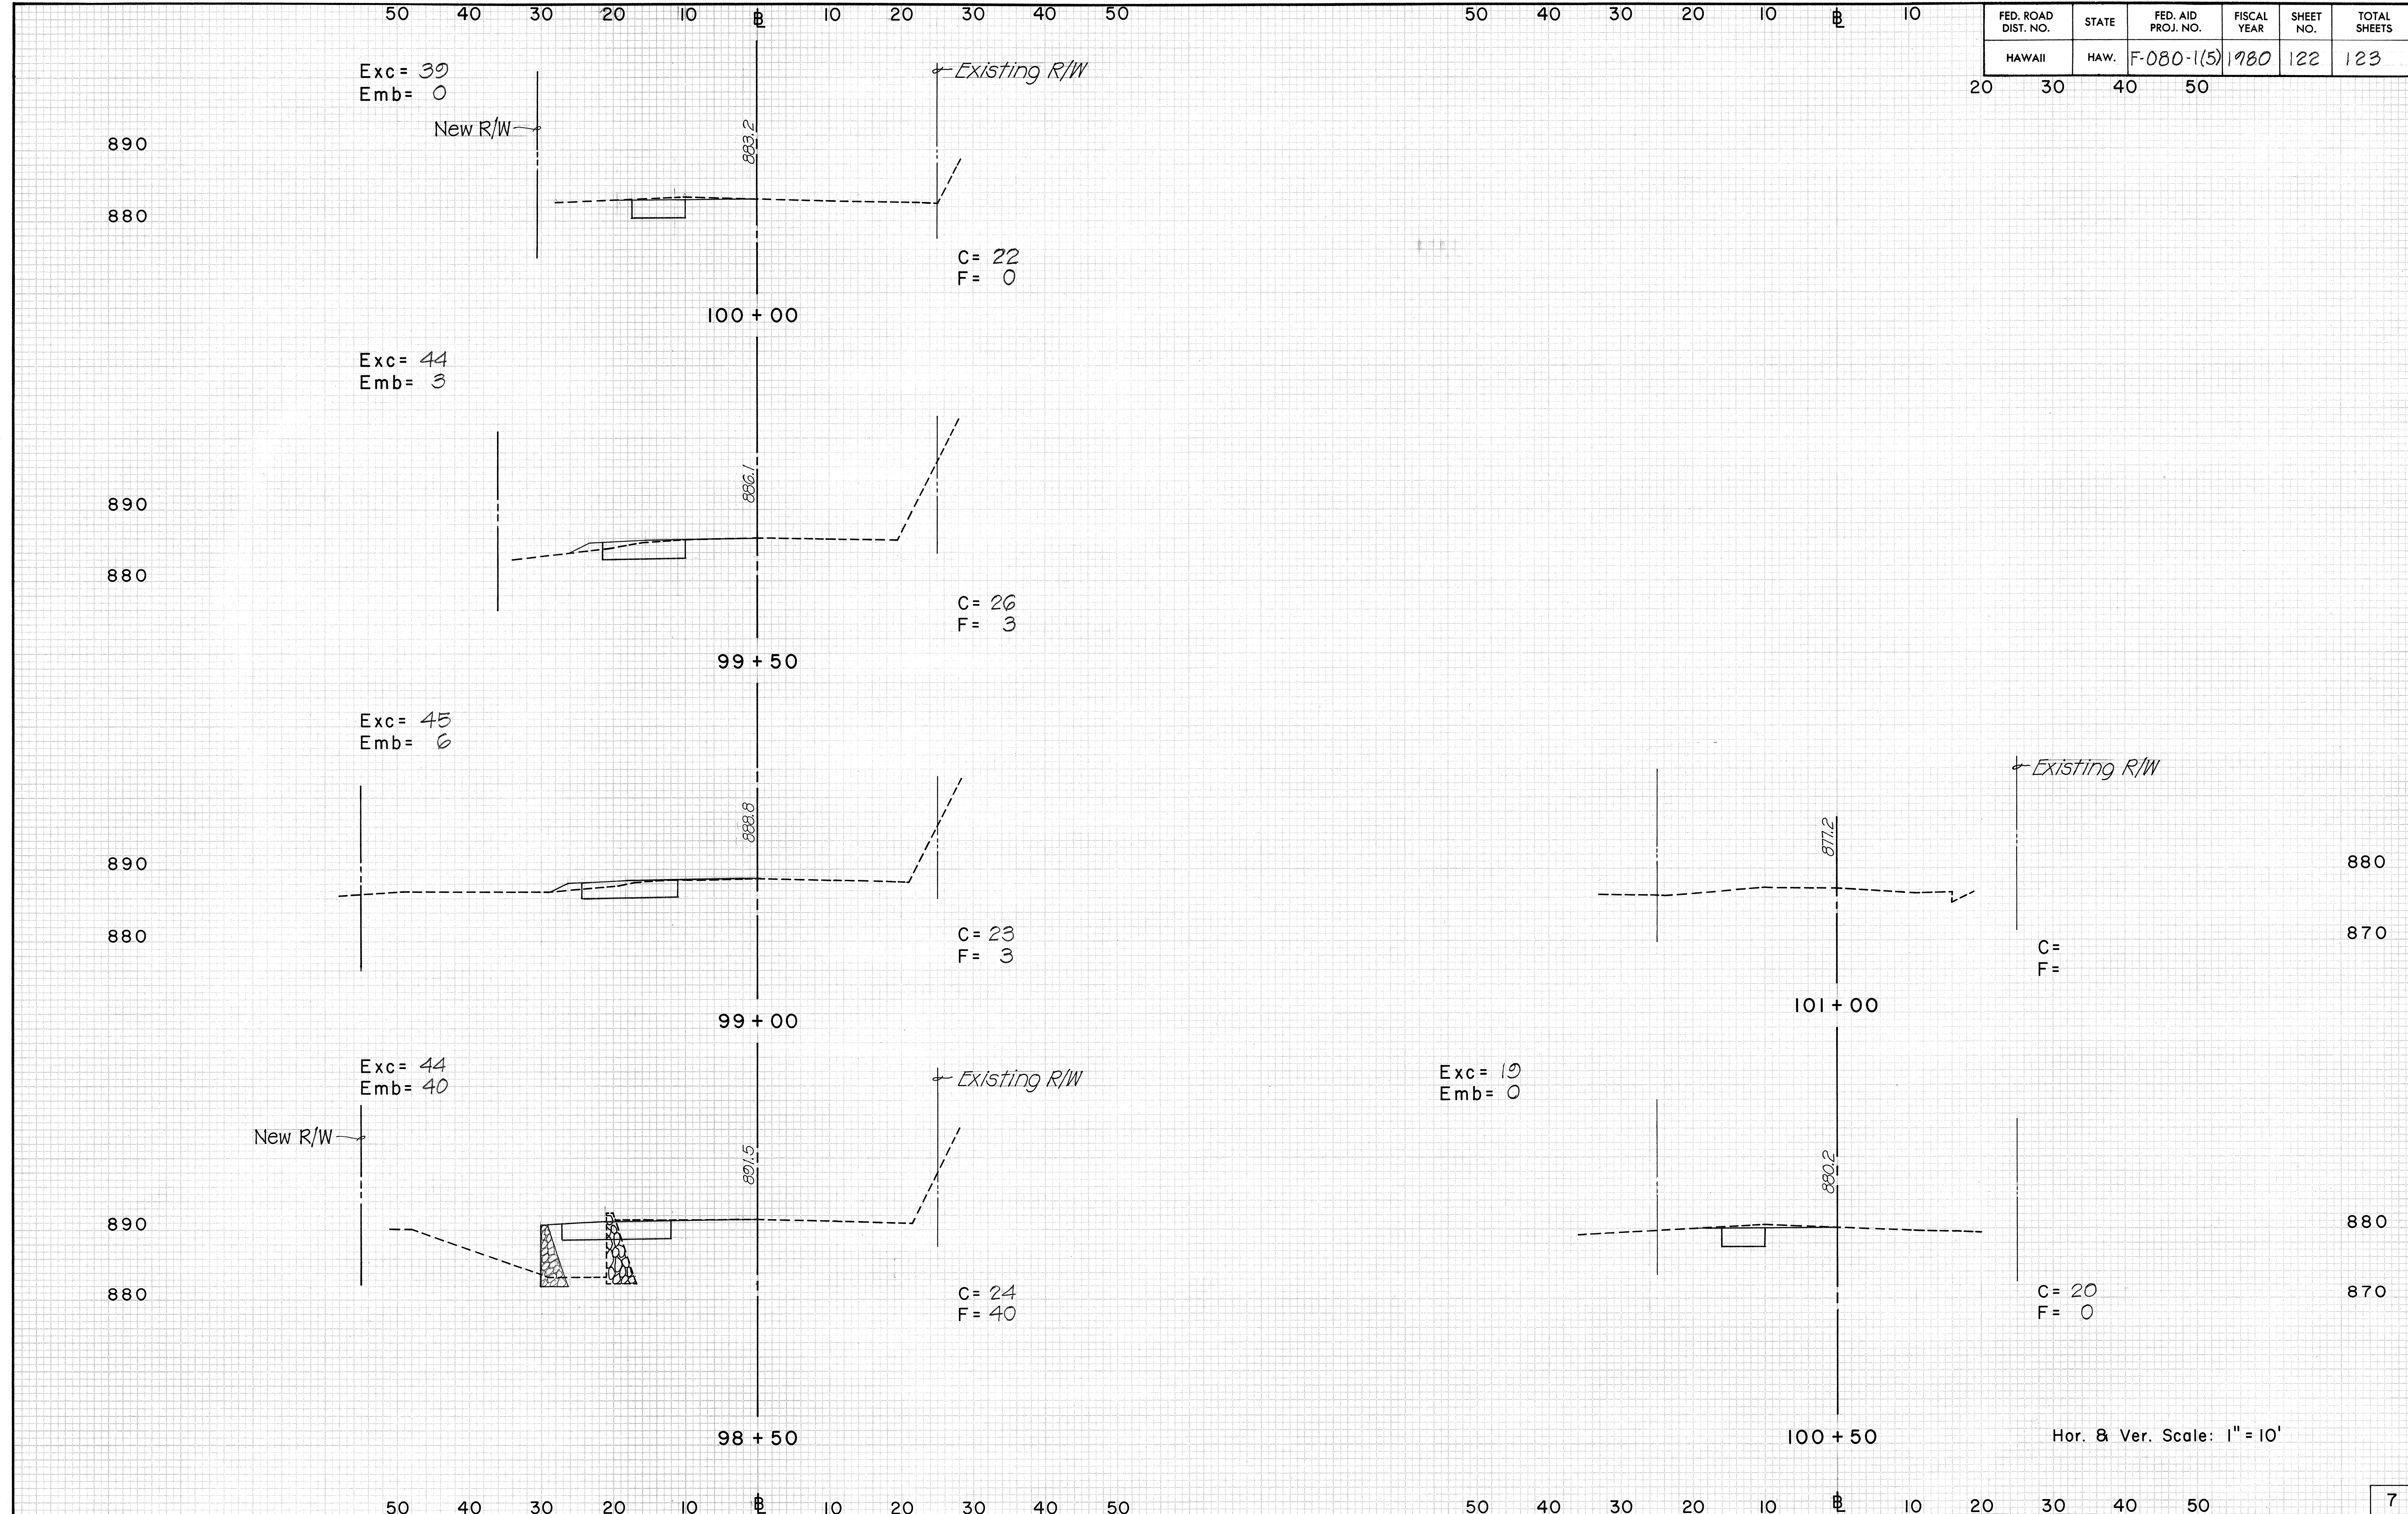

FED. ROAD DIST. NO.	STATE	FED. AID PROJ. NO.	FISCAL YEAR	SHEET NO.	TOTAL SHEETS
HAWAII	HAW.	F.F-080-(15)	1980	123	123

FINAL SURVEY	SURVEYED	BY	DATE
NO.	PLOTTED		
	NOTE BOOK		
	AREAS CHECKED		

ORIGINAL SURVEY	SURVEYED	BY	DATE
NO.	PLOTTED		
	NOTE BOOK		
	AREAS CHECKED		

