	A
	INDEX TO DRAWINGS
SHEET NO.	DESCRIPTION
. 1	TITLE SHEET
2	TRAFFIC CONTROL PLAN AND NOTES
3	TRAFFIC SIGNAL PLAN
. 4	MISCELLANEOUS DETAILS
5 - 15	STANDARD DETAILS
	•
All the second of the second o	



STATE OF HAWAII

DEPARTMENT OF TRANSPORTATION HIGHWAYS DIVISION


HONOLULU, HAWAII


"AS-BUILT"

PLANS FOR

KAMEHAMEHA HIGHWAY TRAFFIC SIGNALS AT WHITMORE AVENUE FEDERAL AID PROJECT NO. RSG-804(I)

DISTRICT OF WAHIAWA
ISLAND OF OAHU

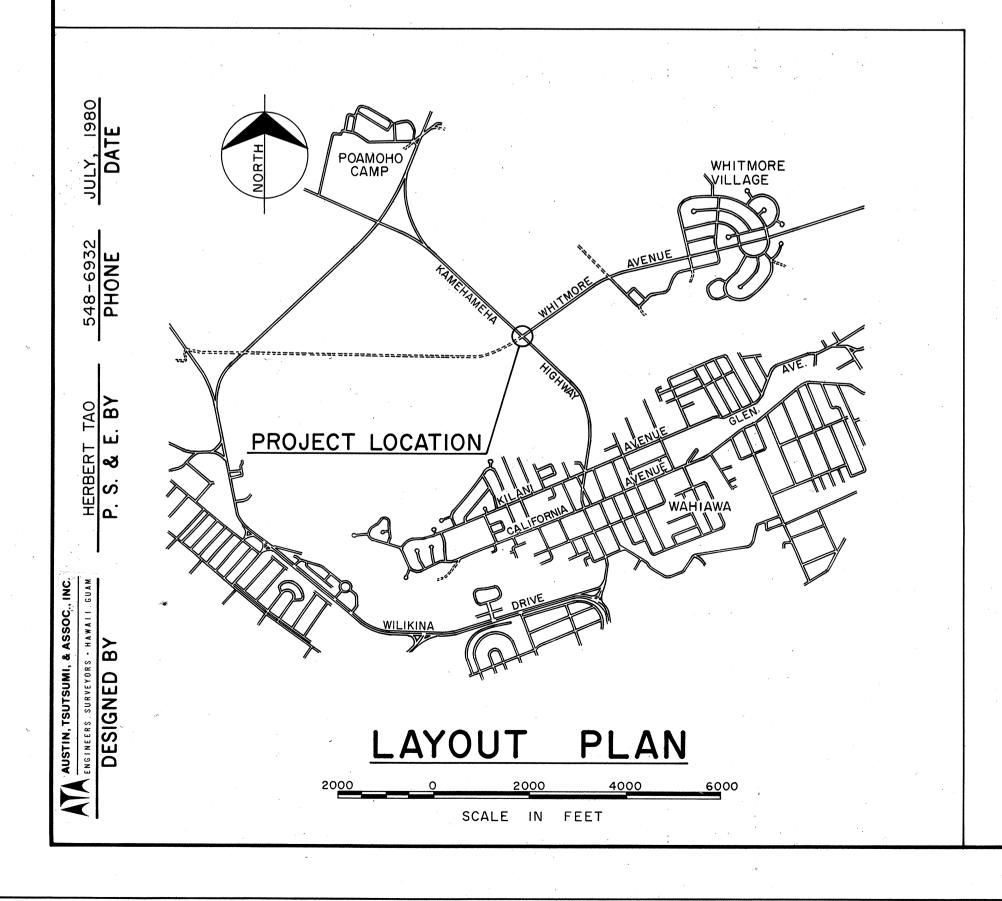

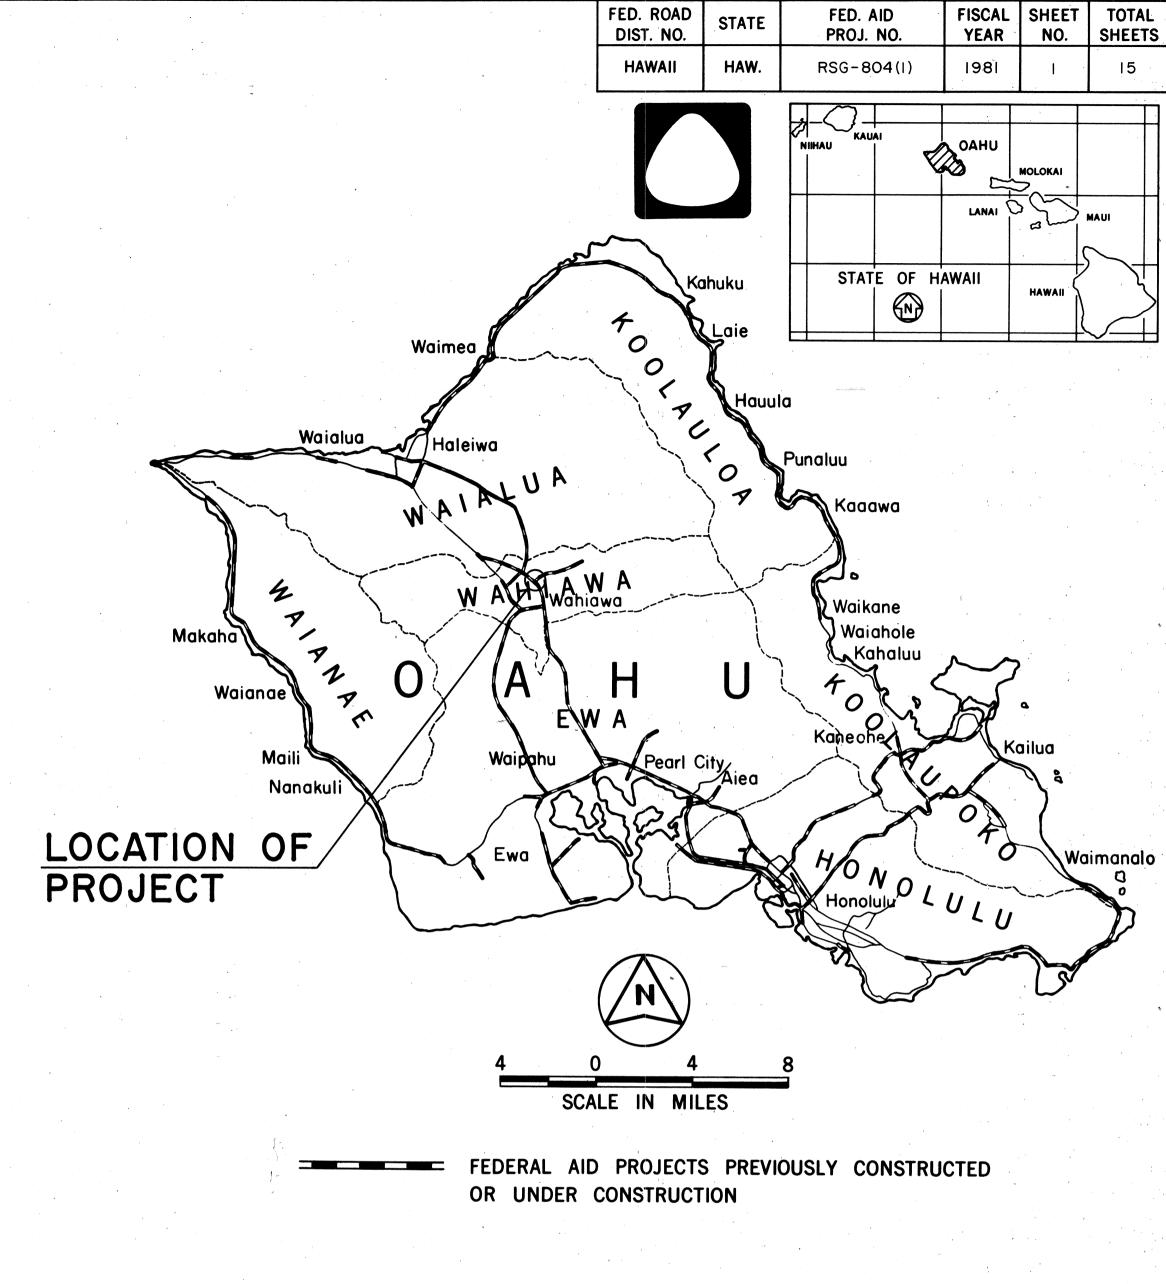

ALL CHANGES MADE DURING CONSTRUCTION HAVE BEEN NOTED IN RED ON THESE TRACINGS AND CHECKED BY

RESIDENT ENGINEER

DESIGN CLASSIFICATION

ADT (1979) 14,479

ADT (1999) 22,200

DHV 1,887

D 65/35

T 4.5%

T₂₄ 5.5%

V 25 MPH

DEPARTMENT OF TRANSPORTATION STATE OF HAWAII

APPROVED:

James R. Lances 3/20/81

FOR TRANSPORTATION DATE

DD-1-4-6