
	INDEX TO DRAWINGS
SHEET NO.	DESCRIPTION
	TITLE SHEET
2	STANDARD PLANS SUMMARY
3-6	BRIDGE DETAILS
,	

STATE OF HAWAII

DEPARTMENT OF TRANSPORTATION
HIGHWAYS DIVISION
"AS-BUILT"
PLANS FOR


KAMEHAMEHA HIGHWAY
REPAIR AND PAINT KARSTEN THOT BRIDGE
PROJECT NO. 80A - 01 - 88 M

DISTRICT OF WAHIAWA ISLAND OF OAHU

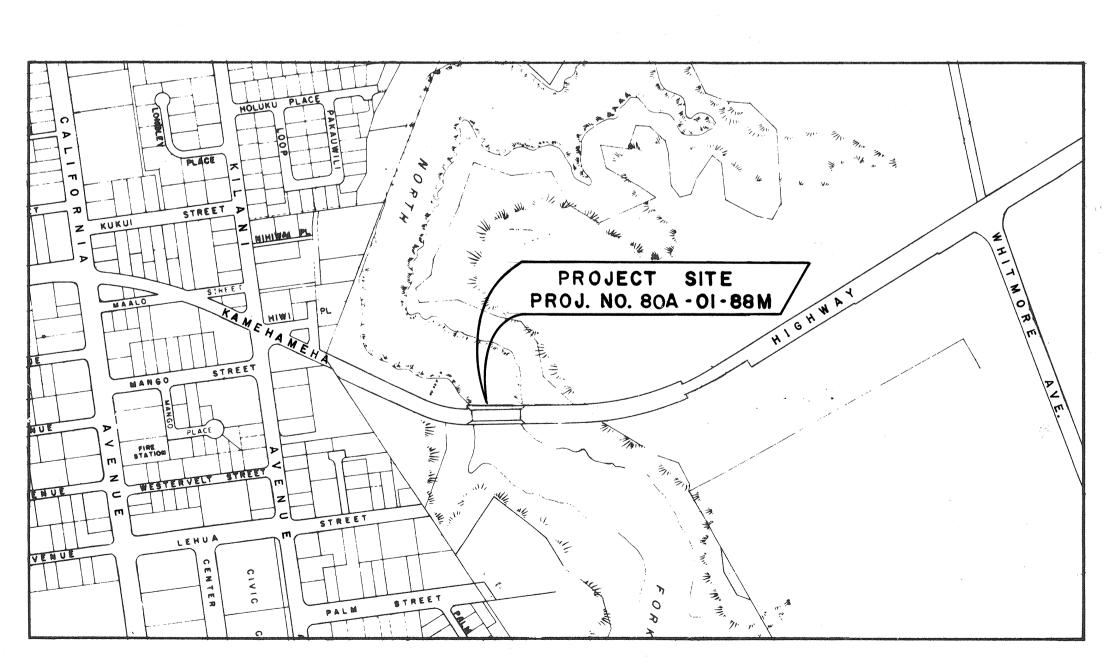

LAYOUT PLAN



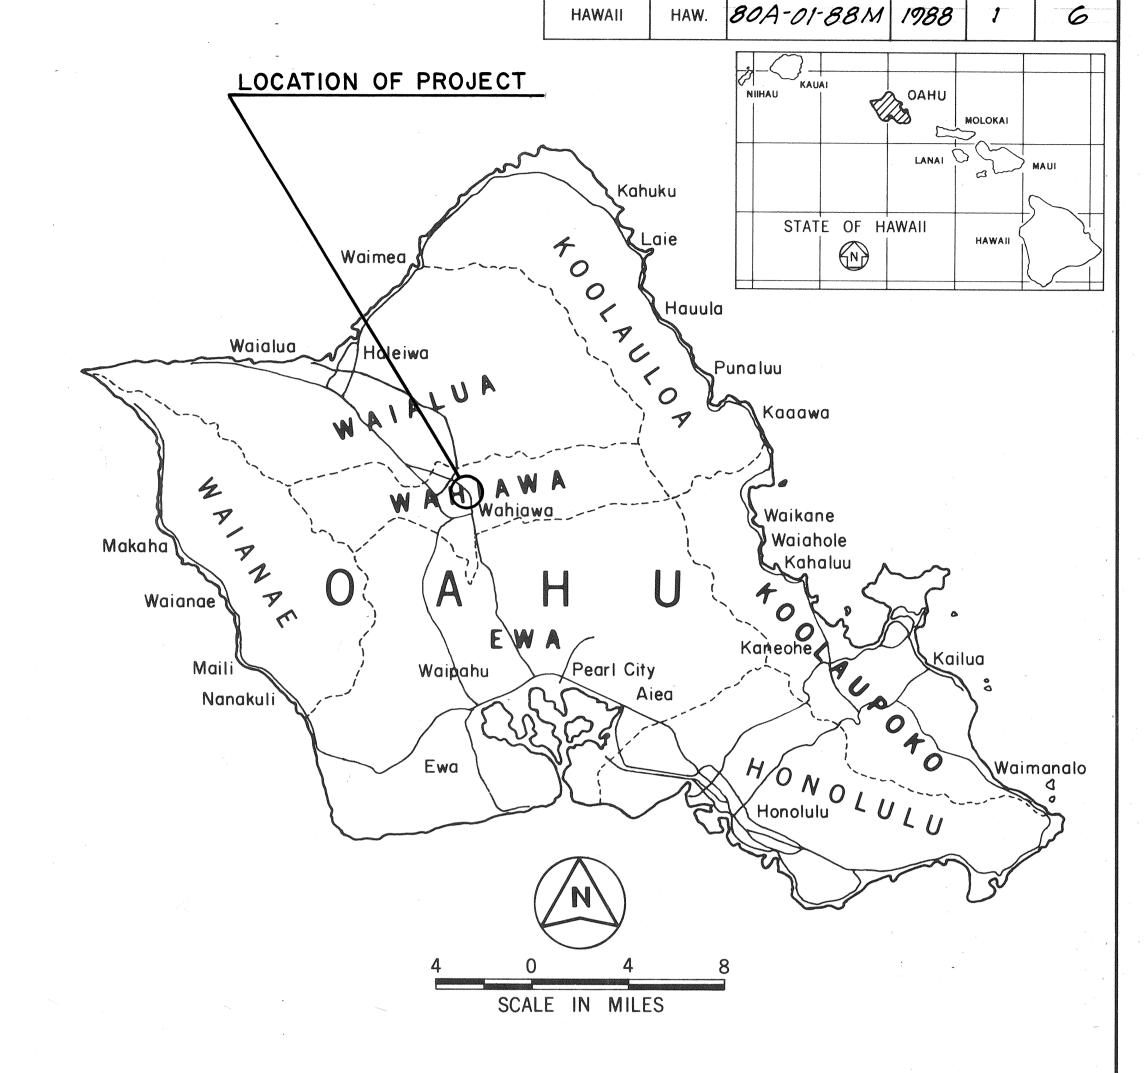

FED. ROAD DIST. NO. FISCAL YEAR

PROJ. NO.

CHANGES MADE DURING CONSTRUCTION HAVE BEEN INCORPORATED ON THESE PLANS EXCEPT CHANGES IN THE ORIGINAL THEORETICAL QUANTITIES. FOR ACTUAL QUANTITIES, REFER TO PROJECT LEDGER AND/OR COMPUTATION BOOK.

RESIDENT ENGINEER

5/5/89 DATÉ

DEPARTMENT OF TRANSPORTATION STATE OF HAWAII

APPROVED:

IR. OF TRANSPORTATION

DATE

9-4-0-0

MAR., 1988 DATE

HWY-DD PHONE