	INDEX TO DRAWINGS
SHEET NO.	DESCRIPTION
1	TITLE SHEET
2	PARTIAL ELECTRICAL PLANS
	:\
3	STREET LIGHT POLE & DETAILS
<u> </u>	

STATE OF HAWAII

DEPARTMENT OF TRANSPORTATION
HIGHWAYS DIVISION
HONOLULU, HAWAII

AS BUILT


PLANS FOR


KAMEHAMEHA HIGHWAY STREET LIGHTS,

KARSTEN THOT BRIDGE TO WHITMORE AVENUE

PROJECT NO. 80B-01-87

DISTRICT OF WAHIAWA, ISLAND OF OAHU

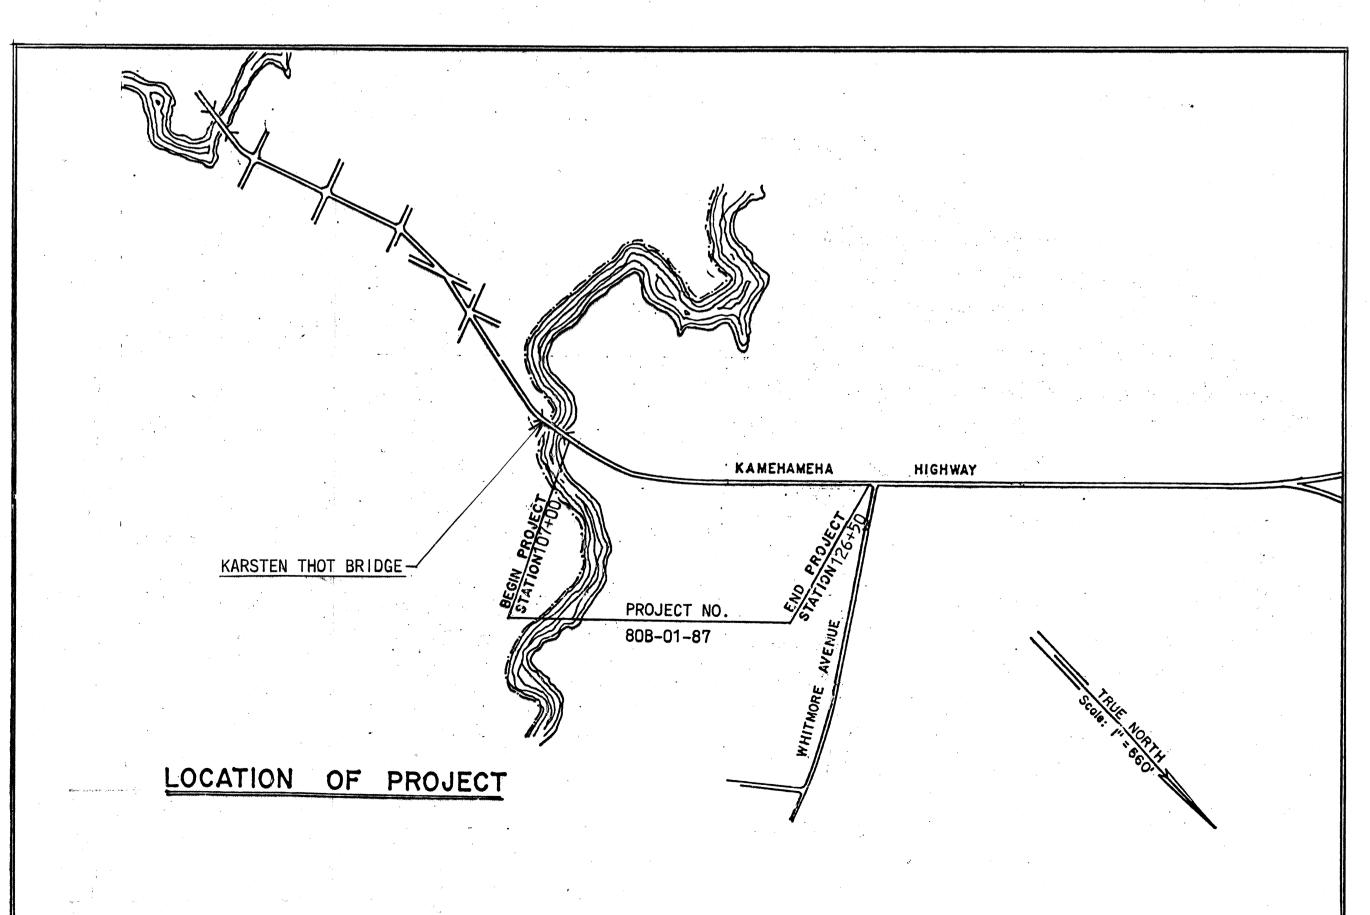

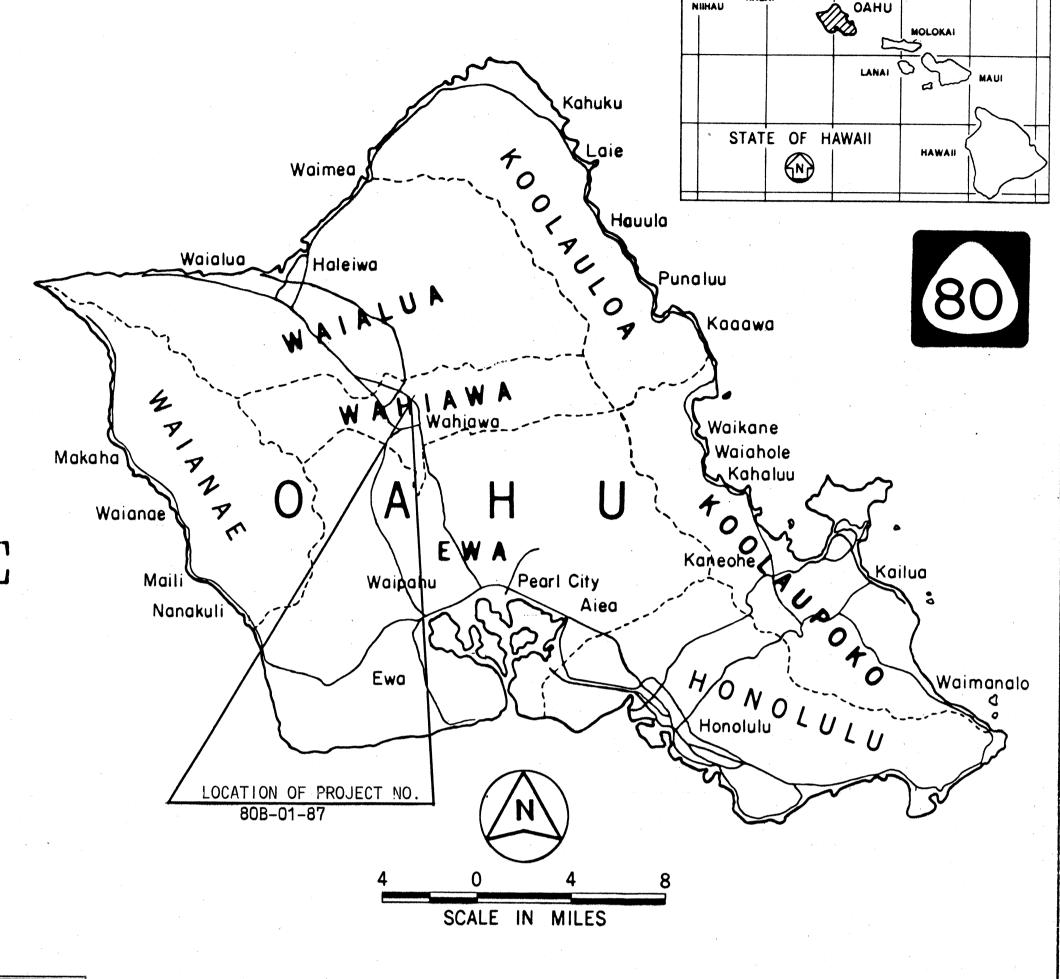

FED. ROAD DIST. NO.


STATE

PROJ. NO.

CHANGES MADE DURING CONSTRUCTION HAVE
BEEN INCORPORATED ON THESE PLANS EXCEPT
CHANGES IN THE ORIGINAL THEORETICAL
QUANTITIES. FOR ACTUAL QUANTITIES, REFER TO
PROJECT LEDGER AND/OR COMPUTATION BOOK.

RESIDENT ENGINEER

DATE

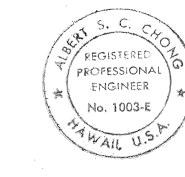

THIS WORK WAS PREPARED BY ME
OR UNDER MY SUPERVISION

Celbera Chong

DEPARTMENT OF TRANSPORTATION STATE OF HAWAII APPROVED:

OF TRANSPORTATION DA

5/20/88 DATE

FISCAL SHEET TOTAL YEAR NO. SHEETS