

[illegible]

STATE OF HAWAII
DEPARTMENT OF TRANSPORTATION
HIGHWAYS DIVISION

HONOLULU, HAWAII


" AS-BUILT "

PLANS FOR

KAMEHAMEHA HIGHWAY TRAFFIC SIGNALS AT WILIKINA DRIVE

PROJECT NO. 99C-01-89

**DISTRICT OF WAHIAWA
ISLAND OF OAHU**

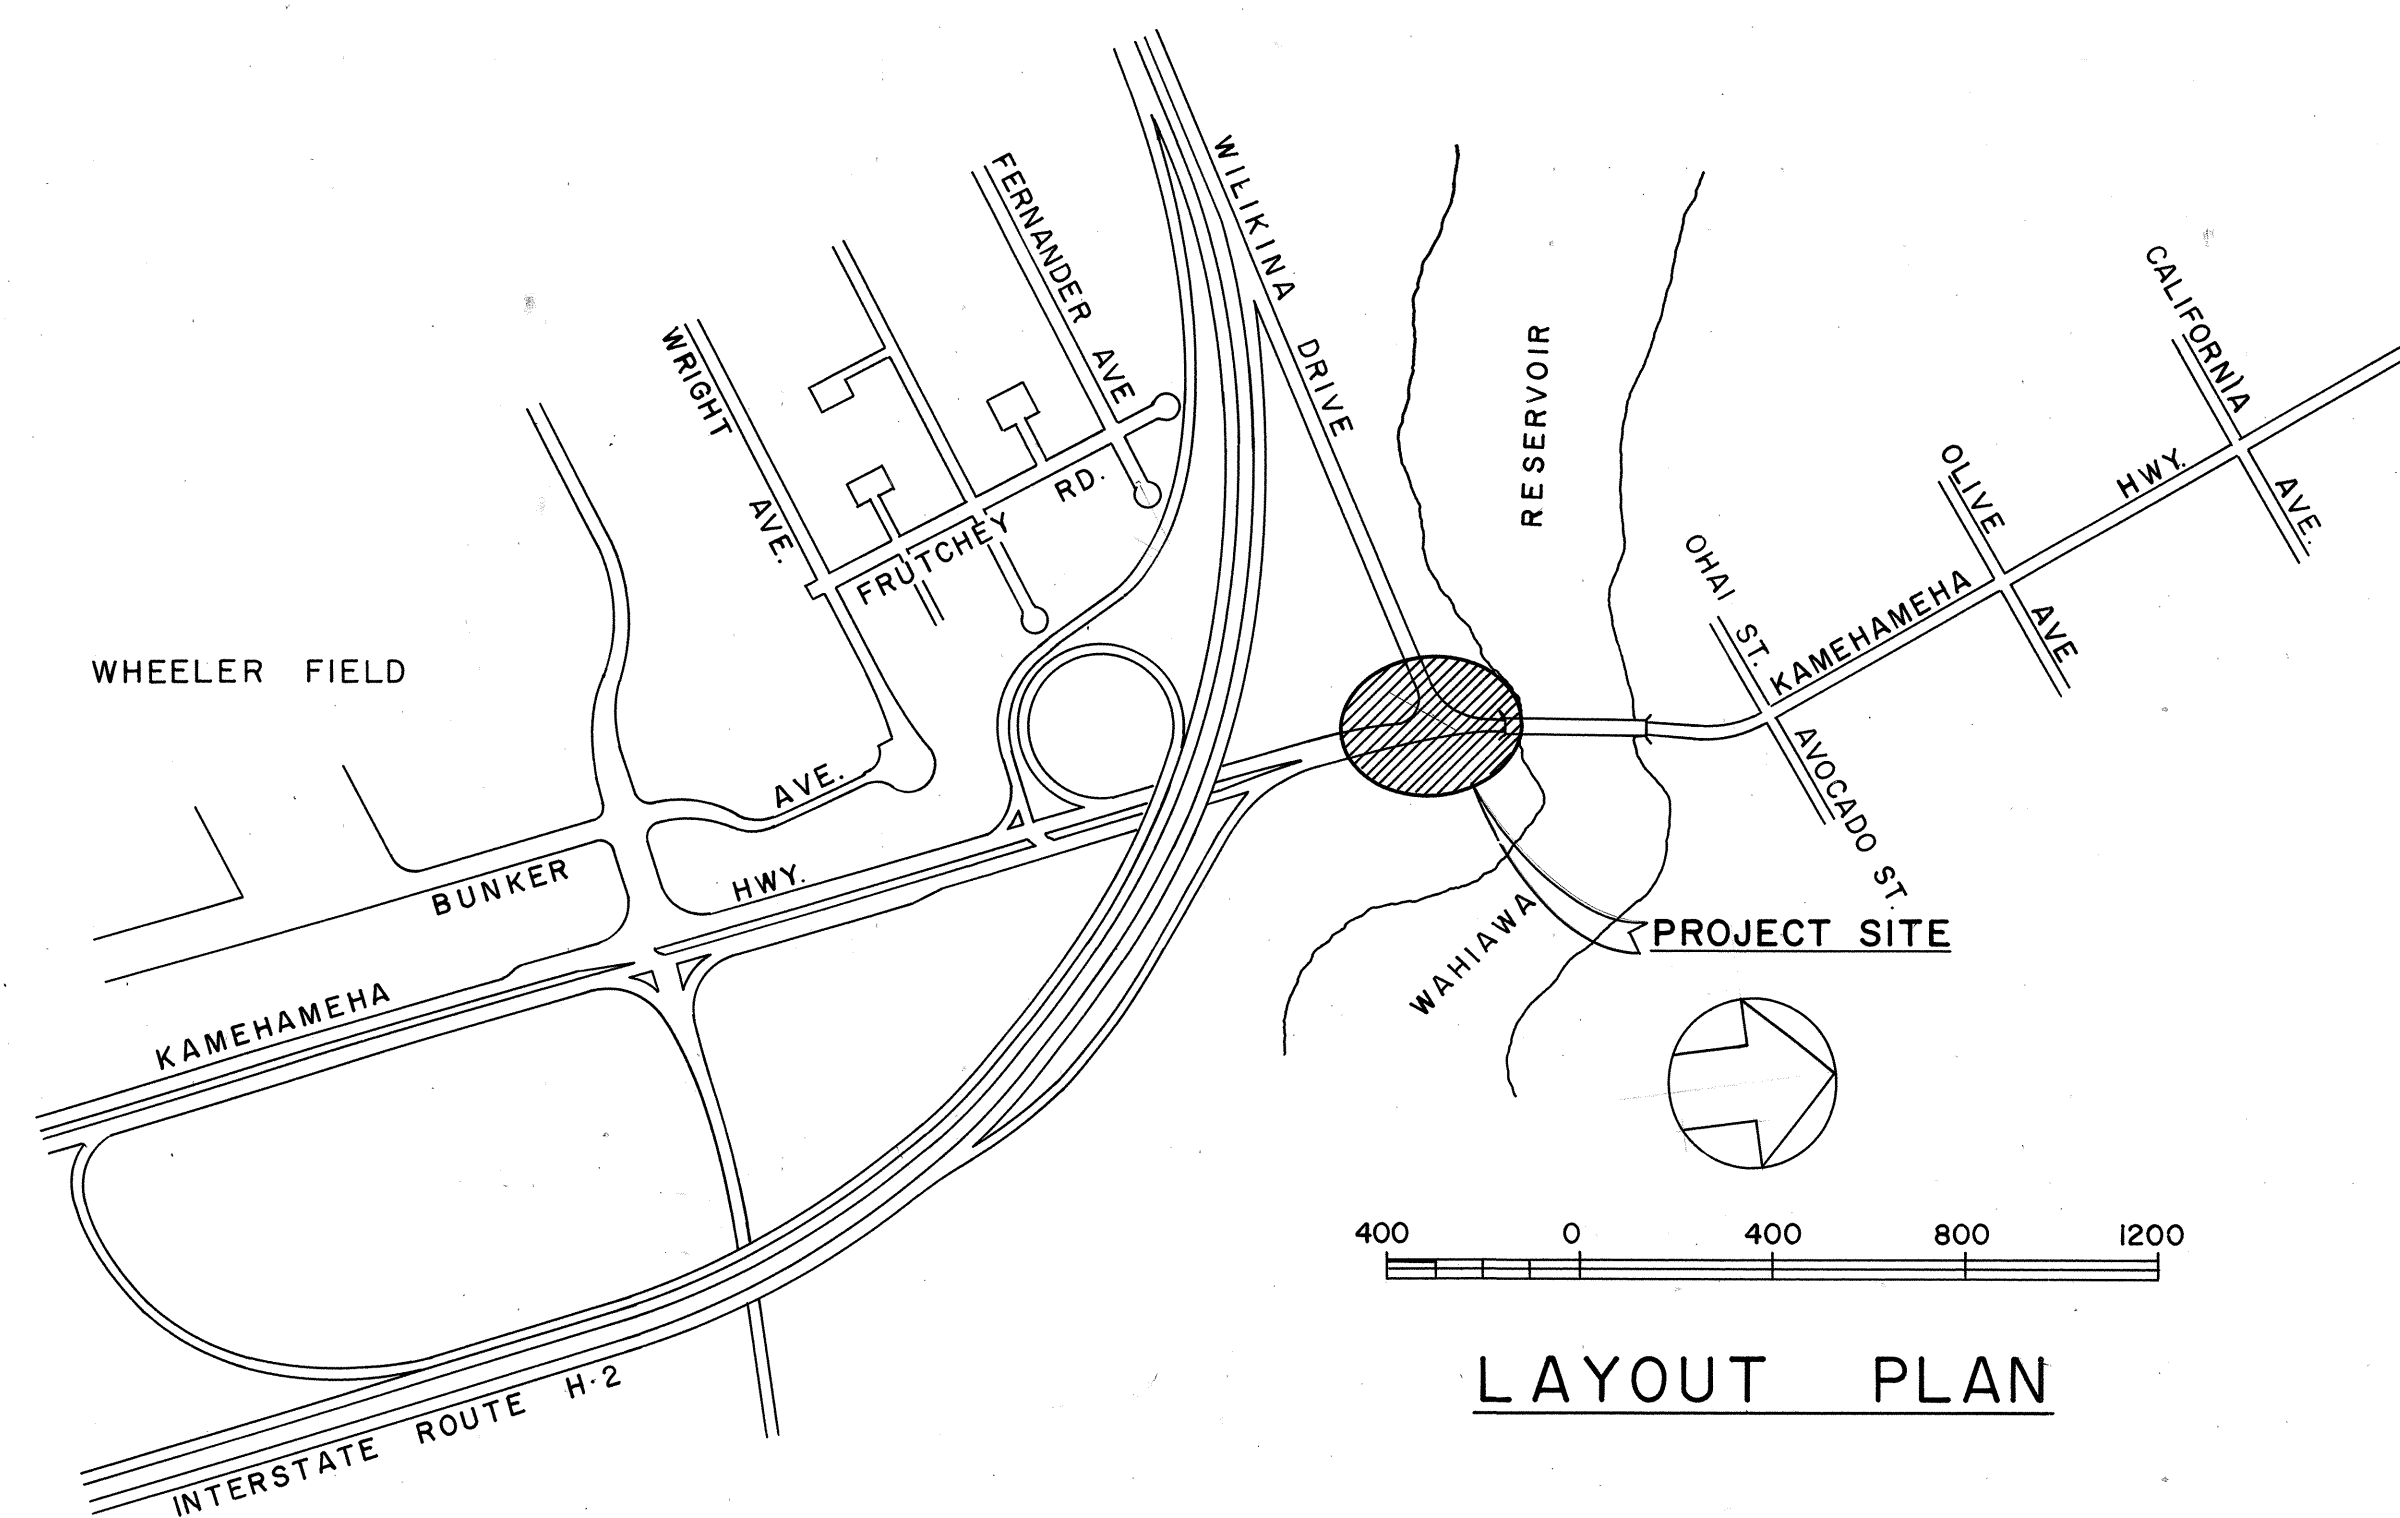

Michael Durriga
RESIDENT ENGINEER

SEY / ATA
DESIGNED BY

F. ABESHIMA
P. S. & E. BY

548-4042
PHONE

OCT. 1988
DATE