• ,	
	INDEX TO DRAWINGS
SHEET NO.	DESCRIPTION
• 1	TITLE SHEET
2	STANDARD PLANS SUMMARY
3	LEGEND, NOTES AND DETAILS
4	SIGNING AND STRIPING PLAN
5	TRAFFIC SIGNAL PLAN
6	LOOP DETECTOR DETAILS
,	

STATE OF HAWAII

DEPARTMENT OF TRANSPORTATION

HIGHWAYS DIVISION

HONOLULU, HAWAII


"AS-BUILT"


PLANS FOR

KAMEHAMEHA HIGHWAY, TRAFFIC SIGNALS AT AVOCADO STREET / OHAI STREET

FEDERAL AID PROJECT NO. HES-080-1(9)

DISTRICT OF WAHIAWA
ISLAND OF OAHU

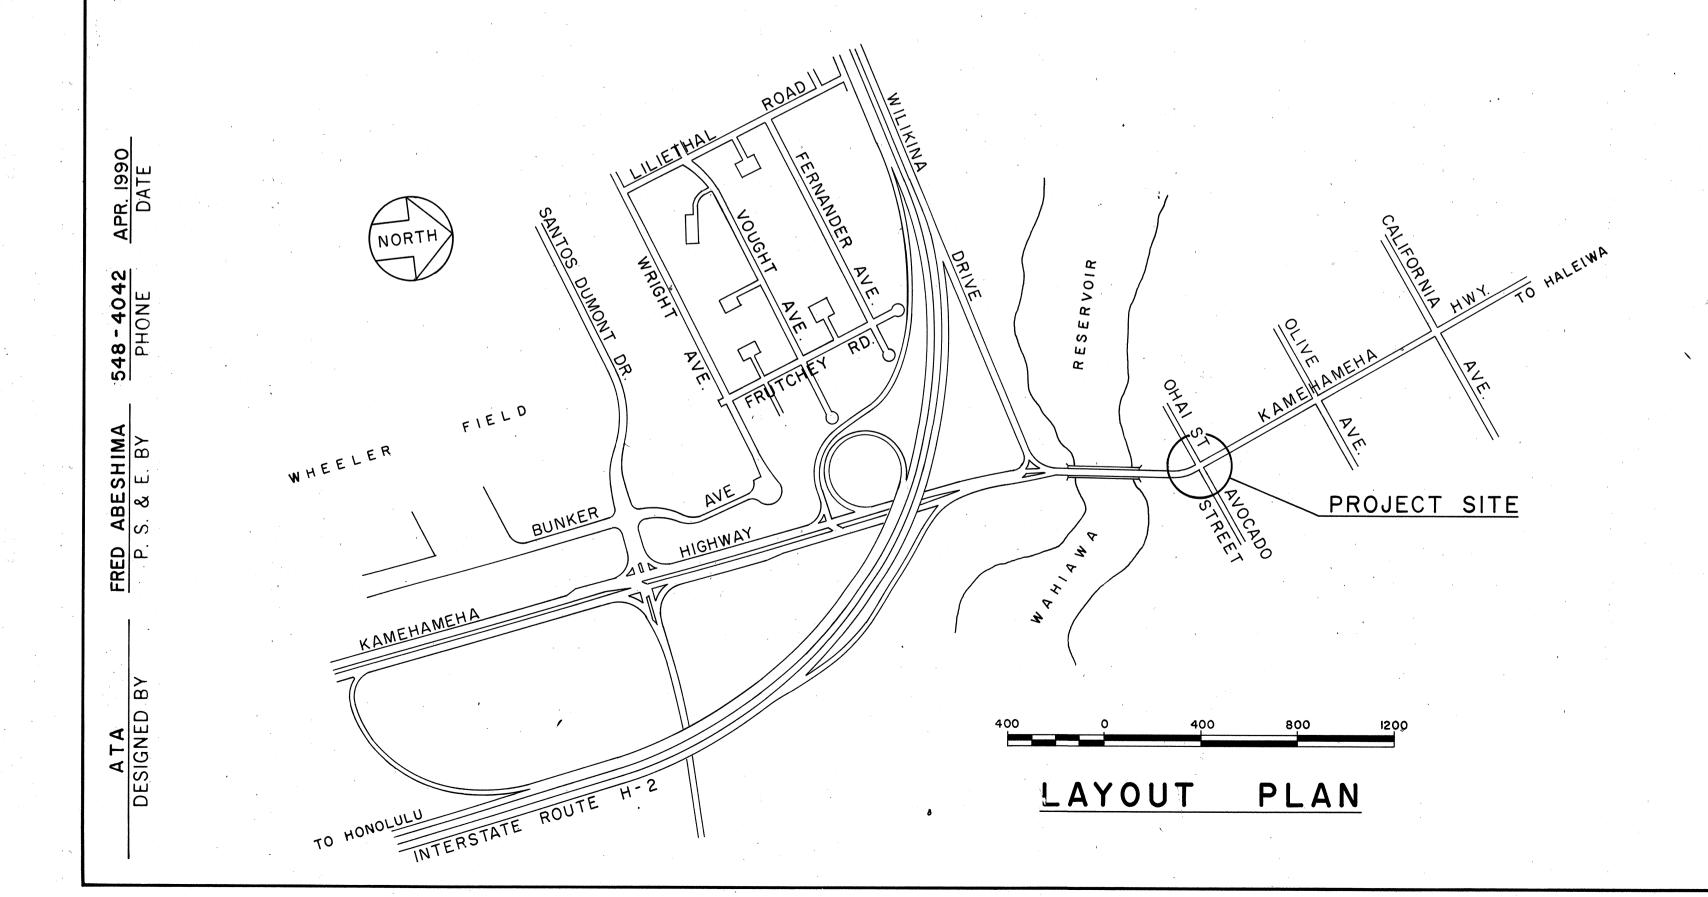

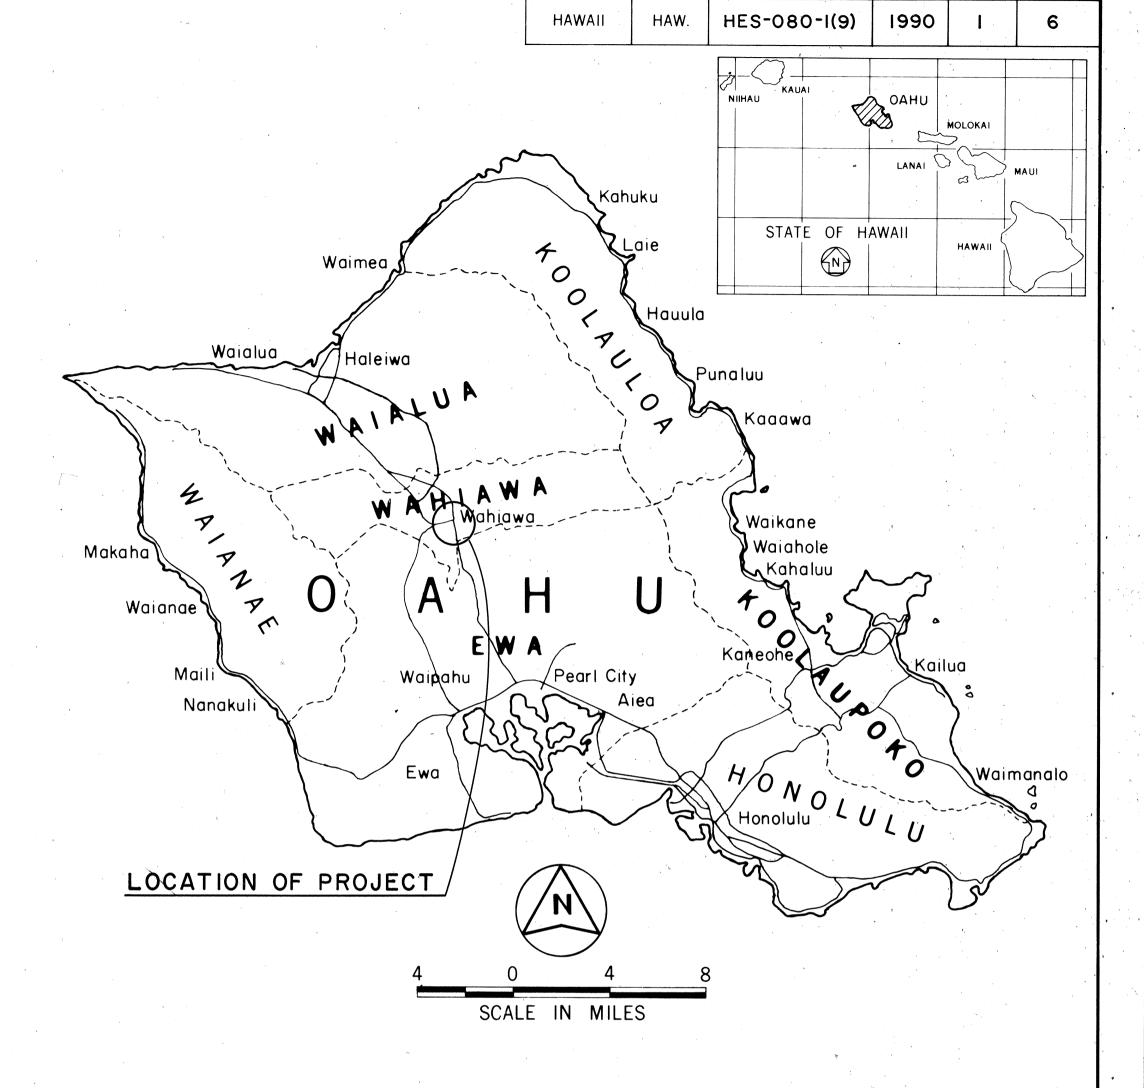

FED. AID PROJ. NO.

CHANGES MADE DURING CONSTRUCTION HAVE
BEEN INCORPORATED ON THESE PLANS EXCEPT
CHANGES IN THE ORIGINAL THEORETICAL
QUANTITIES. FOR ACTUAL QUANTITIES, REFER TO
PROJECT LEDGER AND/OR COMPUTATION BOOK.

Muhael Diniga RESIDENT ENGINEER

10/9/9/ DATE

DEPARTMENT OF TRANSPORTATION FEDERAL HIGHWAY ADMINISTRATION APPROVED:

Continus 4/17

DEPARTMENT OF TRANSPORTATION
STATE OF HAWAII

APPRÔVED:

OF TRANSPORTATION DATE