


INDEX TO DRAWINGS	
SHEET NO.	DESCRIPTION
1	TITLE SHEET
2	STANDARD PLANS SUMMARY
① 3	GENERAL NOTES AND LEGEND
4 - 5	TYPICAL SECTIONS
6 - 7	TYPICAL DETAILS
8	MISCELLANEOUS DETAILS
9 - 22	ROADWAY PLANS
23	PAVEMENT MARKING LEGEND
	AND DETAILS
24	TRAFFIC NOTES
25 - 38	PAVEMENT MARKING AND SIGNING PLAN
39	UNBALANCED SIGN INSTALLATION
40	SIGN DETAILS AND FRAME LAYOUT
41 - 43	DESTINATION SIGN DETAILS
44 - 45	DESTINATION SIGN FRAME LAYOUT
46	LOOP DETECTOR DETAILS
47 - 49	TRAFFIC SUMMARIES




① Plan Sht. Nos. ADD3S-1 and ADD3S-2 are supplementary sheets to this project.
TOTAL SHEET COUNT after "AS-BUILT" postings
51 Sheets.

STATE OF HAWAII
DEPARTMENT OF TRANSPORTATION
HIGHWAYS DIVISION
HONOLULU, HAWAII
"AS-BUILT"
PLANS FOR
KAMEHAMEHA HWY RESURF.
KARSTEN THOT BRIDGE TO
PAALAA UKA PUPUKEA ROAD
AND
WILIKINA DR. AND KAMANANUI RD. RESURF.
INTERSTATE ROUTE H-2 TO KAMEHAMEHA HIGHWAY
FEDERAL AID PROJECT NO. STP-0300(29)
DISTRICTS OF WAHIAWA AND WAIALUA
ISLAND OF OAHU

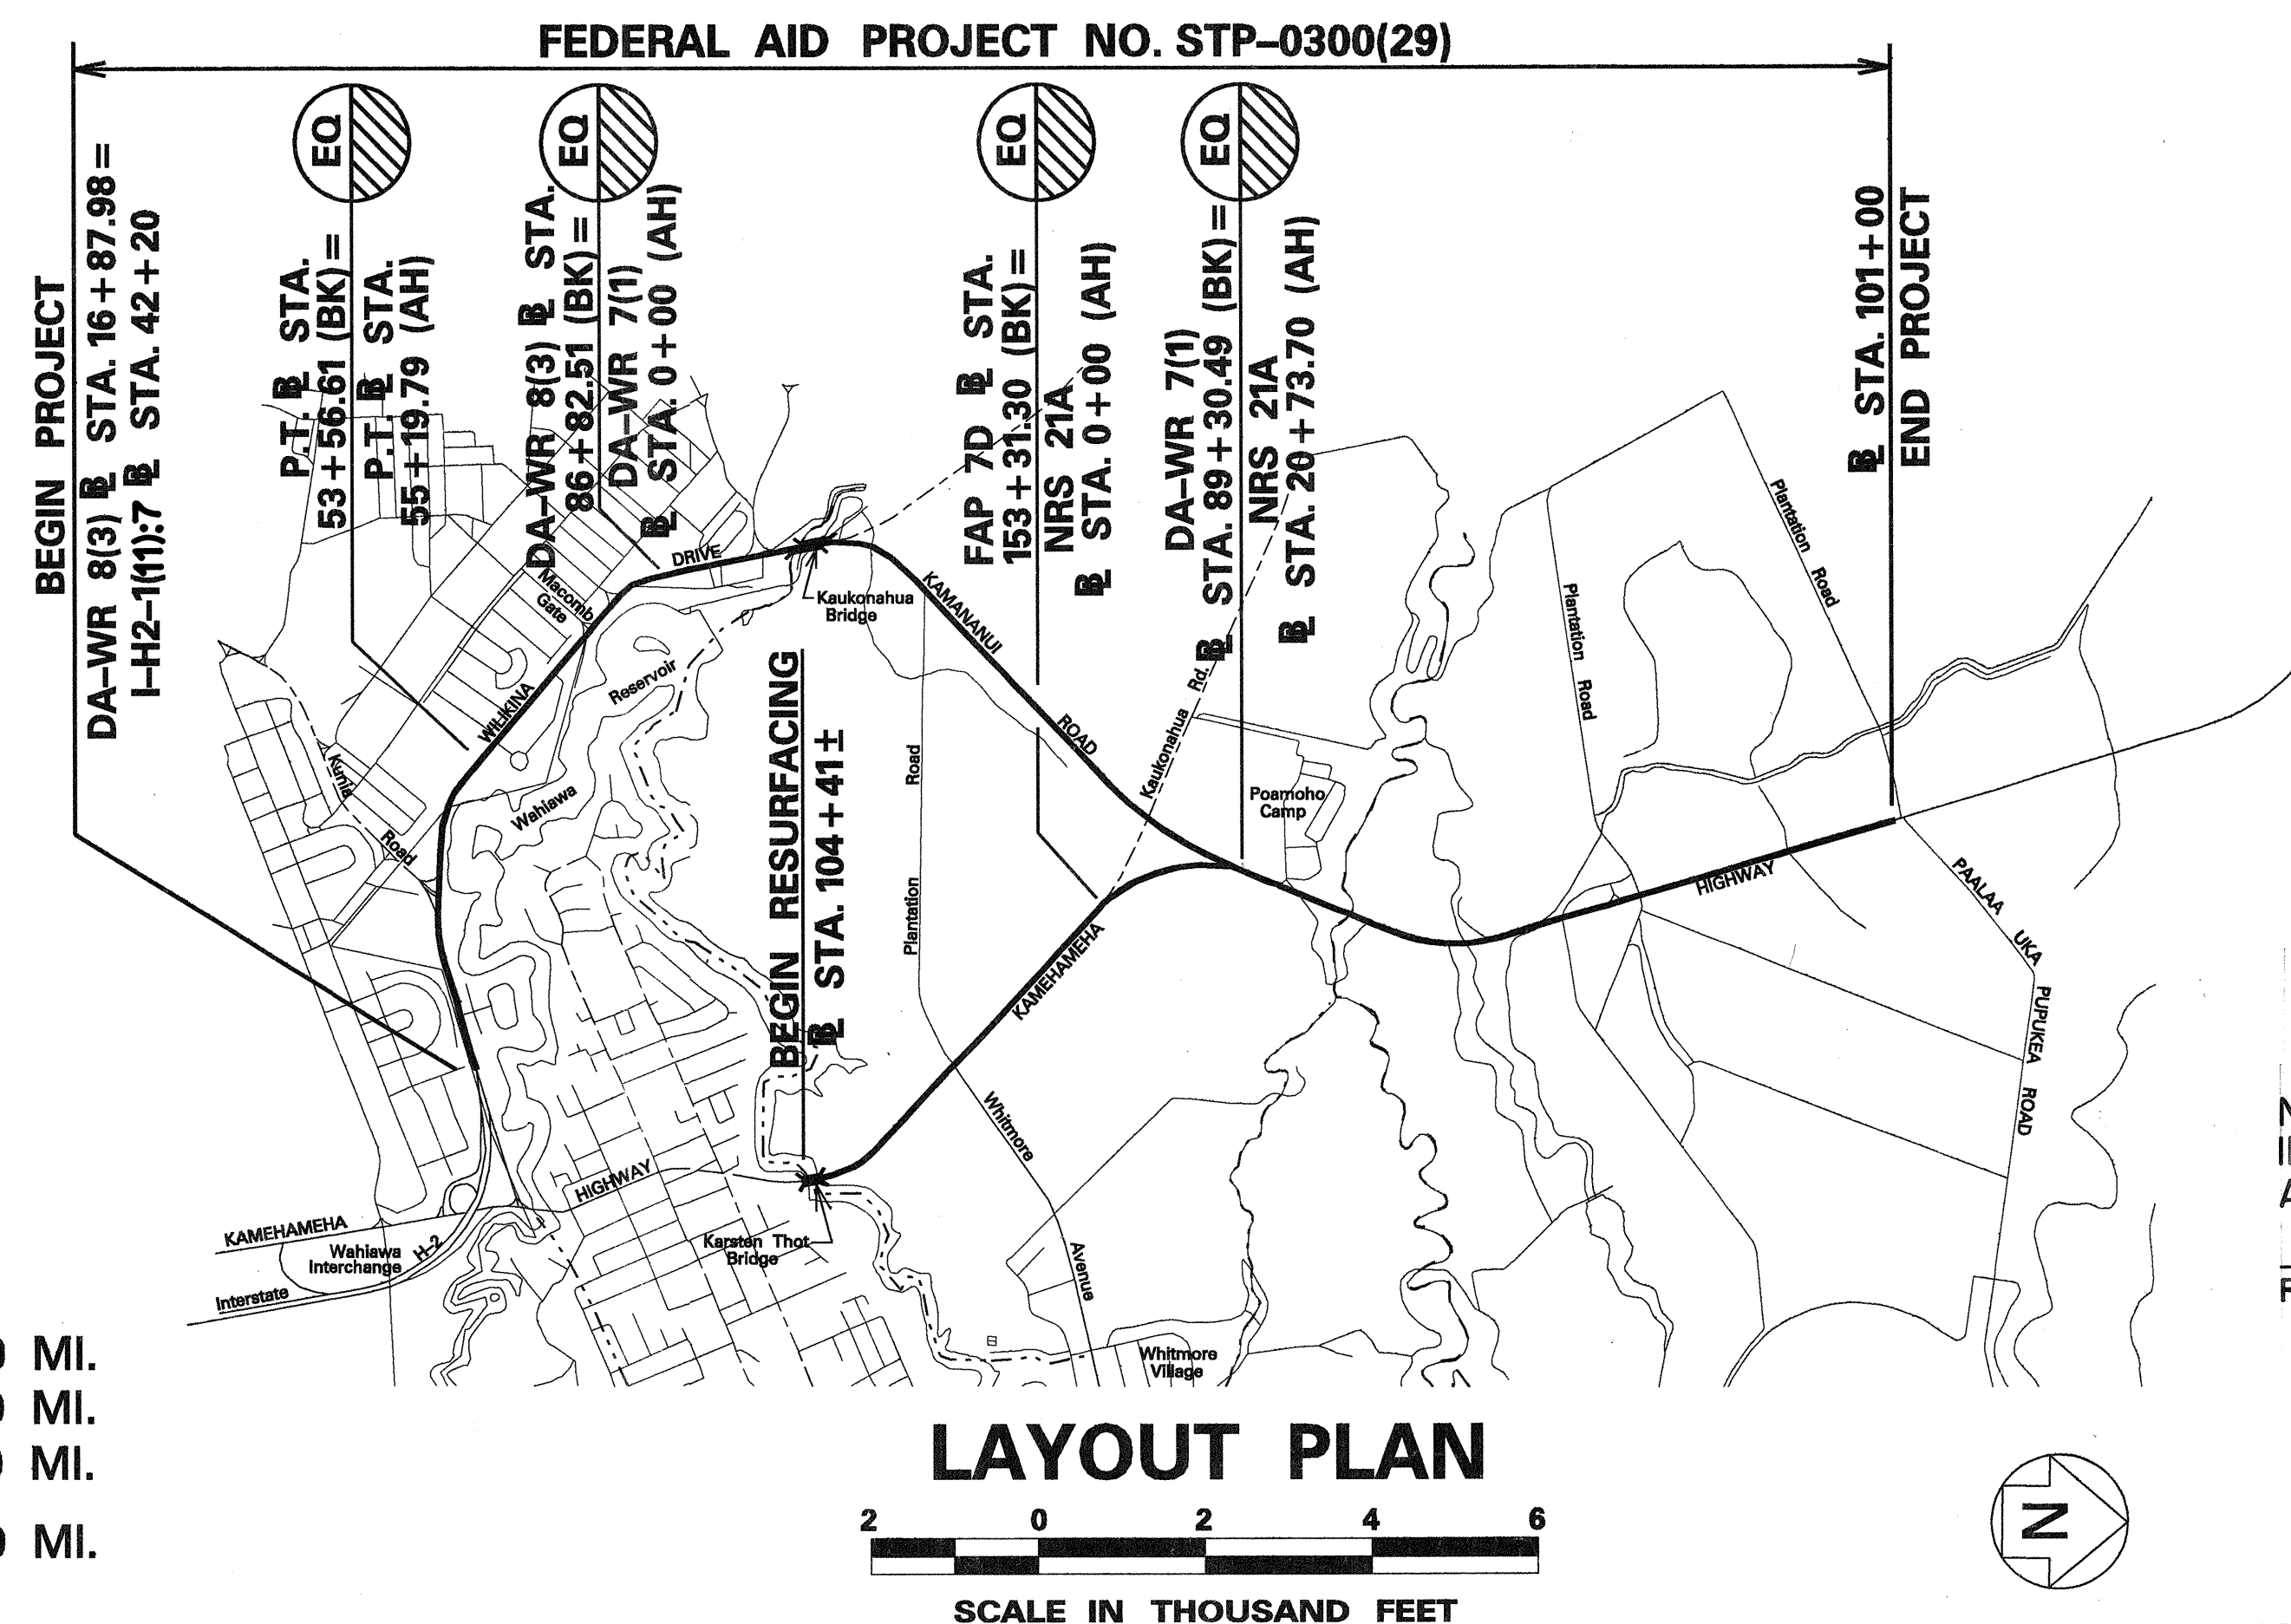

LENGTH OF PROJECT
WILIKINA DR. 1.80 MI.
KAMANANUI RD. 1.10 MI.
KAMEHAMEHA HWY. 2.90 MI.
TOTAL LENGTH 5.80 MI.

FED. ROAD DIST. NO.	STATE	FED. AID PROJ. NO.	FISCAL YEAR	SHEET NO.	TOTAL SHEETS
HAWAII	HAW.	STP-0300(29)	1993	1	49

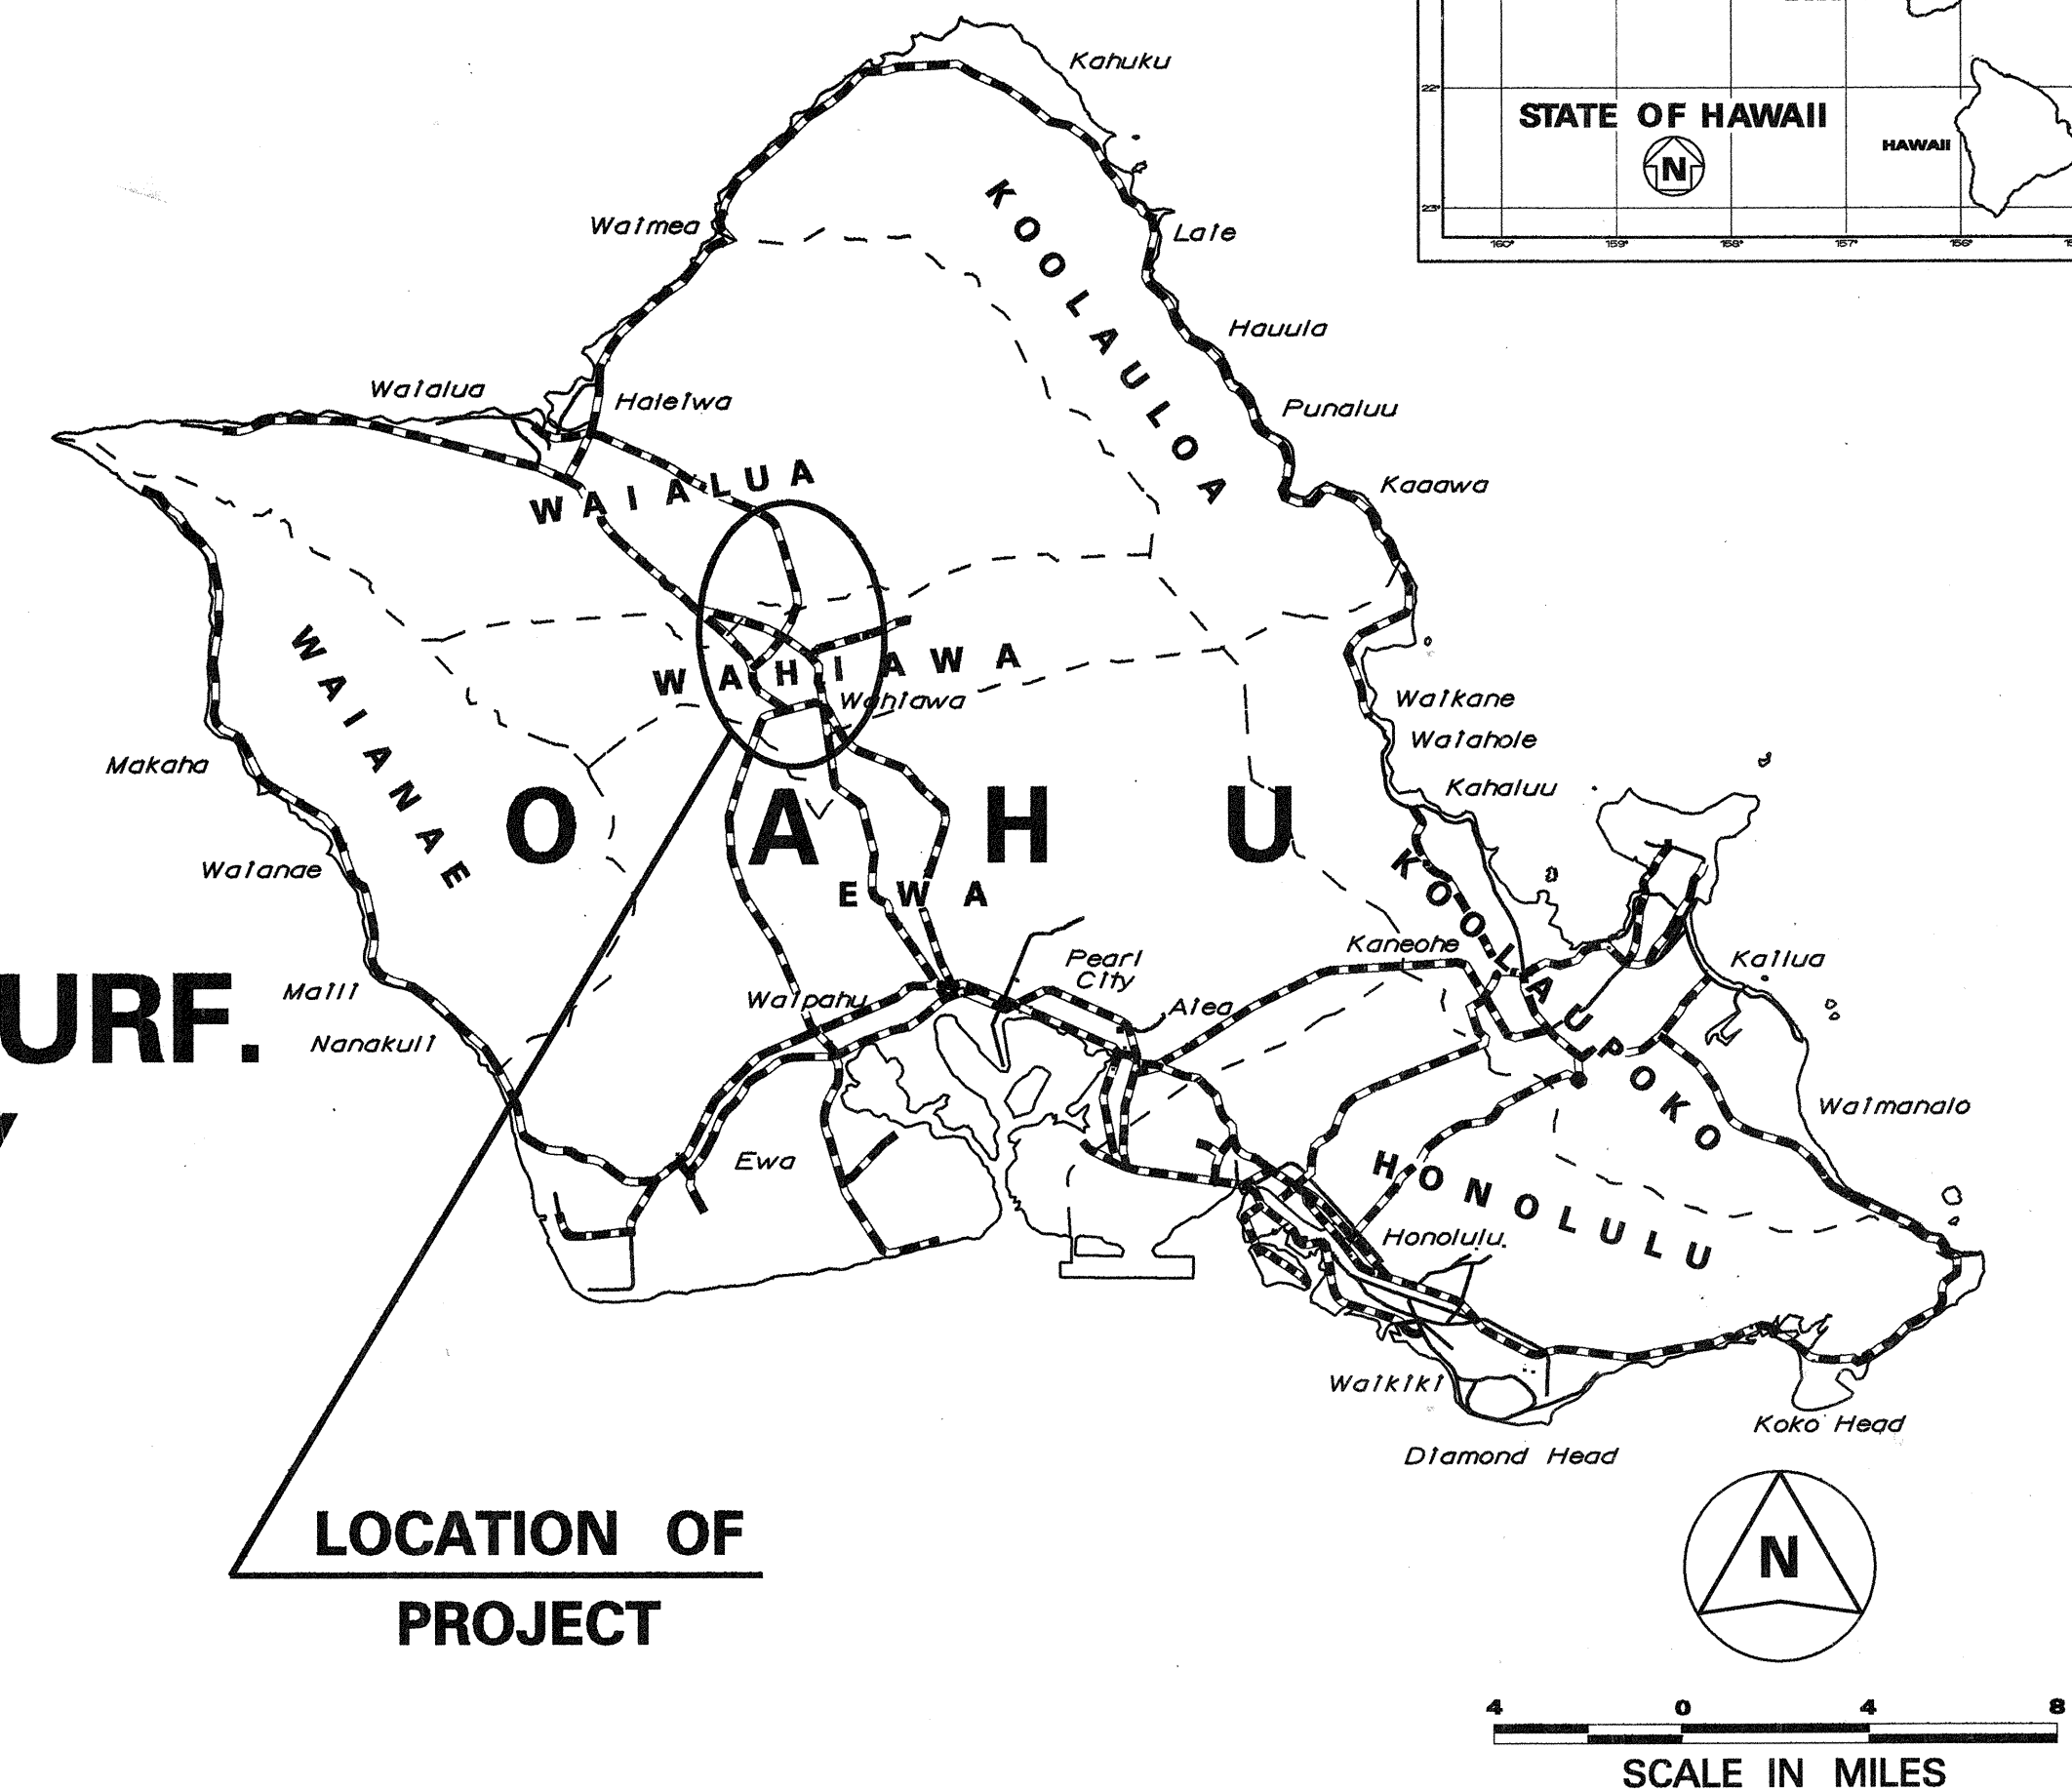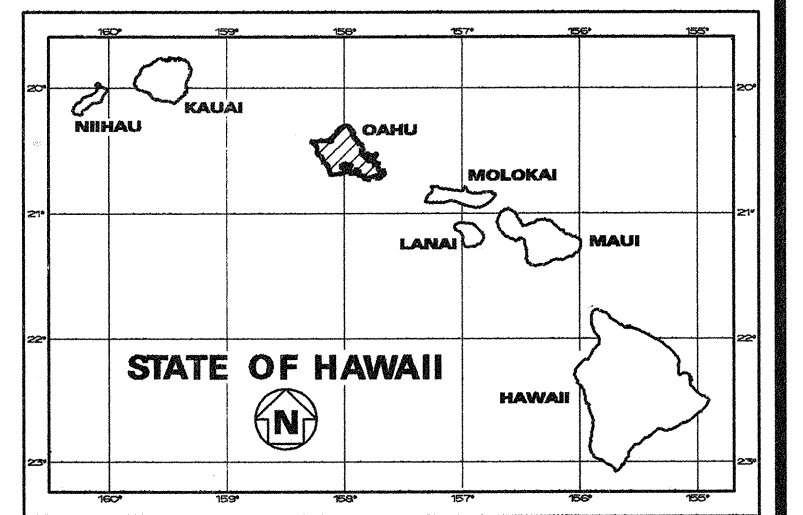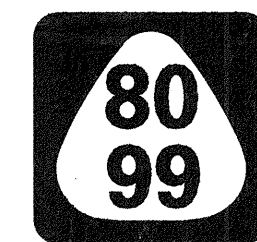

LOCATION OF PROJECT

--- FEDERAL AID PROJECTS PREVIOUSLY CONSTRUCTED OR UNDER CONSTRUCTION

ROUTE 80: MILE POST 0.67 TO MILE POST 1.93
ROUTE 99: MILE POST 4.99 TO MILE POST 9.53

DESIGN DESIGNATION

ADT (1992) 33,670
ADT (2002) 45,520
DHV 3,900
D 60/40
T 2.5%
T₂₄ 5.0%

NO SIGNIFICANT CHANGES WERE MADE DURING CONSTRUCTION ON THESE PLANS EXCEPT CHANGES IN THE ORIGINAL THEORETICAL QUANTITIES. FOR ACTUAL QUANTITIES, REFER TO PROJECT LEDGER AND OR COMPUTATION BOOK.

RESIDENT ENGINEER

DATE

DEPARTMENT OF TRANSPORTATION
FEDERAL HIGHWAY ADMINISTRATION

APPROVED:

for DIVISION ADMINISTRATOR

DATE

DEPARTMENT OF TRANSPORTATION
STATE OF HAWAII

APPROVED:

for DIR. OF TRANSPORTATION

DATE