


FED. ROAD DIST. NO.	STATE	PROJ. NO.	FISCAL YEAR	SHEET NO.	TOTAL SHEETS
HAWAII	HAW.	80A-01-02M	2003	7	15

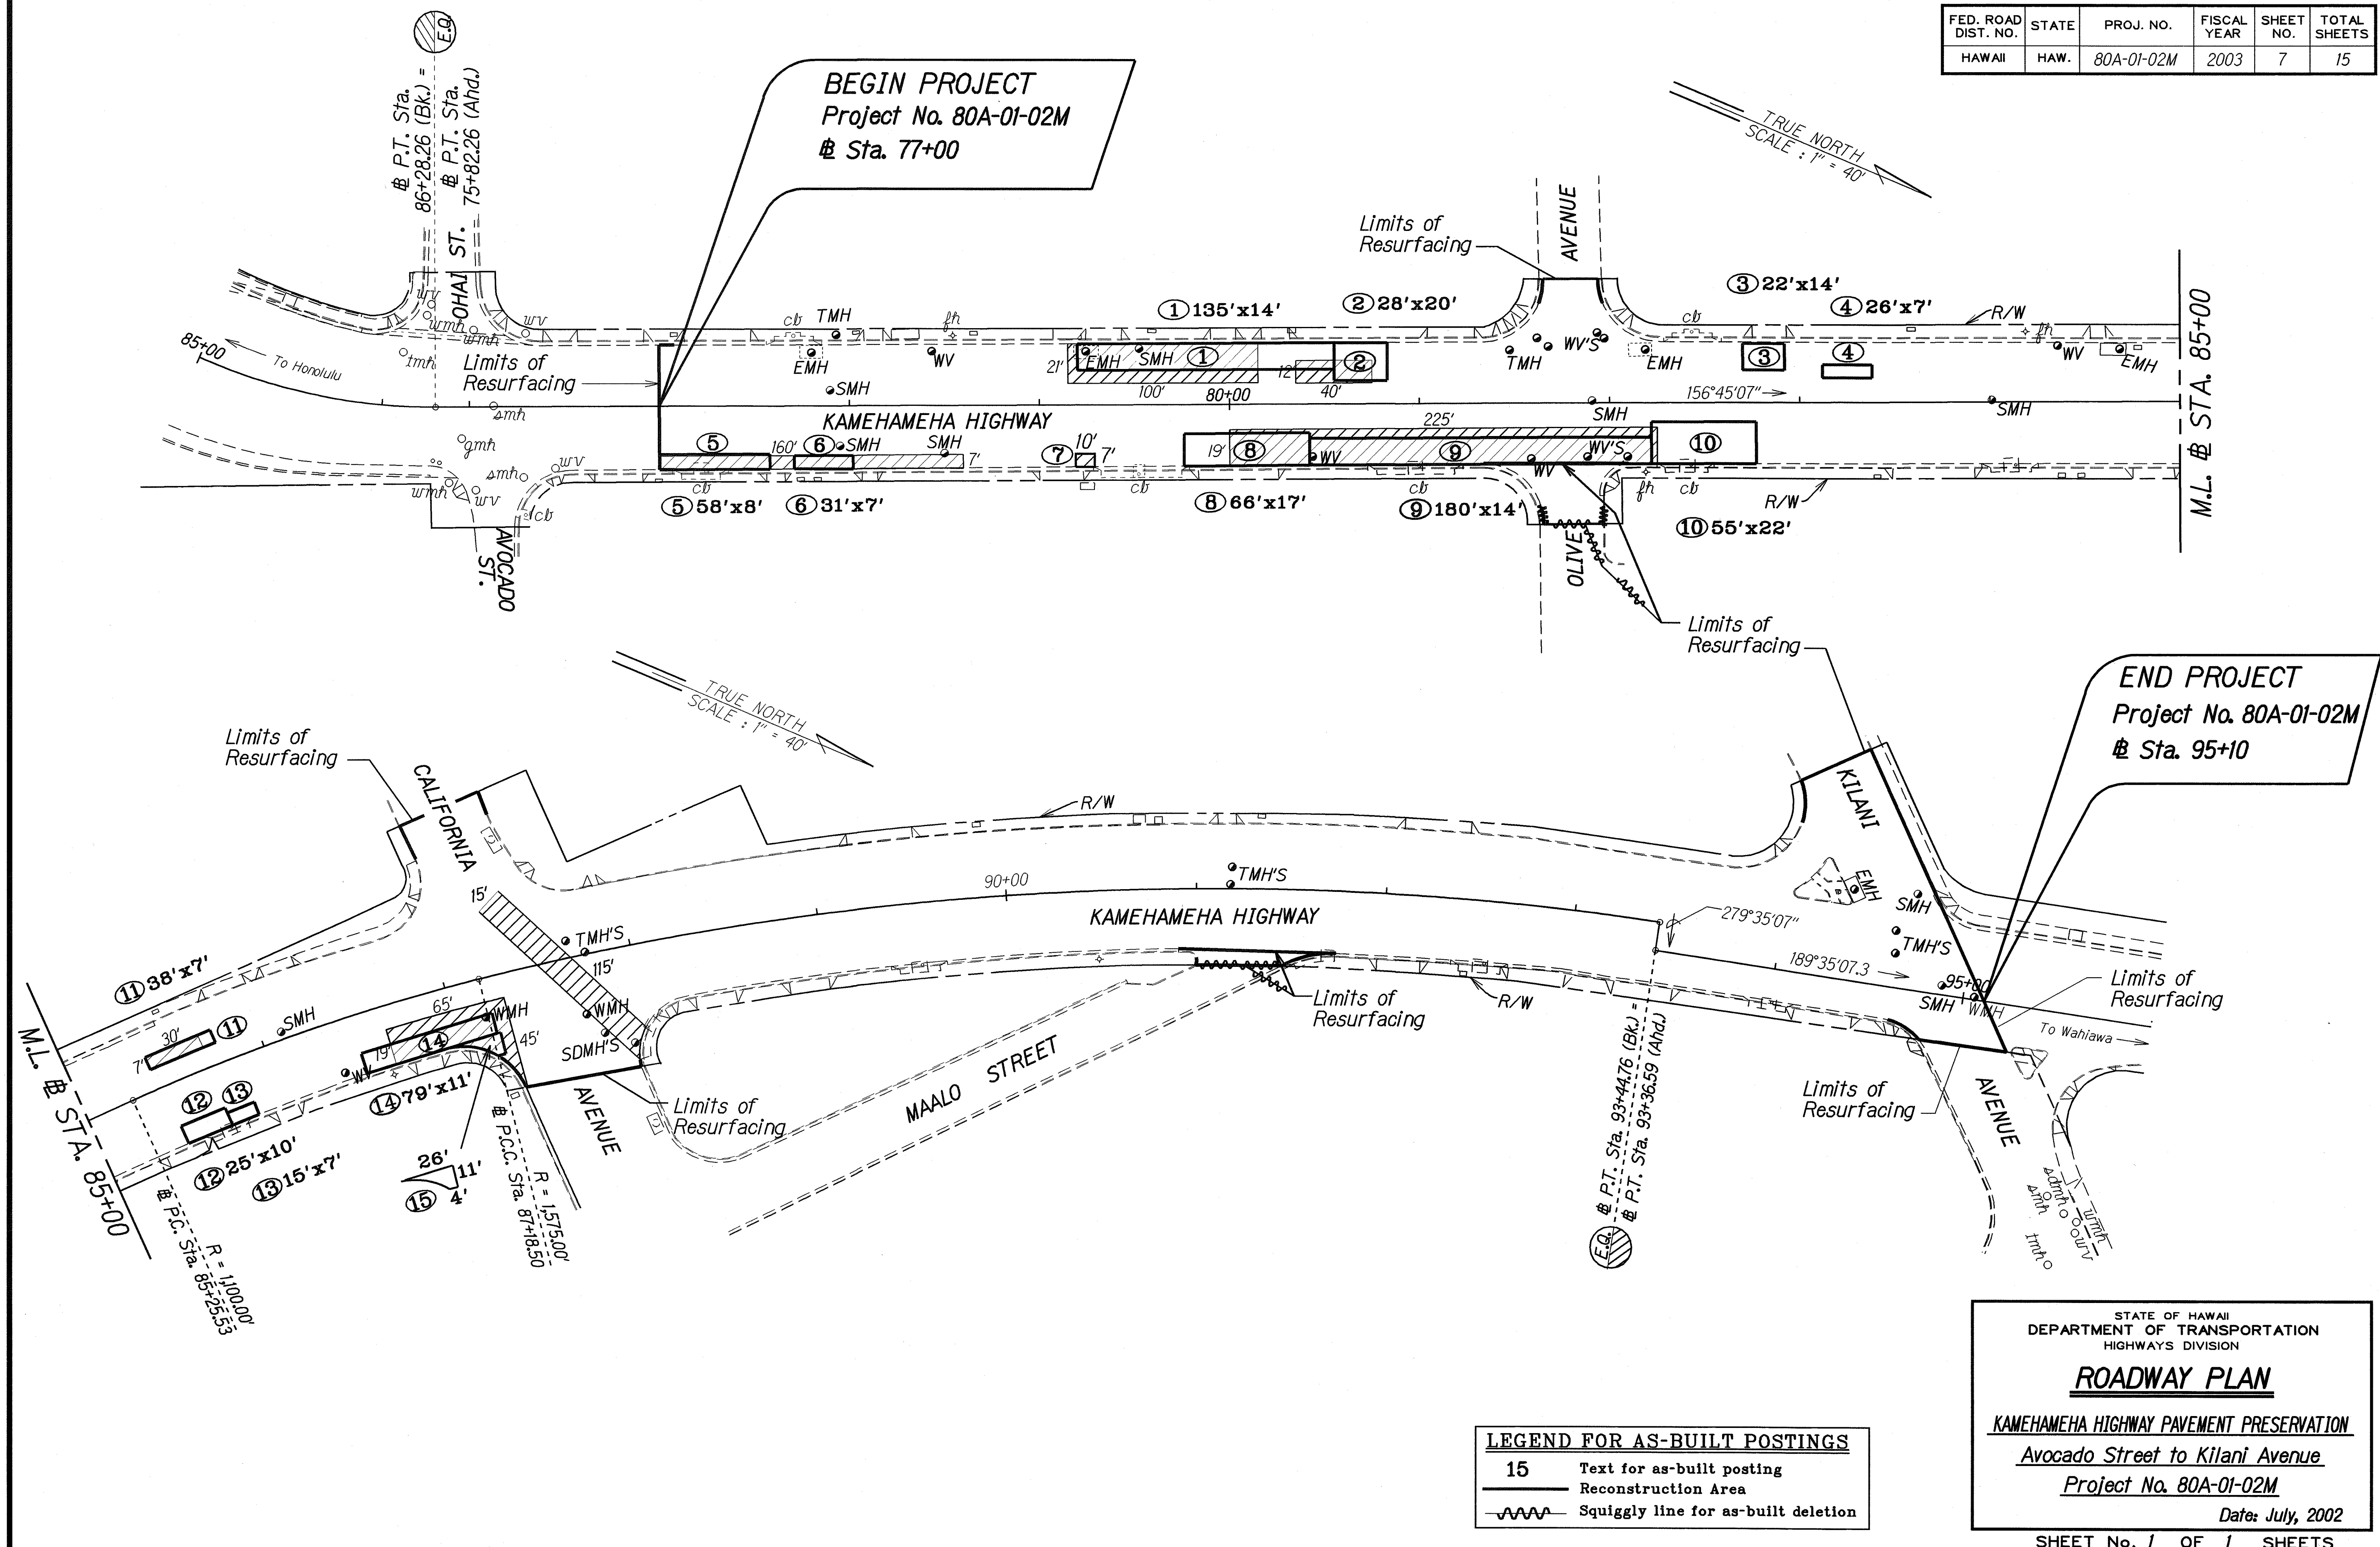

SURVEY PLOTTED BY	DATE
DRAWN BY	12-28-98
NOTE BOOK	
QUANTITIES BY	
CHECKED BY	

"AS-BUILT"