
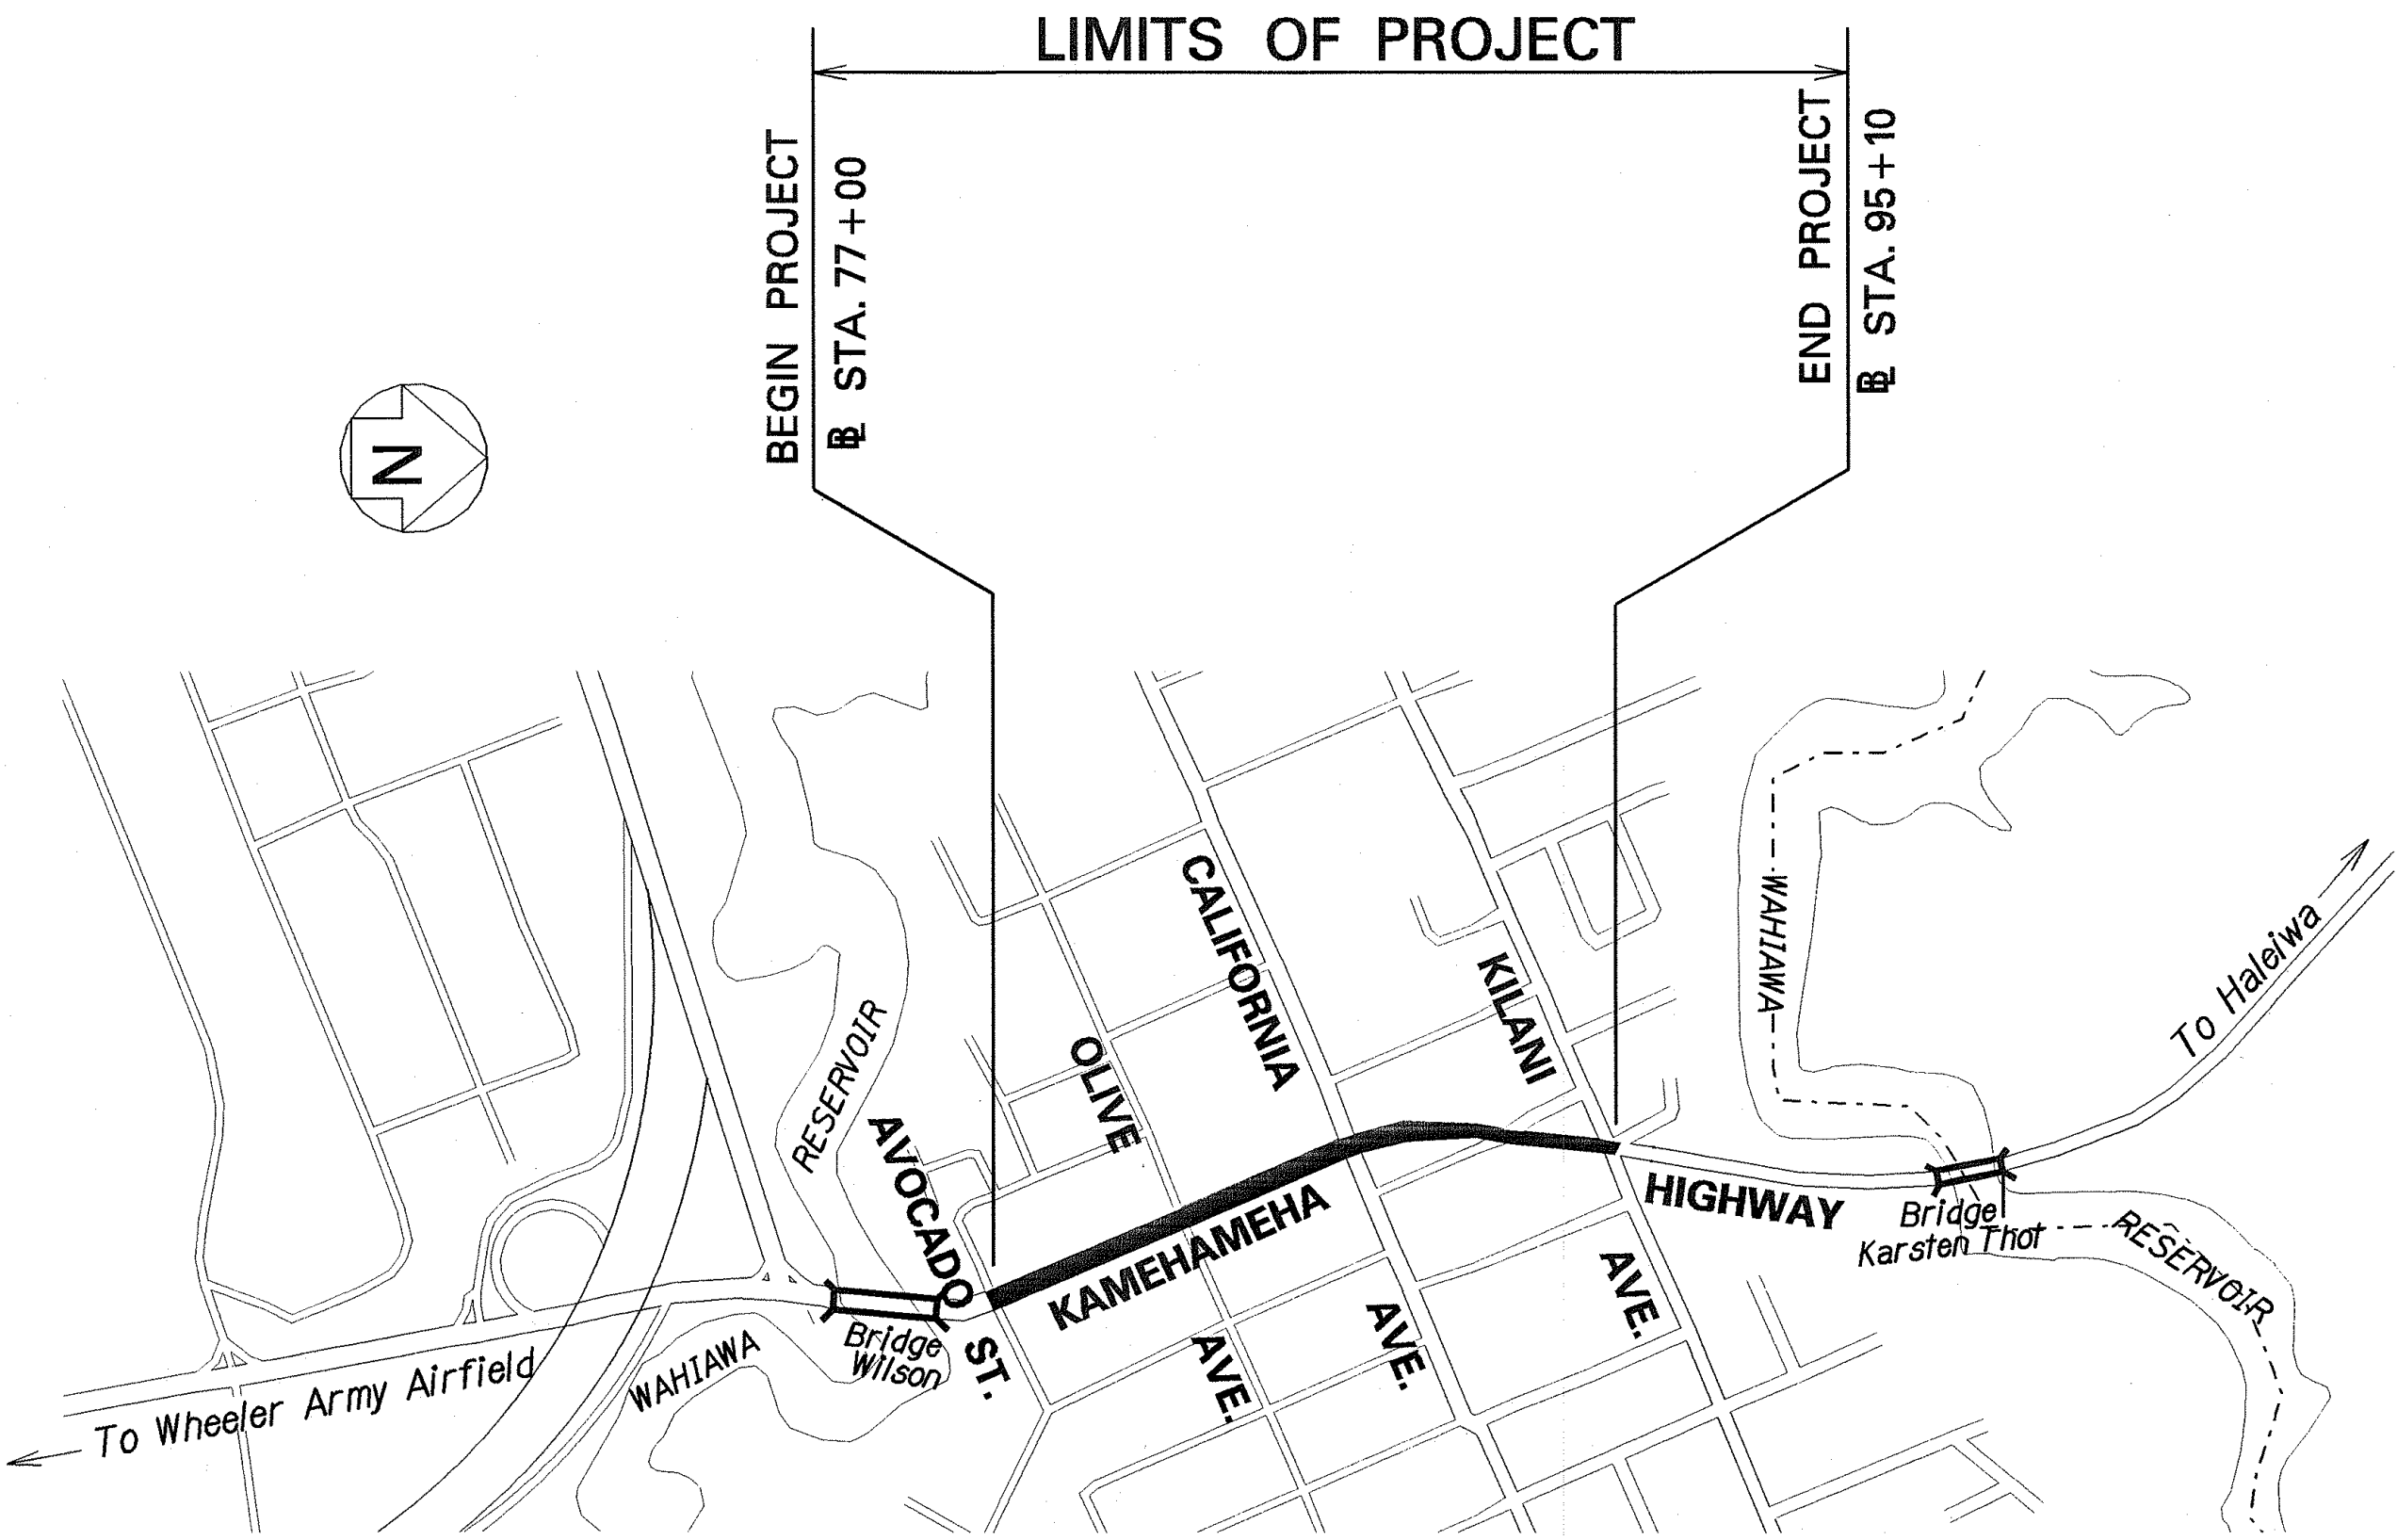


INDEX TO DRAWINGS	
SHEET NO.	DESCRIPTION
1	TITLE SHEET
2	STANDARD PLANS
3	GENERAL NOTES
4 - 5	WATER POLLUTION AND EROSION CONTROL NOTES
6	TYPICAL SECTION
7	ROADWAY PLAN
8	TRAFFIC LEGENDS, DETAILS & NOTES
9-10	PAVEMENT MARKING & SIGNING PLAN
11	SIGN DETAILS
12	TRAFFIC SUMMARIES
13-14	TRAFFIC SIGNAL PLAN
15	LOOP DETECTORS

STATE OF HAWAII
DEPARTMENT OF TRANSPORTATION
HIGHWAYS DIVISION
HONOLULU, HAWAII
"AS-BUILT"
PLANS FOR
KAMEHAMEHA HIGHWAY
PAVEMENT PRESERVATION
AVOCADO STREET TO KILANI AVENUE
PROJECT NO. 80A-01-02M
DISTRICT OF WAHIAWA
ISLAND OF OAHU

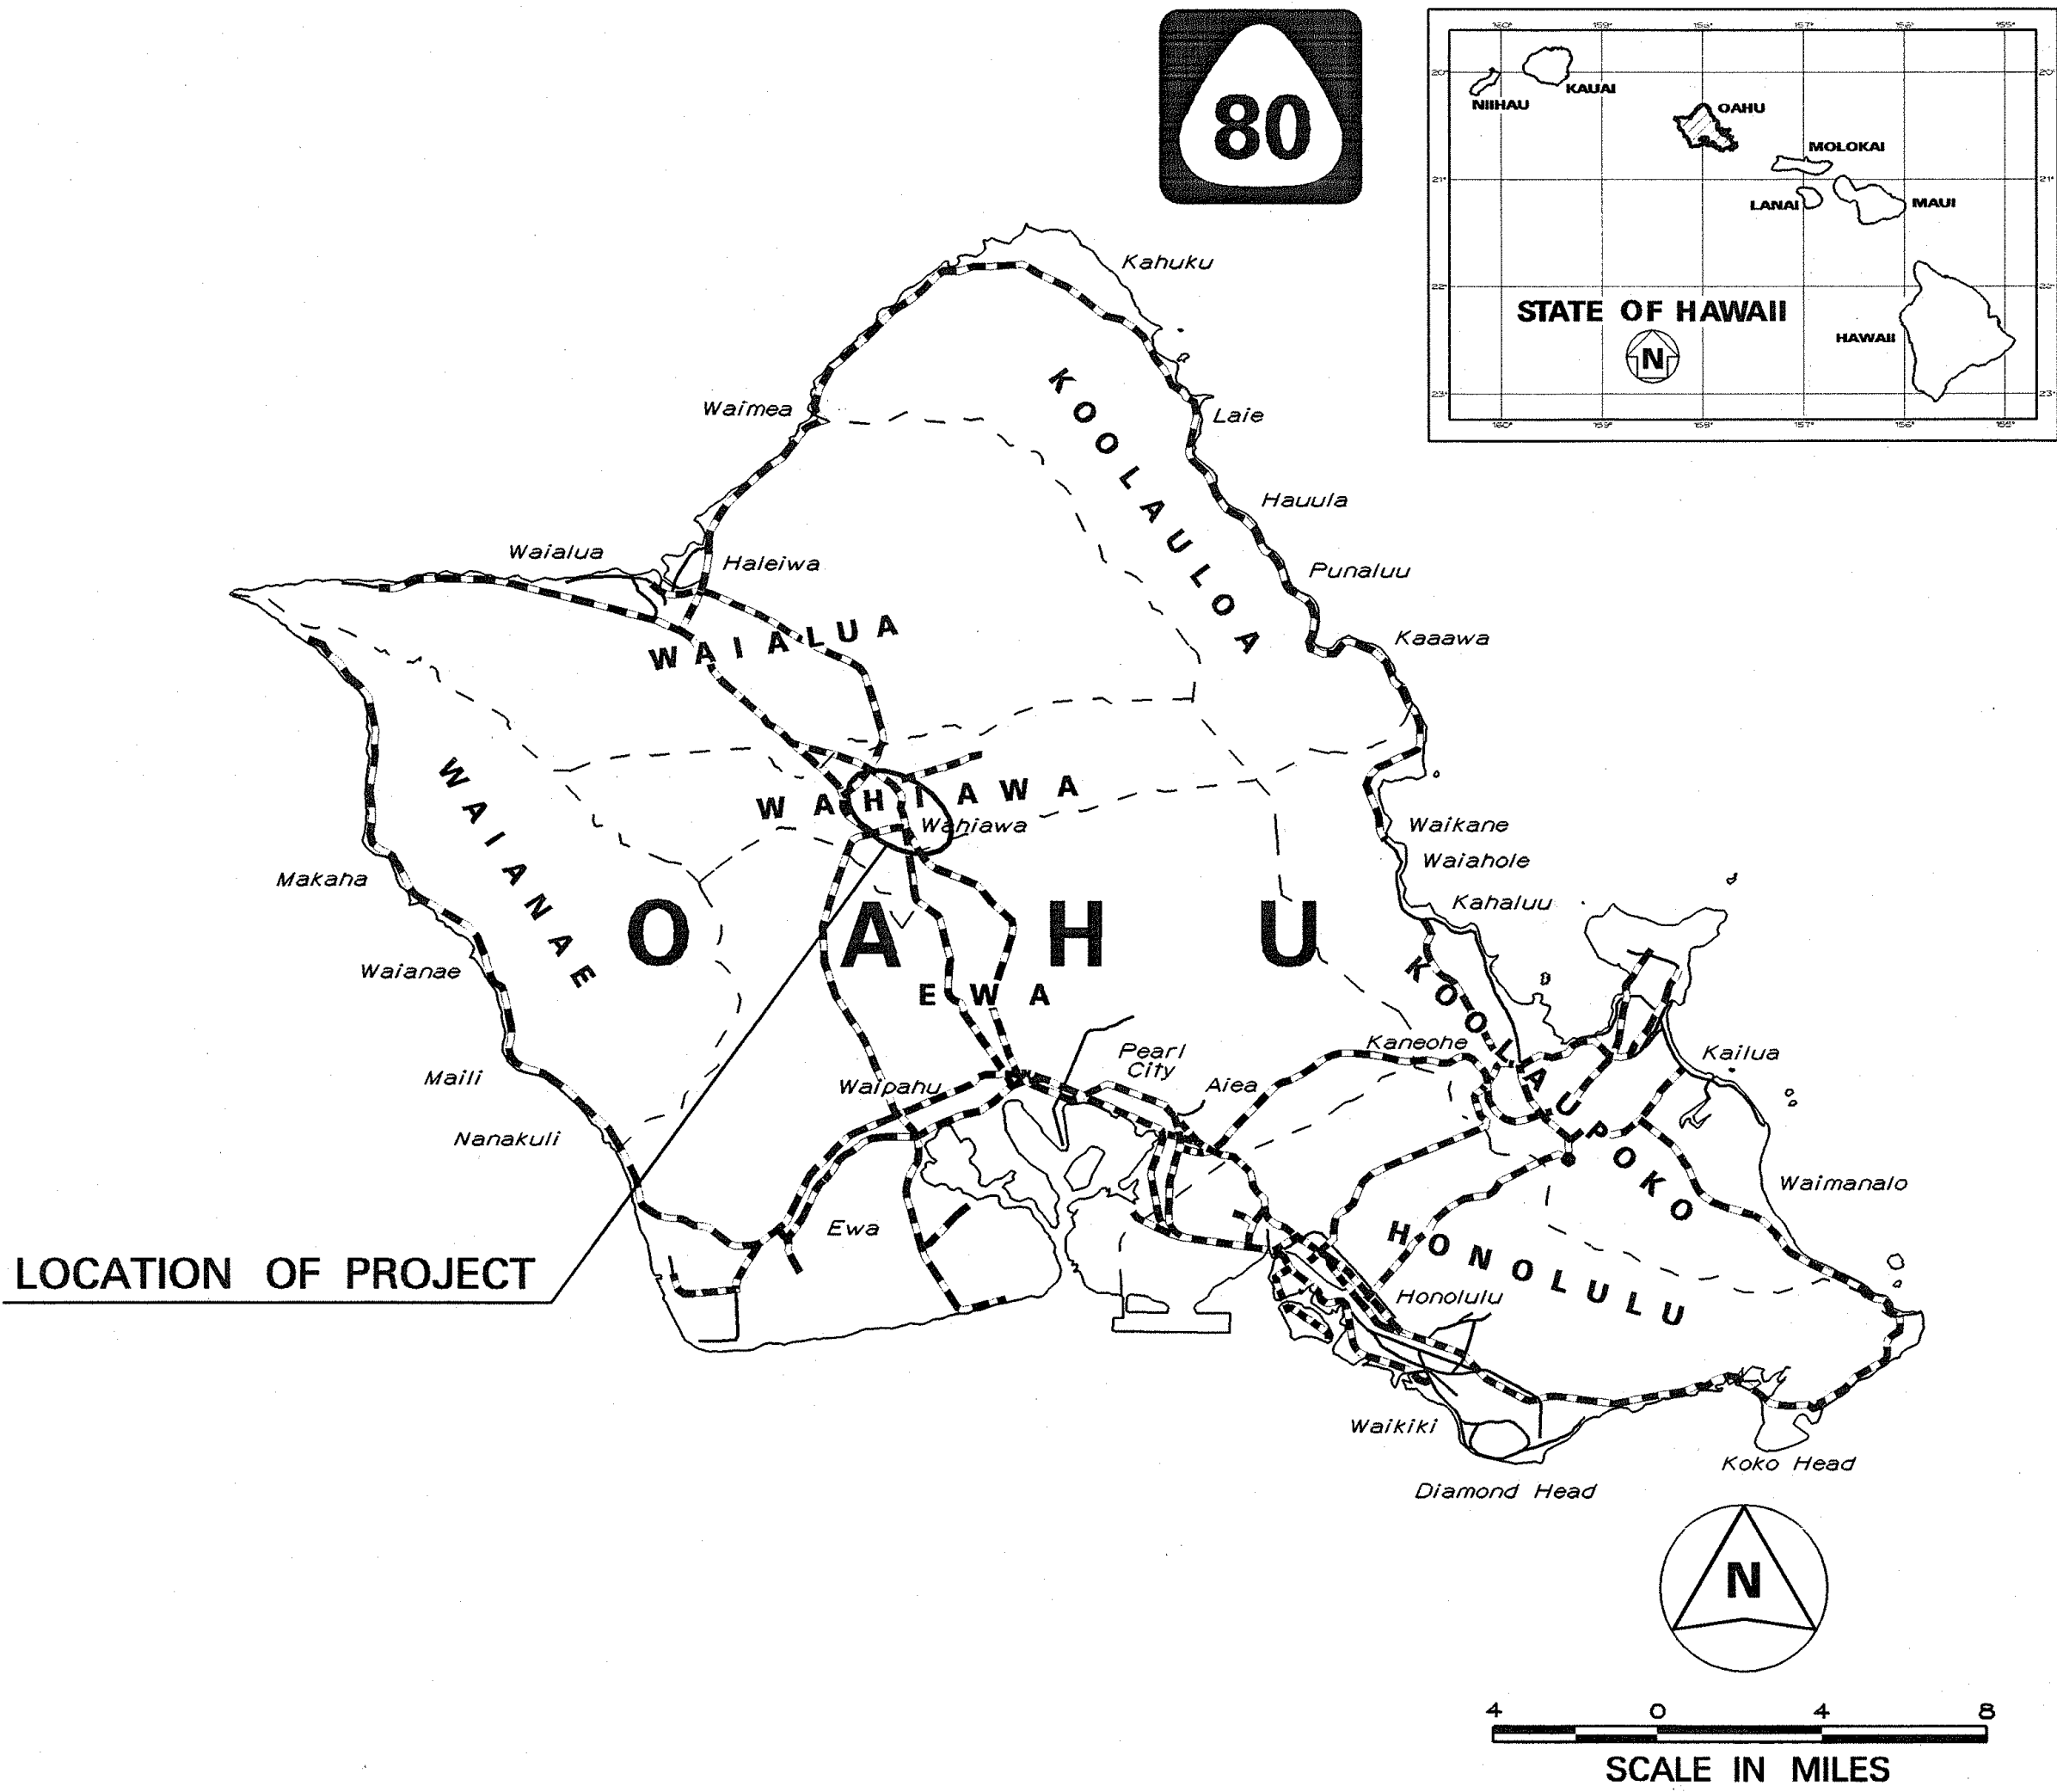

----- FEDERAL AID INTERSTATE PROJECTS PREVIOUSLY
CONSTRUCTED OR UNDER CONSTRUCTION

DESIGN DESIGNATION	MILE POST 0.11 TO MILE POST 0.45	
	AVOCADO STREET TO CALIFORNIA AVENUE	CALIFORNIA AVENUE TO KILANI AVENUE
ADT (2002)	45,000	22,700
ADT (2023)	51,700	26,100
DHV	3,880	2,090
D	55/45	55/45
T	1.5 %	1.5 %
T ₂₄	2.5 %	2.5 %
V	25 M.P.H.	25 M.P.H.

CHANGES MADE DURING CONSTRUCTION HAVE BEEN
INCORPORATED ON THESE PLANS EXCEPT CHANGES
IN THE ORIGINAL THEORETICAL QUANTITIES. FOR
ACTUAL QUANTITIES, REFER TO PROJECT LEDGER
AND/OR COMPUTATION BOOK.

RESIDENT ENGINEER

DATE

DEPARTMENT OF TRANSPORTATION
STATE OF HAWAII

APPROVED:

2-7-03
DIR. OF TRANSPORTATION DATE

HWY-DD
DESIGNED BY
S. HIRAOKA
P. S. & E. BY
692-7581
PHONE
JULY, 2002
DATE

5 0 5 10 15
SCALE IN HUNDRED FEET

LAYOUT PLAN

GROSS LENGTH OF PROJECT..... 0.34 MILES