



FED. ROAD DIST. NO.	STATE	PROJ. NO.	FISCAL YEAR	SHEET NO.	TOTAL SHEETS
HAWAII	HAW.	80A-01-02M	2003	6	15

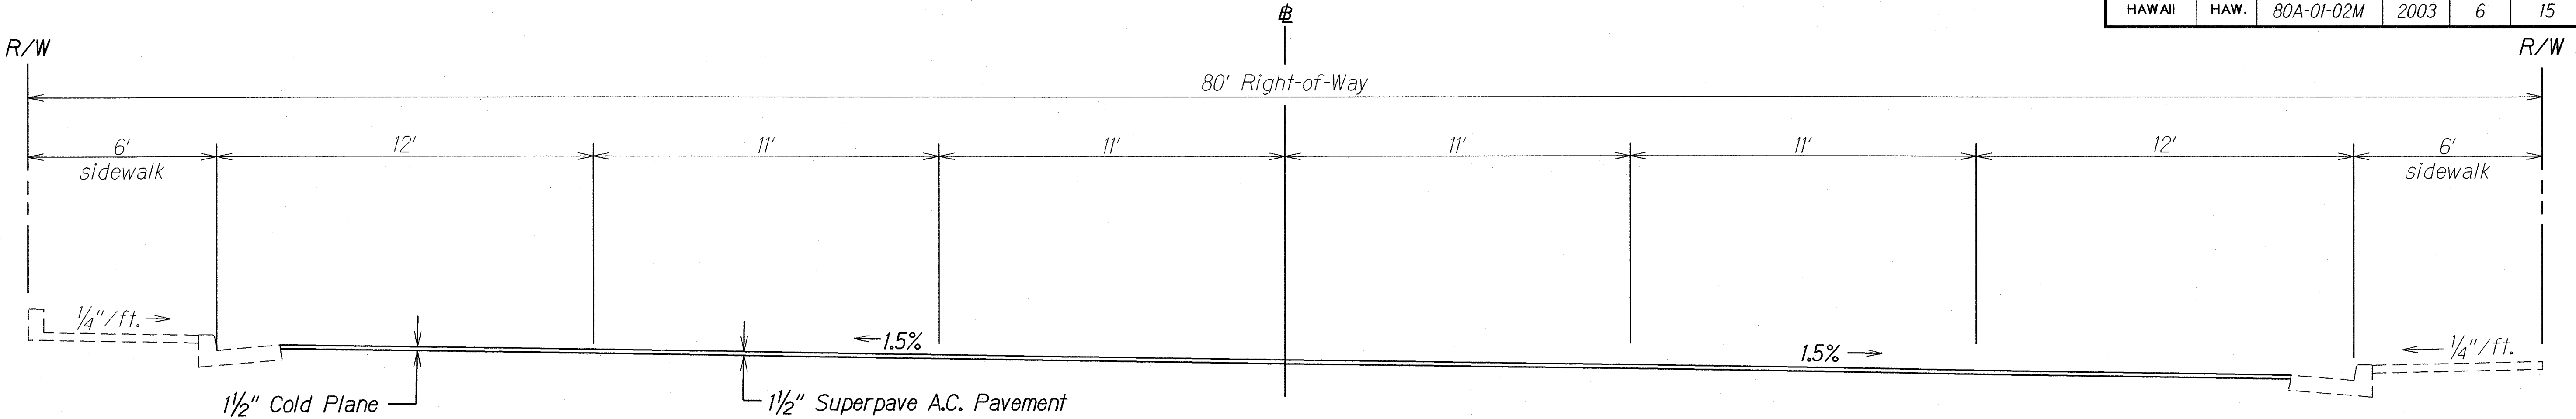


TYPICAL SECTION
AVOCADO STREET / OHAI STREET TO CALIFORNIA AVENUE
STA. 77+00.00 to # STA. 85+51.53

Scale: 3/8"=1'-0"

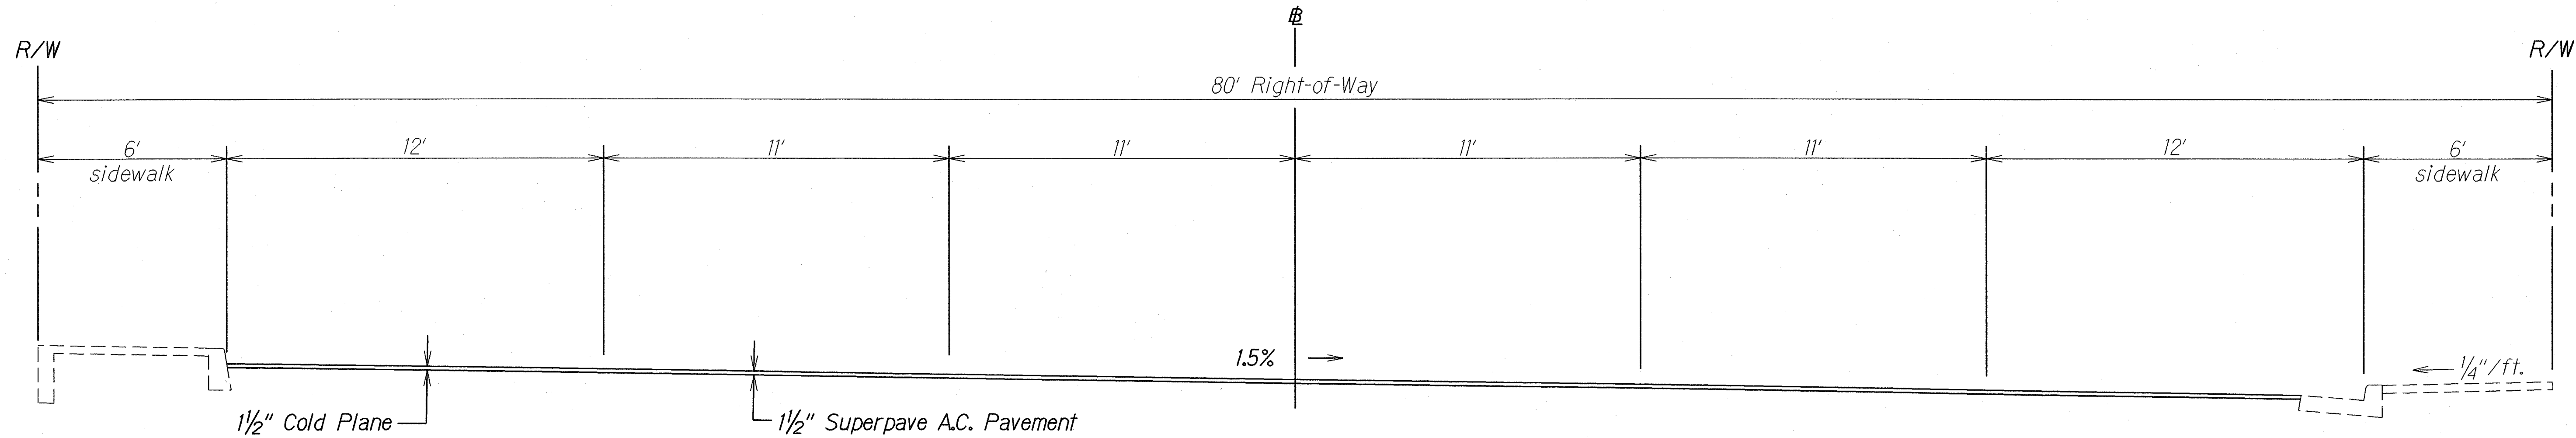

TYPICAL SECTION
CALIFORNIA AVENUE to KILANI AVENUE
STA. 85+51.53 to # STA. 95+10.00

Scale: 3/8"=1'-0"

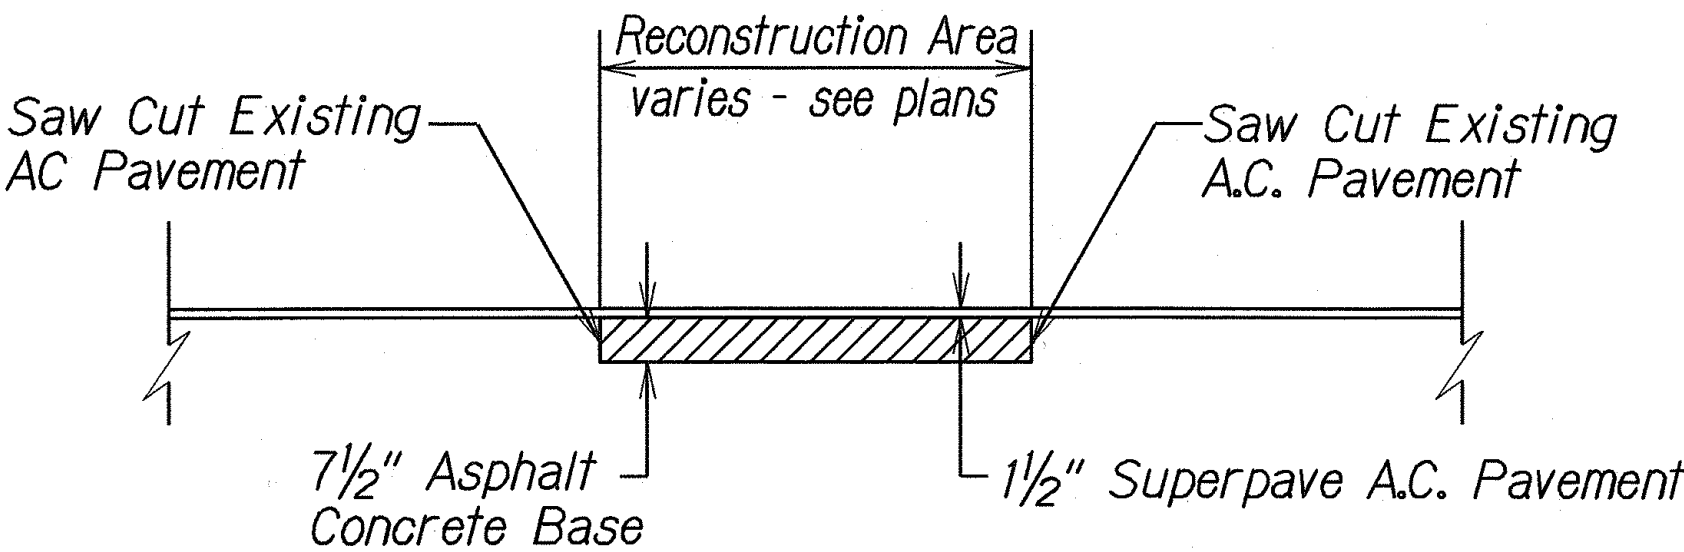

TYPICAL RECONSTRUCTION AREA
Scale: 3/8"=1'-0"

STATE OF HAWAII
DEPARTMENT OF TRANSPORTATION
HIGHWAYS DIVISION

TYPICAL SECTIONS

KAMEHAMEHA HIGHWAY PAVEMENT PRESERVATION

Avocado Street to Kilani Avenue

Project No. 80A-01-02M

Scale: As Shown Date: July, 2002

SHEET No. 1 OF 1 SHEETS