


| FED. ROAD<br>DIST. NO. | STATE | PROJ. NO.   | FISCAL<br>YEAR | SHEET<br>NO. | TOTAL<br>SHEETS |
|------------------------|-------|-------------|----------------|--------------|-----------------|
| HAWAII                 | HAW.  | HWY-0-07-91 | 1991           | 4            | 5               |

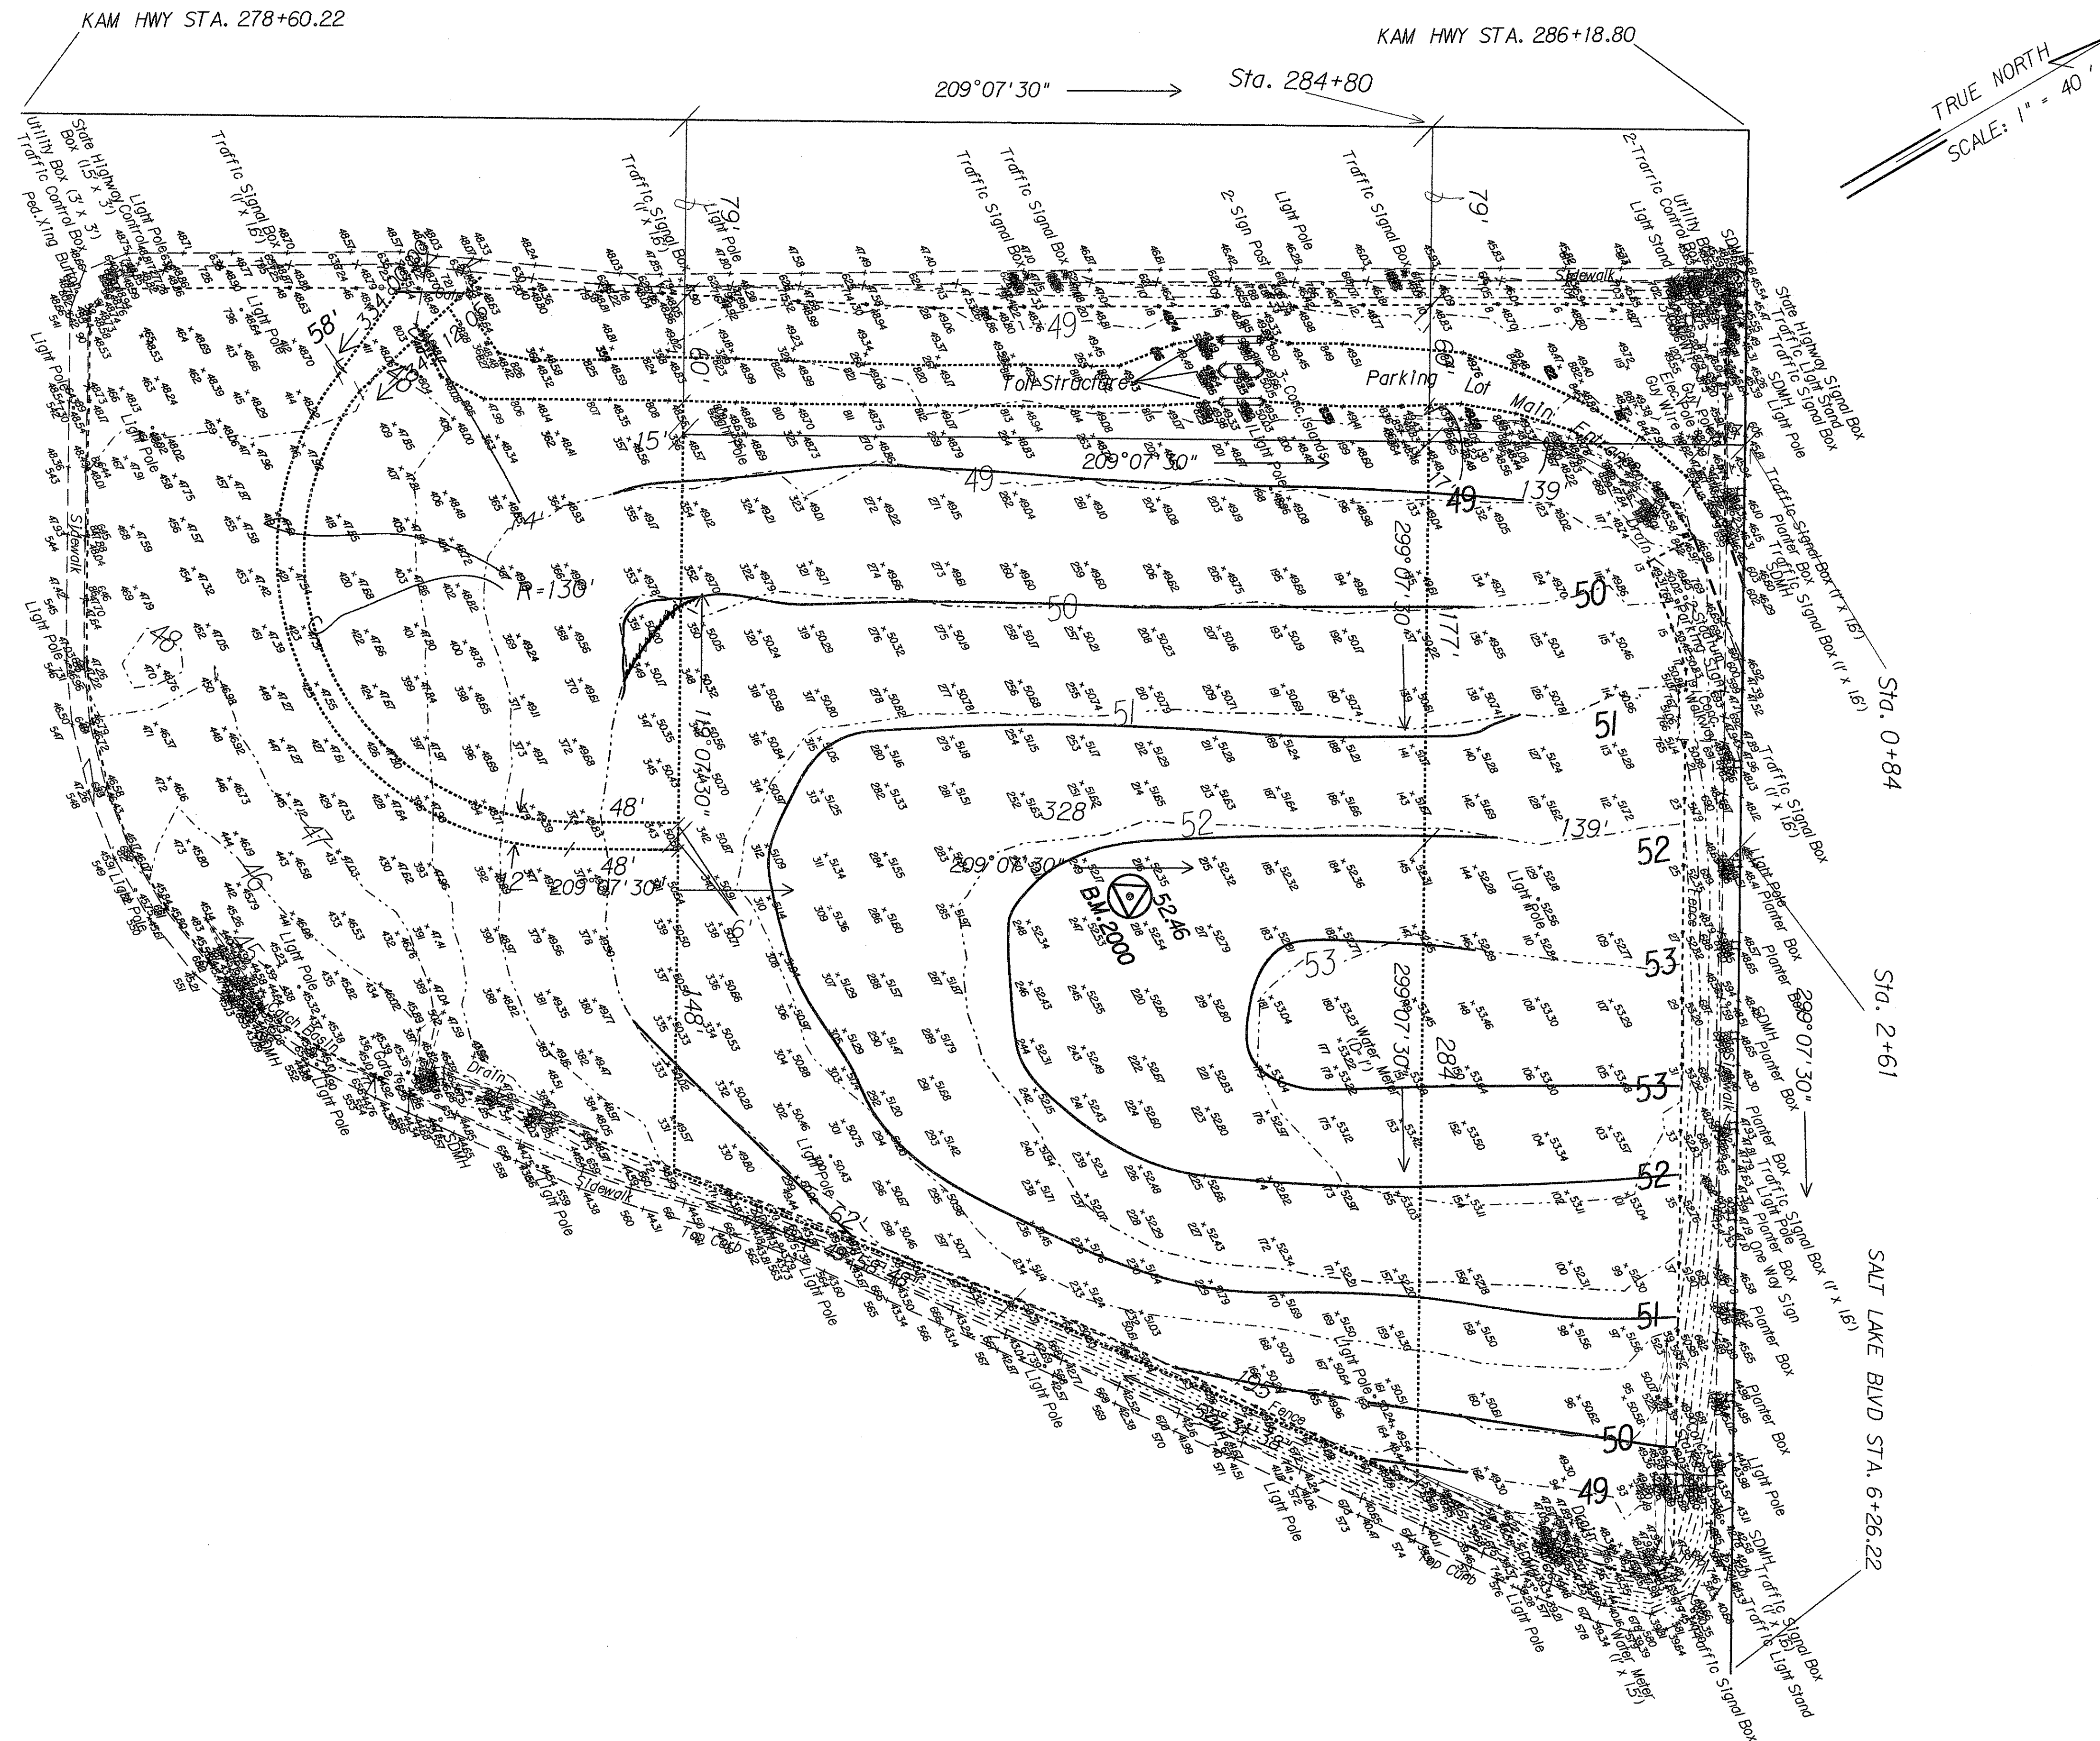

*LEGEND*

*Finish Grade Contour*

Existing Grade Contour

APPROVED :

K. Syab 5/7/91  
Stadium Authority Date

STATE OF HAWAII  
DEPARTMENT OF TRANSPORTATION  
HIGHWAYS DIVISION

## GRADING PLAN

MVSO TEST SITE AT  
ALOHA STADIUM PARKING LOT  
Project No. HWY-0-07-91

Scale: 1" = 40'

Date: May, 1991

SHEET No. 1 OF 1 SHEETS

## "AS-BUILT"

4

|                  |                                    |
|------------------|------------------------------------|
| ORIGINAL<br>PLAN | SURVEY PLOTTED BY _____ DATE _____ |
| NOTE BOOK        | DRAWN BY _____                     |
|                  | TRACED BY _____                    |
|                  | DESIGNED BY _____                  |
|                  | QUANTITIES BY _____                |
| No. _____        | CHECKED BY _____                   |