	INDEX TO DRAWINGS
SHEET NO.	DESCRIPTION
1	TITLE SHEET
2	STANDARD PLANS SUMMARY SHEET
3	TYPICAL SECTIONS AND GENERAL NOTES
4	GRADING PLAN
5	PARKING LOT PLAN
	·
A A A A A A A A A A A A A A A A A A A	

STATE OF HAWAII

DEPARTMENT OF TRANSPORTATION


HIGHWAYS DIVISION
HONOLULU, HAWAII
"AS-BUILT"


PLANS FOR


MVSO TEST SITE AT ALOHA STADIUM PARKING LOT


PROJECT NO. HWY-0-07-91


DISTRICT OF EWA
ISLAND OF OAHU

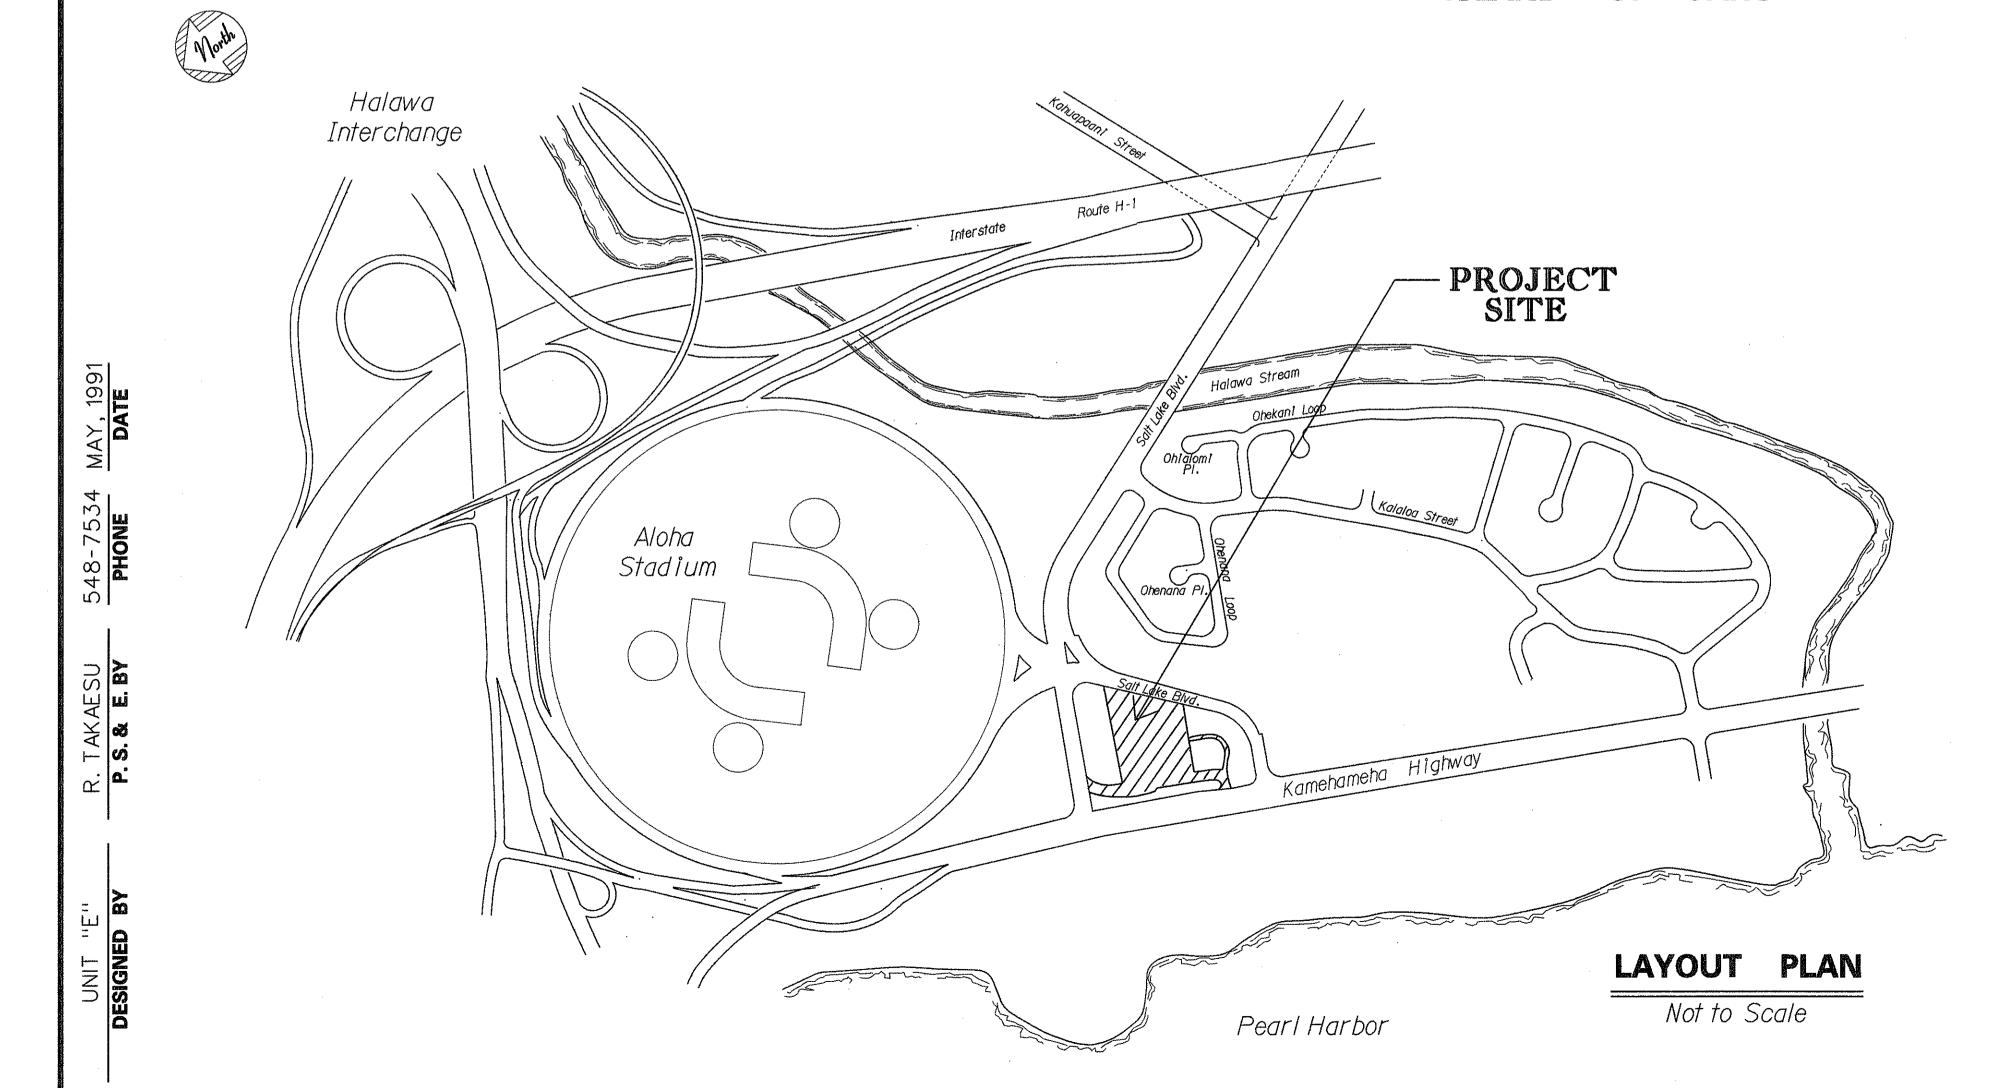

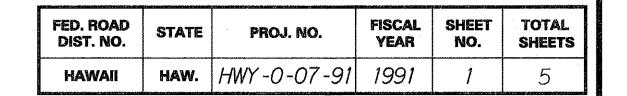

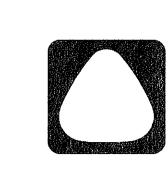

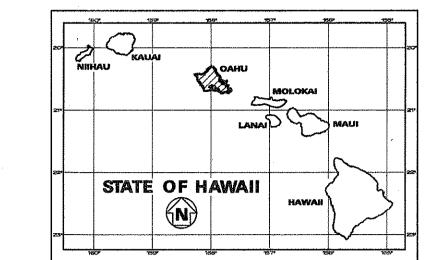

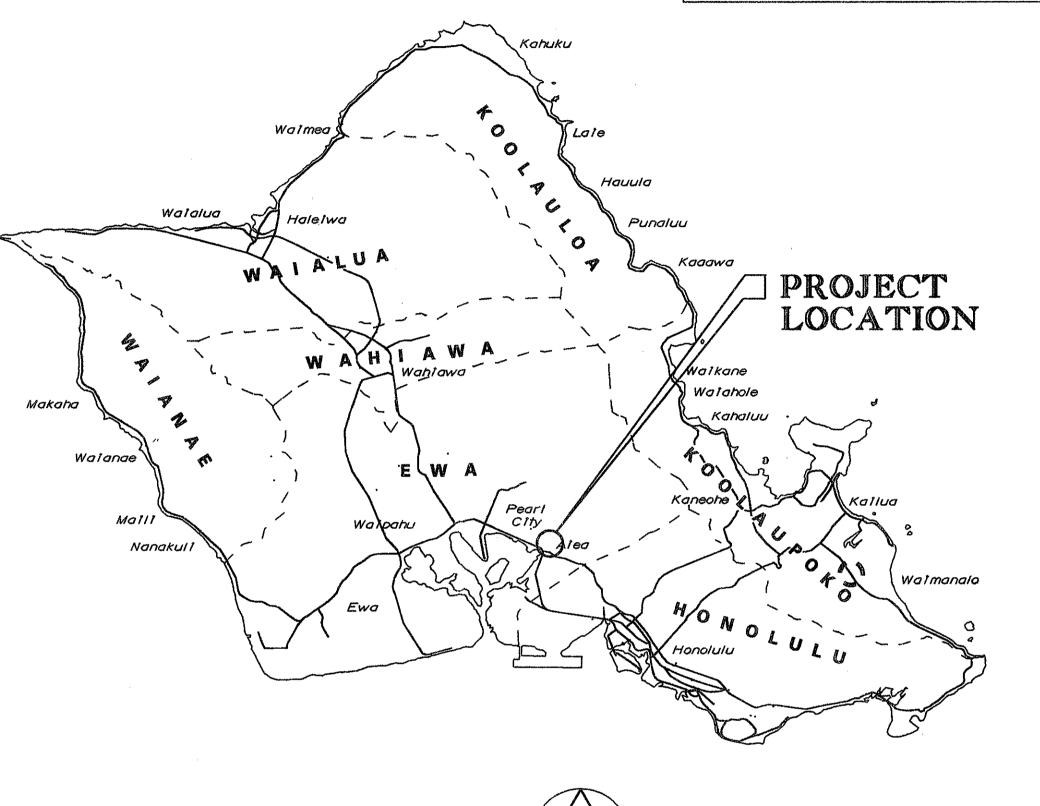

CHANGES MADE DURING CONSTRUCTION HAVE BEEN INCORPORATED ON THESE PLANS EXCEPT CHANGES IN THE ORIGINAL THEORETICAL QUANTITIES. FOR ACTUAL QUANTITIES, REFER TO PROJECT LEDGER AND/OR COMPUTATION BOOK.

SCALE IN MILES

RESIDENT ENGINEER

10/17/00 DATE

DEPARTMENT OF TRANSPORTATION
STATE OF HAWAII

APPROVED:

DIR. OF TRANSPORTATION

DATE