



FED. ROAD DIST. NO.	STATE	PROJ. NO.	FISCAL YEAR	SHEET NO.	TOTAL SHEETS
HAWAII	HAW.	HWY-0-07-91	1991	3	5

**GENERAL NOTES:**

1. Scope of Work: Grading and paving, and constructing a reinforced concrete driveway, for the MVS0 Test Site at the Aloha Stadium Parking Lot.
2. The Contractor shall contact the Stadium Authority Engineer (Mr. Cal Nekoniishi) at 486-9529 at least ten (10) days before work is to begin.
3. The Contractor shall be held liable for any damages incurred to existing utility facilities as a result of his operations. All damages shall be repaired and/or replaced immediately in accordance with the Standards and Specifications of the State and/or the affected Utility Company.
4. The Contractor shall grade the existing ground to the finish grade, including excavating, reshaping, and compacting, as shown on the attached Grading Plan. This work shall meet the requirements of Section 203 - Excavation and Embankment and will be paid for under Item 203.0200, Roadway Excavation. Surplus excavation shall be disposed of by the Contractor at his expense.
5. The Contractor shall pave the area shown on the plans with a two (2) inch layer of Asphalt Concrete Mix No. V over a four (4) inch thick Plant Mix Asphalt Concrete base course.
6. The Contractor's attention is directed to sub-sections 103.03 and 108.02 regarding Award of Contract and Notice to Proceed.
7. The Contractor shall provide a smooth riding transition between the paved areas and the unpaved areas. This work shall be considered to be incidental to Roadway Excavation and no extra payment will be made.

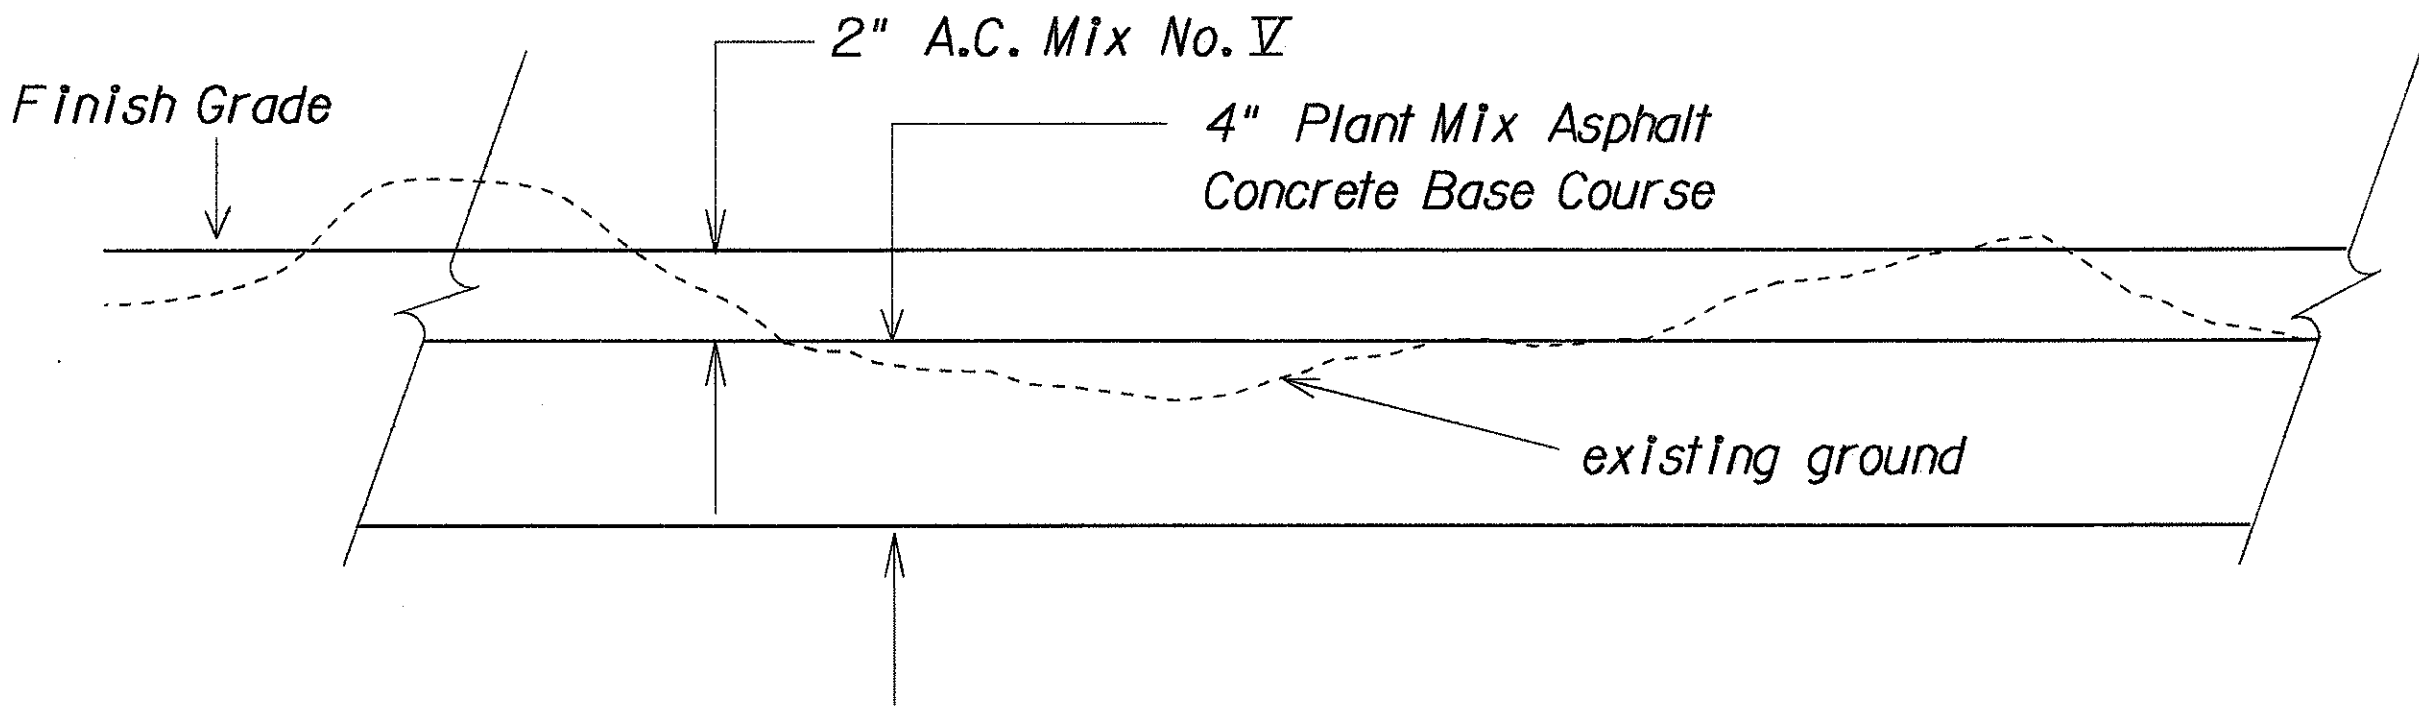

**TYPICAL SECTION**  
Not to Scale

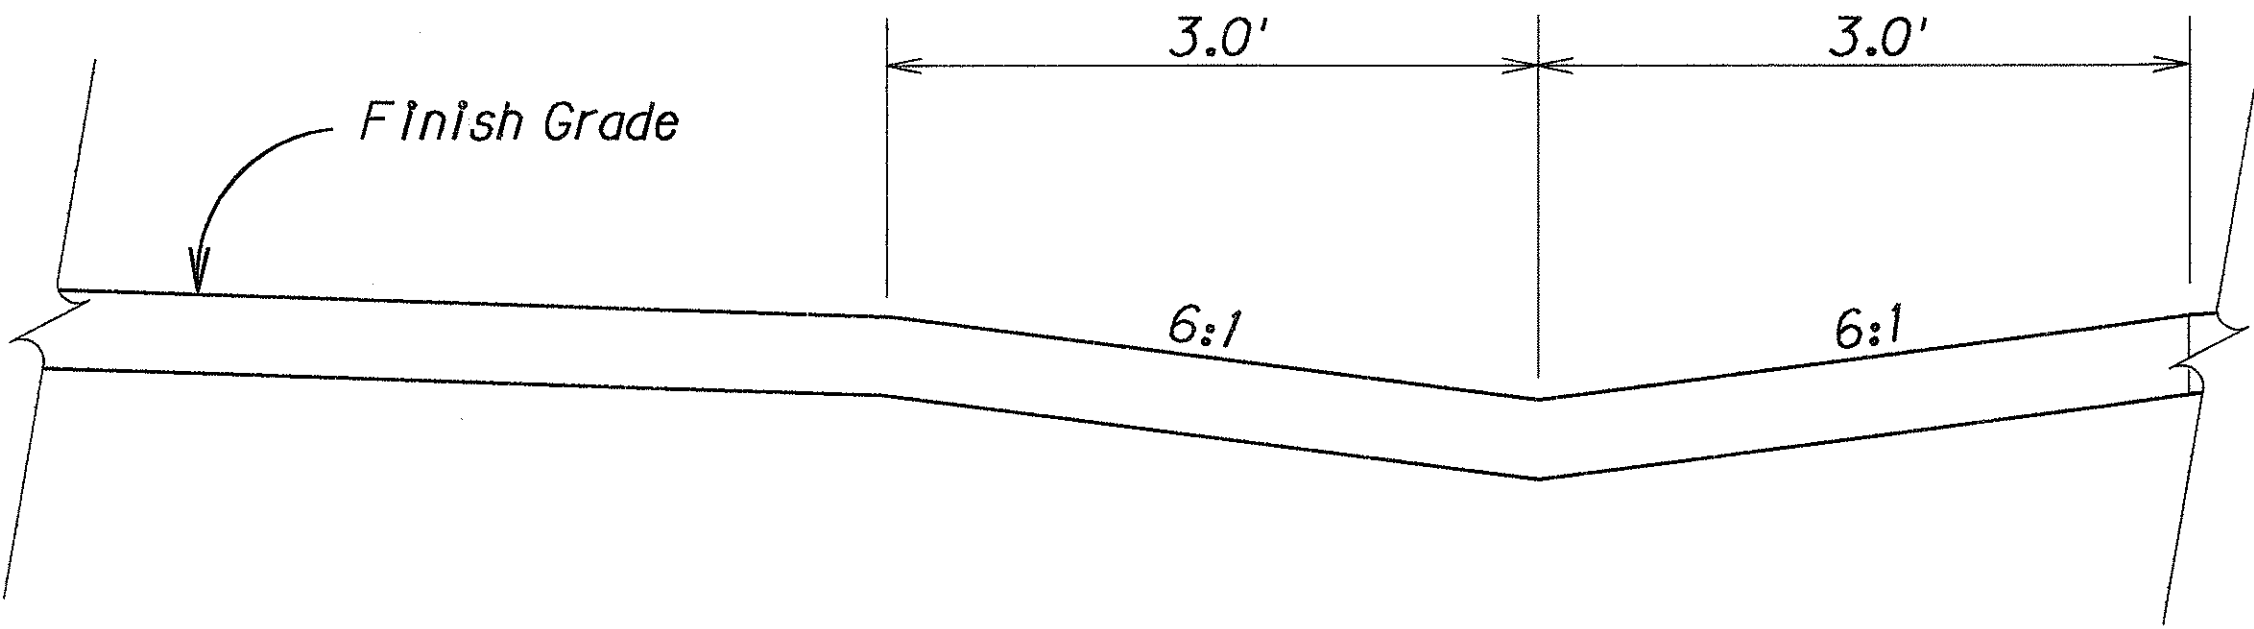

**TYPICAL SECTION-DRAINAGE SWALE**  
Not to Scale

SURVEY PLOTTED BY	DATE
DRAWN BY	
DESIGNED BY	
QUANTITIES BY	
CHECKED BY	
ORIGINAL PLAN	
NOTE BOOK	
No.	

STATE OF HAWAII  
DEPARTMENT OF TRANSPORTATION  
HIGHWAYS DIVISION

**TYPICAL SECTIONS AND  
GENERAL NOTES**  
  
MVS0 TEST SITE AT  
ALOHA STADIUM PARKING LOT  
Project No. HWY-0-07-91  
Scale: As Shown      Date: May, 1991  
SHEET No. 1 OF 1 SHEETS