


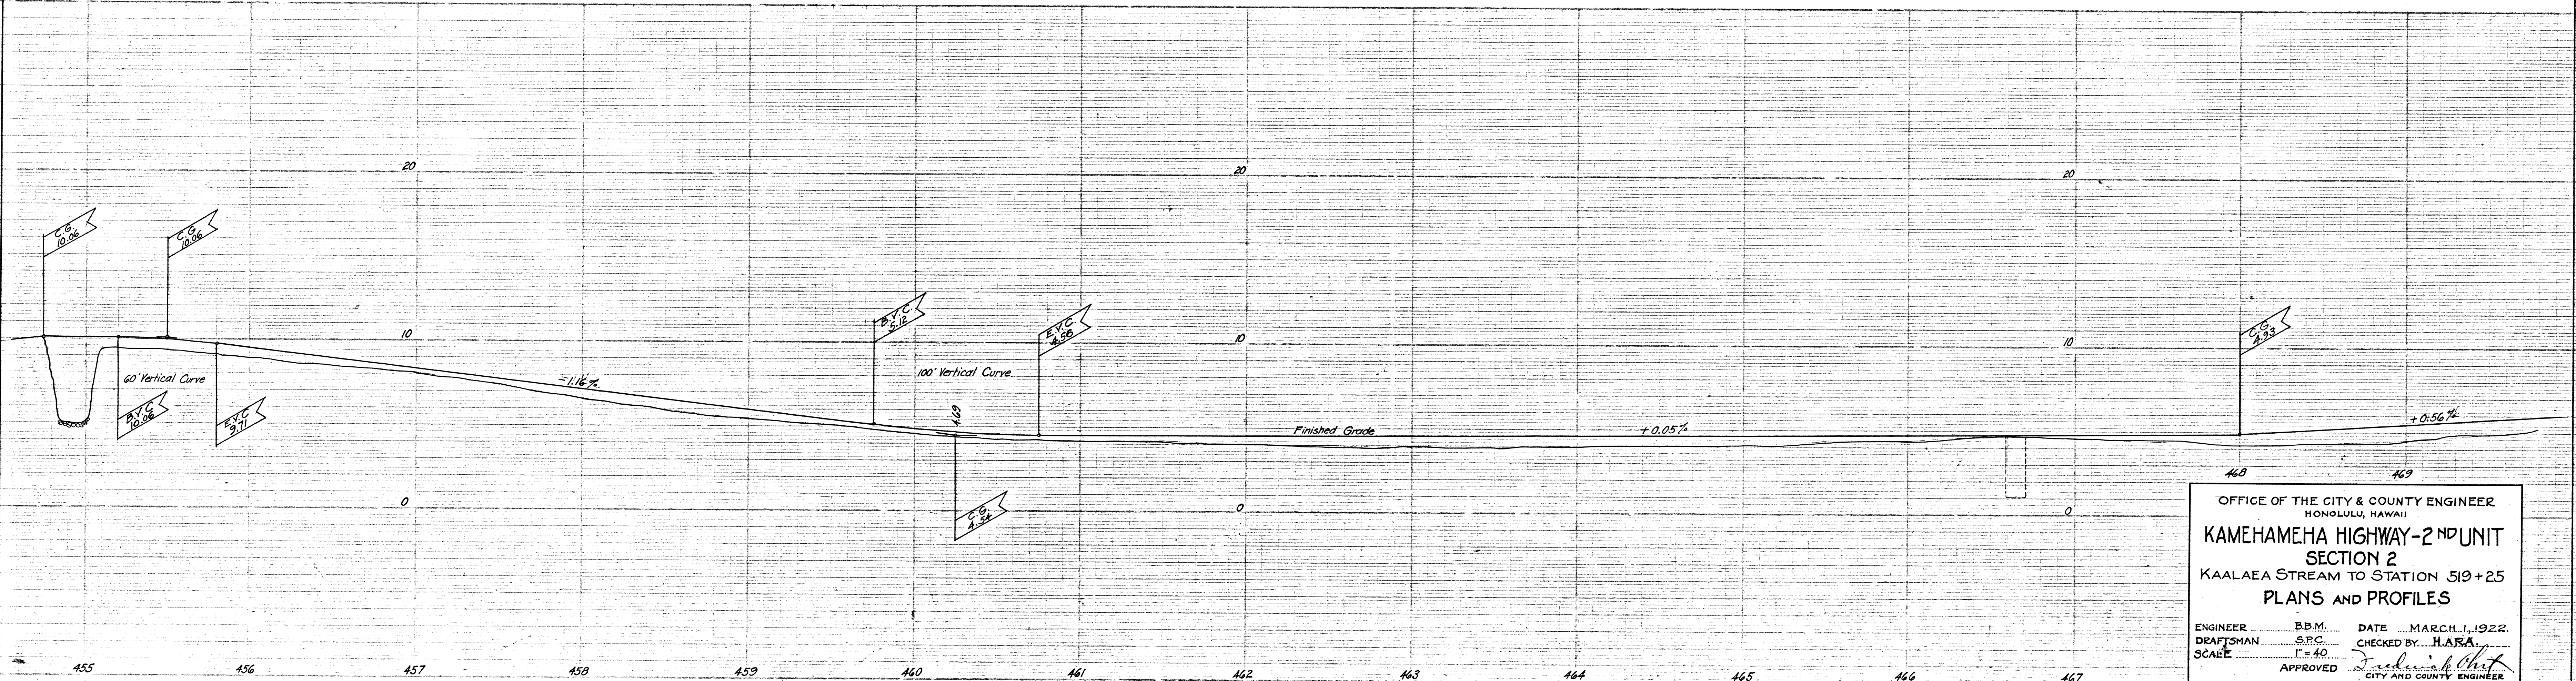


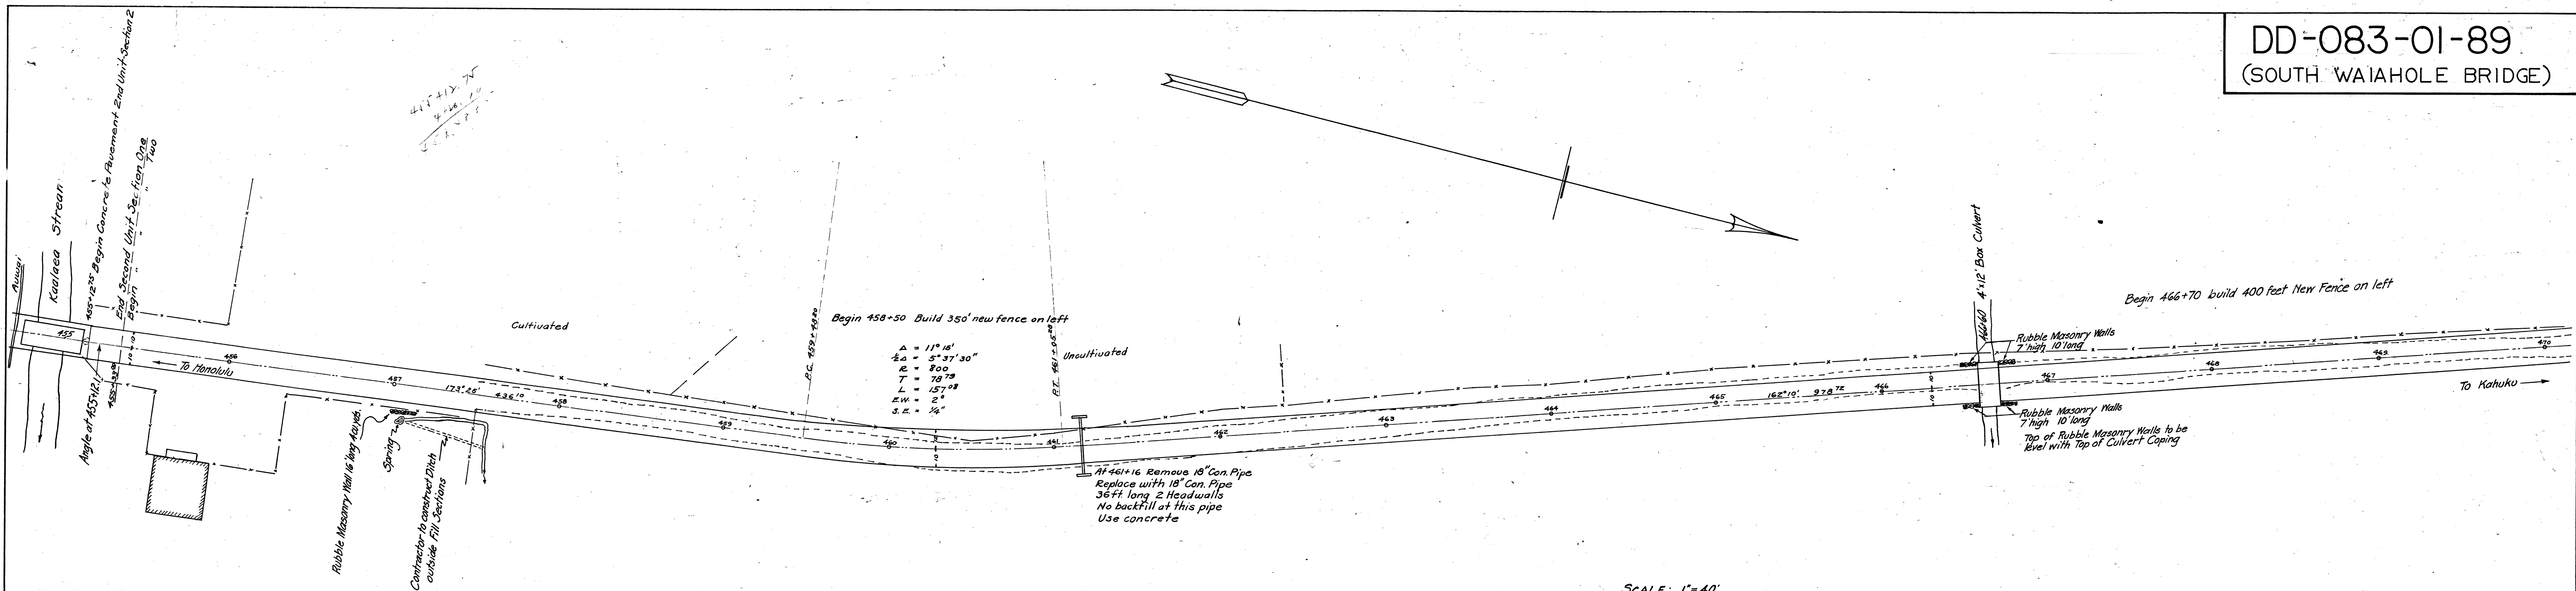

OFFICE OF THE CITY & COUNTY ENGINEER
HONOLULU, HAWAII
**KAMEHAMEHA HIGHWAY-2ND UNIT
SECTION 2**
KAALAEA STREAM TO STATION 519+25
PLANS AND PROFILES
ENGINEER B.P.M. DATE MARCH 1, 1922.
DRAFTSMAN S.P.C. CHECKED BY H.A.R.
SCALE 1" = 40' APPROVED [Signature]
CITY AND COUNTY ENGINEER

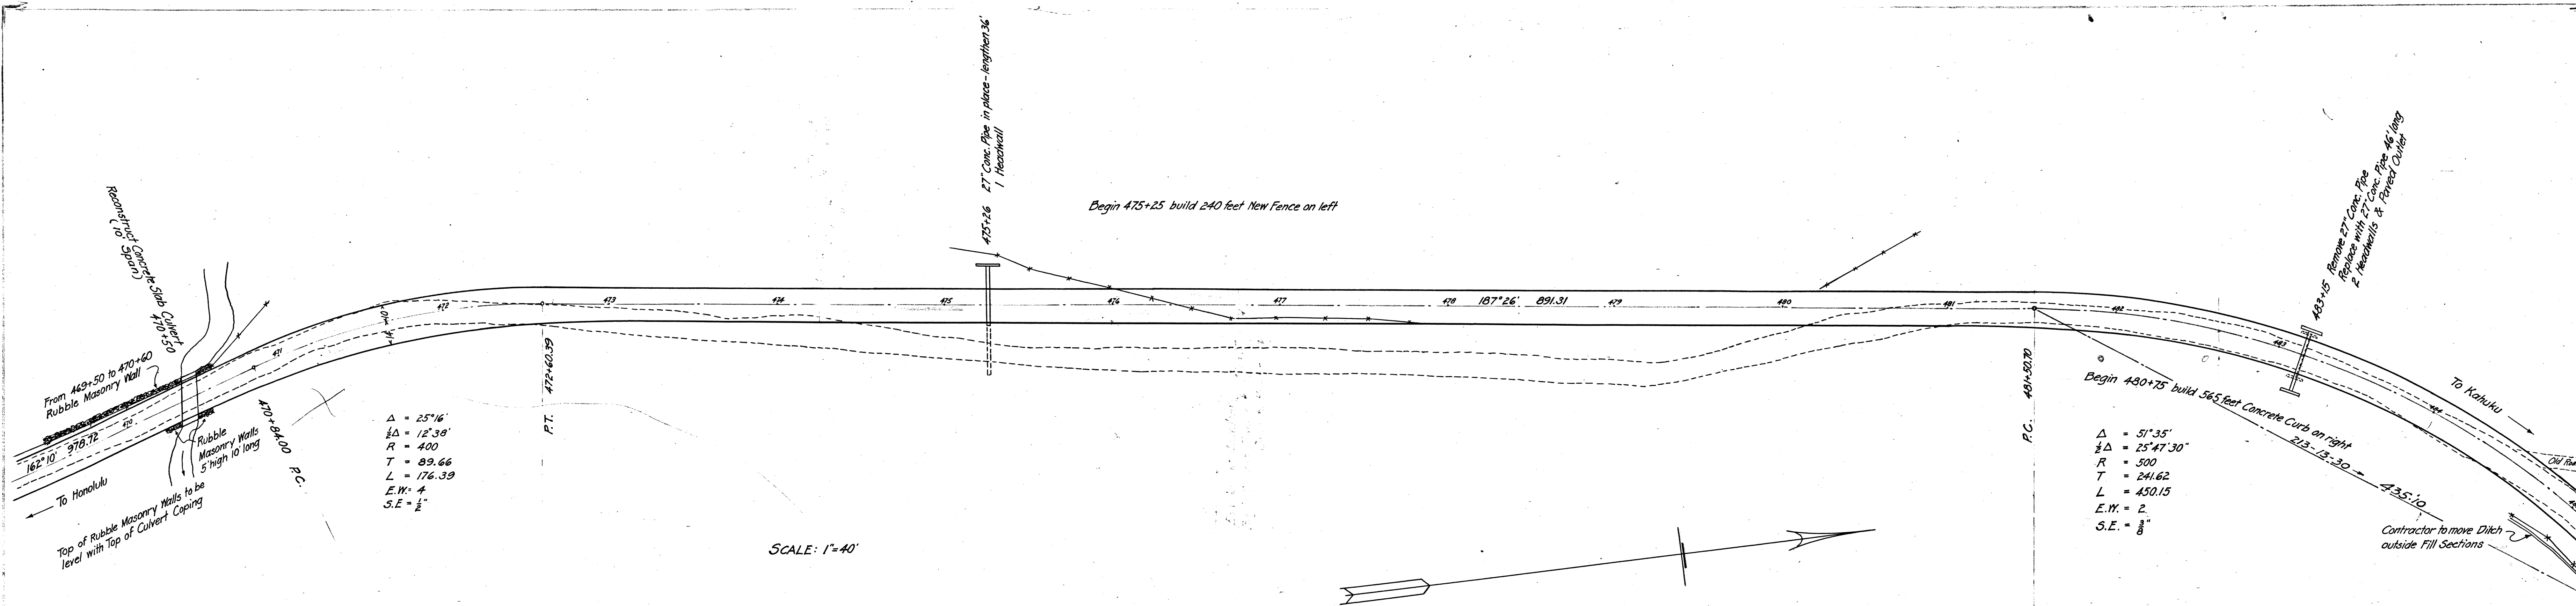

DD-083-01-89
(SOUTH WAIHOLE BRIDGE)

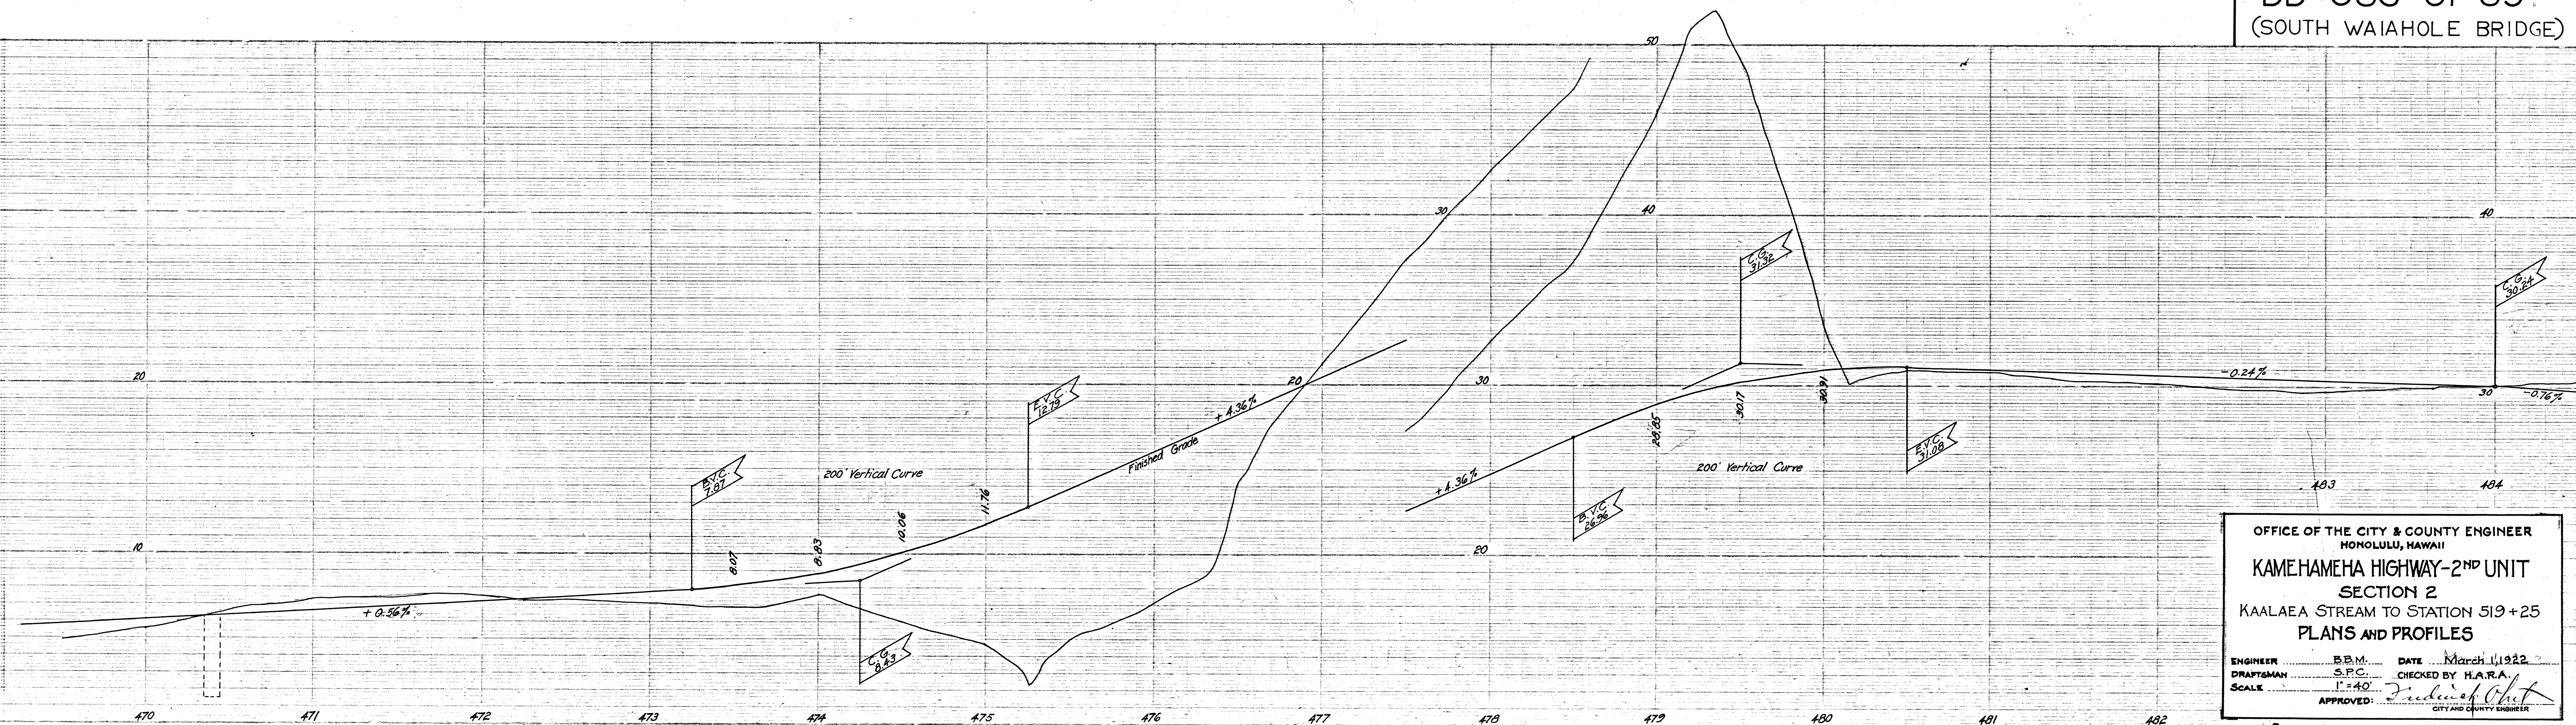


OFFICE OF THE CITY & COUNTY ENGINEER
HONOLULU, HAWAII
KAMEHAMEHA HIGHWAY-2ND UNIT
SECTION 2
KAALAEA STREAM TO STATION 519+25
PLANS AND PROFILES
ENGINEER: B.E.M. DATE: March 1, 1922
DRAFTSMAN: S.P.C. CHECKED BY: H.A.R.A.
SCALE: 1"=40' APPROVED: *Frederick A. Holt*
CITY AND COUNTY ENGINEER


Sheet 2 of 5 Sheets

FILE	POCKET	FOLDER	NO.
1	X	3	3

FILE NO DD-J-15


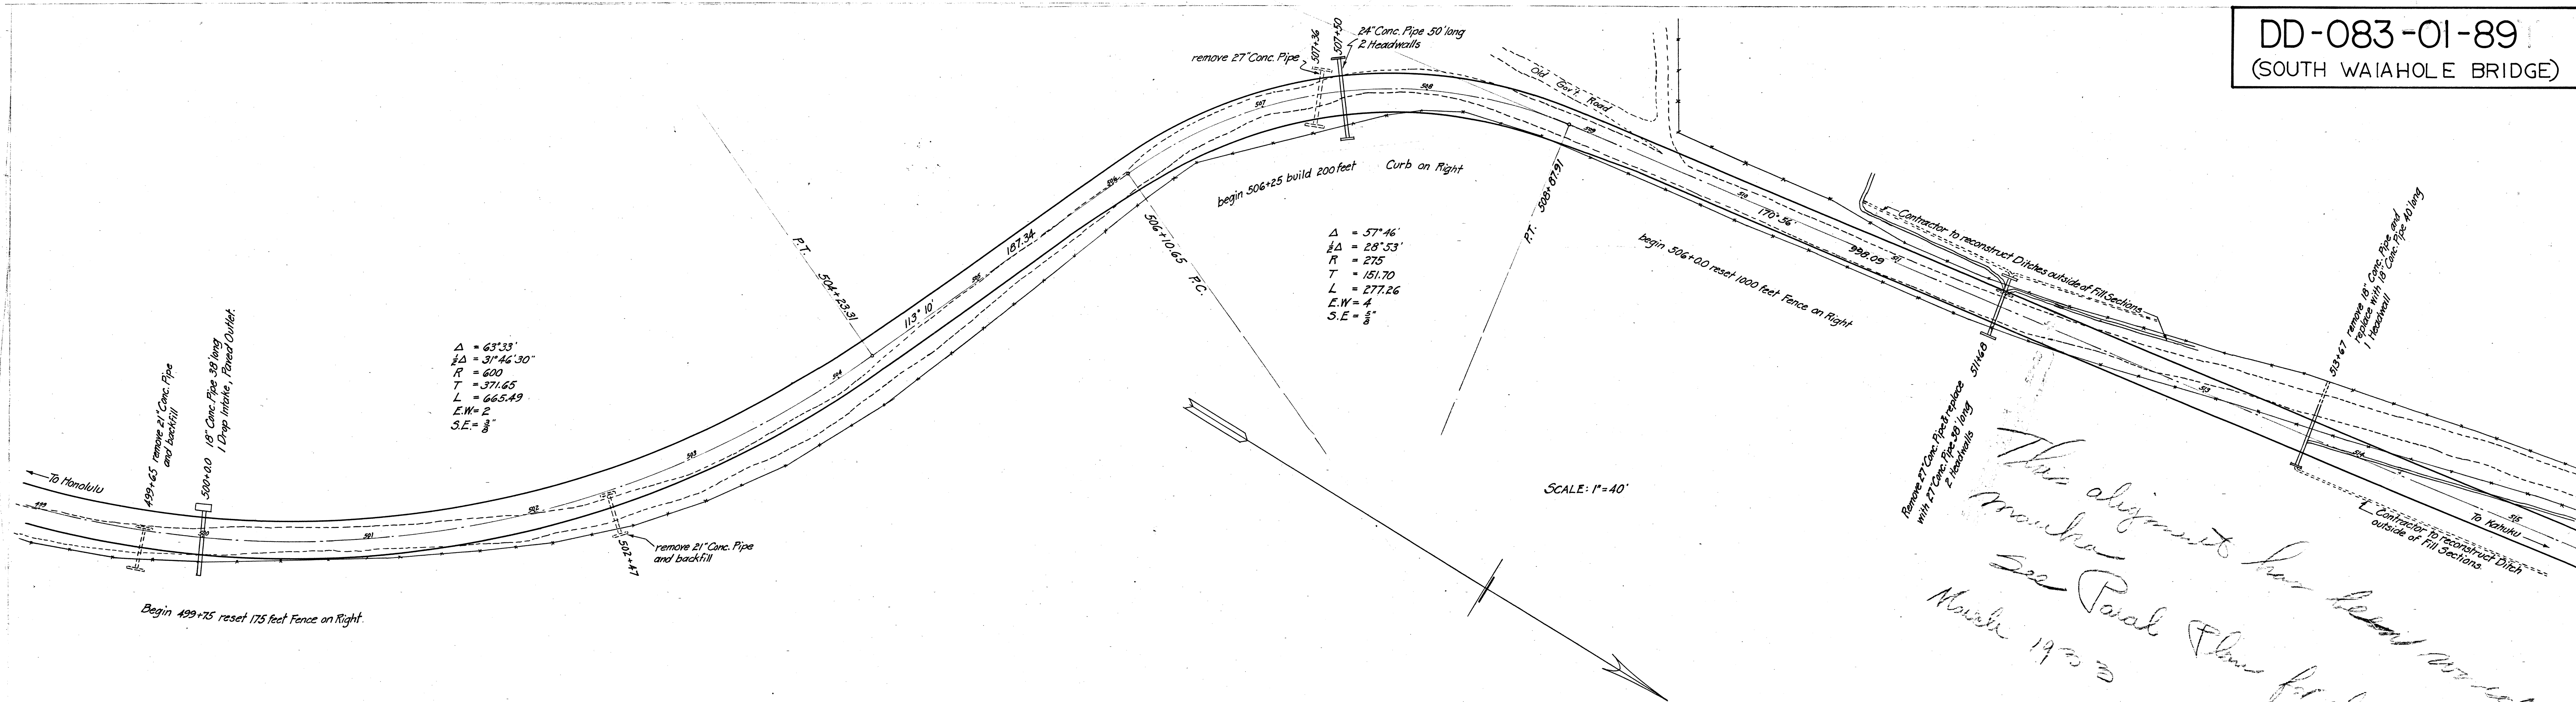


*This alignment has been revised
See Parol Plans for alignment
March 1933
K-15 - 1 Tr.*

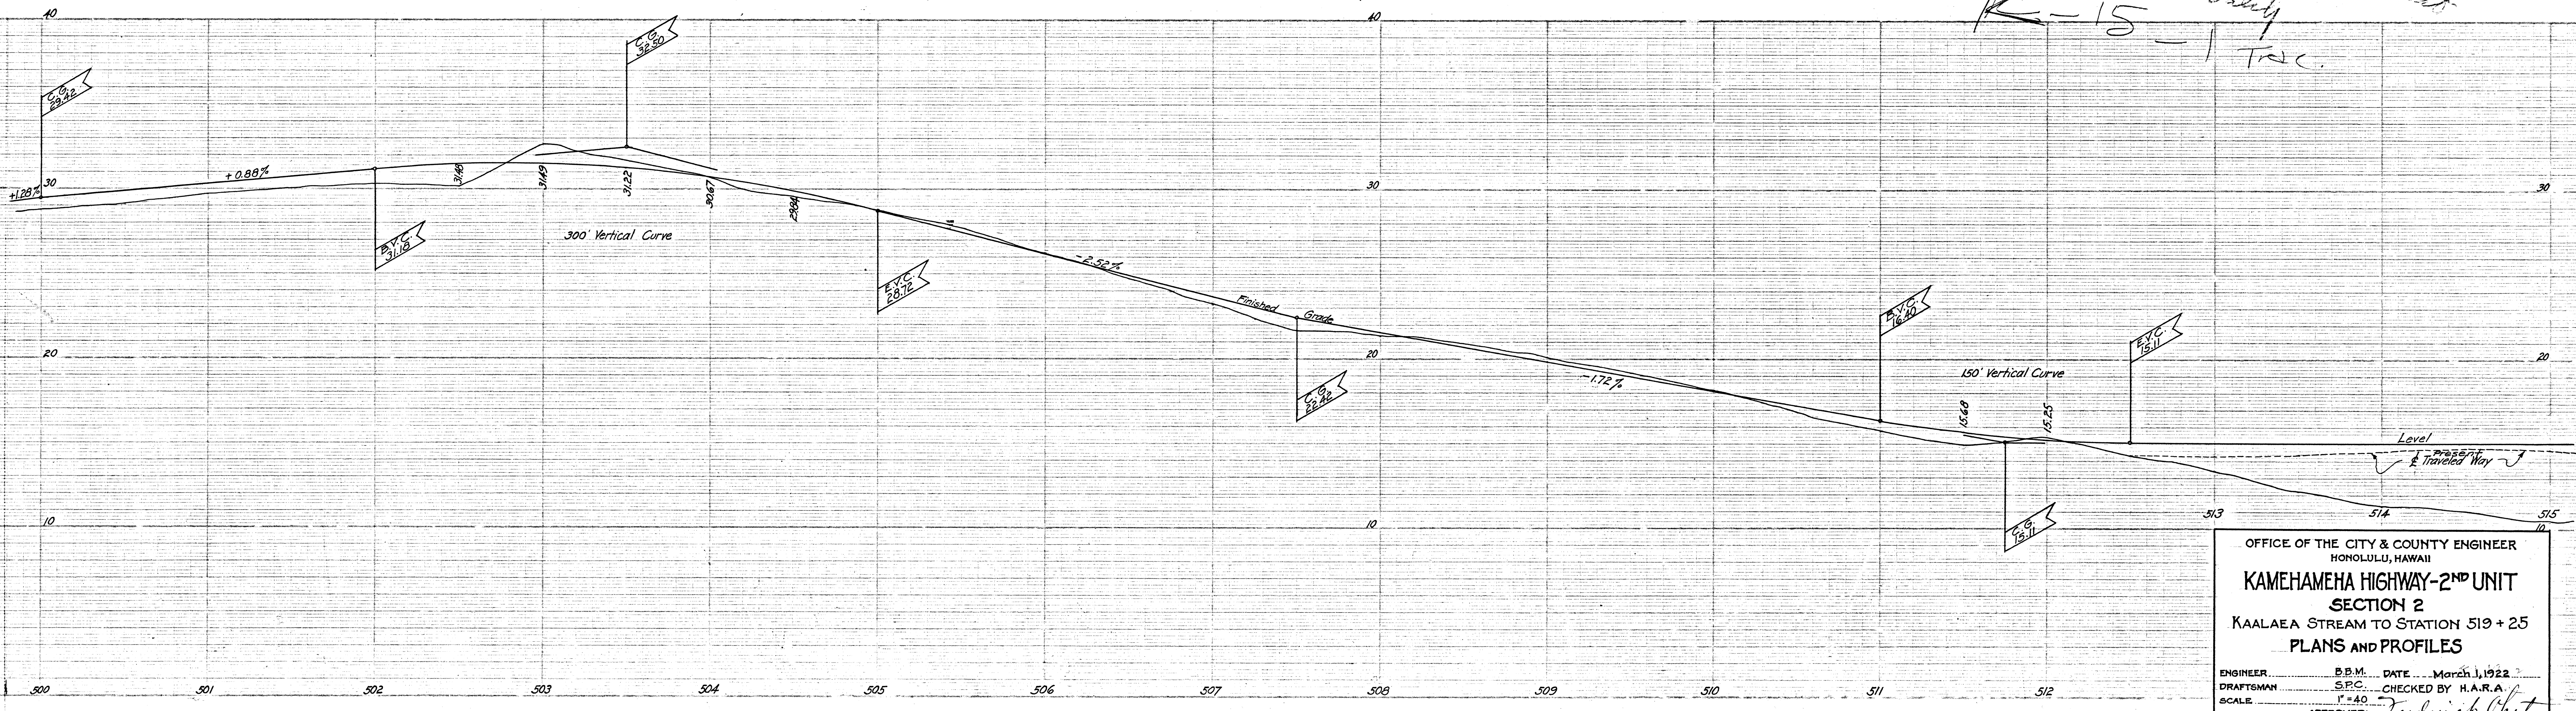

OFFICE OF THE CITY & COUNTY ENGINEER
HONOLULU, HAWAII
KAMEHAMEHA HIGHWAY-2ND UNIT
SECTION 2
KAALAEA STREAM TO STATION 513 + 25
PLANS AND PROFILES
ENGINEER... DATE... March 1, 1922
DRAFTSMAN... S.P.C. CHECKED BY H.A.R.A.
SCALE... 1\"/>

DD-083-01-89
(SOUTH WAIHOLE BRIDGE)

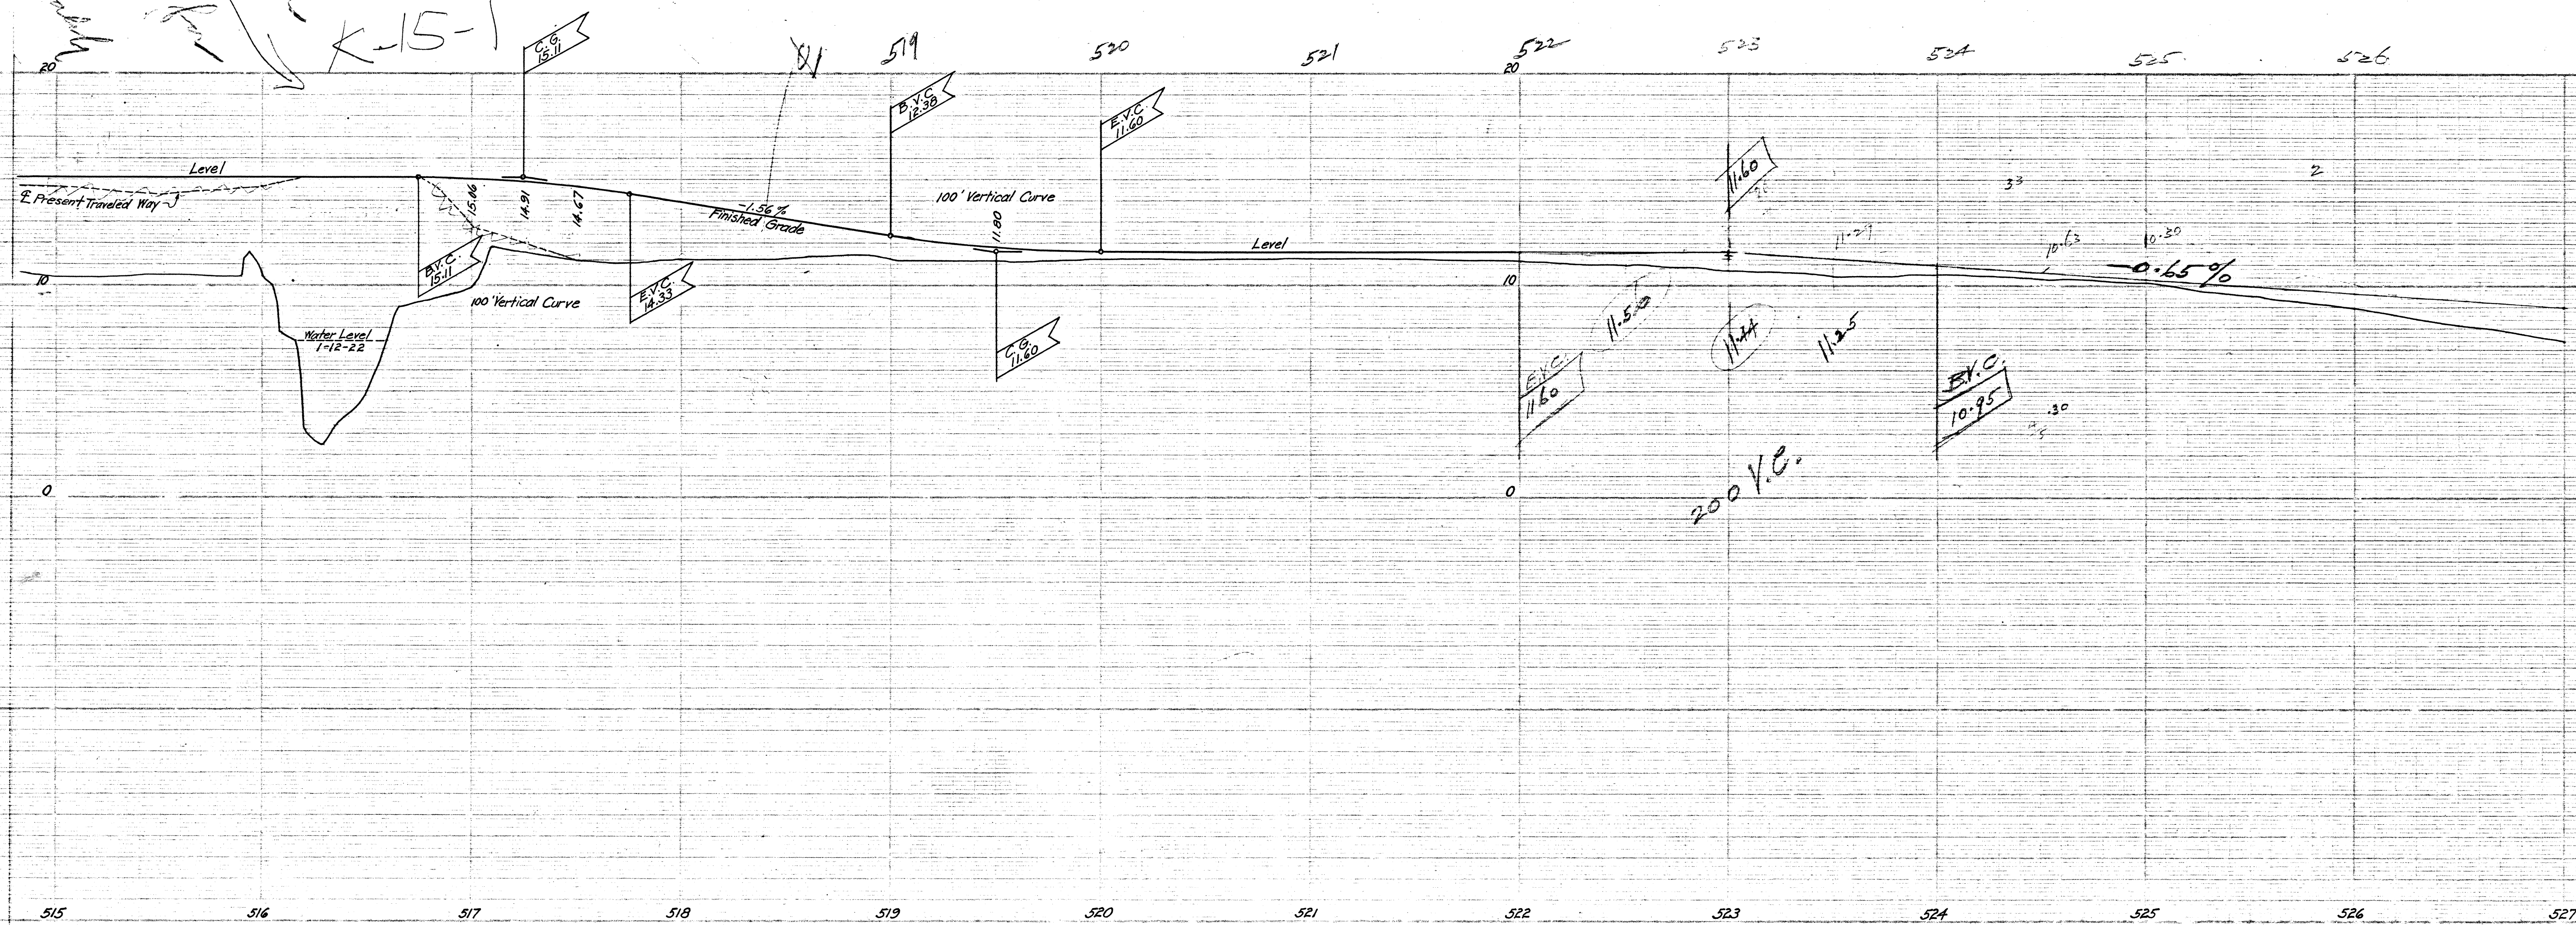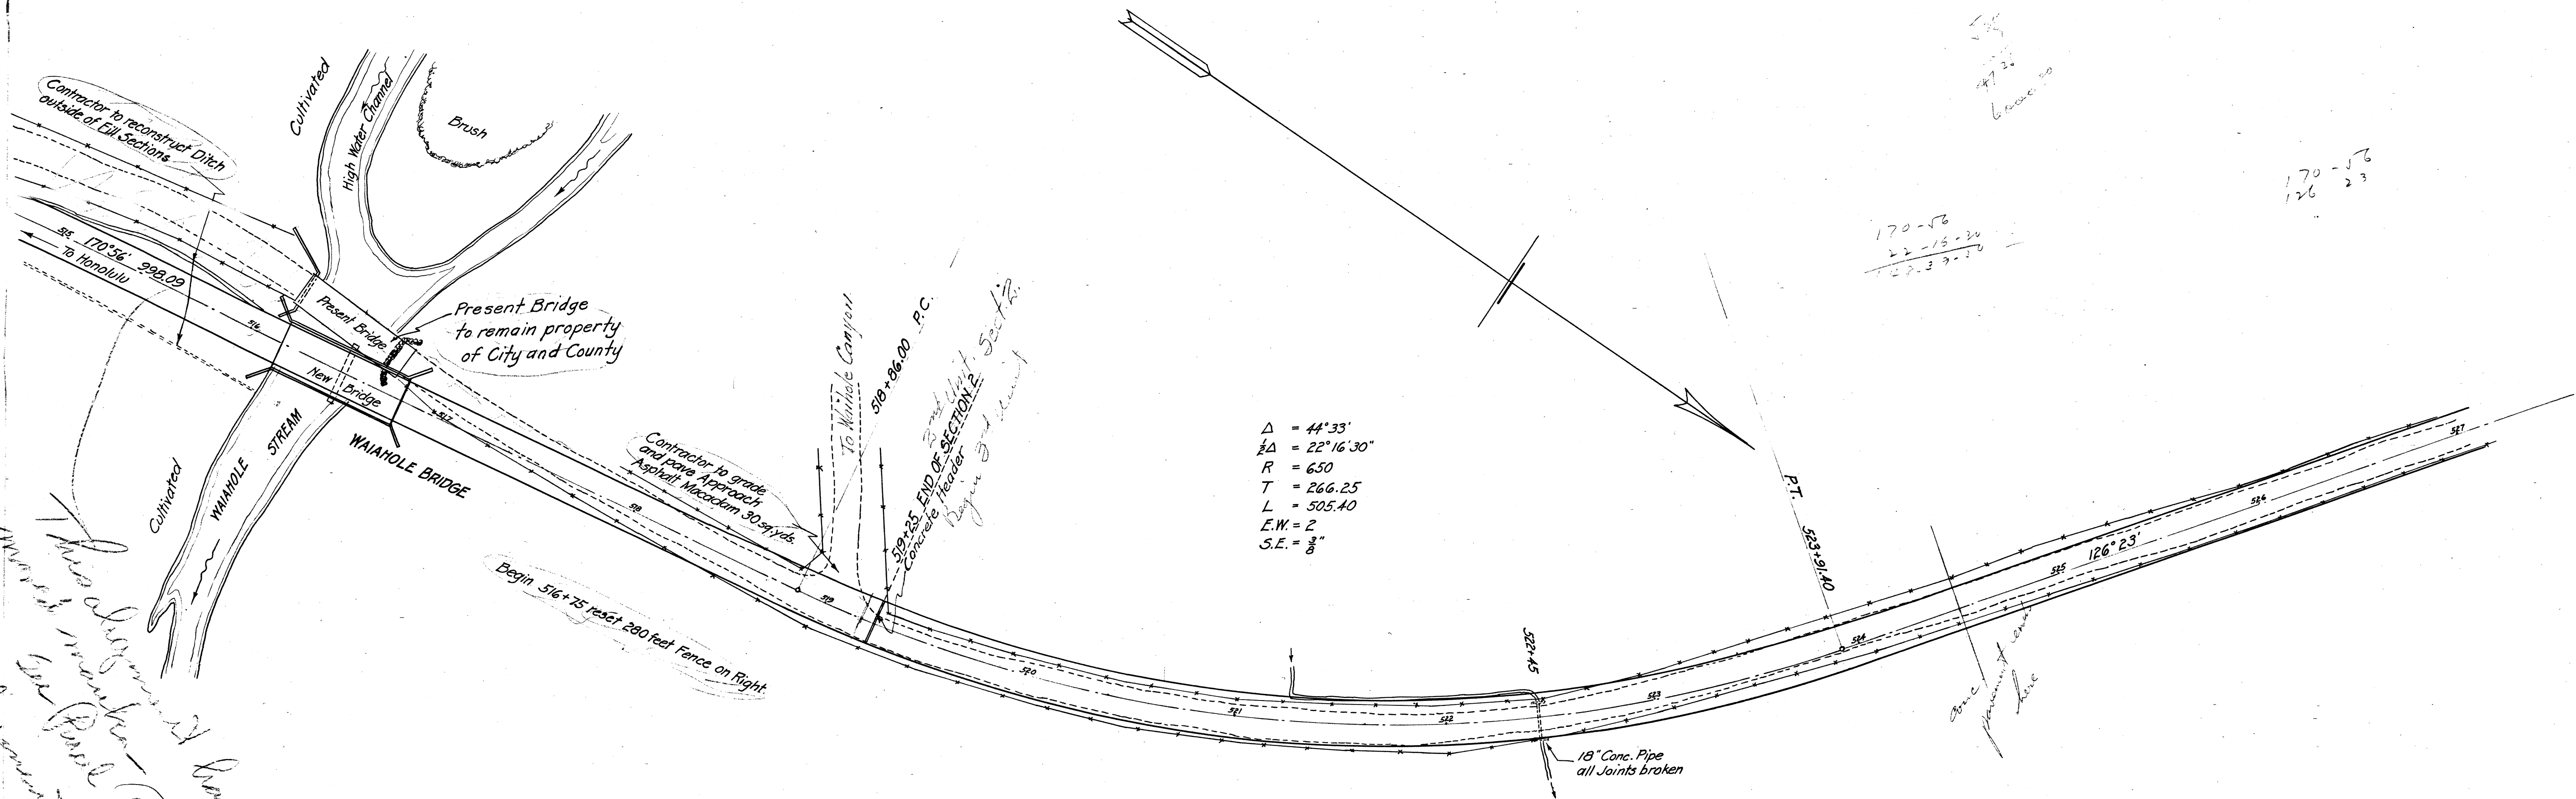

OFFICE OF THE CITY & COUNTY ENGINEER
HONOLULU, HAWAII

KAMEHAMEHA HIGHWAY-2ND UNIT
SECTION 2
KAALAEA STREAM TO STATION 519+25
PLANS AND PROFILES

ENGINEER: B.B.M. DATE: March 1, 1922
DRAFTSMAN: S.P.C. CHECKED BY: H.A.R.A.
SCALE: 1" = 40'
APPROVED: [Signature] CITY AND COUNTY ENGINEER

Sheet 5 of 5 Sheets

7 FILE POCKET FOLDER NO.

FILE NO. DD-J-15