
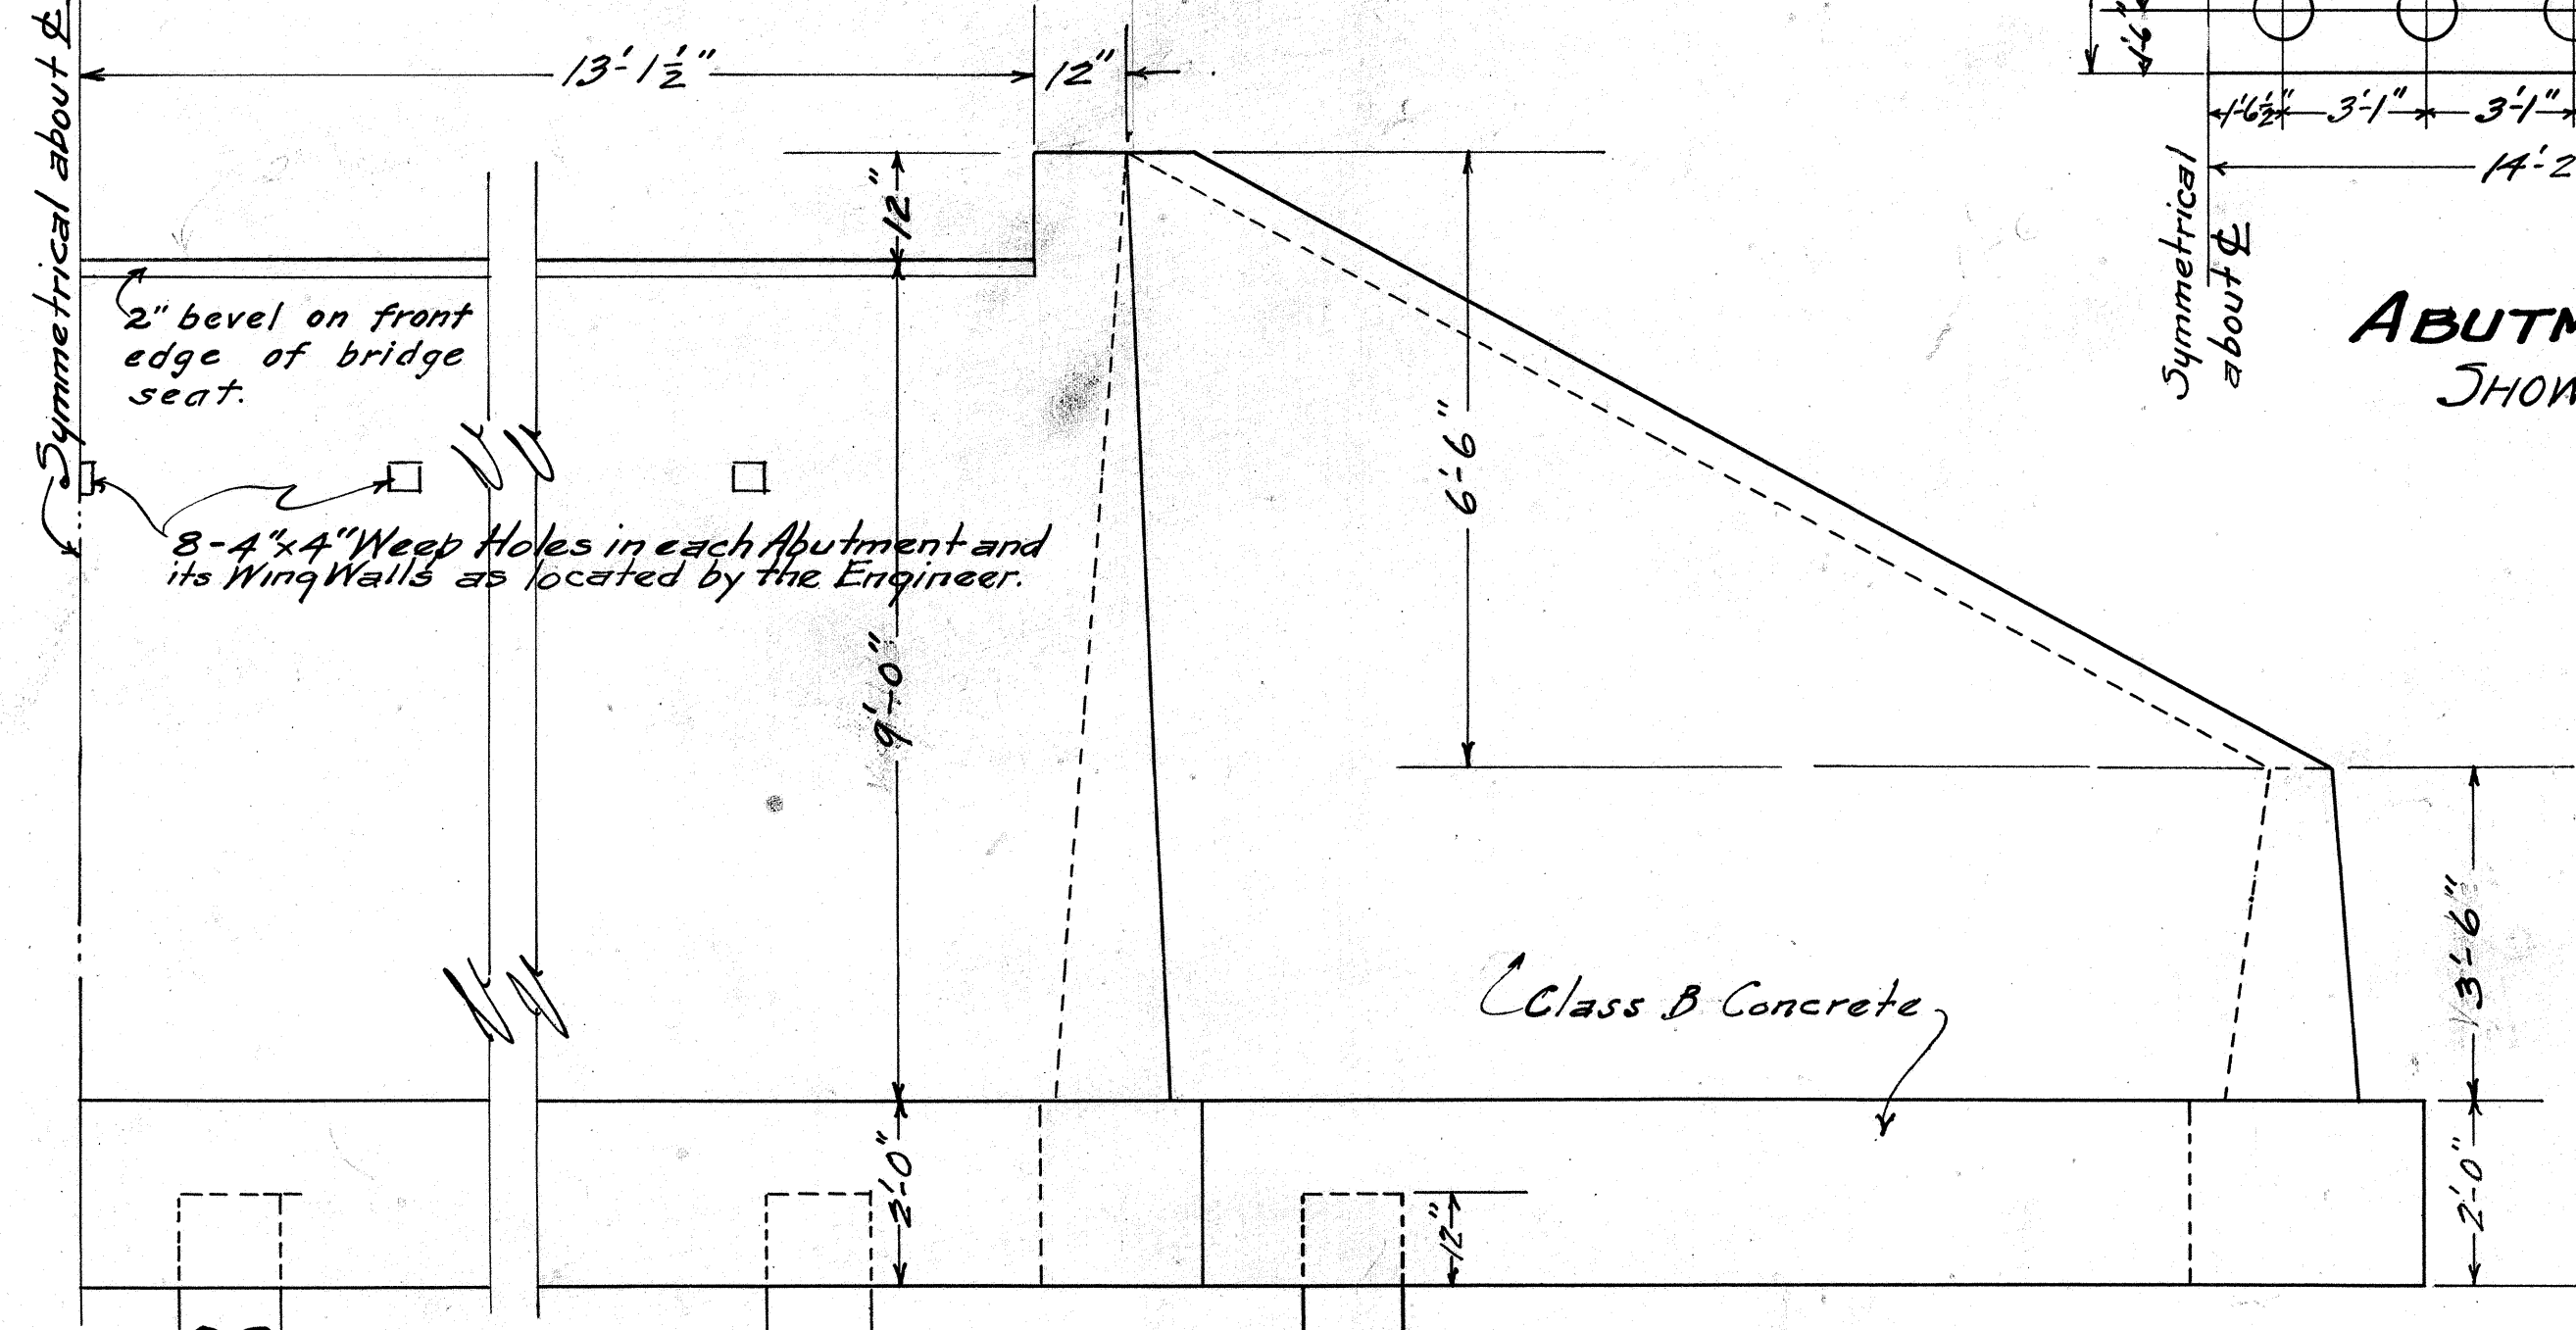
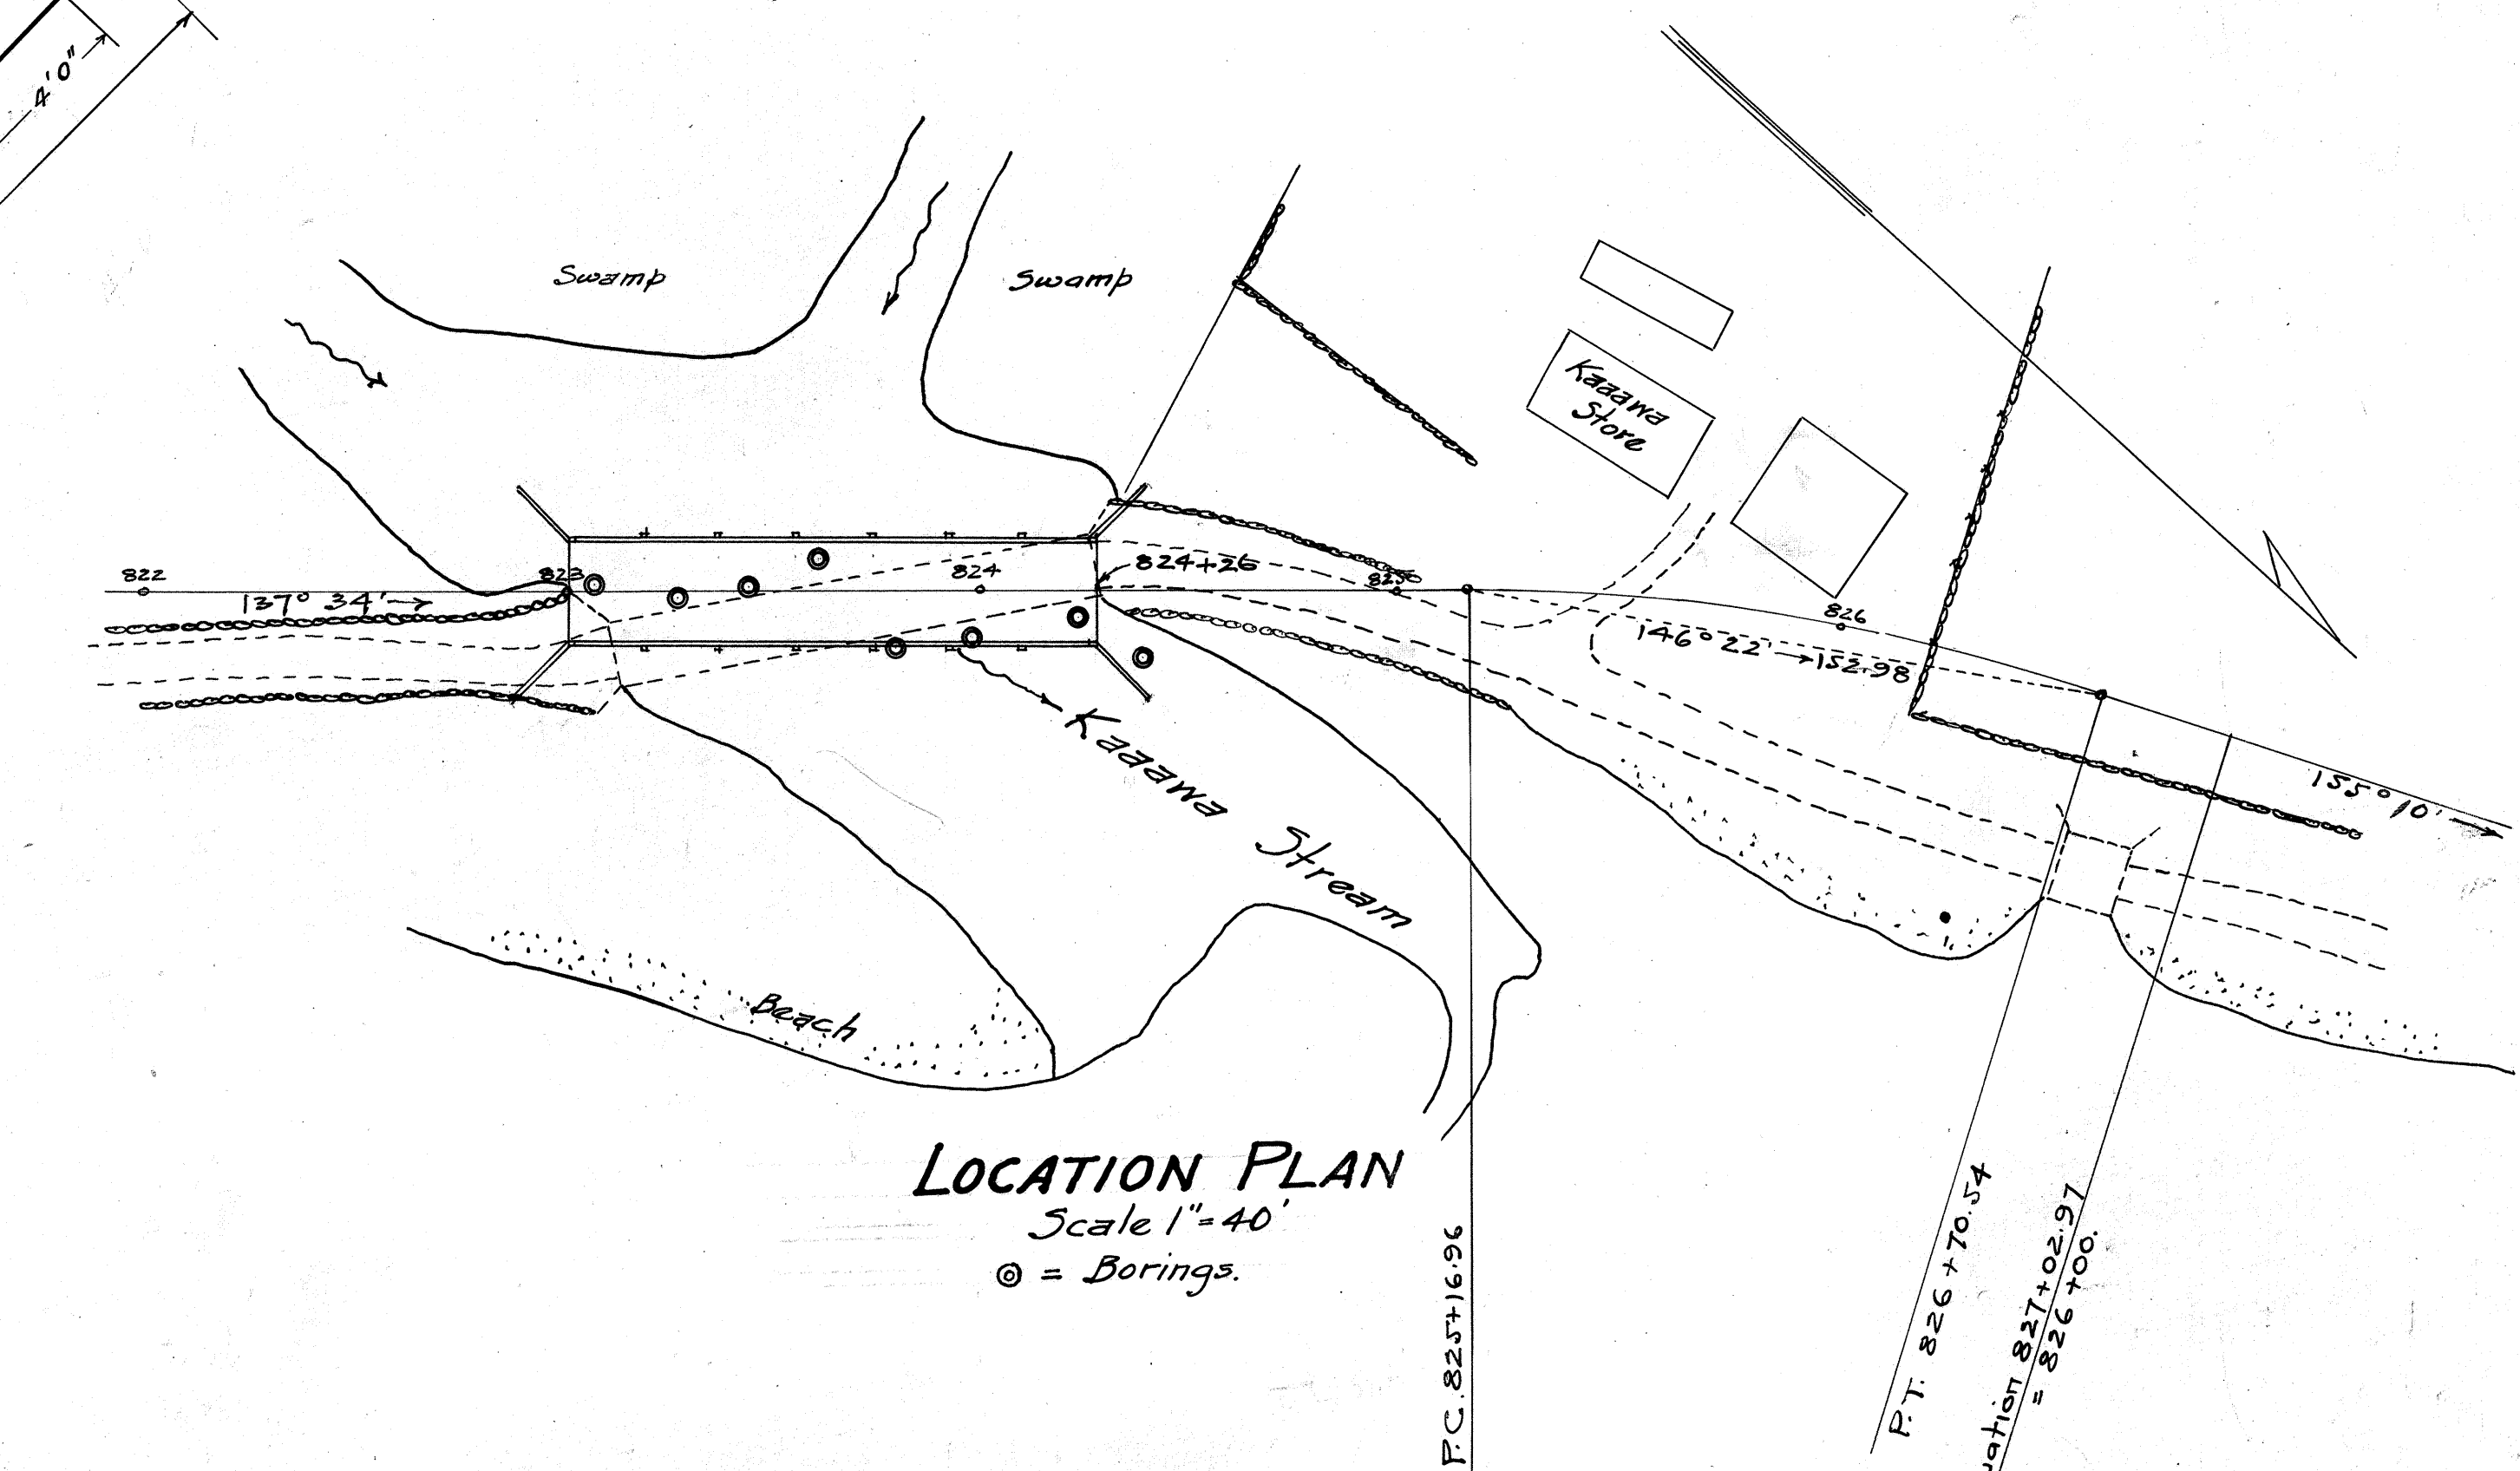
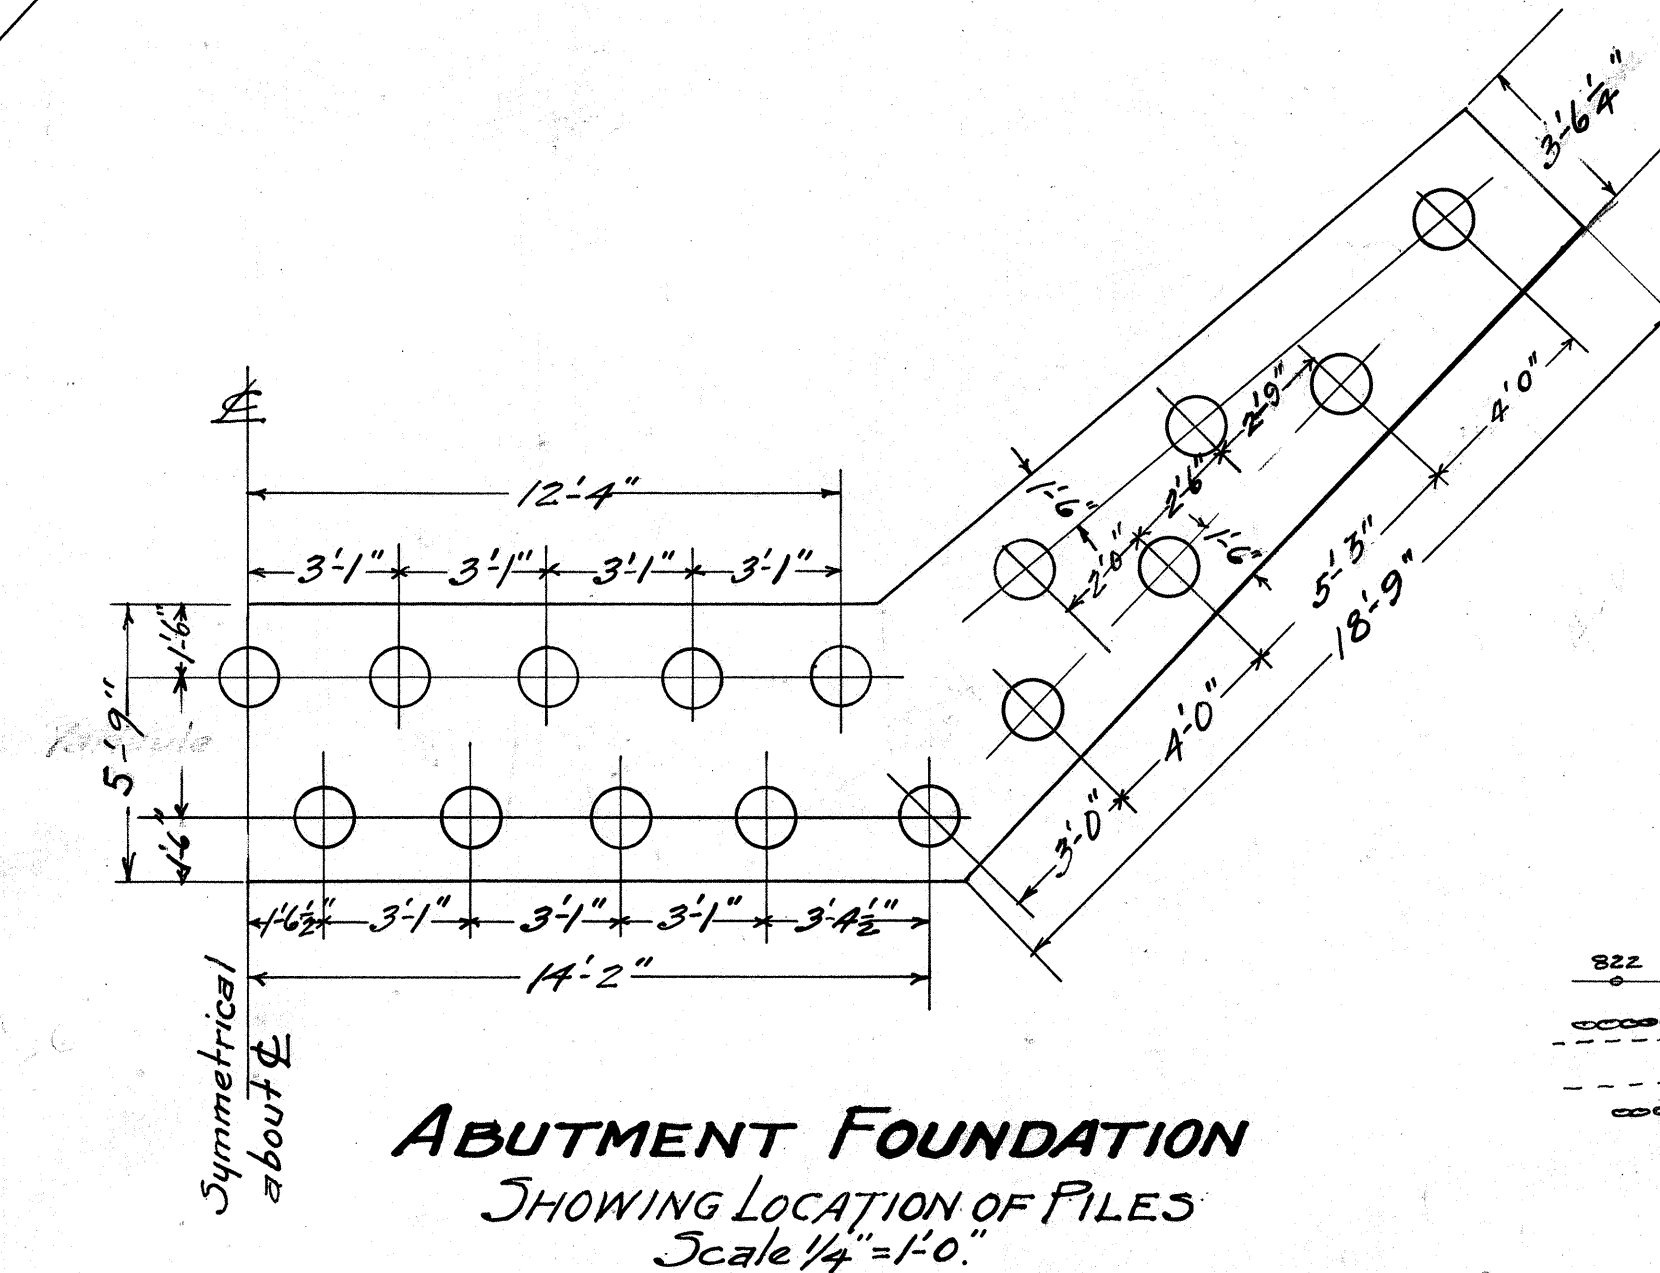
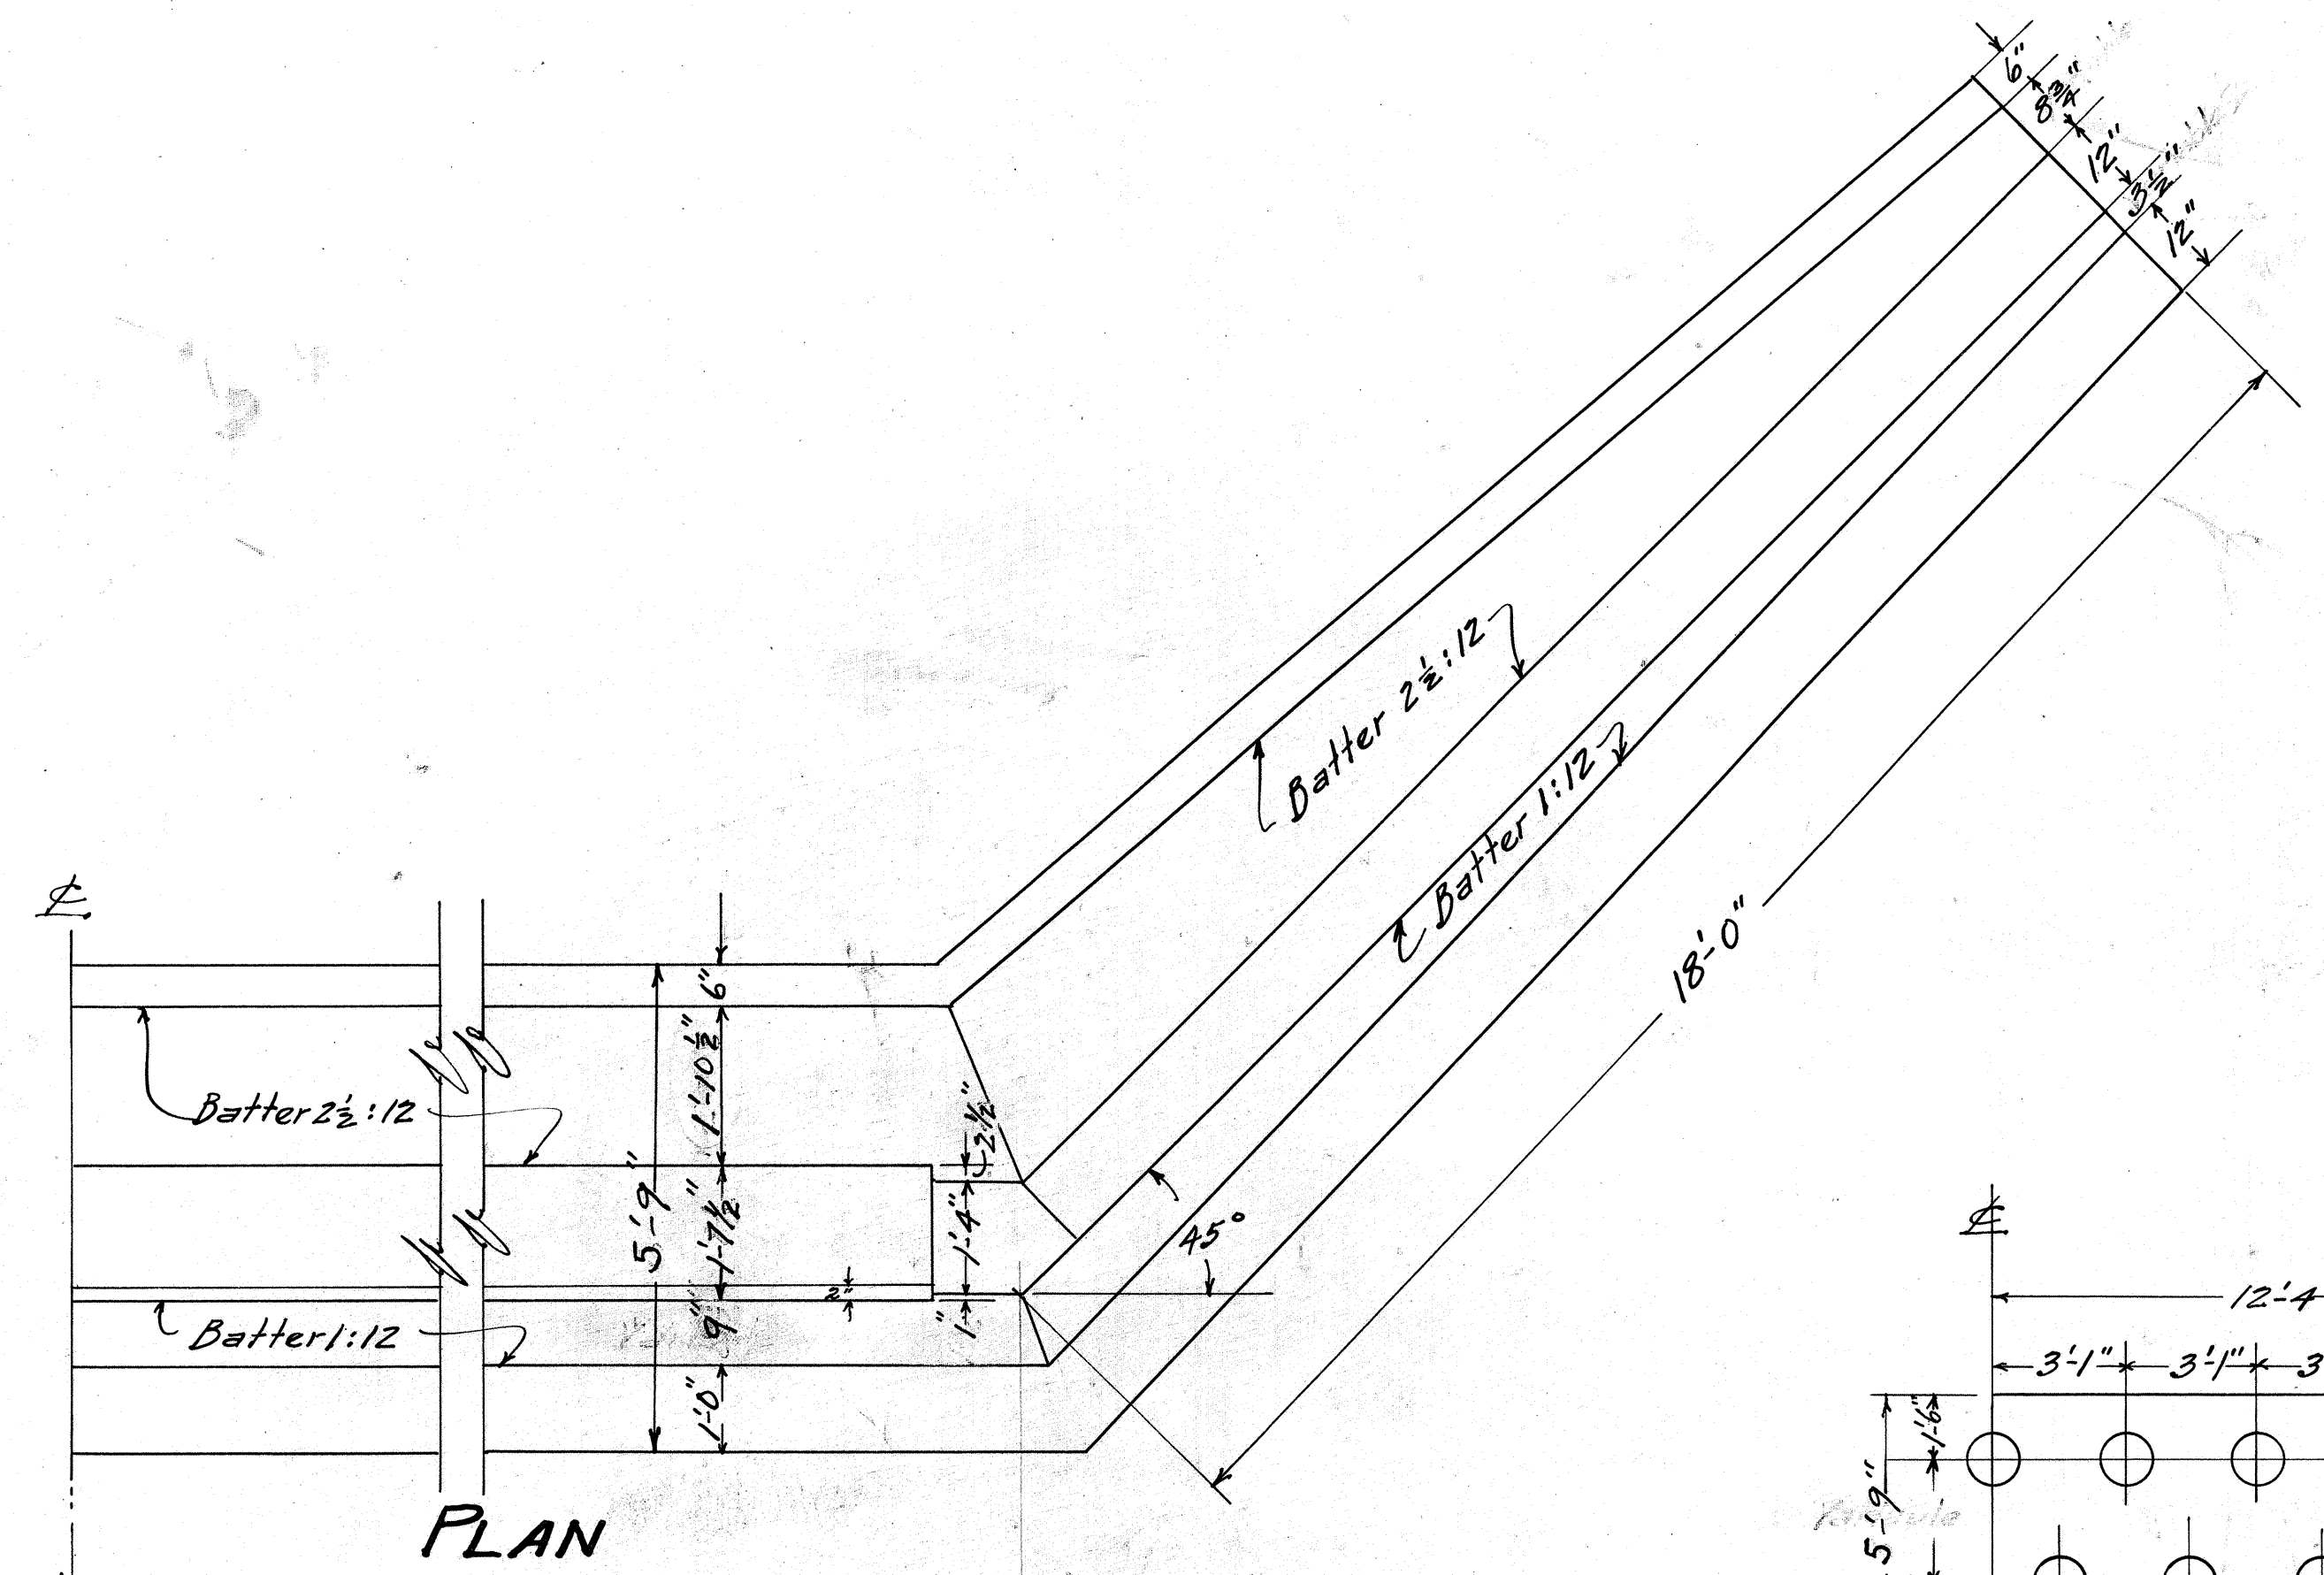


TERMINAL HIGHWAY ENGINEER

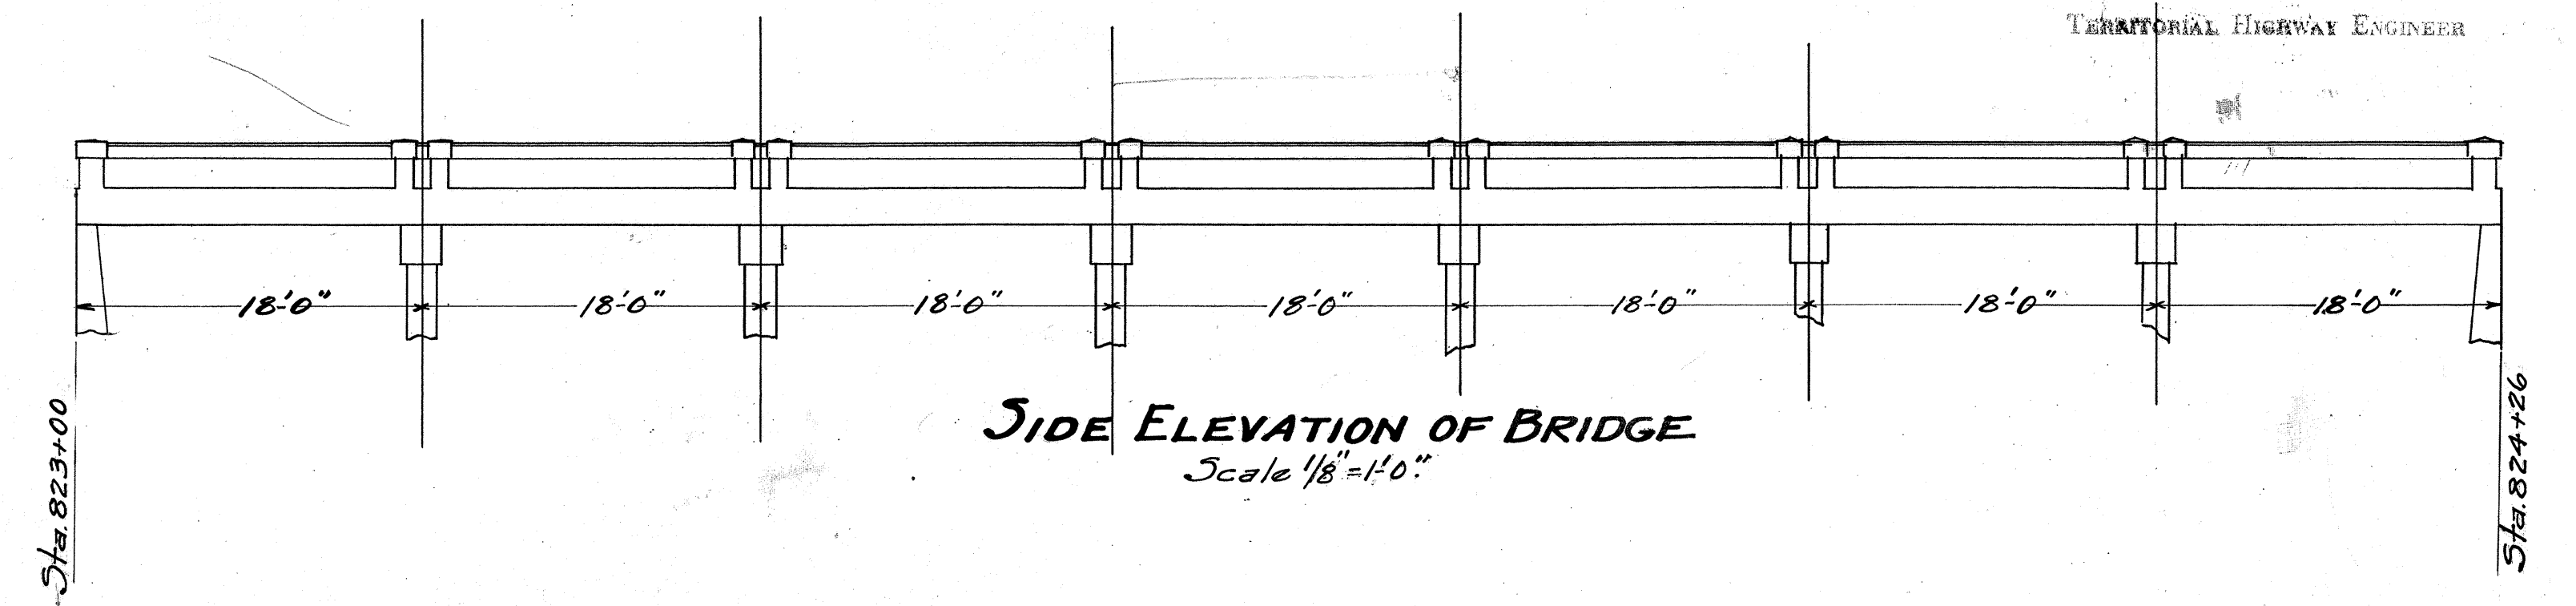

APPROXIMATE QUANTITIES

Class A Concrete	228.4	Cu.Yds.
Class B Concrete	143	Cu.Yds.
30-12 Concrete Socket Piles		
92-50 Wooden Piles	4600	Lin.Ft.

NOTE:- FOR DETAILS OF SUPERSTRUCTURE
SEE SHEET 7 STANDARD DETAILS

3076.49

OFFICE OF THE CITY & COUNTY ENGINEER
HONOLULU, HAWAII

KAMEHAMEHA HIGHWAY PROJECT I

BRIDGE No. 5 DETAILS

ENGINEER: B.B.M. DATE: _____
DRAFTSMAN: S.L.W. CHECKED BY: _____
SCALE: As Noted APPROVED: _____ CITY & COUNTY ENGINEER