

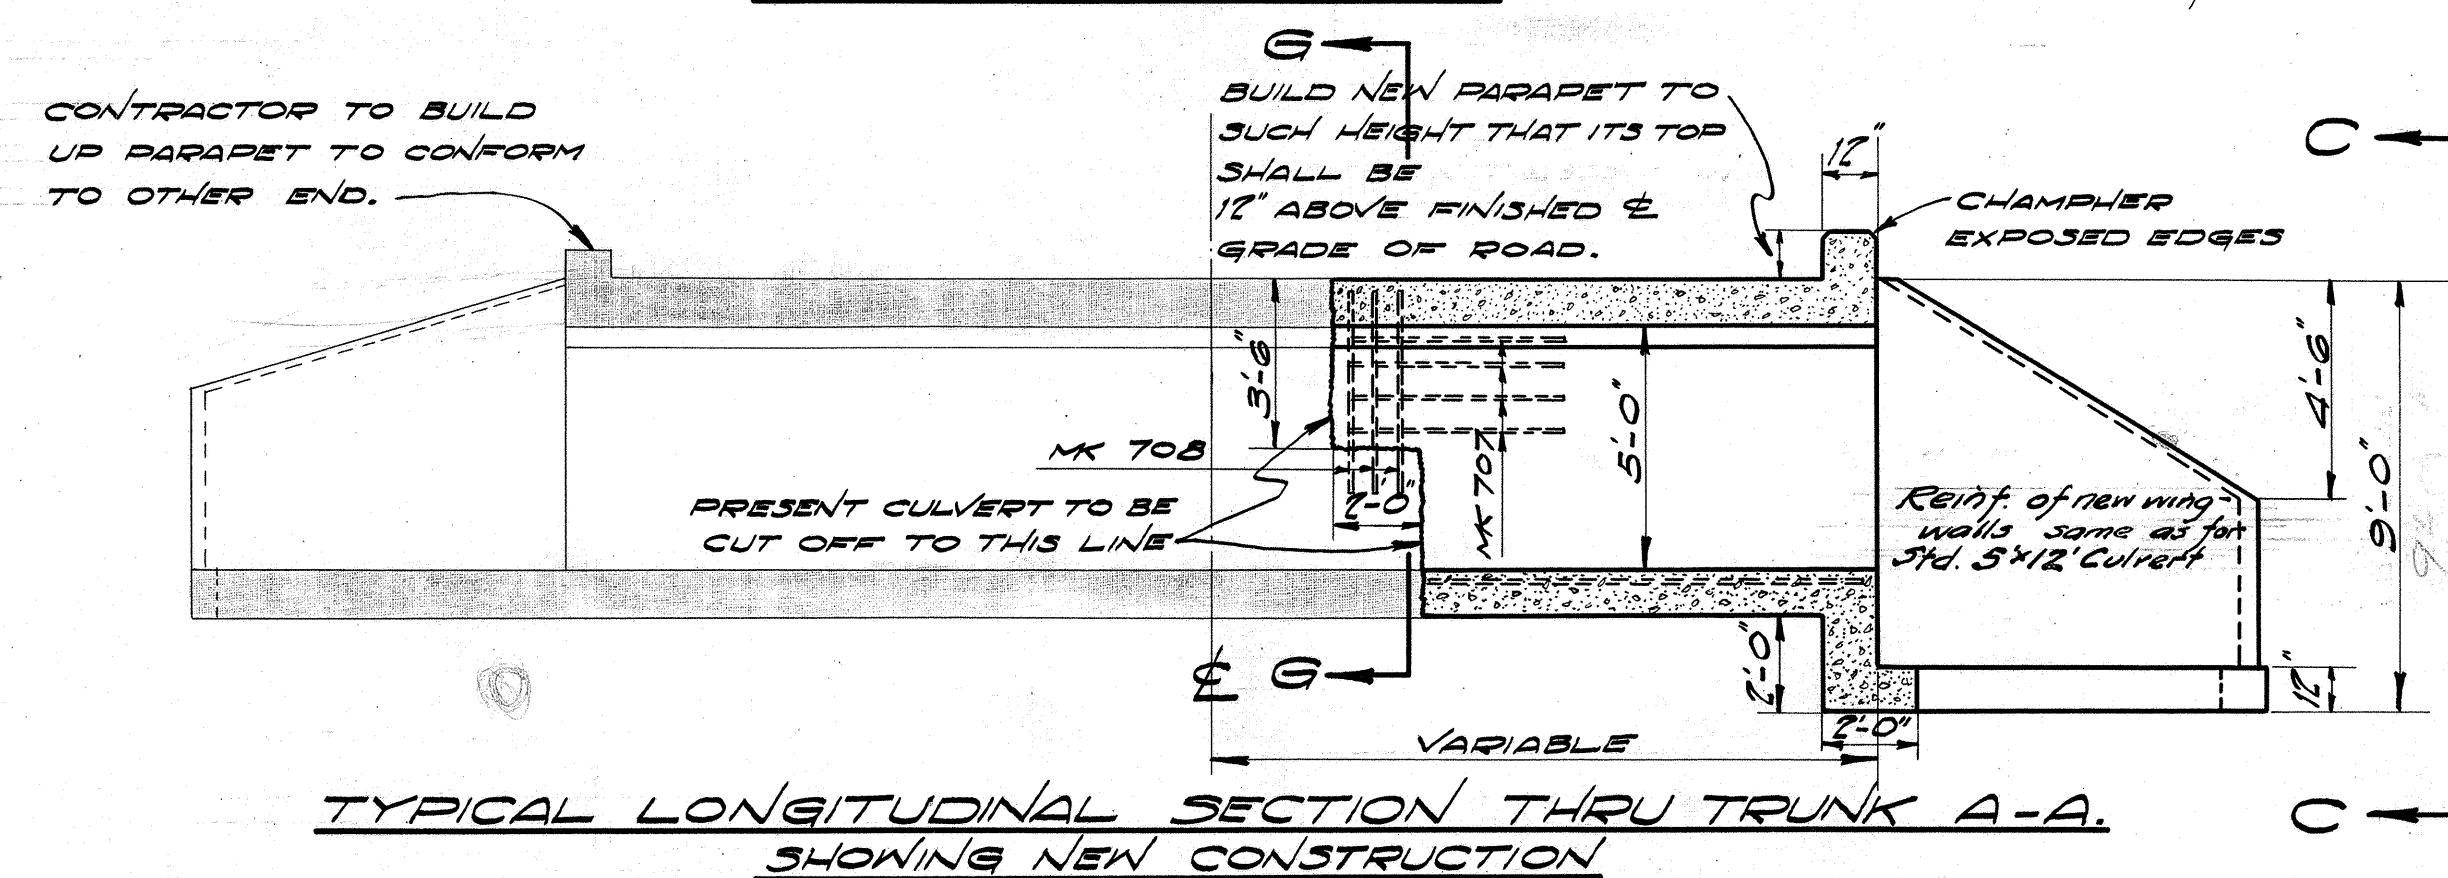
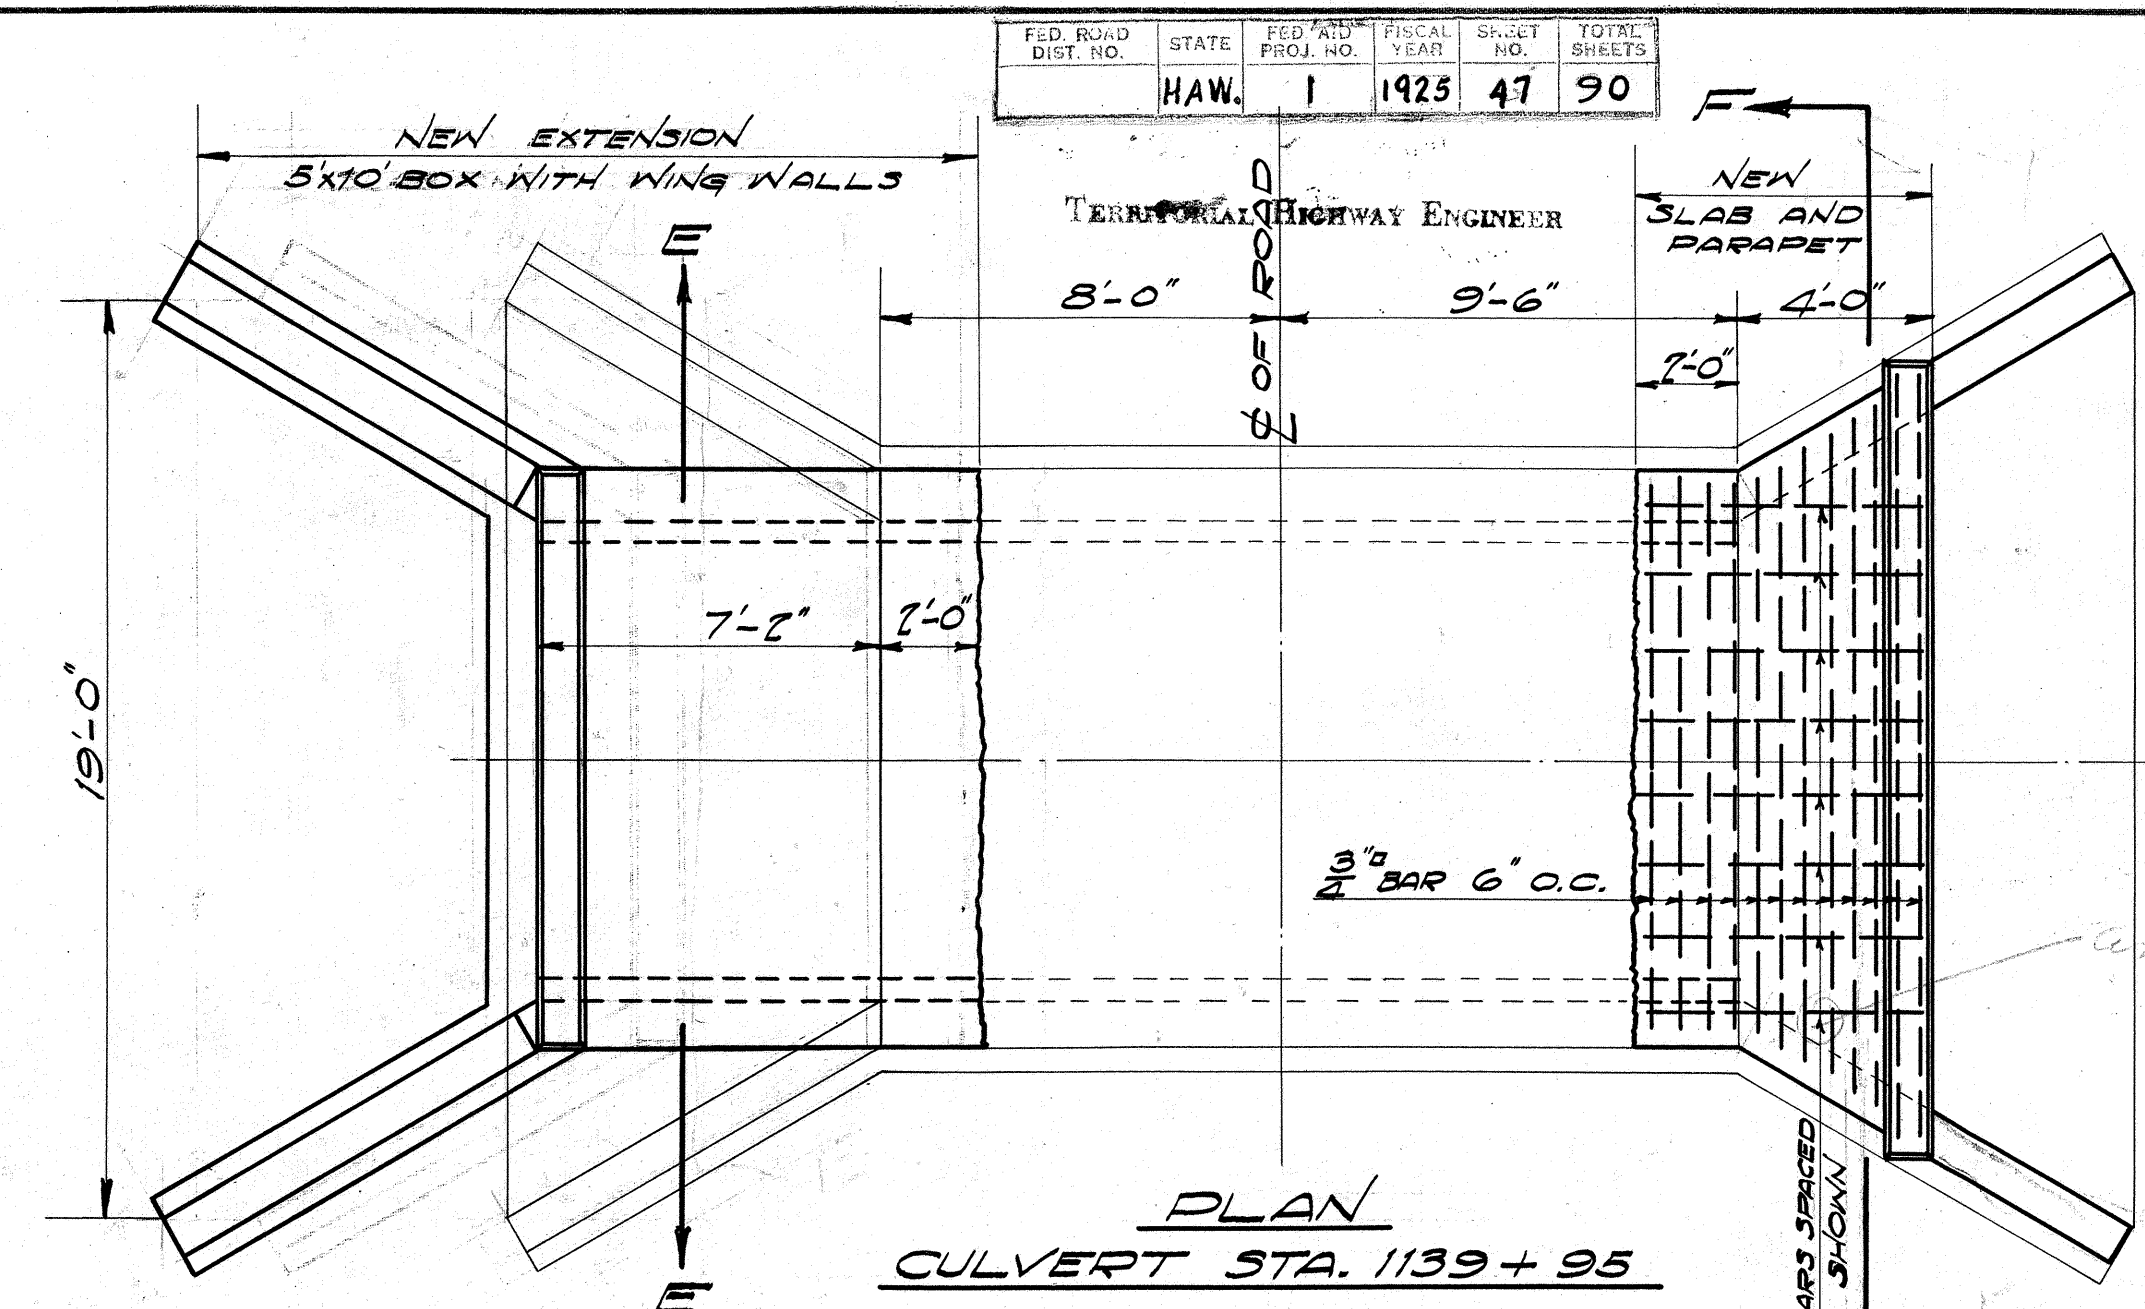
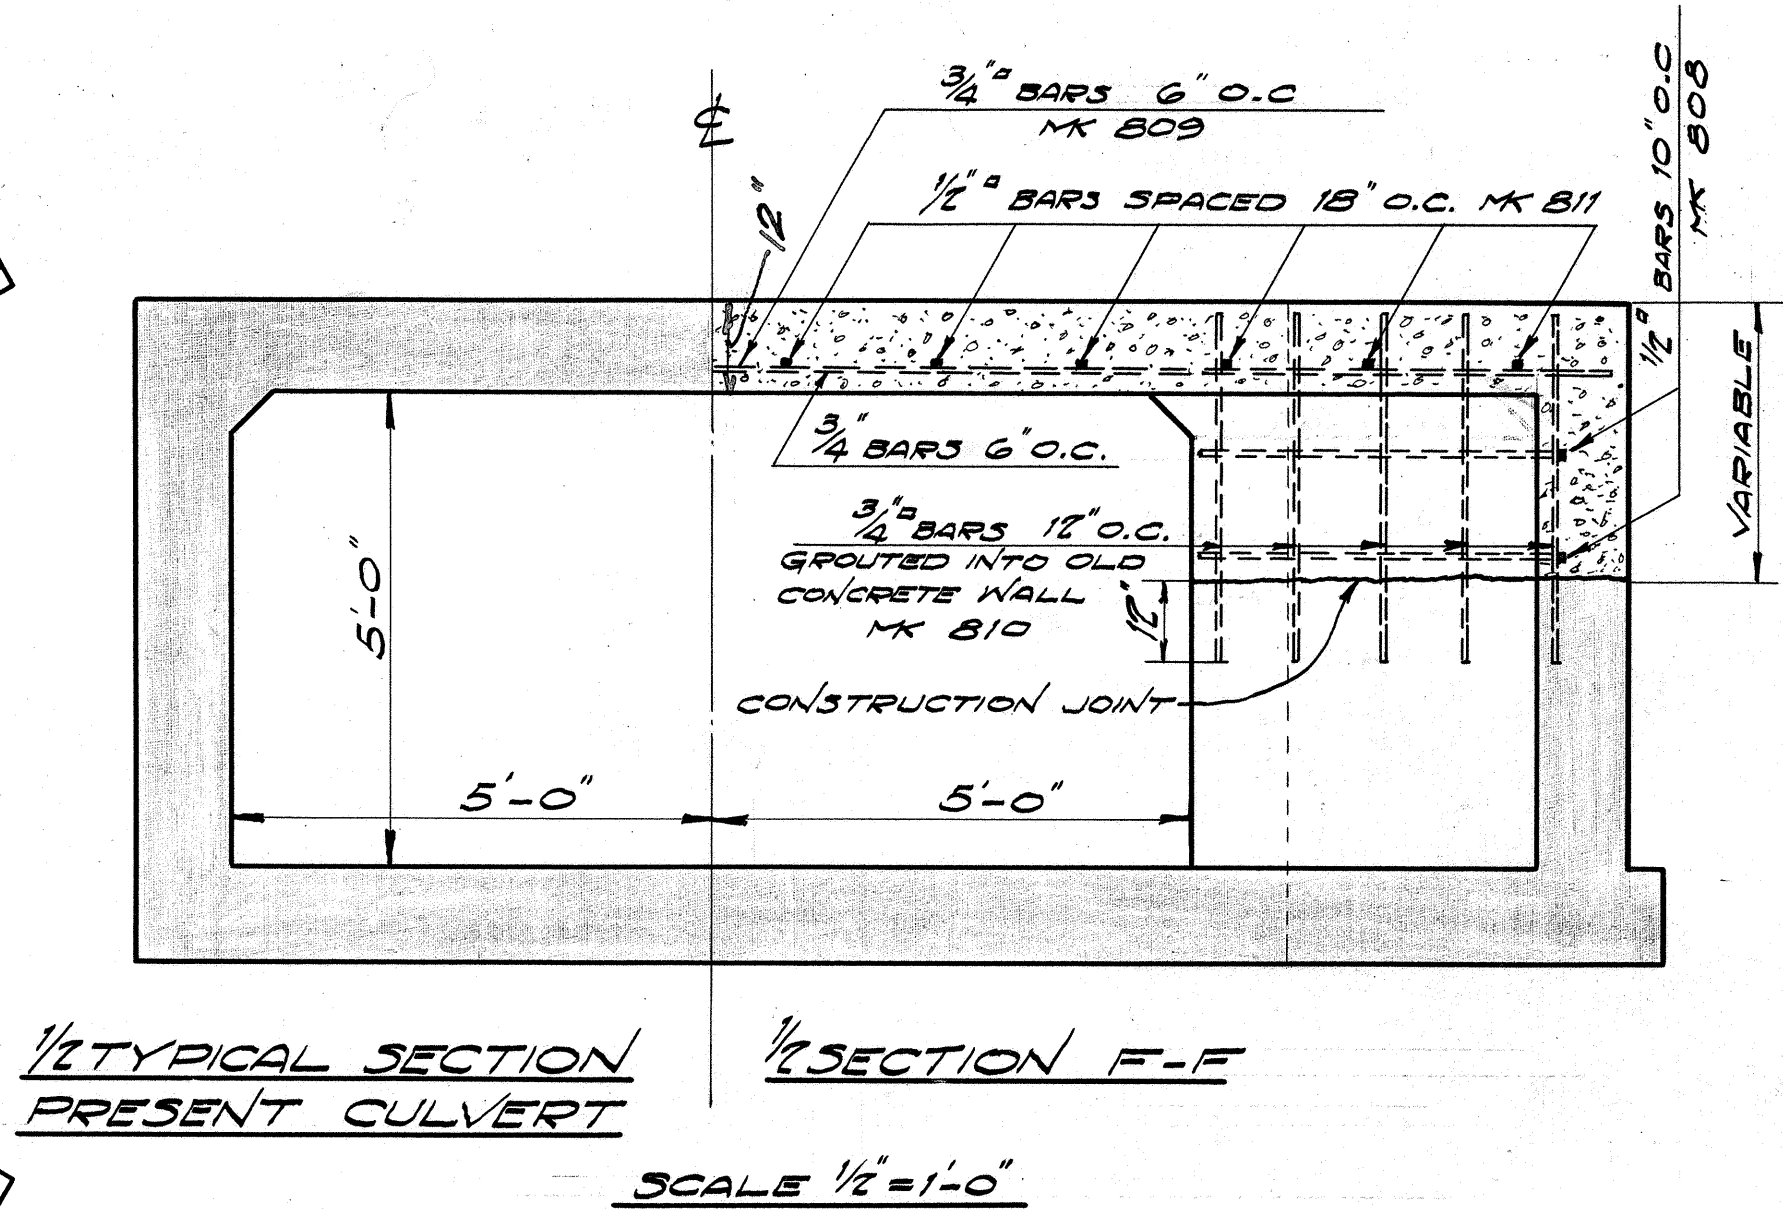
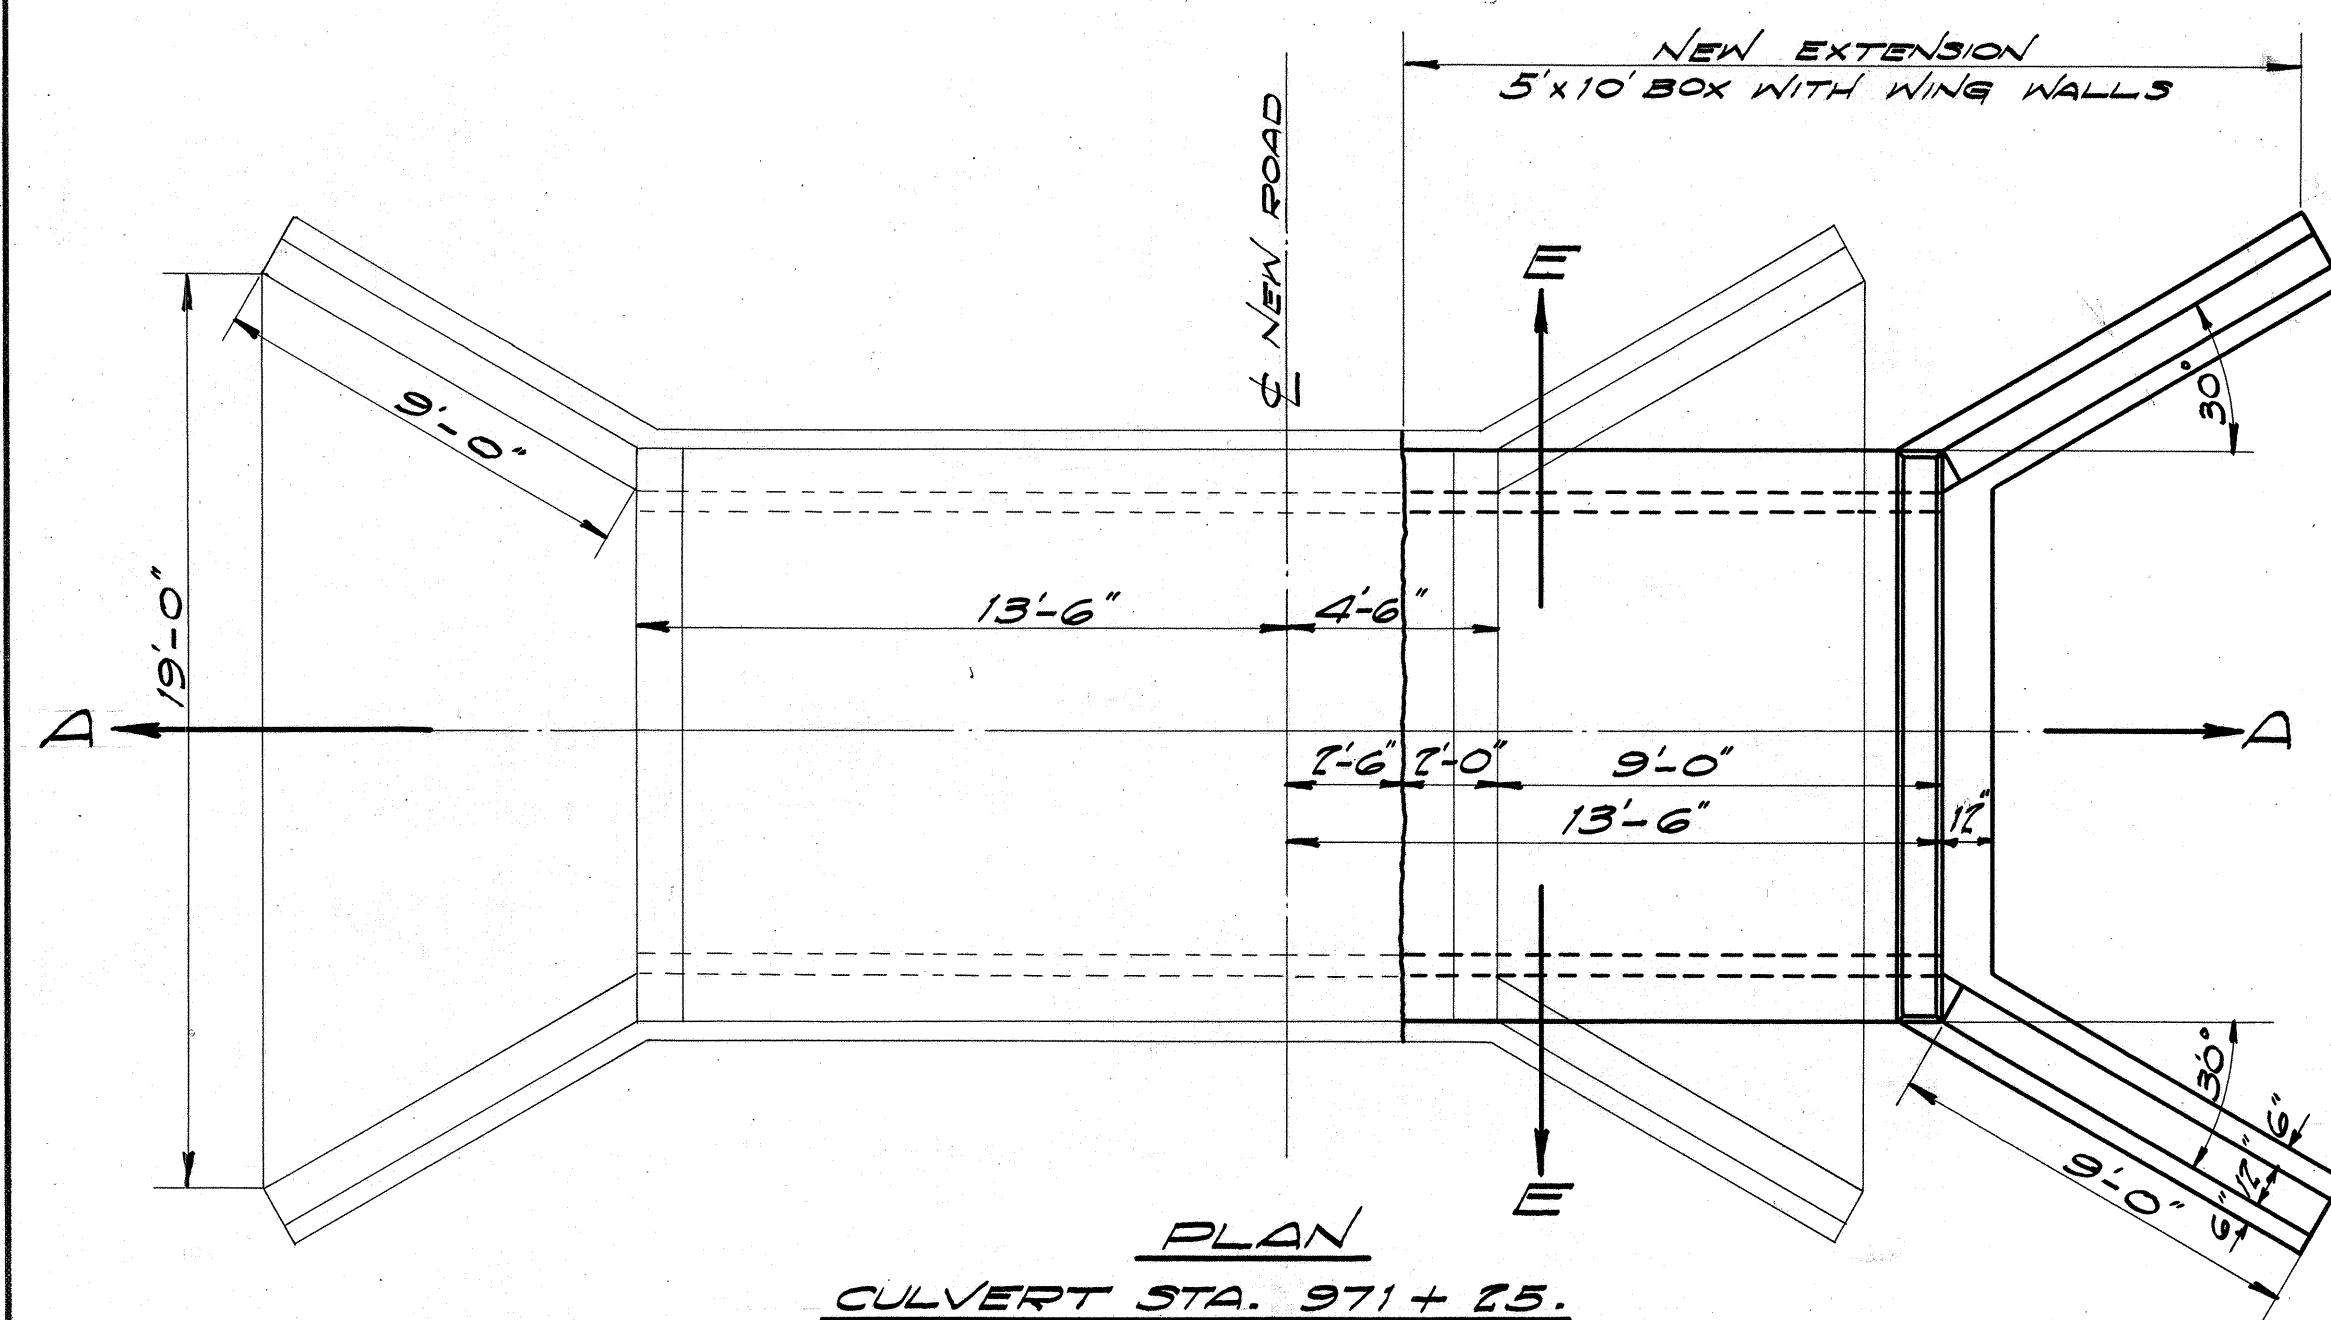
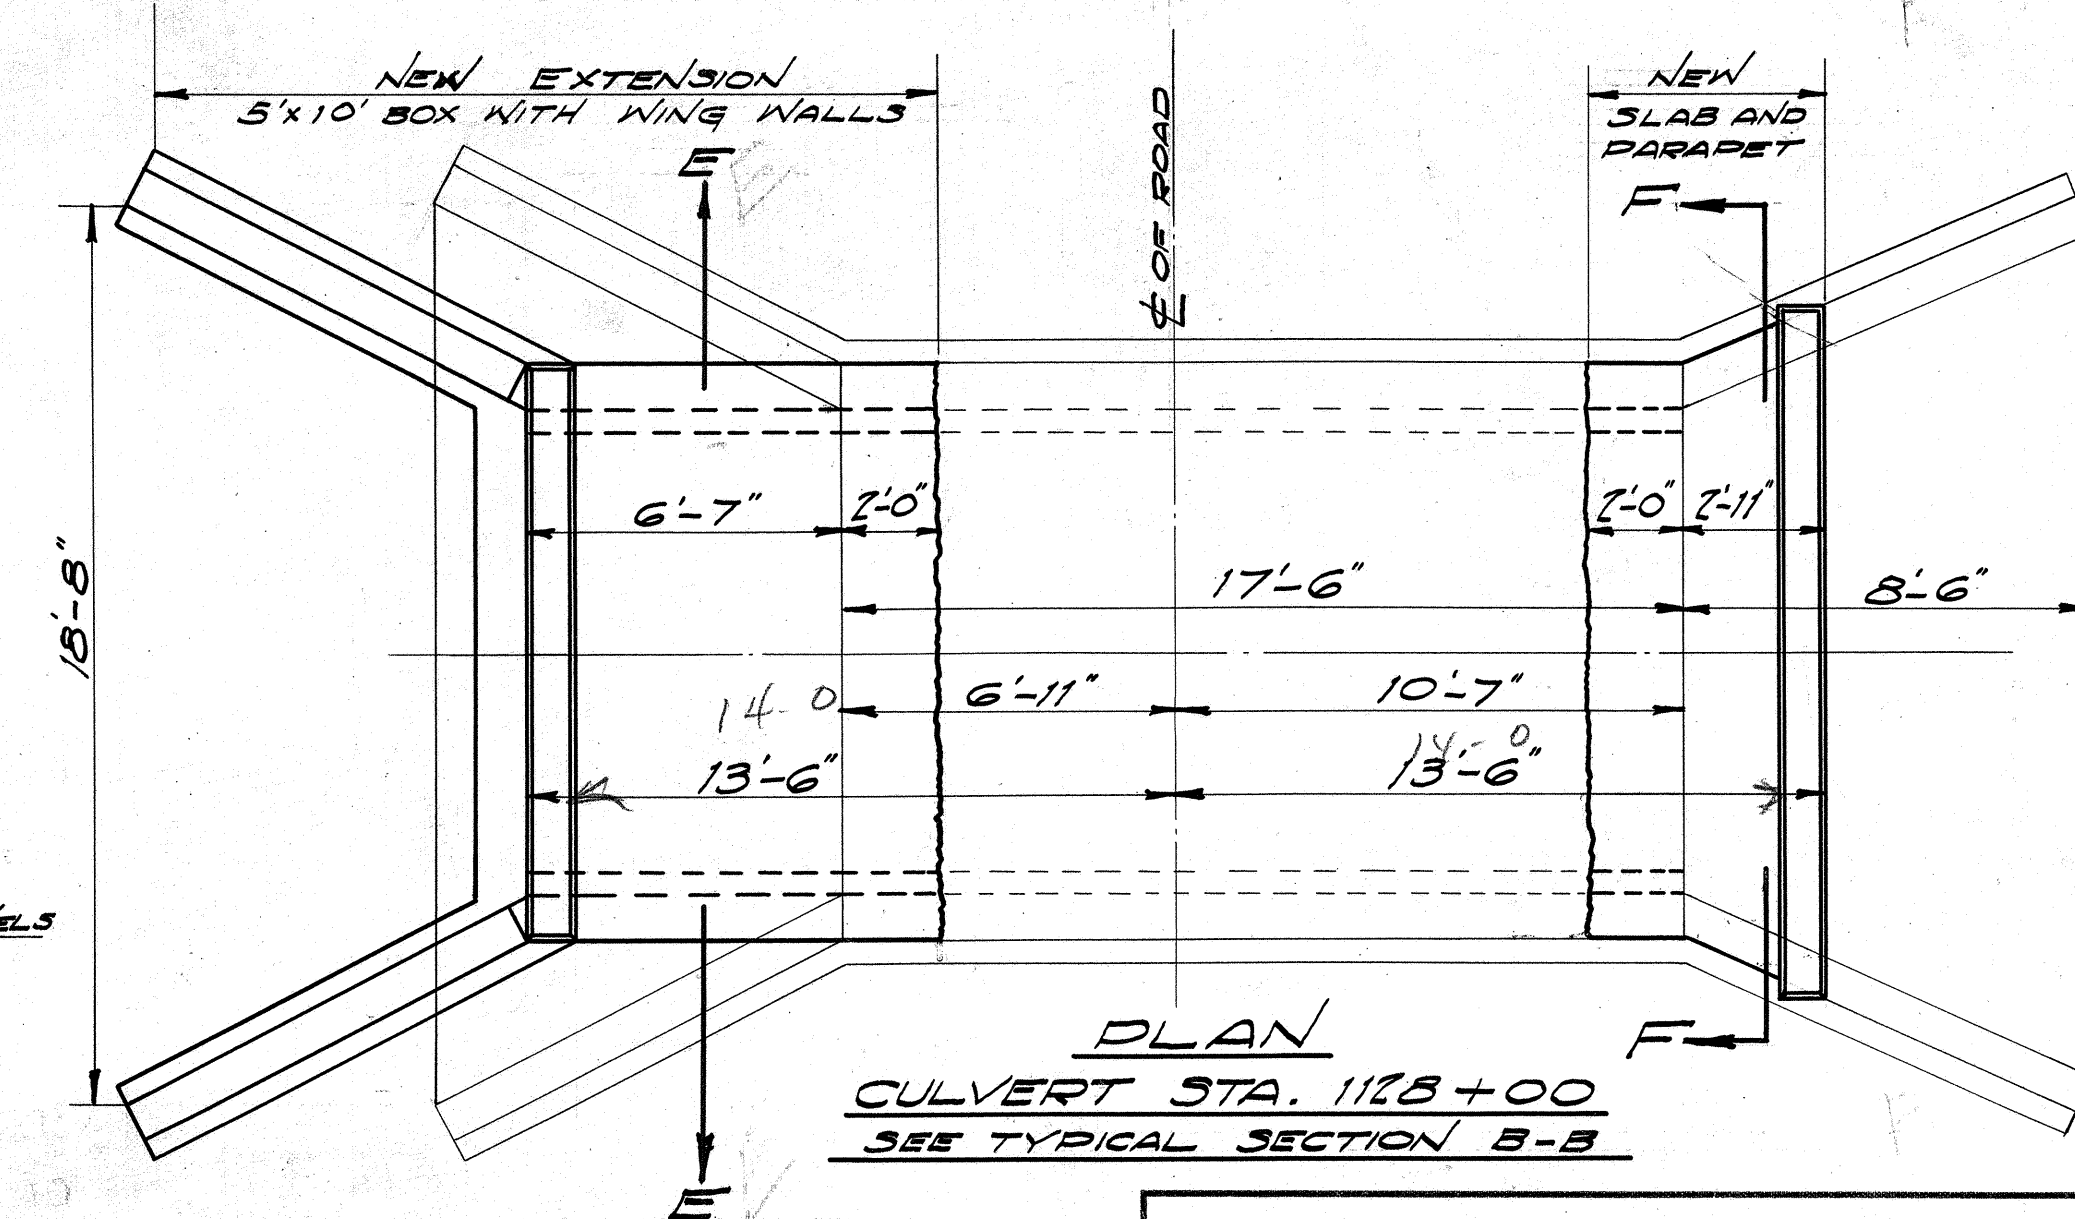
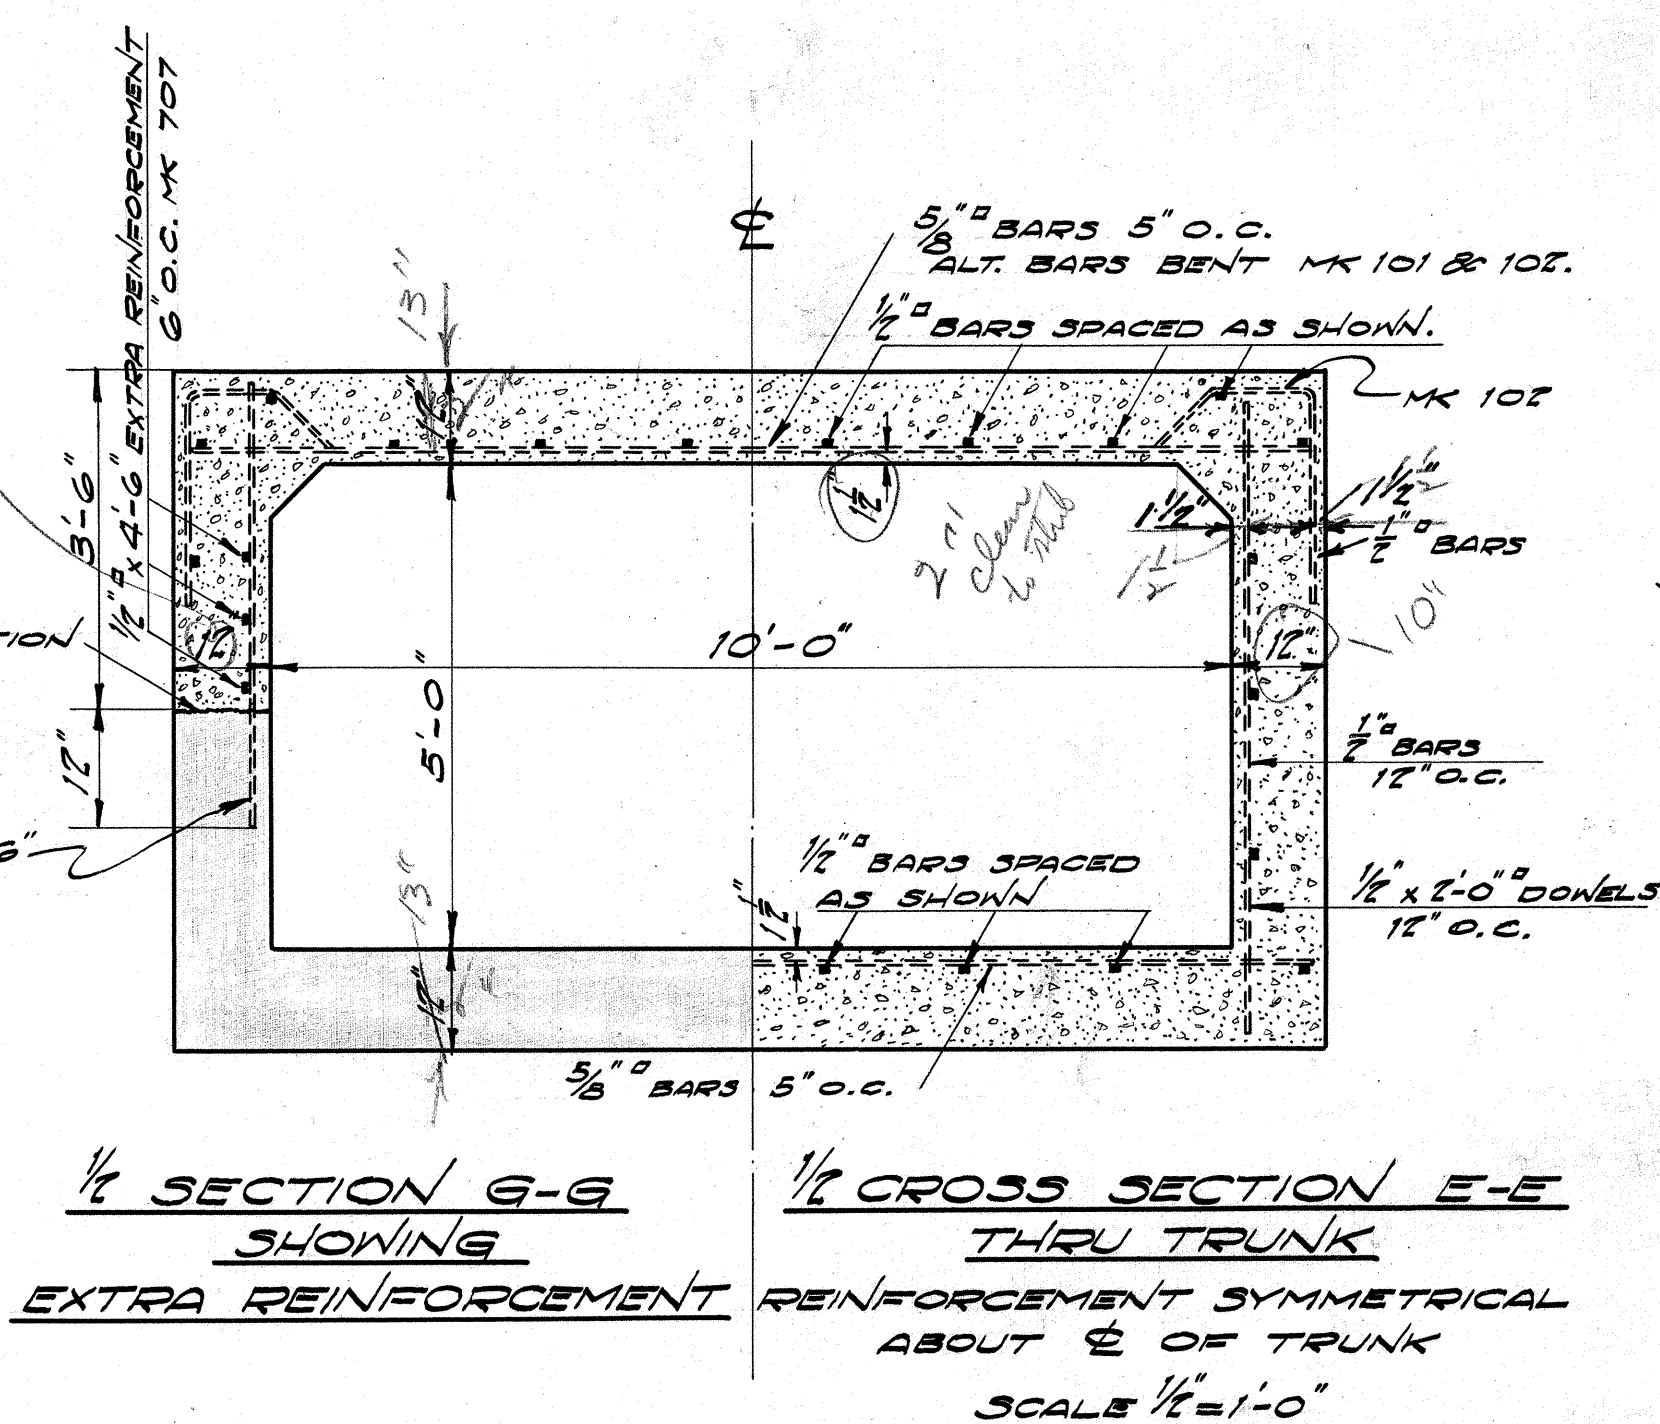
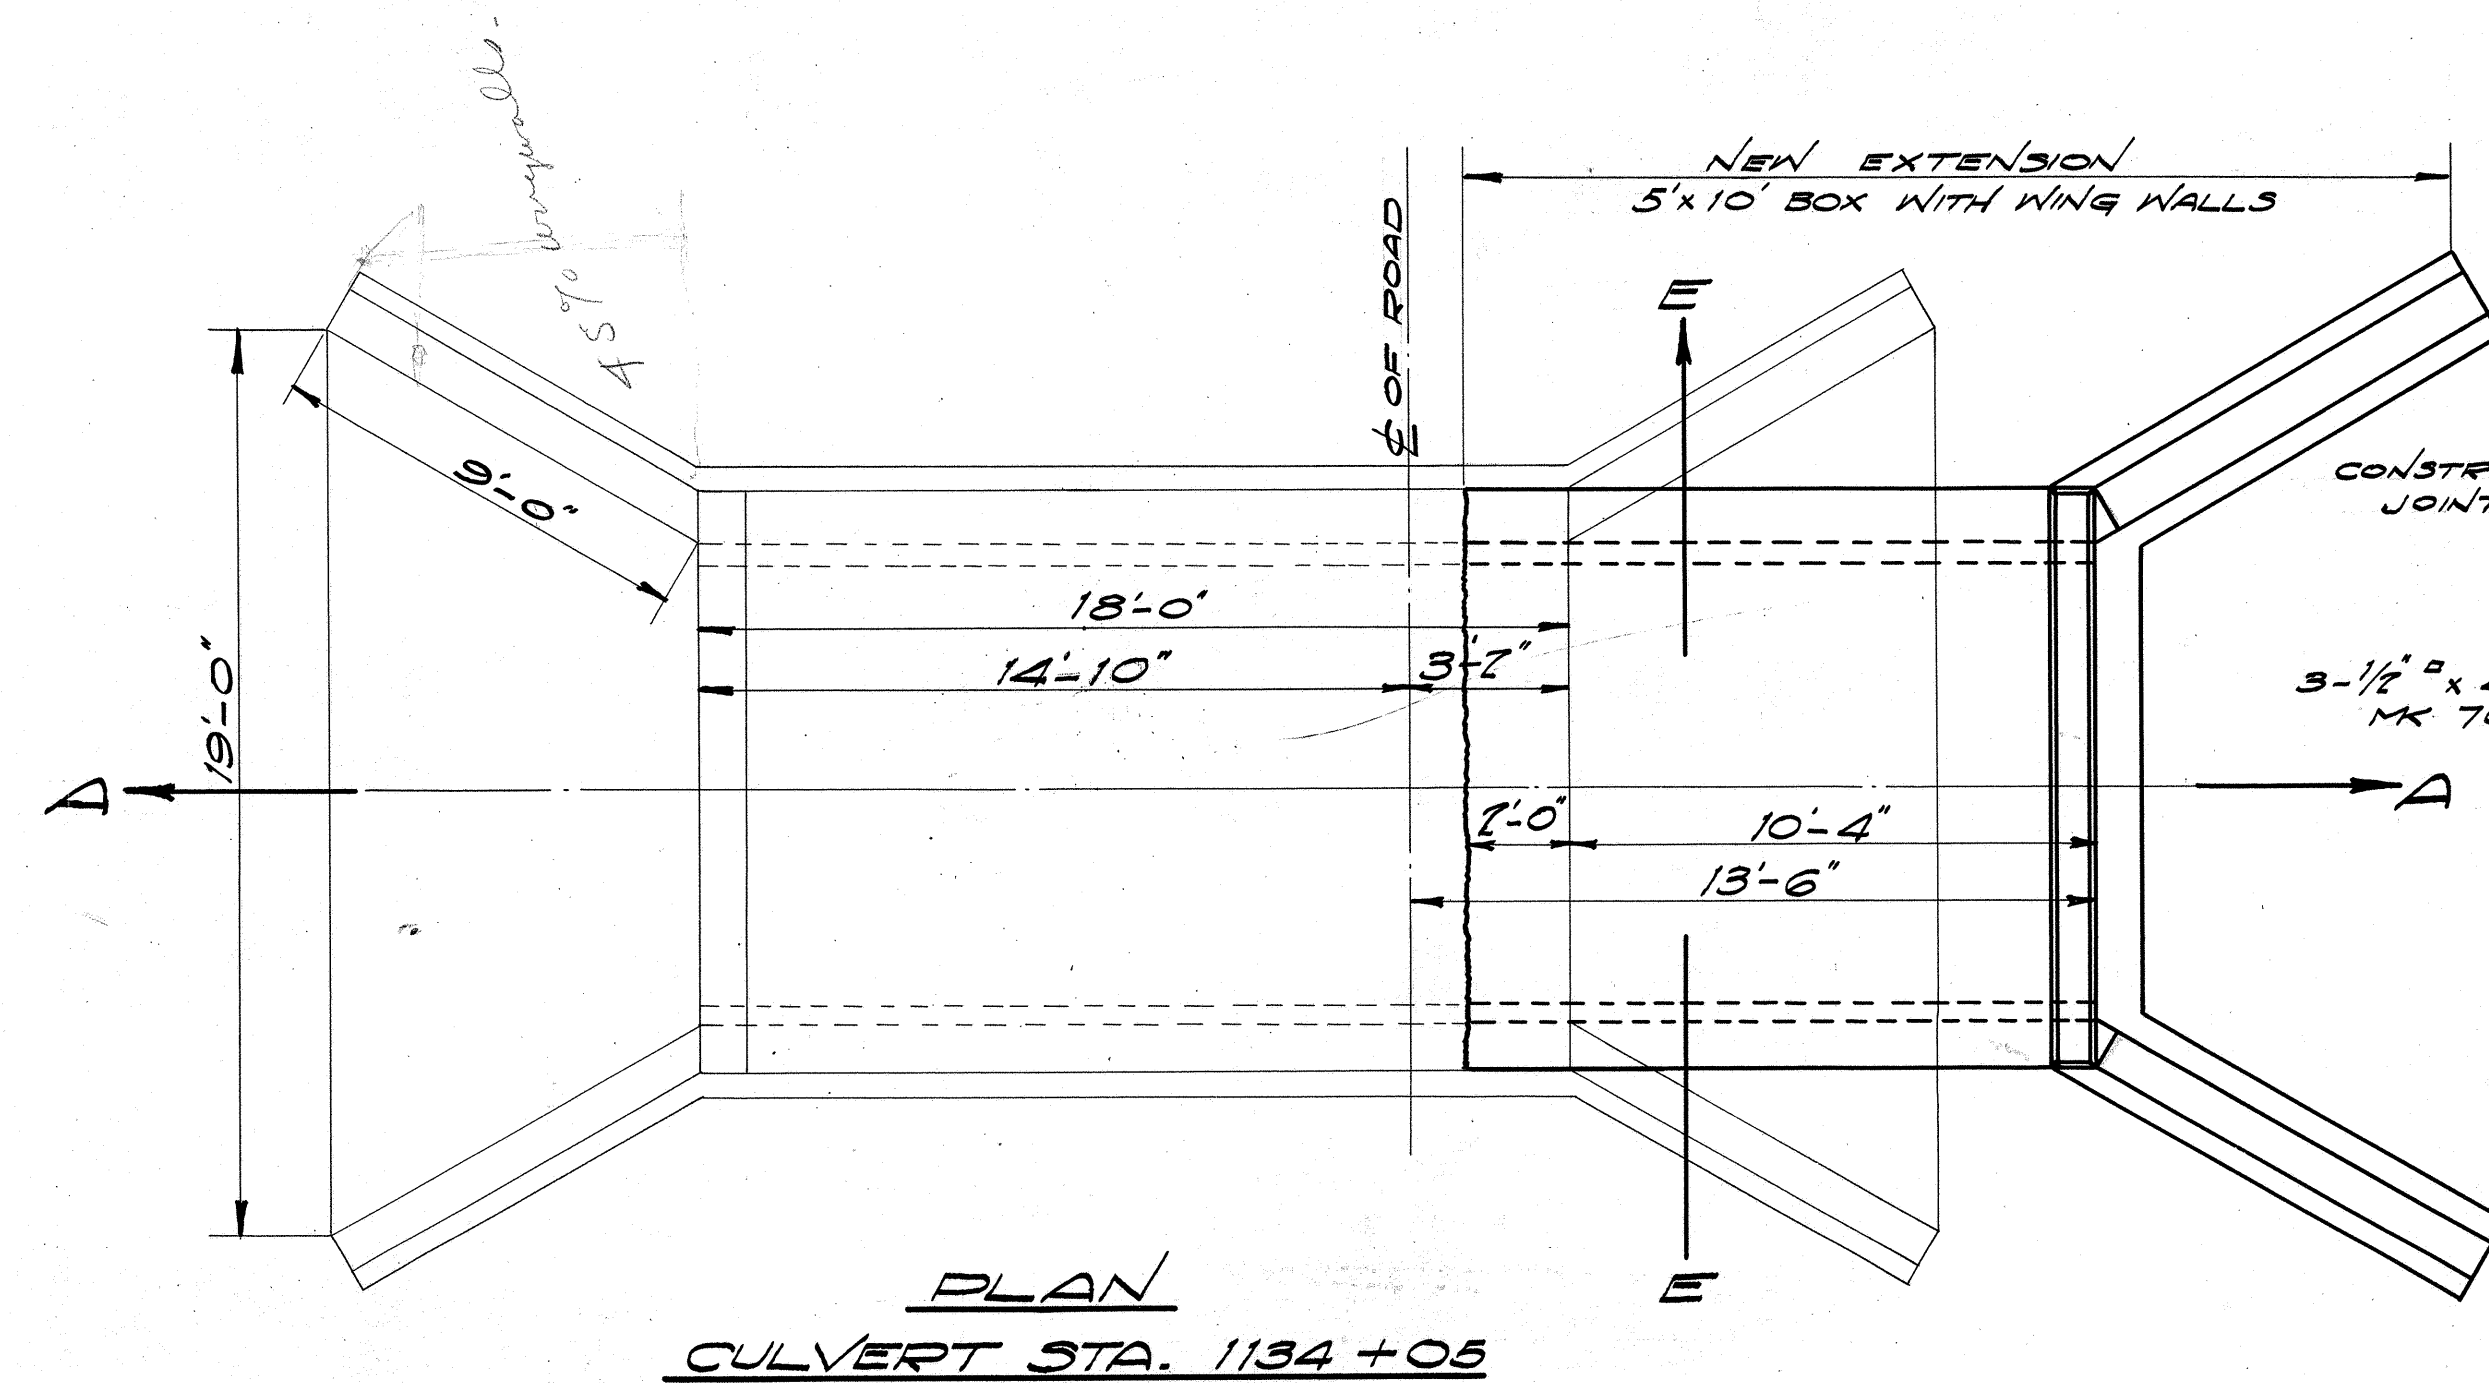


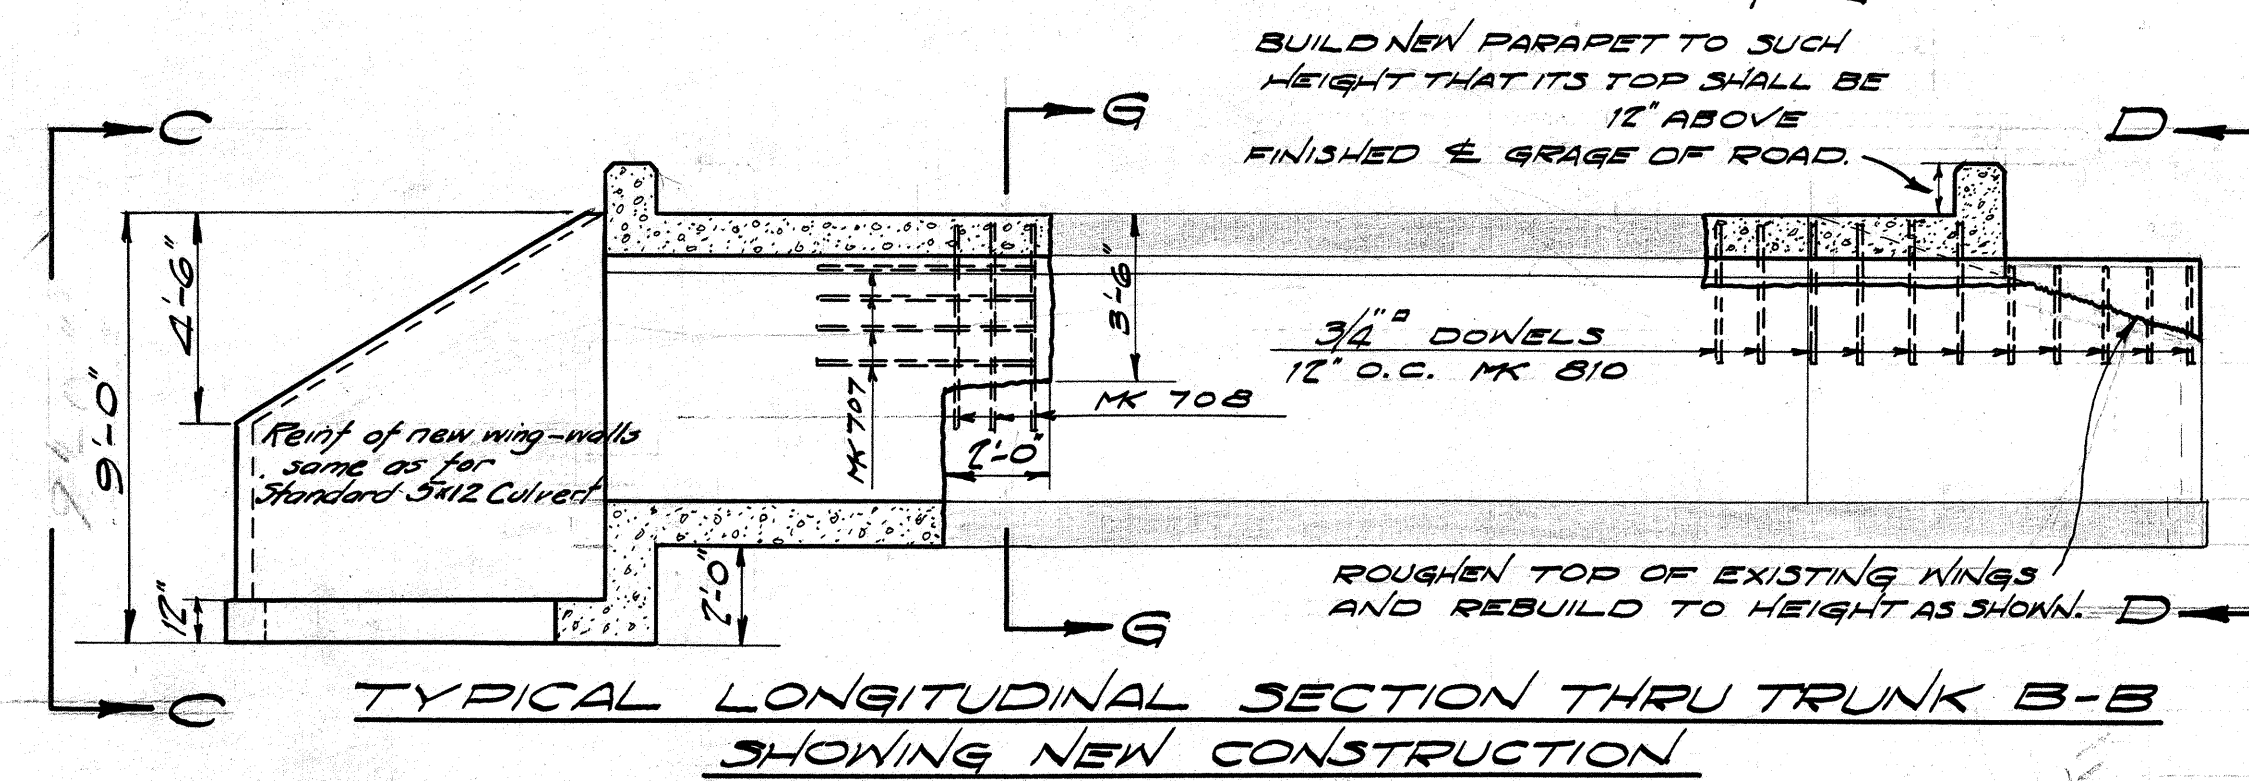

NOTE :- HEAVY LINES DENOTE NEW CONSTRUCTION.
LIGHT LINES DENOTE PRESENT CONSTRUCTION
FOR REINFORCEMENT SEE 1/2" SCALE SECTION.

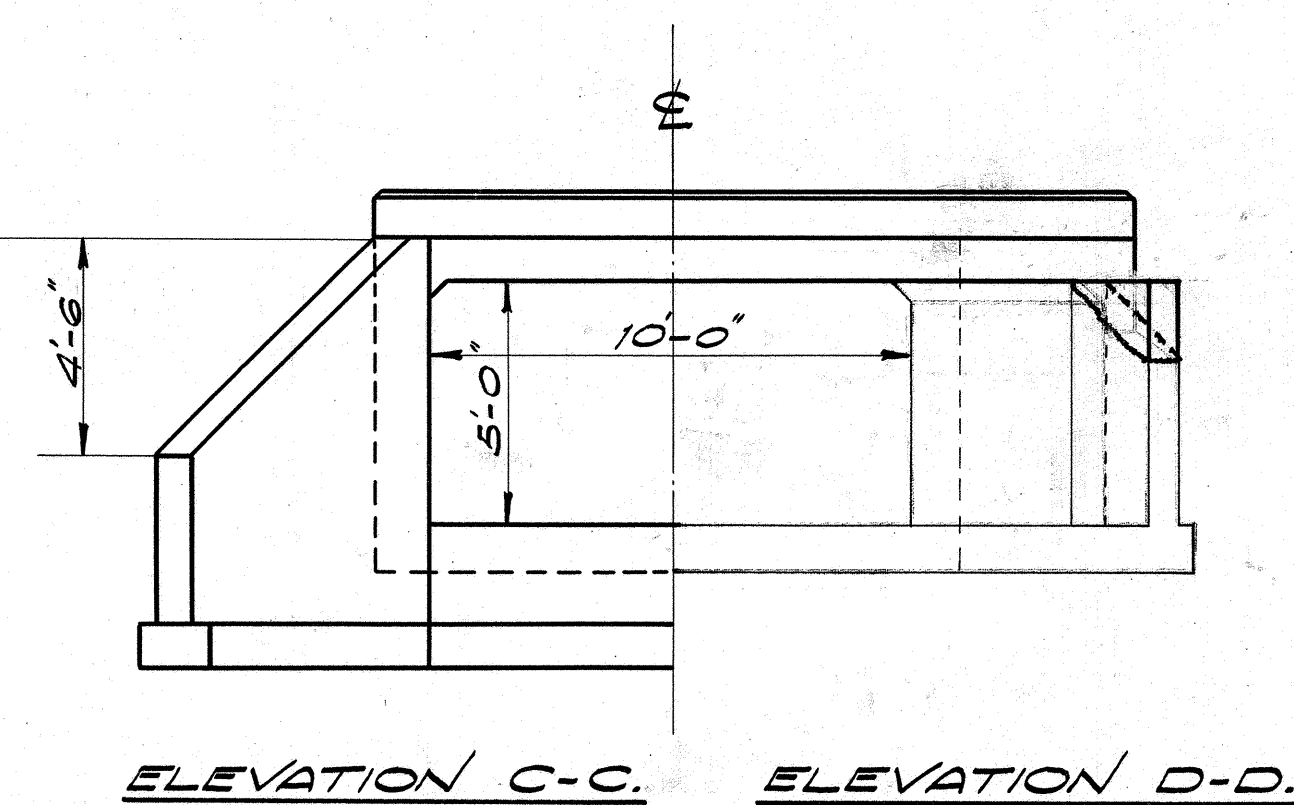

CLASS A CONCRETE
82 CU. YDS. FOR 4 CULVERTS

OFFICE OF THE CITY & COUNTY ENGINEER
HONOLULU, HAWAII
KAMEHAMEHA HIGHWAY
PROJECT I
EXTENSIONS
5' x 10' CULVERTS

ENGINEER G.K.L. - S.L.W. DATE _____
DRAFTSMAN S.L.W. - D.A.A. CHECKED BY S.L.W.
SCALE As Noted
APPROVED: _____
CITY & COUNTY ENGINEER

3076.47