


INDEX TO DRAWINGS.	
SHEET NO.	DESCRIPTION.
1	TITLE SHEET.
2	TYPICAL ROAD SECTION.
3-43	PLANS AND PROFILES.
44	STD DETAILS (FENCE, GUARDRAIL, DITCH SECTION DROP INTAKES, CATCH BASINS, HEADWALLS FOR CONCRETE PIPES)
45	STD DETAILS FOR 5'x12' CONCRETE BOX CULVERTS.
46	STD DETAILS FOR 4'x10' CONCRETE BOX CULVERTS.
47	EXTENSIONS TO EXISTING 5'x10' CONCRETE BOX CULVERTS DETAILS.
48	STD DETAILS FOR CONCRETE BRIDGES.
49	BRIDGE NO. 5 DETAILS.
50-52	BRIDGE NO. 6 ABUTMENTS, PLAN, PROFILE AND CROSS SECTIONS NEW CHANNEL.
53	BRIDGE NO. 7 DETAILS.
54-55	BRIDGE NO. 8 DETAILS.
56-60	BRIDGES NOS. 9-10-11-12-13. DETAILS.
61-90	CROSS SECTIONS.

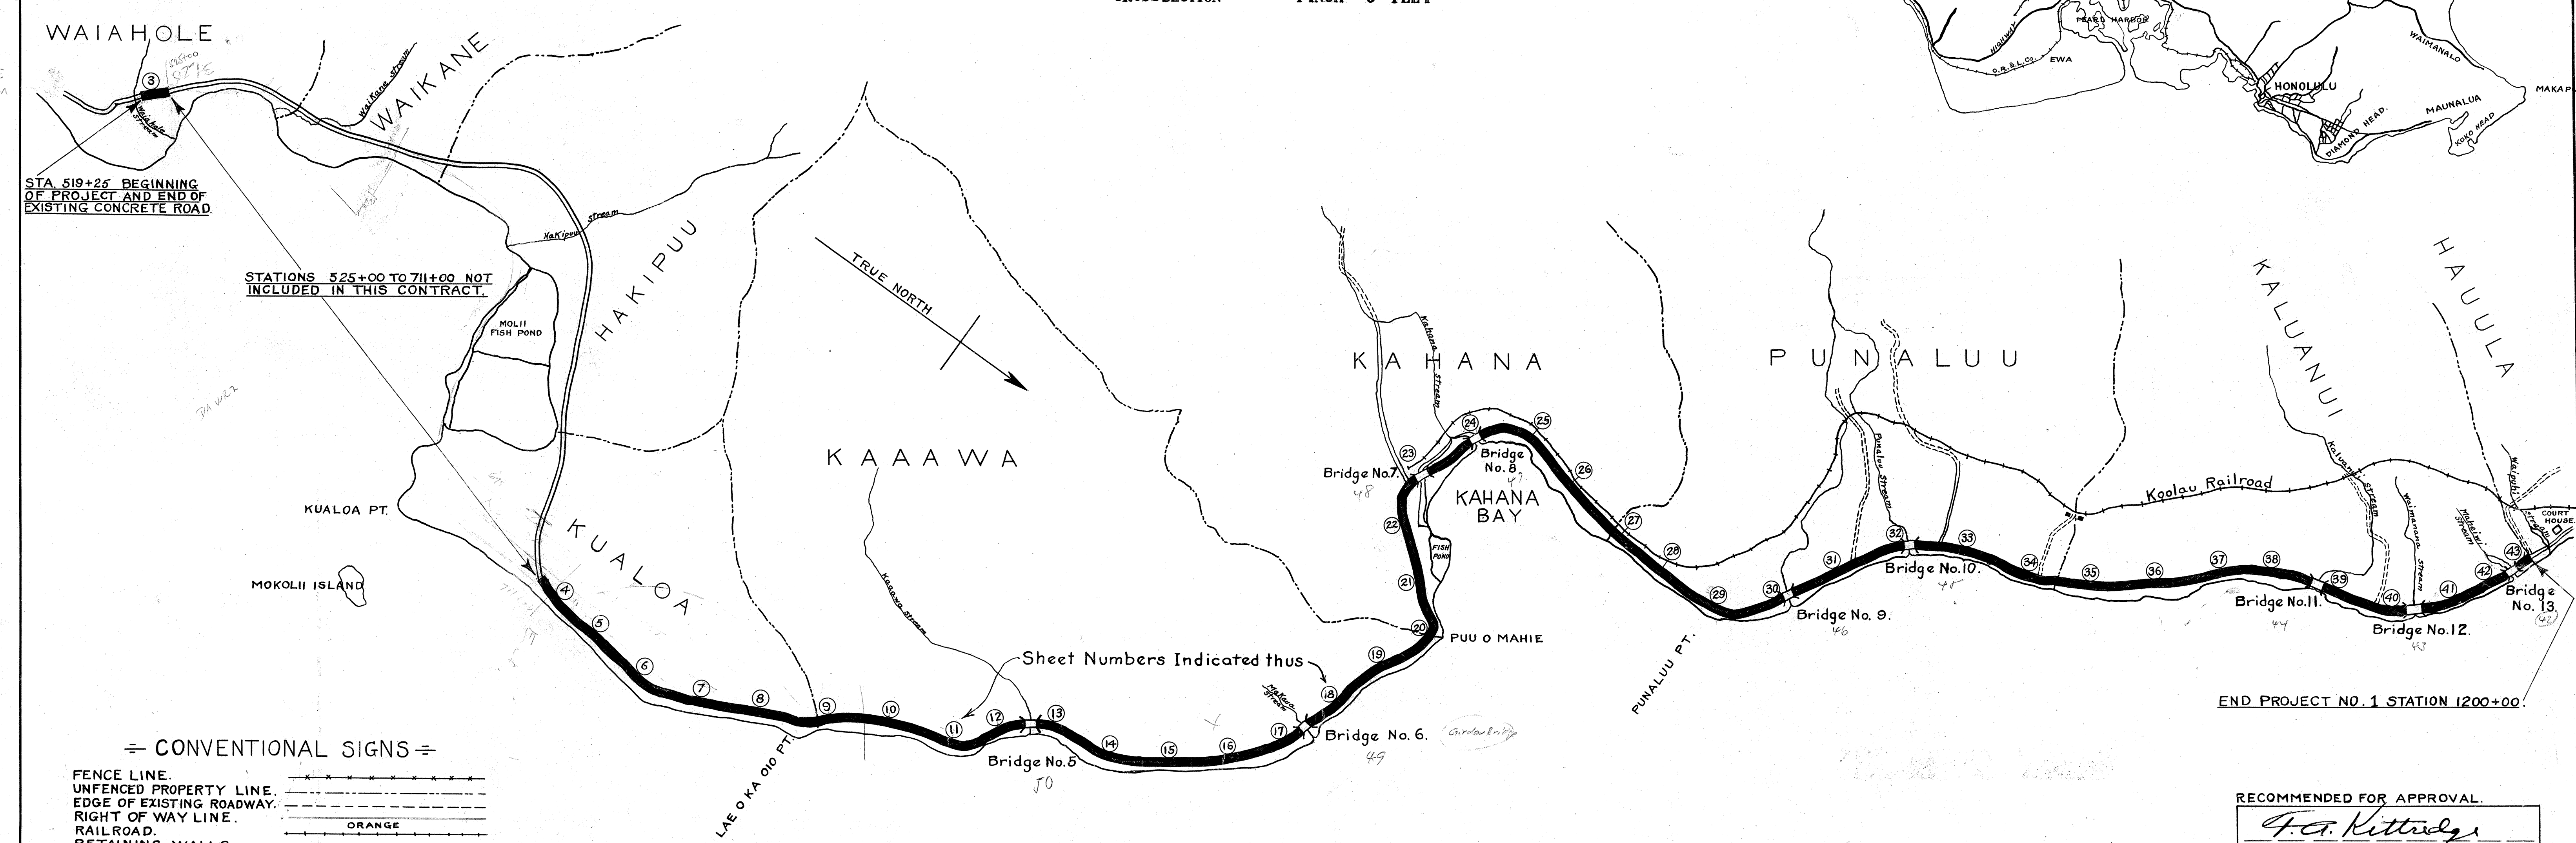

≡ CONVENTIONAL SIGNS ≡

FENCE LINE.	----
UNFENCED PROPERTY LINE.	----
EDGE OF EXISTING ROADWAY.	----
RIGHT OF WAY LINE.	----
RAILROAD.	----
RETAINING WALLS.	----
CULVERTS.	----
EXISTING CULVERT.	----
STONE WALL FENCE OR EXISTING	----
DRY RUBBLE RETAINING WALLS	----
DITCHES.	----

NOTE.
Elevations refer to Mean Tide, City Datum.
Tide ranges from about -1.0' to +2.0'

Exceptions.
Bridges #5 to #13 over 20 ft long = 761 ft. = 0.145 miles.
Existing Road not included in this Project = 3.522 " "
Total Exceptions = 3.667 " "

LAYOUT OF PROJECT

Scale 1 inch = 1500 feet.

GROSS LENGTH	12.893 MILES
EXCEPTIONS	3.667 " "
NET LENGTH	9.226 " "

TERRITORY OF HAWAII.
TERRITORIAL HIGHWAY DEPARTMENT.
HONOLULU, T.H.


PLANS OF KAMEHAMEHA HIGHWAY

FEDERAL AID PROJECT NO.1
KOOLAULOA AND KOOLAUPOKO DISTRICTS.
OAHU, T.H.

IN ACCORDANCE WITH ITEM 27, ACT 214, S.L. HAW. 1923

SCALE

PLAN		1 INCH = 40 FEET
HOR.		1 INCH = 40 FEET
PROFILE		1 INCH = 4 FEET
VER.		1 INCH = 5 FEET
CROSS SECTION		

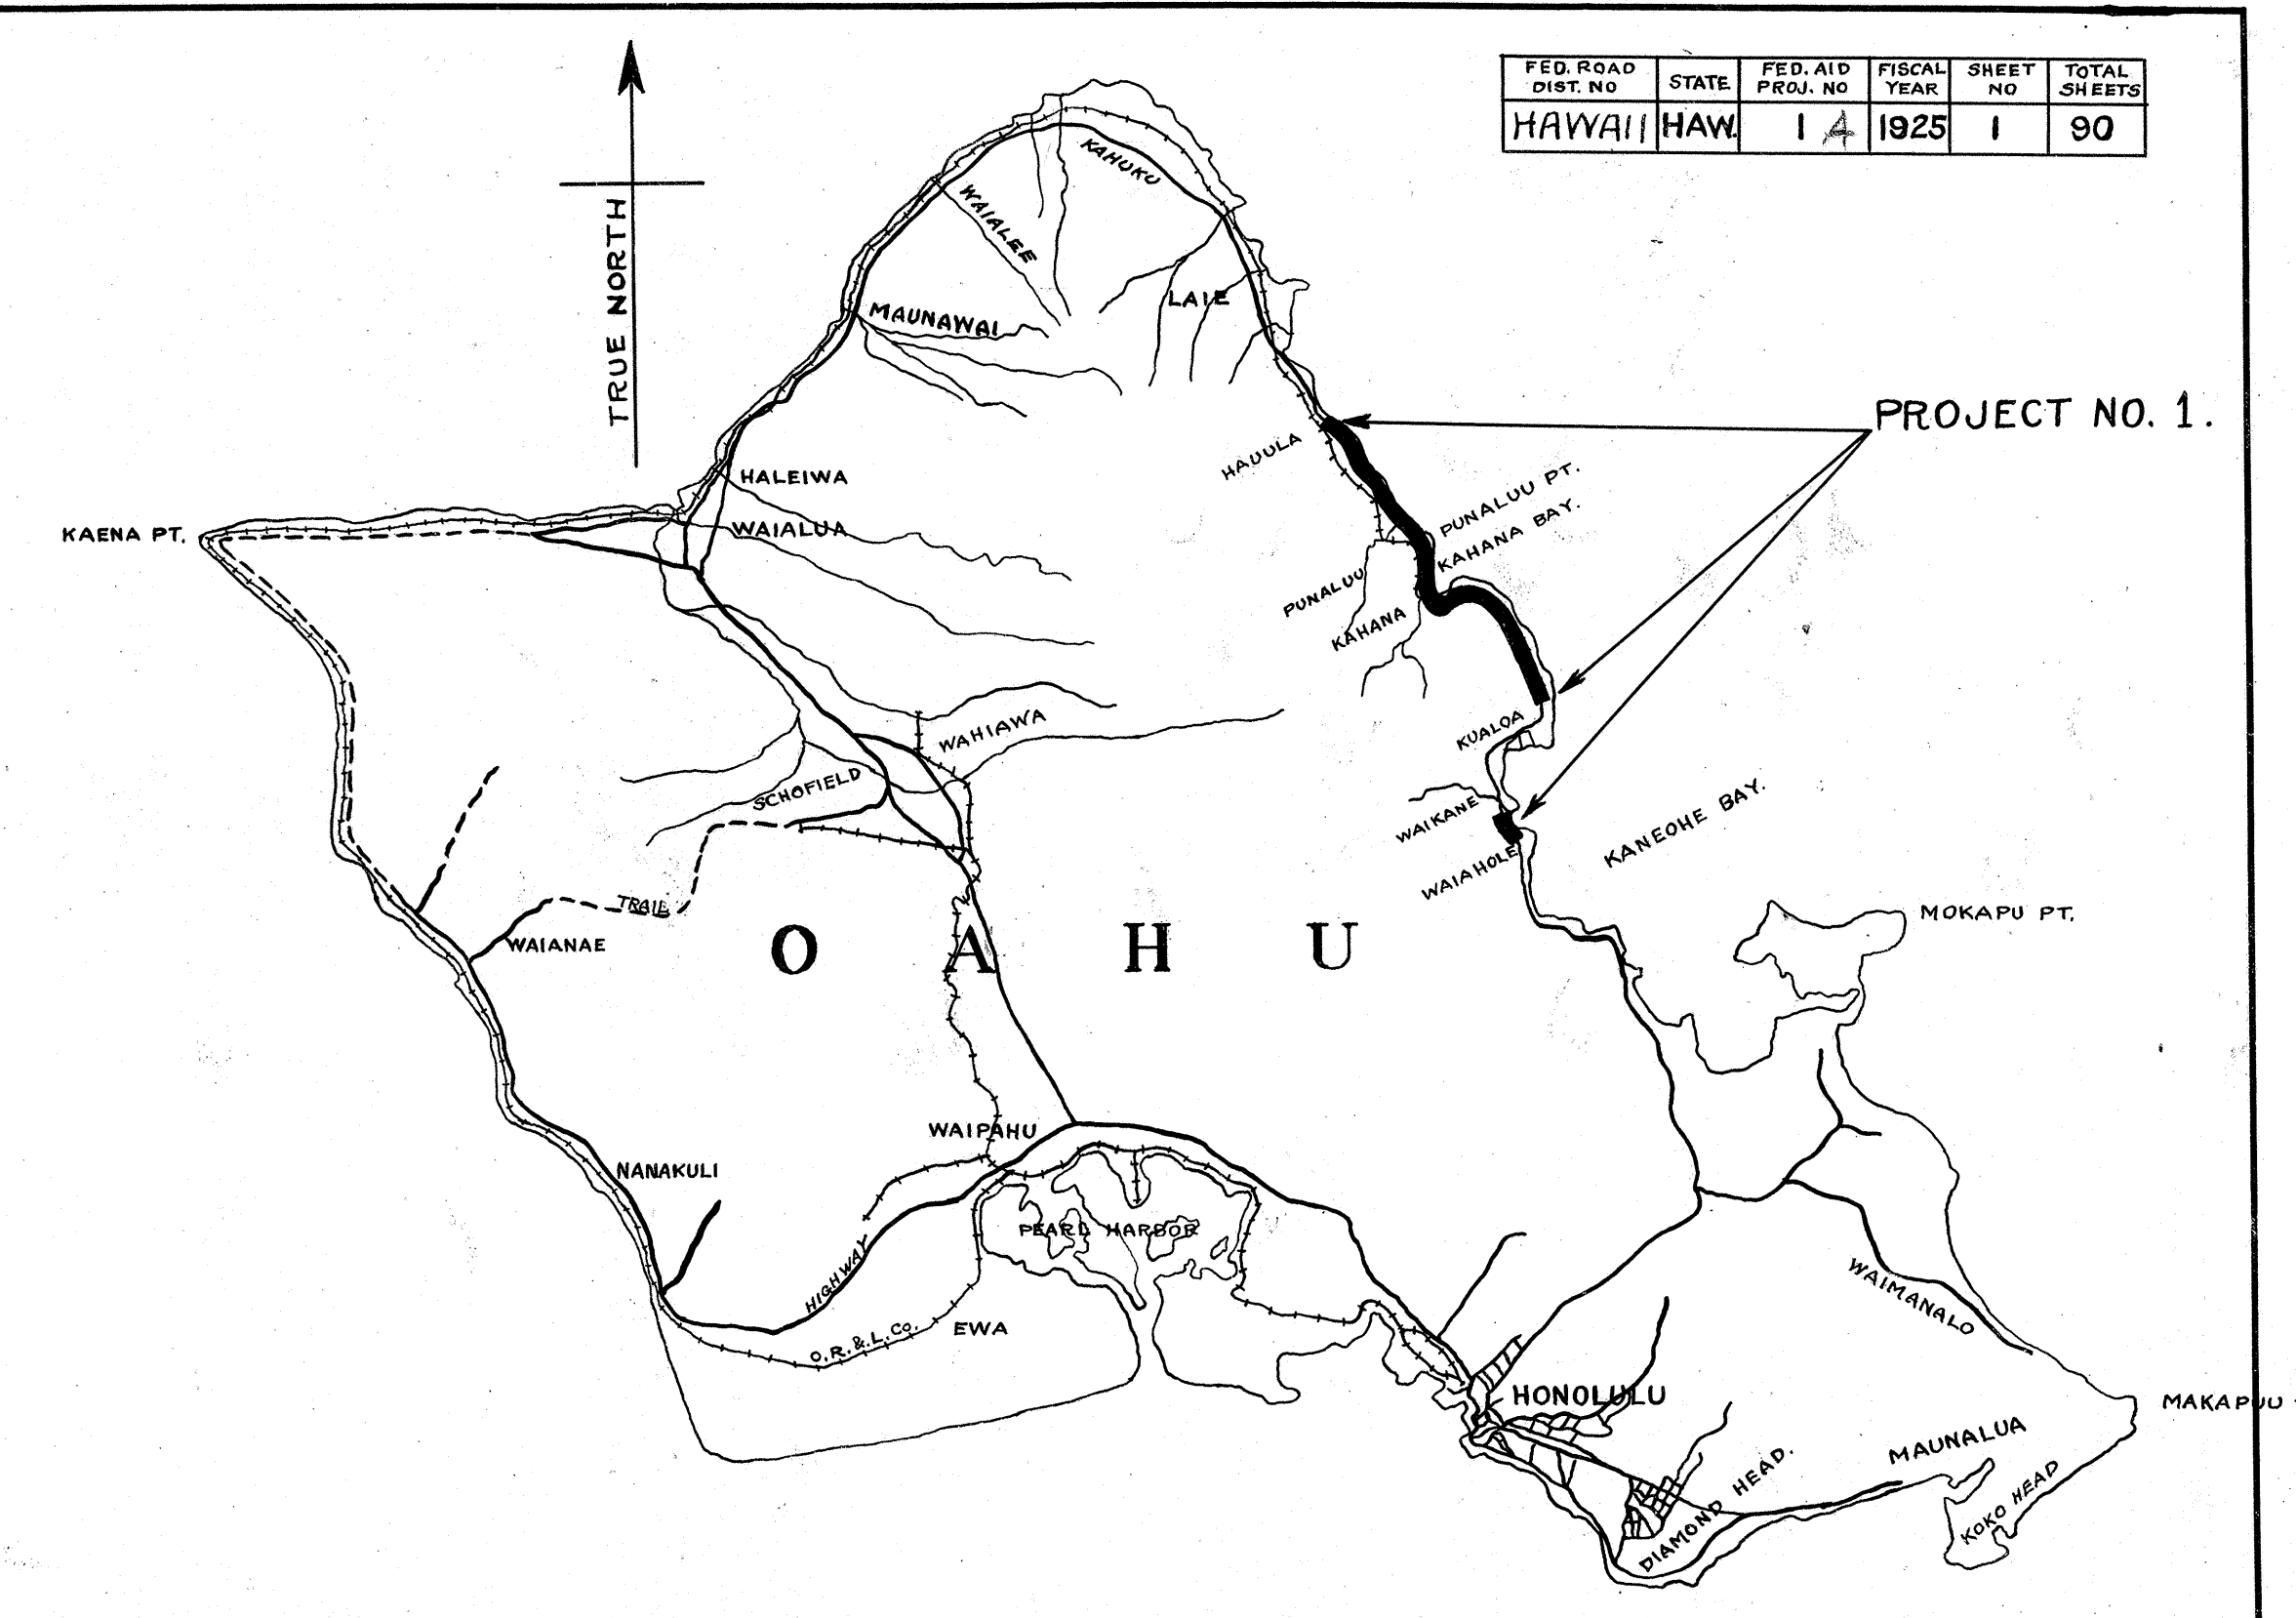

FED. ROAD DIST. NO.	STATE	FED. AID PROJ. NO.	FISCAL YEAR	SHEET NO.	TOTAL SHEETS
HAWAII	HAW	14	1925	1	90

RECOMMENDED FOR APPROVAL.

F. A. Kittredge
Sept. 24, 1925.
DISTRICT ENGINEER, Bureau of Public Roads.

RECOMMENDED FOR APPROVAL.

CHIEF ENGINEER, Bureau of Public Roads.

APPROVED.

James H. Bigelow
Sept. 24, 1925.
TERRITORIAL HIGHWAY ENGINEER.

APPROVED.

DIRECTOR, Bureau of Public Roads.

3076.1