

INDEX TO DRAWINGS	
SHEET NO.	DESCRIPTION
1	TITLE SHEET.
2	TYPICAL ROAD SECTION
3-17	PLANS AND PROFILES
18	STANDARD DETAILS
19	BOX CULVERTS
20-21	BRIDGE NO 1
22	BRIDGE NO 2
23-33	ROAD CROSS-SECTIONS.

TERRITORY OF HAWAII.
TERRITORIAL HIGHWAY DEPARTMENT
HONOLULU T.H.

PLANS OF
KAMEHAMEHA HIGHWAY
FEDERAL AID PROJECT NO. 1-B
KOOLAULOA AND KOOLAUPOKO DISTRICTS
OAHU, T. H.

IN ACCORDANCE WITH ITEM 27, ACT 214, S.L. HAW. 1923
AND ITEM 19, ACT 271, S.L. HAW. 1927.

PLAN

PROFILE

CROSS SECTION

HOR.


VER.

1 INCH = 40 FEET

1 " = 40 "

1 " = 4 "

1 " = 5 "

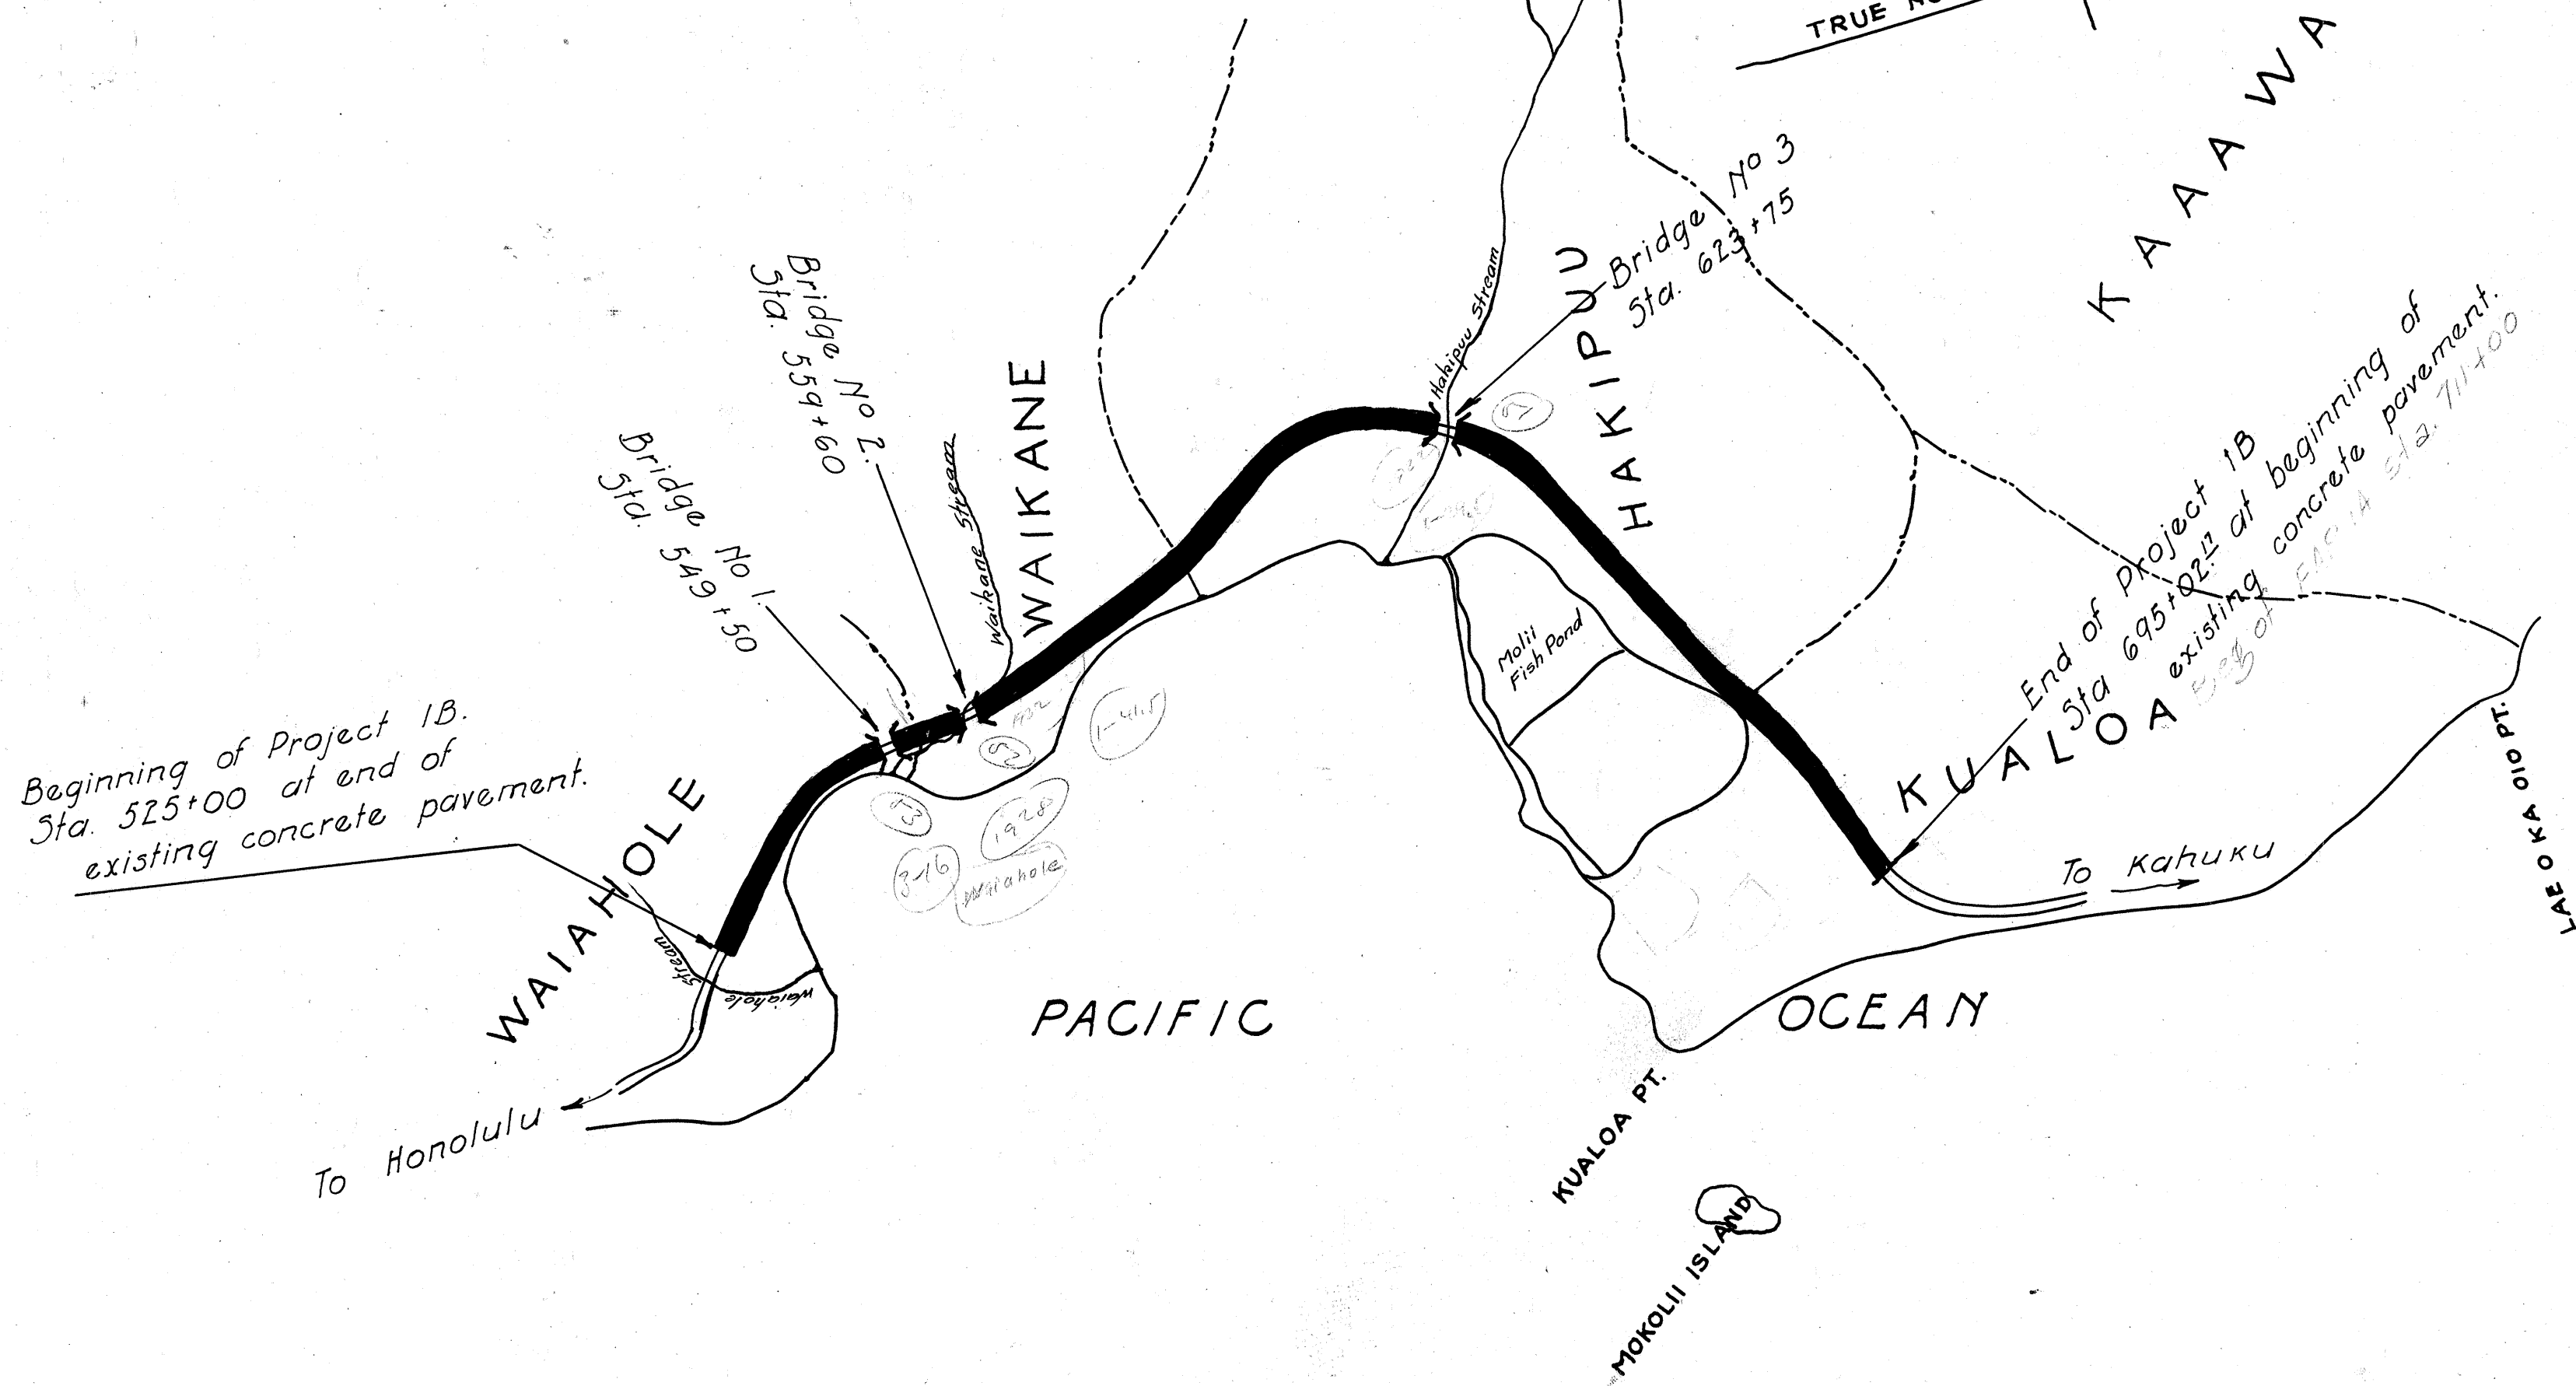

- CONVENTIONAL SIGNS —
- FENCE LINE

UNFENCED PROPERTY LINE

EDGE OF EXISTING ROADWAY

RIGHT OF WAY LINE

RAILROAD

RETAINING WALLS

CULVERTS

EXISTING CULVERT

STONE WALL FENCE OR EXISTING DRY RUBBLE RETAINING WALLS

DITCHES

LAYOUT OF PROJECT

Scale 1 inch = 1500 feet.

GROSS LENGTH

EXCEPTIONS

NET LENGTH

3.2406 Miles

0.007

3.2334

Note:

Elevations refer to Mean Tide City Datum.

Tide ranges about 2 feet.

APPROVED.

Robert W. Schuchman

ACTING

TERRITORIAL HIGHWAY ENGINEER

RECOMMENDED FOR APPROVAL

SENIOR HIGHWAY ENGINEER Bureau of Public Roads.

RECOMMENDED FOR APPROVAL

CHIEF ENGINEER Bureau of Public Roads.

APPROVED

DIRECTOR Bureau of Public Roads.

4011.1.