


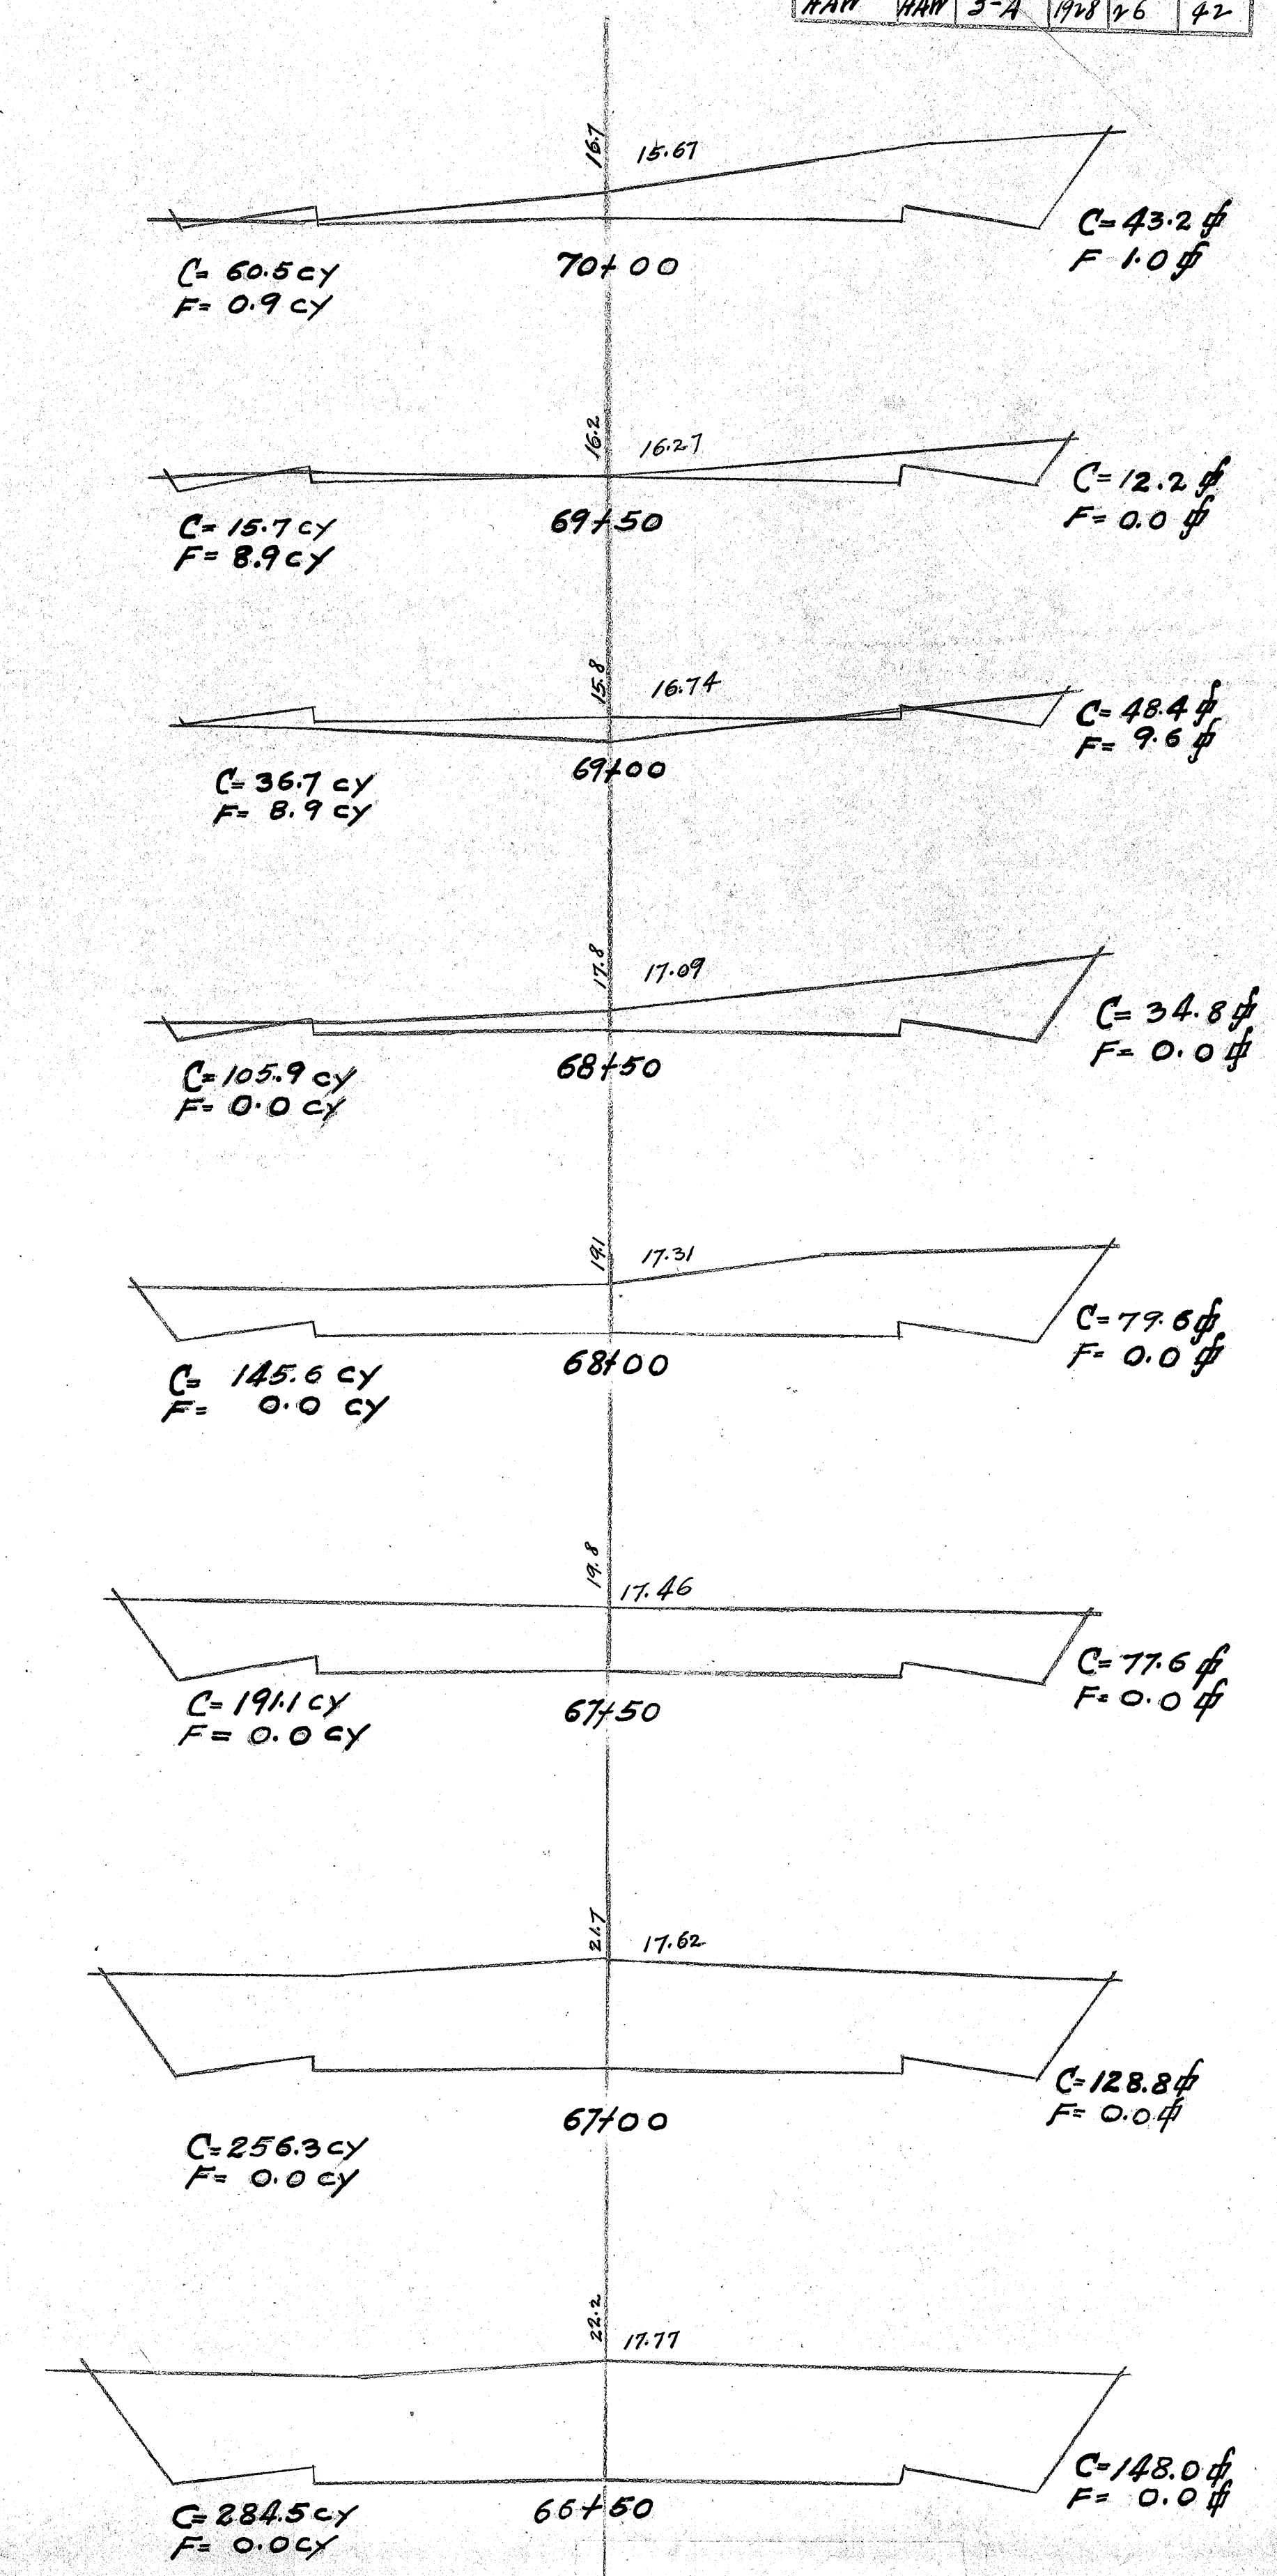
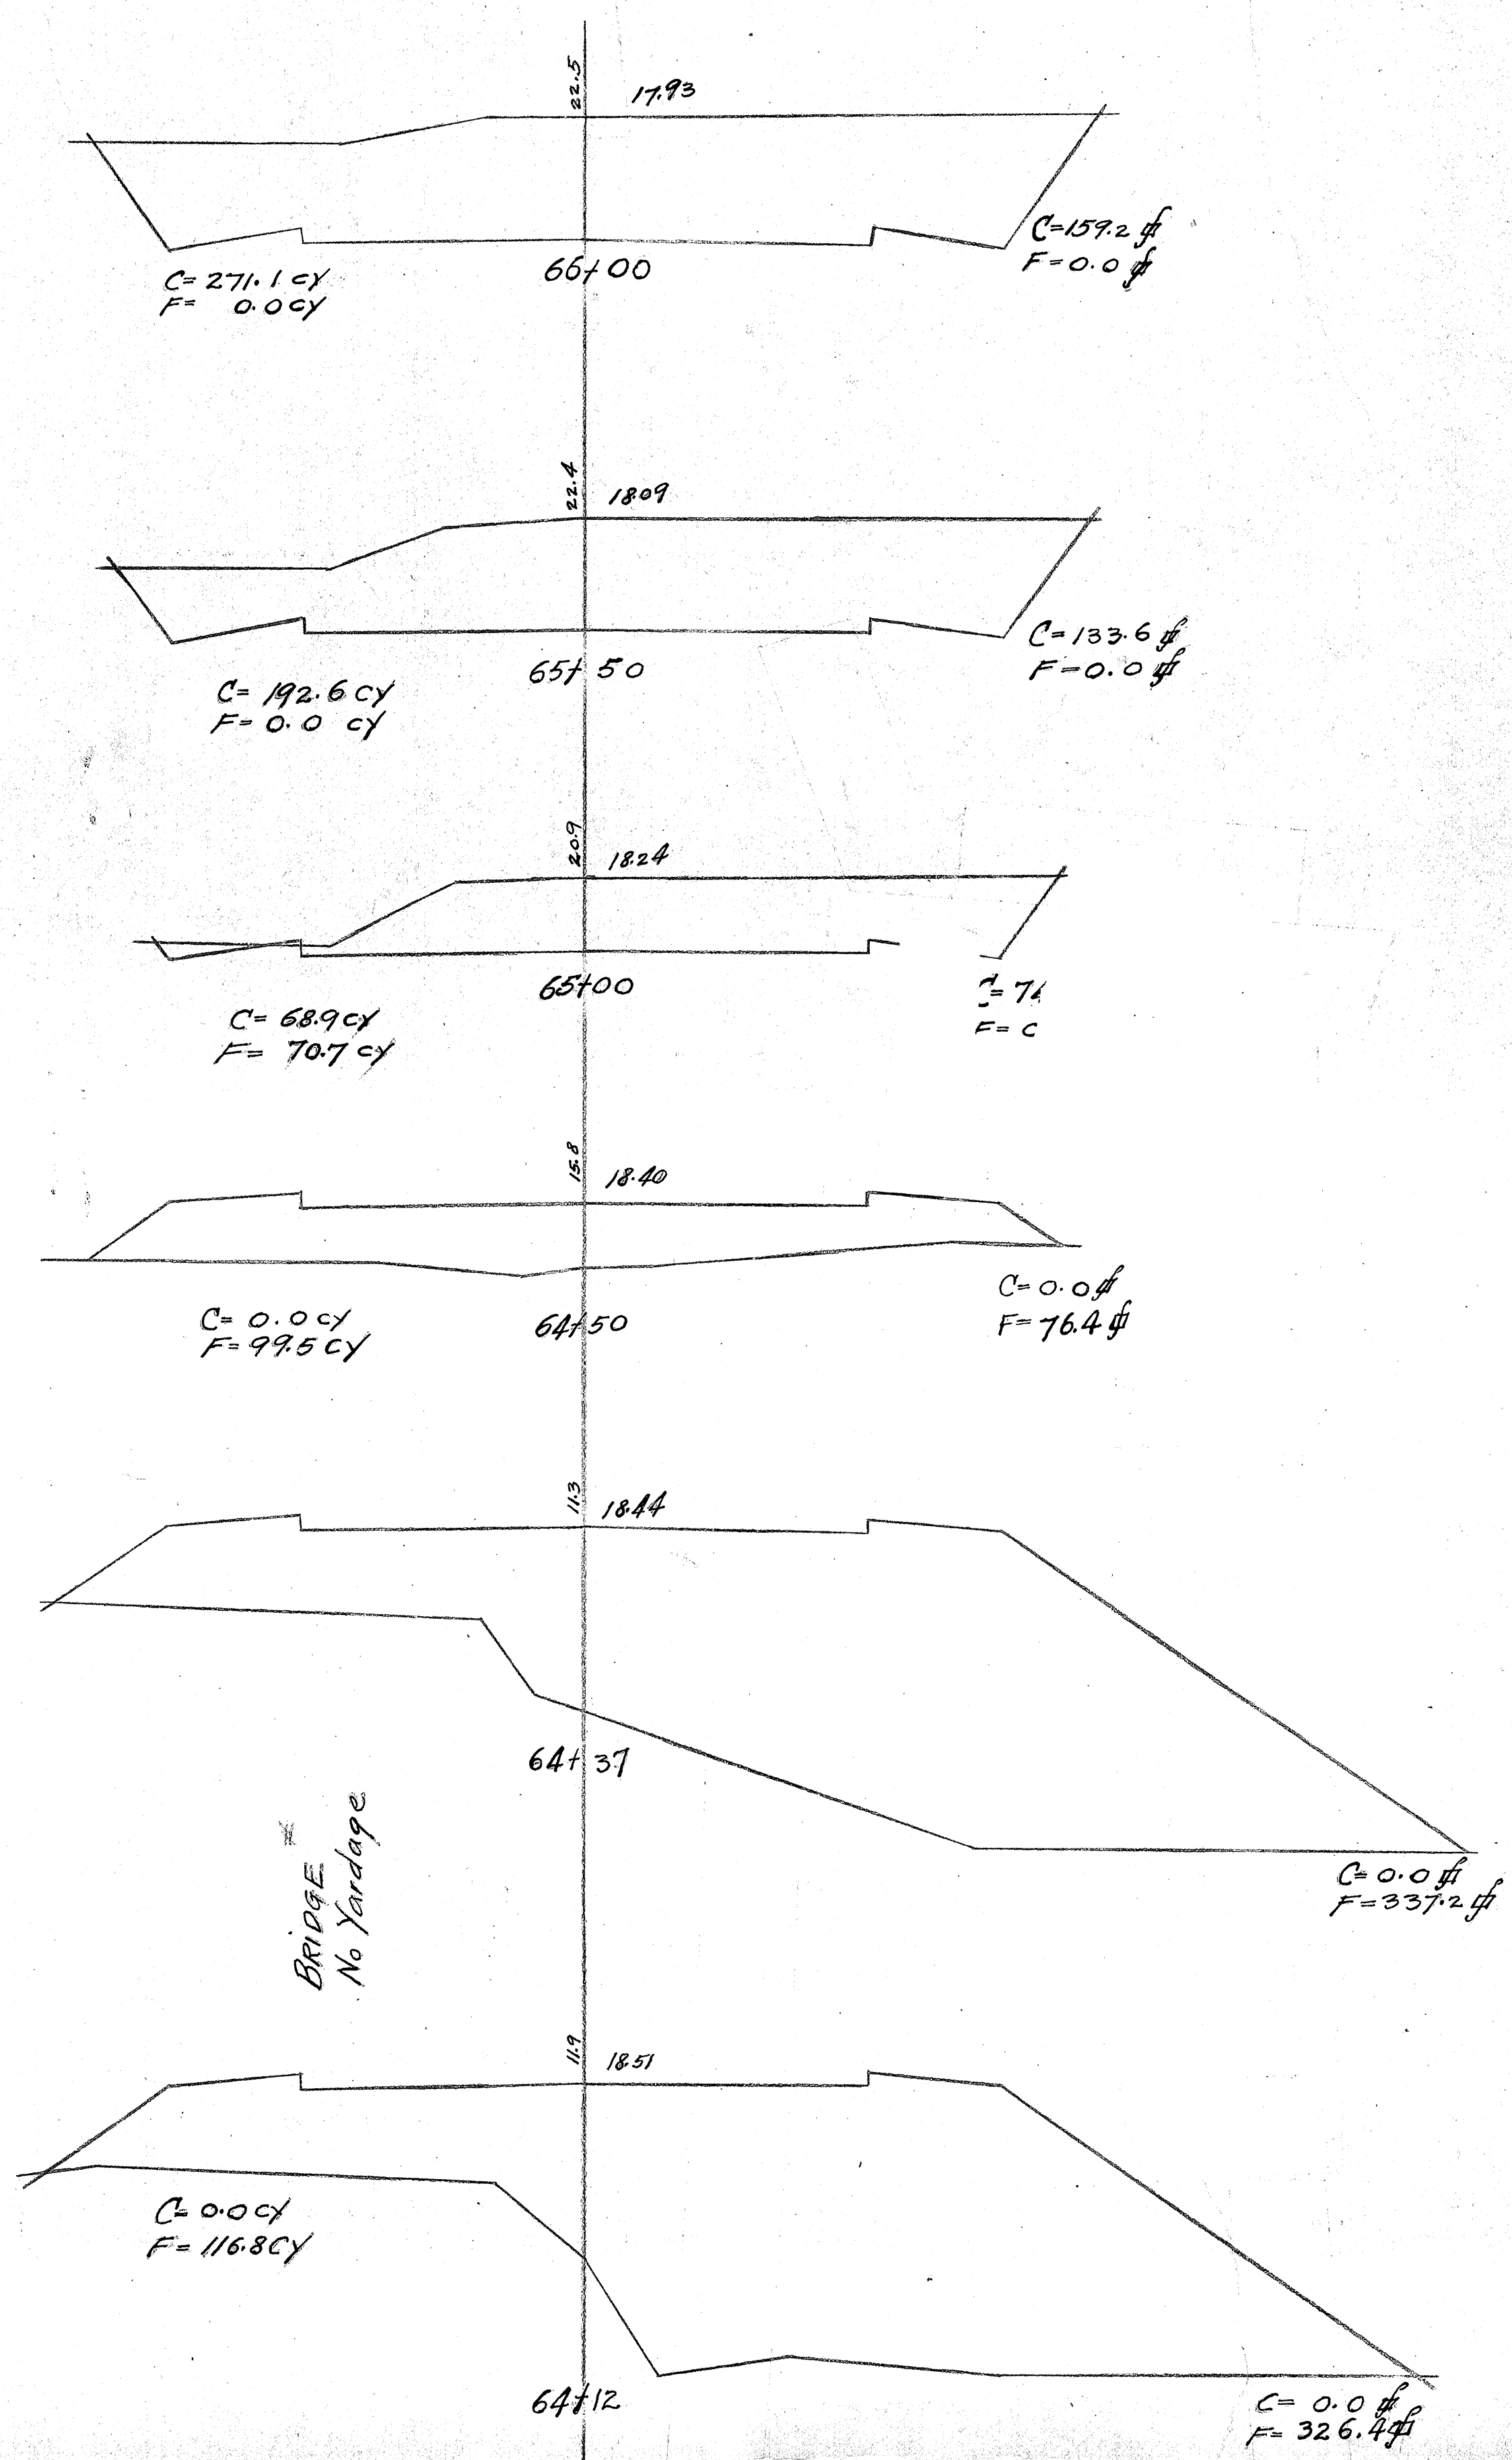
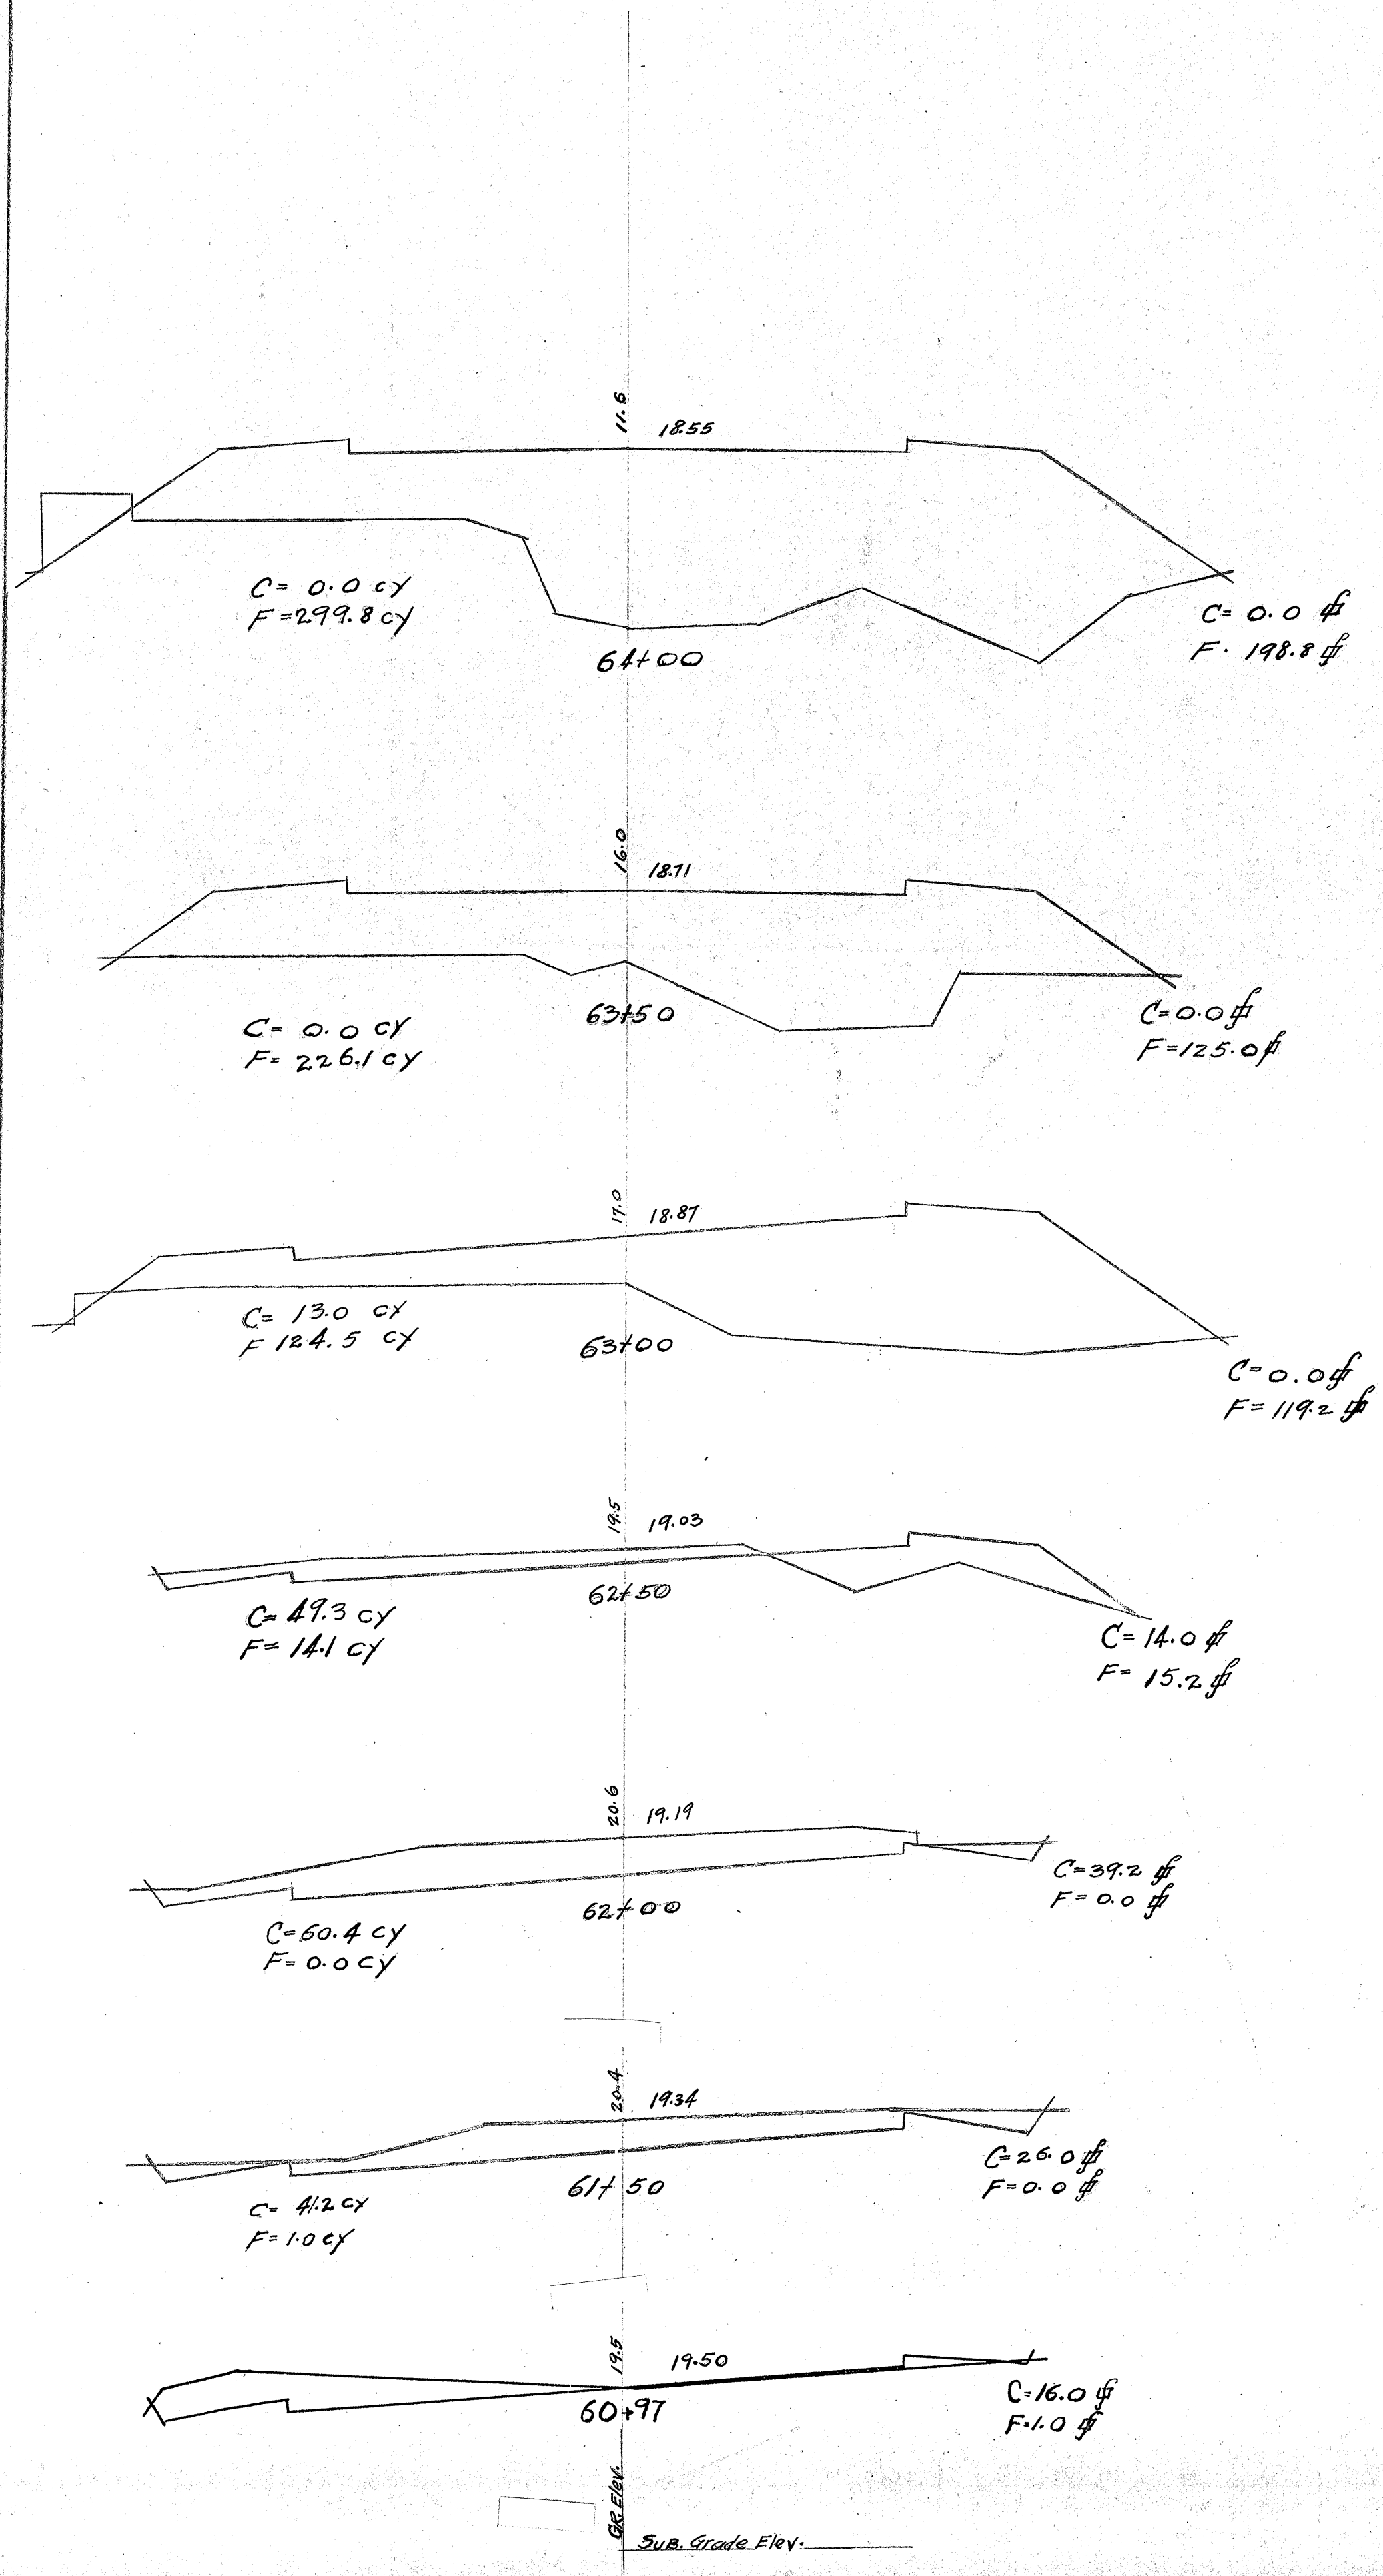
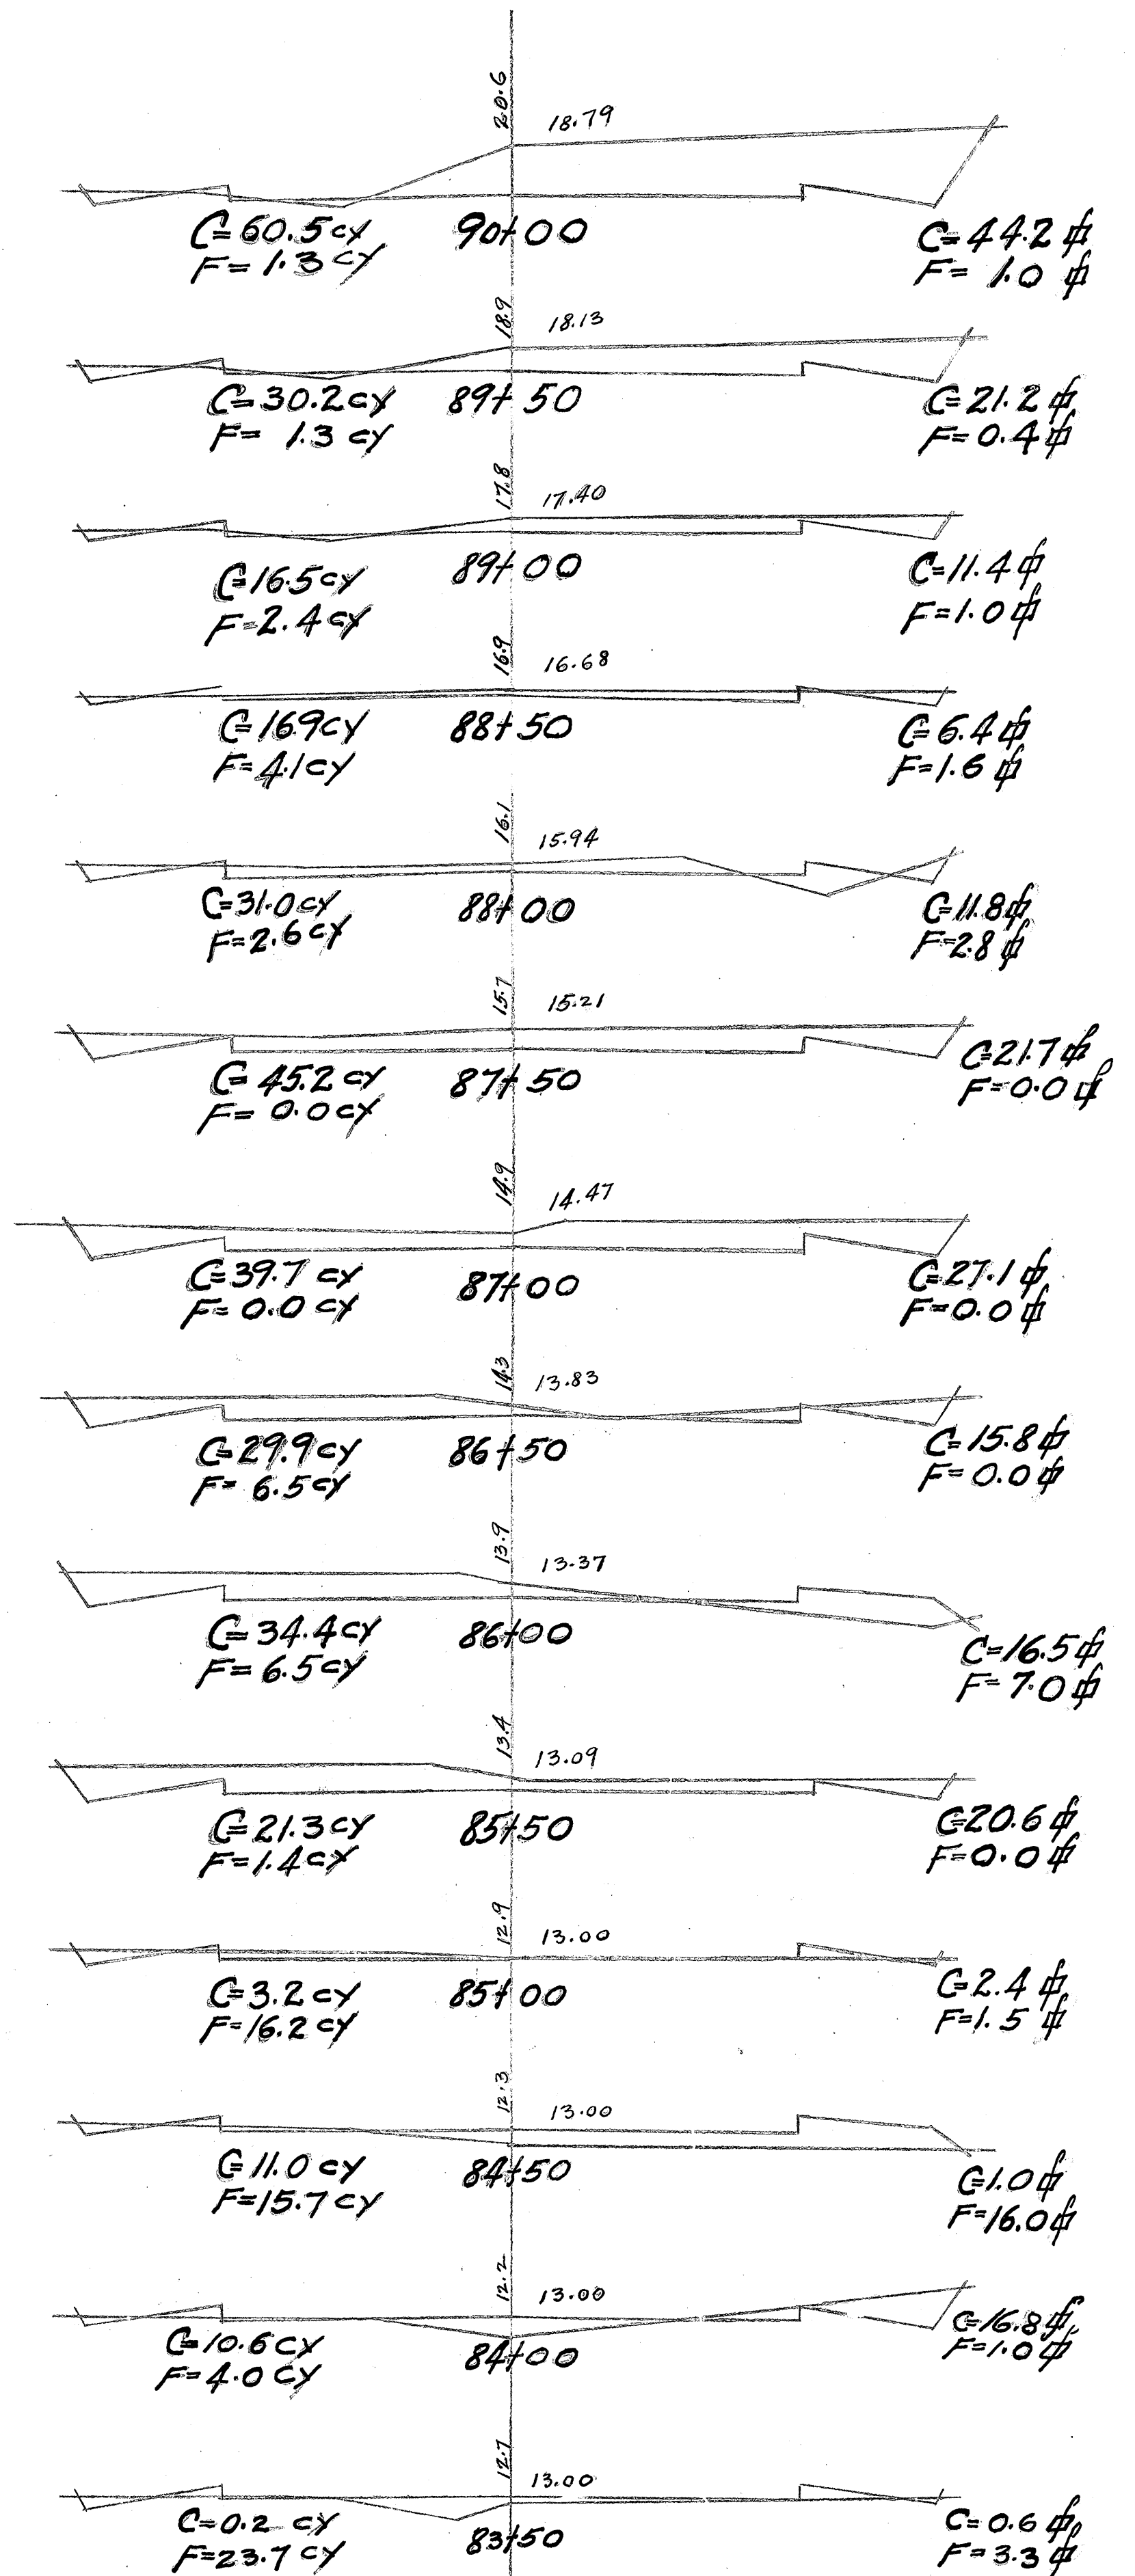
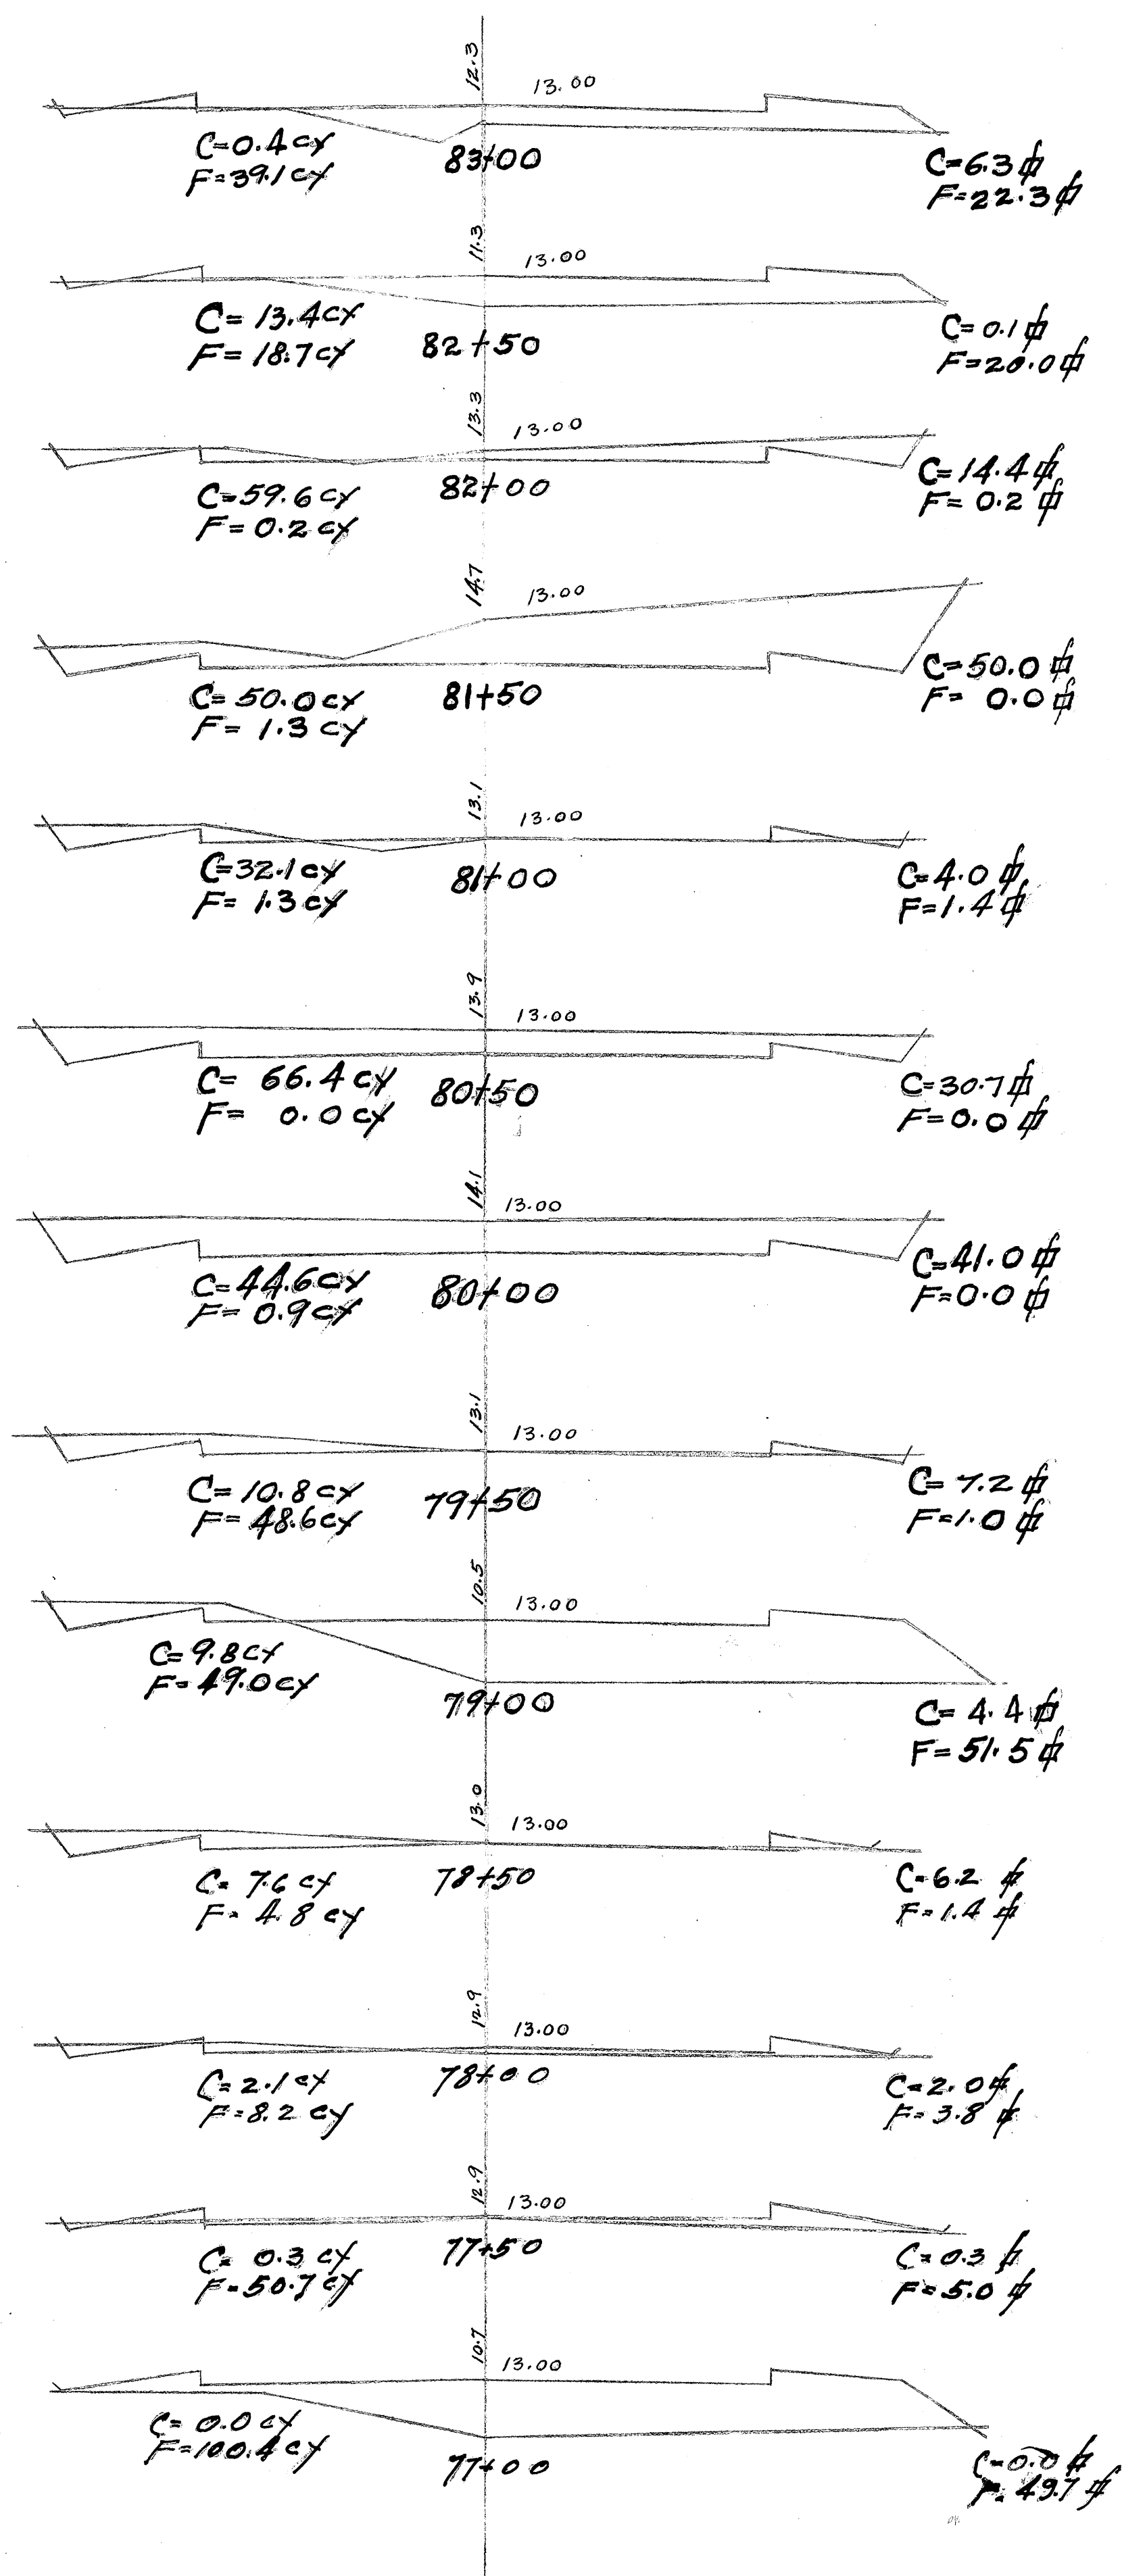
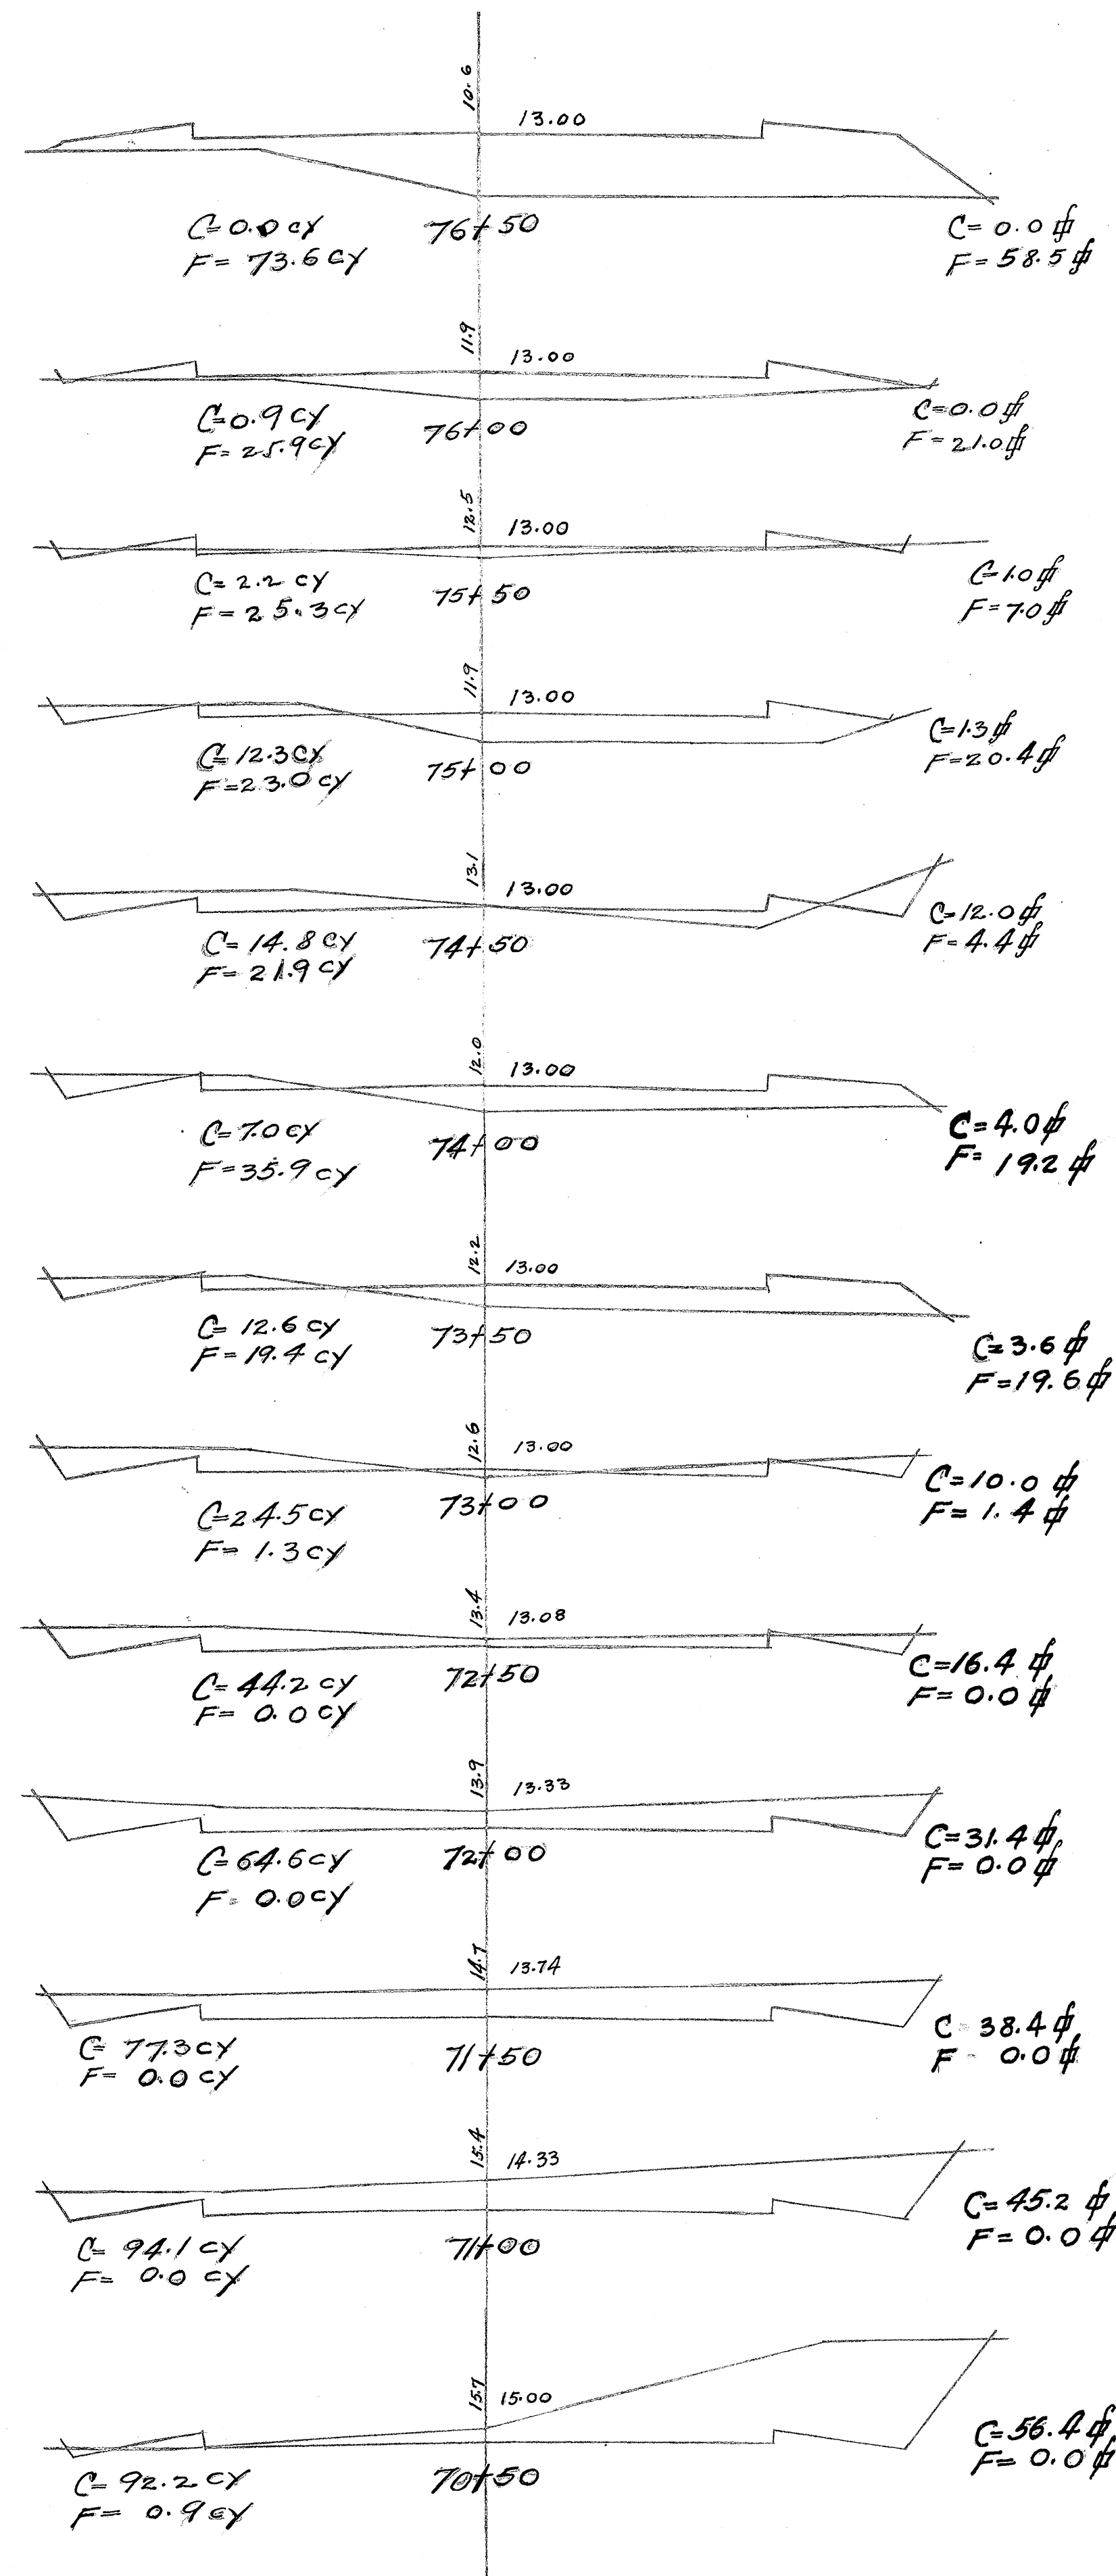


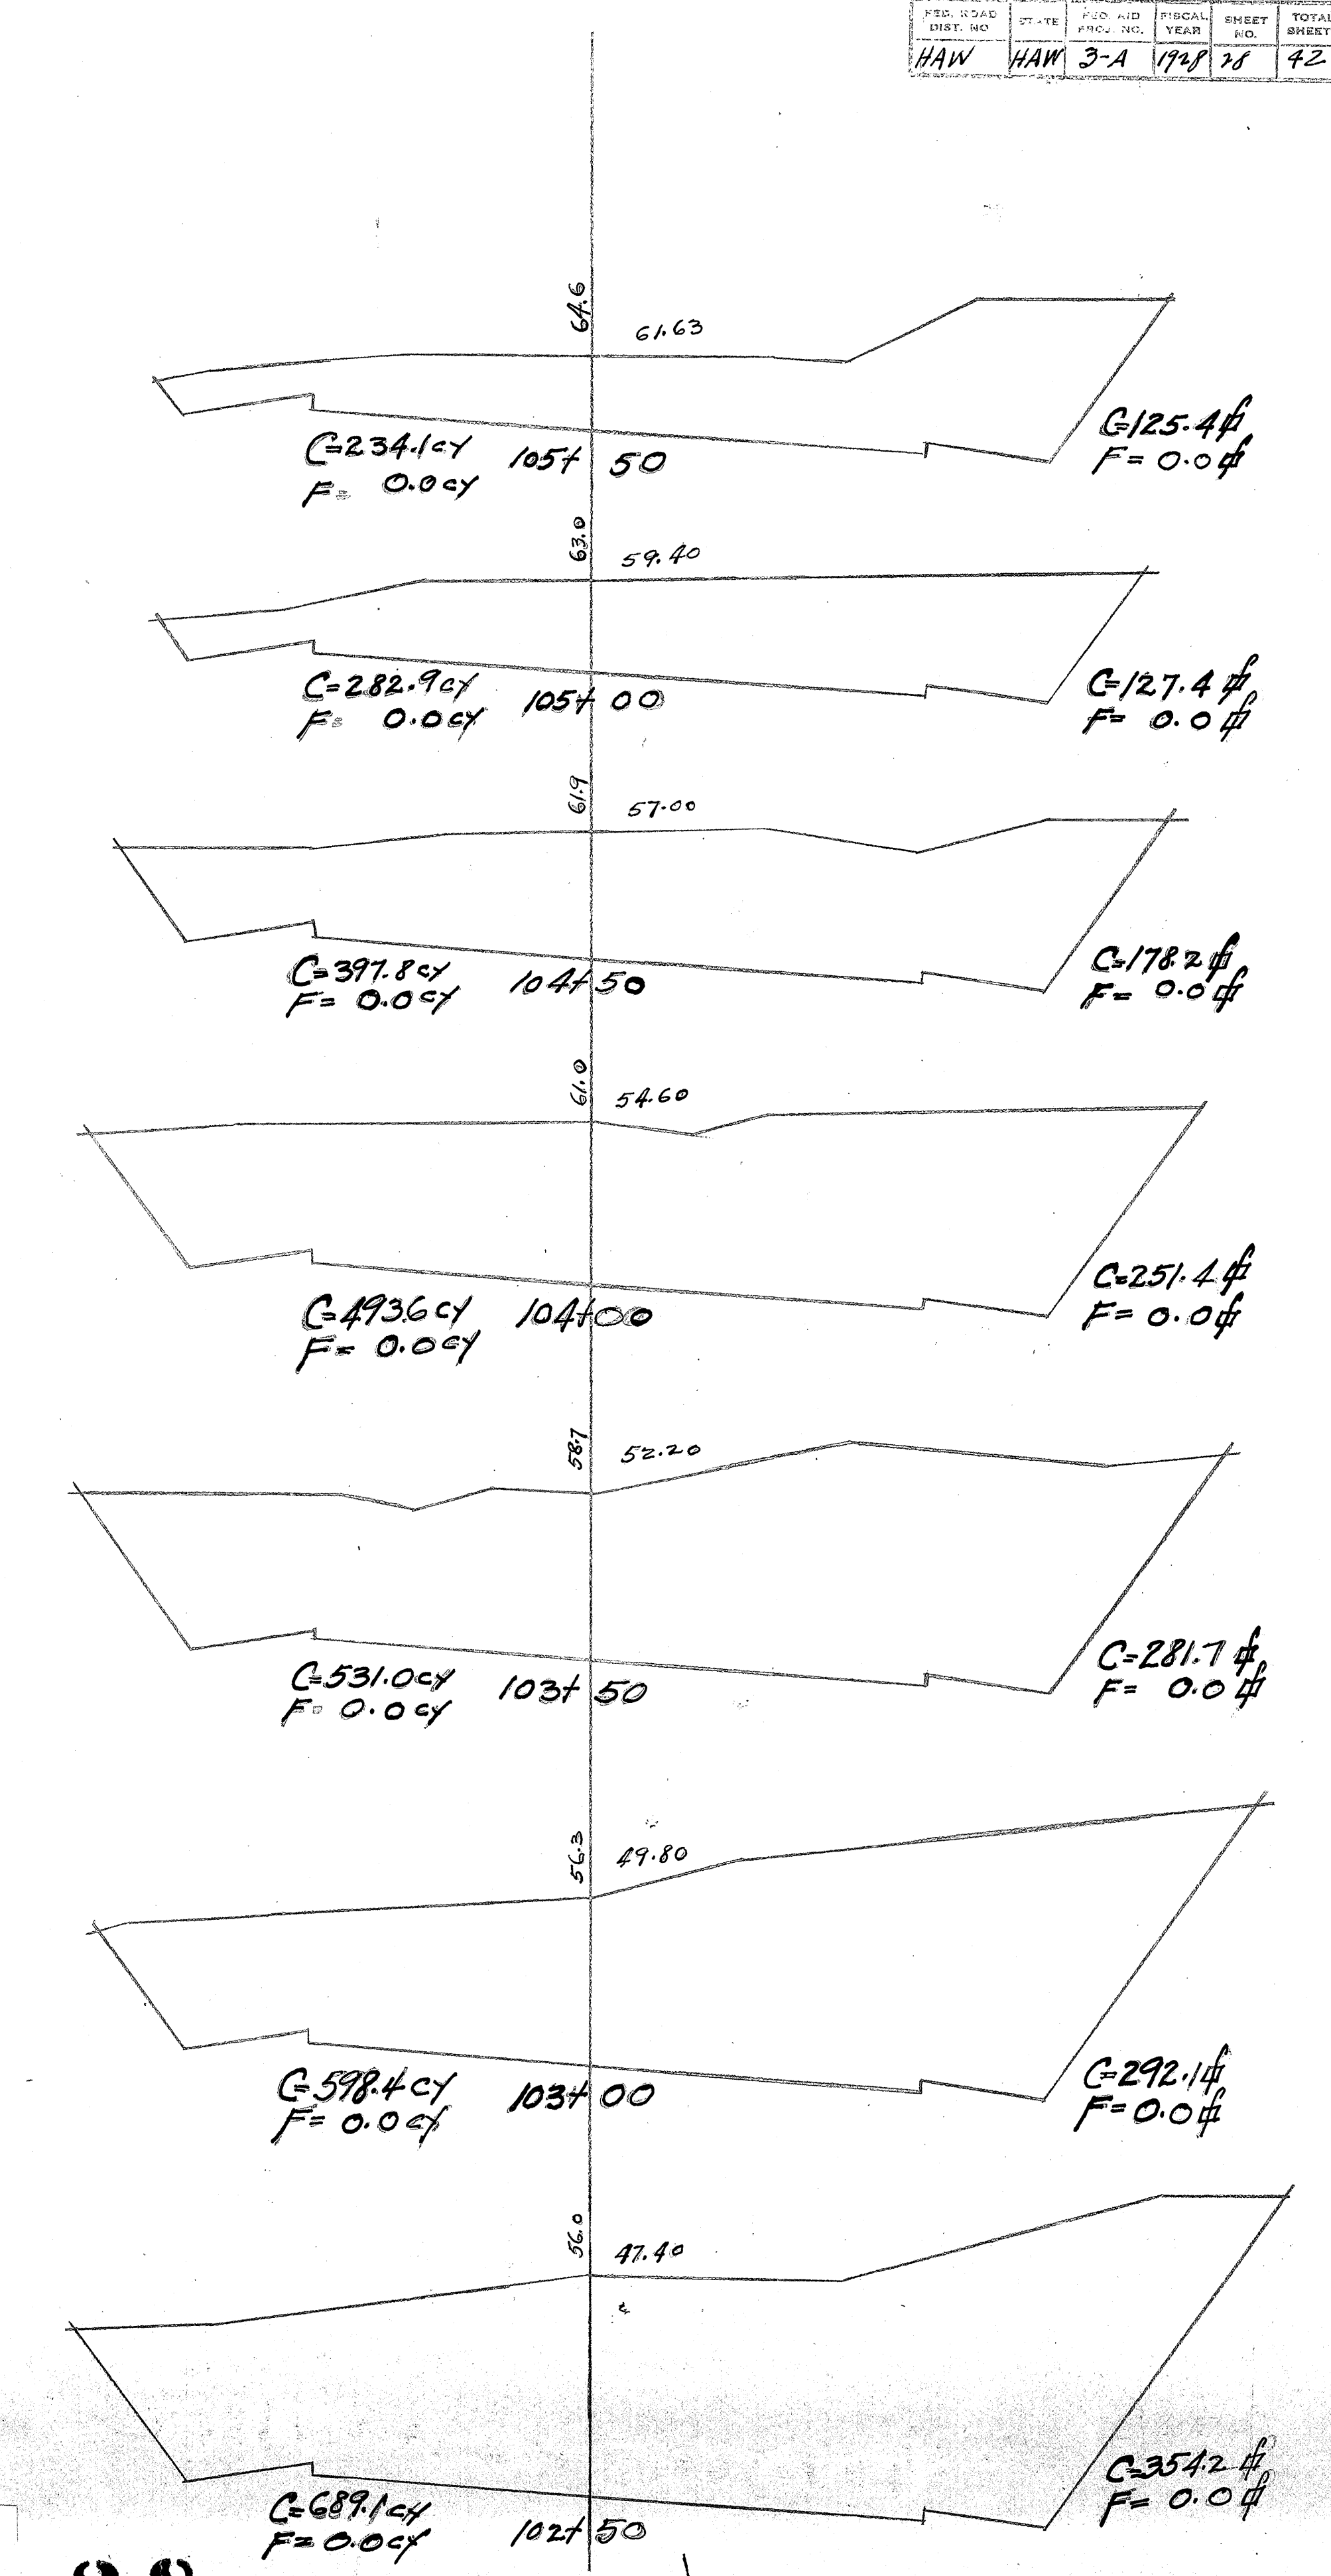



4057.26

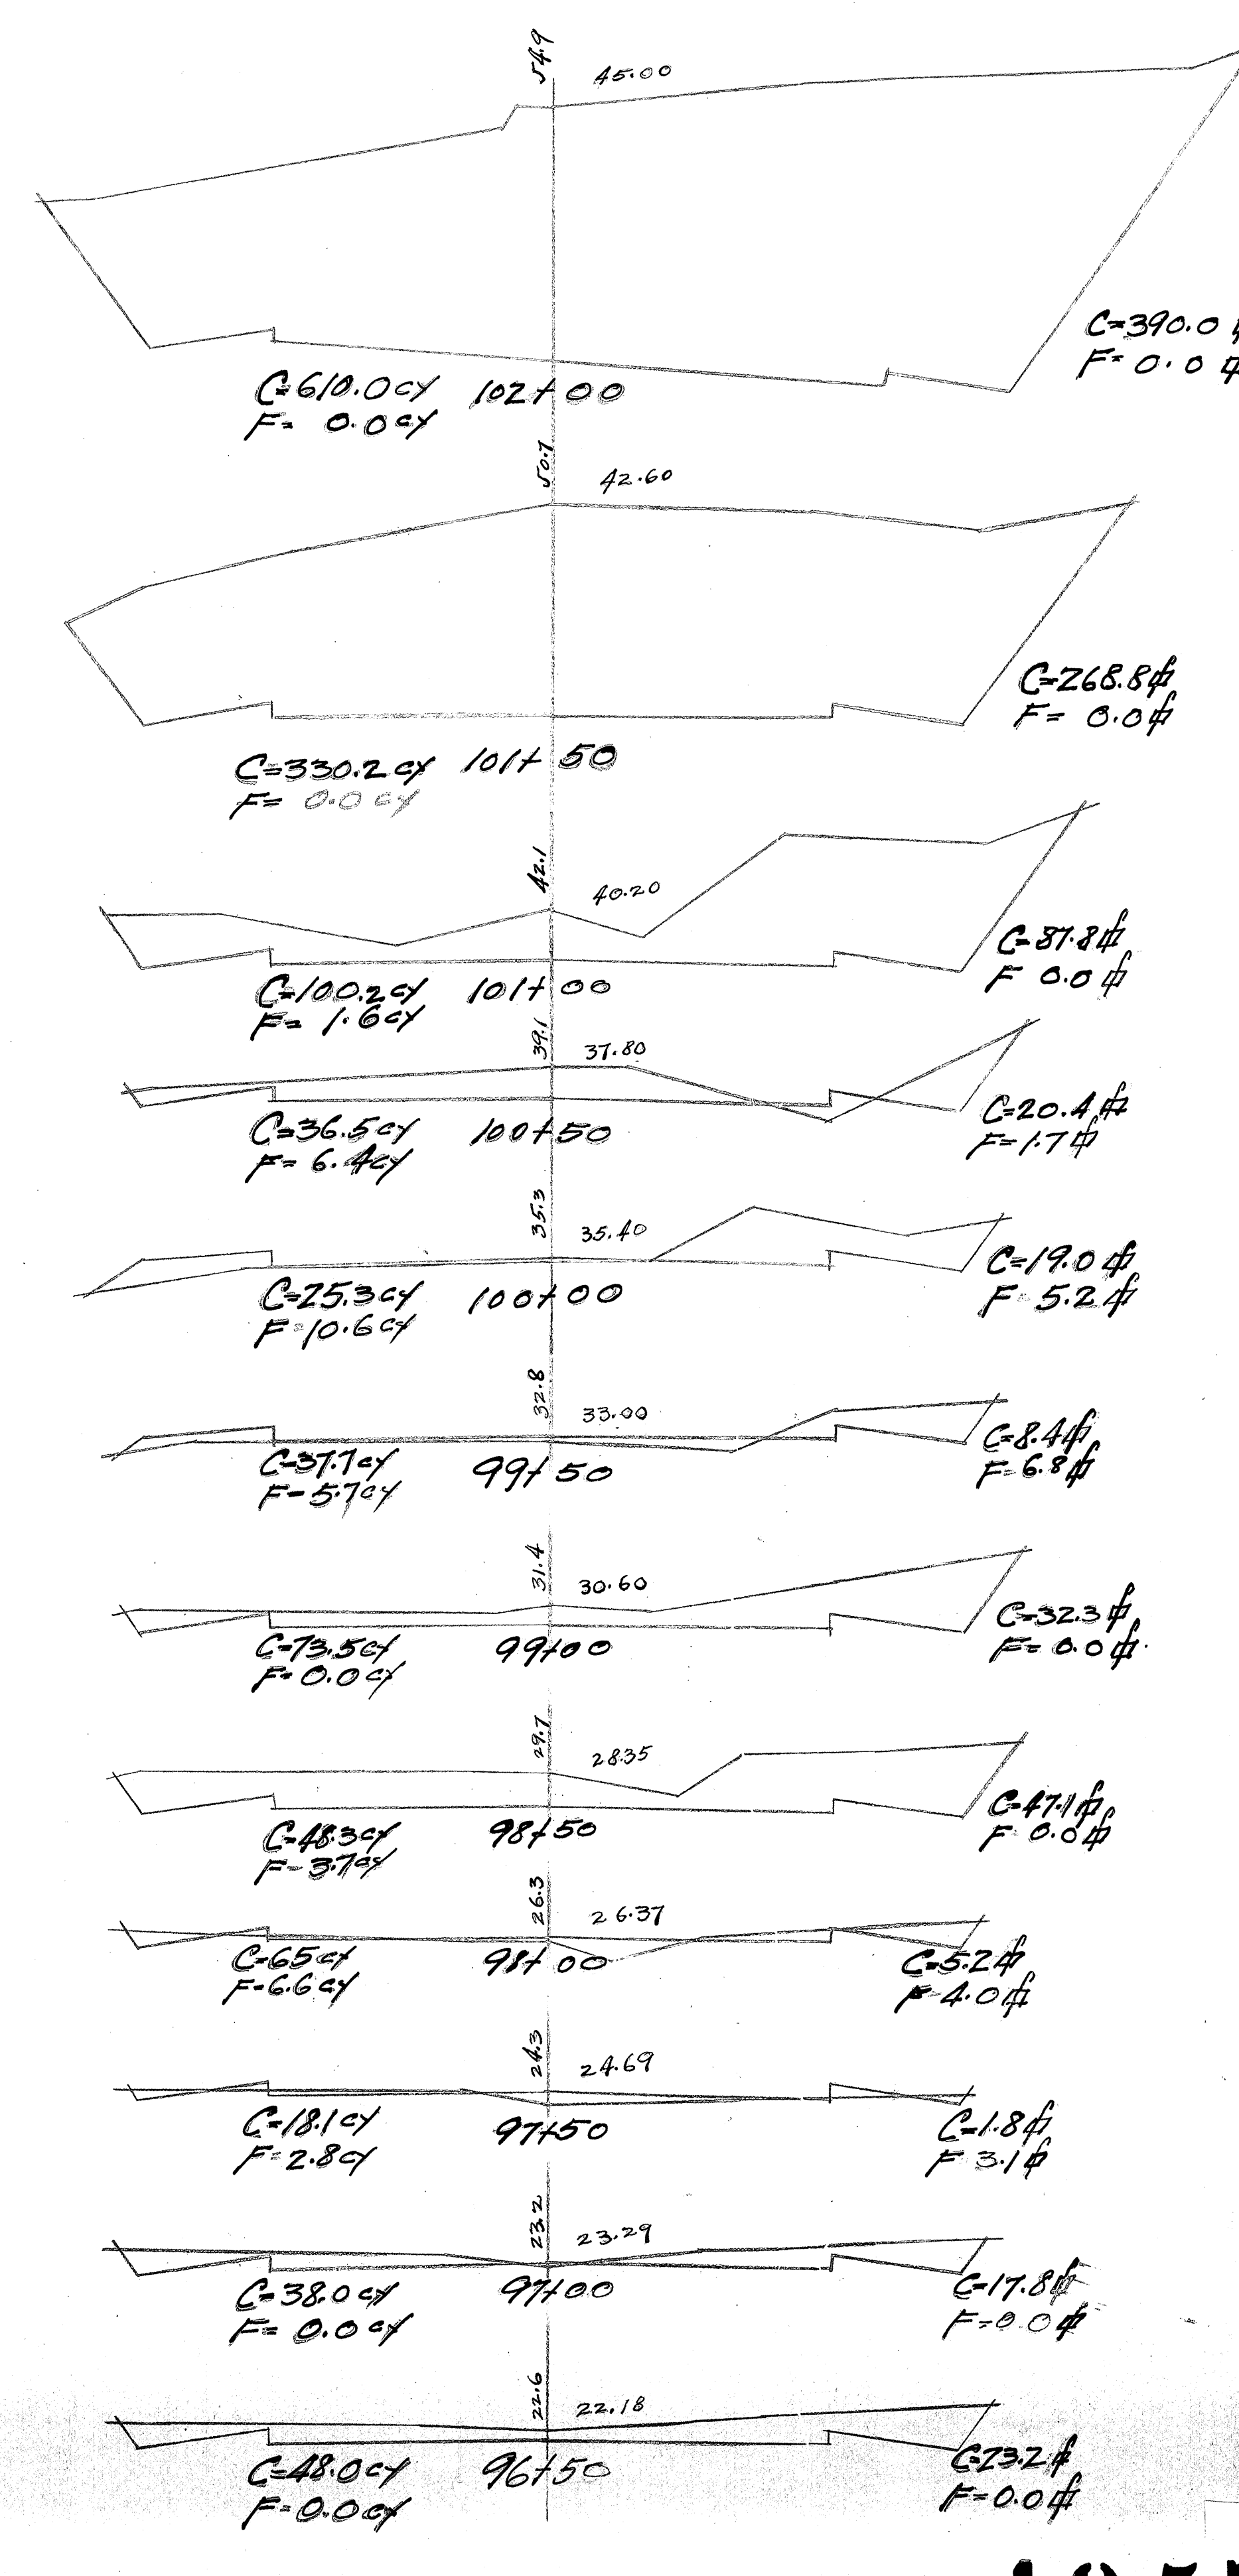


4057.27

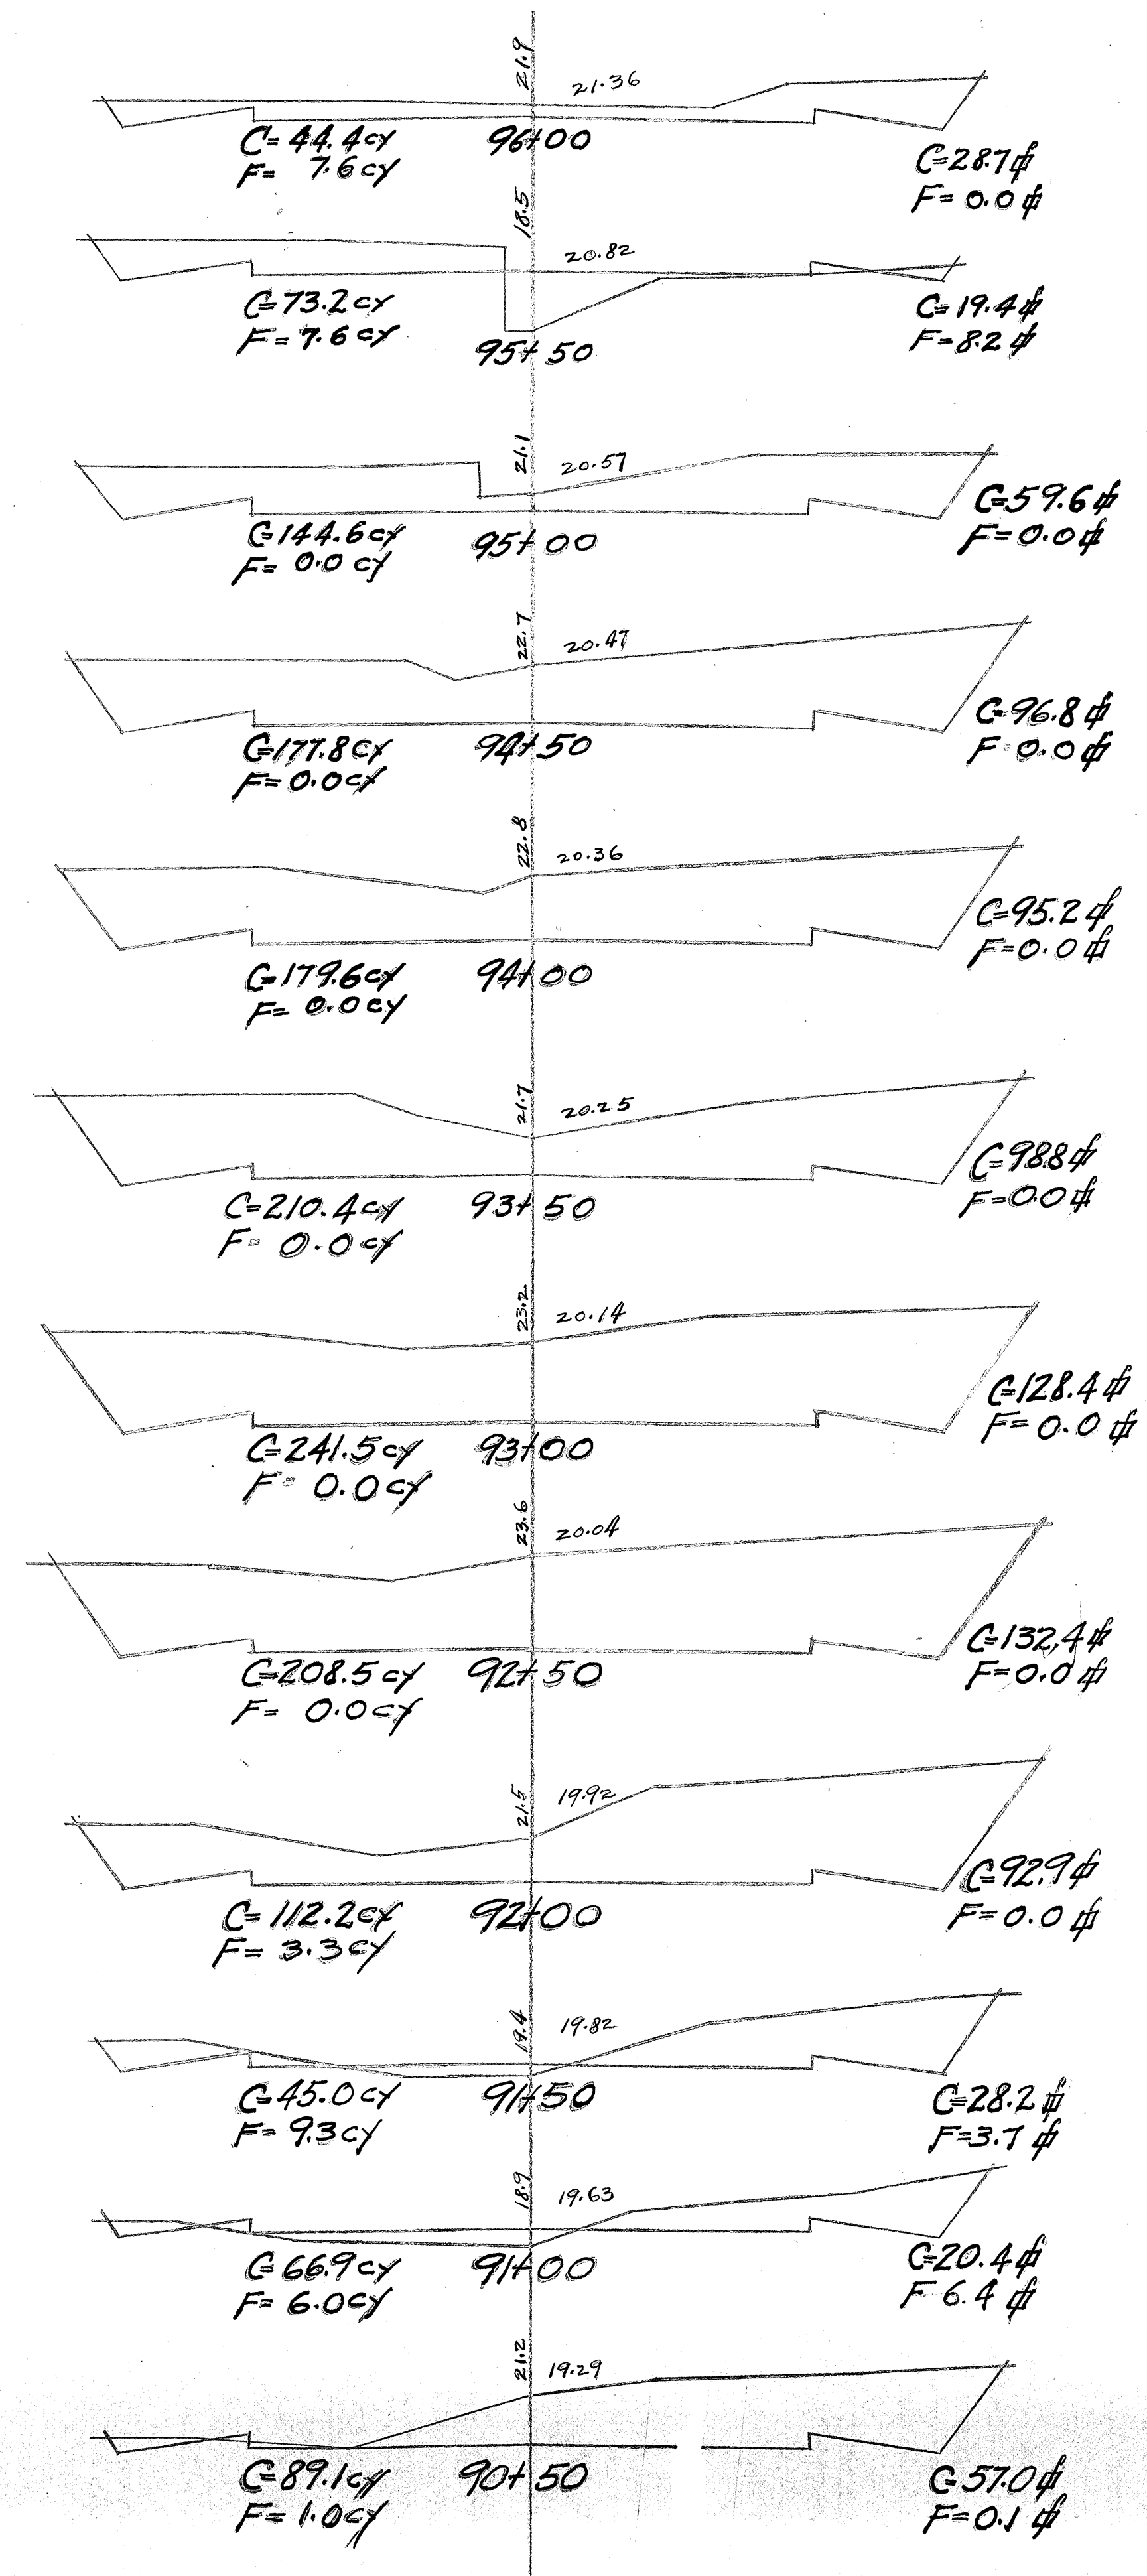


4057.28

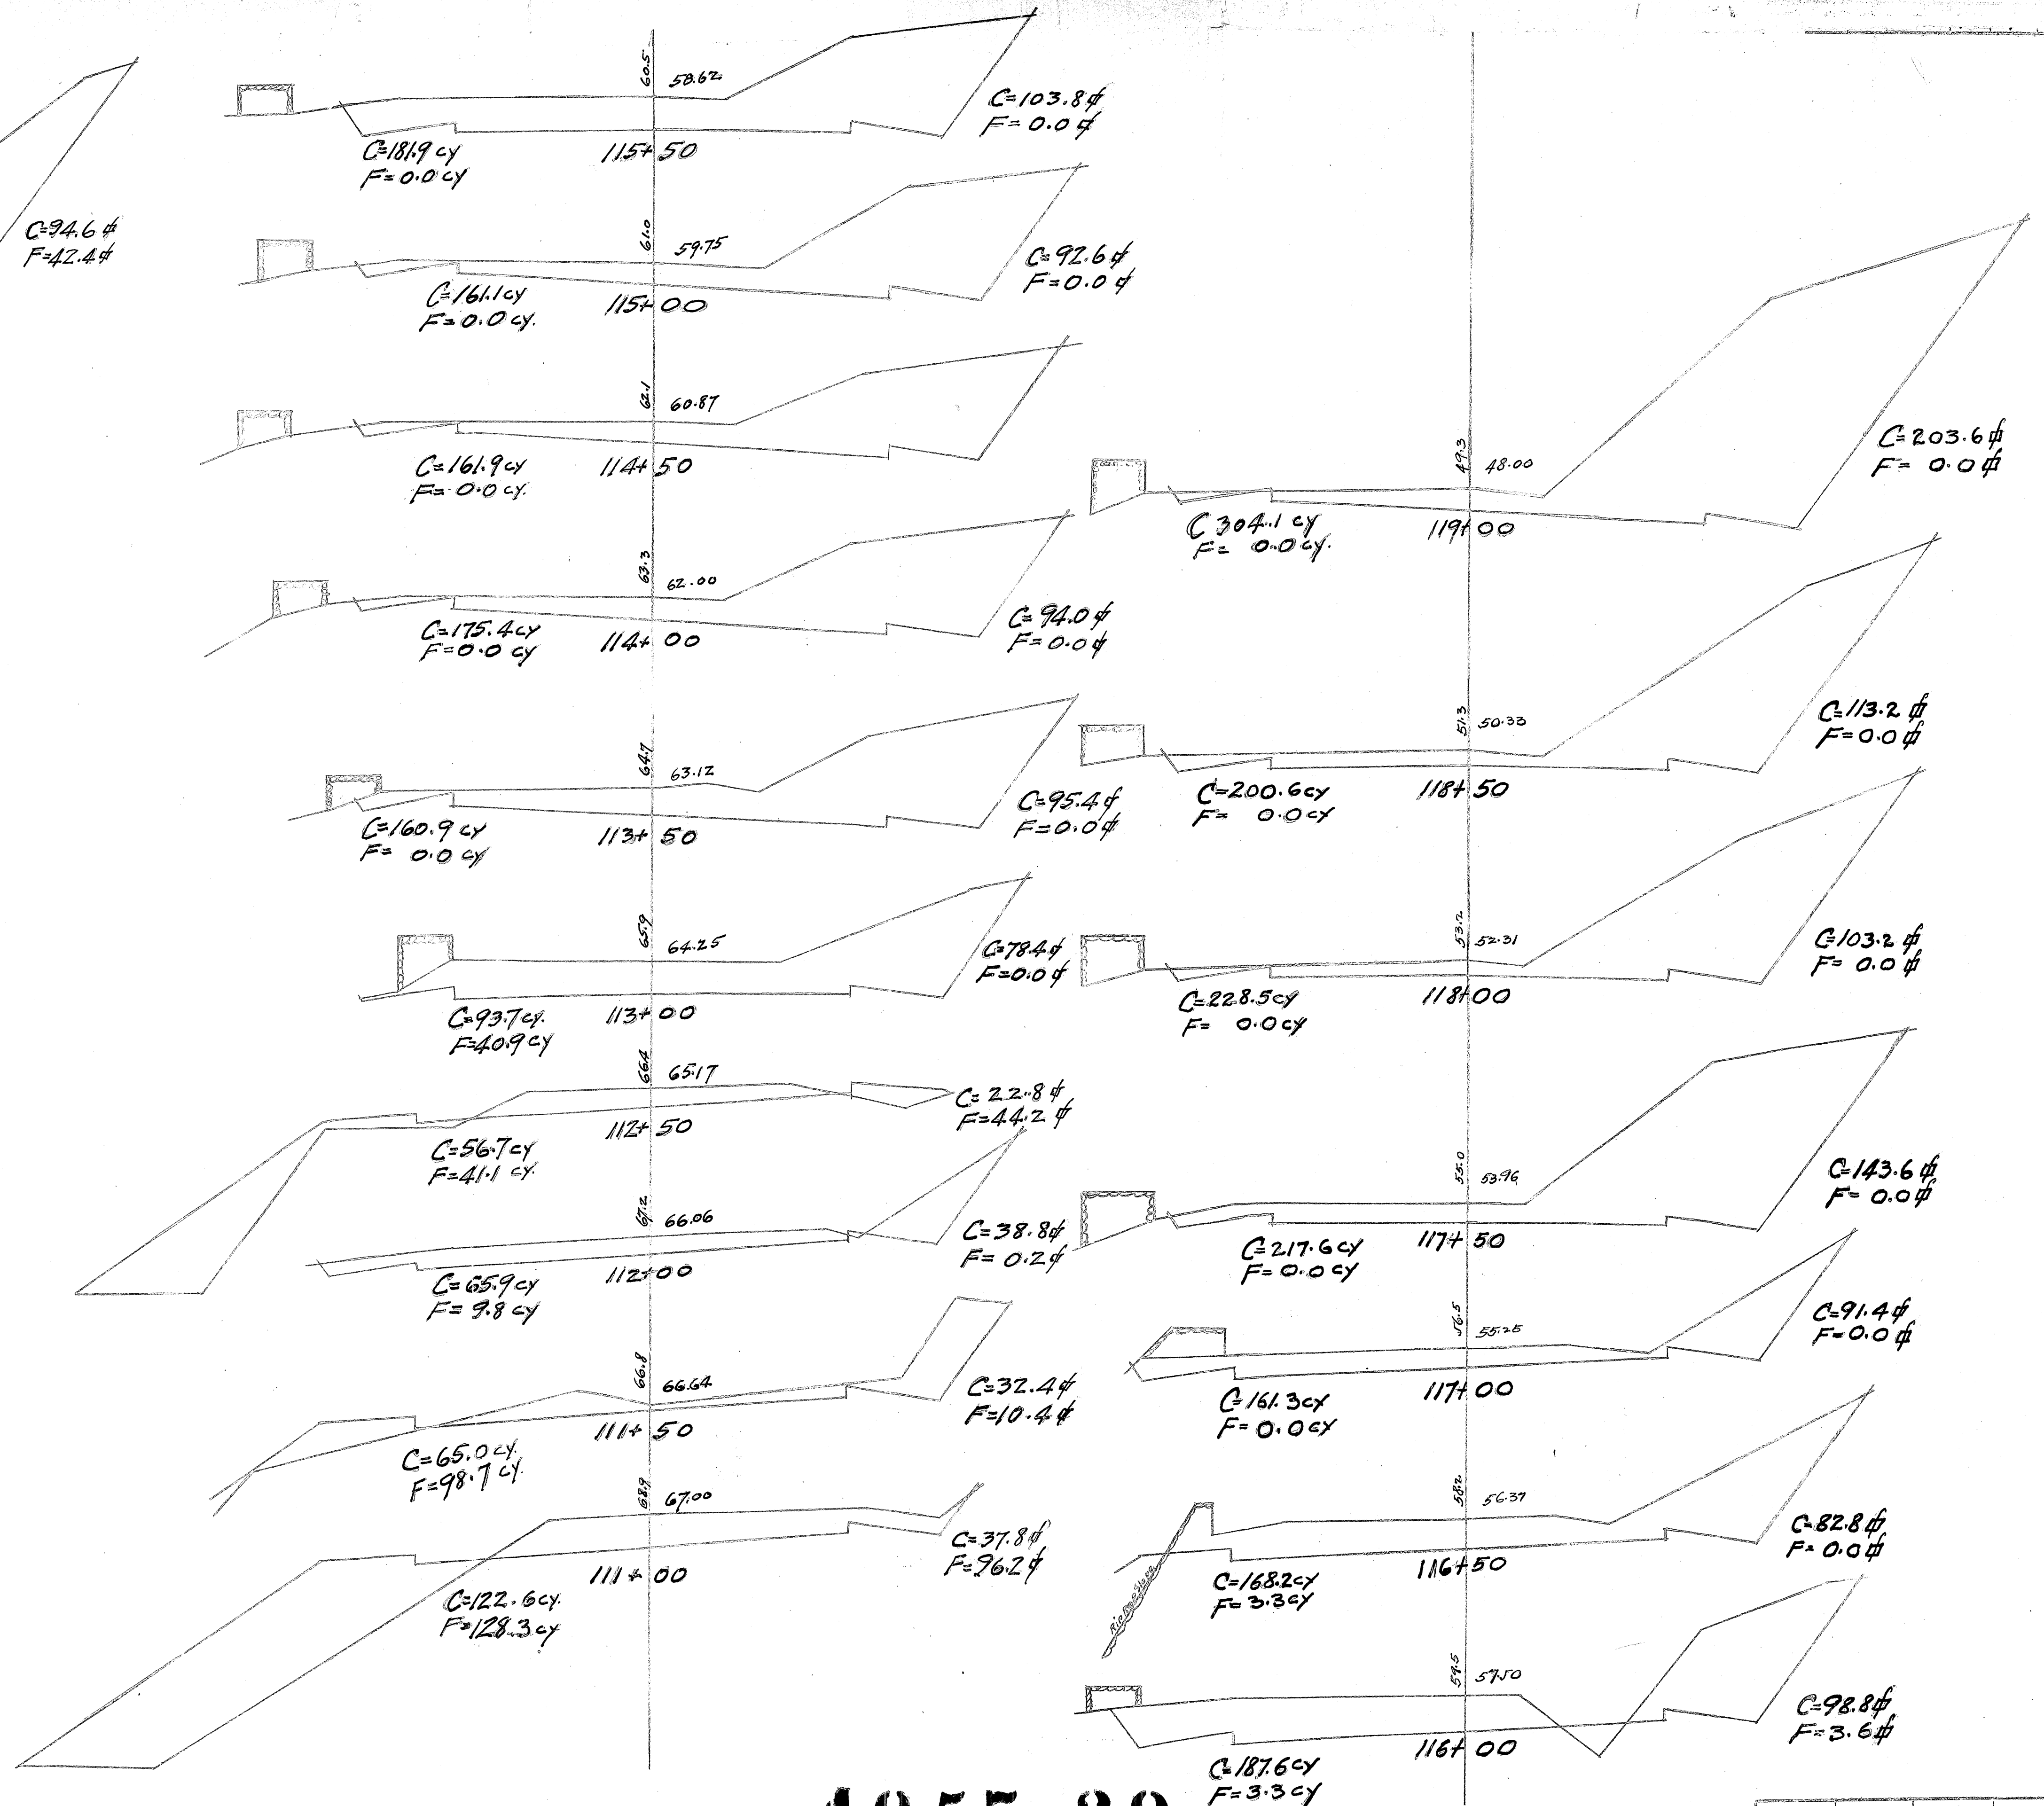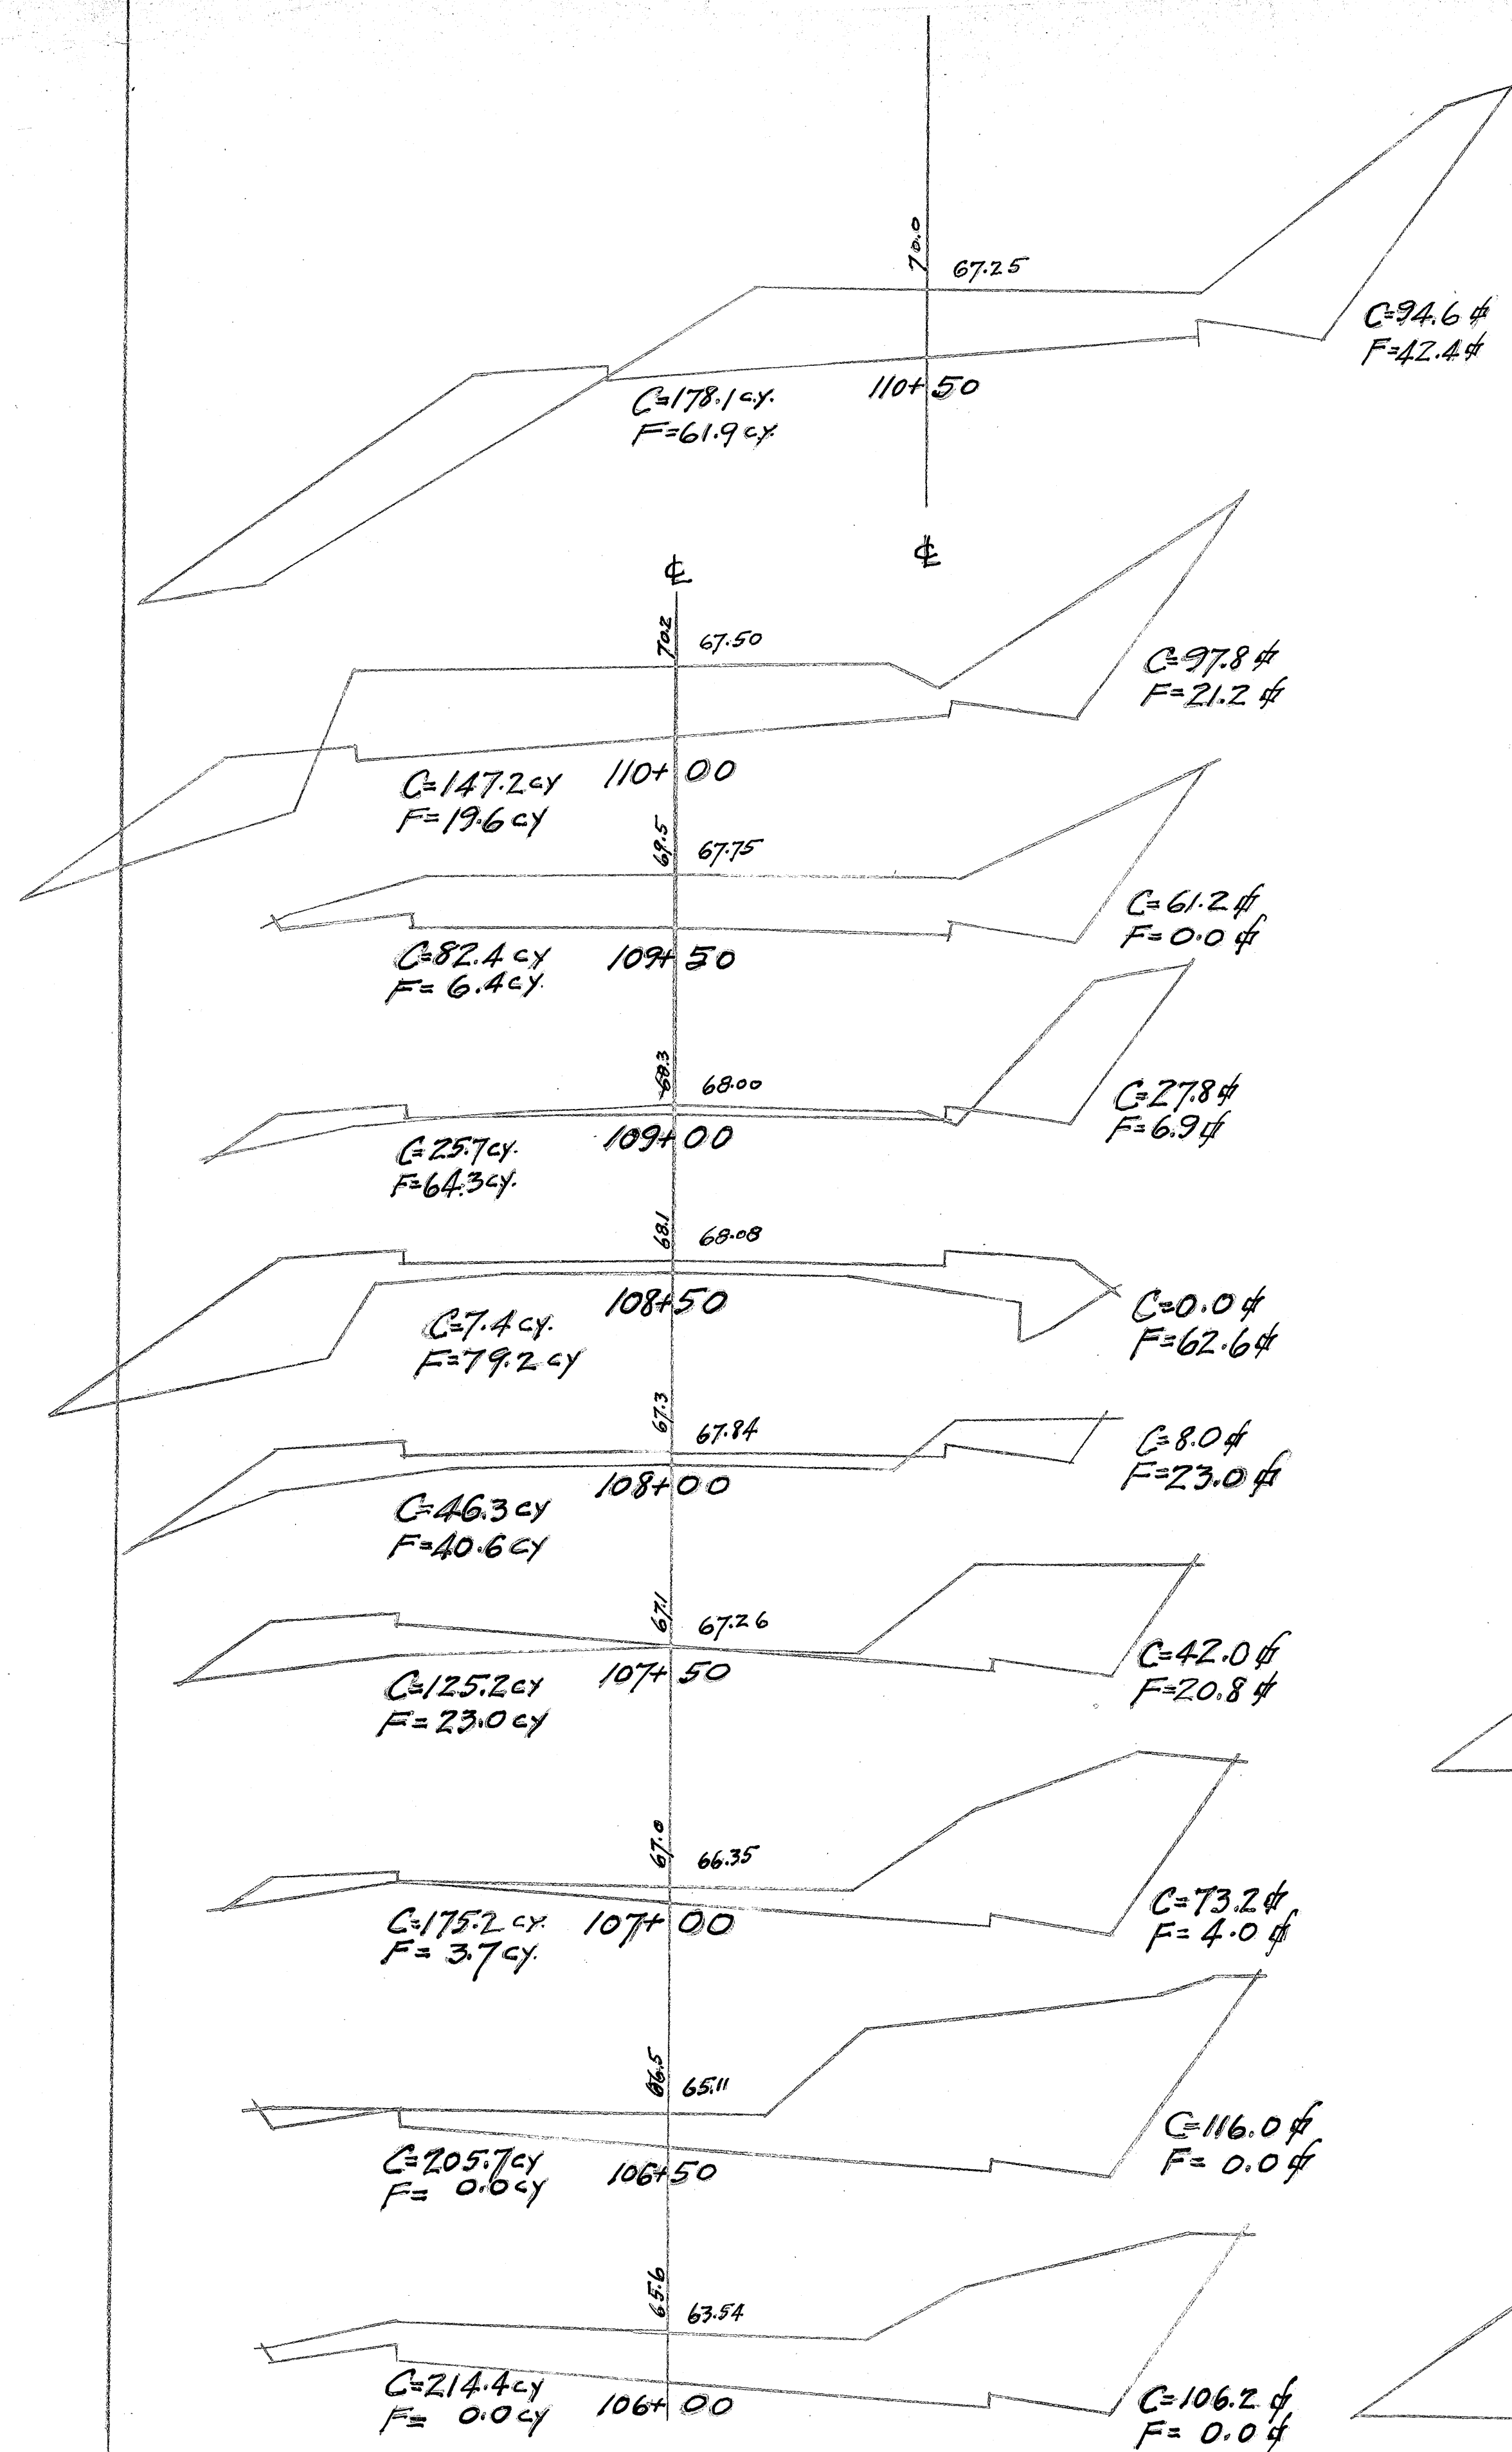


4057.29

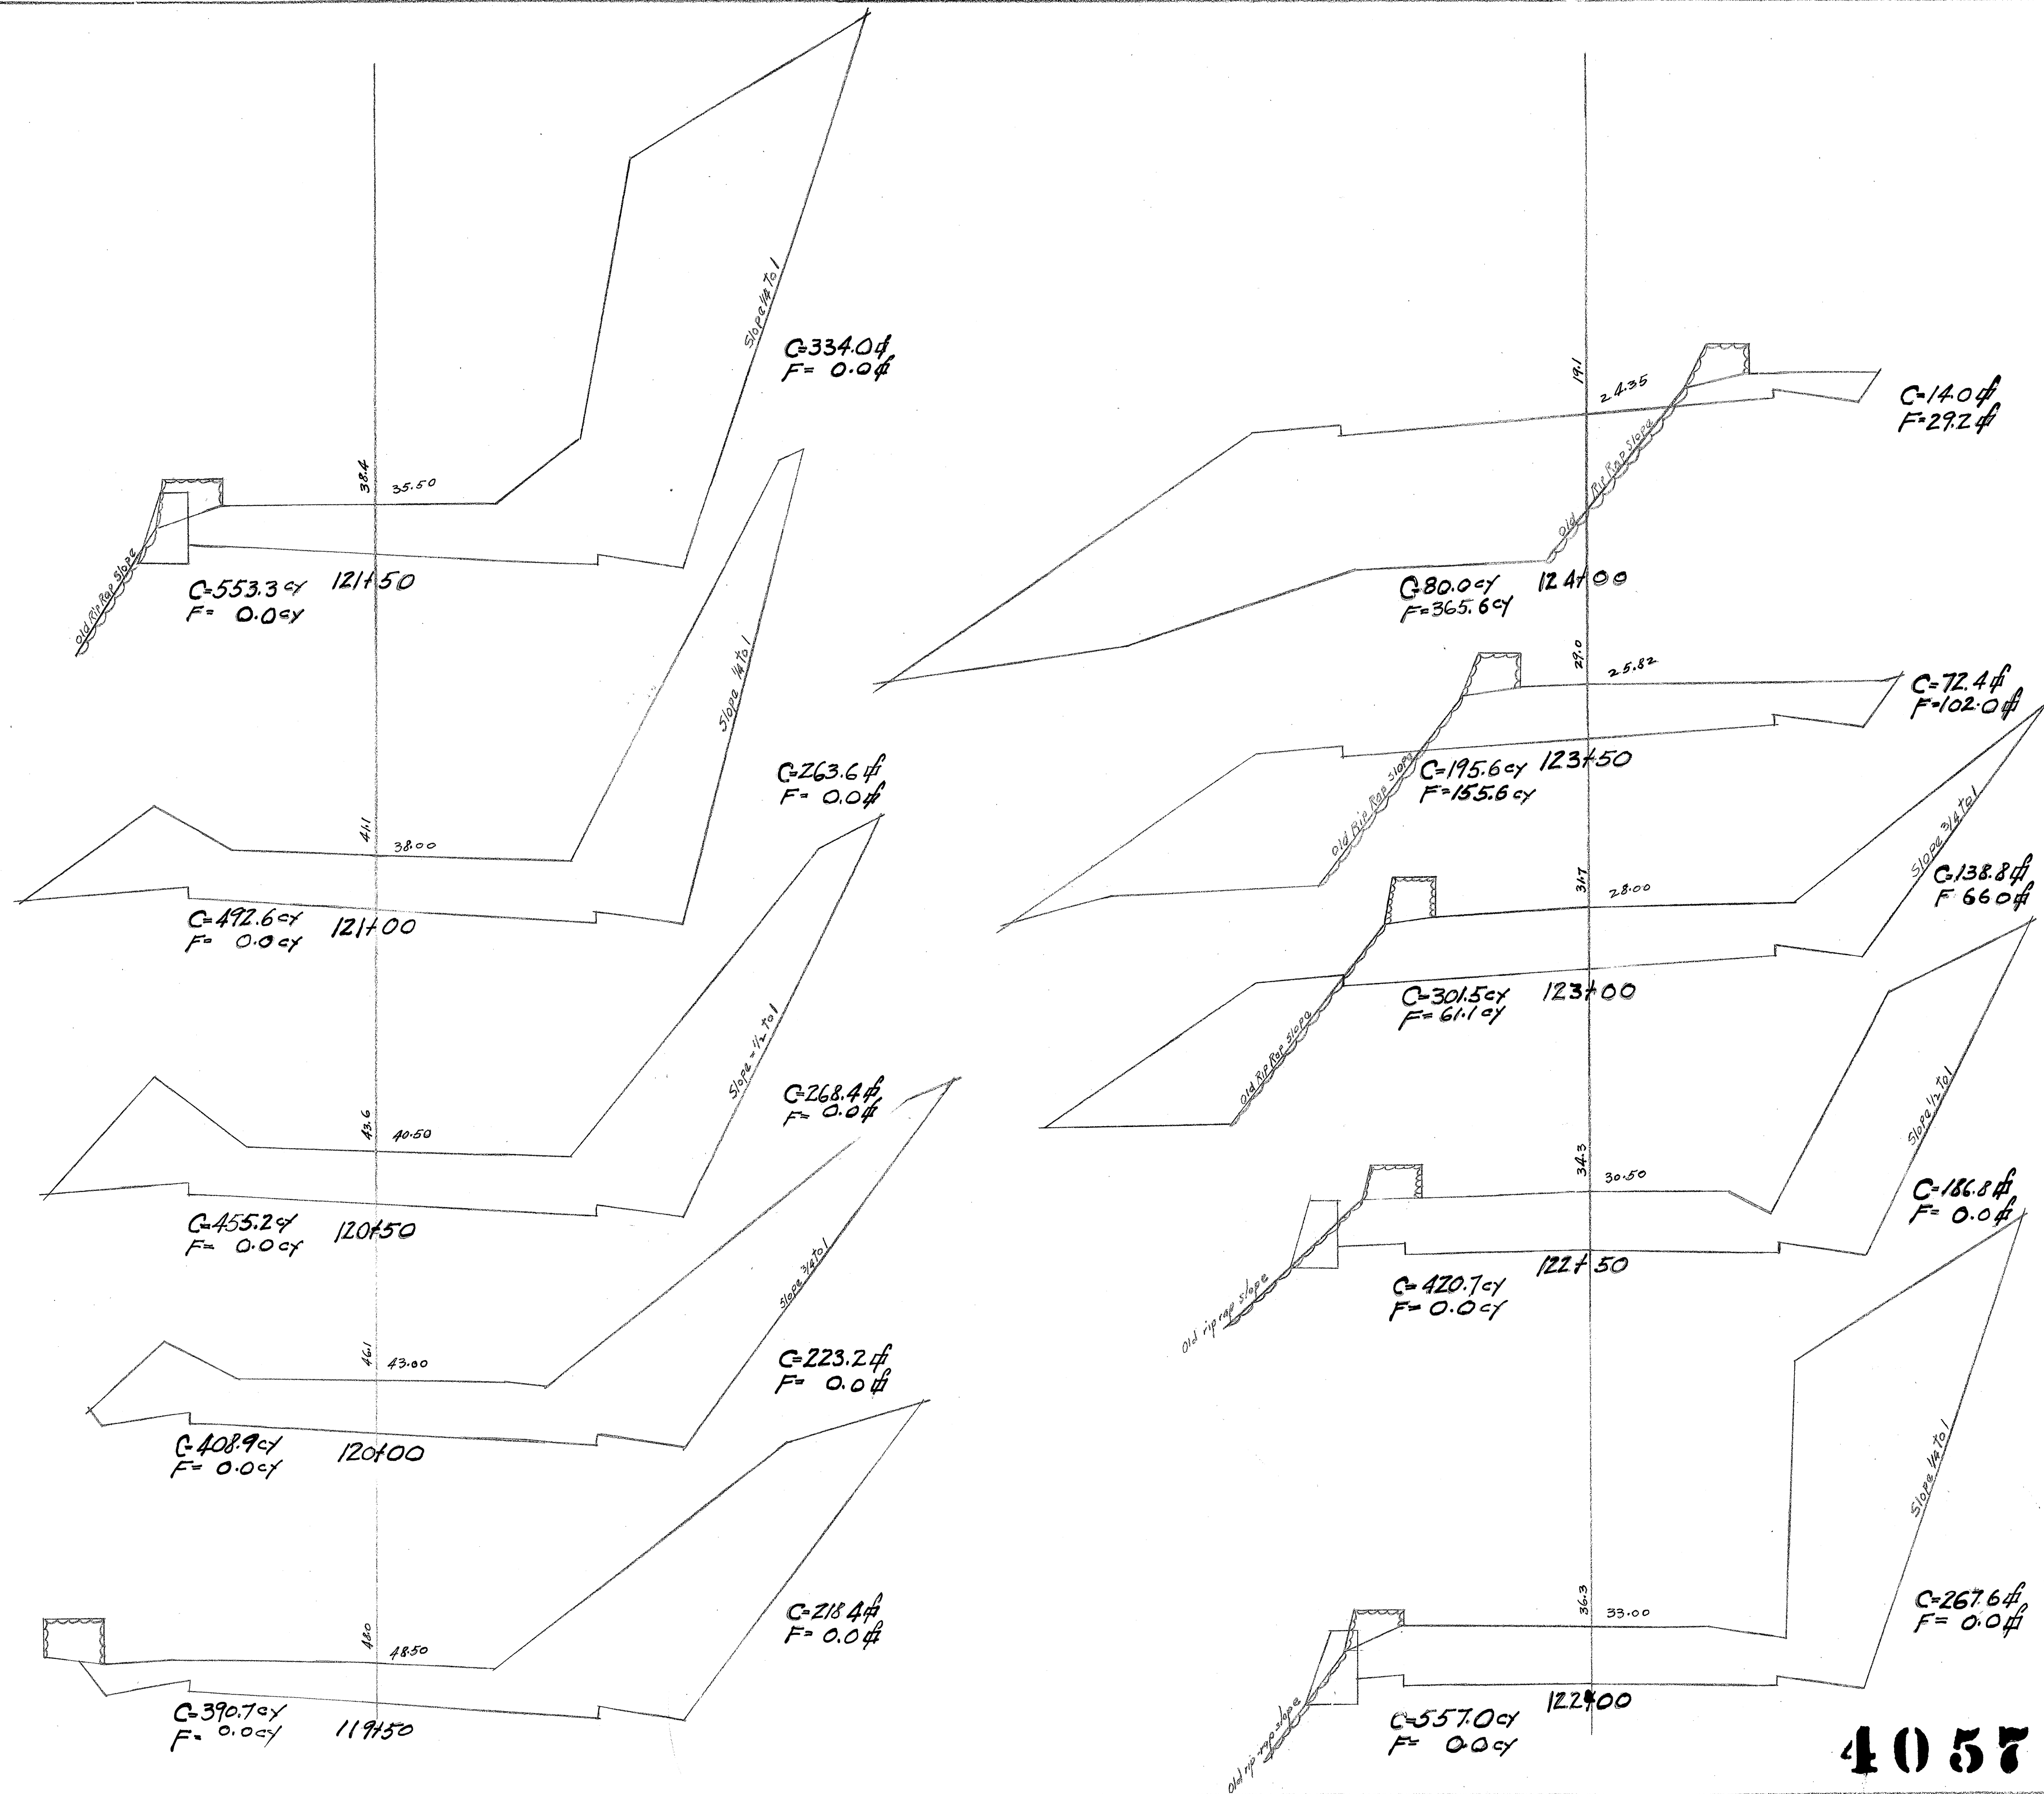


4057.30

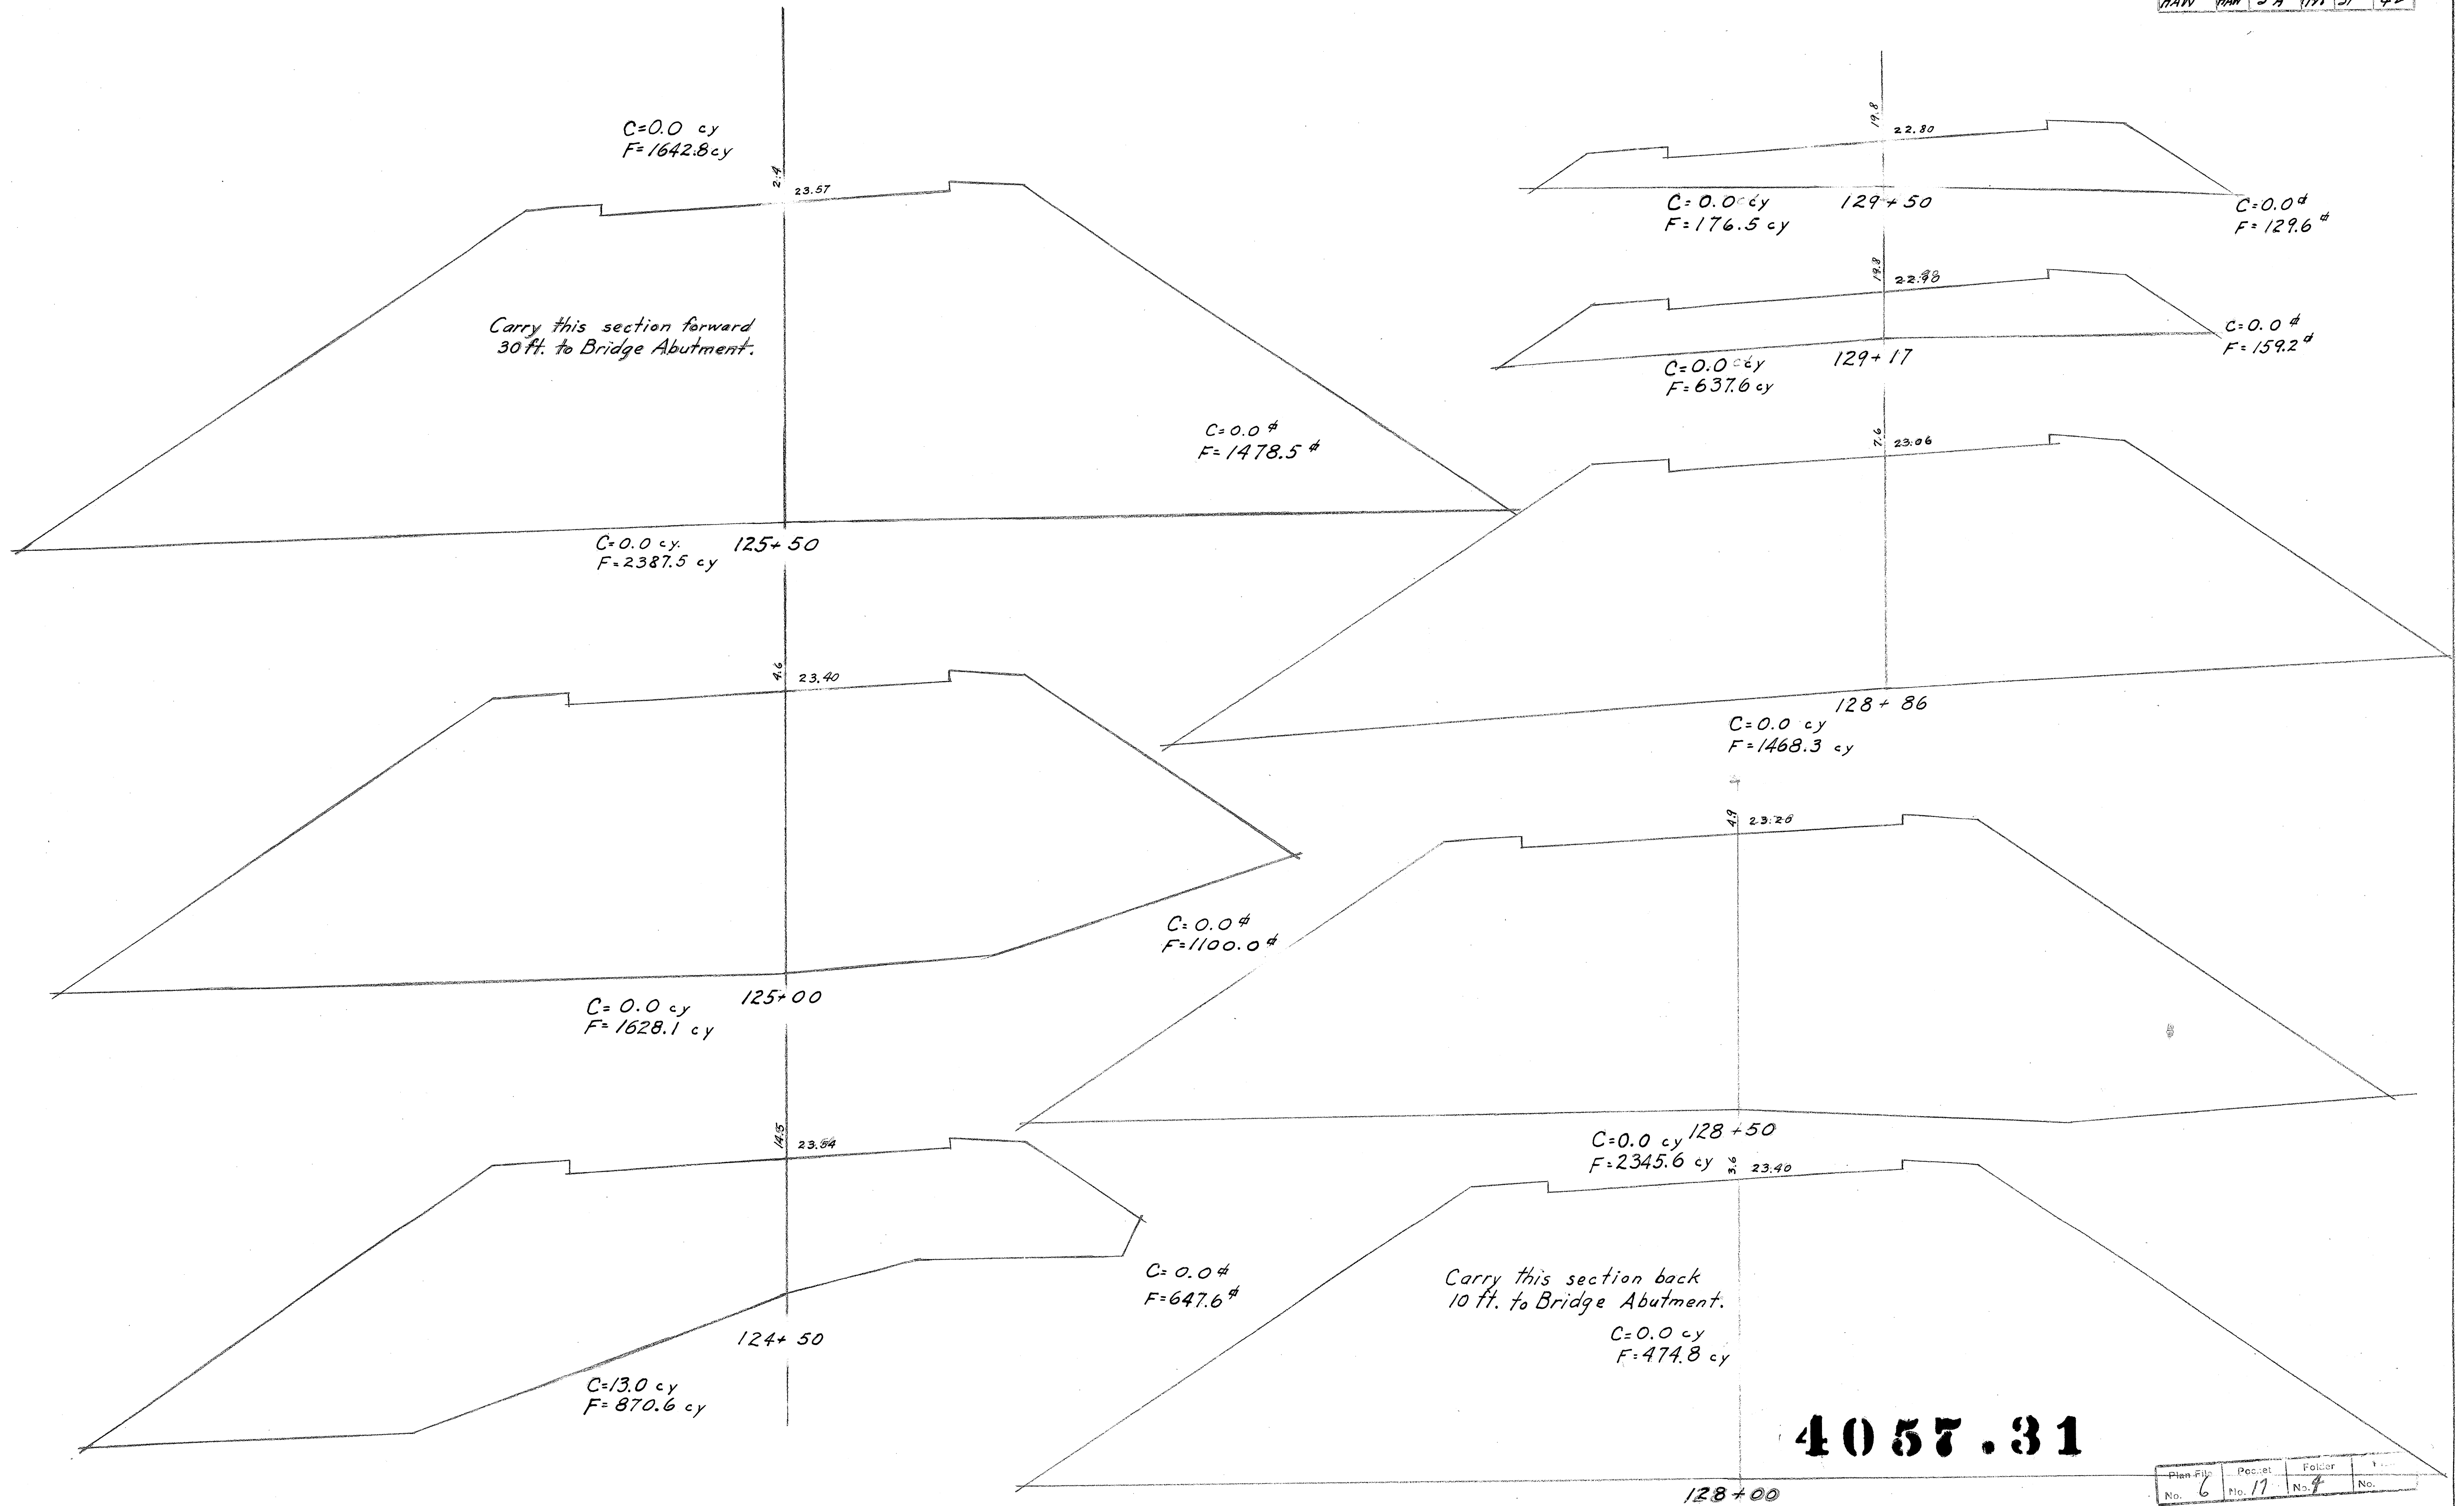



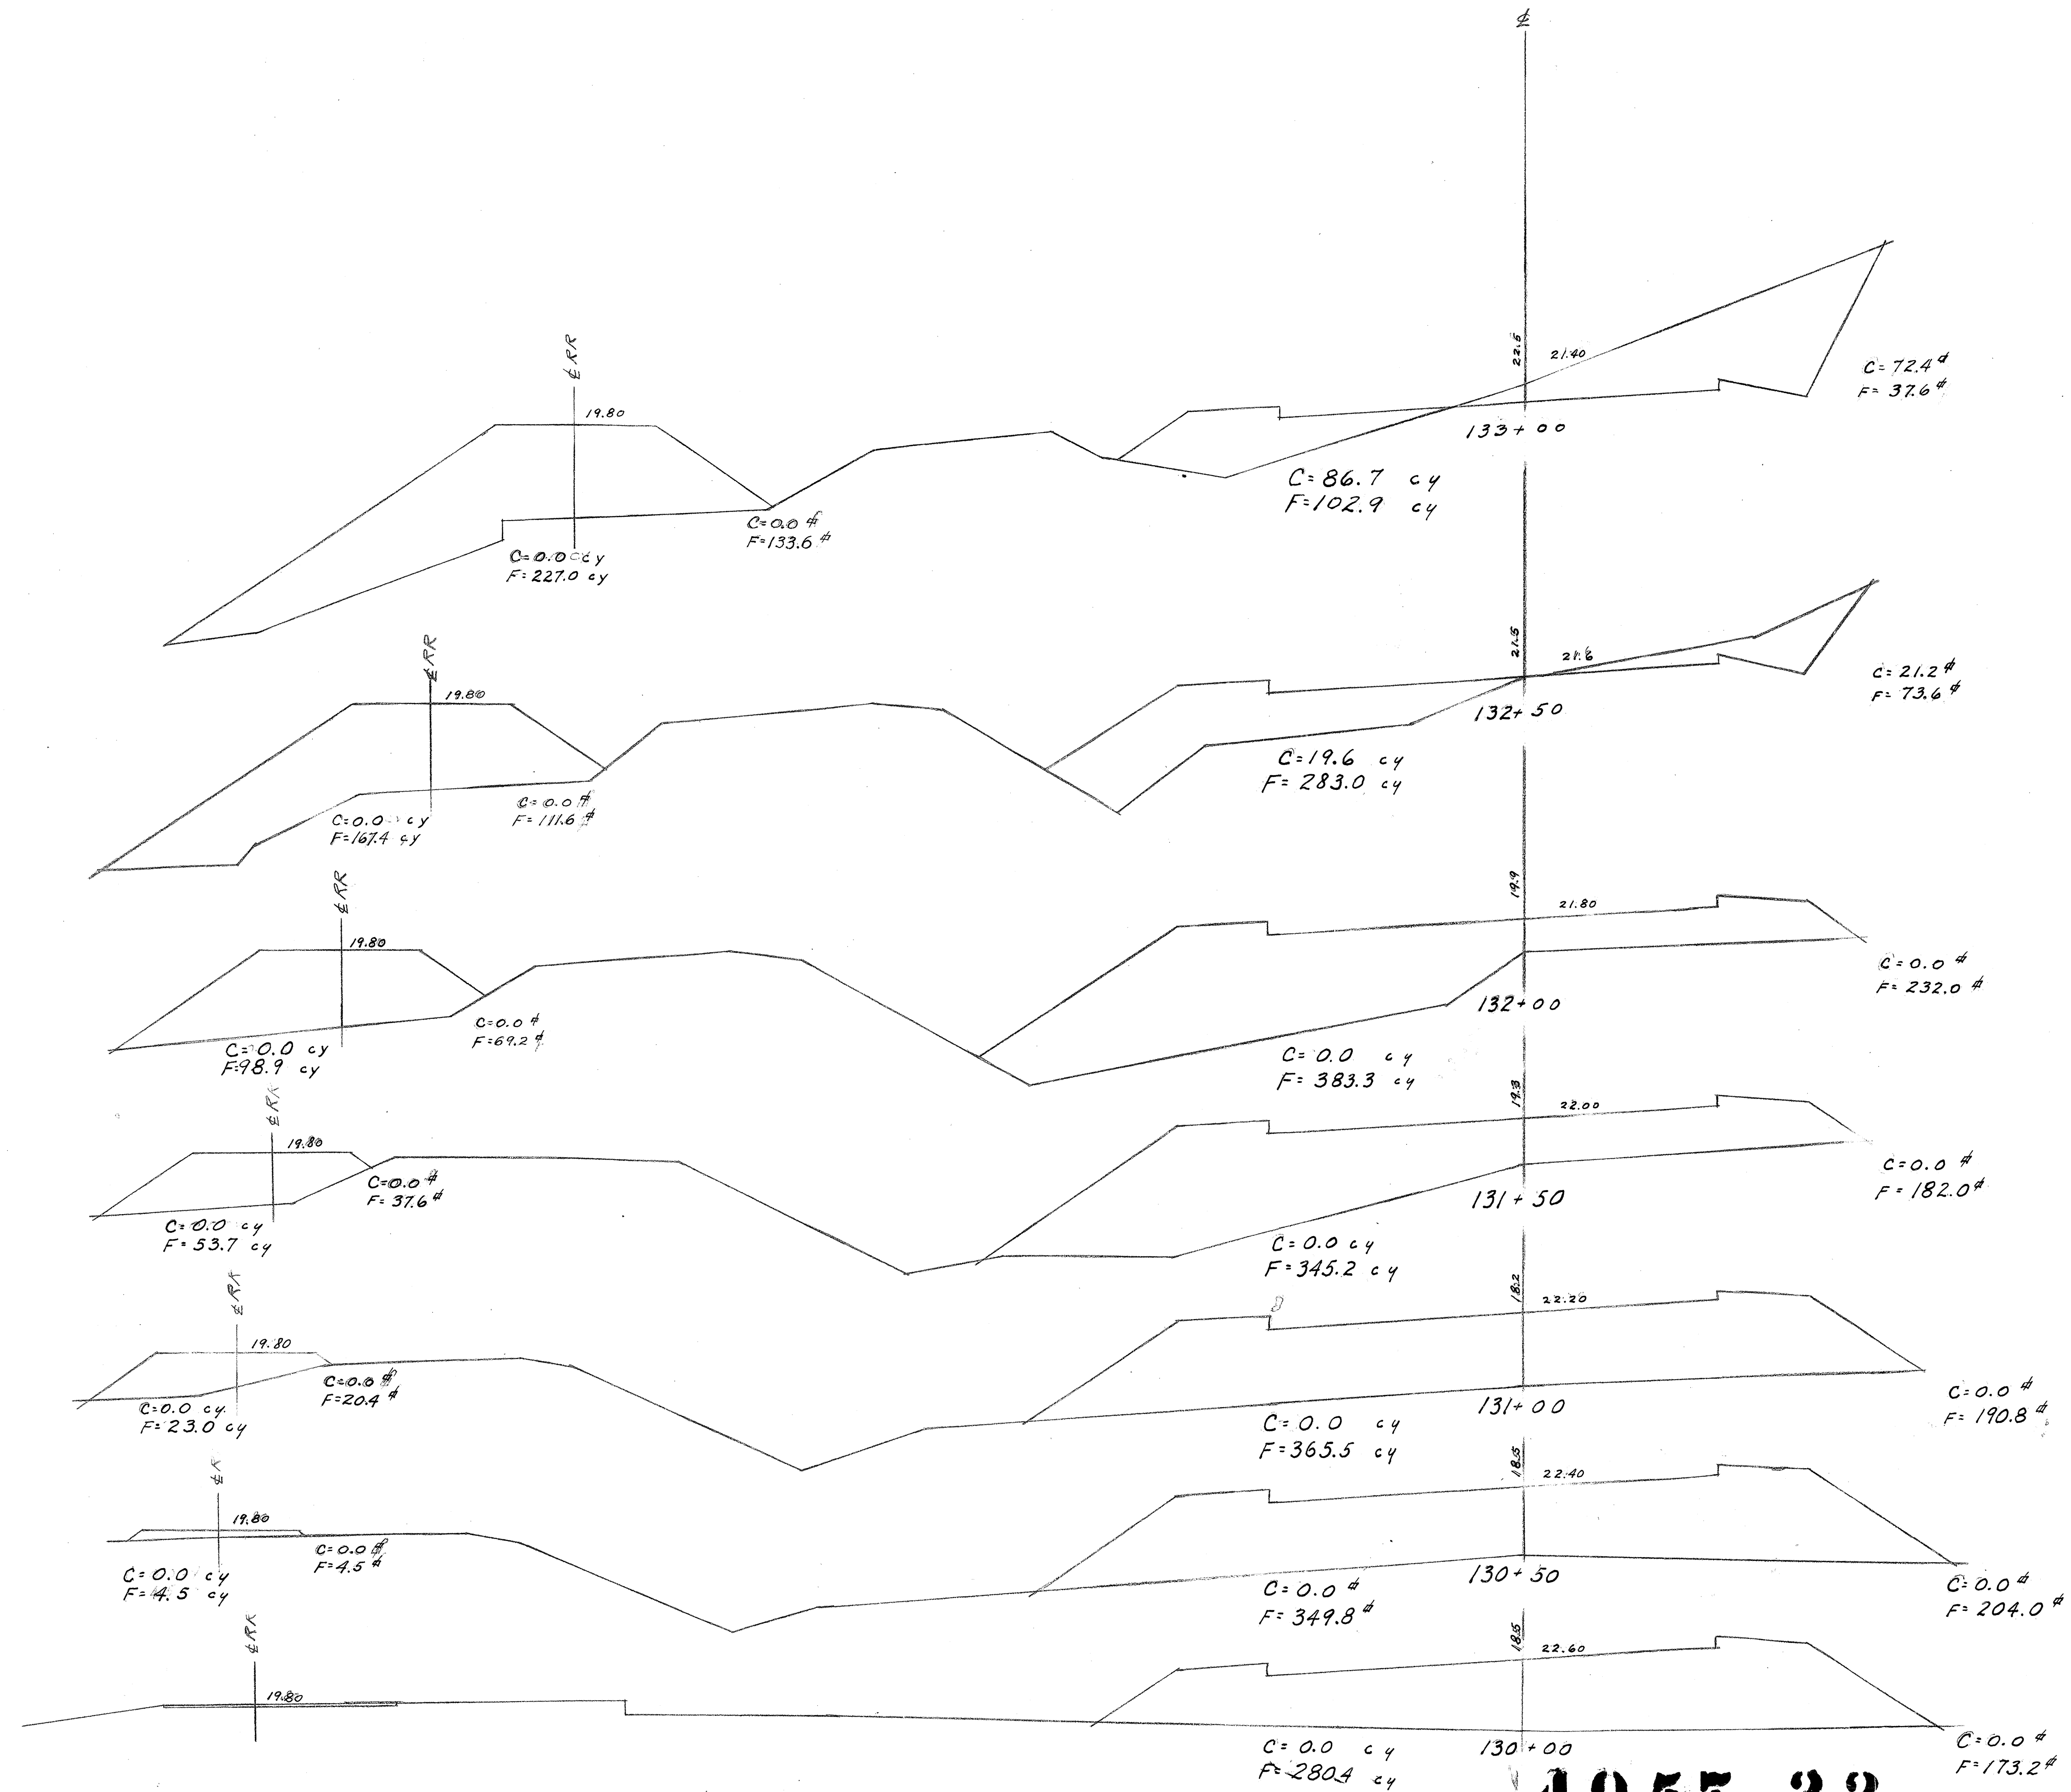


4057.32






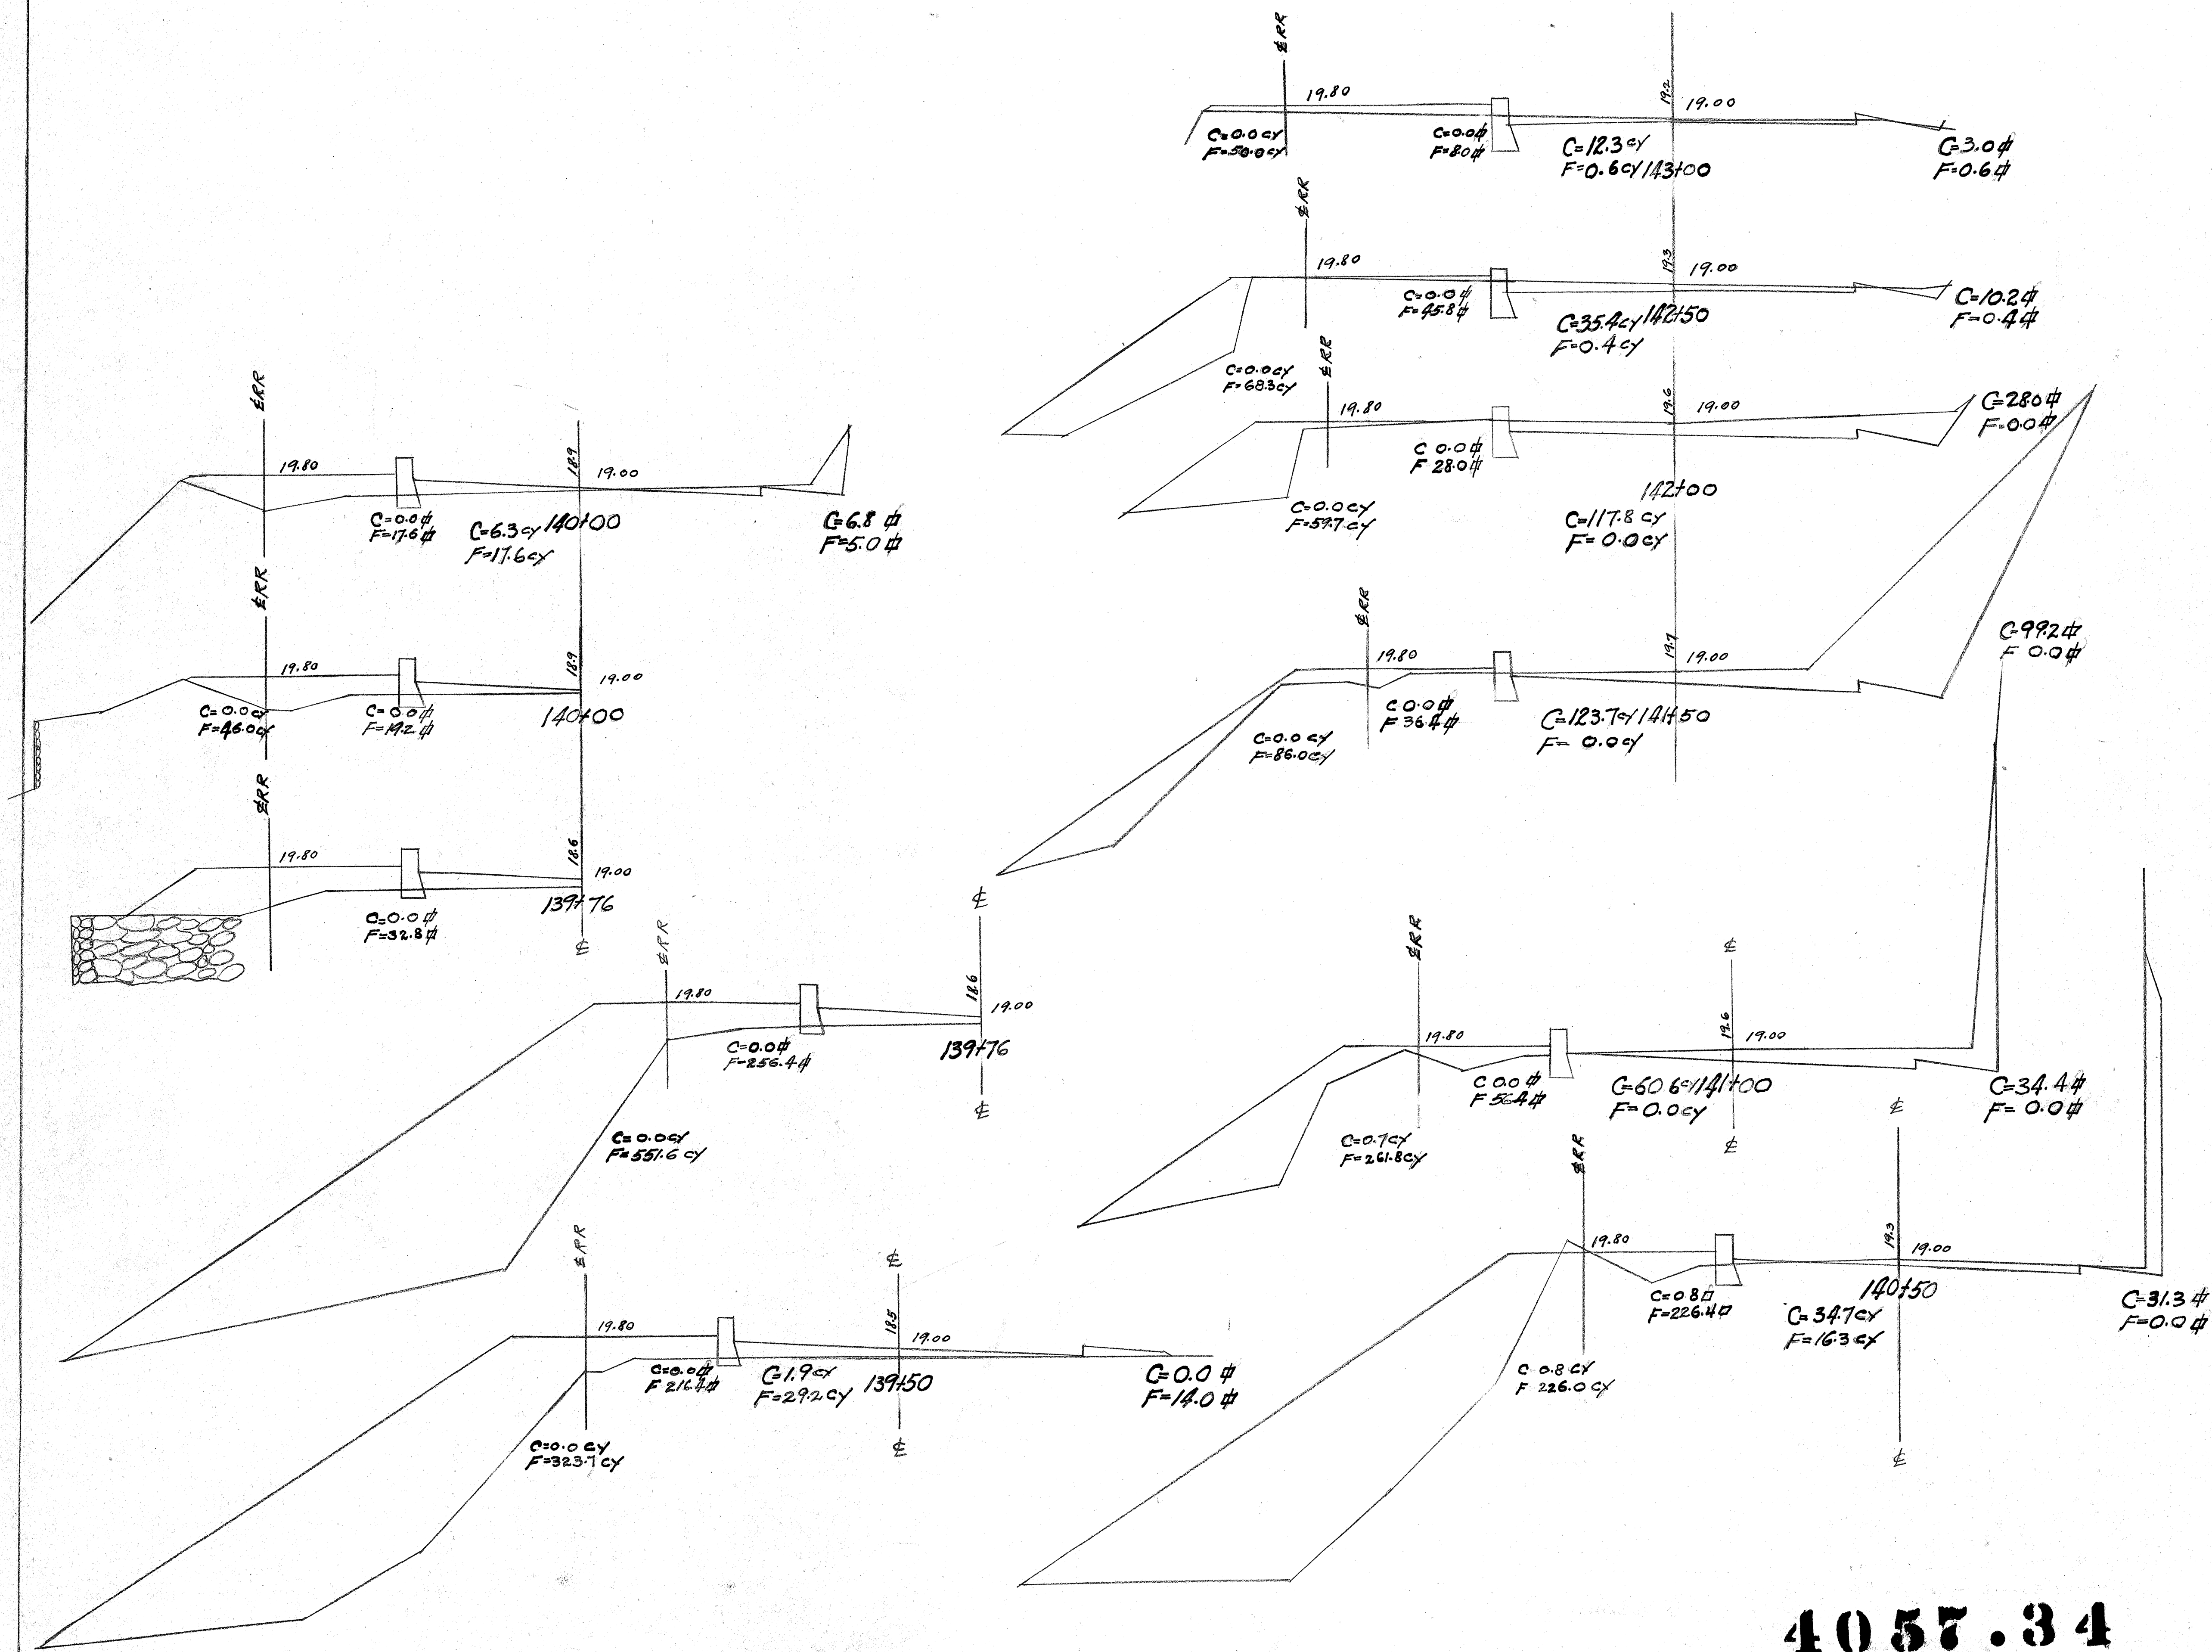


4057.34

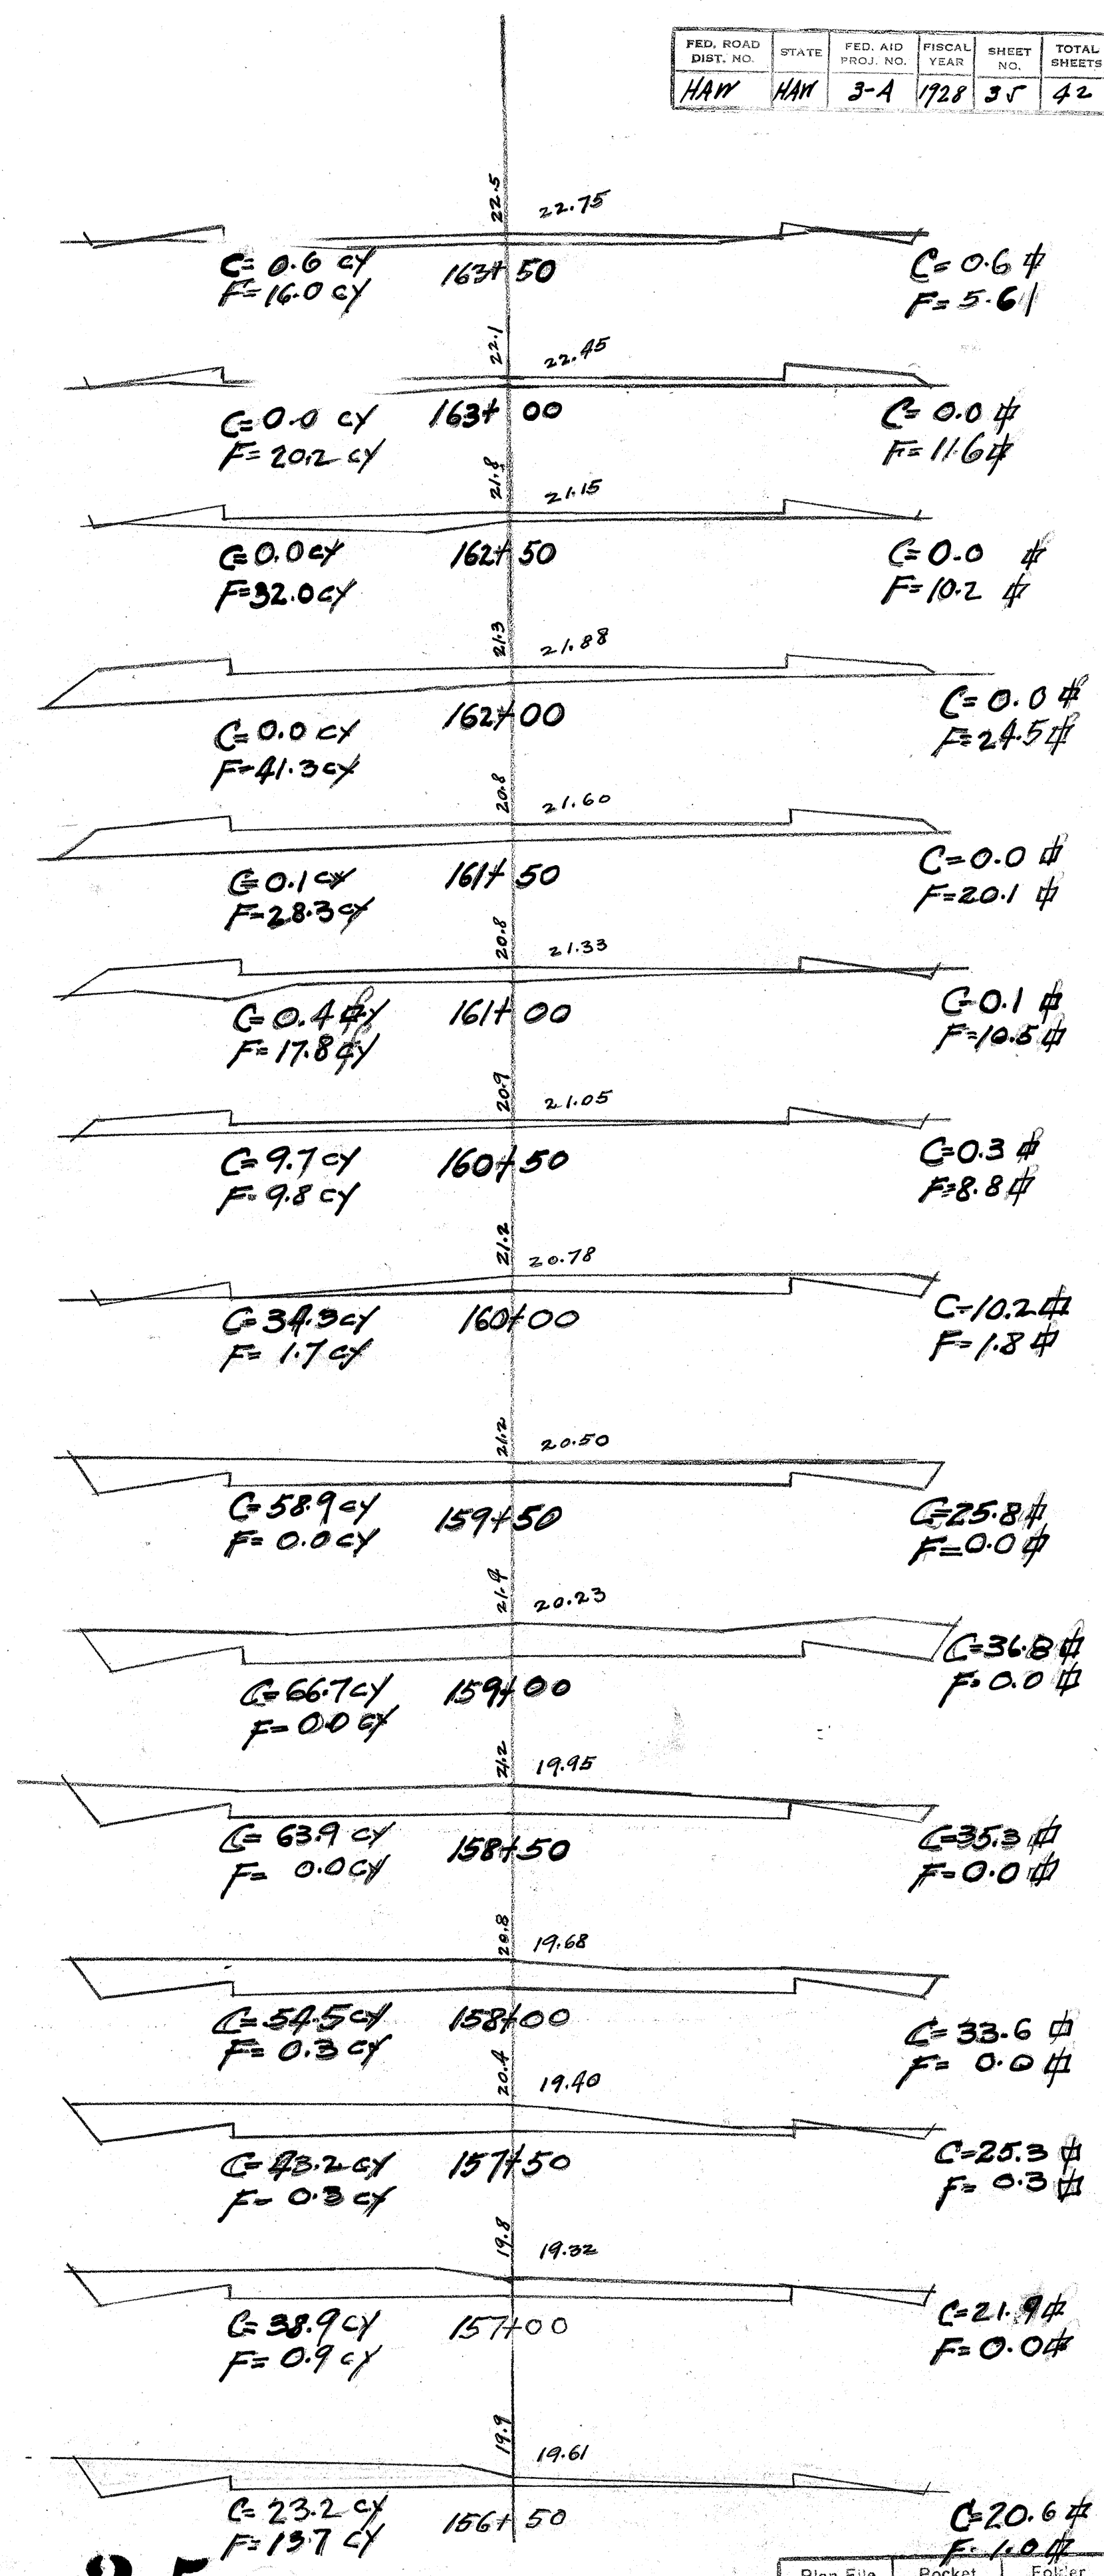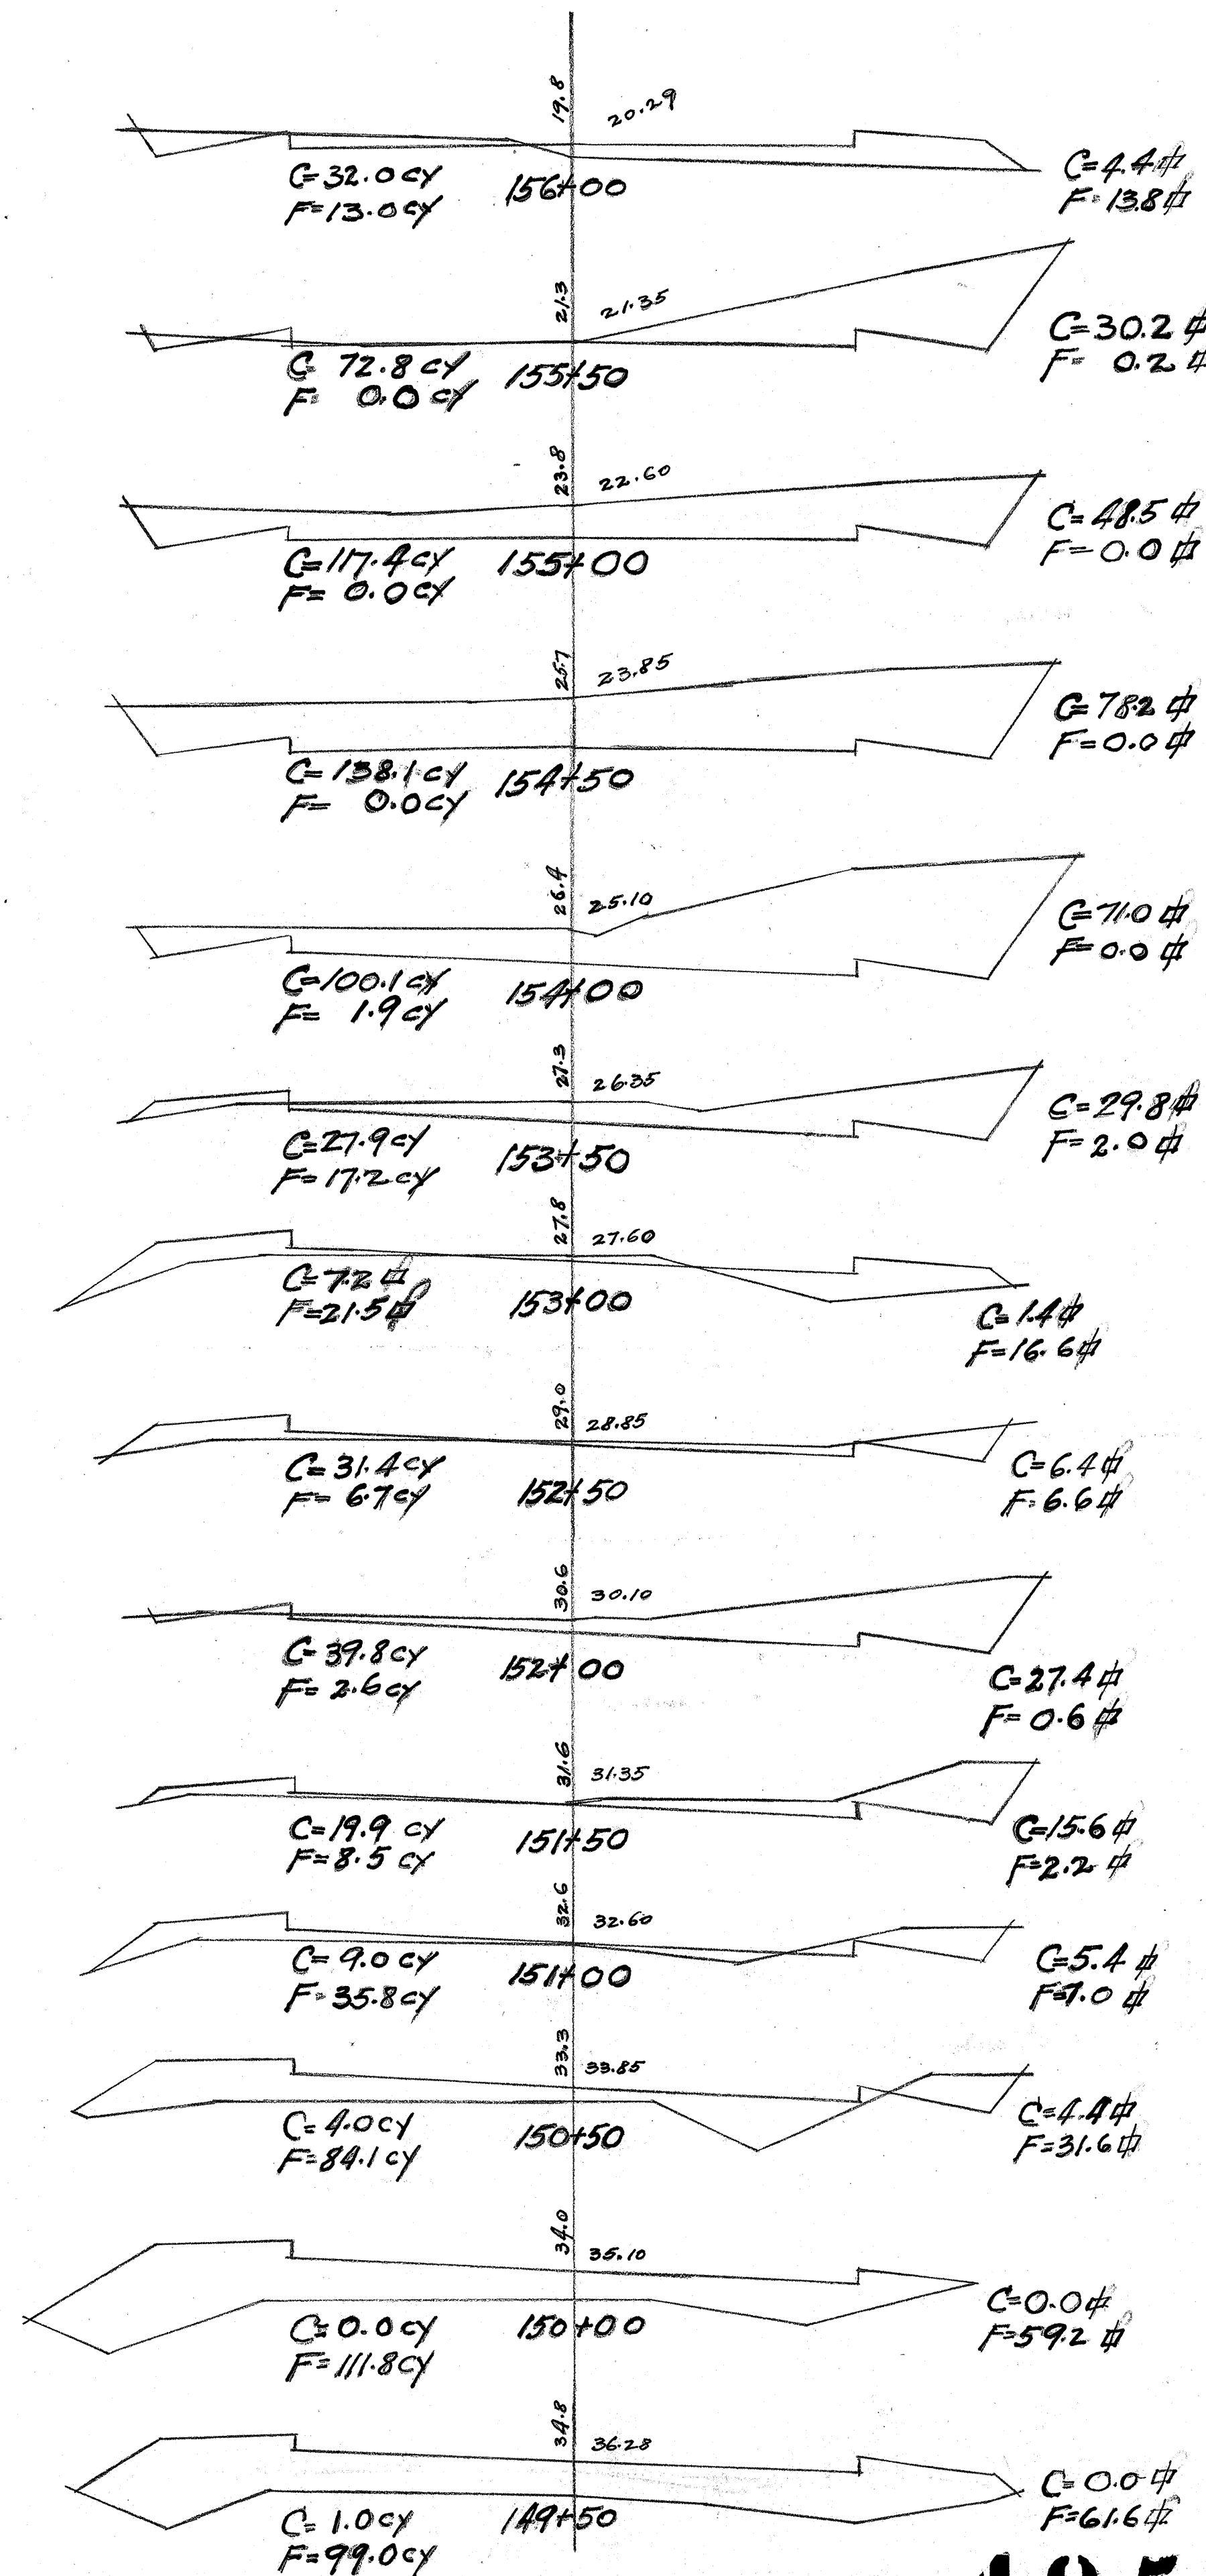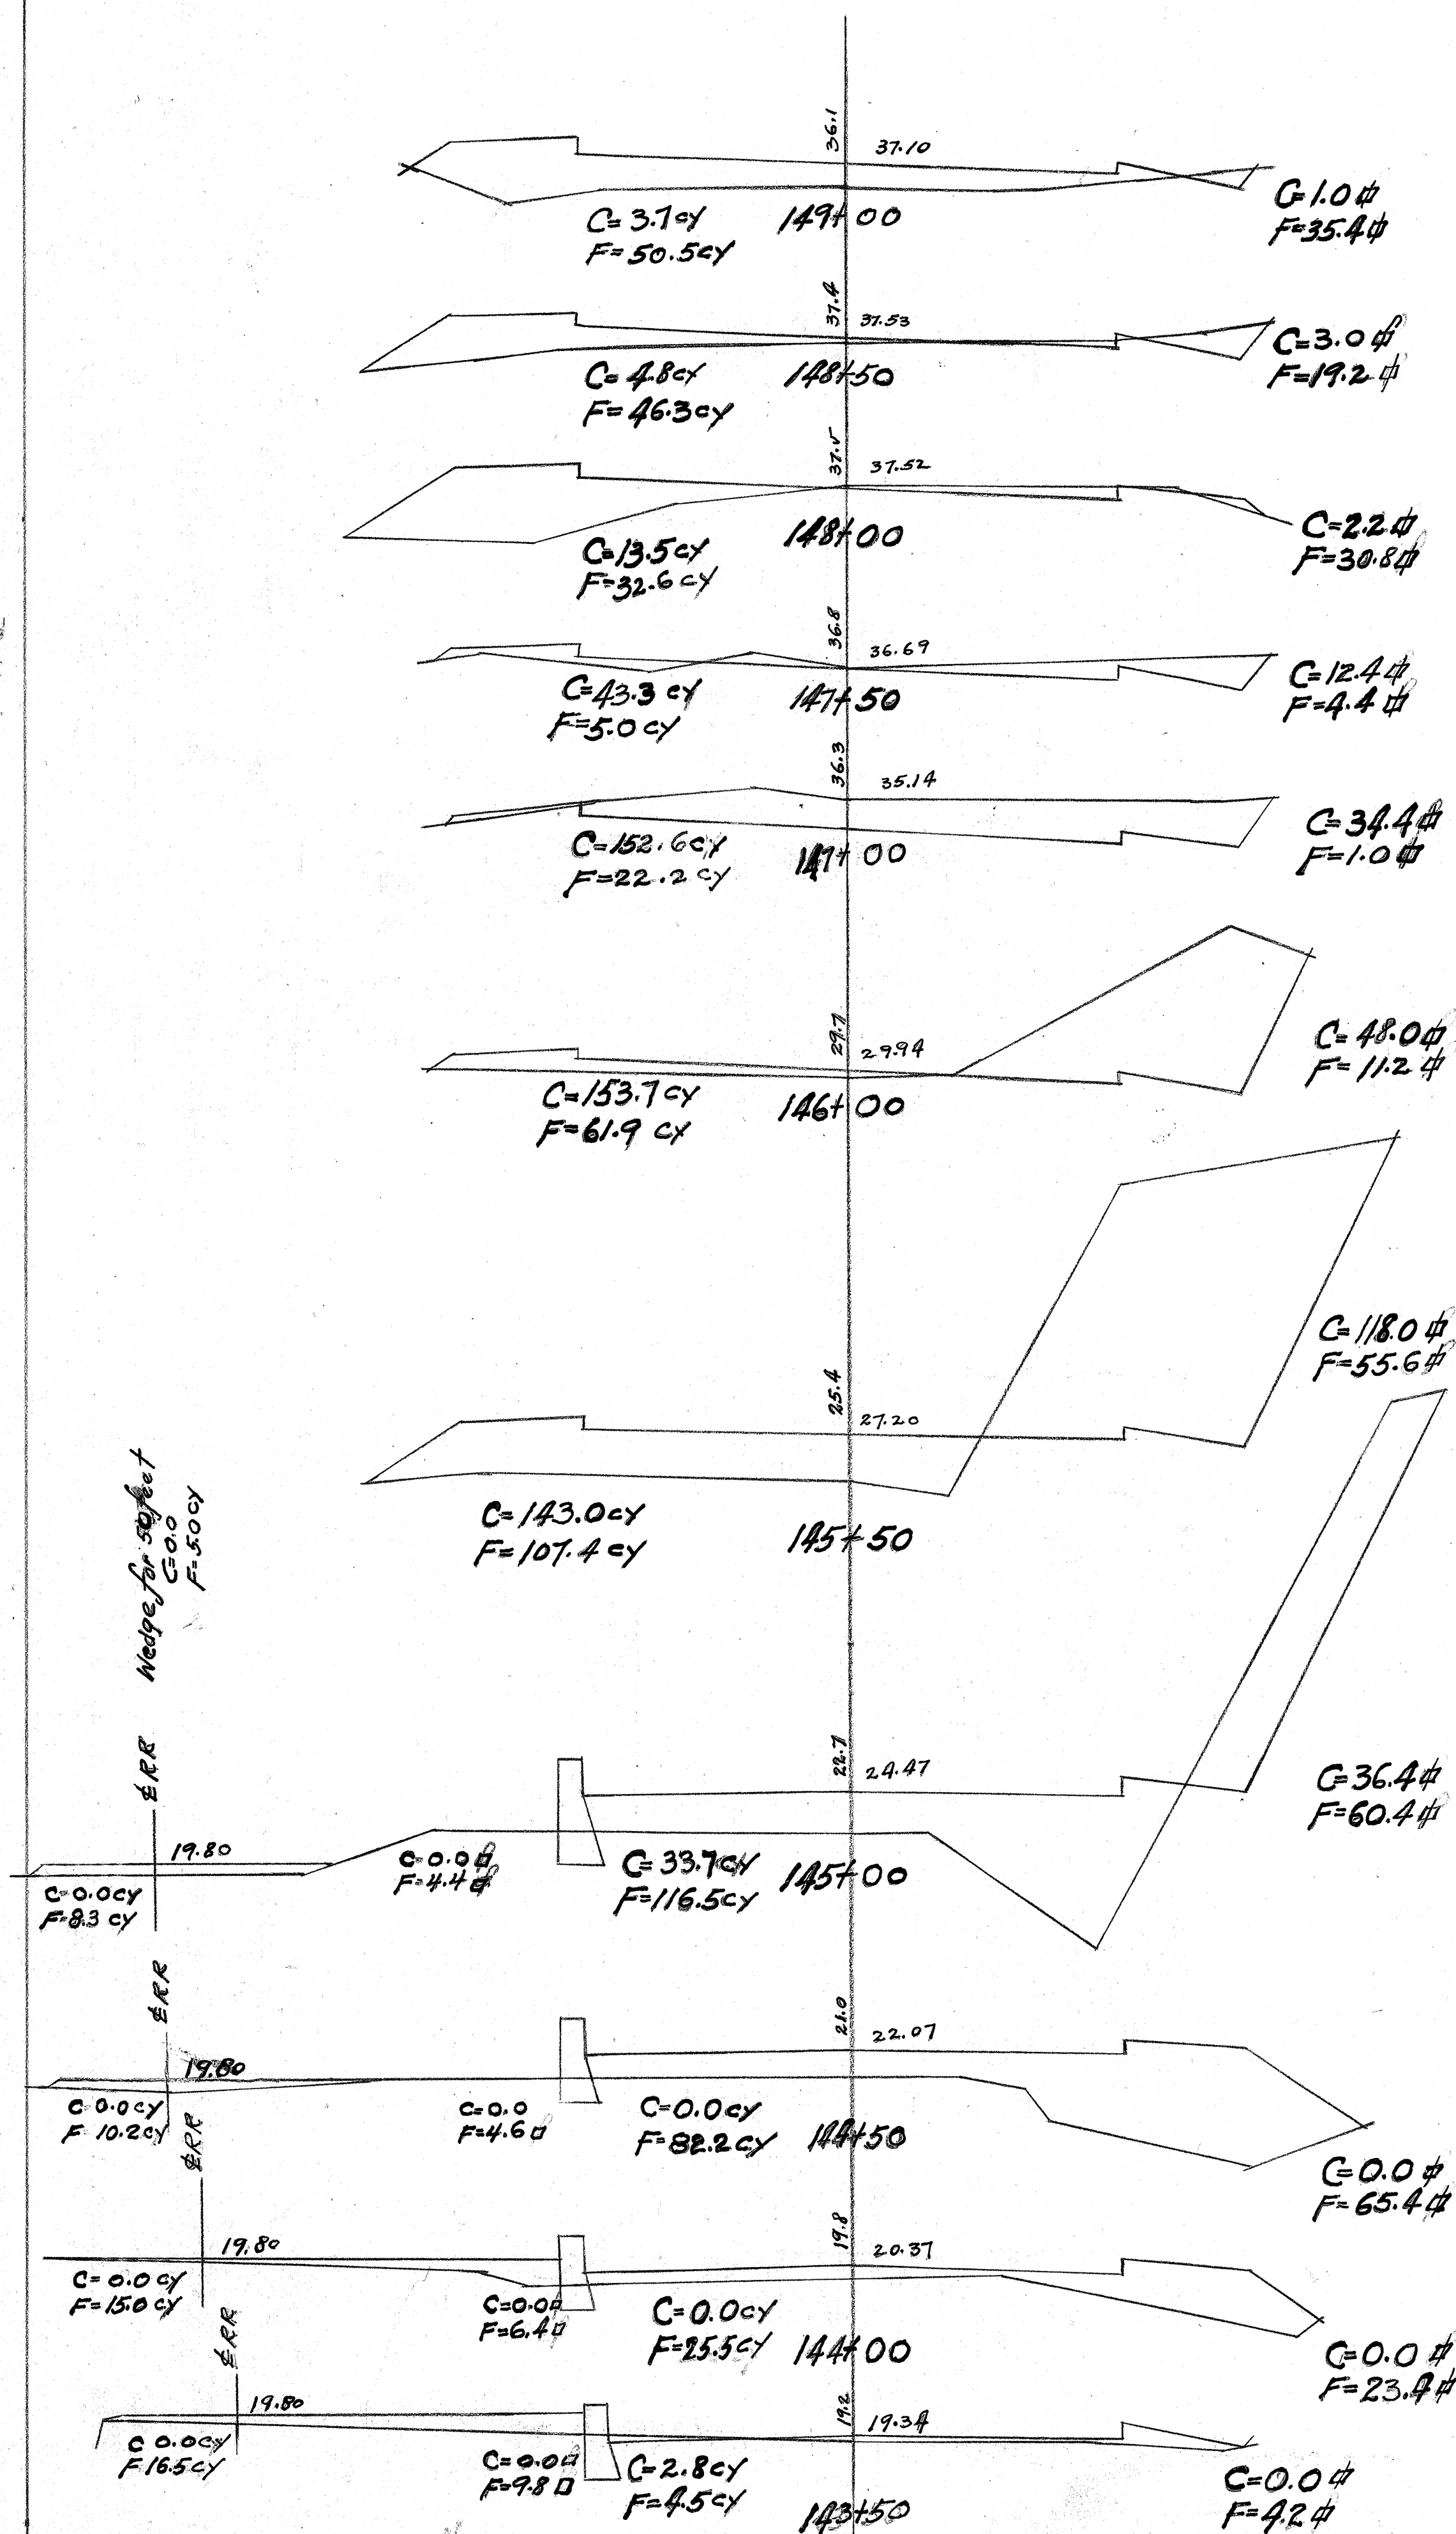




4057.35

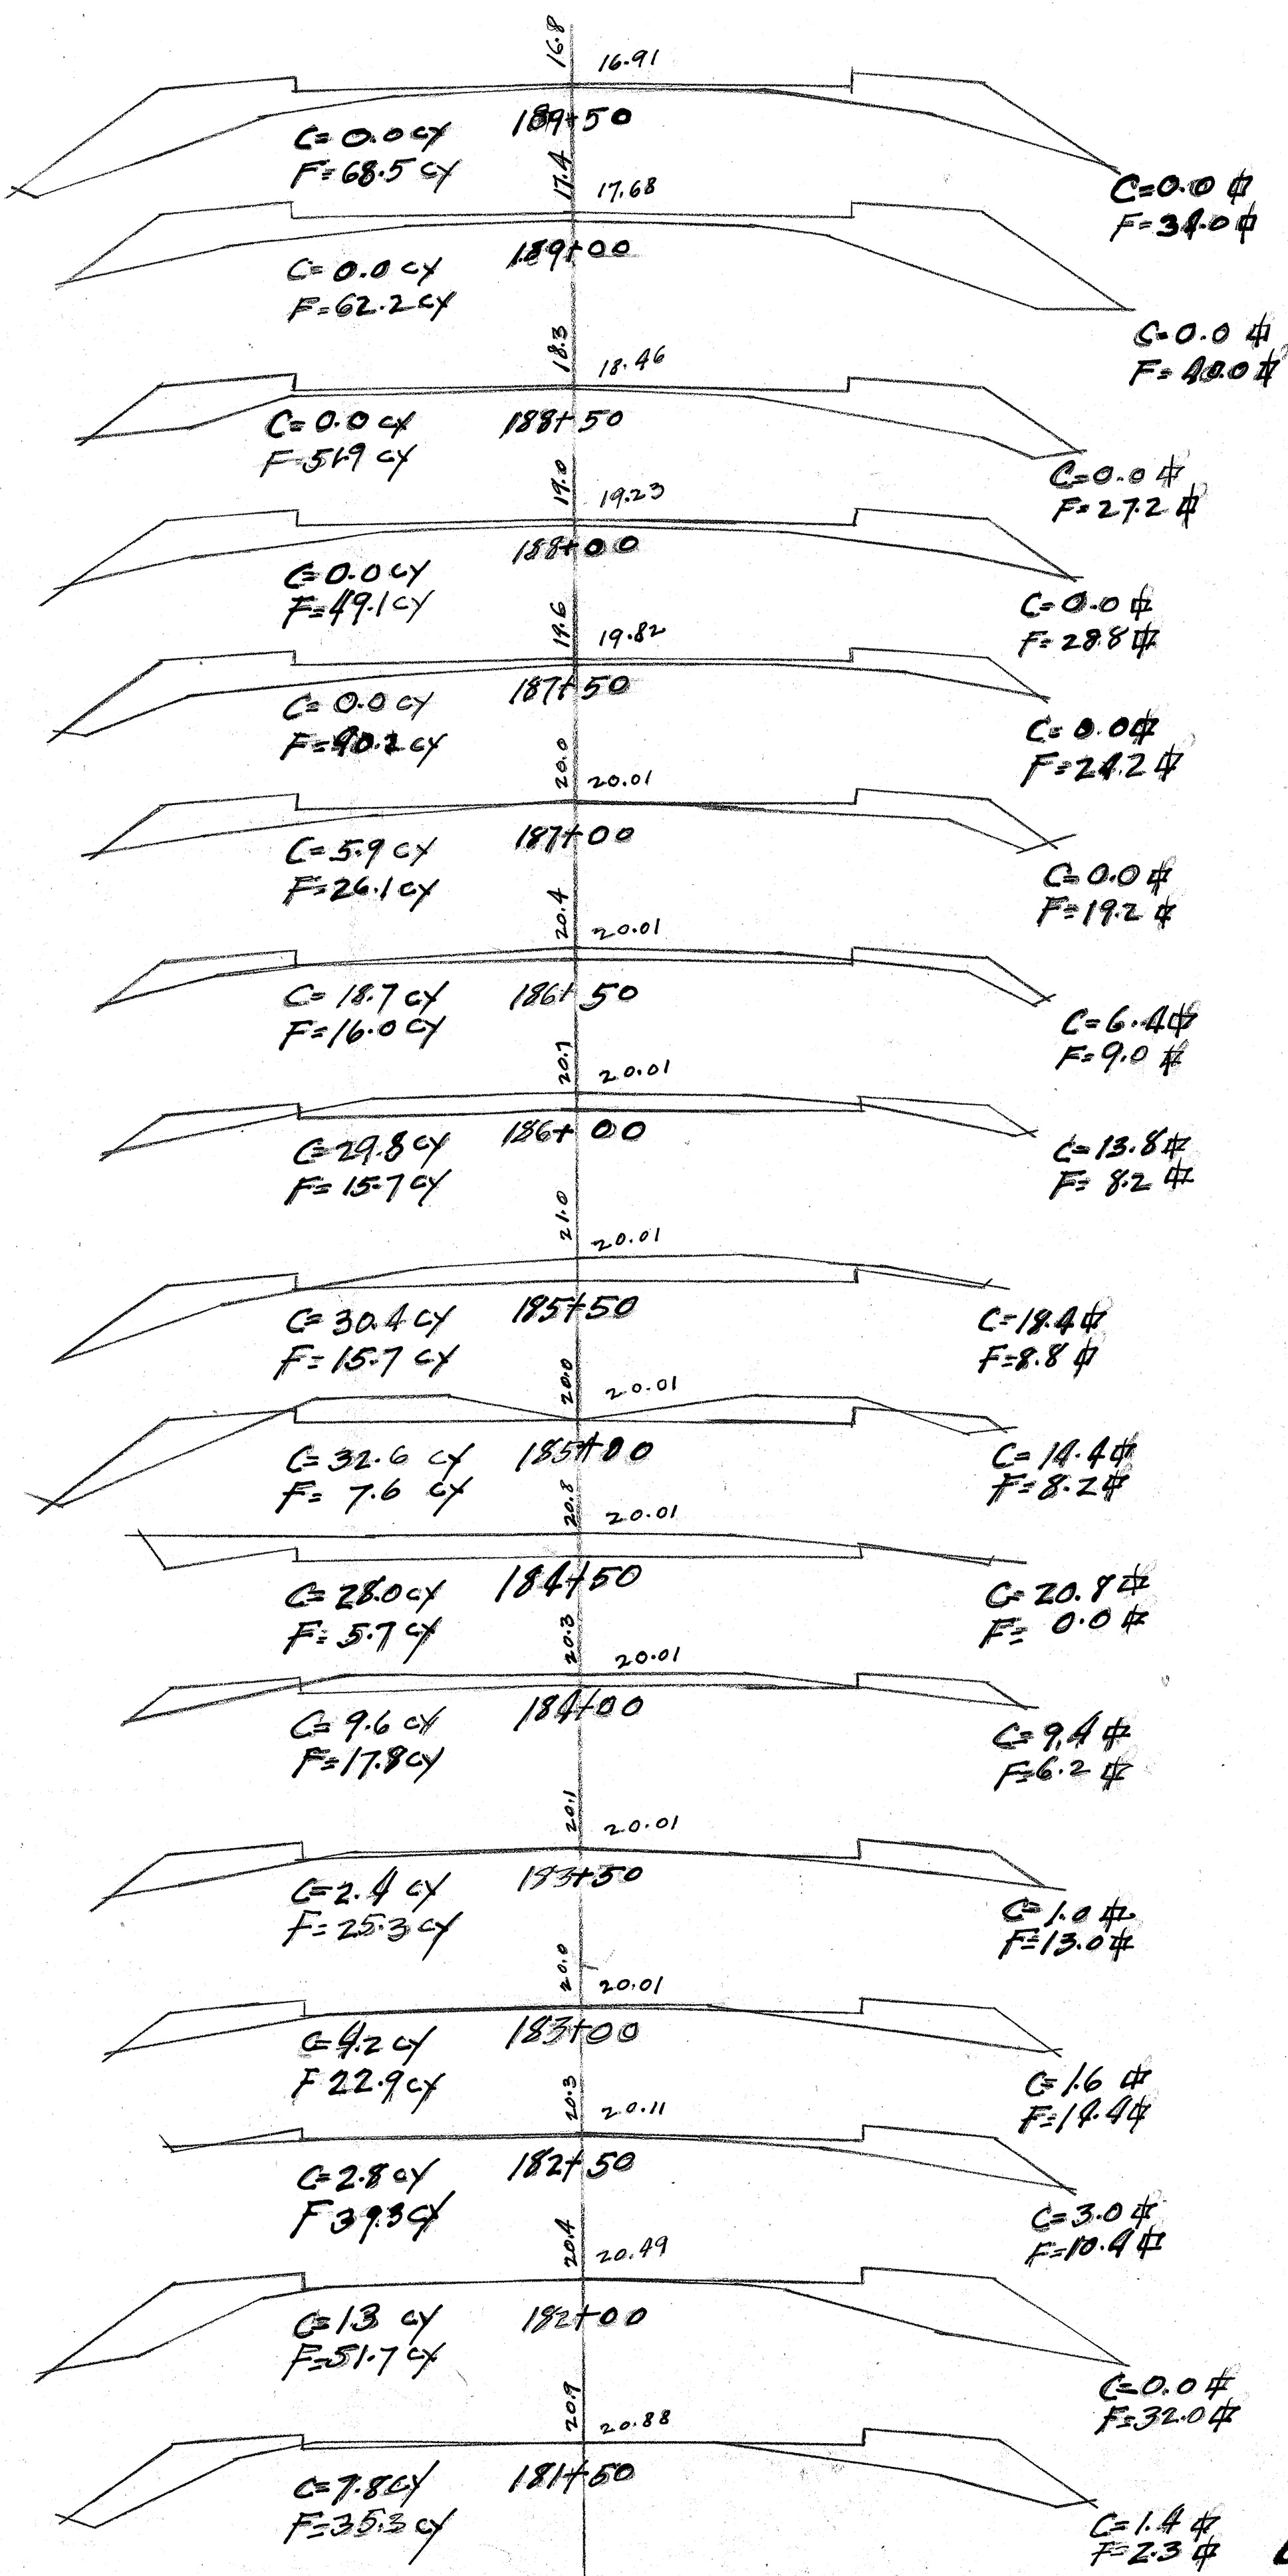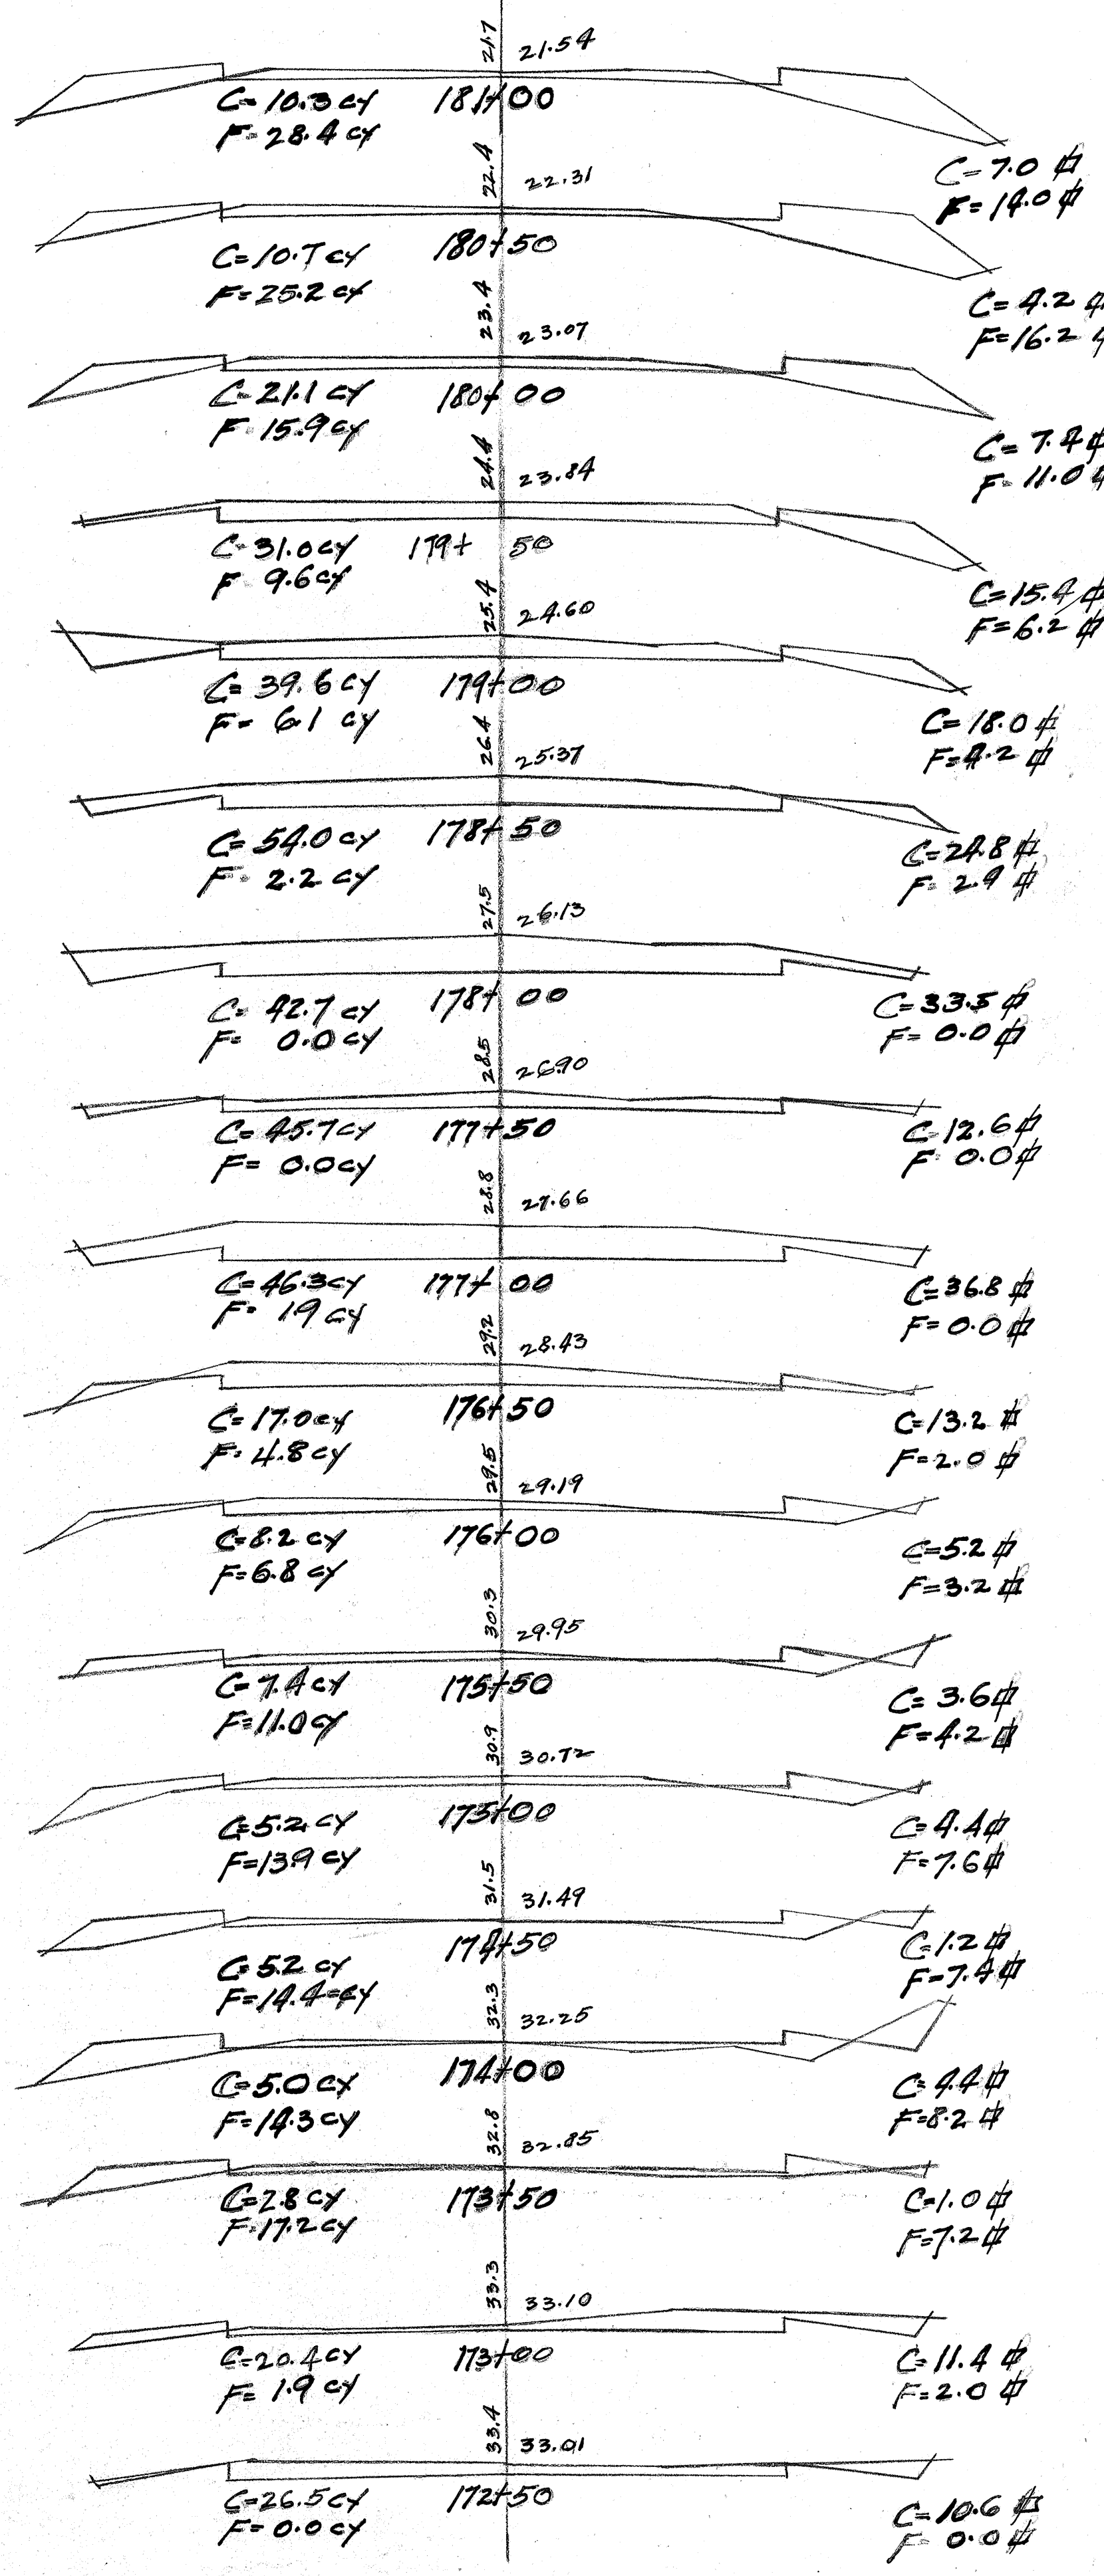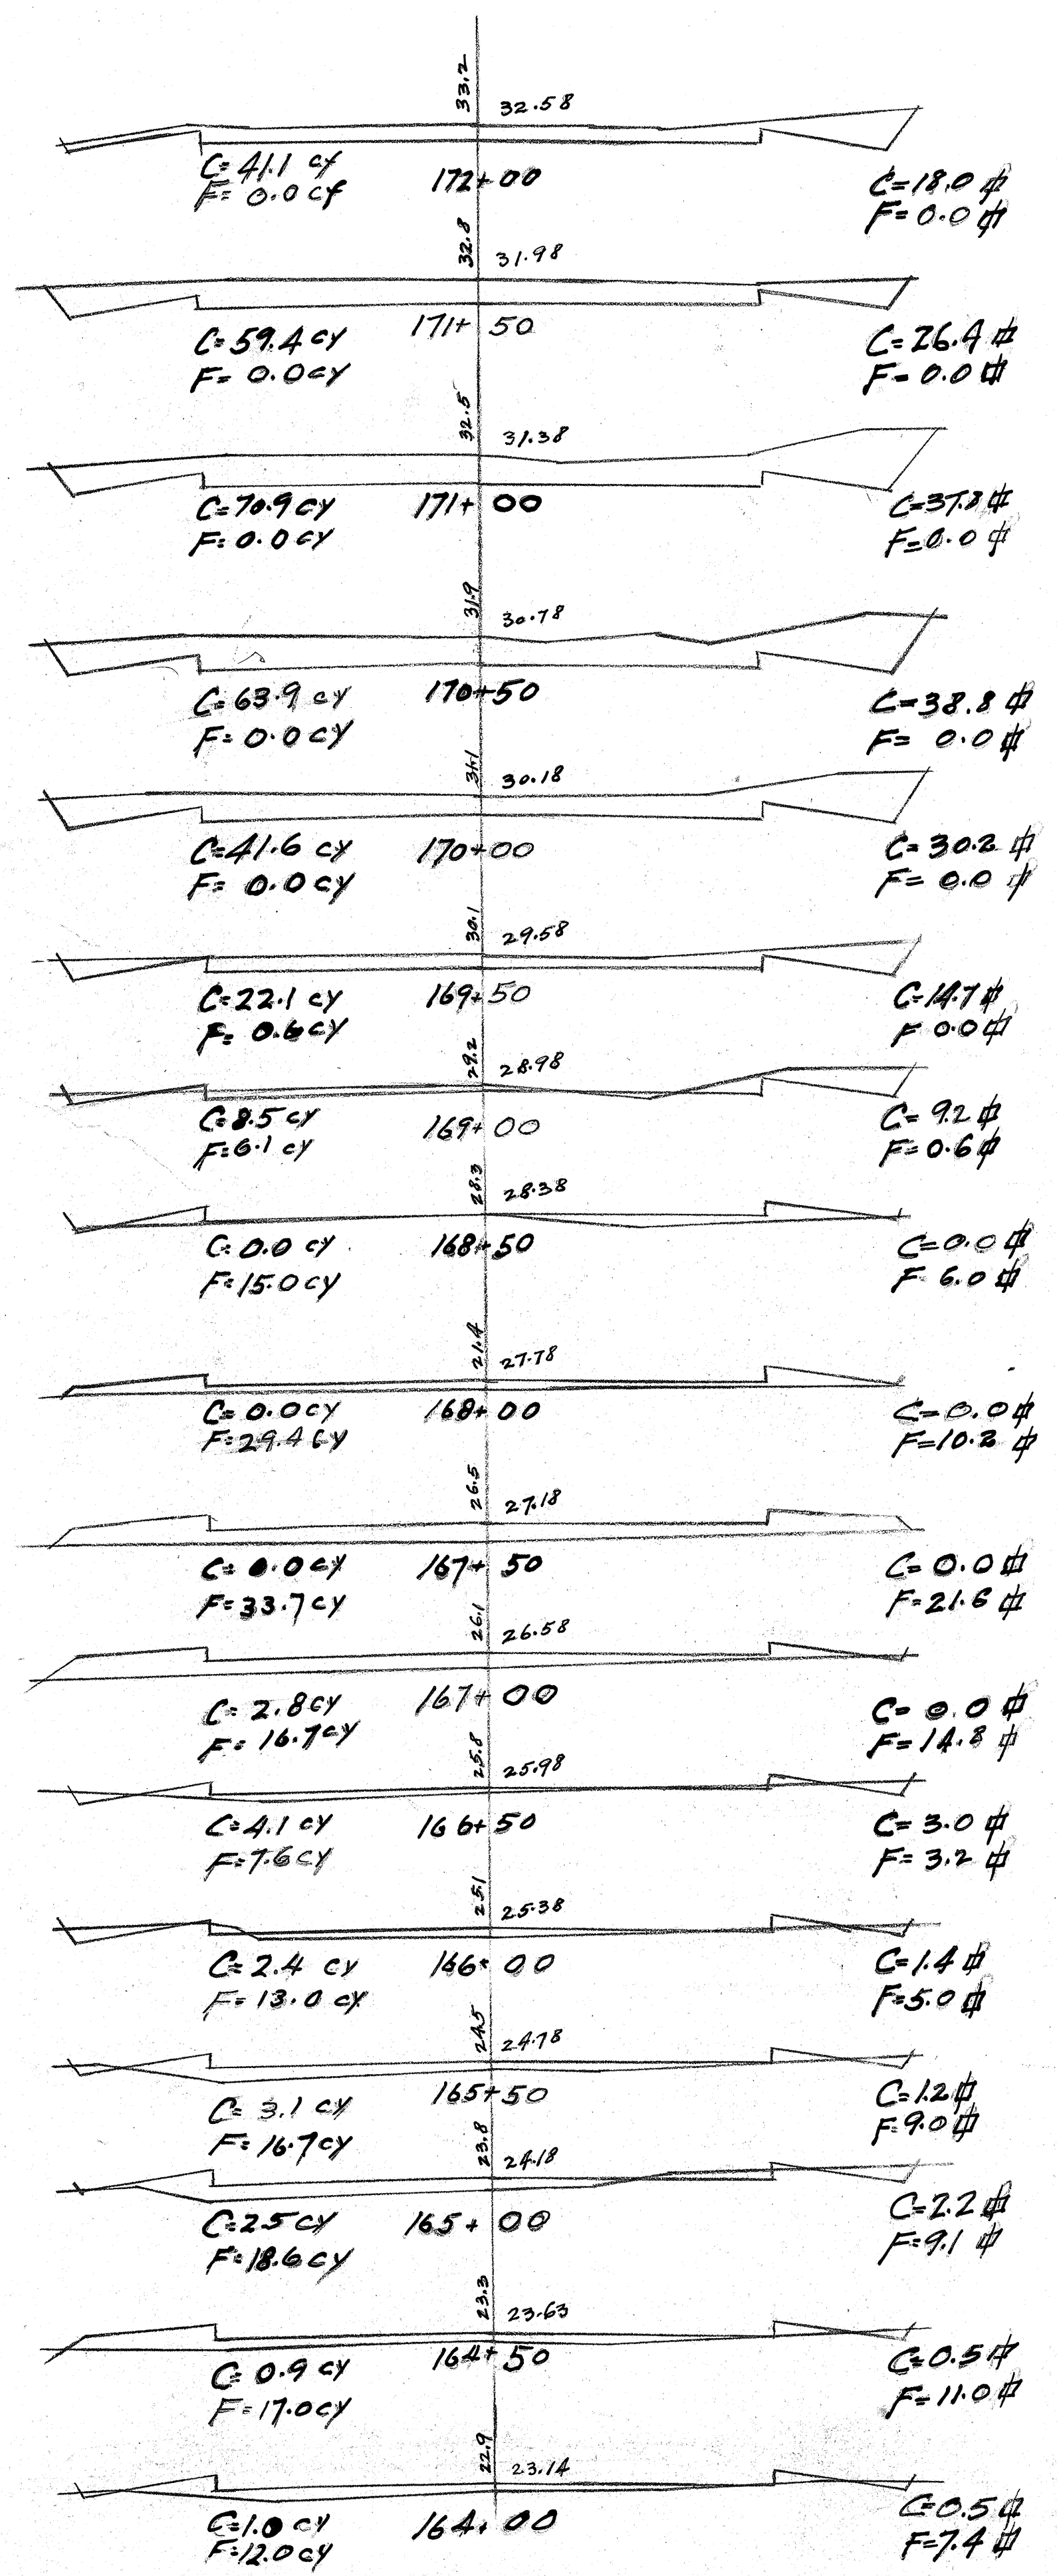

4055.36



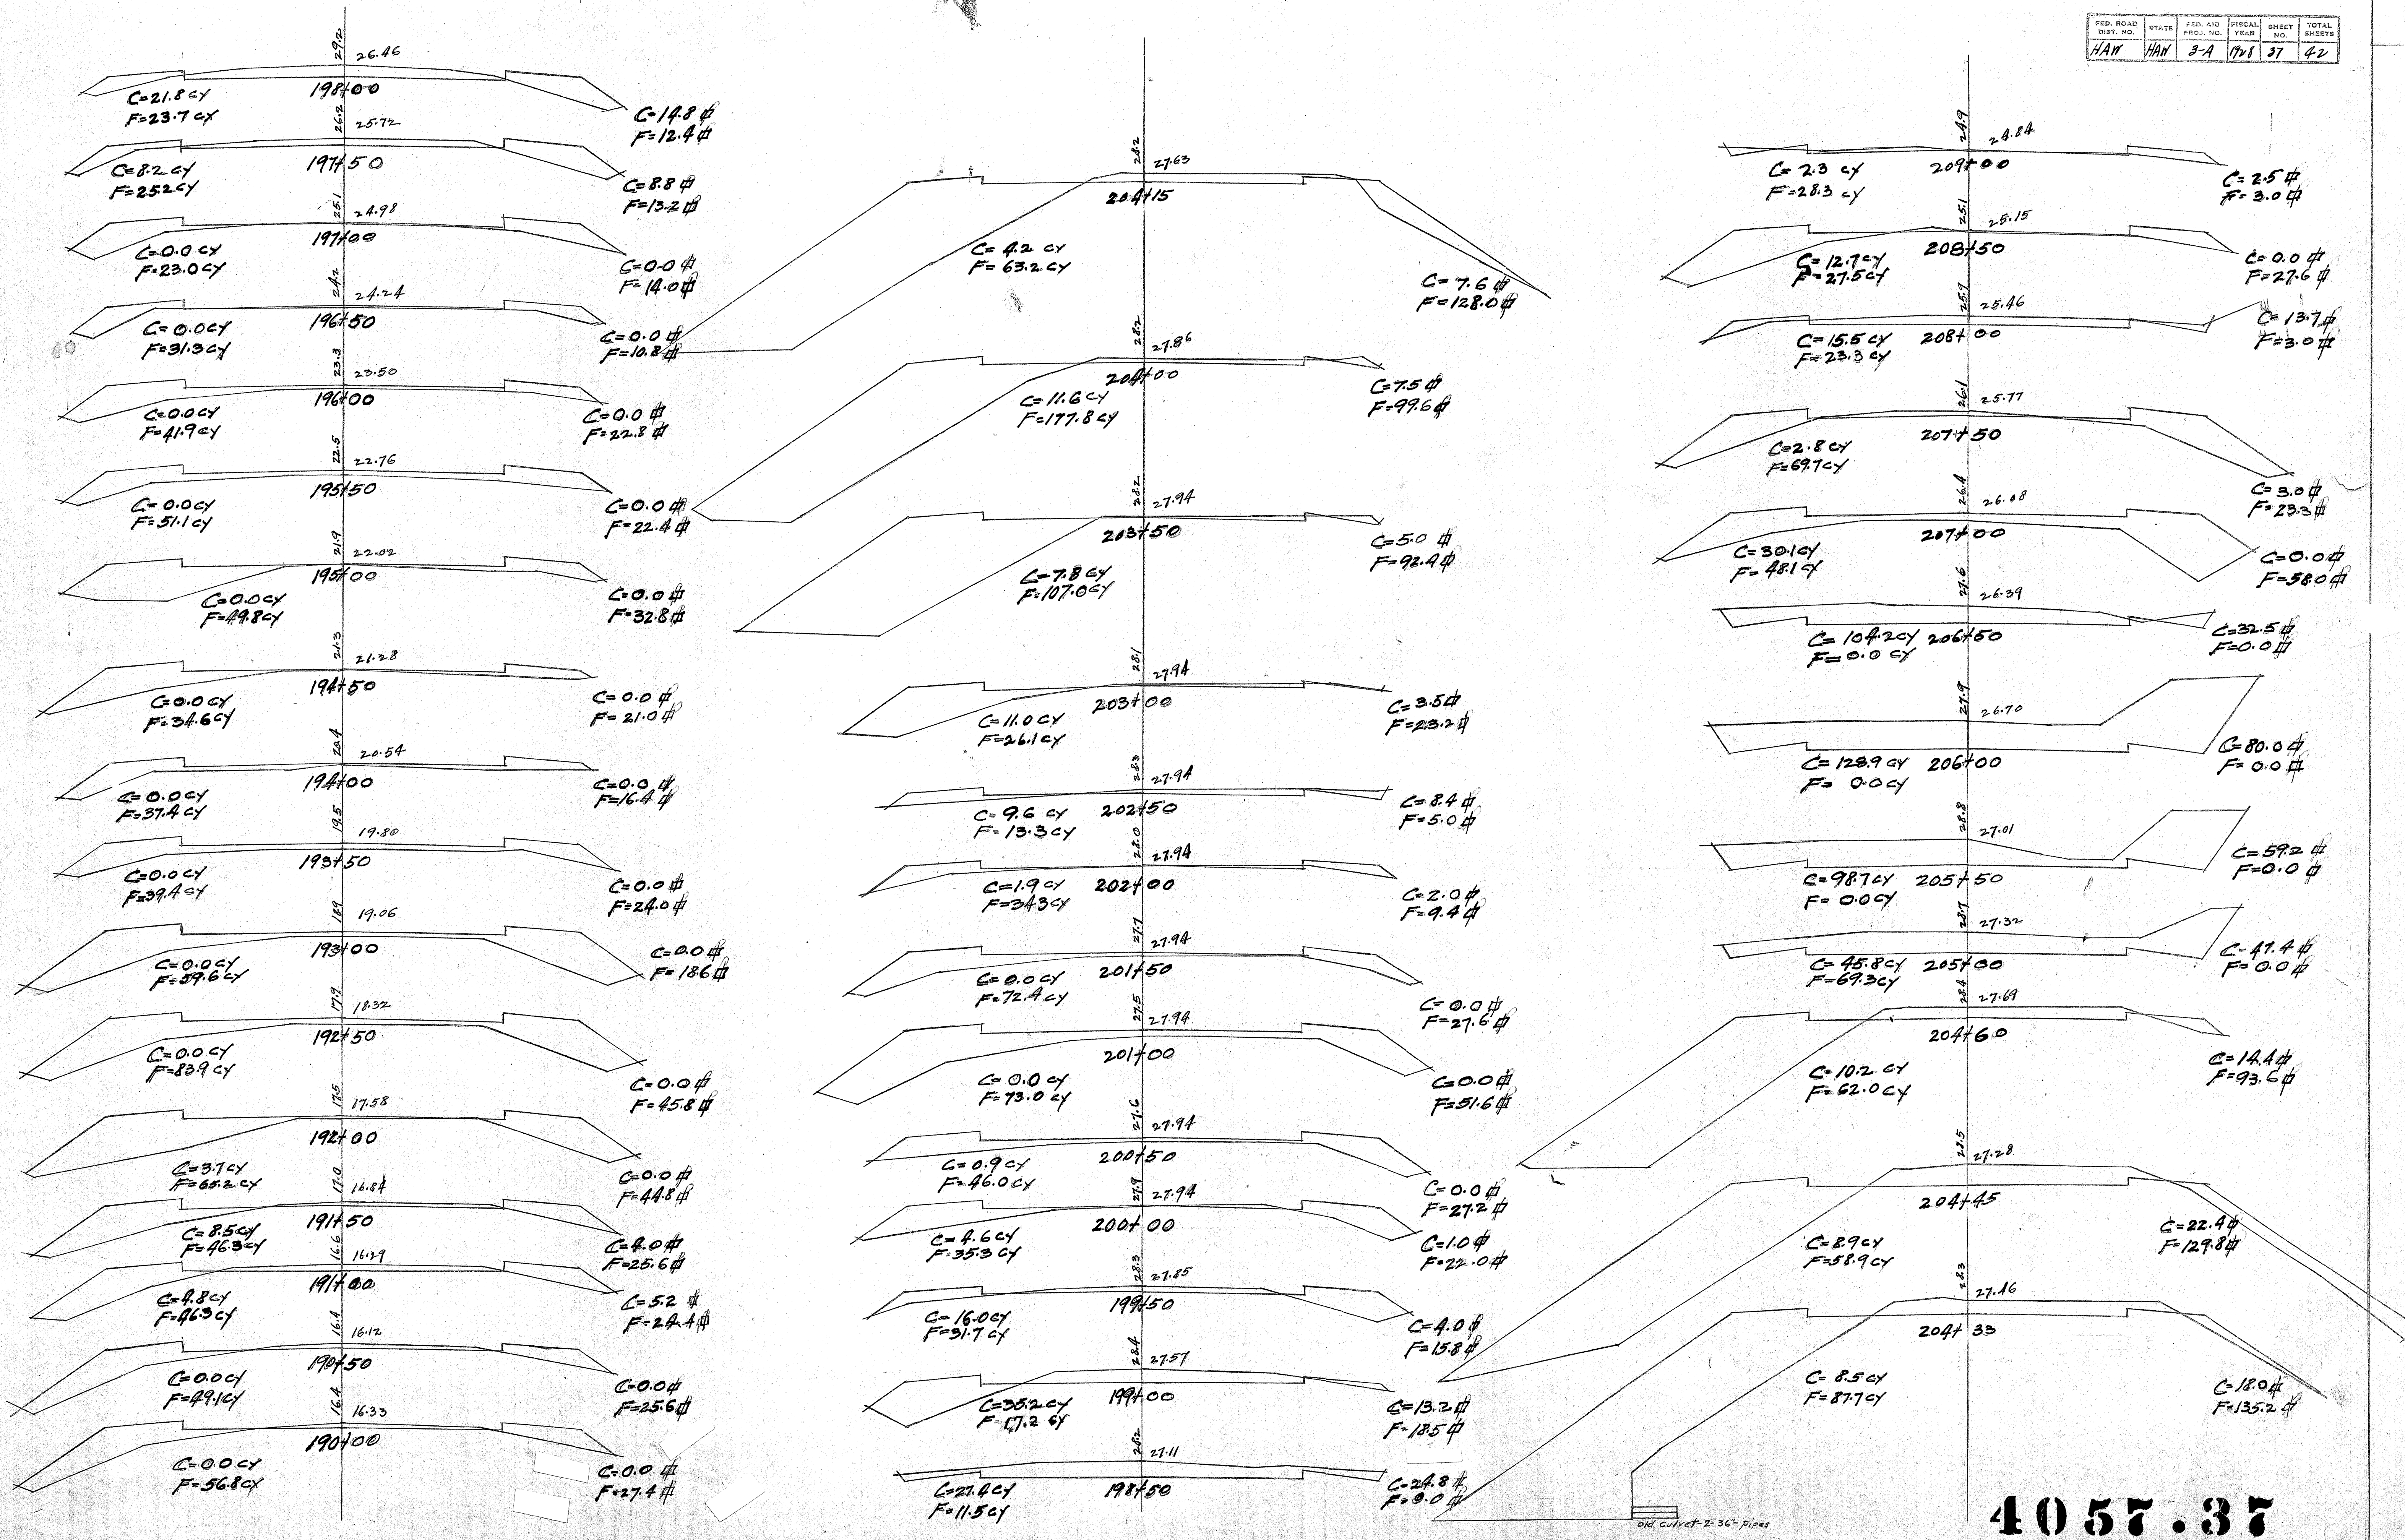


4057.37

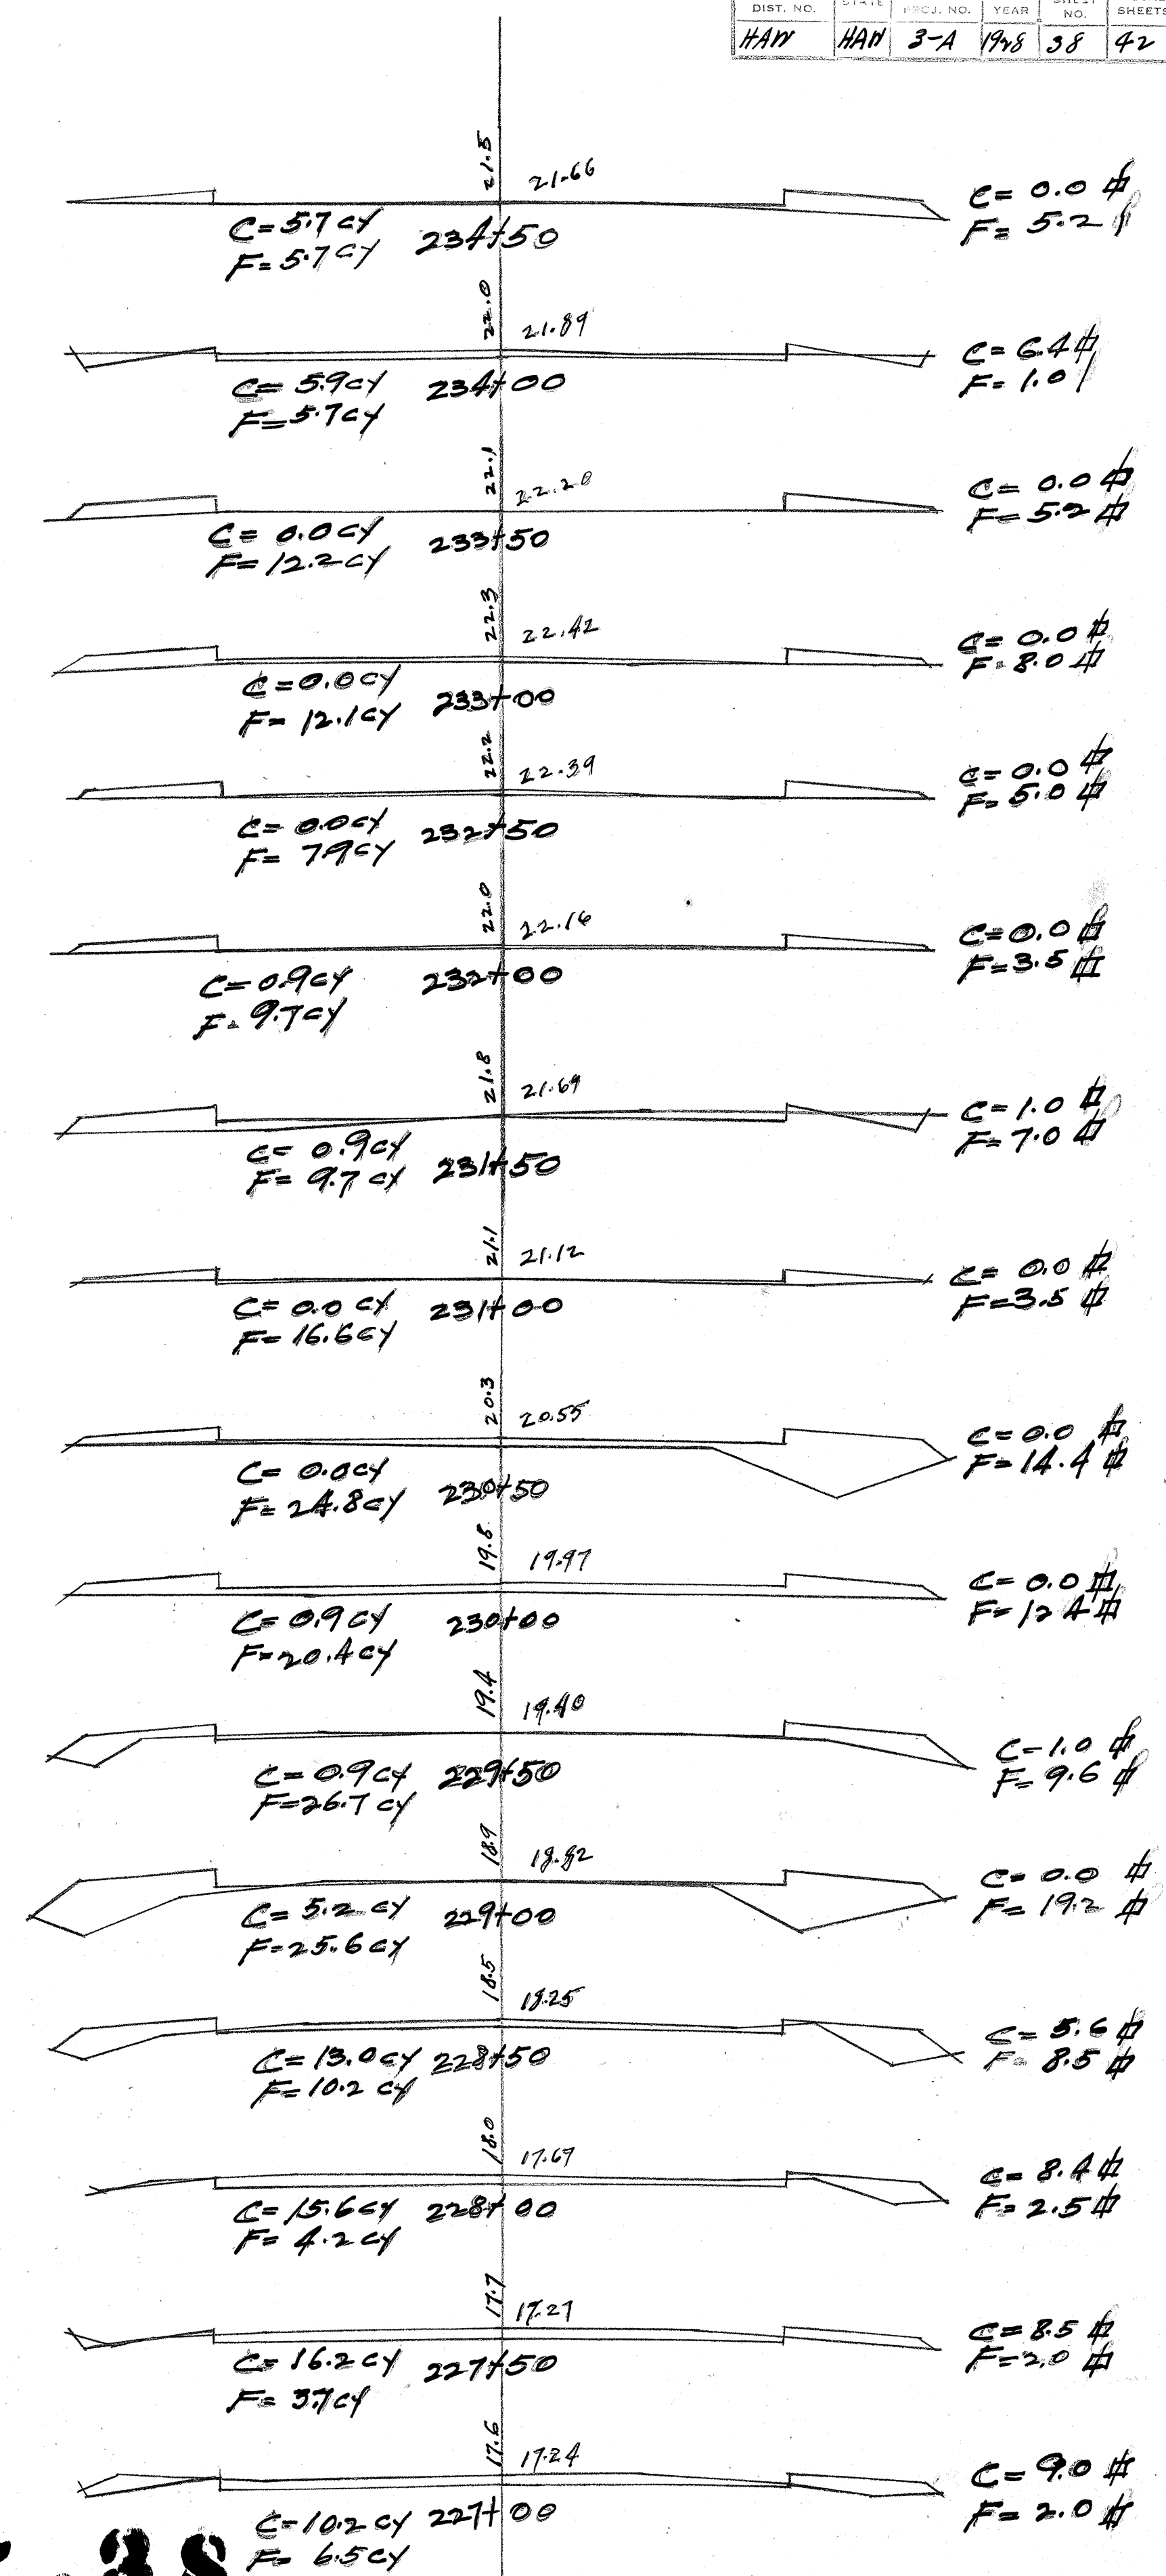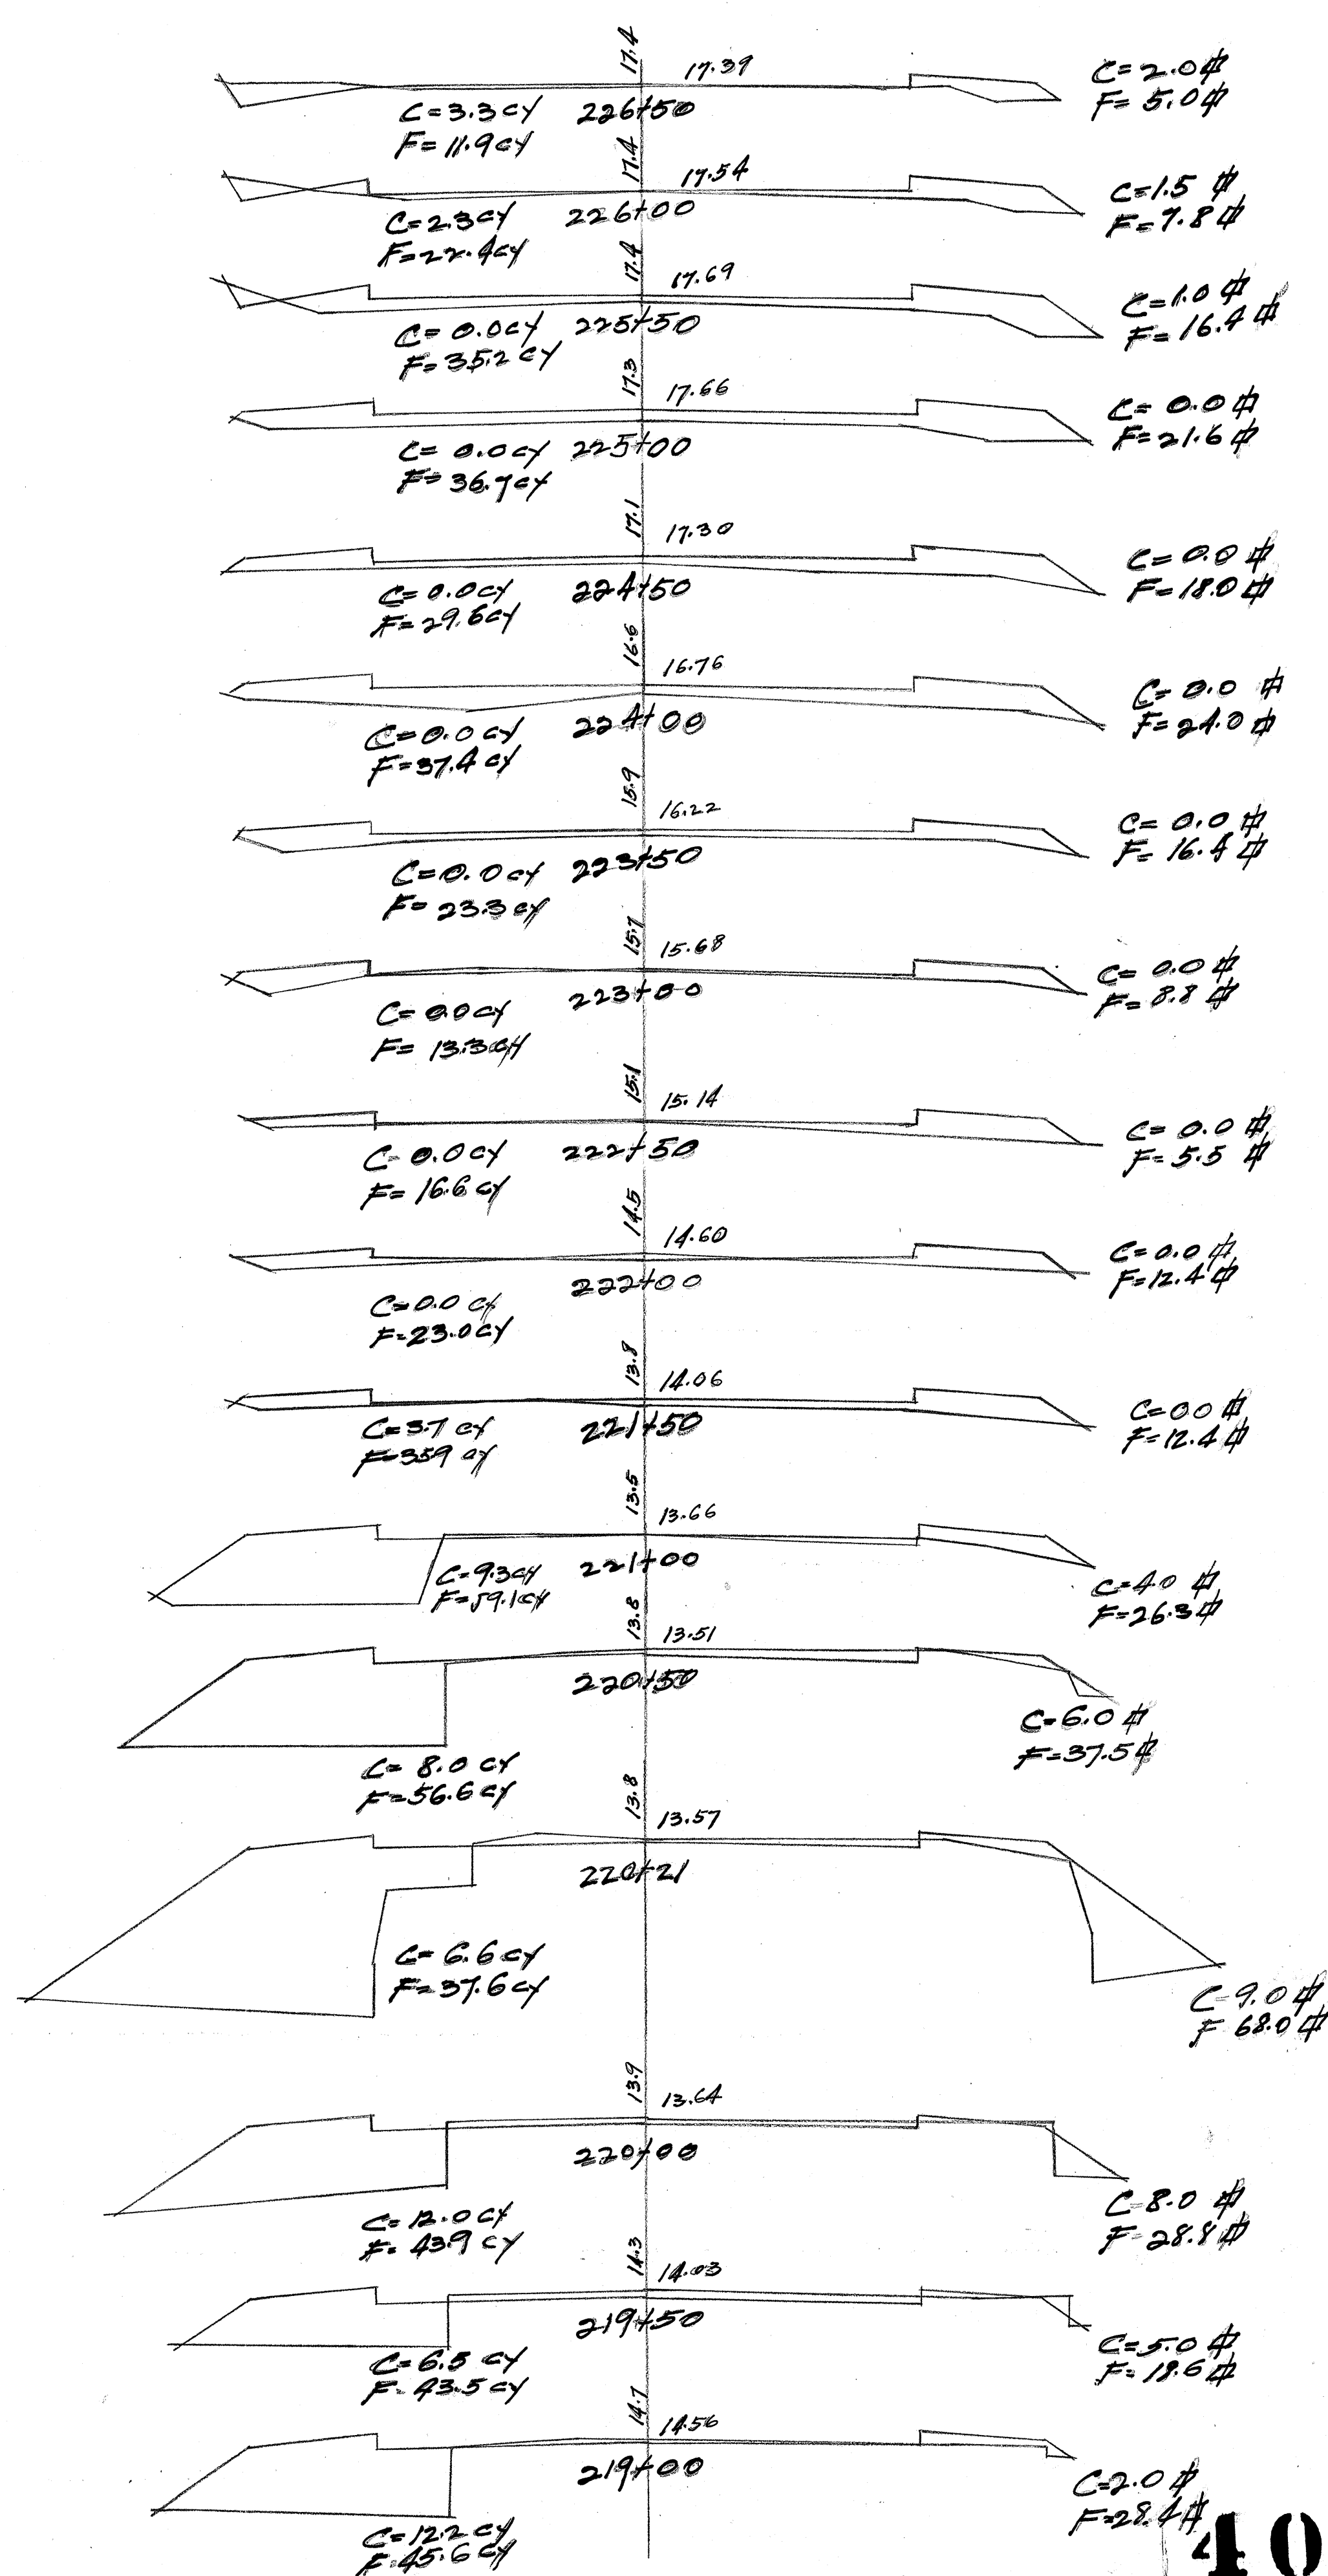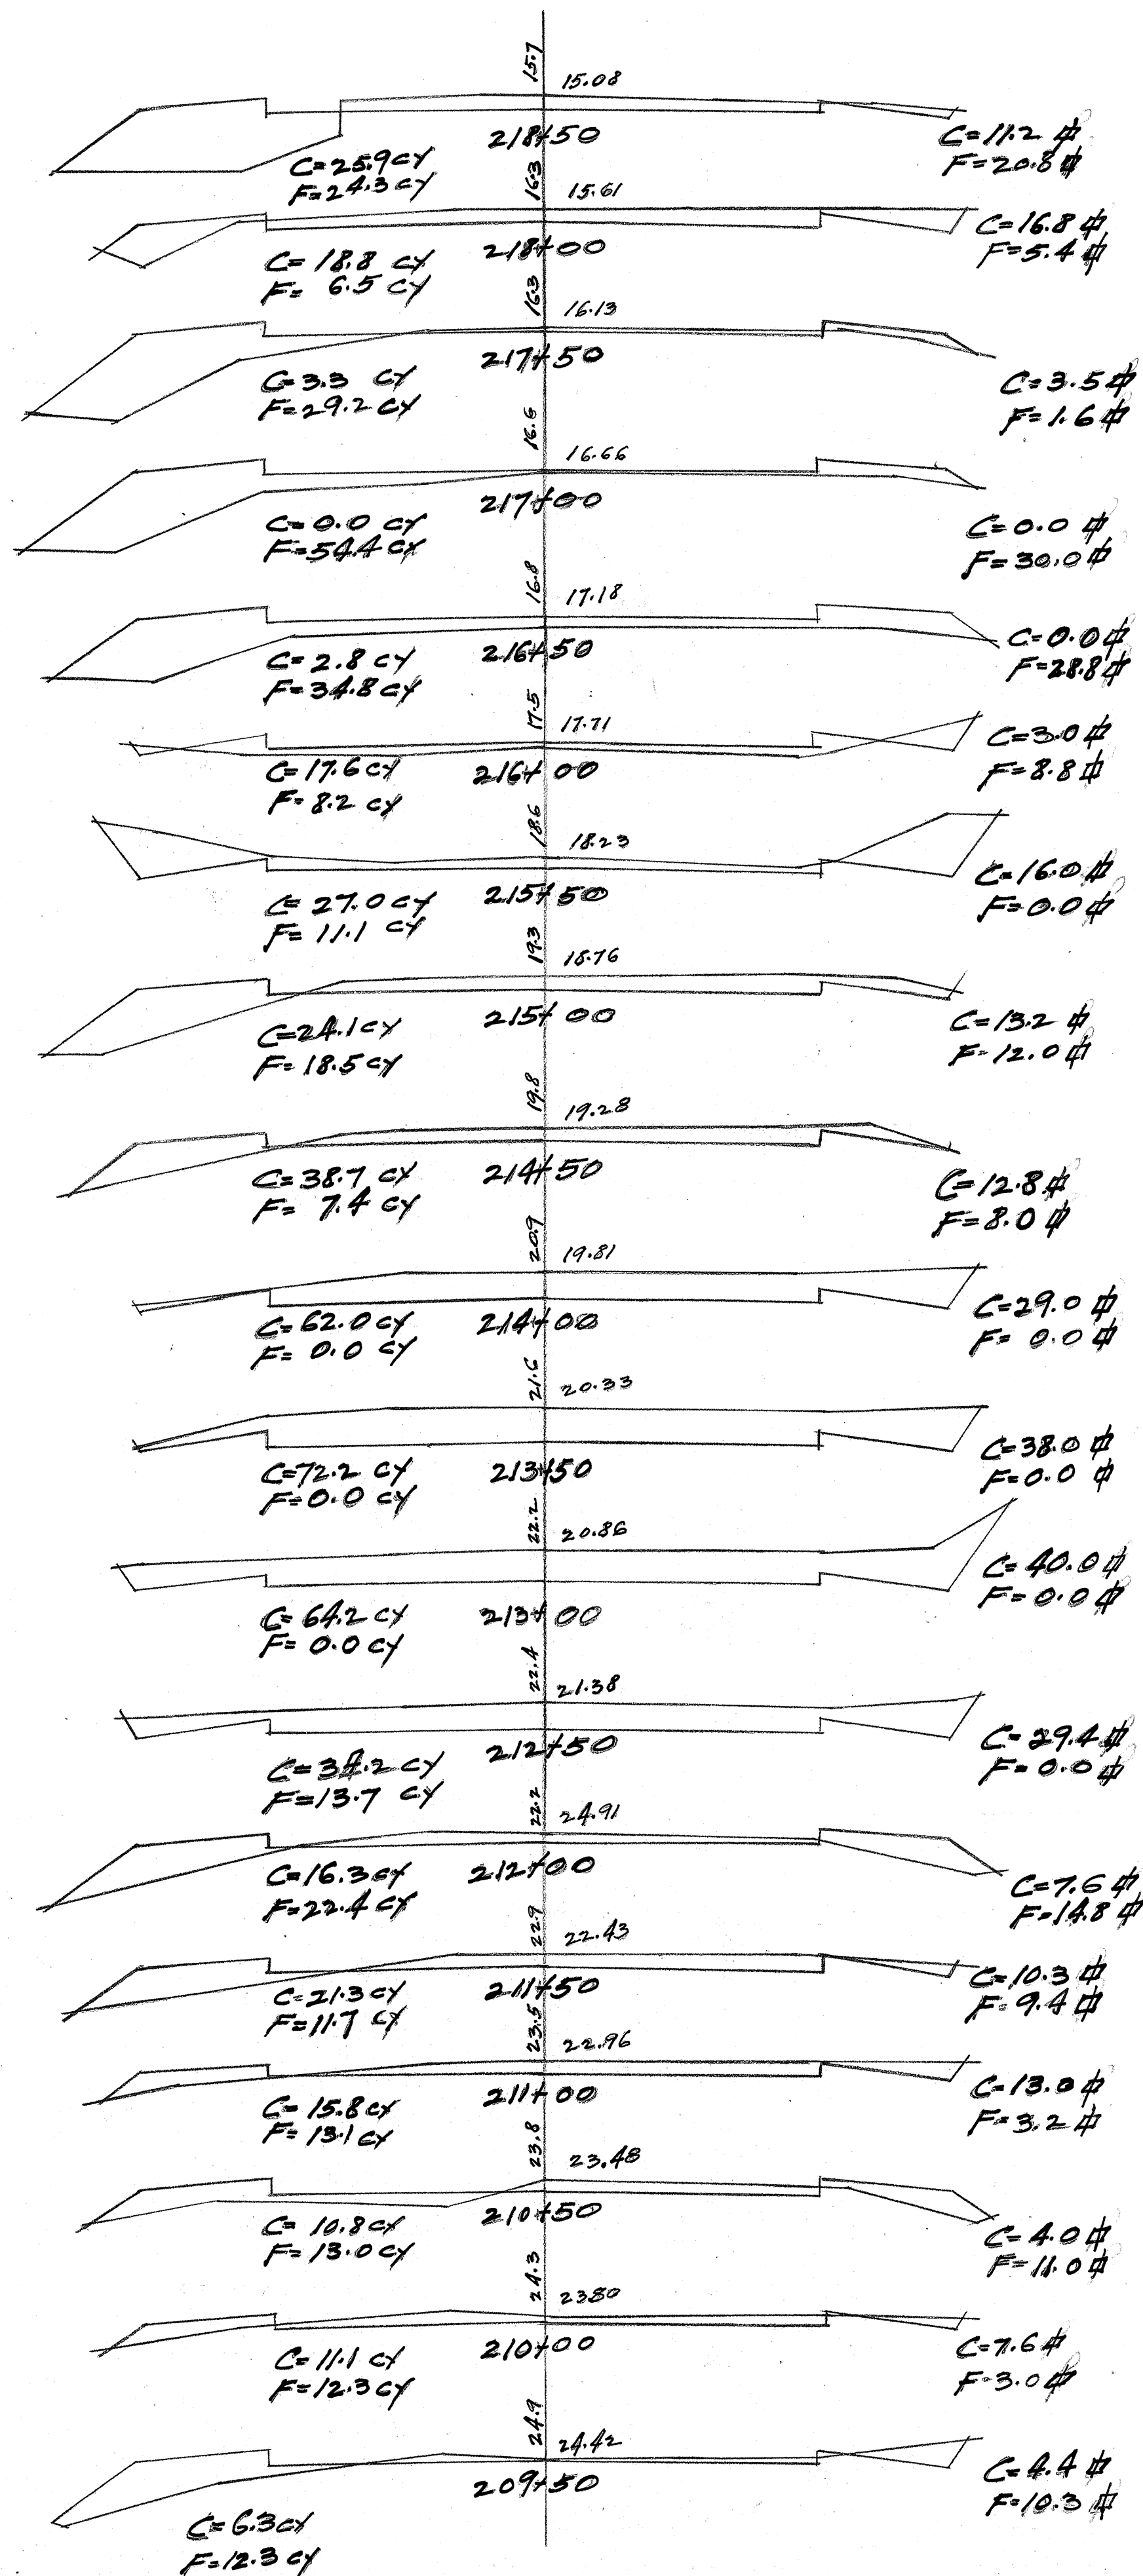




4057.38

| FED. ROAD DIST. NO. | STATE | FED. AID PROJ. NO. | FISCAL YEAR | SHEET NO. | TOTAL SHEETS |
|---------------------|-------|--------------------|-------------|-----------|--------------|
| HAW                 | HAW   | 3-A                | 1971        | 37        | 42           |

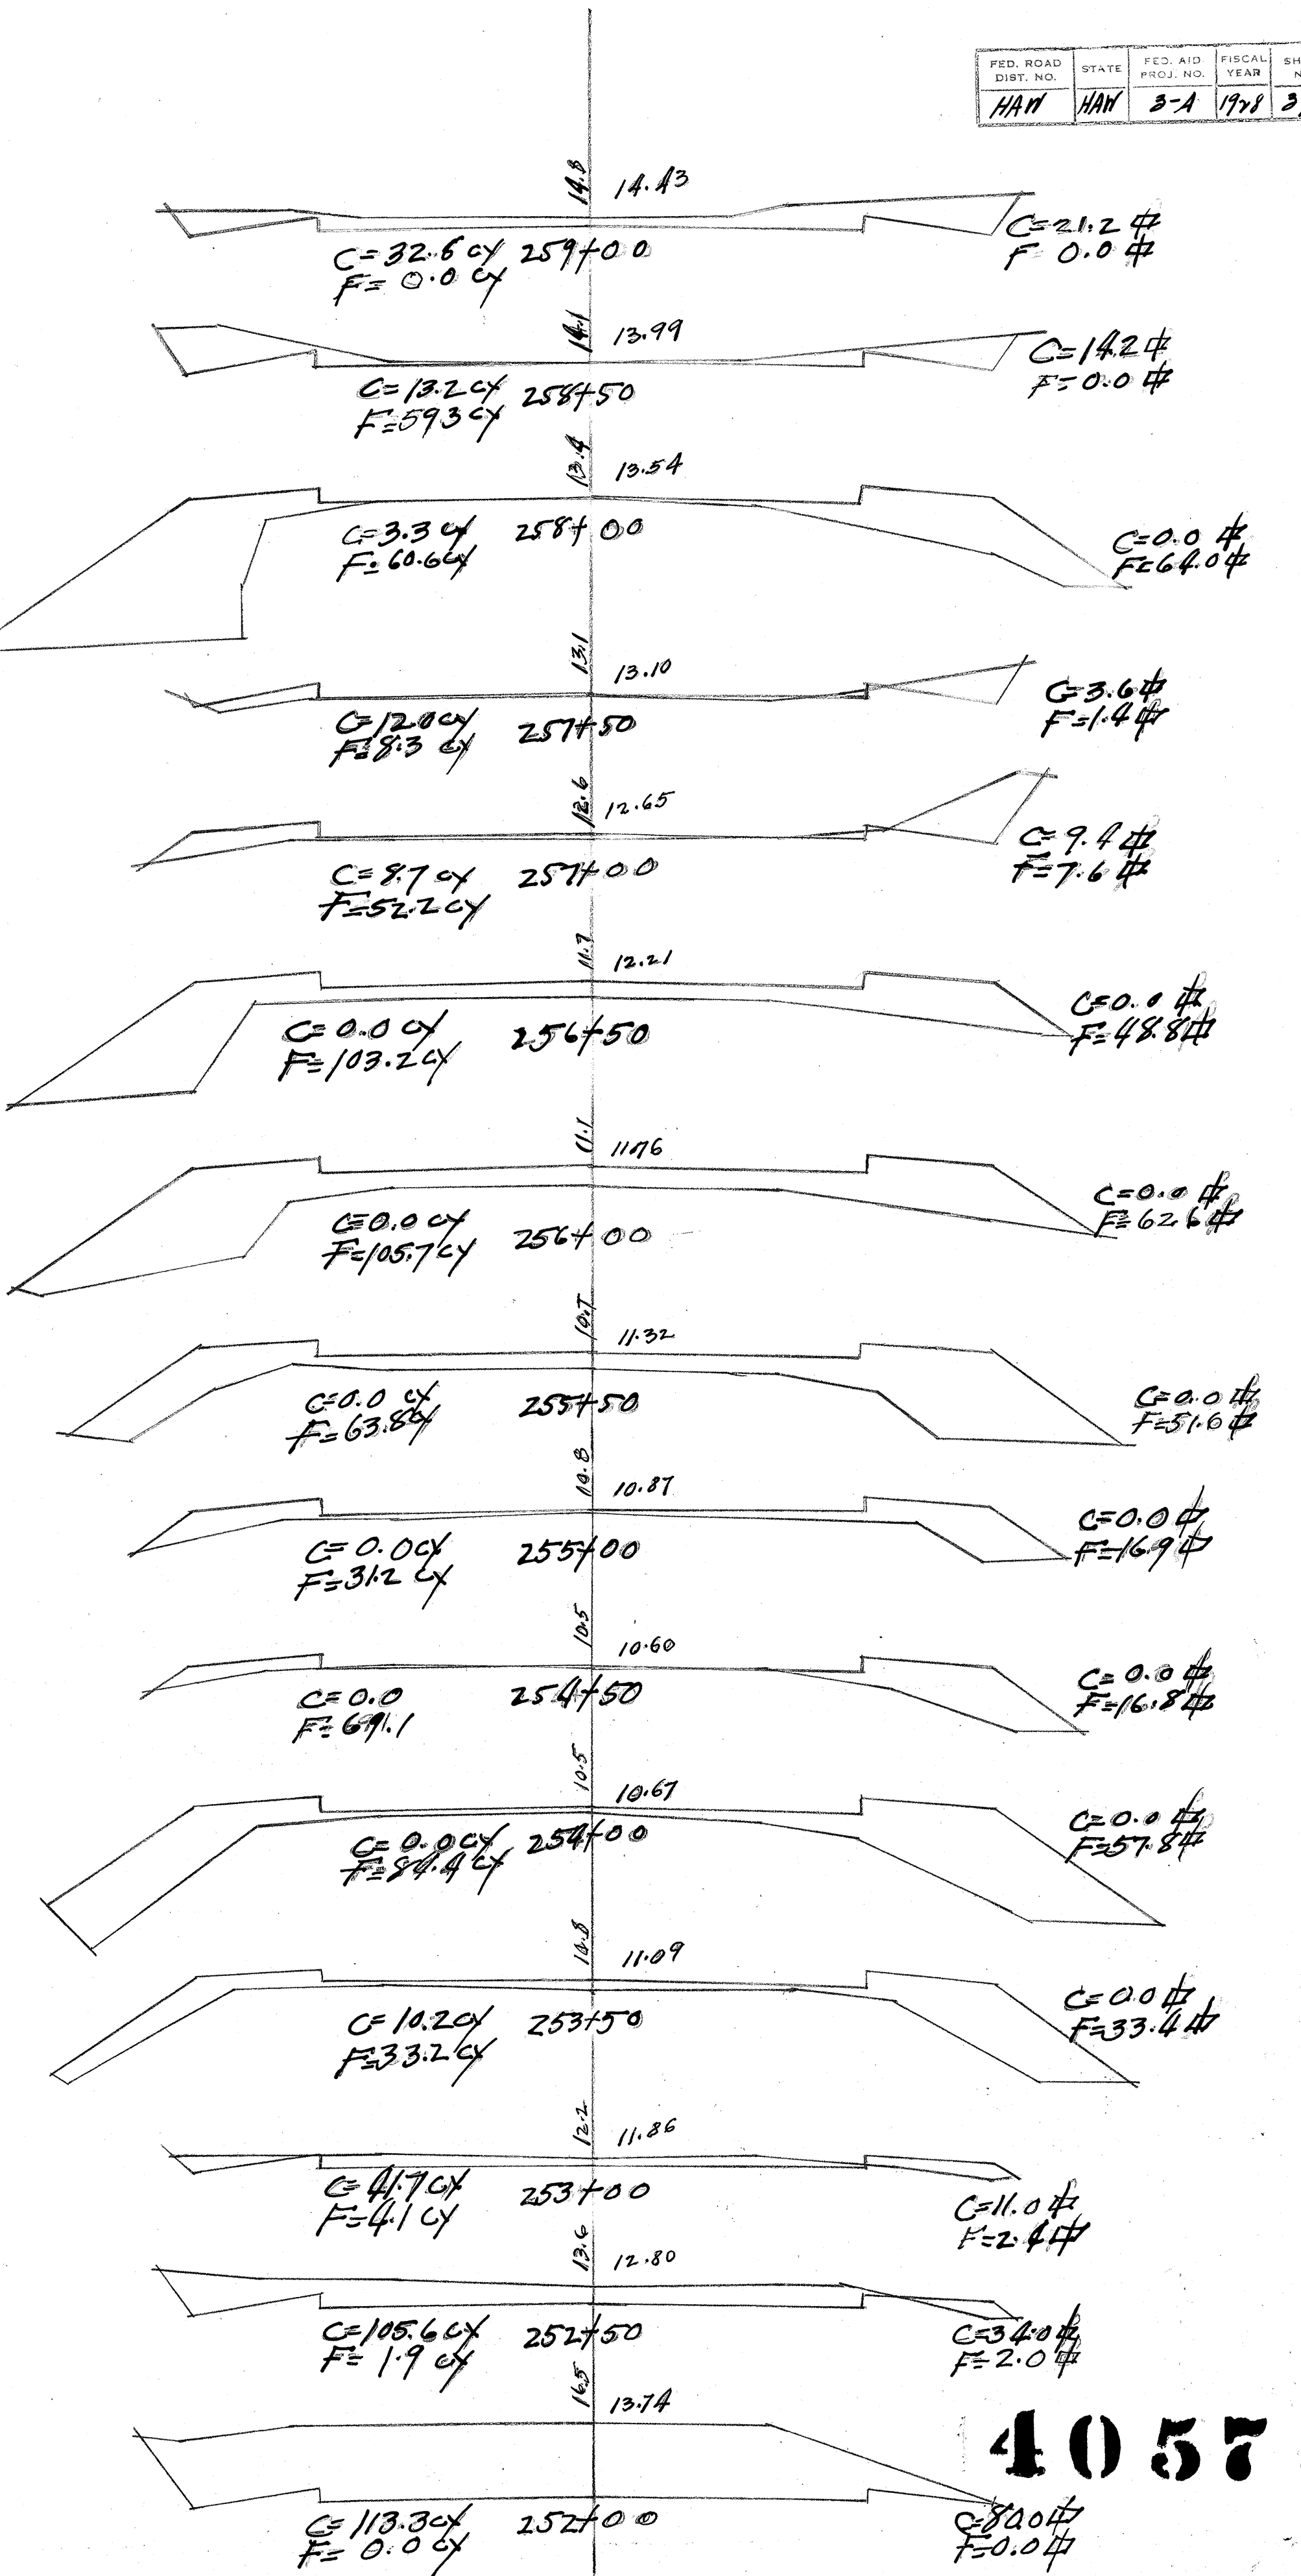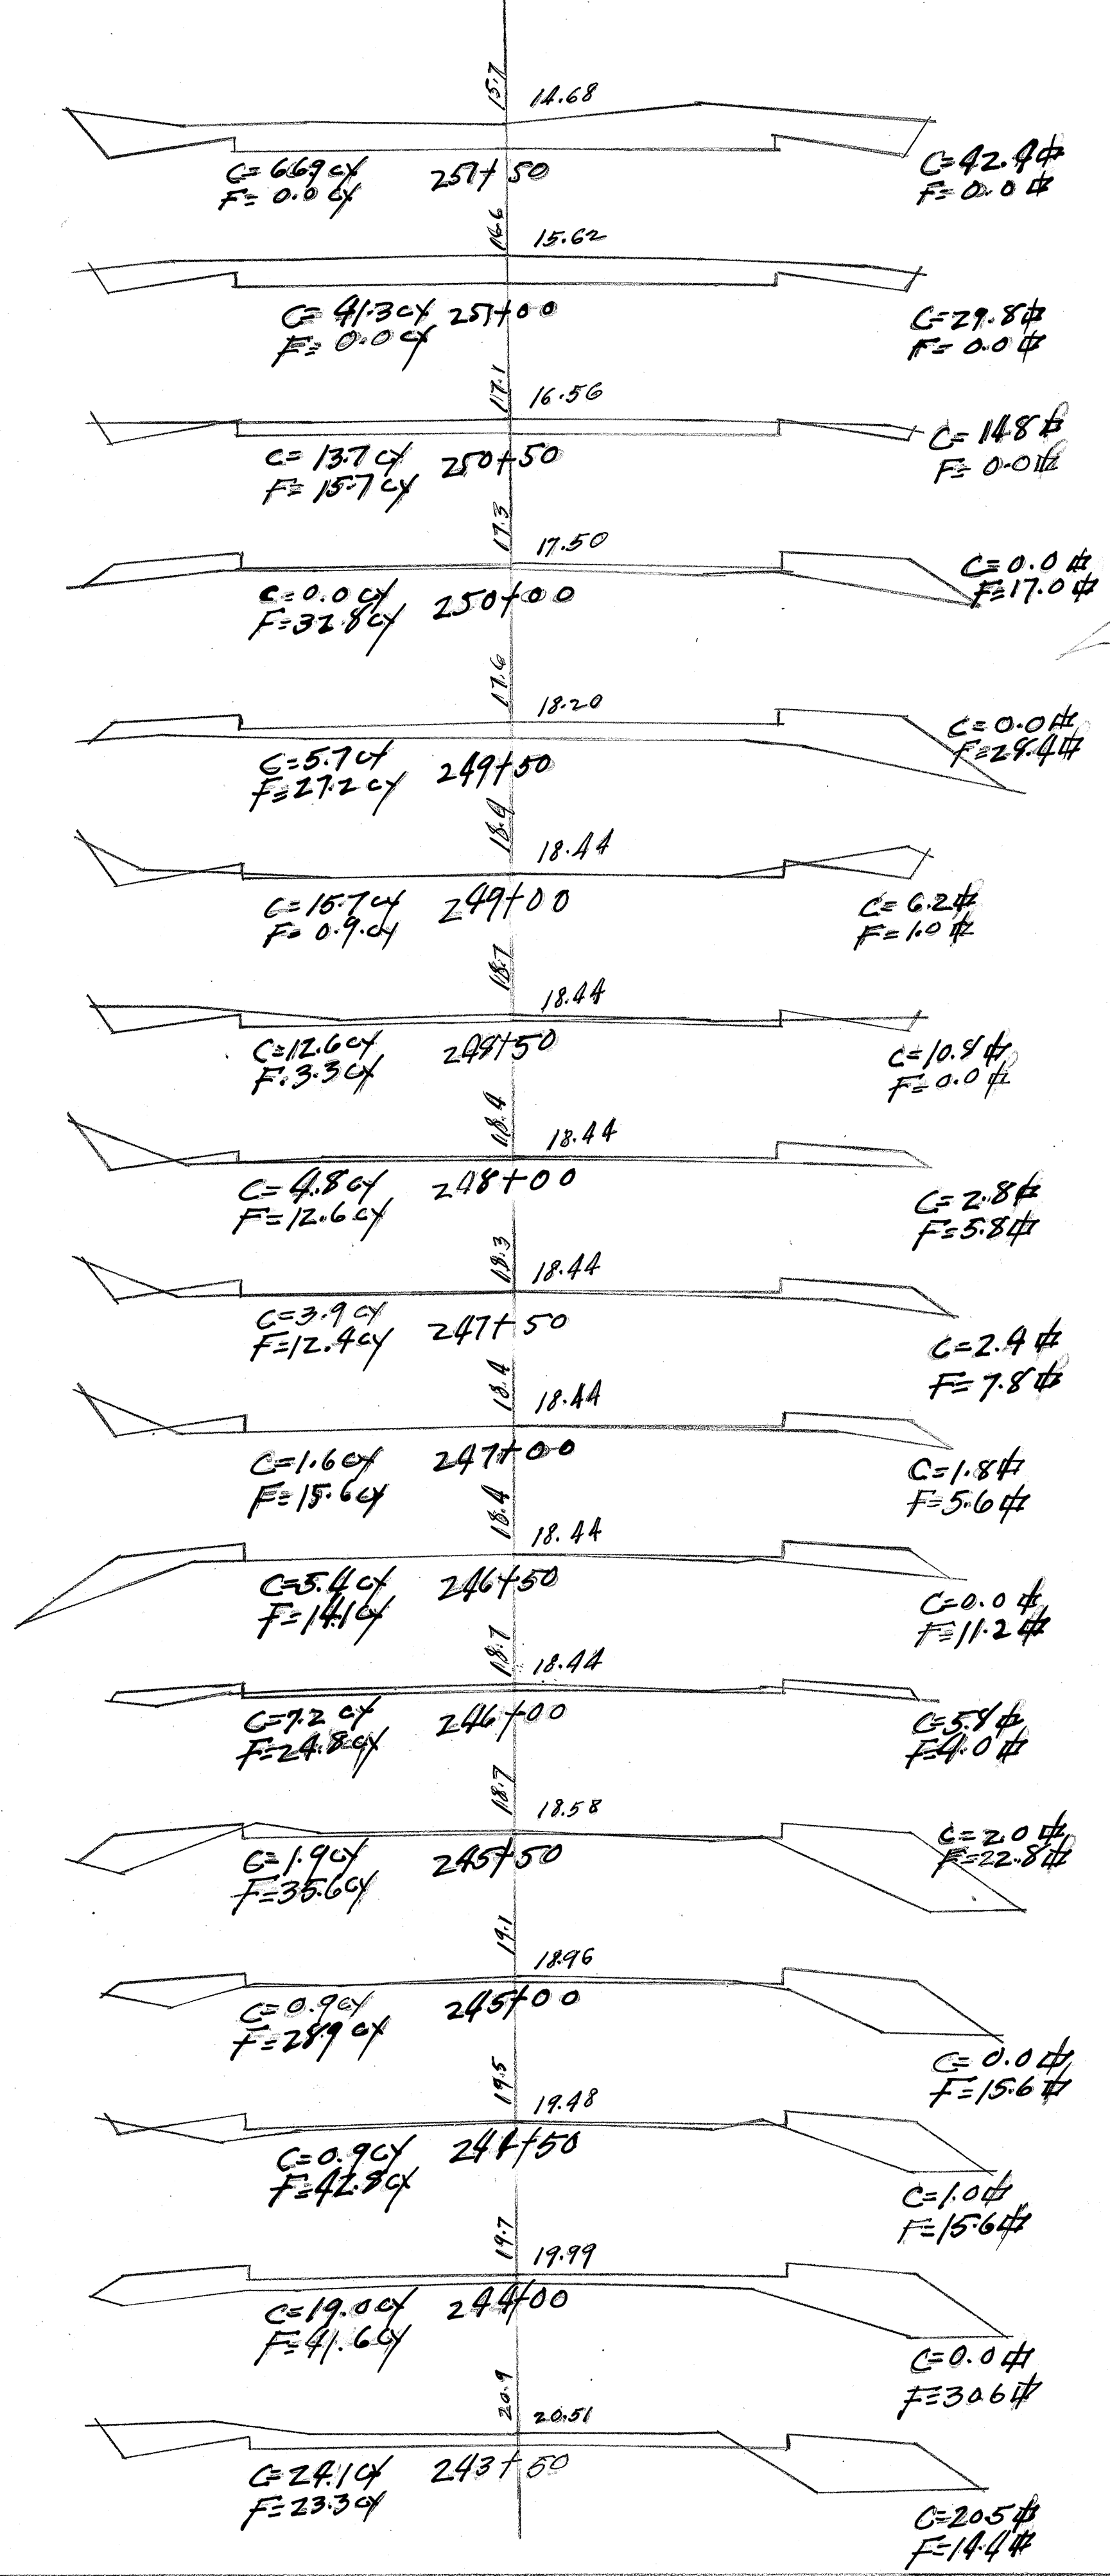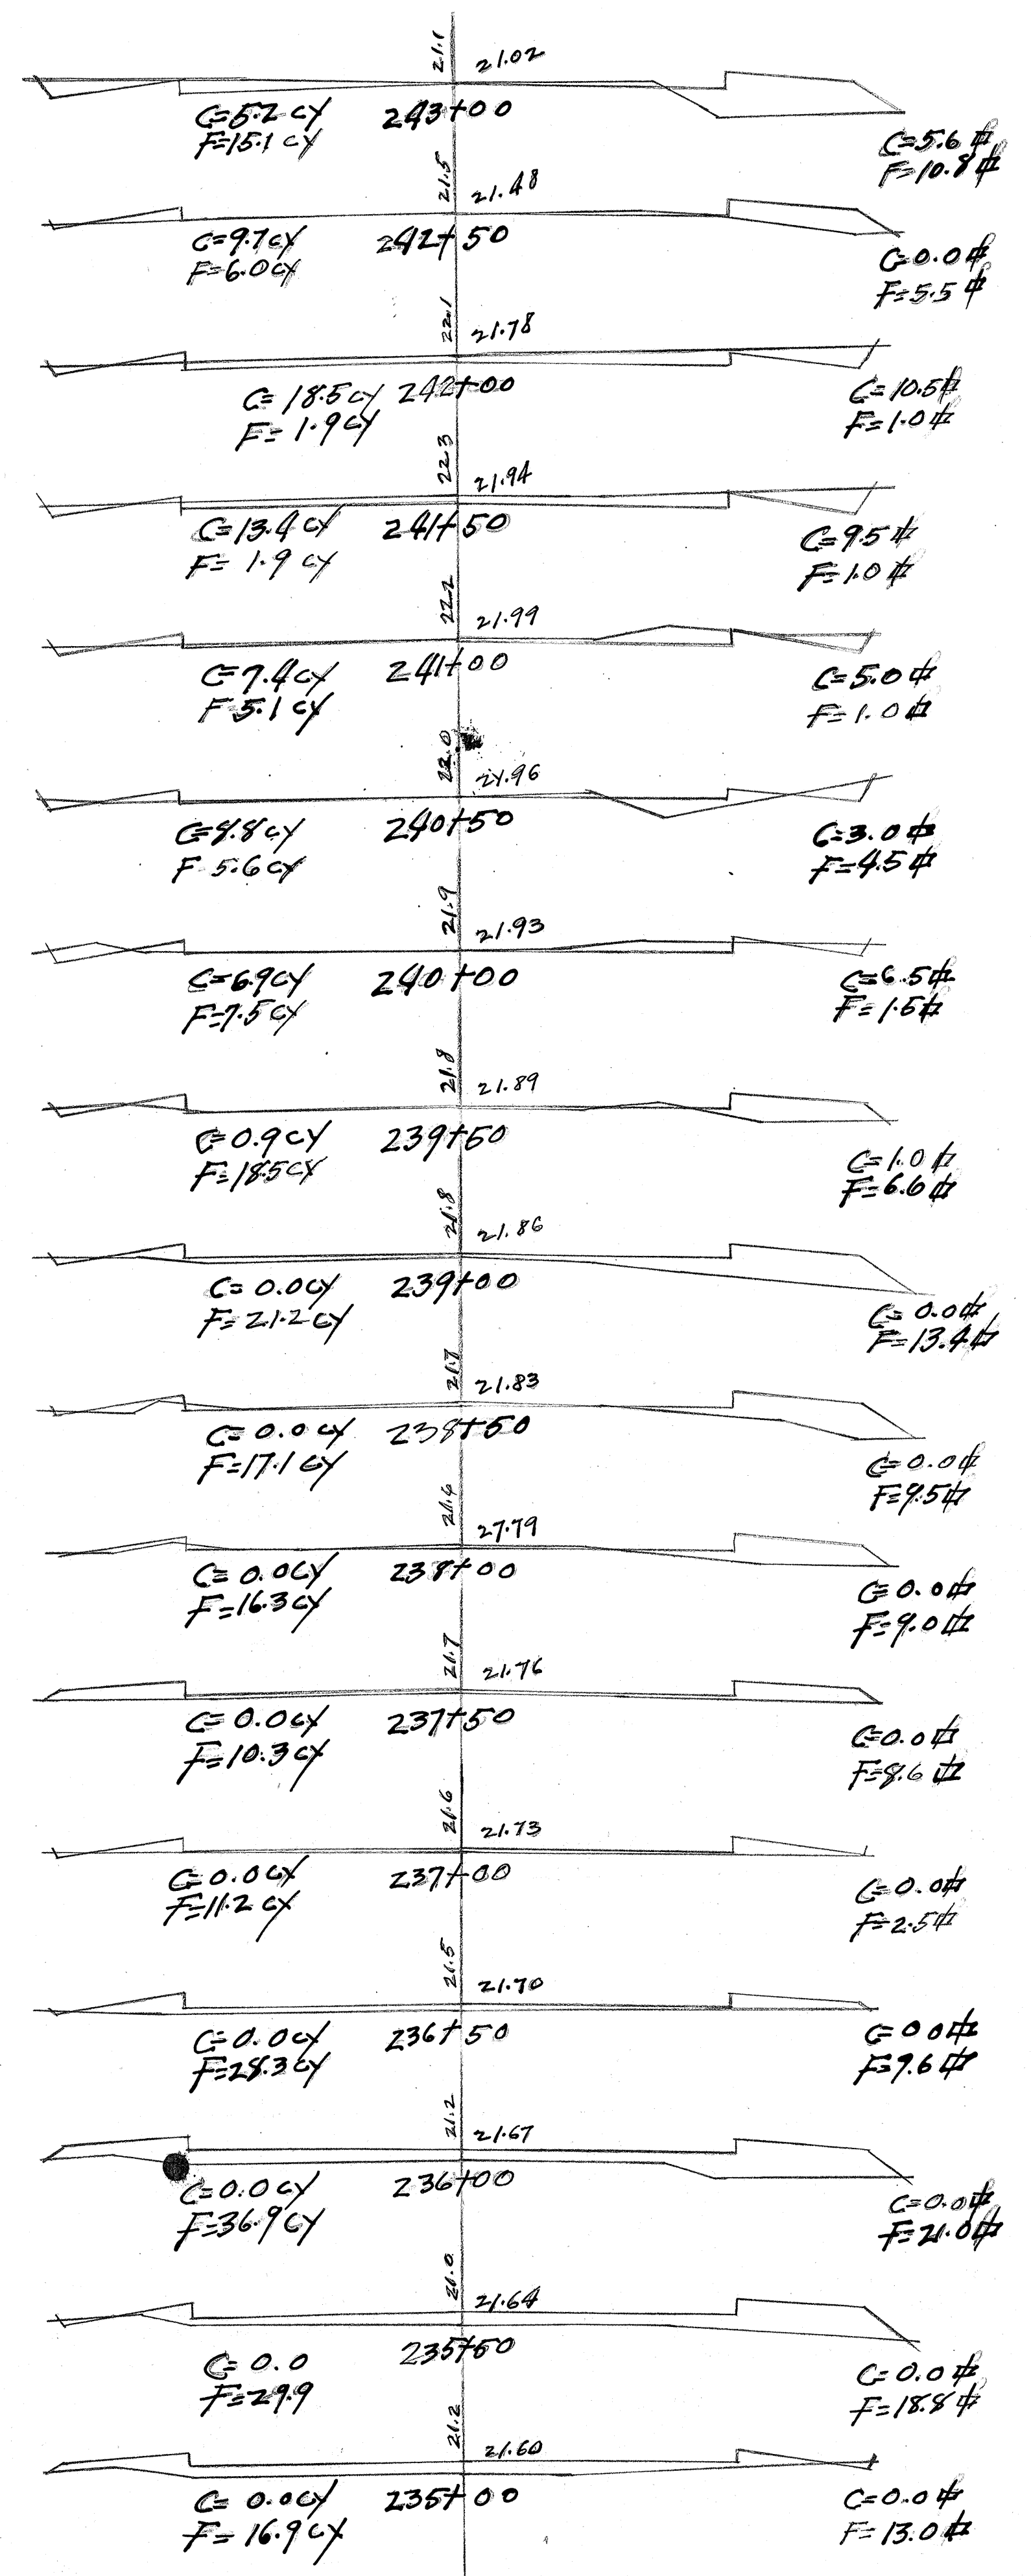



4057.39

| Plan File No. | Project No. | Folder No. | Page No. |
|---------------|-------------|------------|----------|
| 6             | 17          | 4          |          |

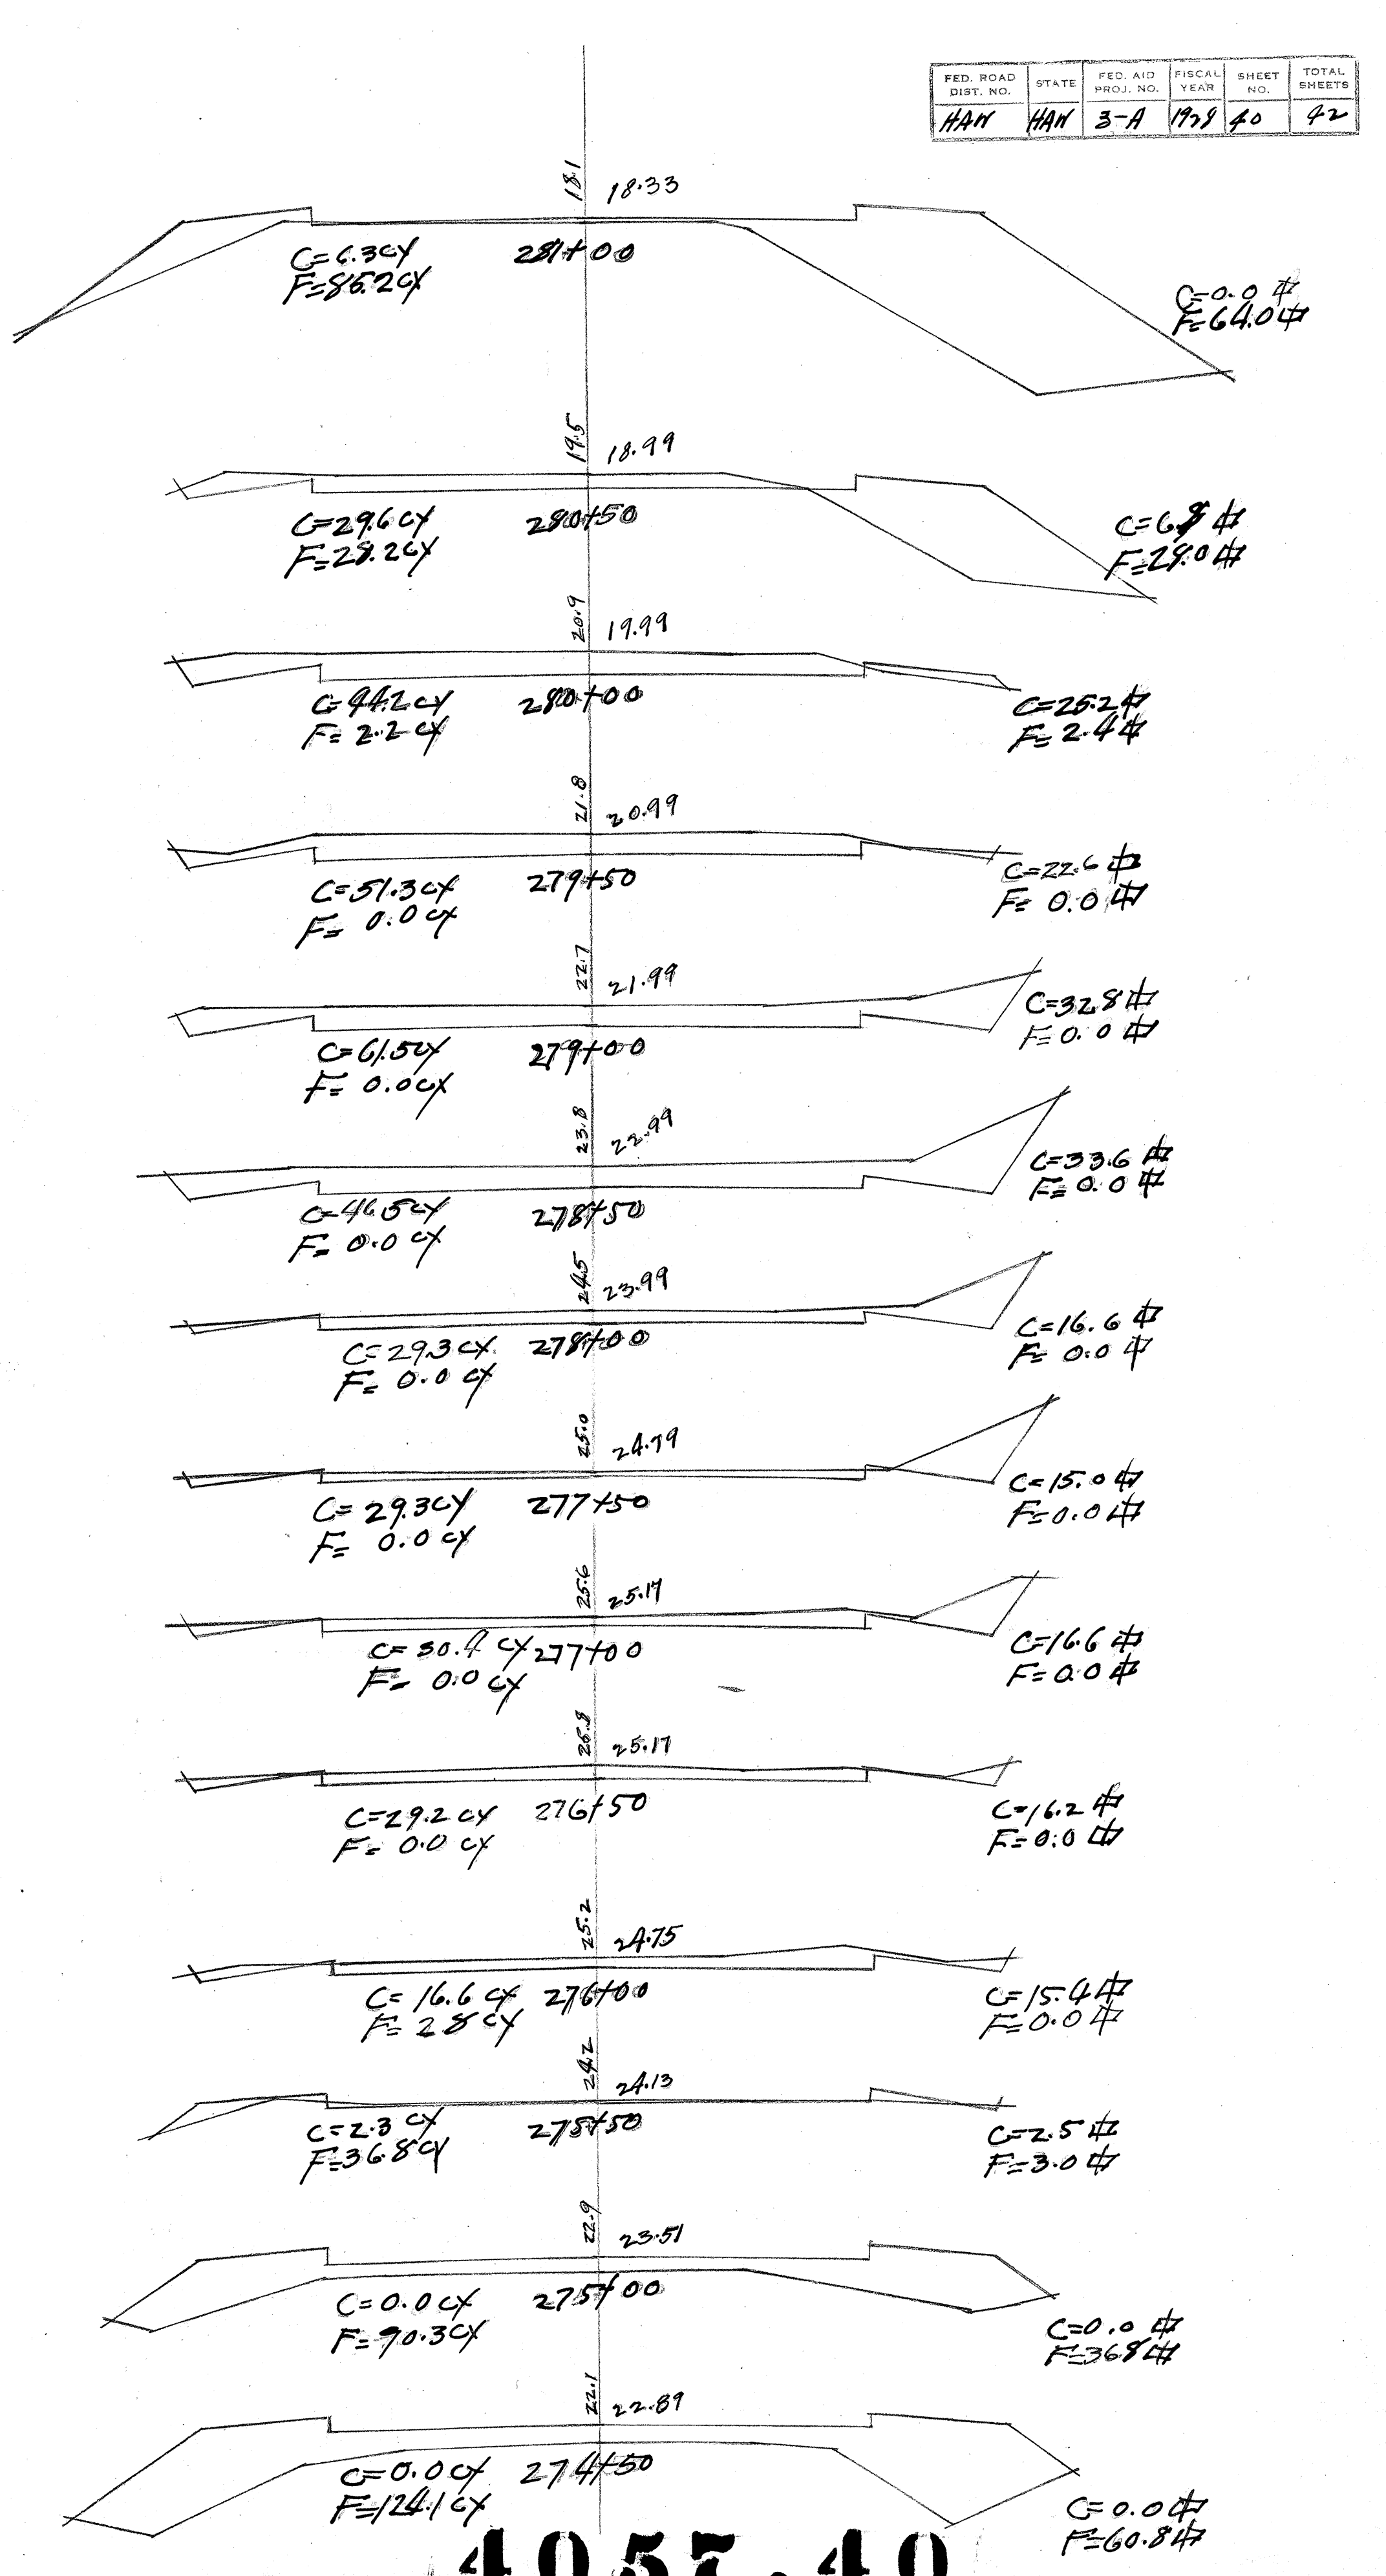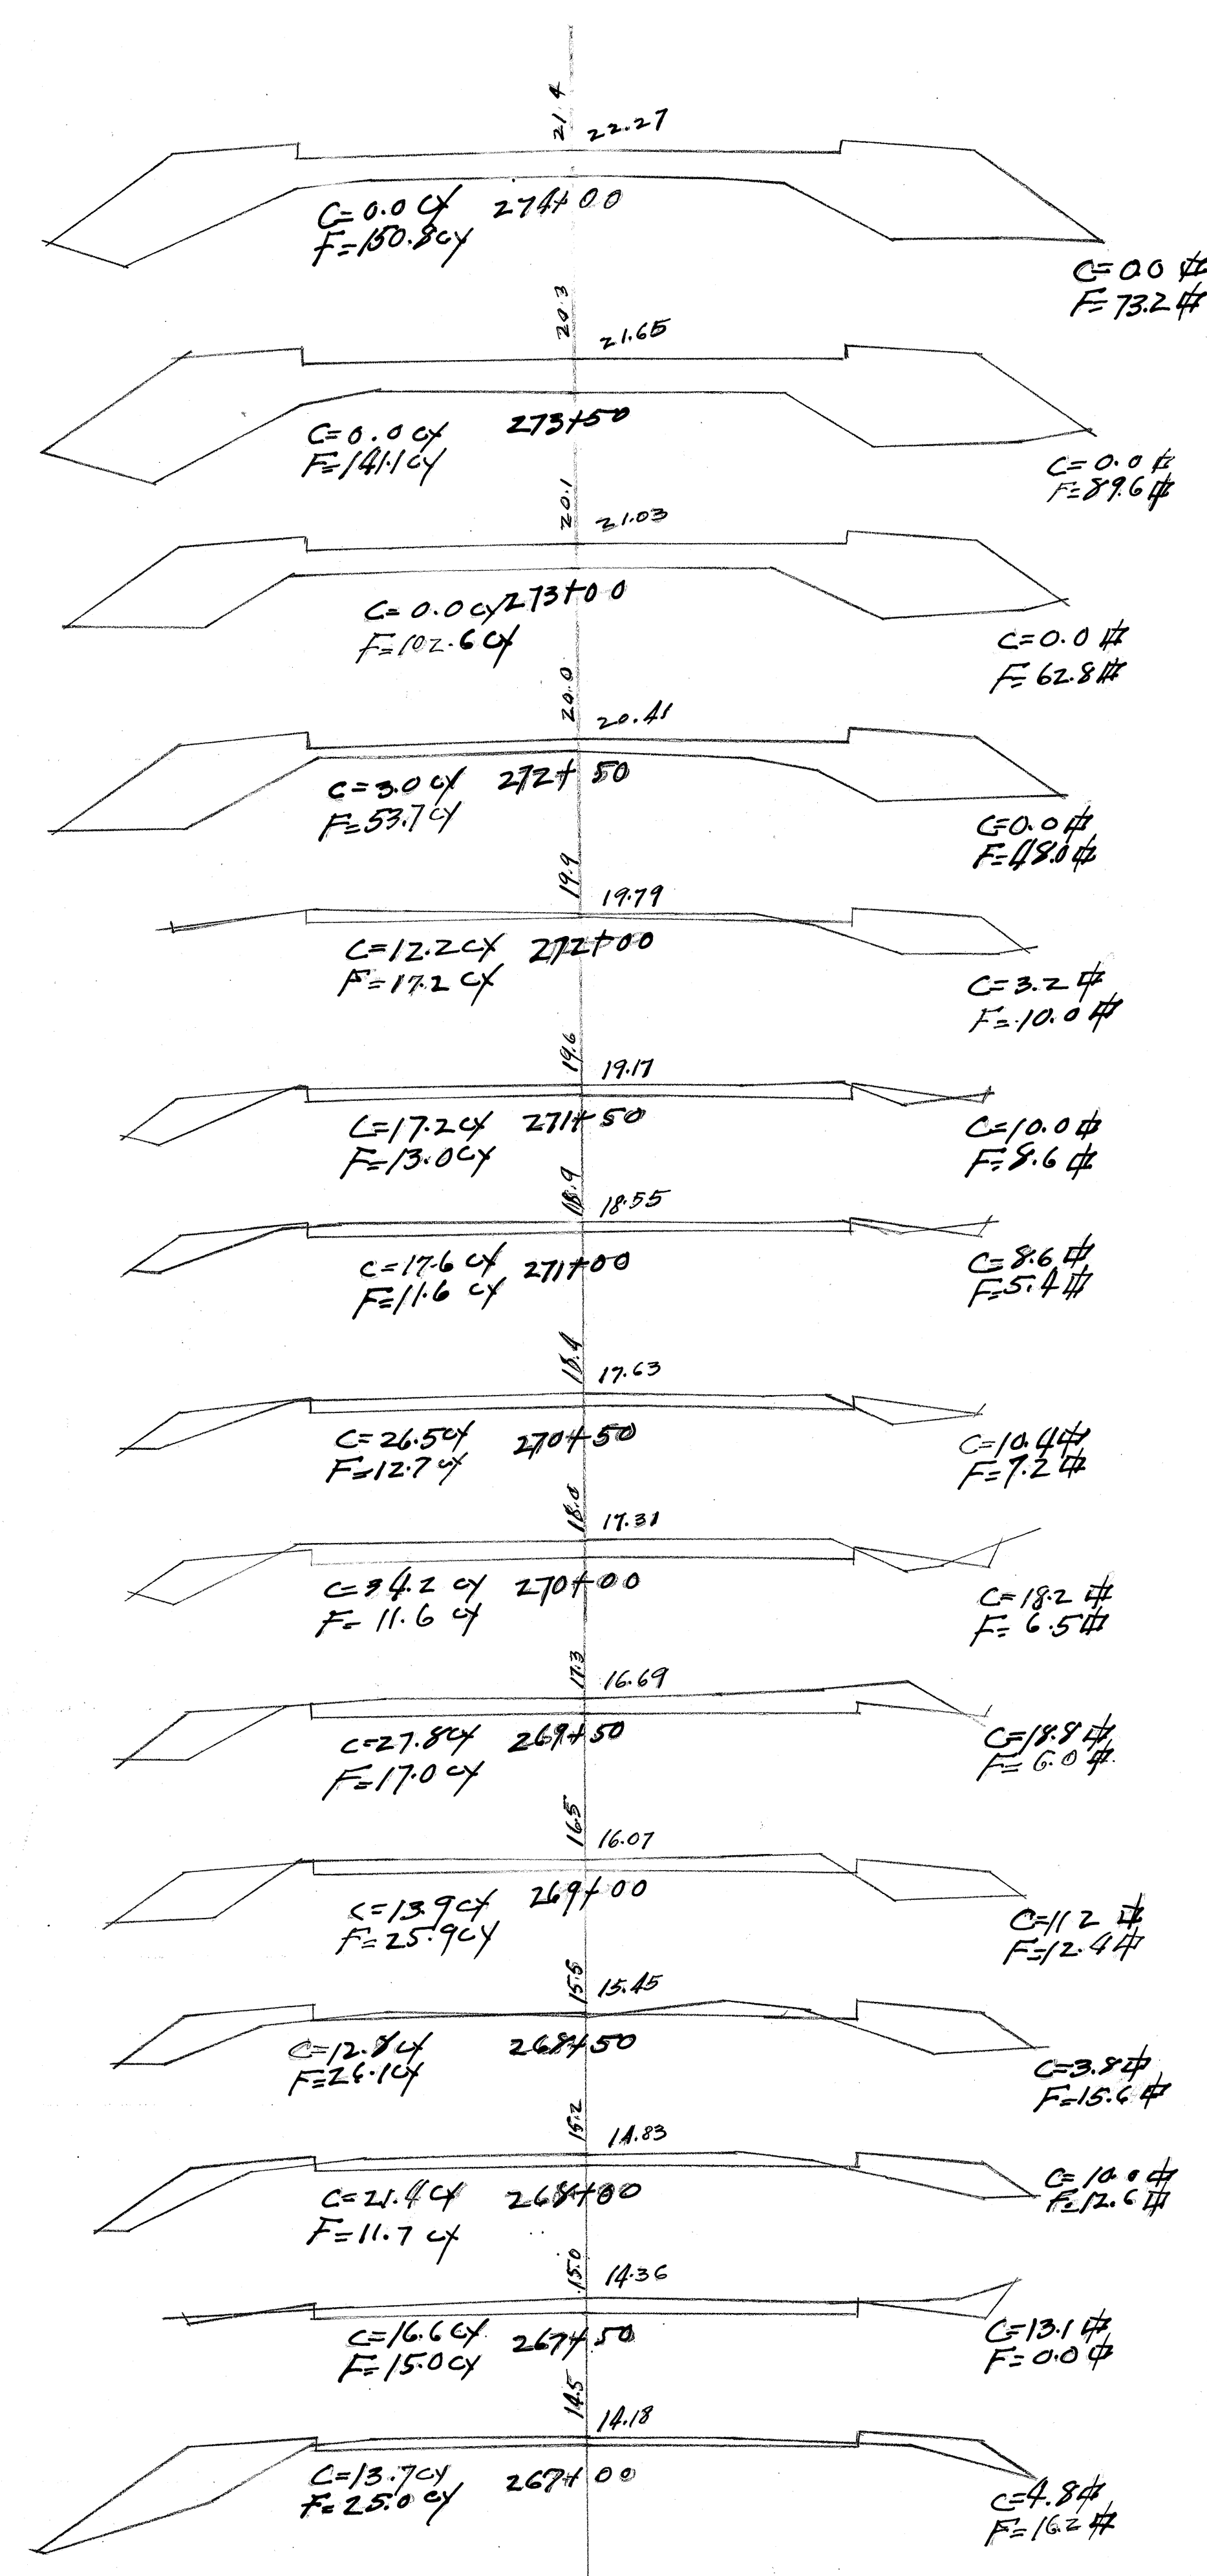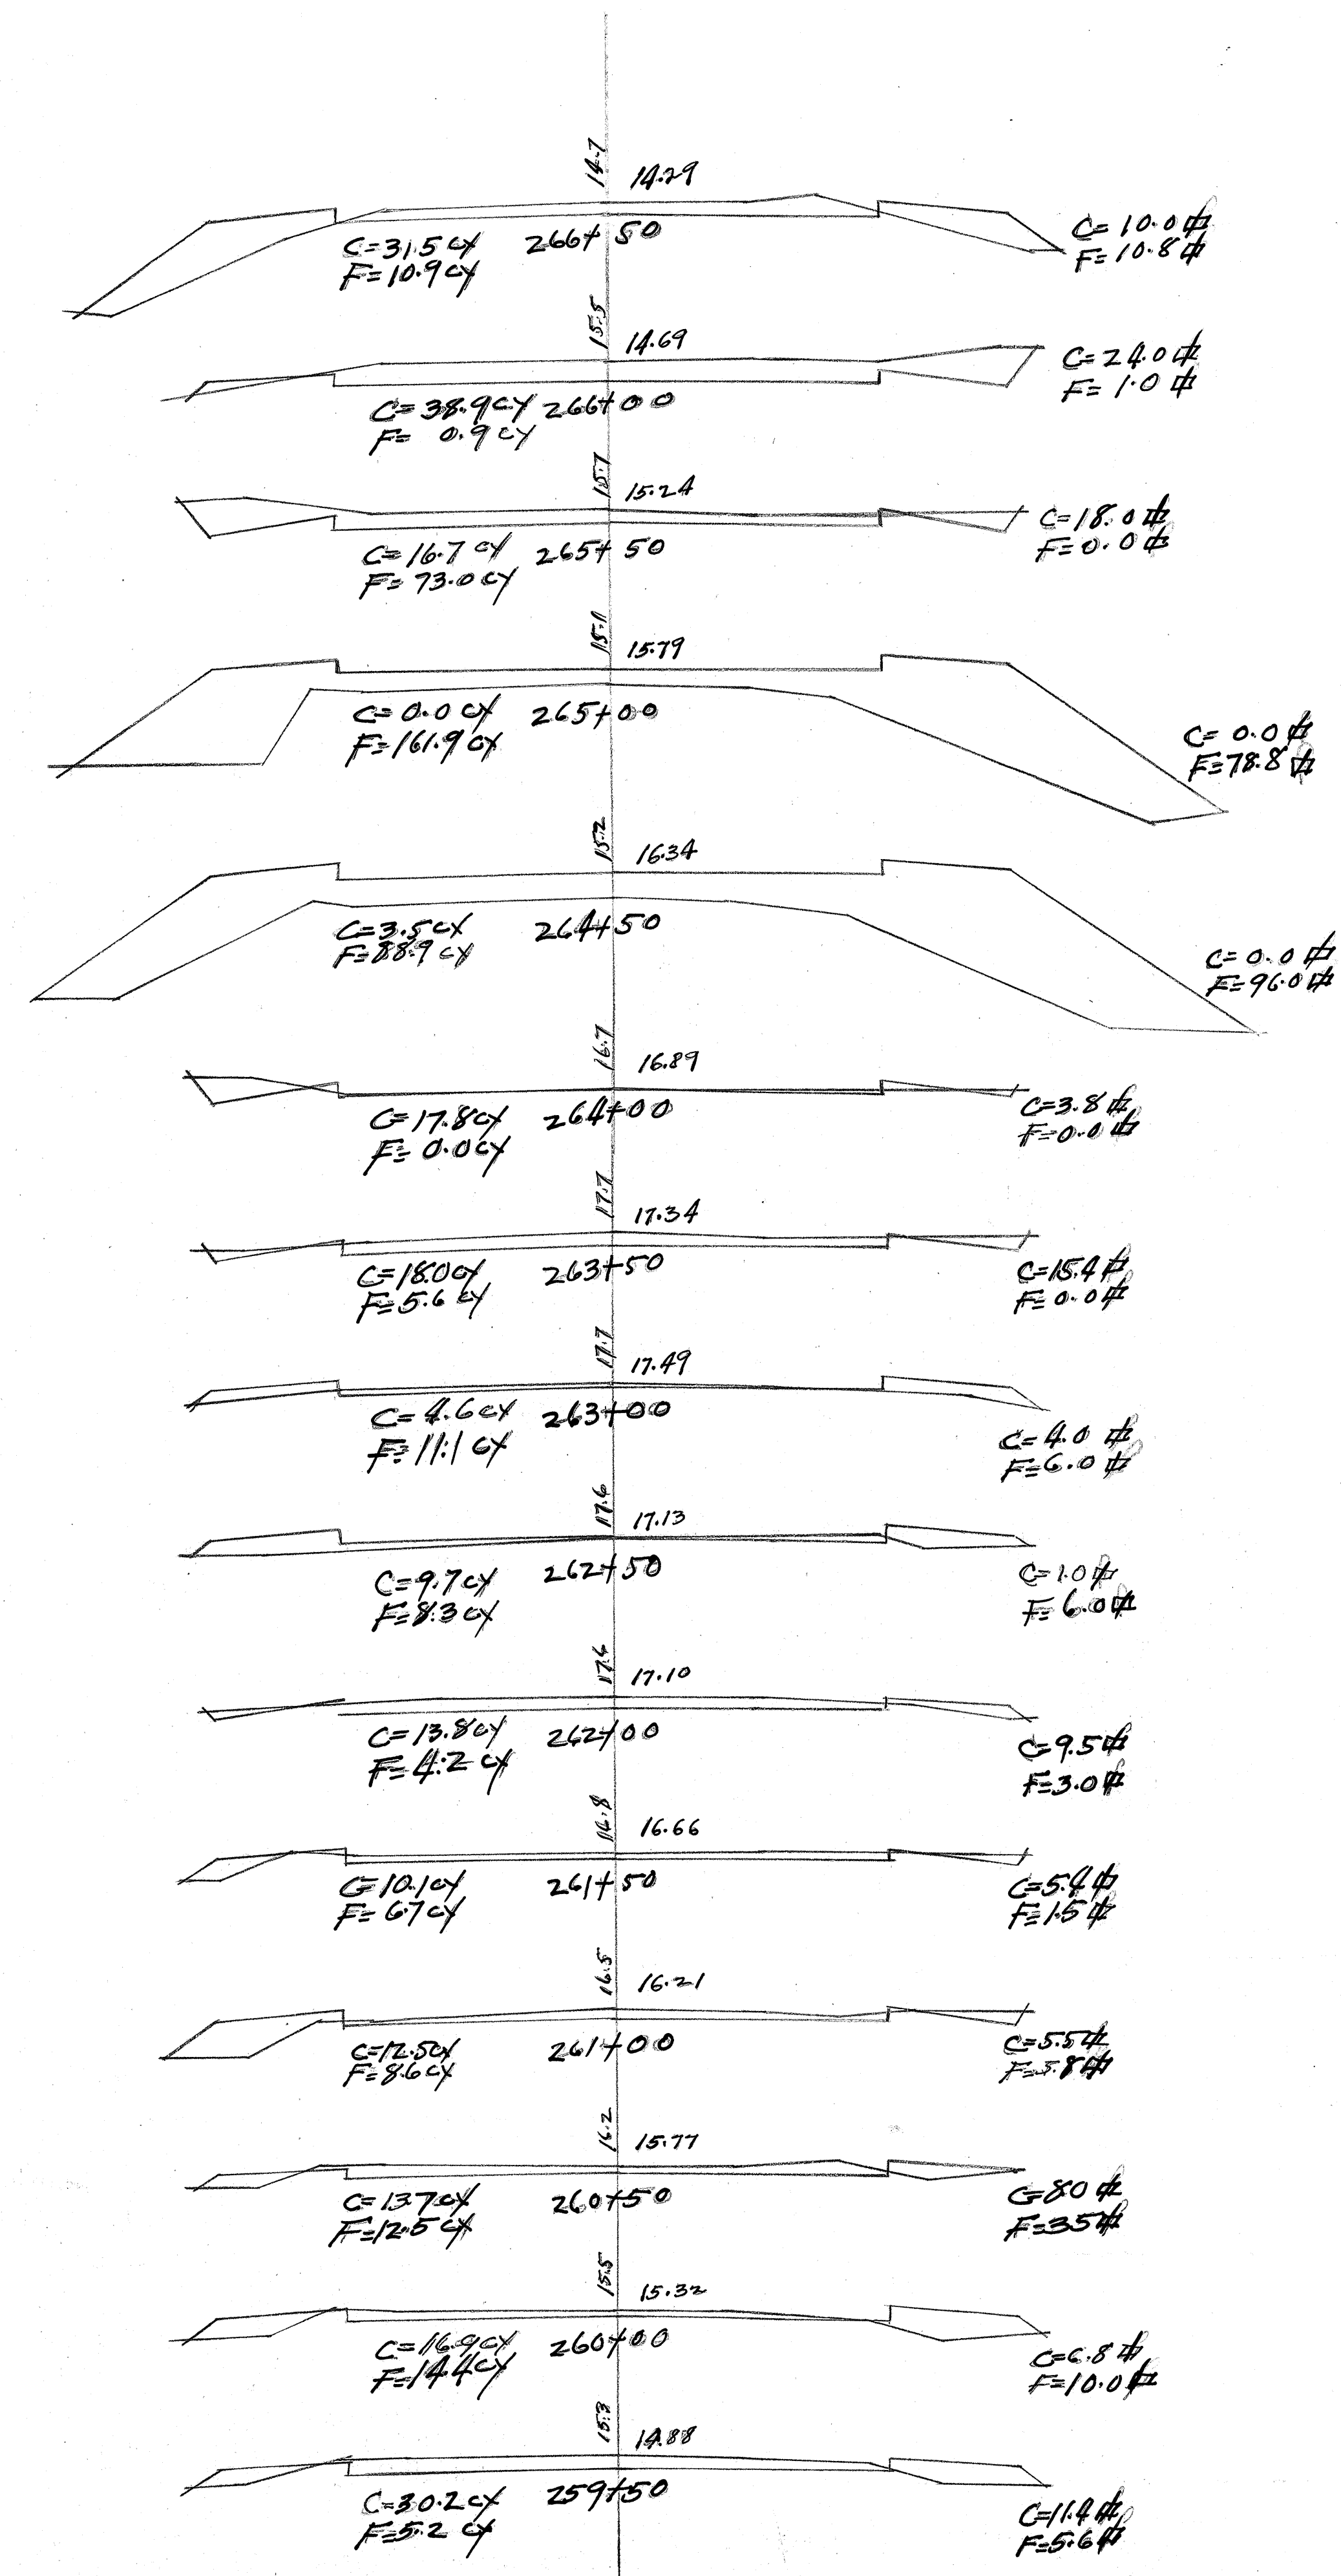

4057.40



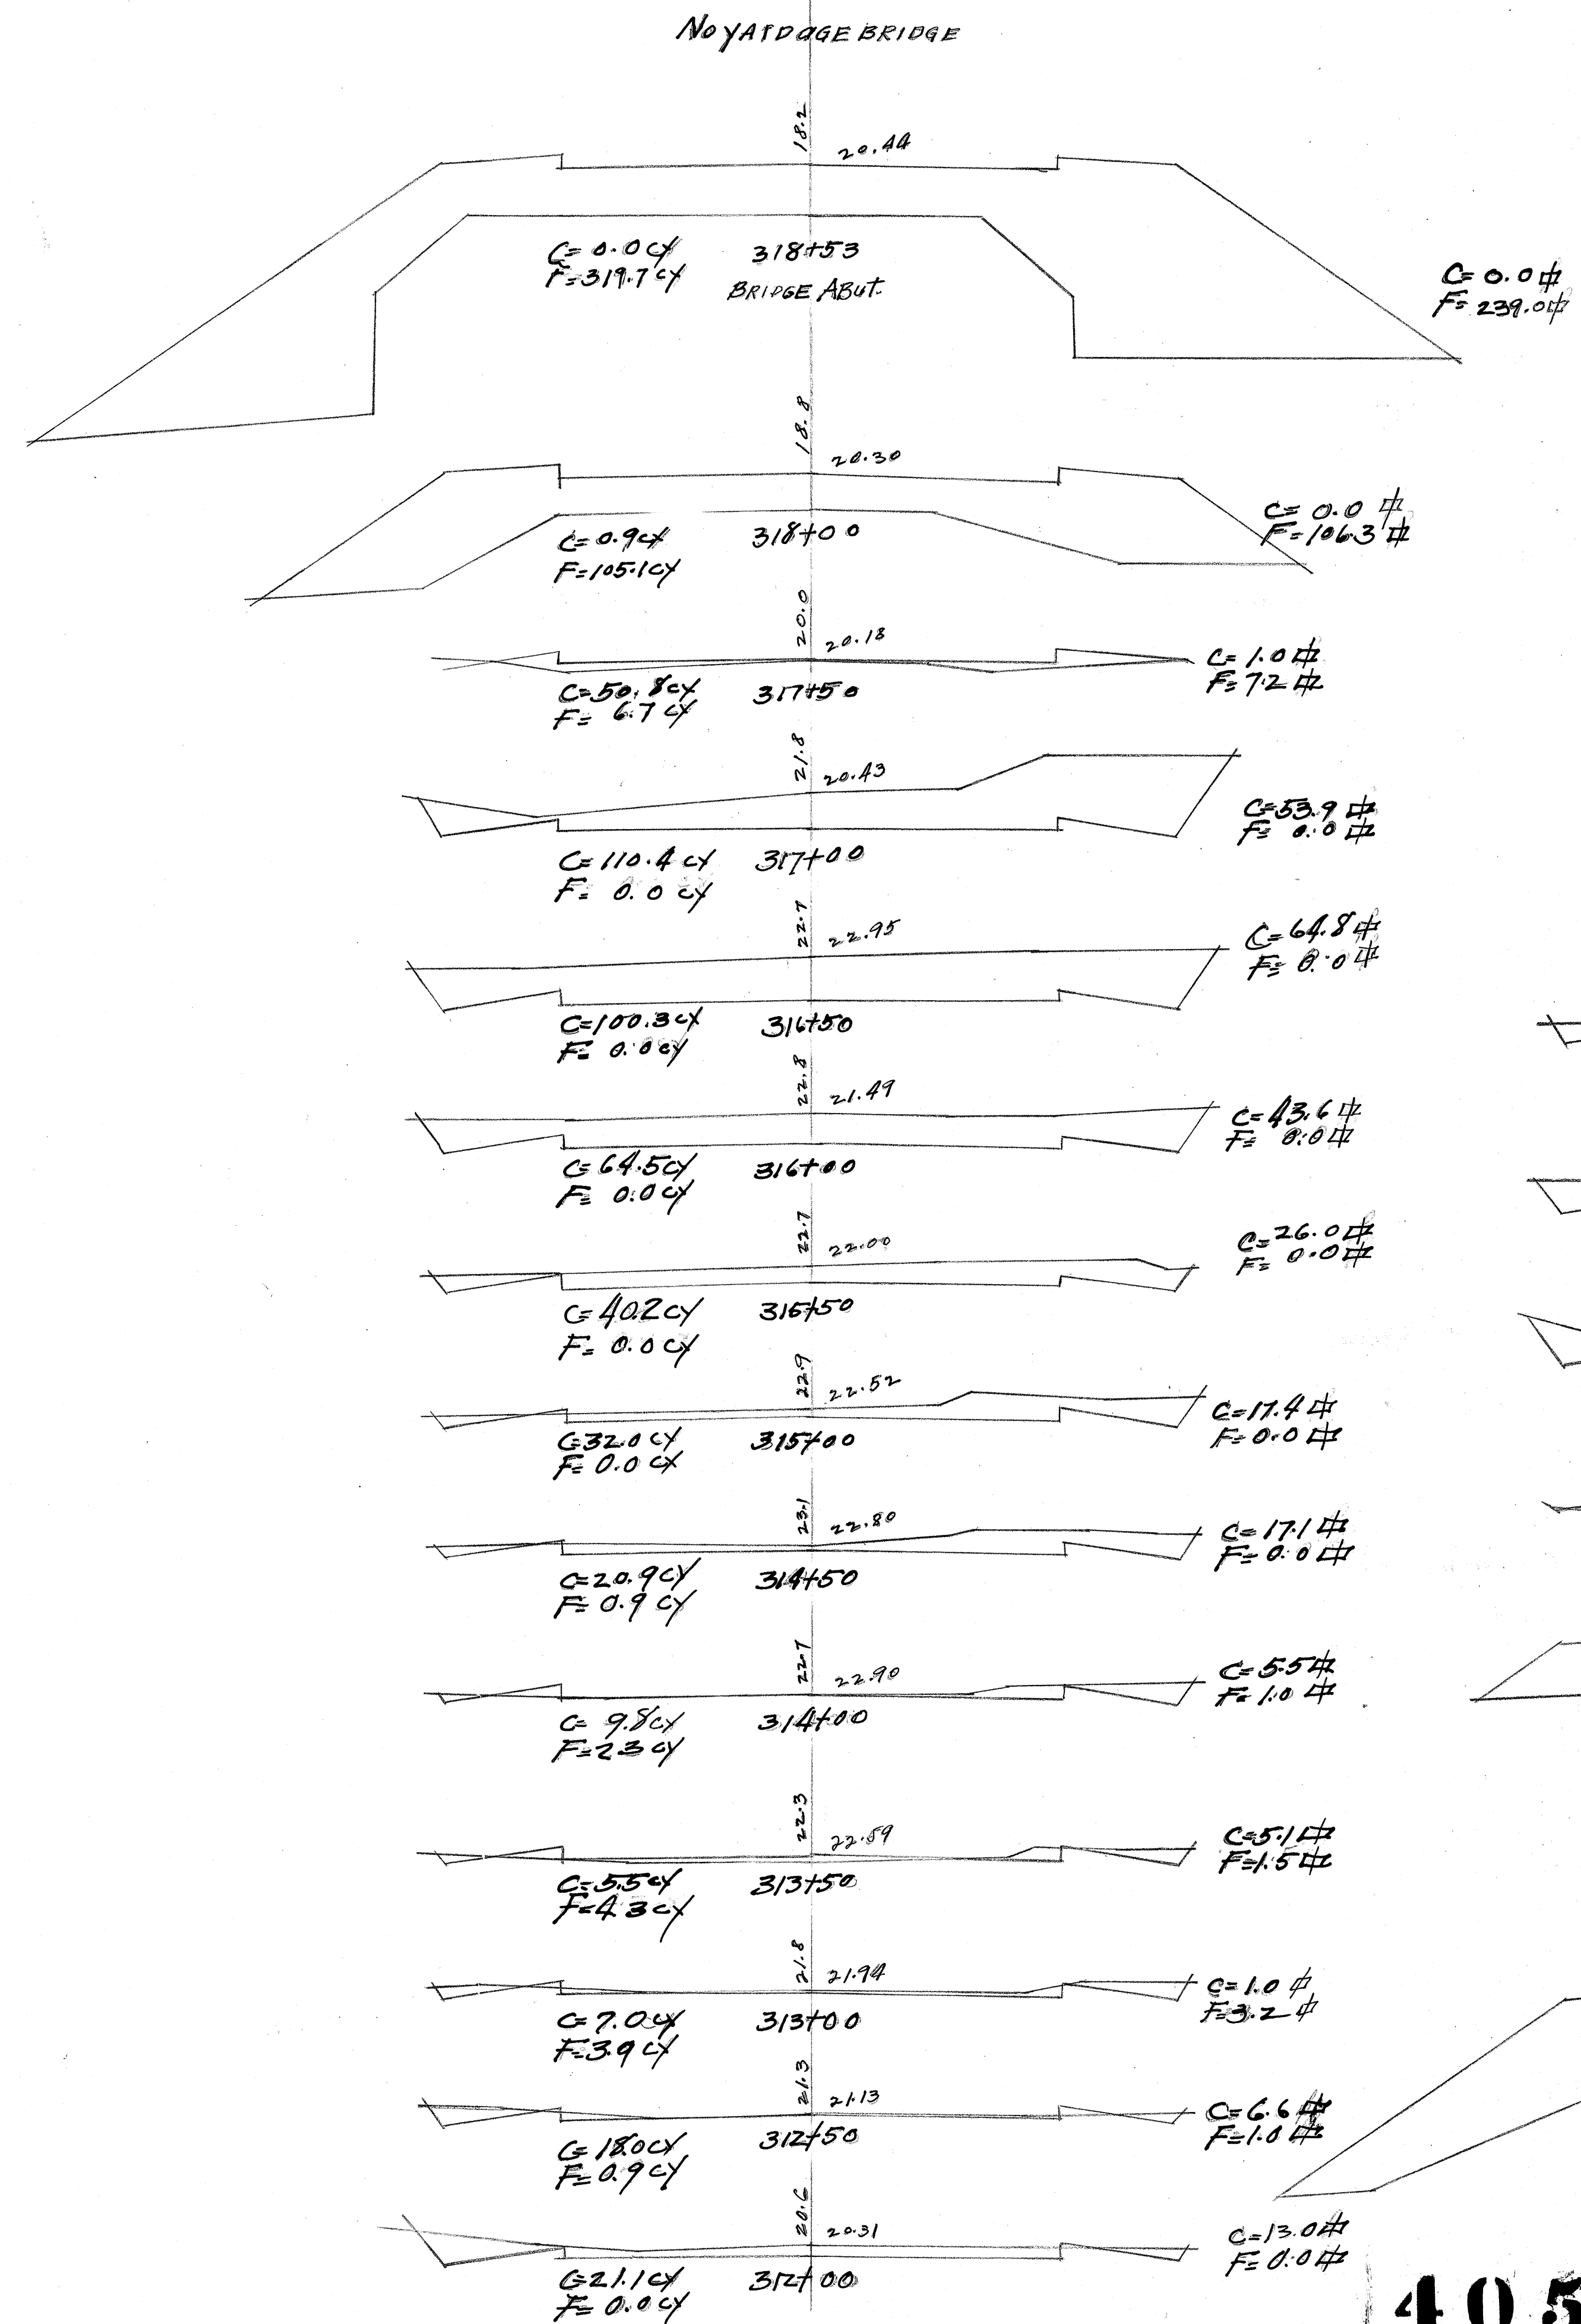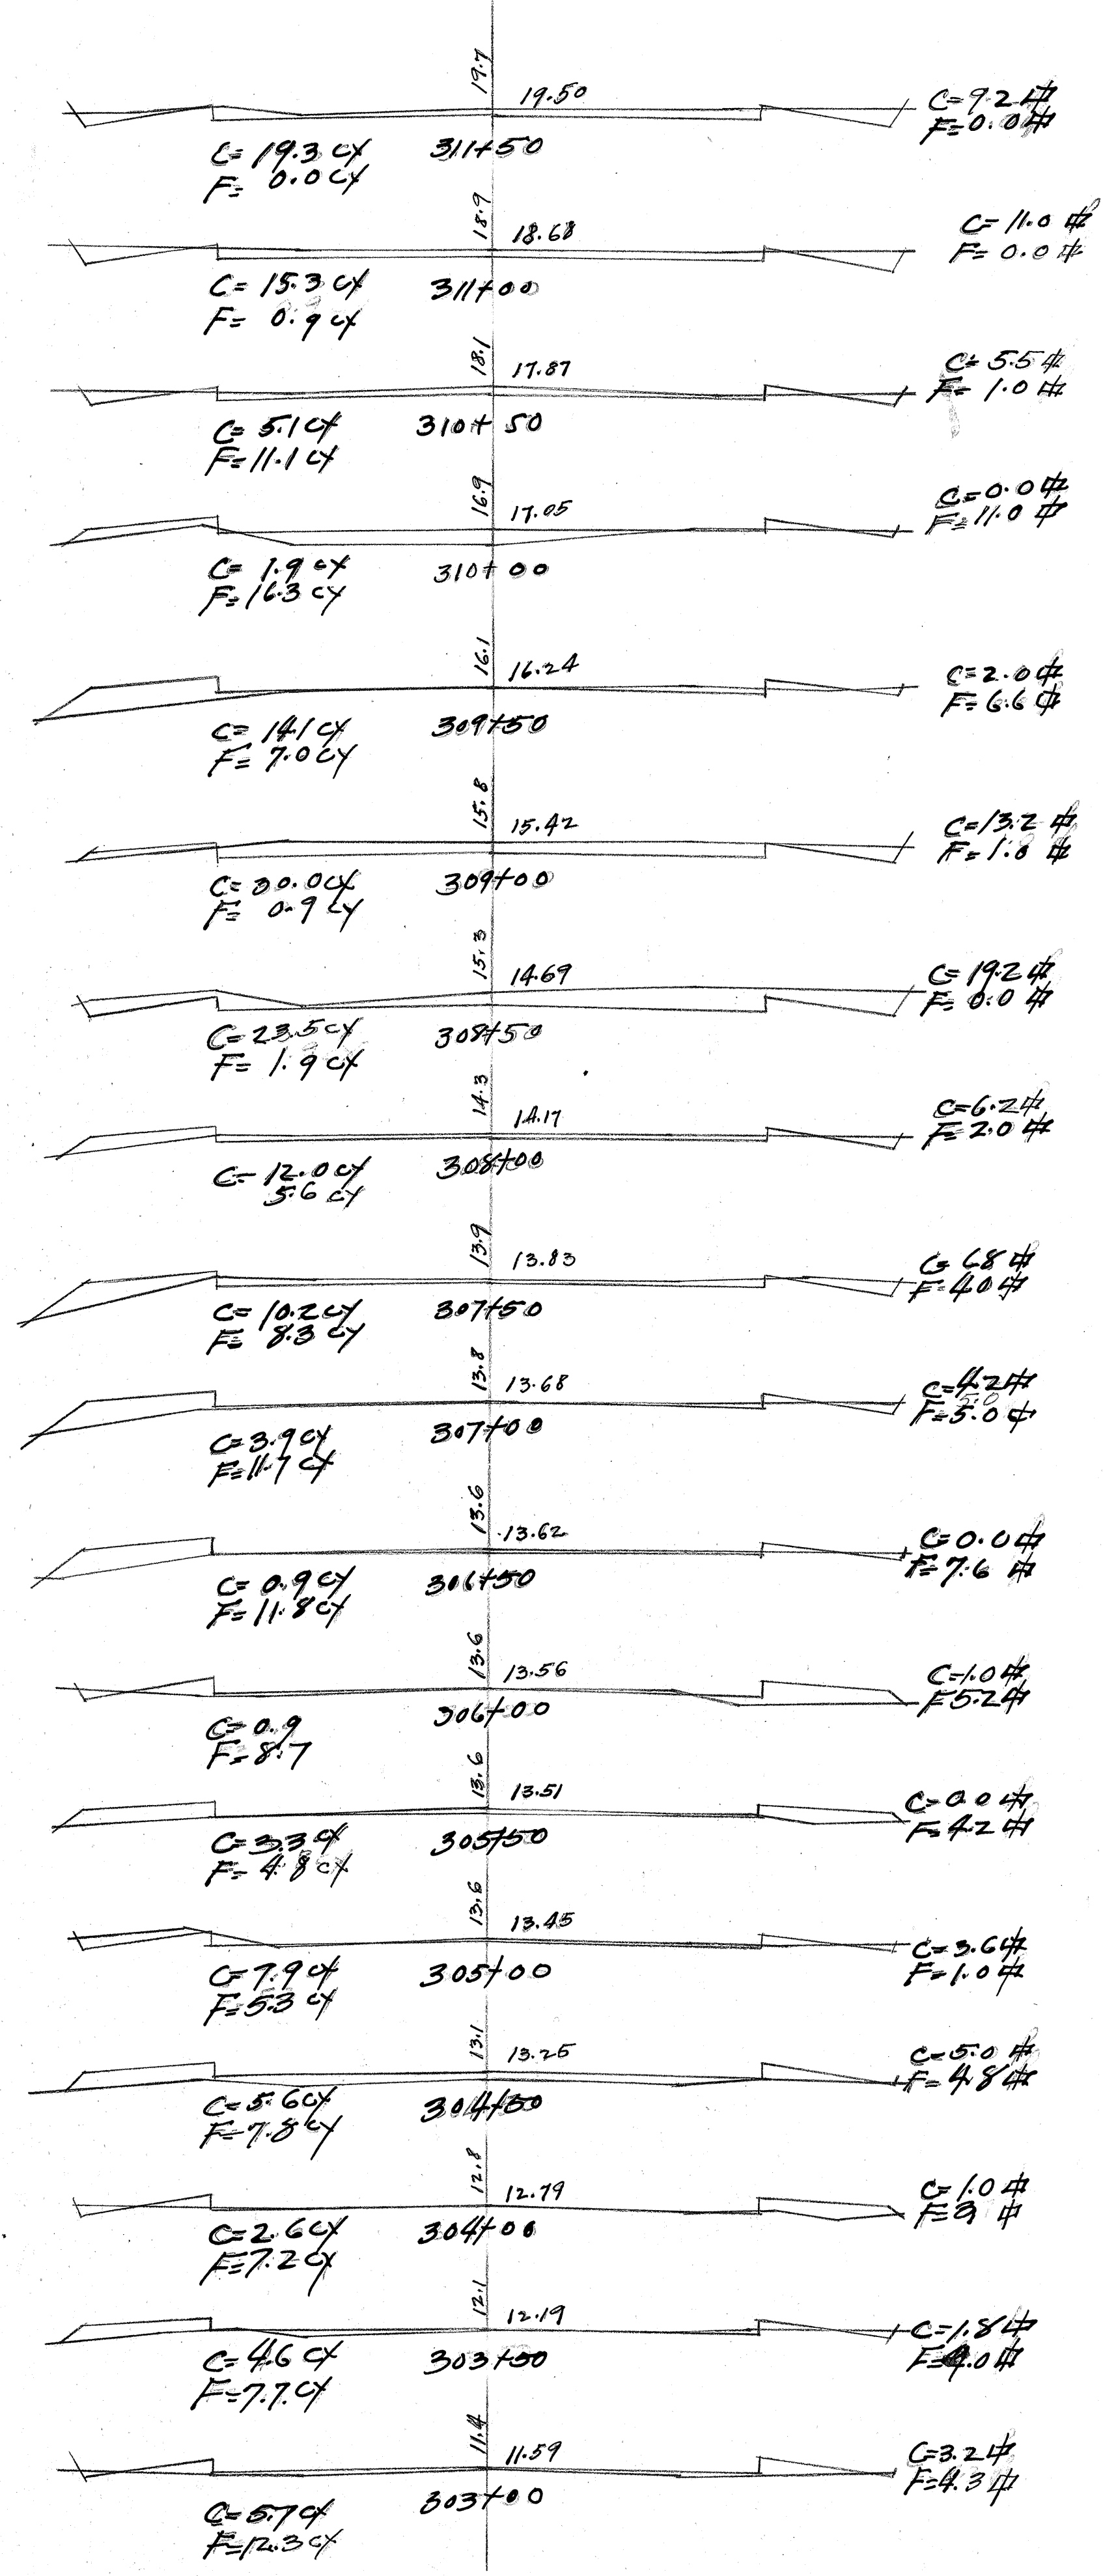

4057.42