



INDEX TO DRAWINGS	
SHEET NO.	DESCRIPTIONS
1	TITLE SHEET
2	TYPICAL ROAD SECTIONS
3-17	PLANS & PROFILE
18	STANDARD DETAILS
19-25	BRIDGES
26-42	ROAD CROSS SECTIONS

TERRITORY OF HAWAII
TERRITORIAL HIGHWAY DEPARTMENT
DISTRICT OF HONOLULU T.H.
**PLANS OF
KAMEHAMEHA HIGHWAY
FEDERAL AID PROJECT NO.3A**

OAHU T.H.
IN ACCORDANCE WITH ITEM 21, ACT 271, S.L.HAW. 1927.
SCALE

PLAN	1 INCH = 40 FEET	Sta 61+00 to 182+00
PROFILE	1 INCH = 40 FEET	
PLAN	1 INCH = 100 FEET	Sta 182+00 to 321+00
PROFILE	1 INCH = 100 FEET	
CROSS SECTION	1 INCH = 5 FEET	
	1 INCH = 5 FEET	

— CONVENTIONAL SIGNS —
Edge of existing Road
Existing Fence
Boundary Line (Not Fenced)
Existing Stone Wall
O.R. & L. Railroad
Center Line
Existing Culverts

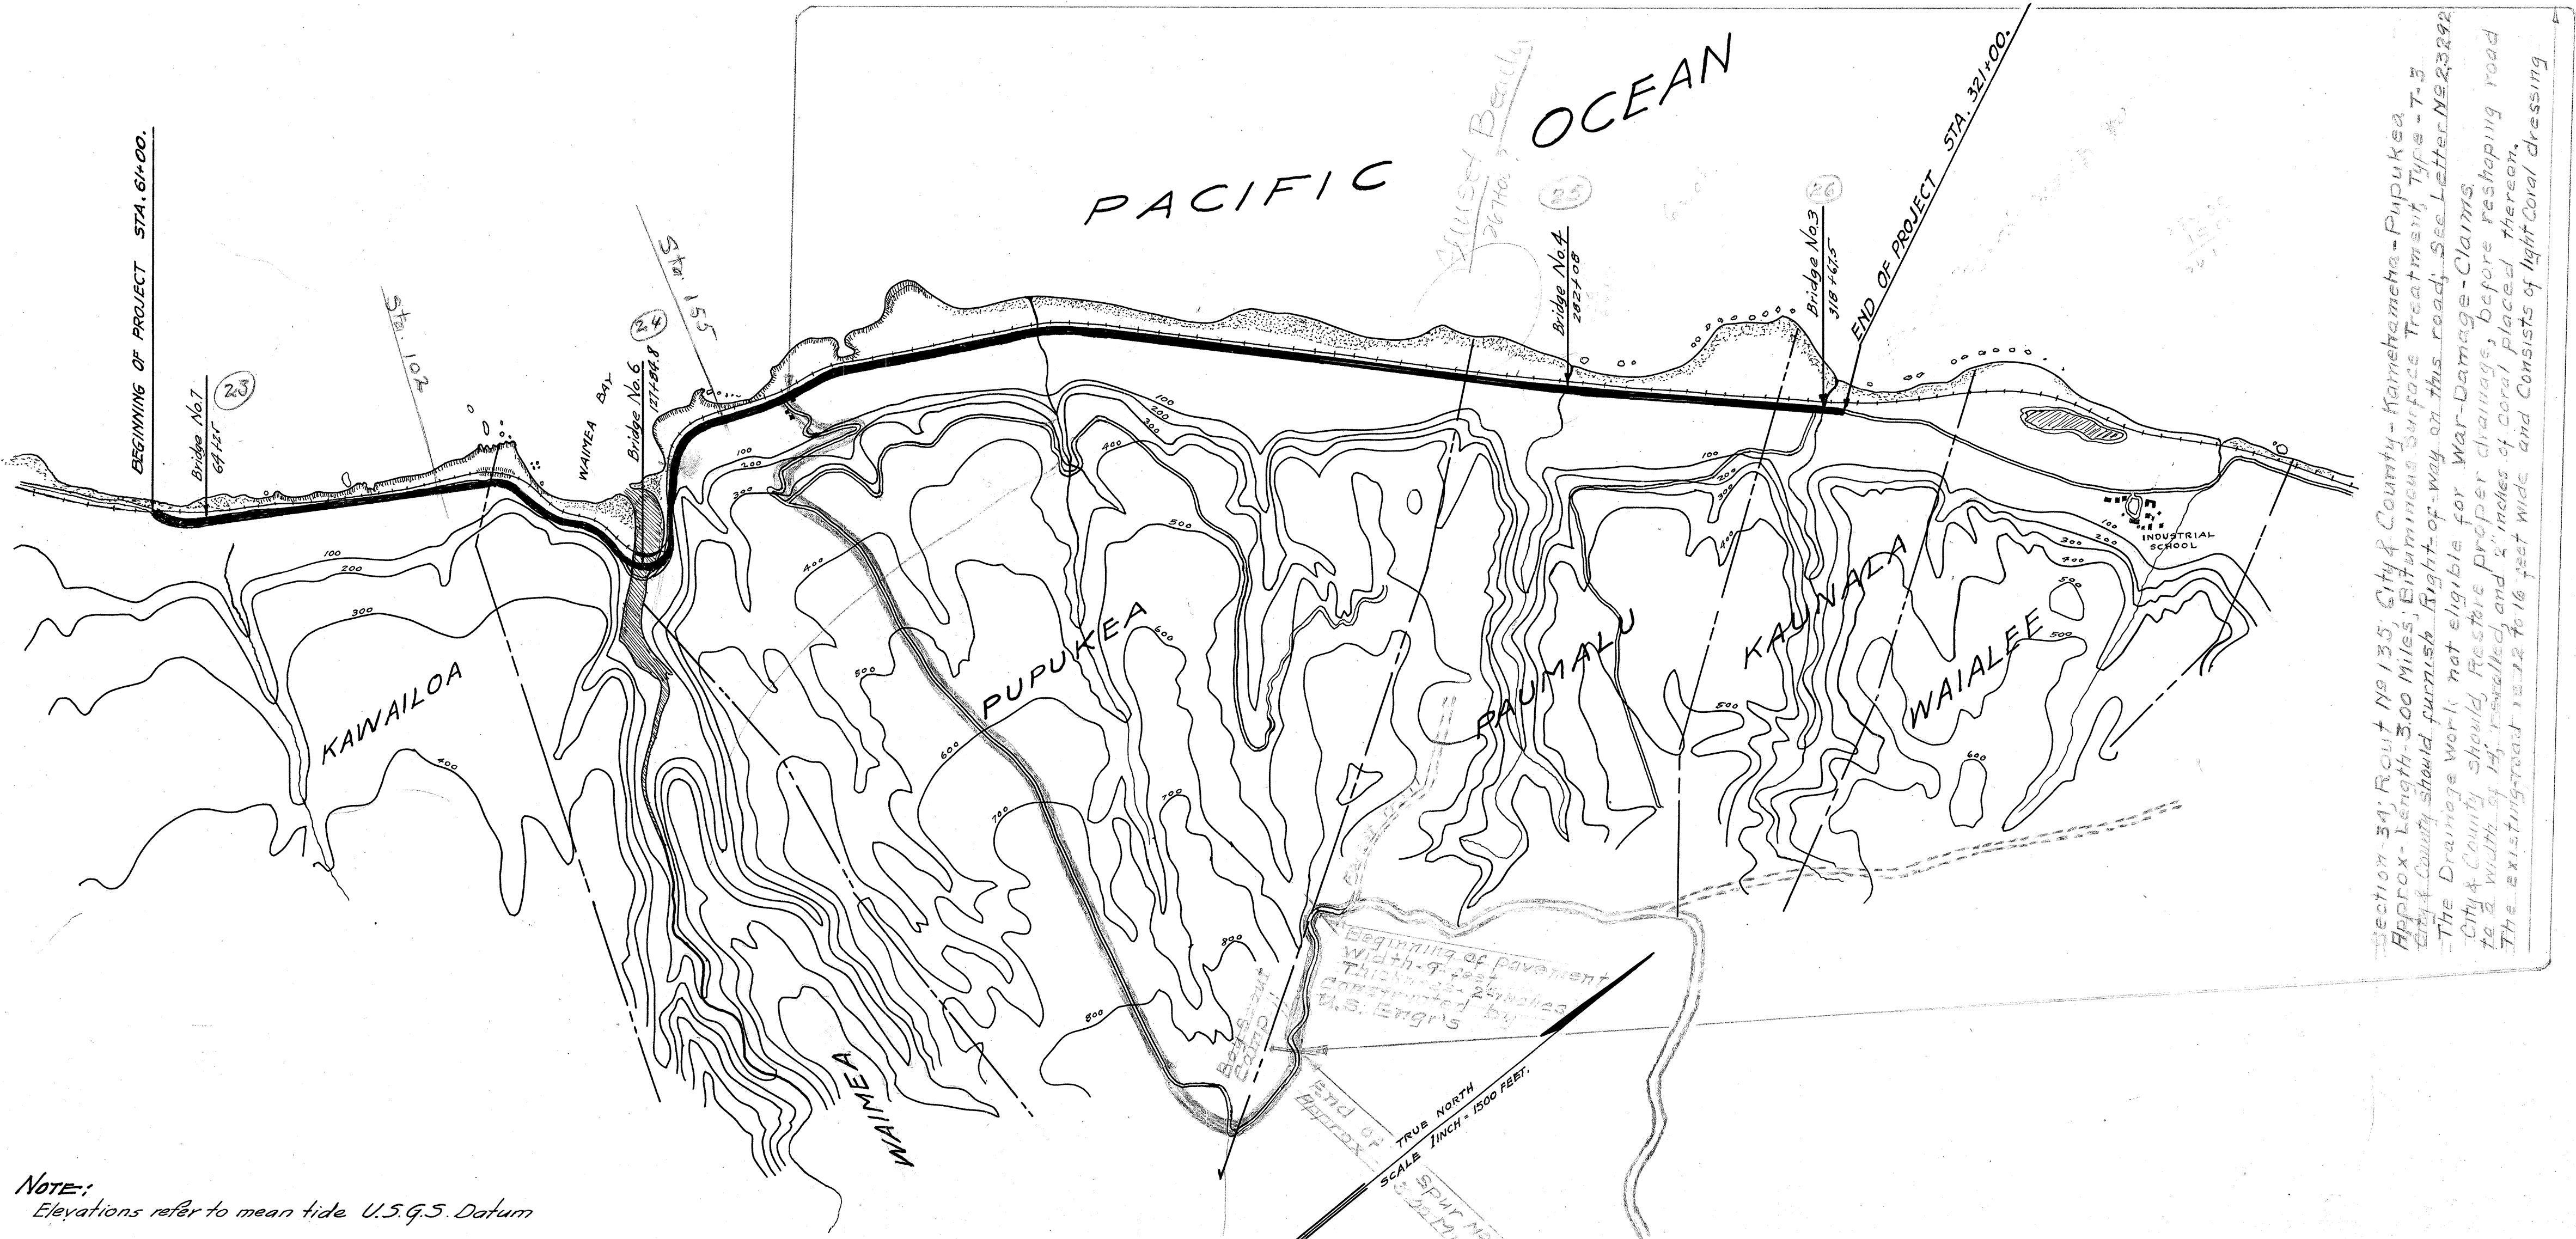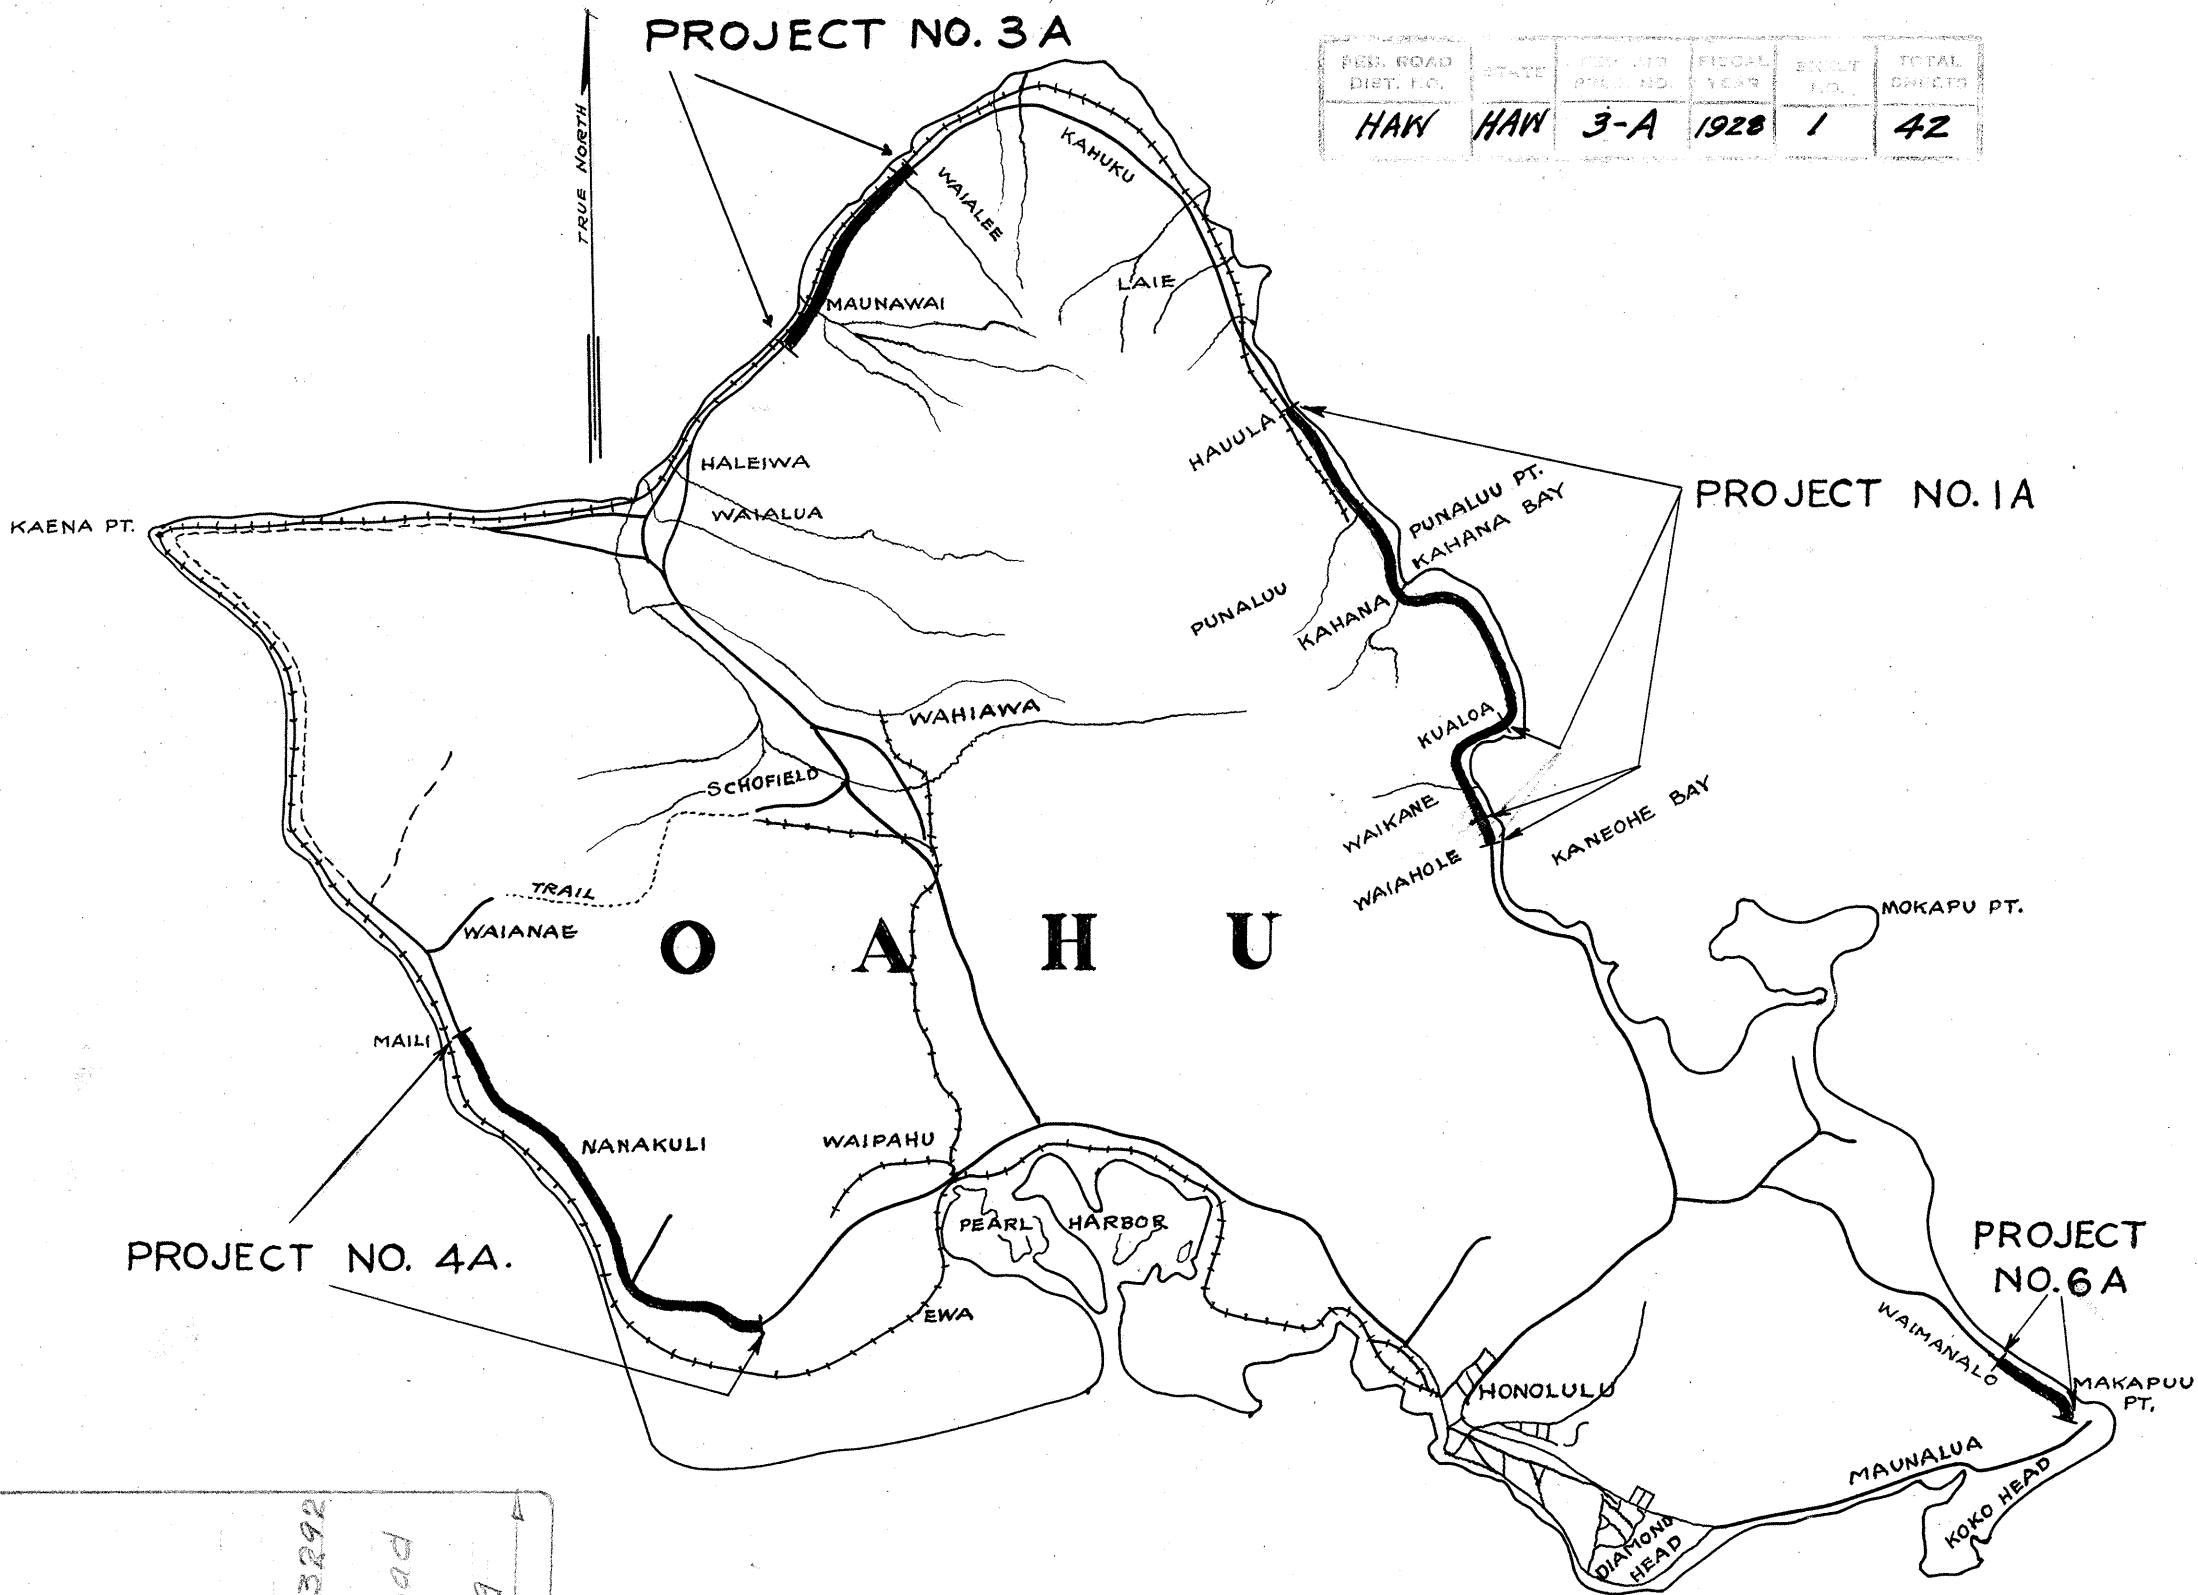

Section 34, Rout No 135, City & County - Kamehameha - Pupukea
Approx. Length 3.00 Miles. Entombed Surface Treatment, Type - T-3
City & County should furnish right-of-way on this road. See Letter No. 2292.
The Drainage work not eligible for War-Damage-Claims.
City & County should restore proper drainage, before reshaping road
to a width of 14', resurface, and 2' miles of coral placed thereon.
The existing road is 12 to 16 feet wide and consists of light coral dressing

NOTE:
Elevations refer to mean tide U.S.G.S. Datum
All poles & braces will be moved to 8 ft. clear
of pavement by M.T. Company.

LAYOUT OF PROJECT
SCALE 1 INCH = 1500 FEET

GROSS LENGTH 4.924 MI. EXCEPTIONS 0.076 MI. NET LENGTH 4.846 MI.

4057.1

APPROVED
By *H. H. Sigmond*
10-12-1928
TERRITORIAL HIGHWAY ENGR.

RECOMMENDED FOR APPROVAL
PRINCIPAL HIGHWAY ENGR. Bureau of Public Roads.
RECOMMENDED FOR APPROVAL
CHIEF ENGR. Bureau of Public Roads.
APPROVED
DIRECTOR, Bureau of Public Roads.