
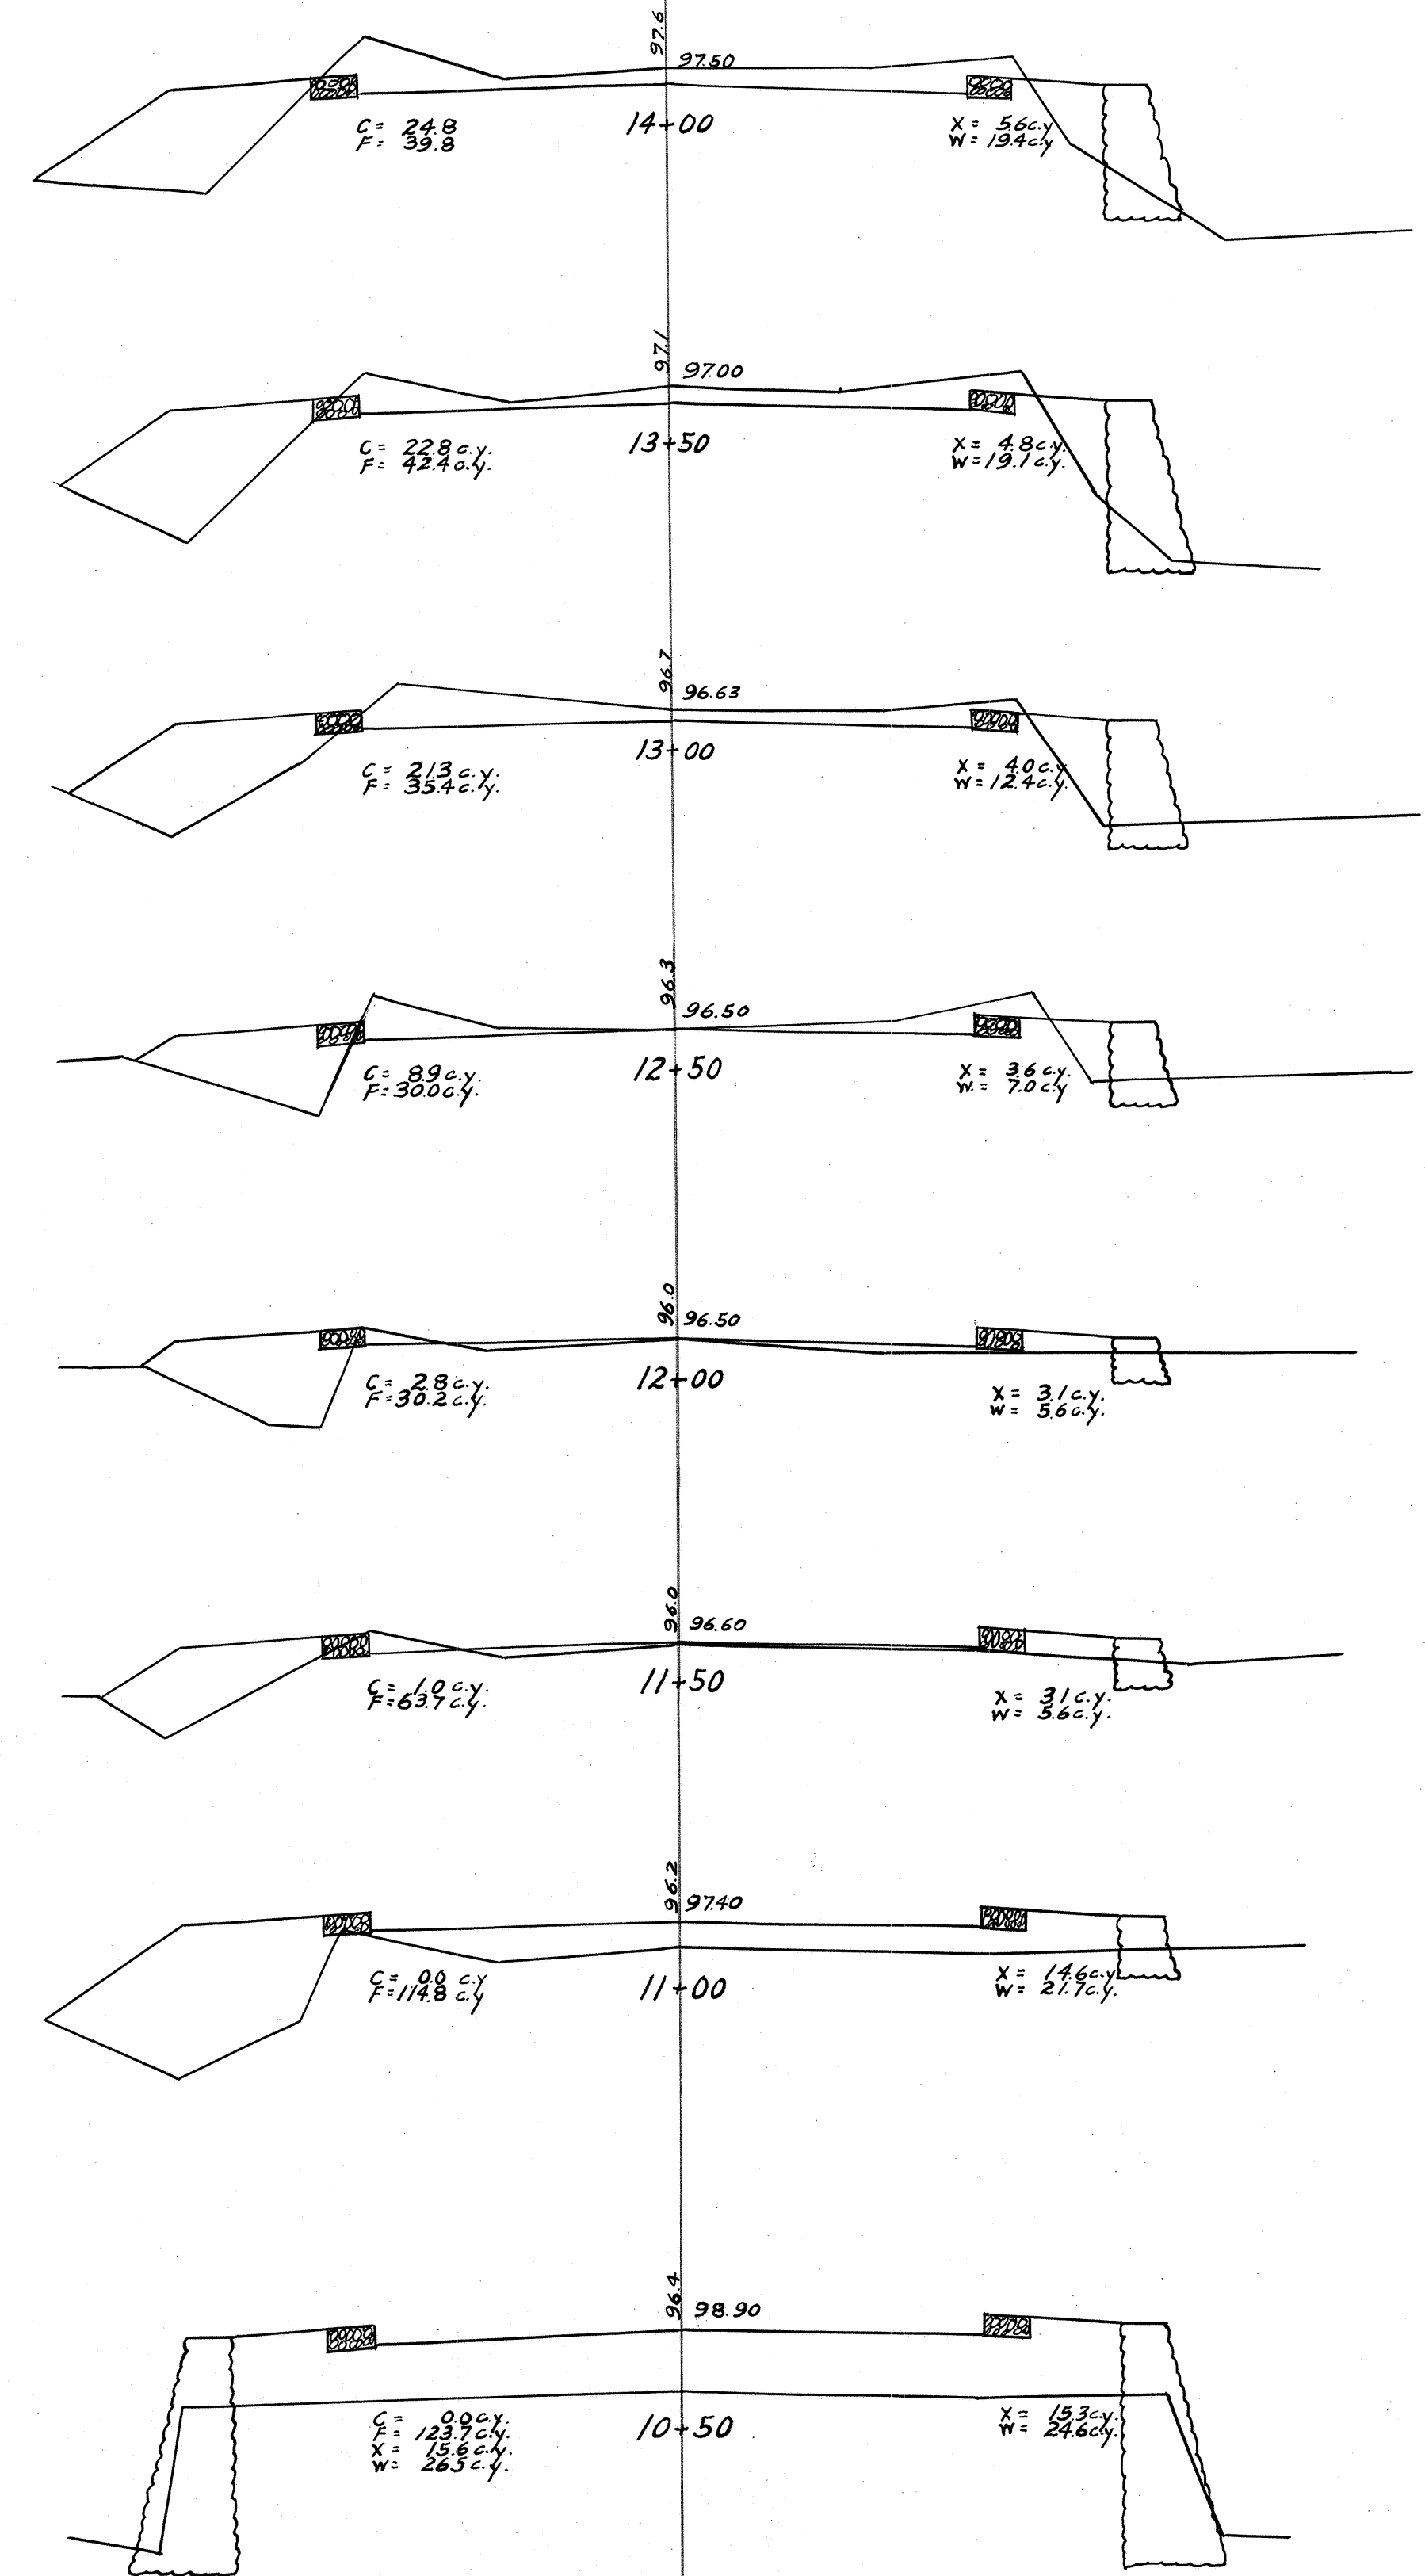


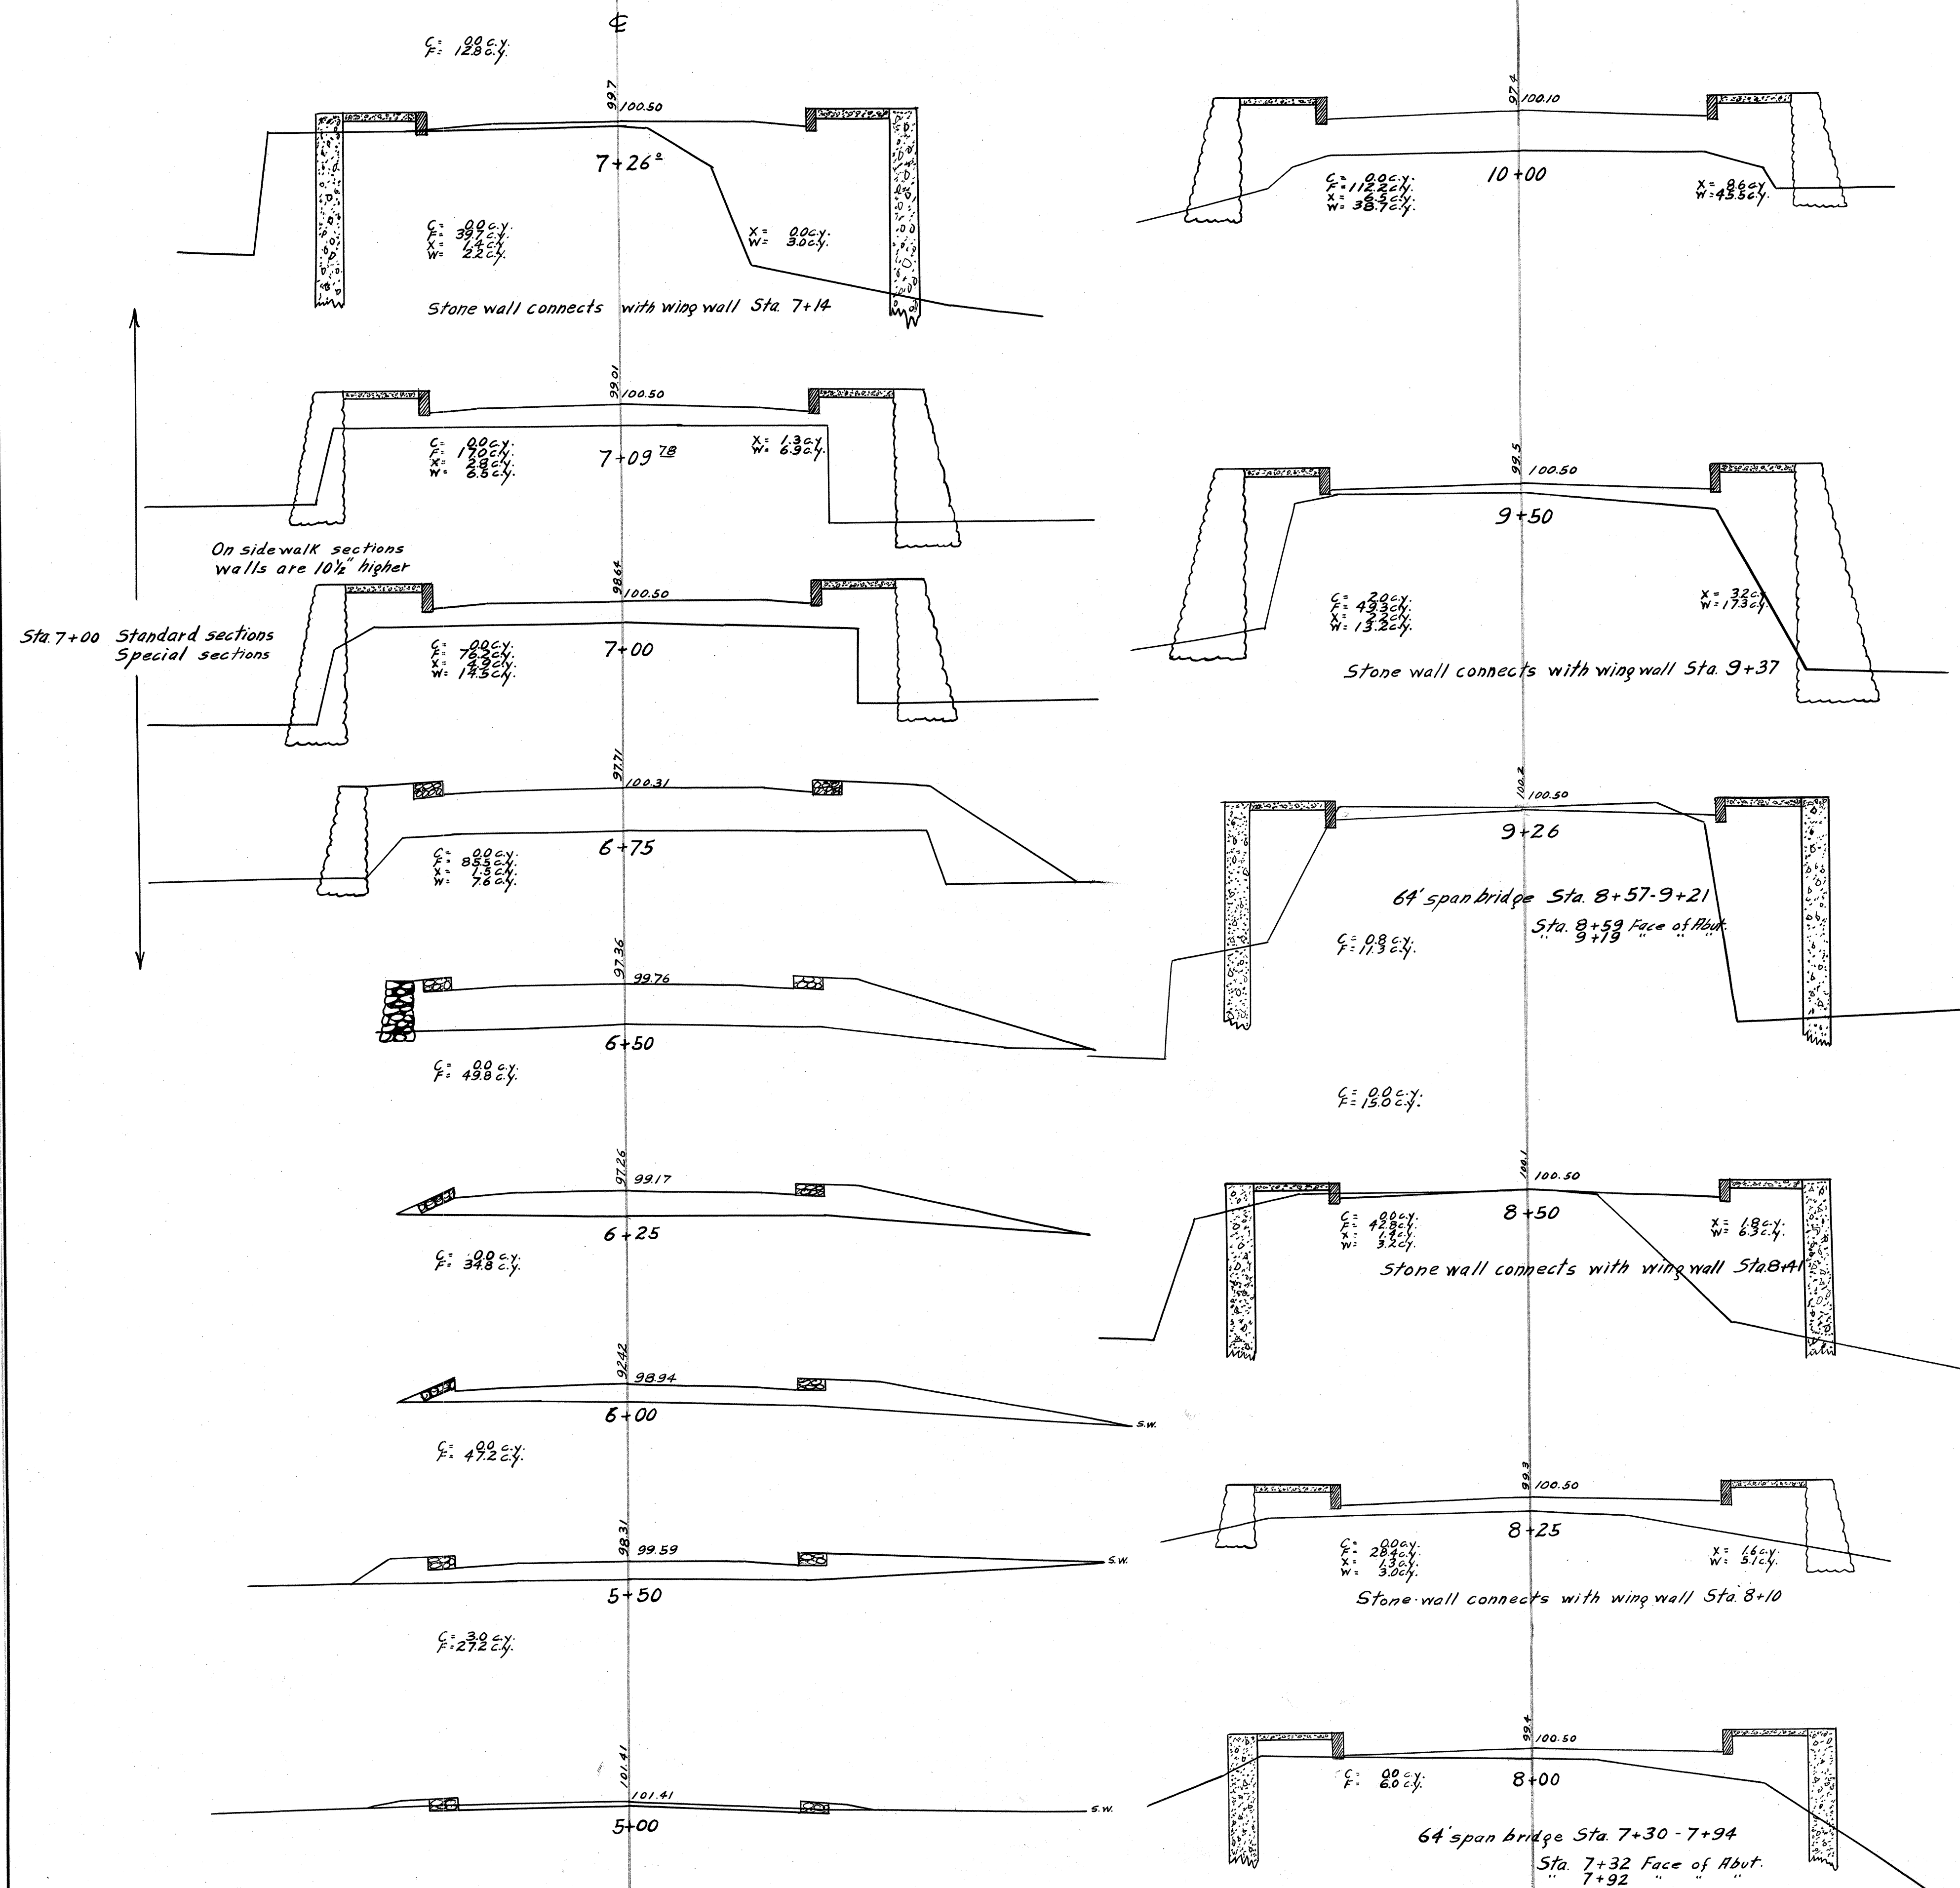

Elevations shown are finished grade
 C = Excavation
 E = Embankment
 X = Excavation for wall
 W = Wall

4029.SPECIAL, NO. 1