

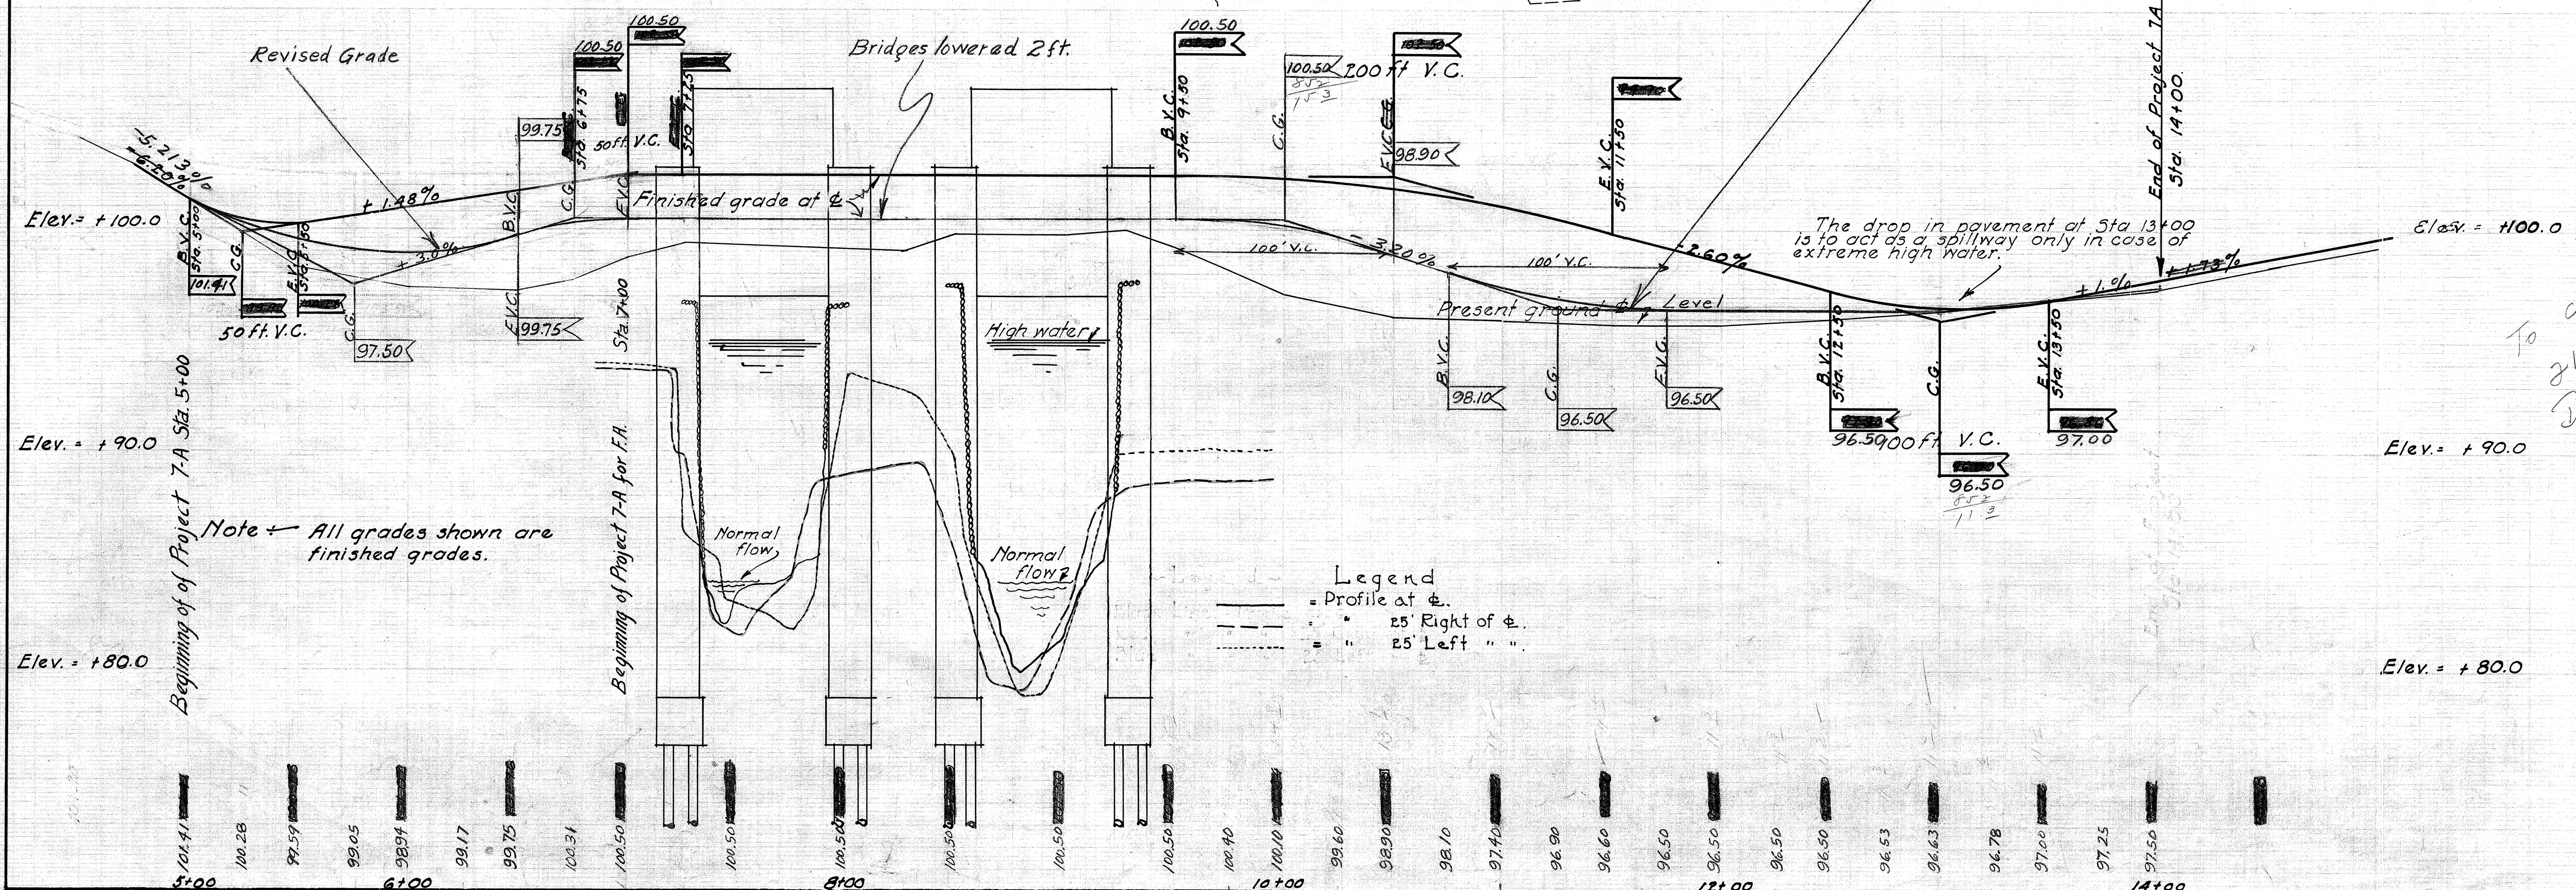


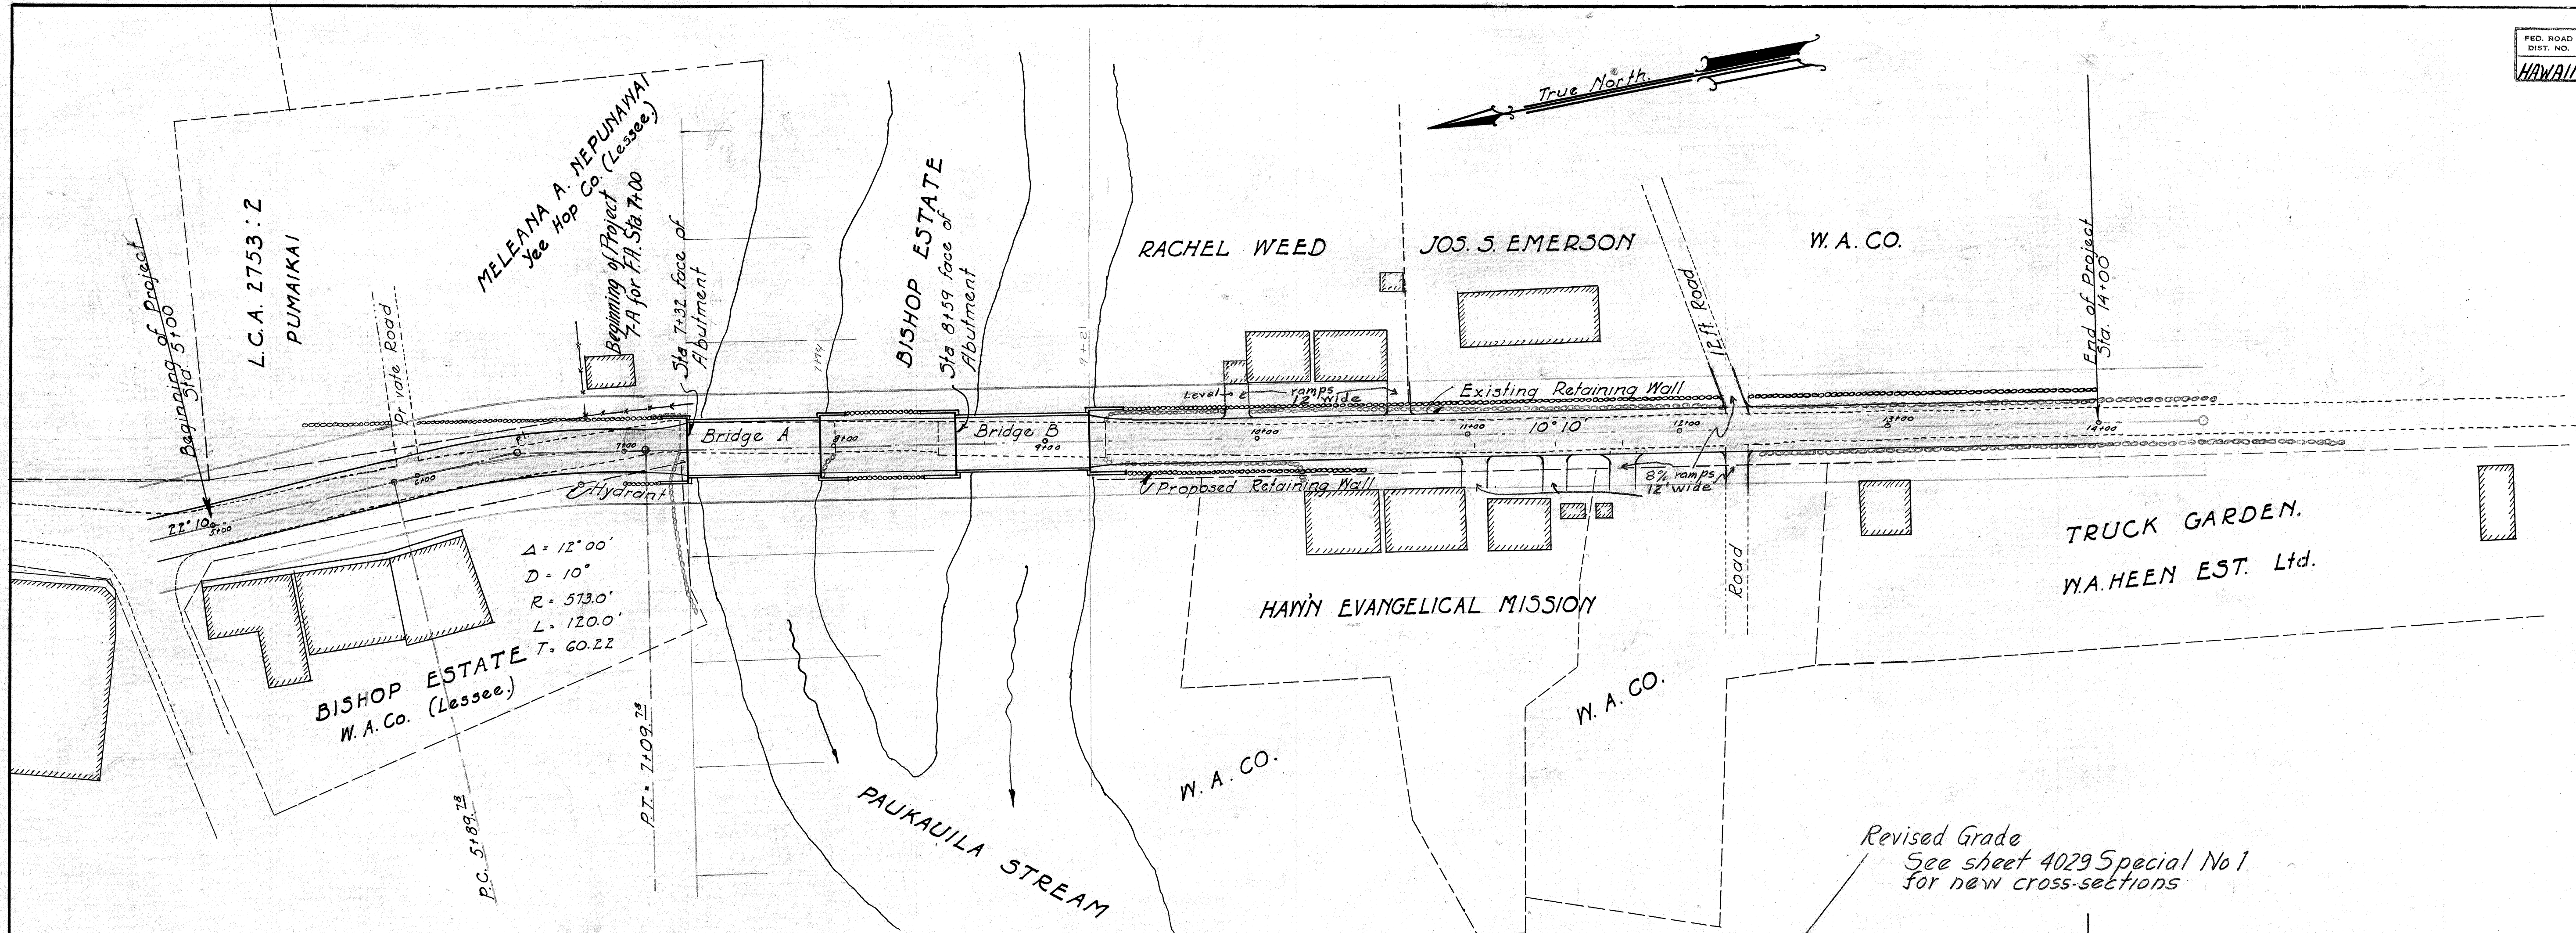


Legend
 — Profile at $\pm$.
 - - - 25' Right of $\pm$.
 - - - 25' Left " "

To correct to 21 B Datum
 Deduct 85"

Revised to include revised grades and ramps 5/31/28

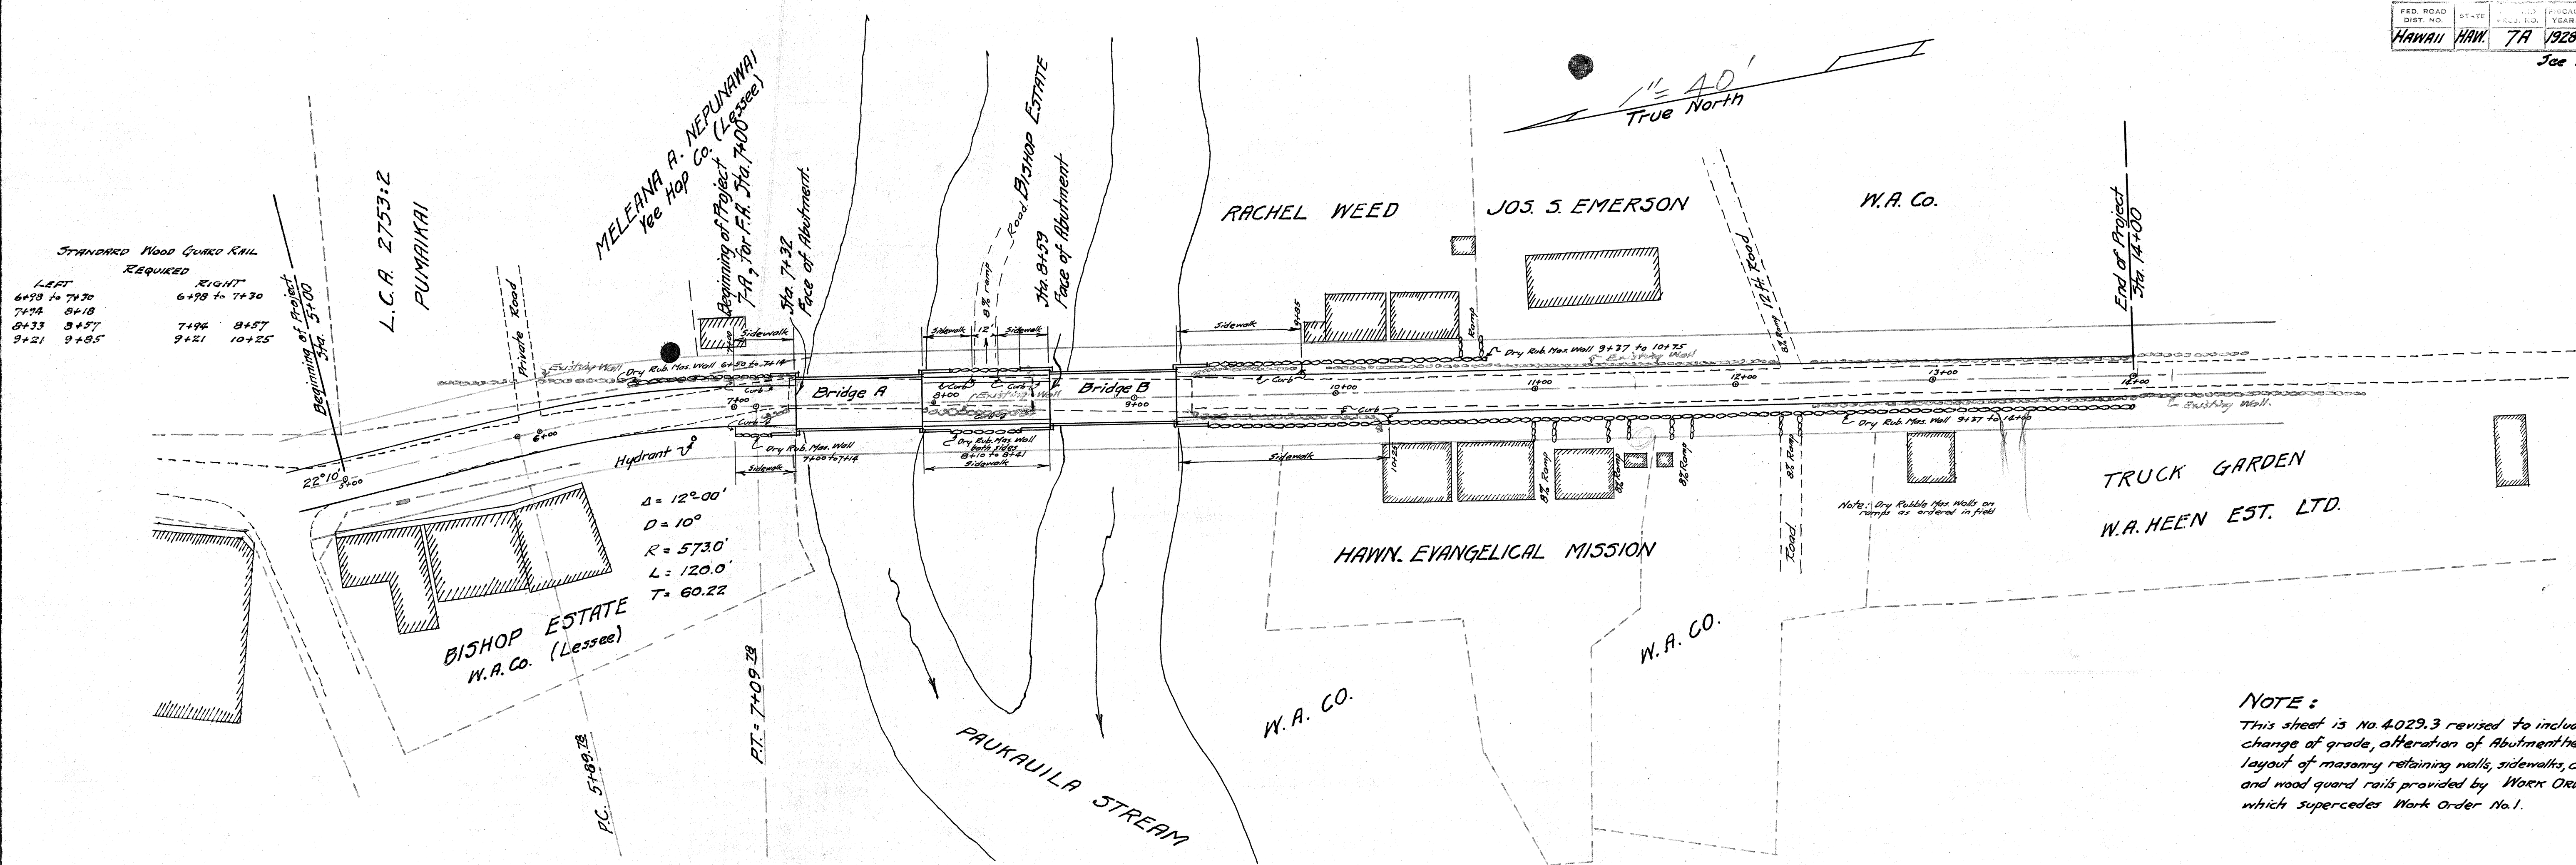

NOTE:
This sheet is No. 4029.3 revised to include the change of grade, alteration of Abutment heights, layout of masonry retaining walls, sidewalks, curbs, and wood guard rails provided by Work Order No. 2 which supercedes Work Order No. 1.

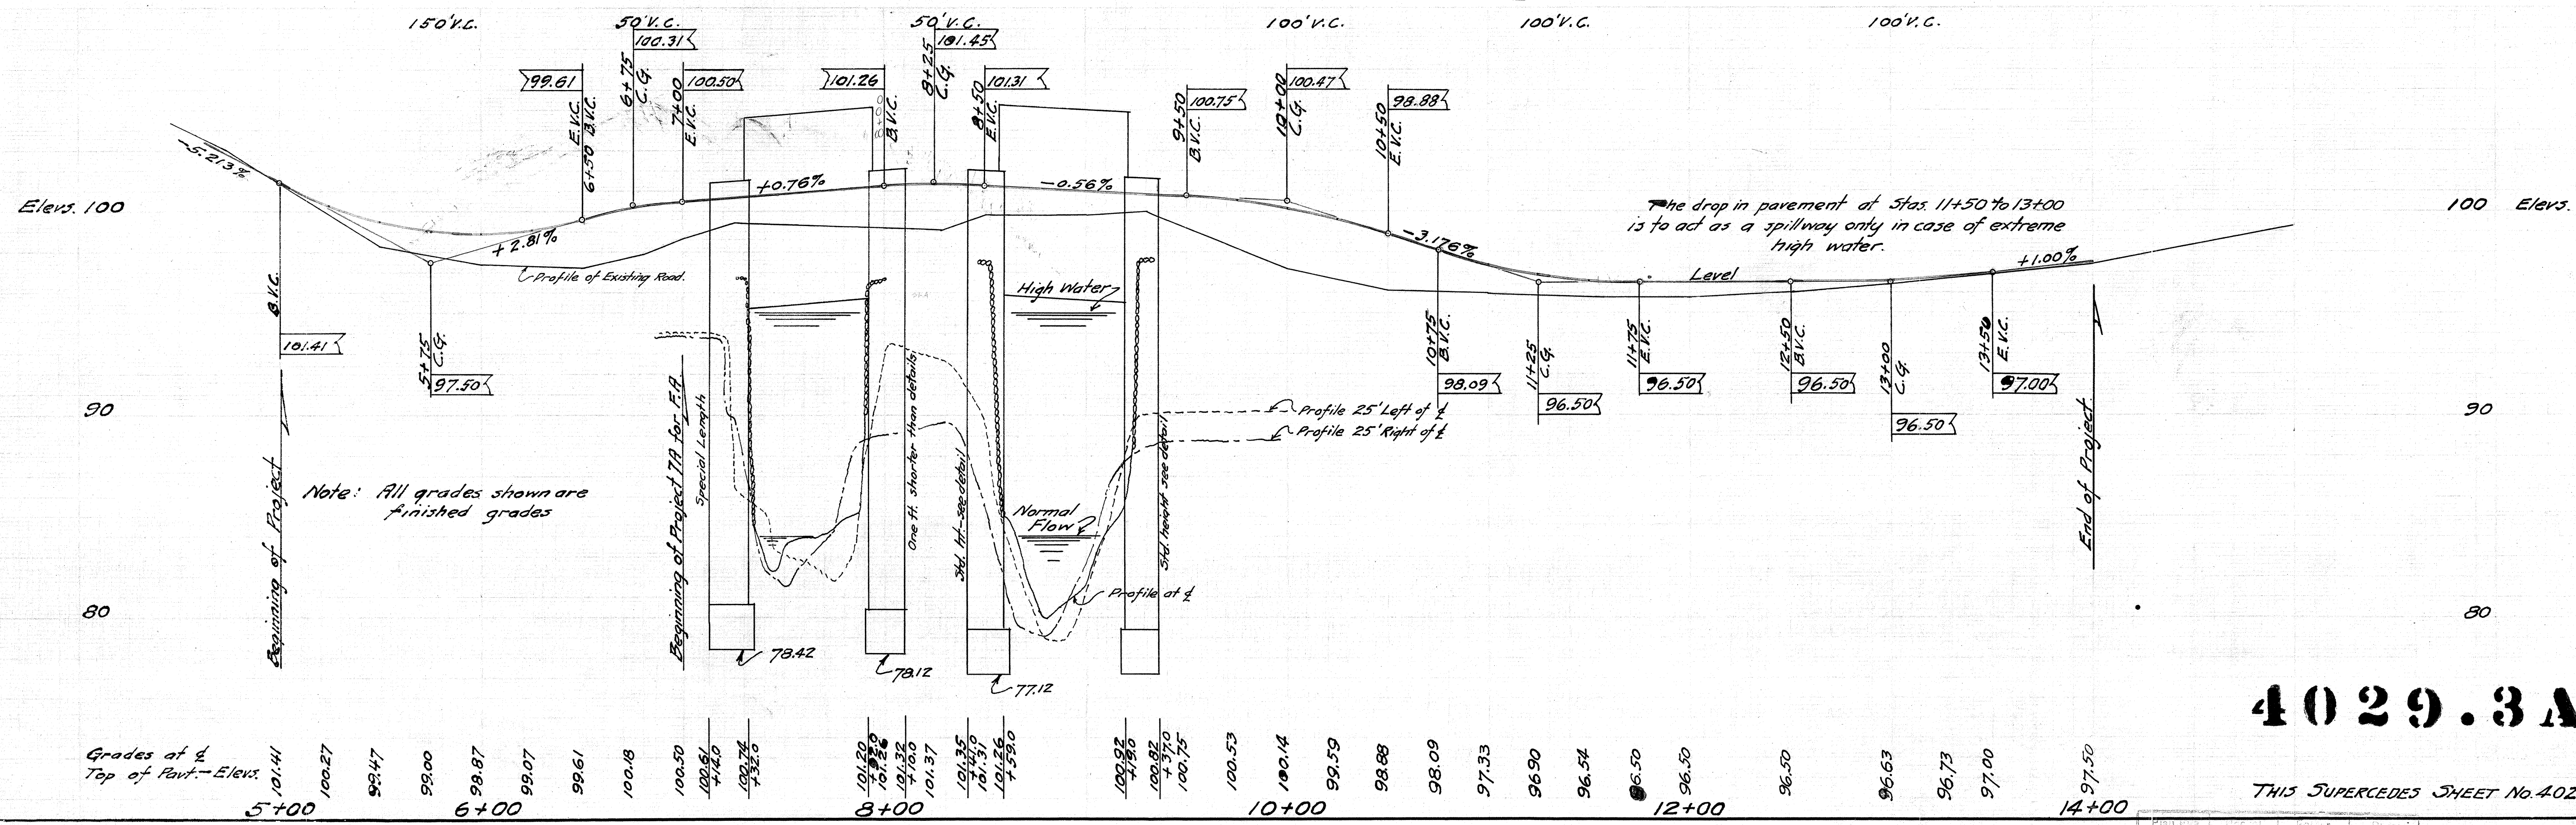

4029.3A

THIS SUPERCEDES SHEET No. 4029.3