




FED. ROAD DIST. NO.	STATE	FED. AID PROJ. NO.	FISCAL YEAR	SHEET NO.	TOTAL SHEETS
HAWAII	HAW	3 B	1930	10	12

H.C. Young, C.E.C.
H.C. Young & Sons

H.C. Young, C.E.C. JUNIOR
H.C. Young & Sons

627

627

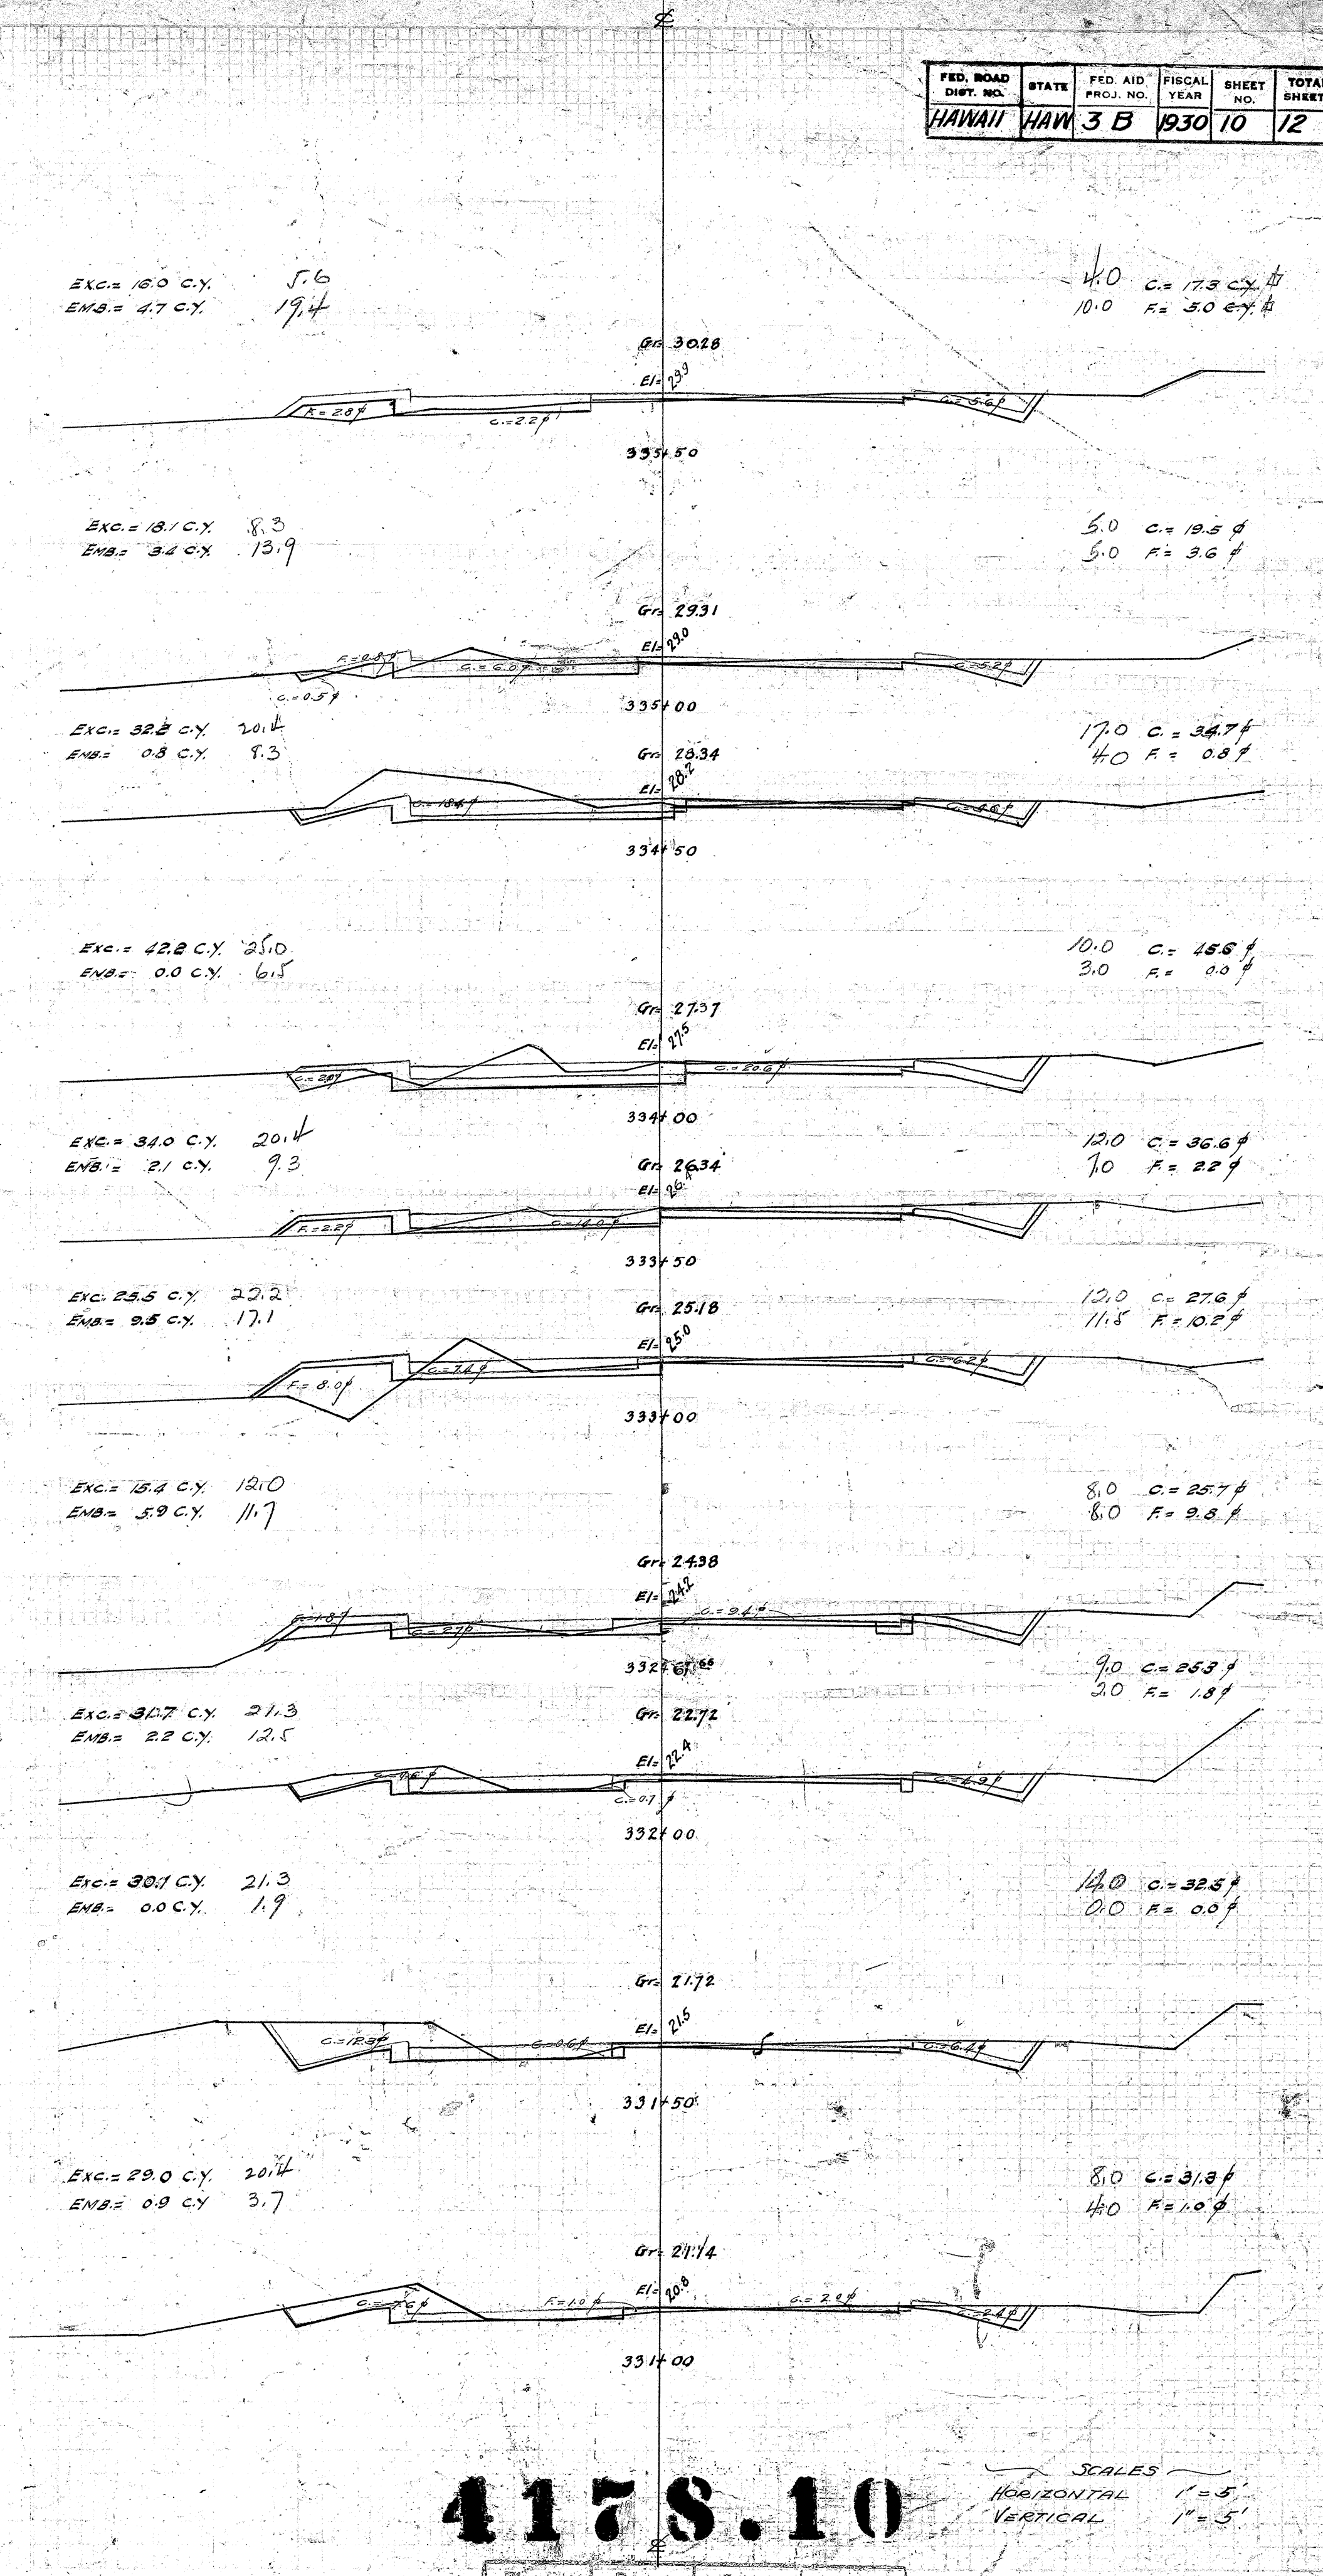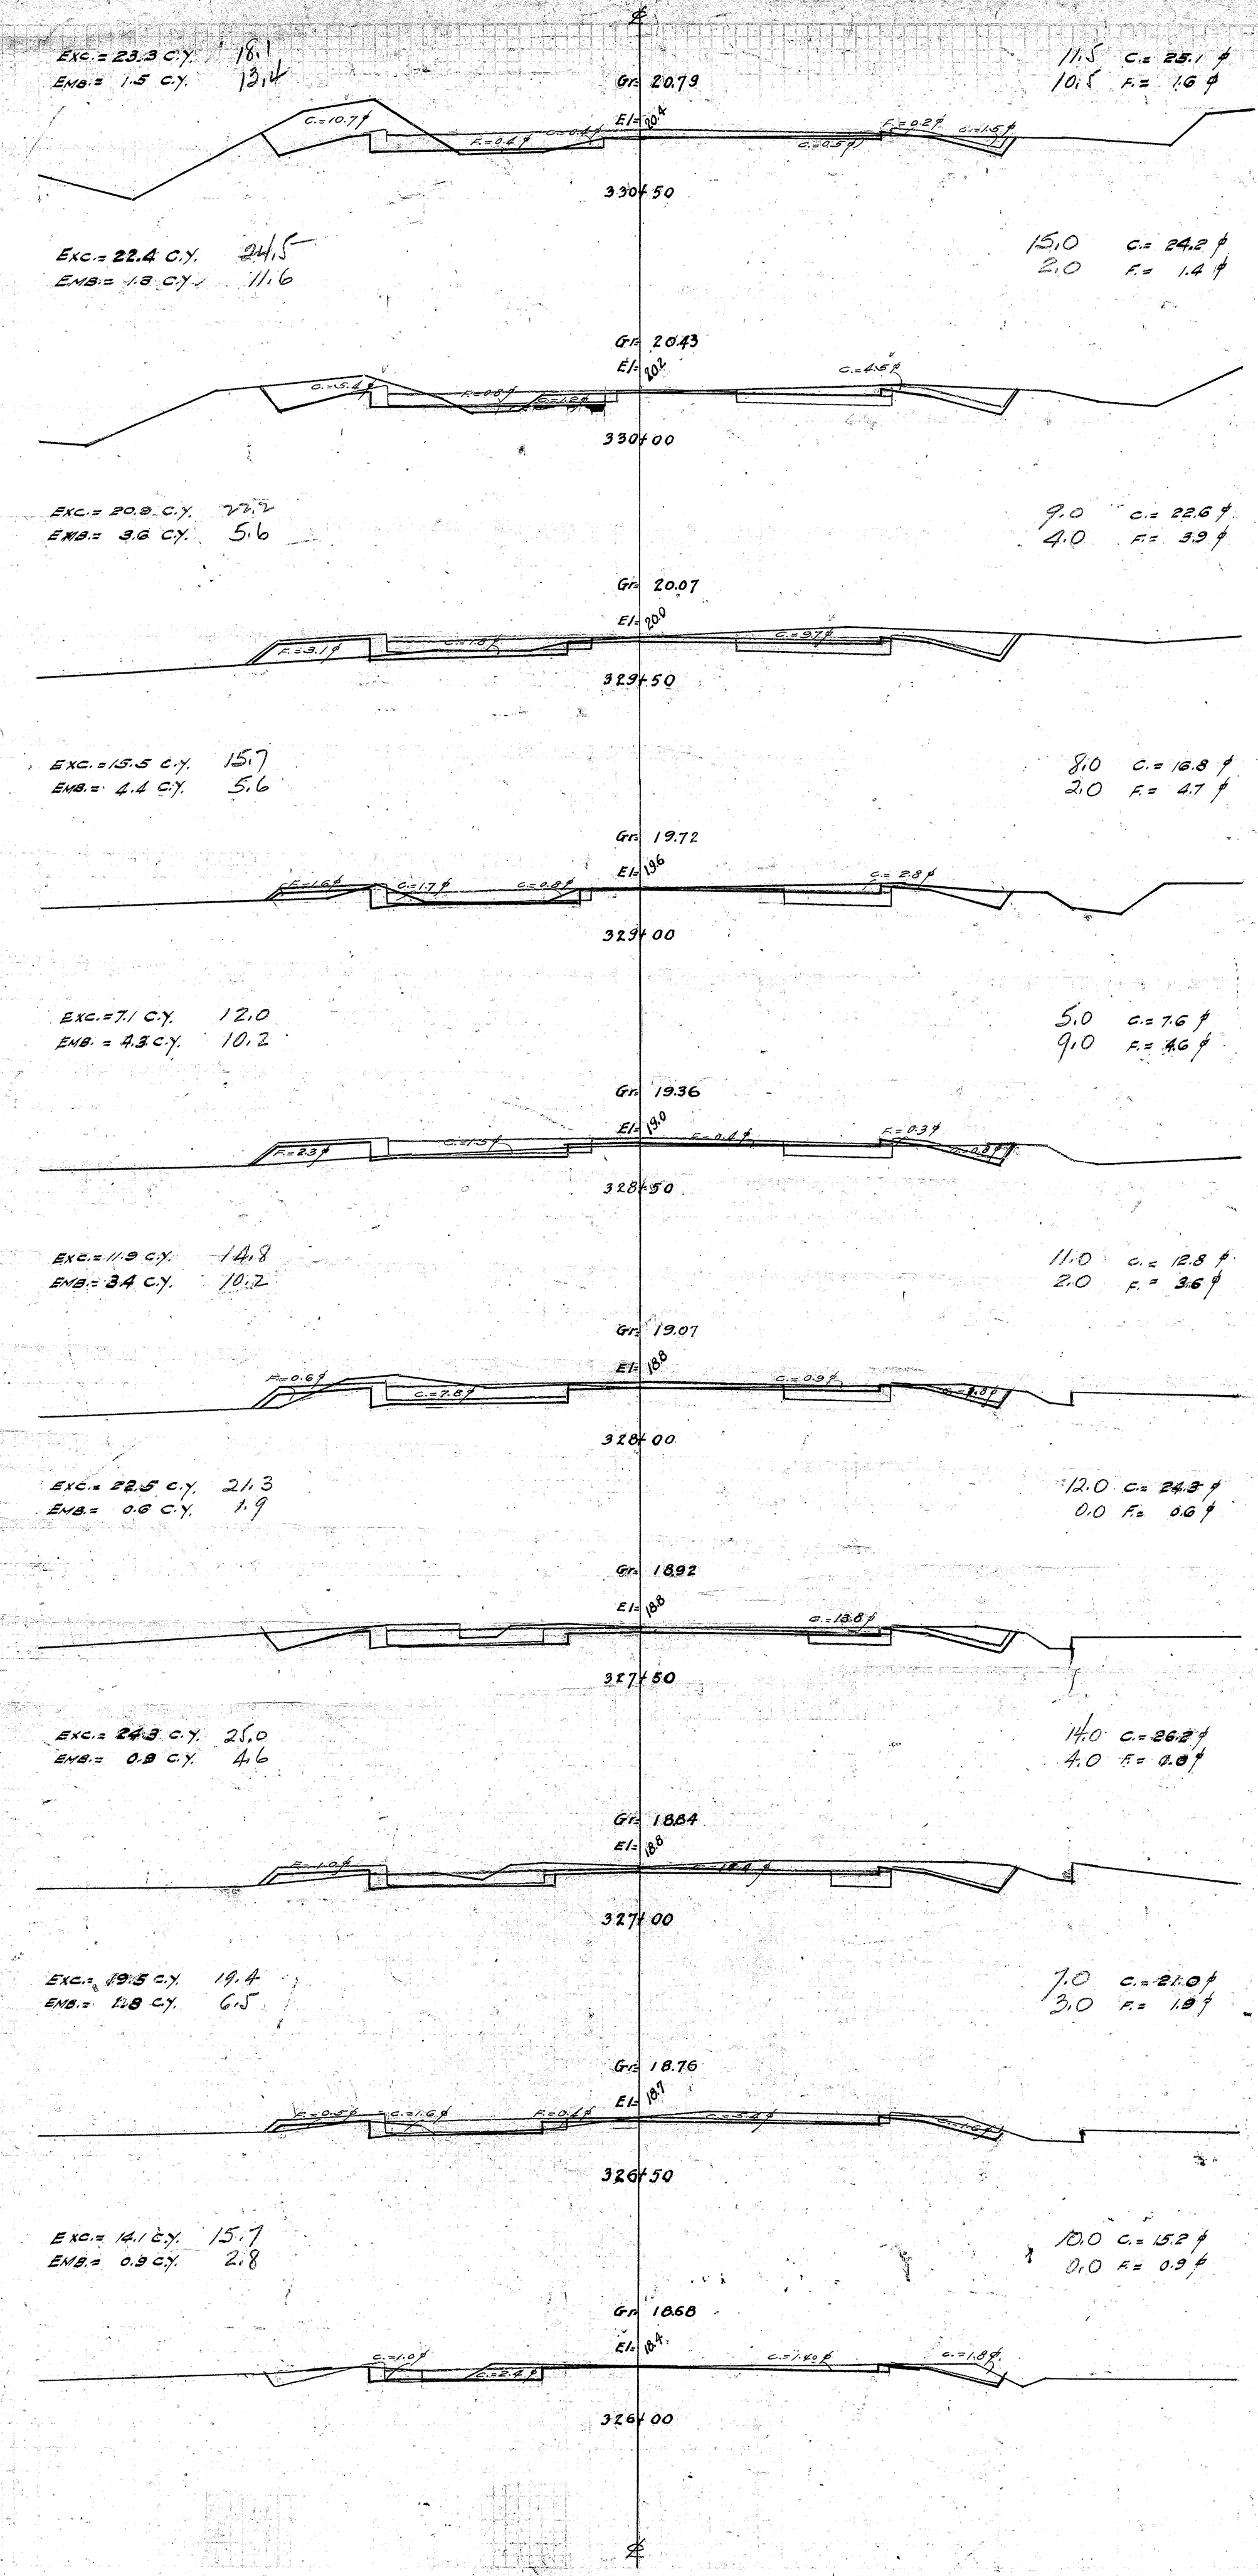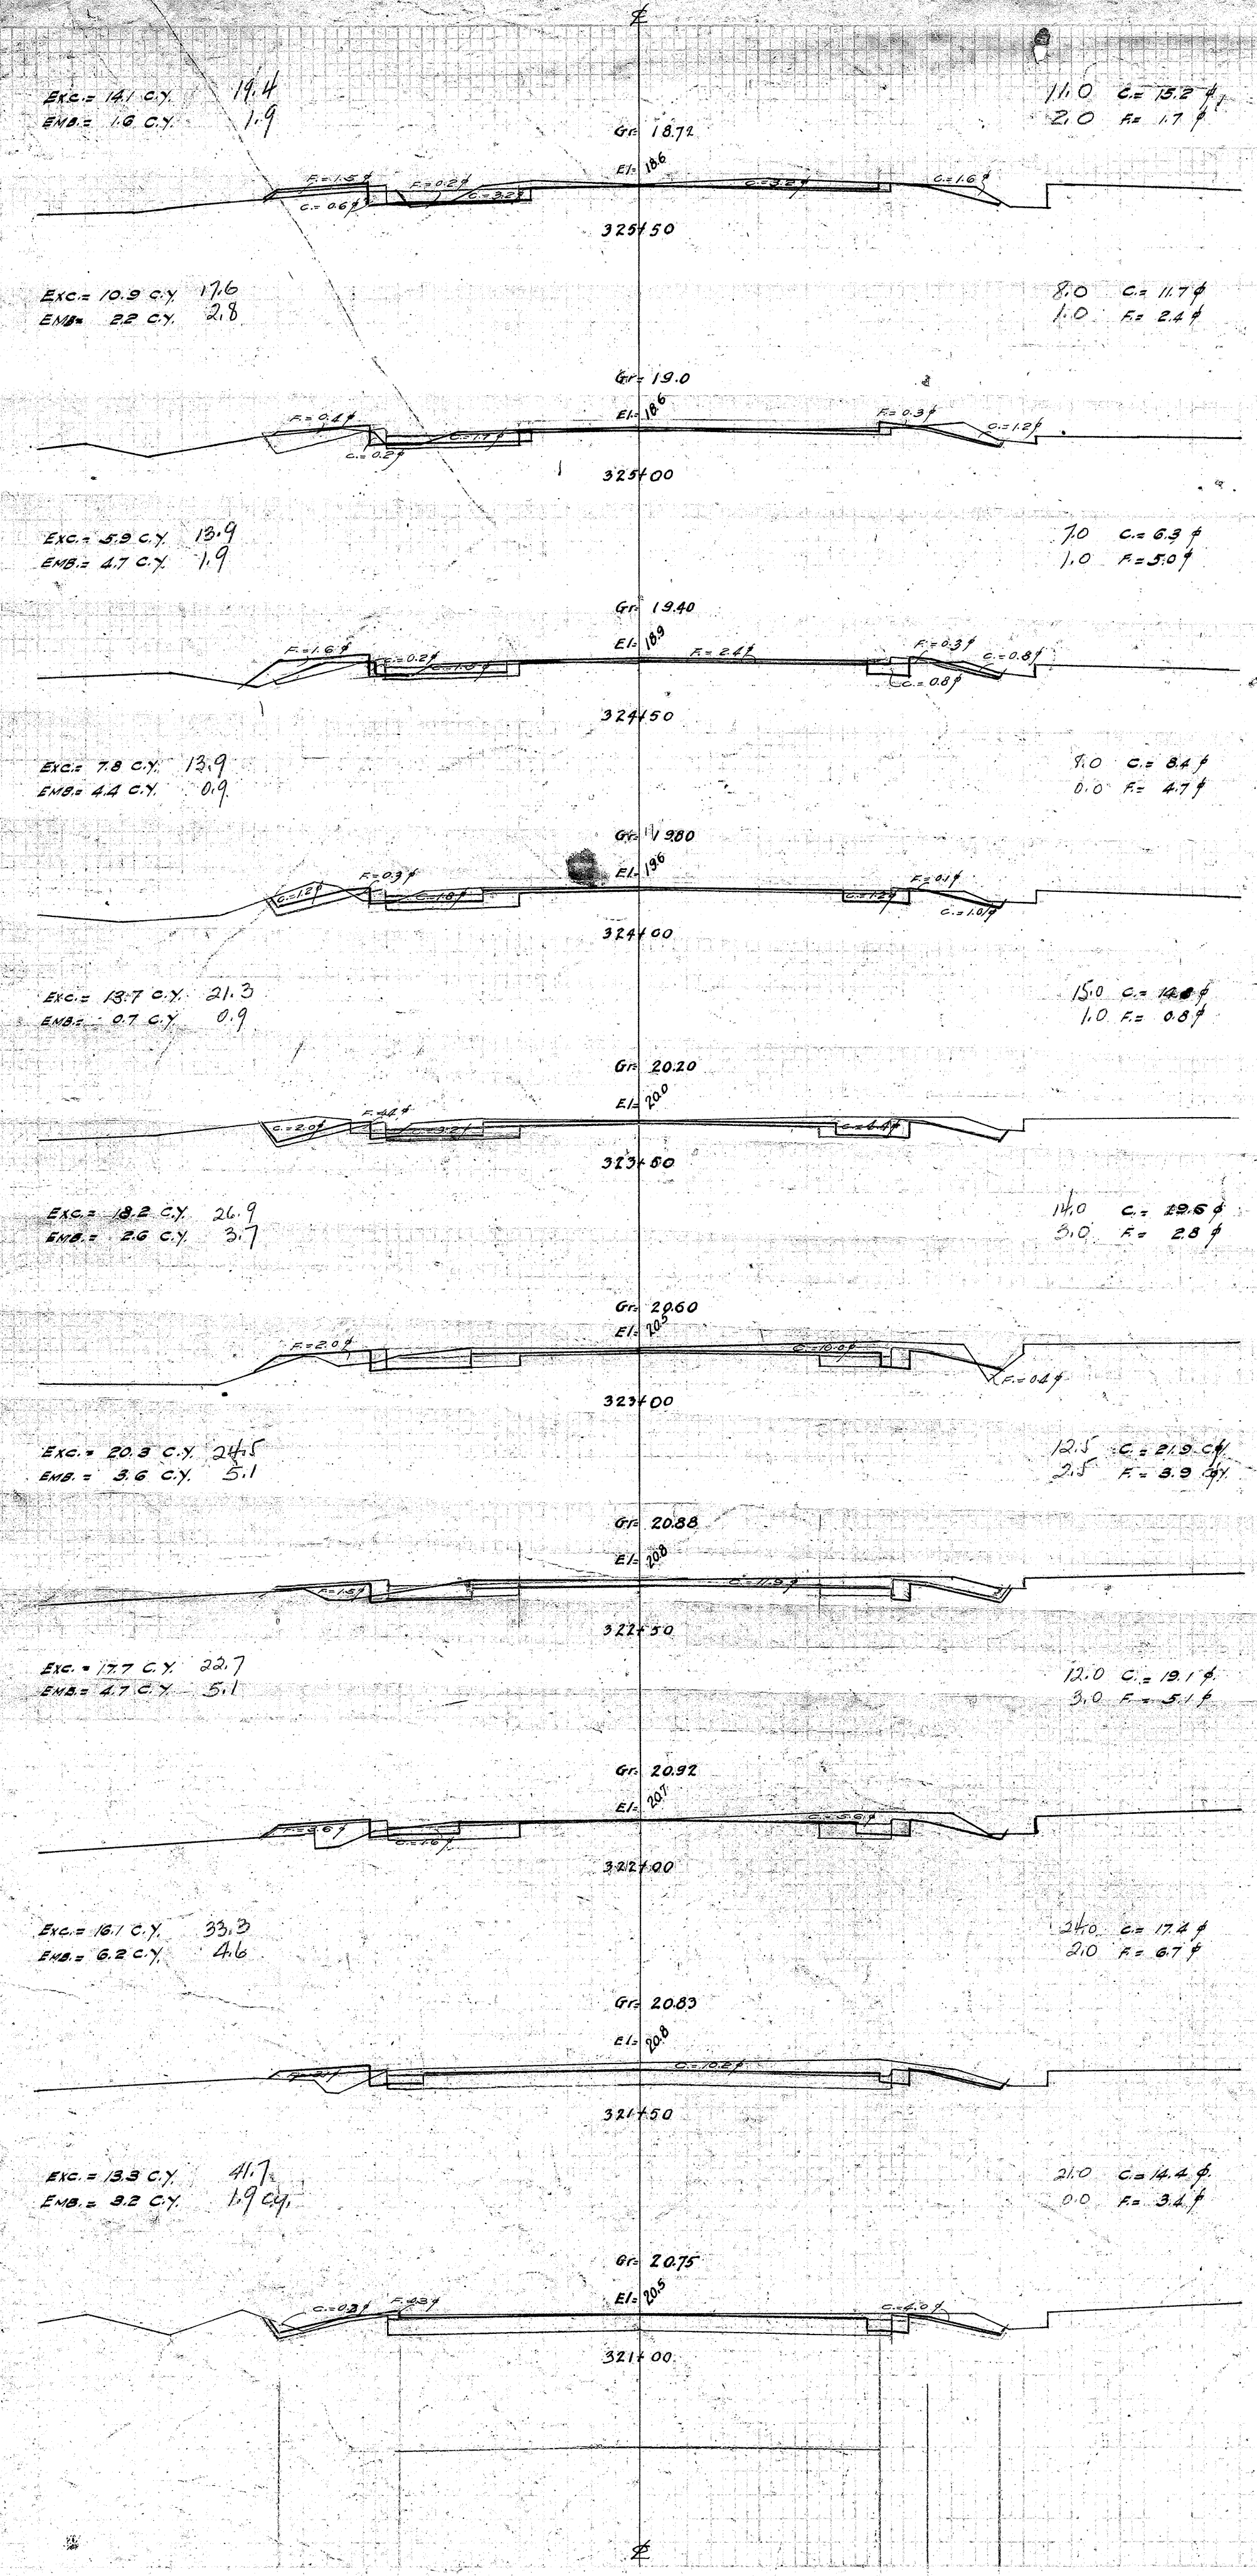

4178.10

SCALES
HORIZONTAL 1"=5'
VERTICAL 1"=5'




Plan	Profile	Section	Plan
No. 6	No. 17	No. 3	No.

H.K. Young C. & C. June 1930
H.K. Young & J. Zane



417 S. 11

FED. ROAD DIST. NO.	STATE	FISCAL YEAR	SHEET NO.	TOTAL SHEETS
HAWAII	HAWAII	1930	12	12

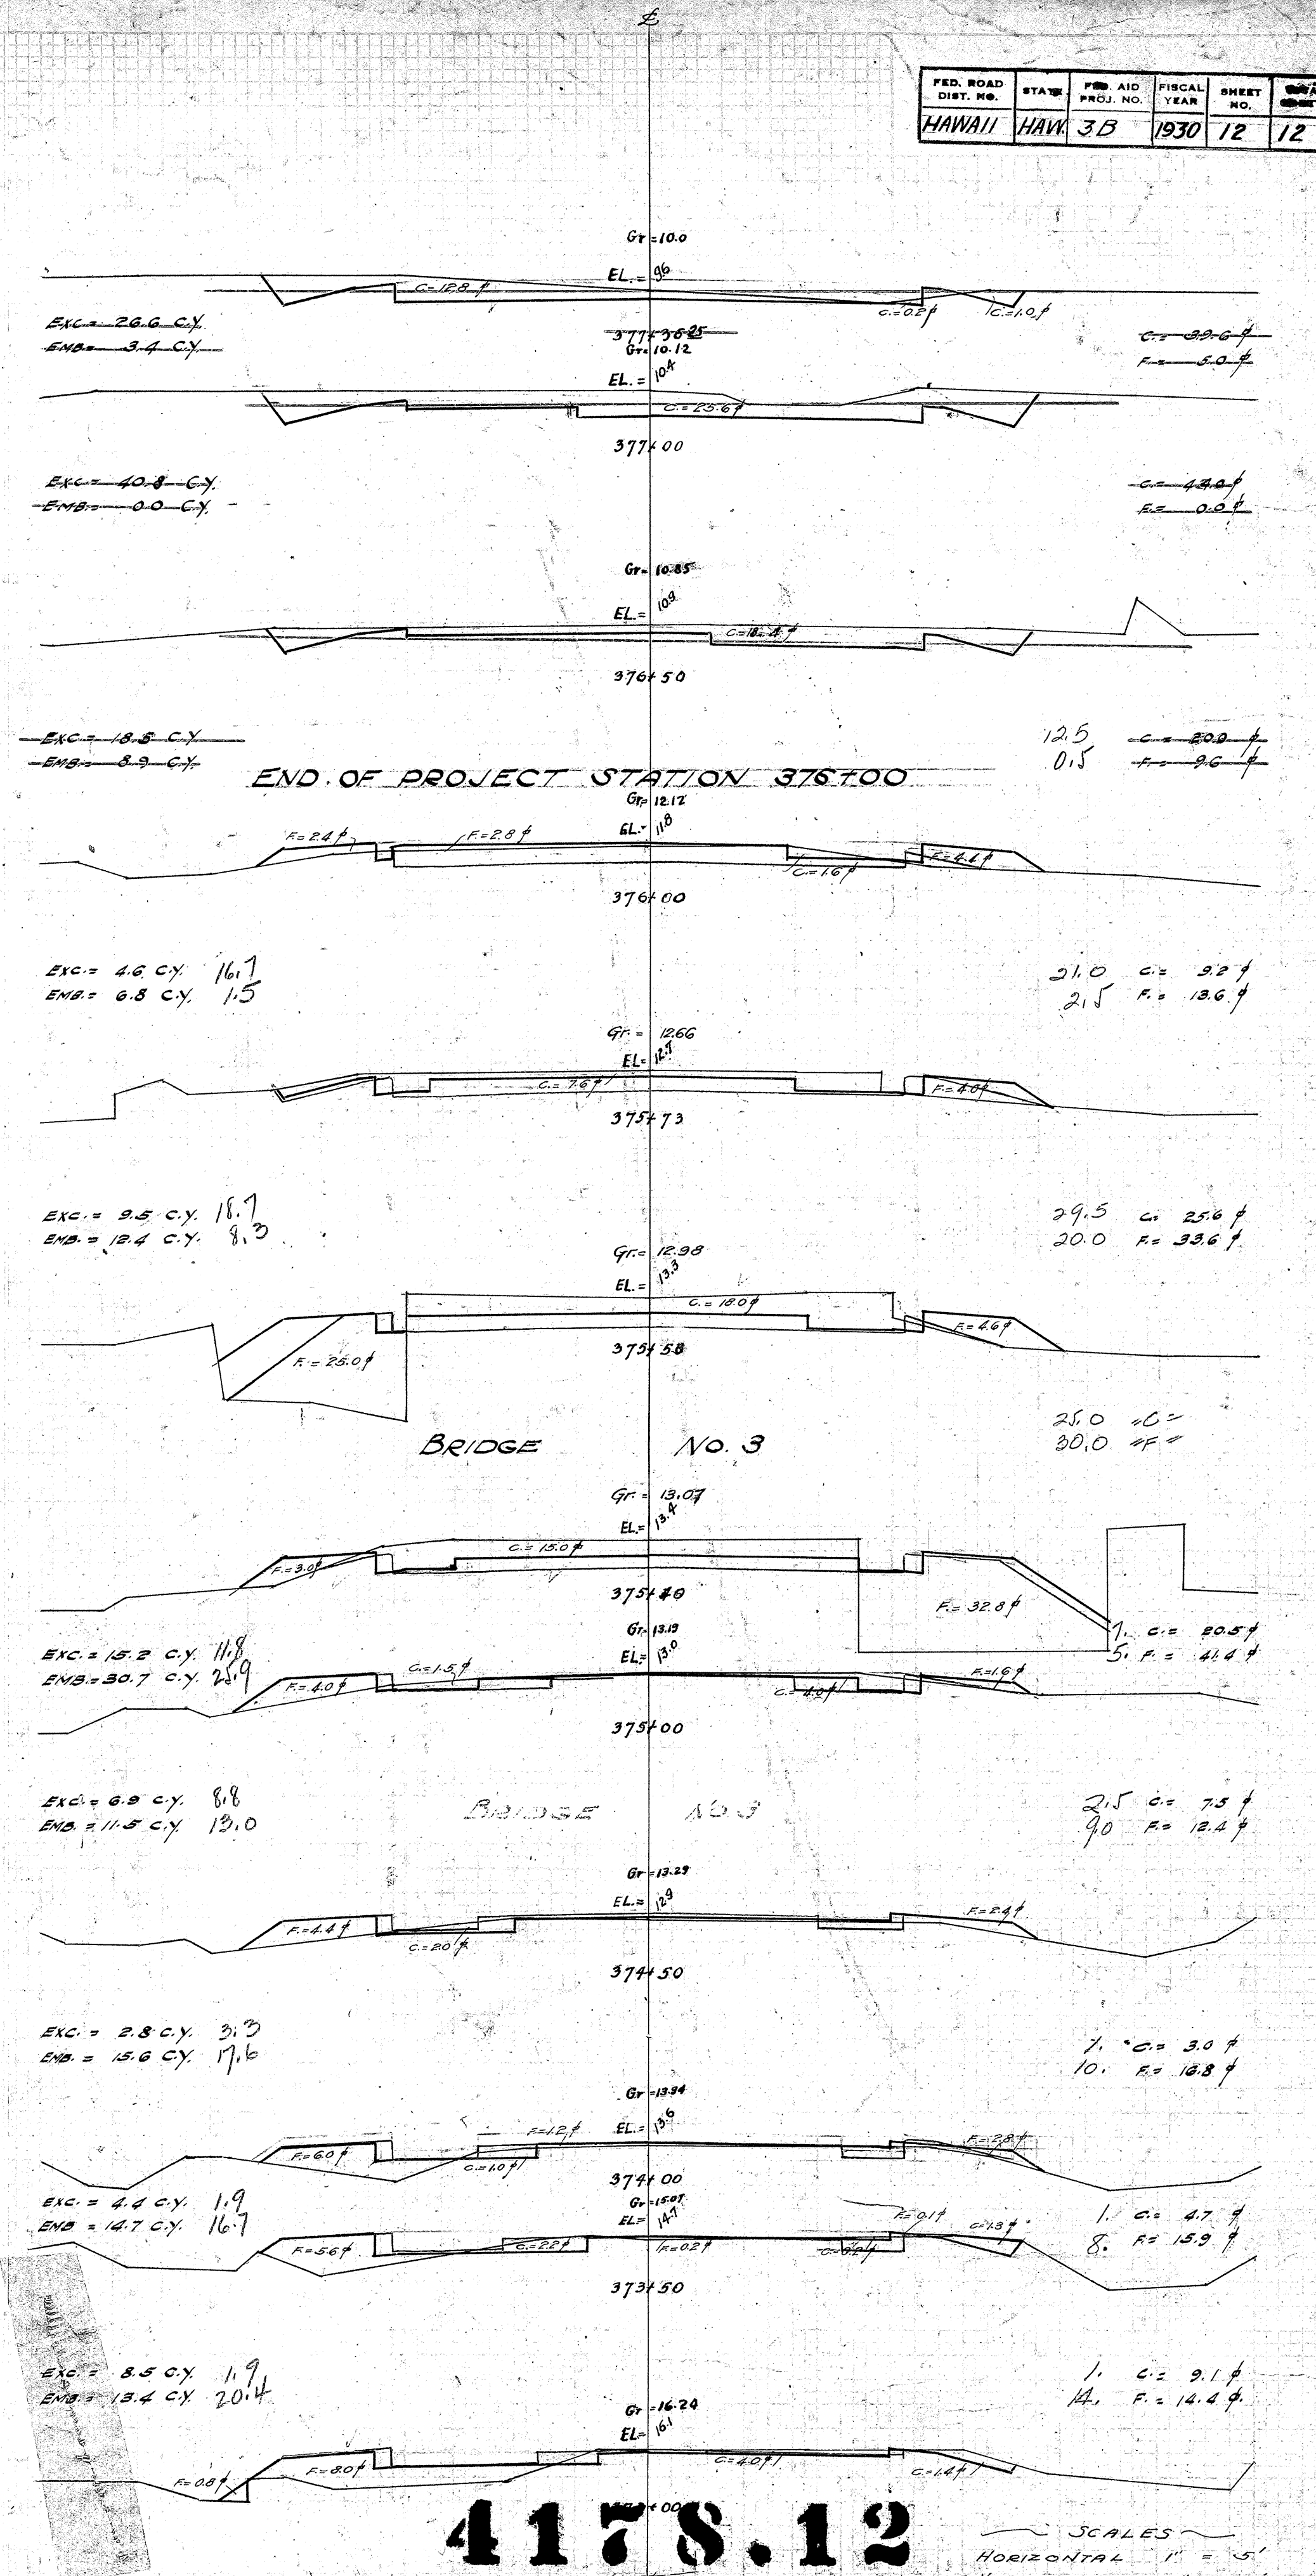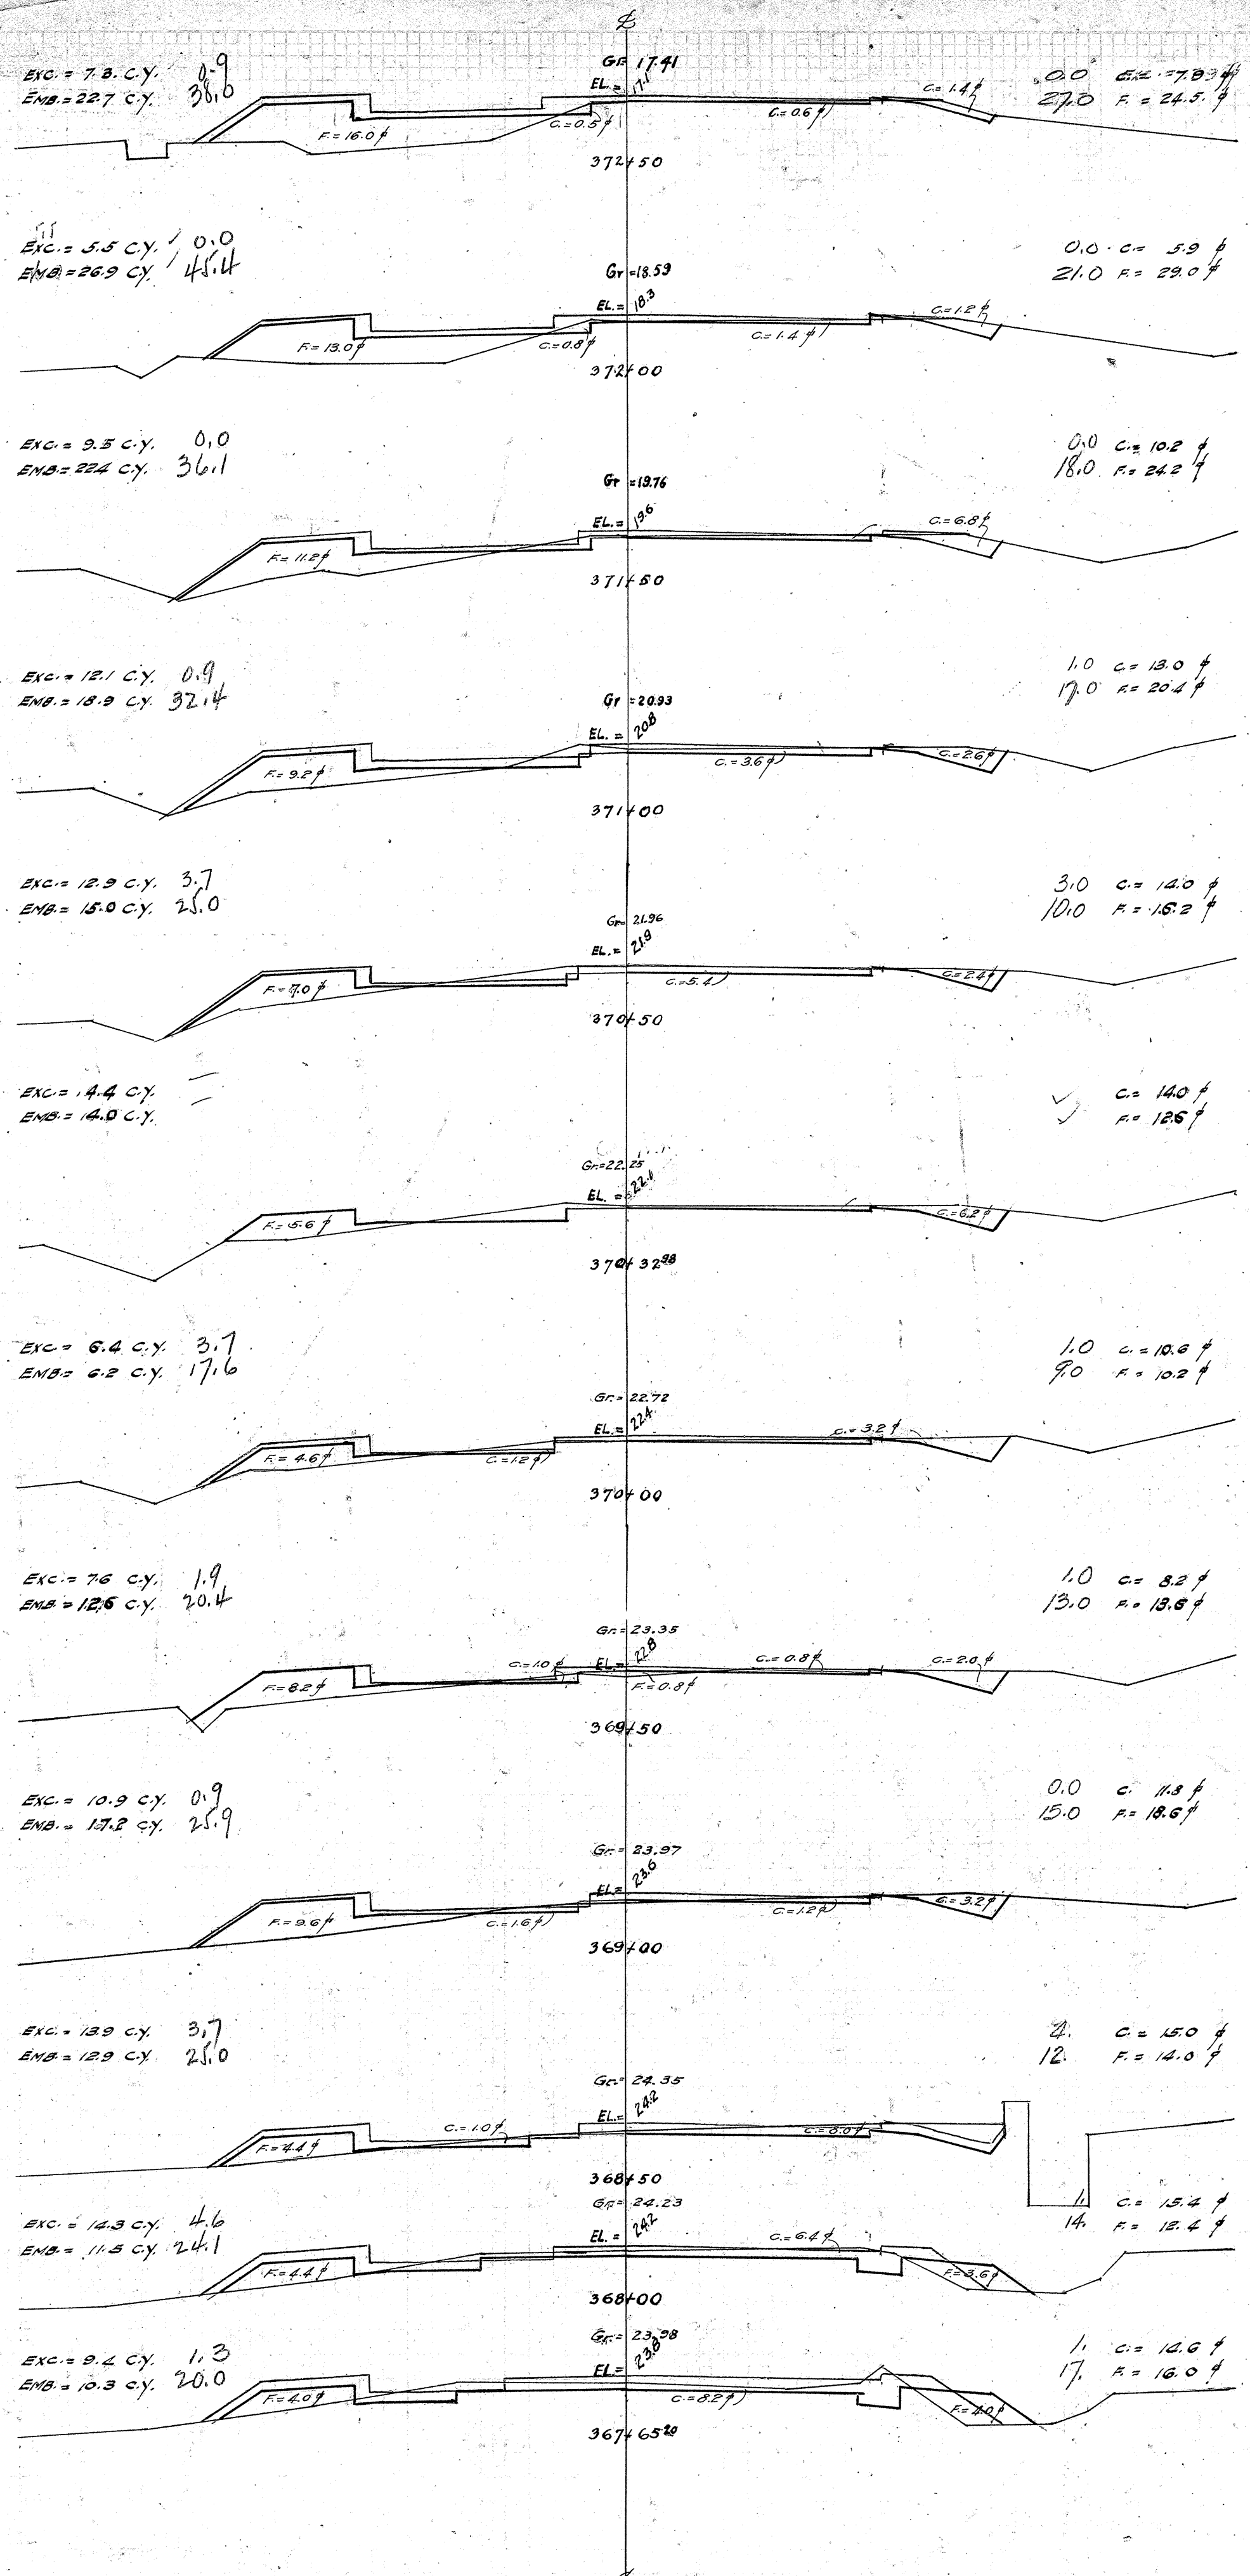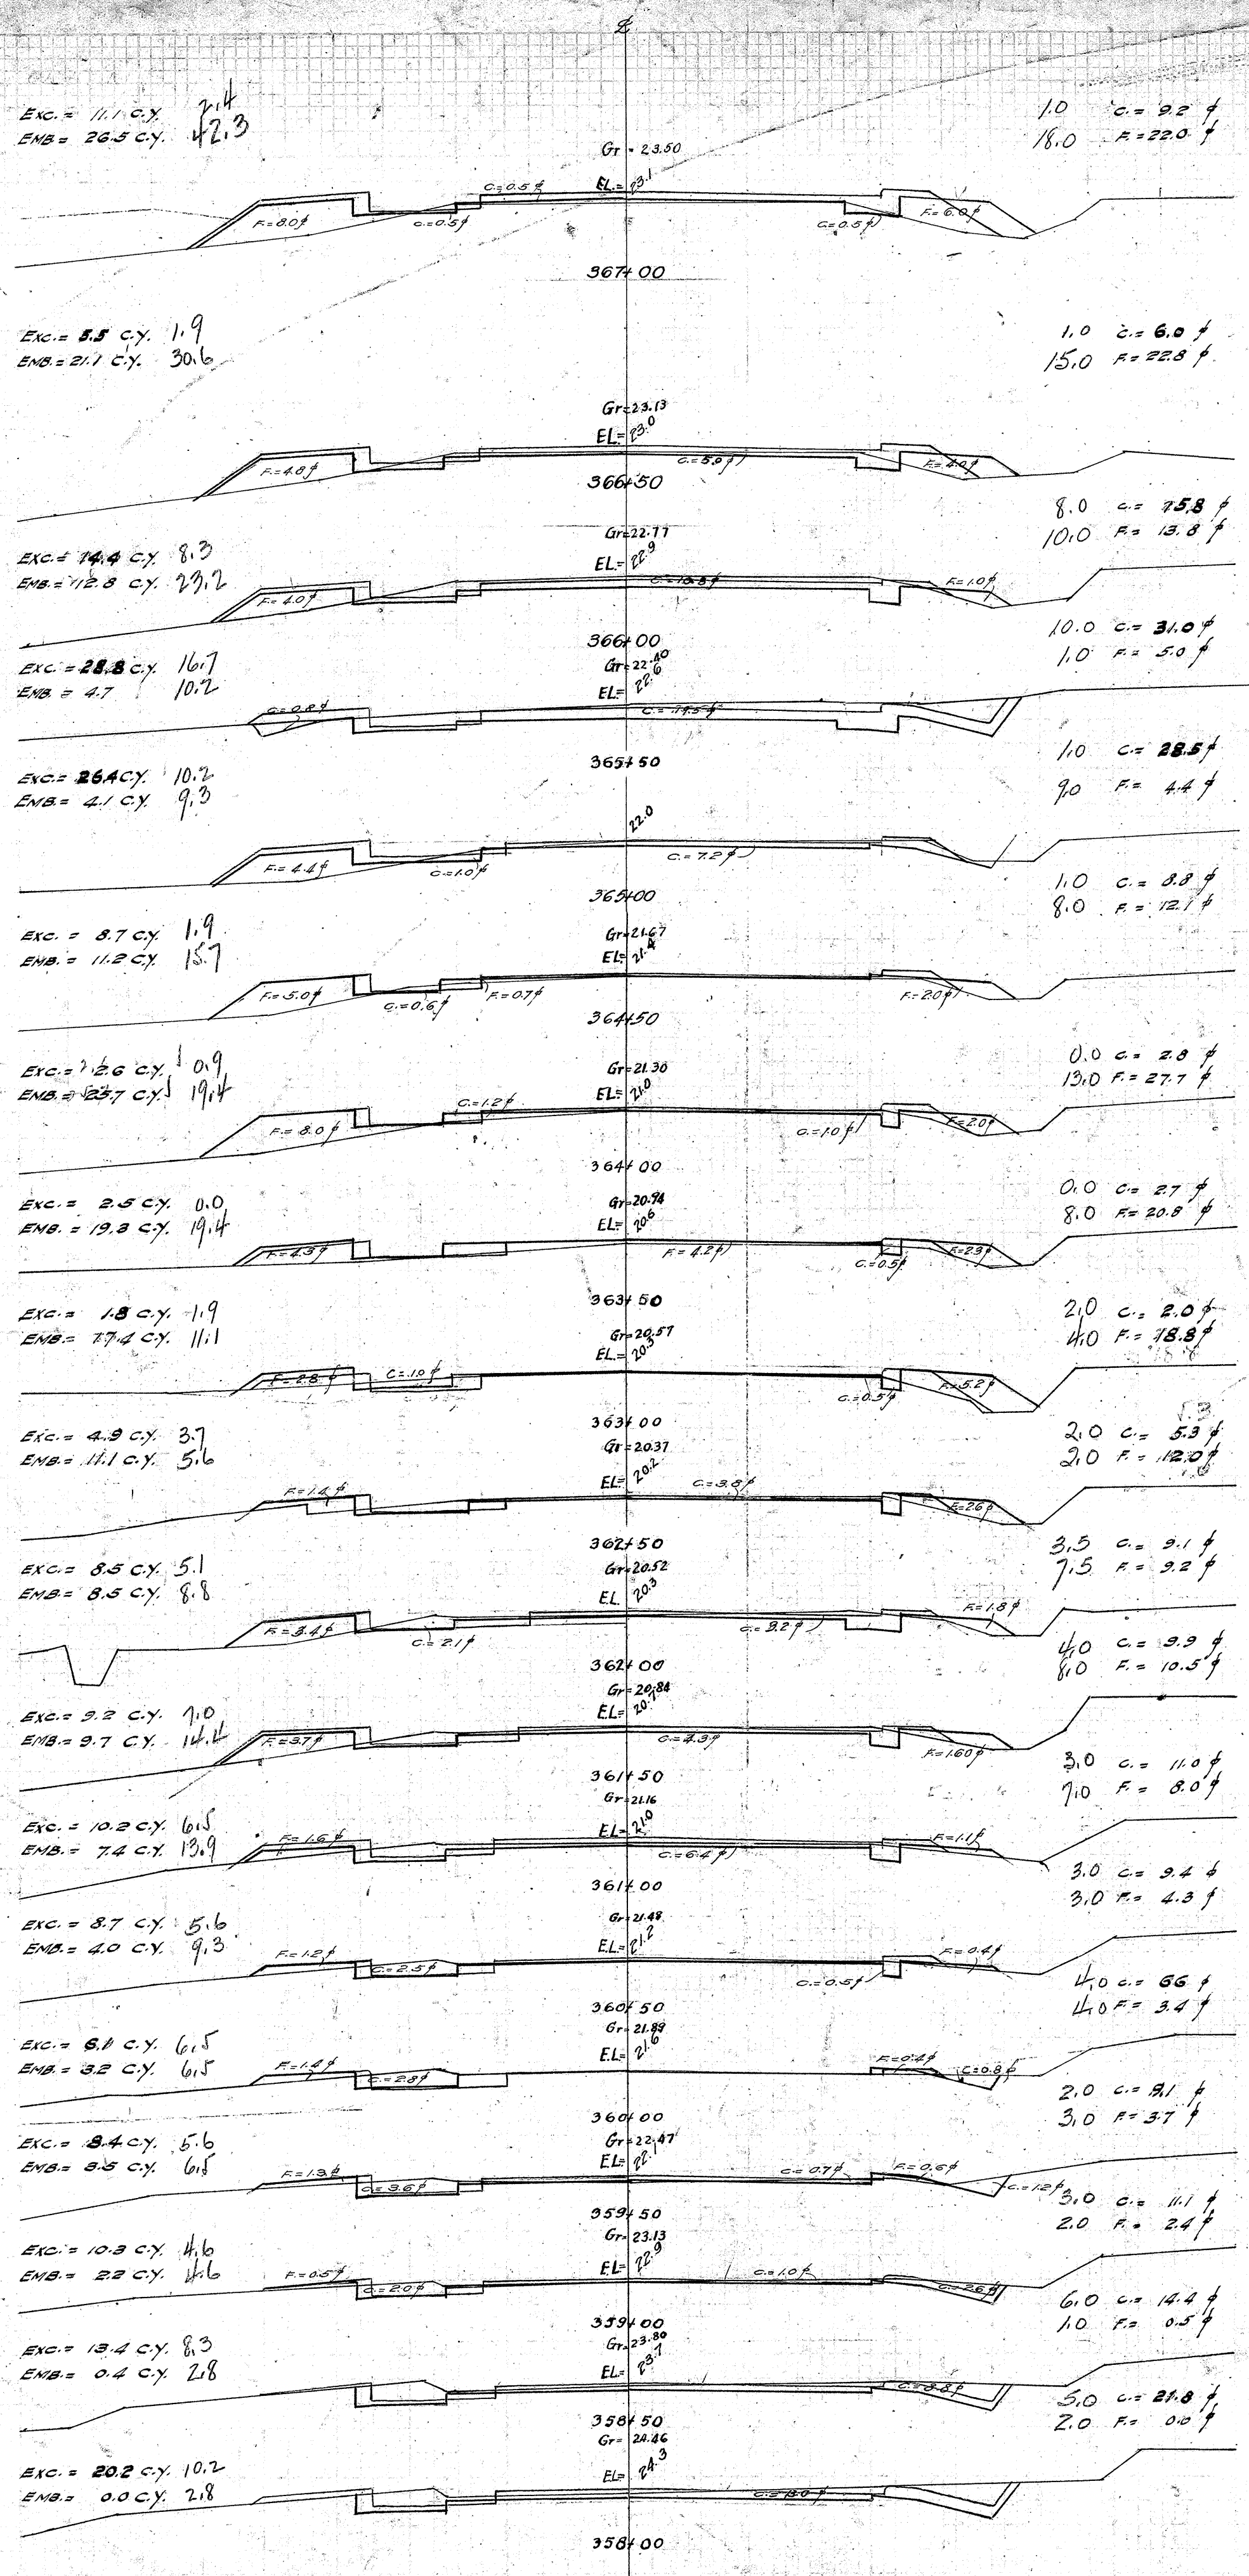

4178.12

Plan	Profile	Section	Sheet
No. 6	No. 17	No. 3	No. 12

SCALES
HORIZONTAL 1" = 5'
VERTICAL 1" = 5'