
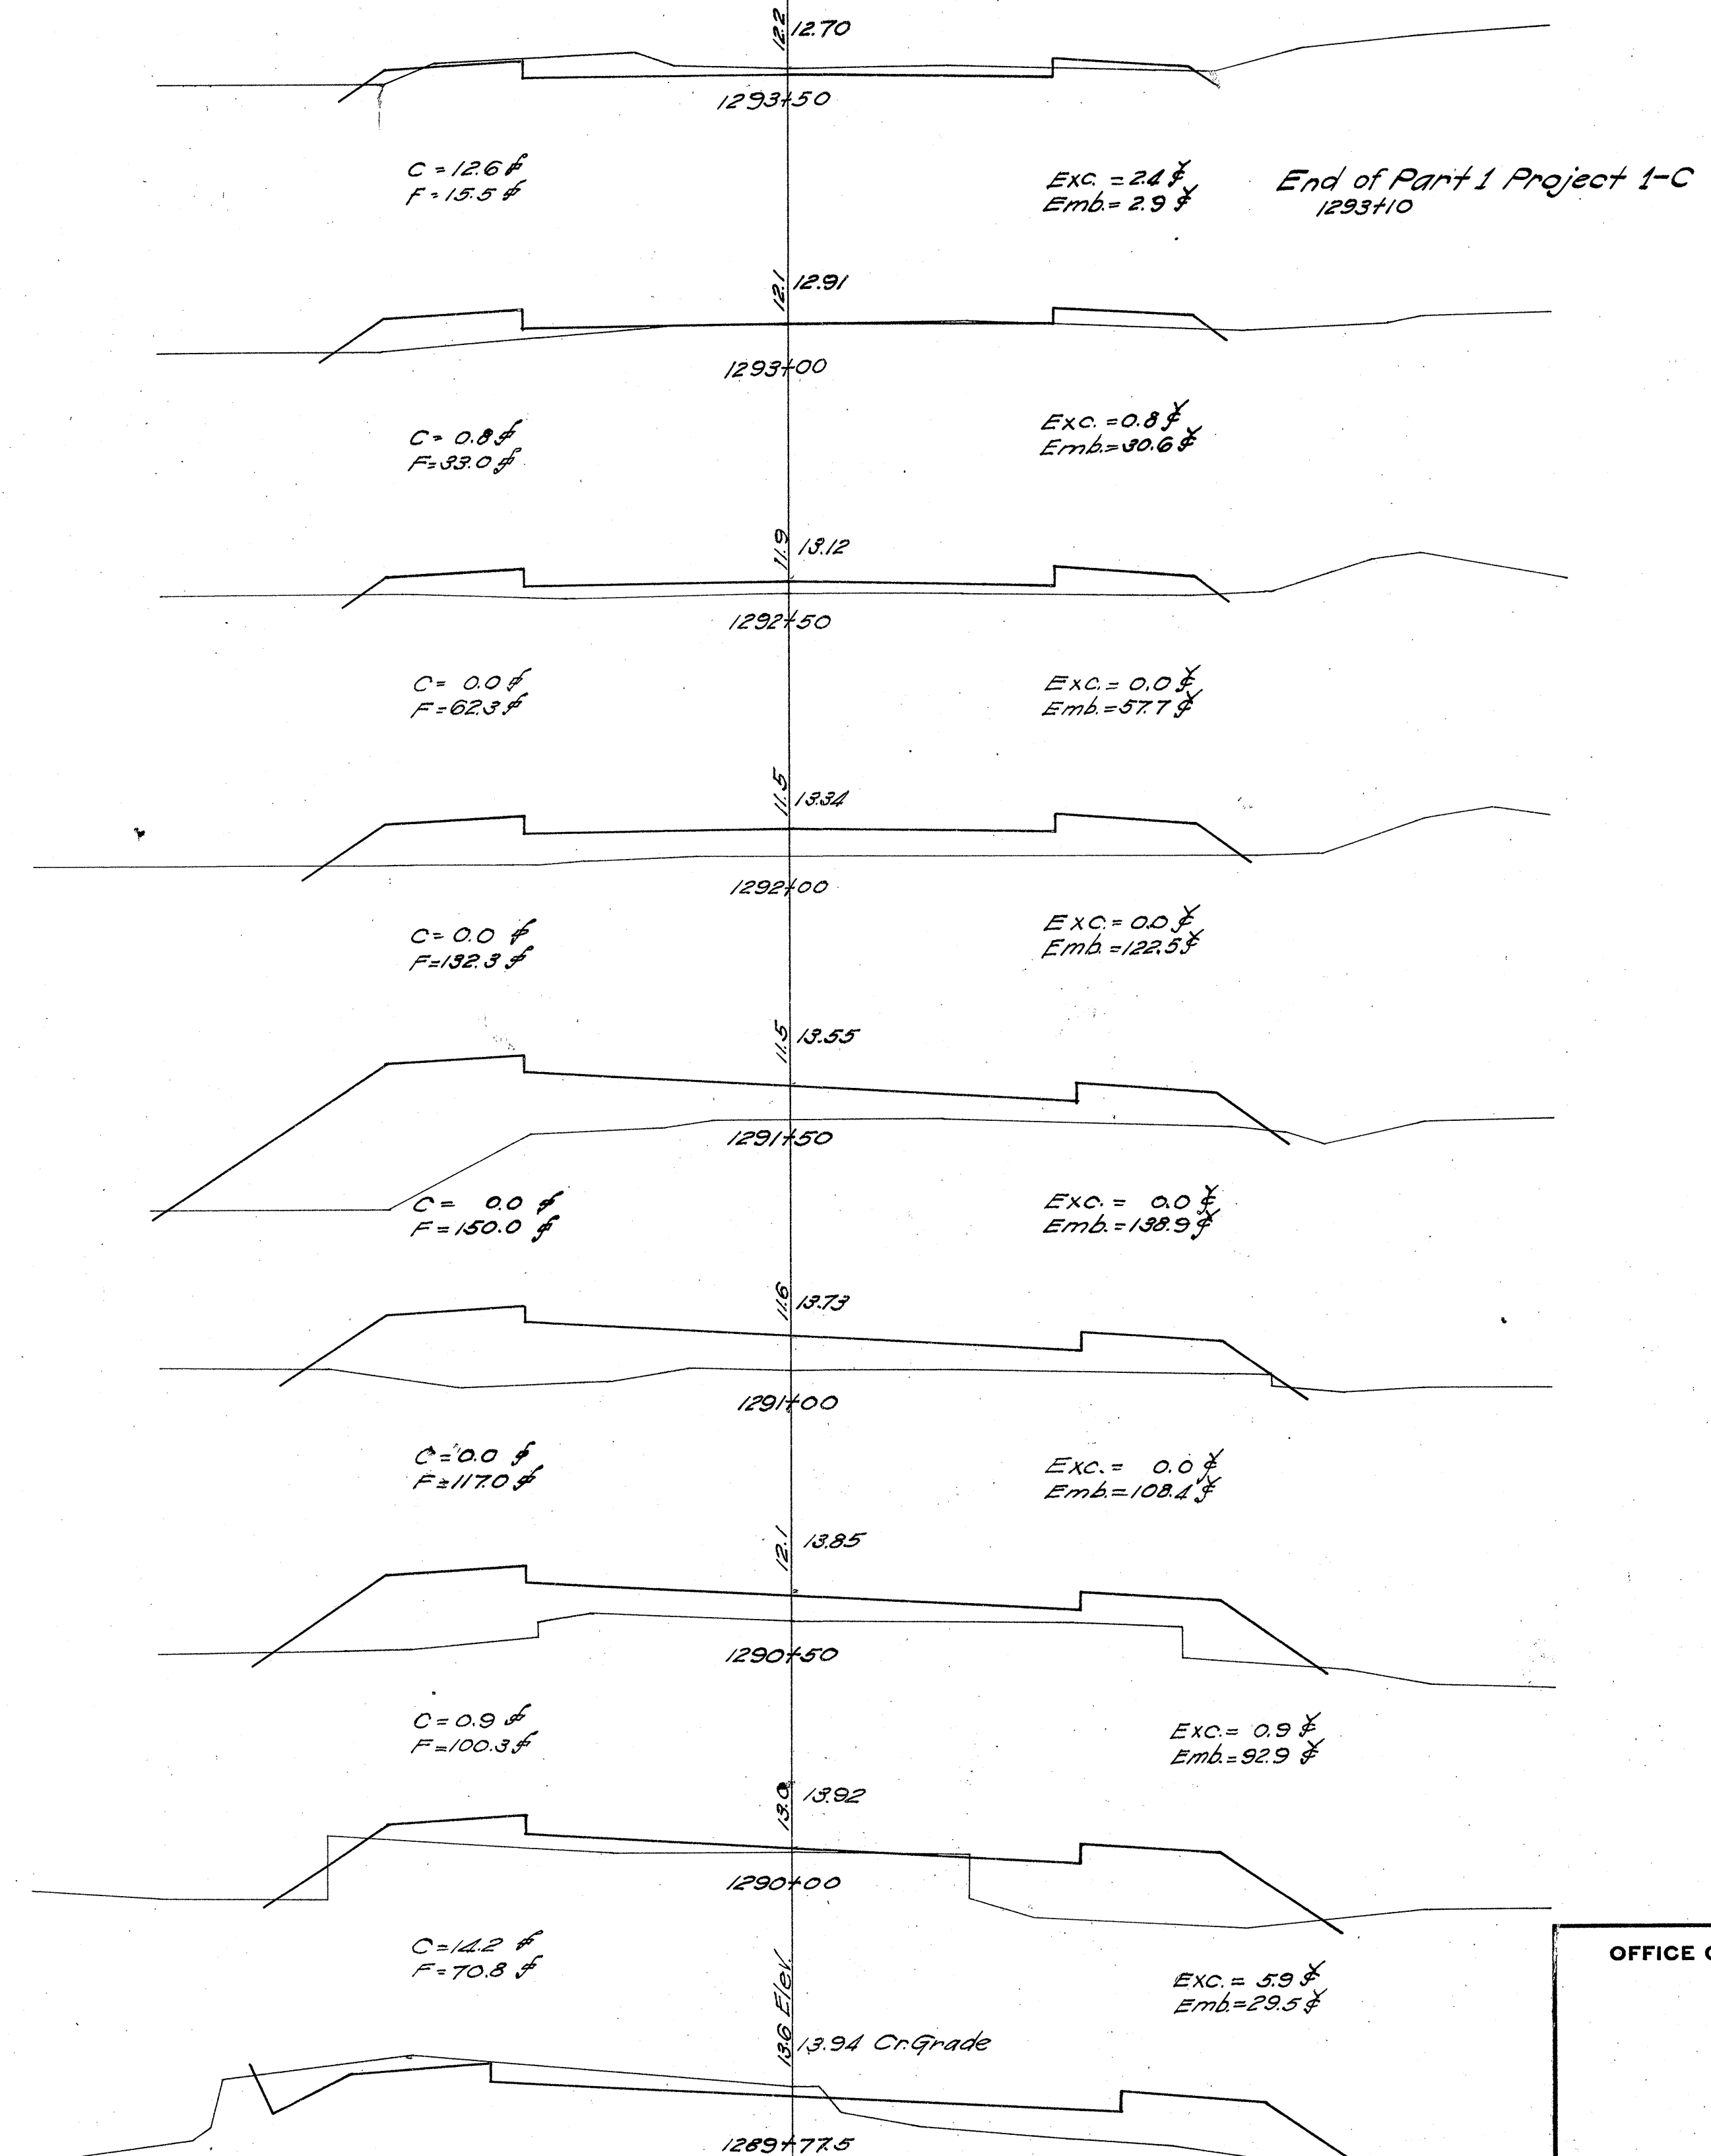


# BRIDGE SECTION

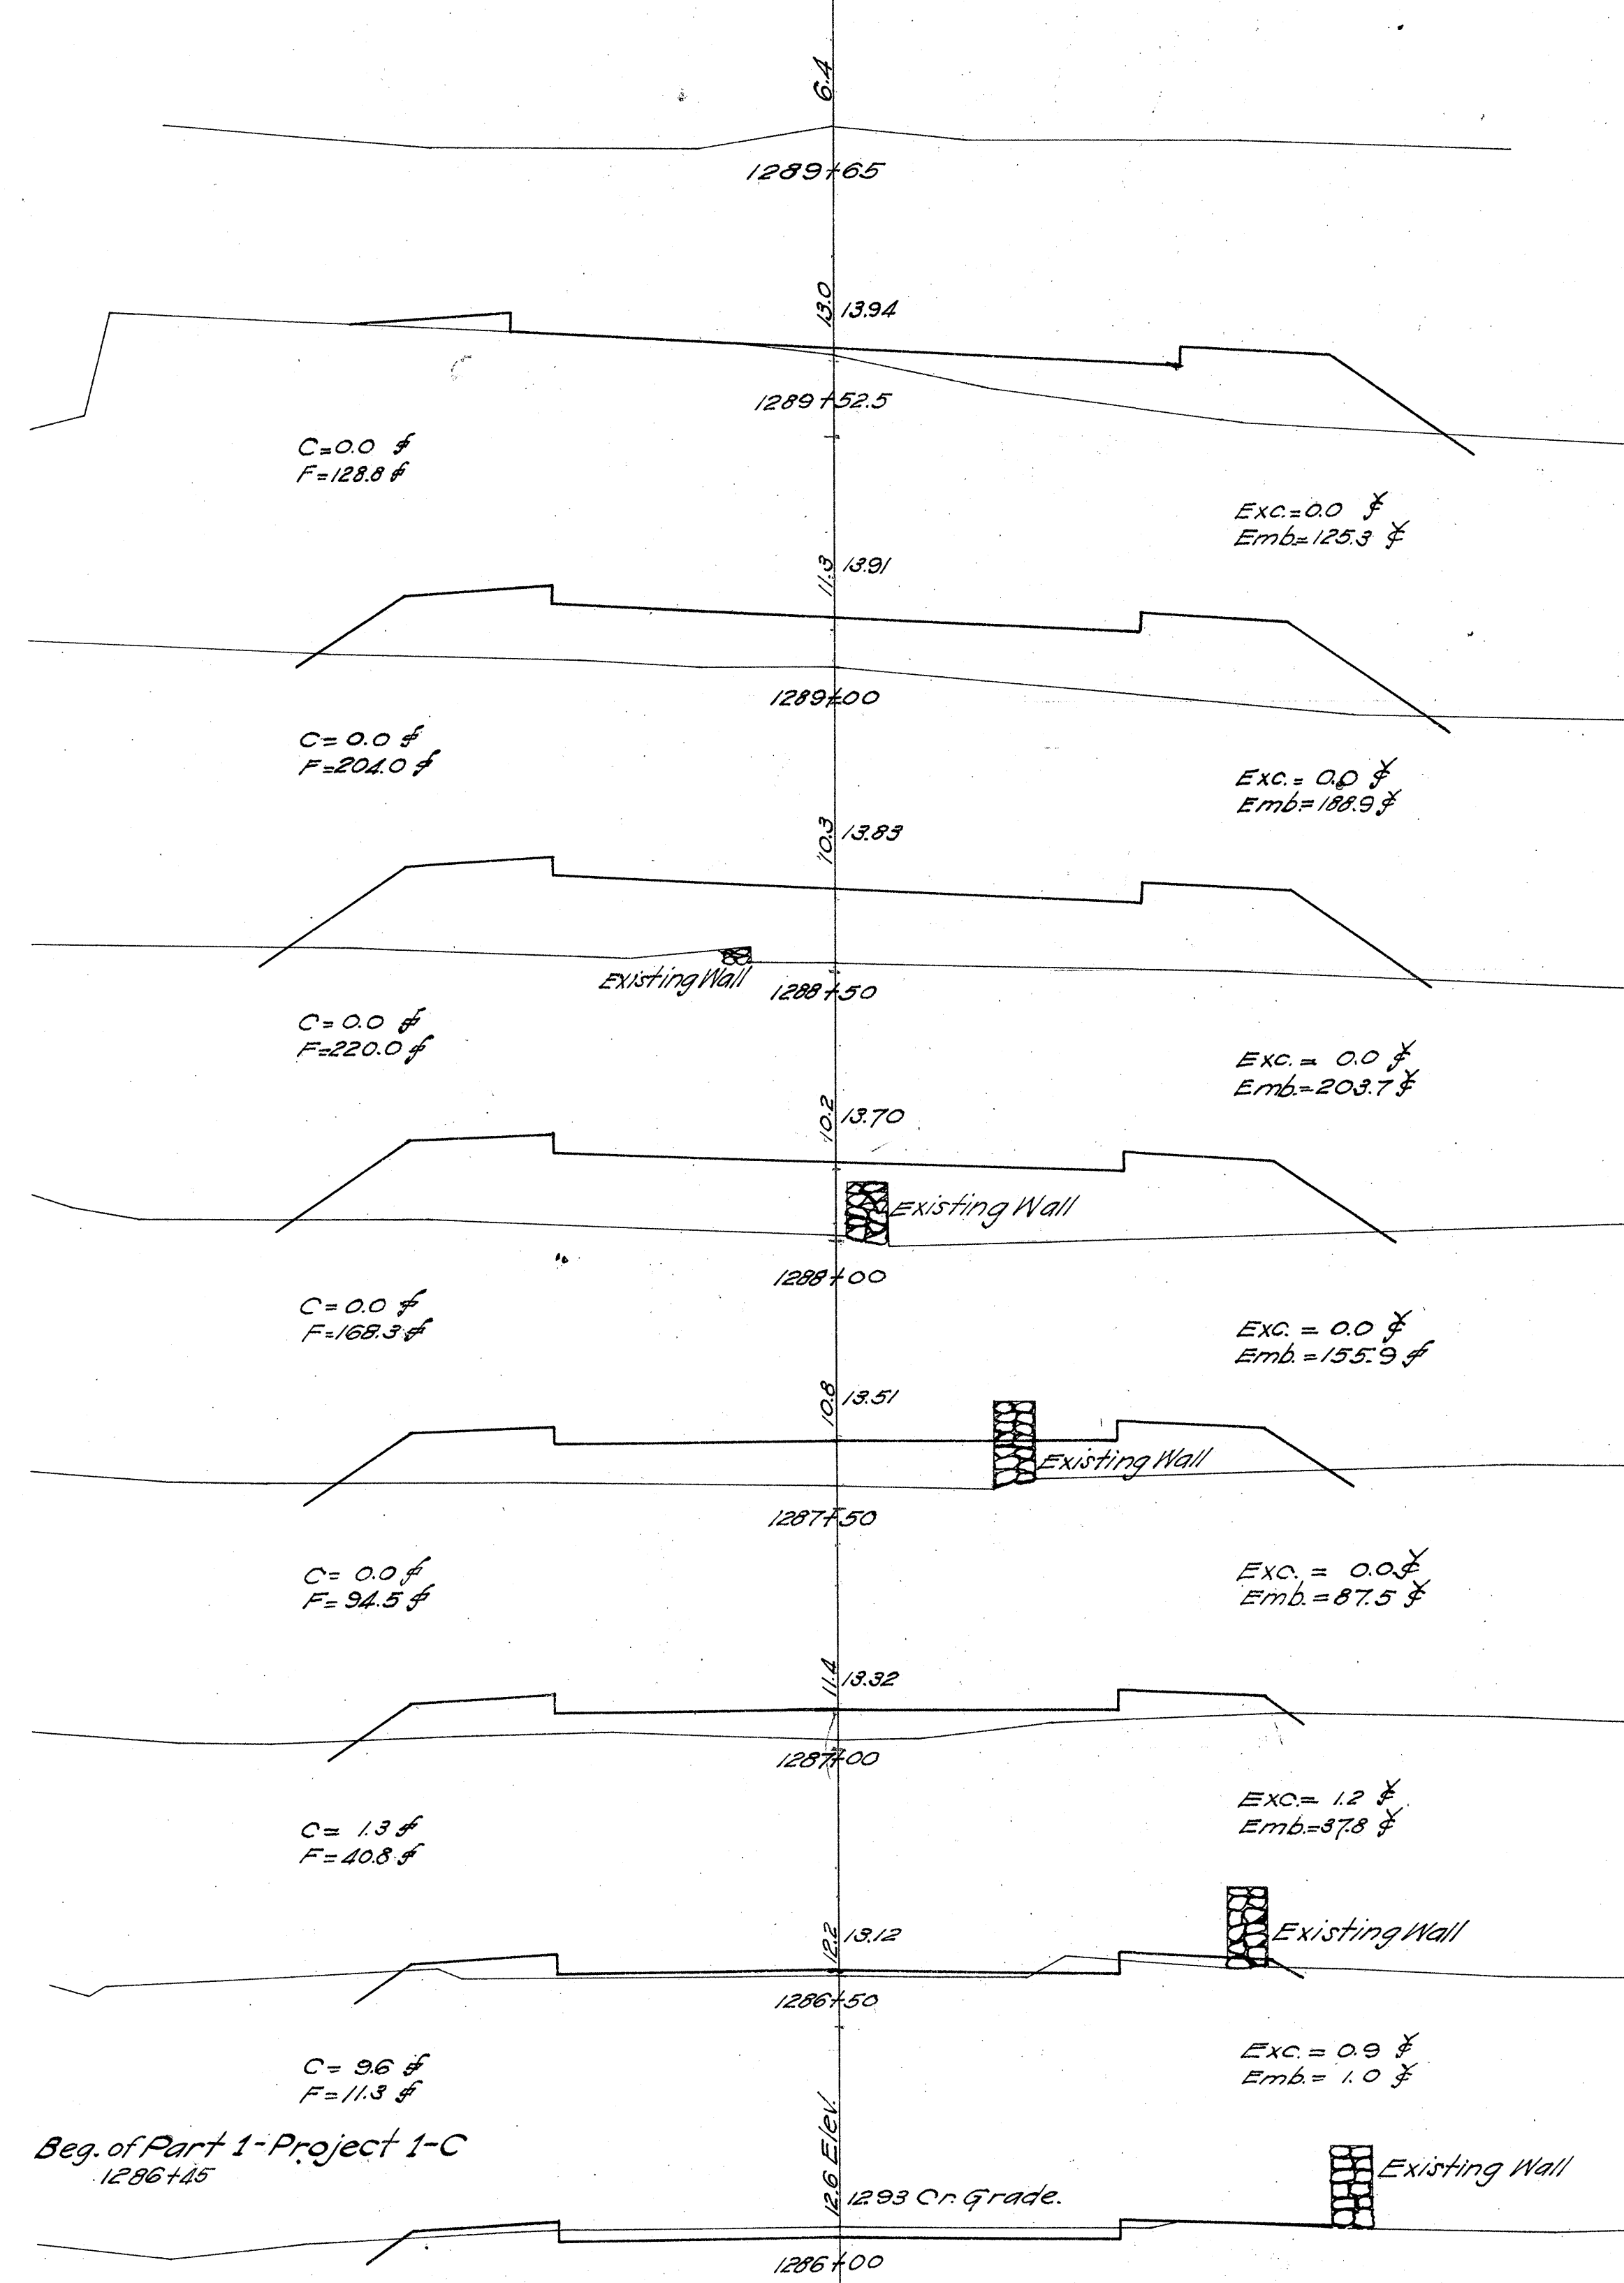

OFFICE OF THE CITY & COUNTY ENGINEER  
HONOLULU, HAWAII

ENGINEER \_\_\_\_\_ DATE \_\_\_\_\_  
DRAFTSMAN \_\_\_\_\_ CHECKED BY \_\_\_\_\_  
SCALE \_\_\_\_\_  
APPROVED: \_\_\_\_\_ CITY & COUNTY ENGINEER

4236.13



|               |          |      |
|---------------|----------|------|
| FINAL         | SURVEYED | DATE |
| SURVEY        | PLANNED  |      |
| NOTE BOOK     | NO. 1    |      |
| AREAS CHECKED |          |      |

|               |          |      |
|---------------|----------|------|
| ORIGINAL      | SURVEYED | DATE |
| SURVEY        | PLANNED  |      |
| NOTE BOOK     | NO. 1    |      |
| AREAS CHECKED |          |      |

| FED. ROAD DIST. NO. | STATE | FED. AID PROJ. NO. | FISCAL YEAR | SHEET NO. | TOTAL SHEETS |
|---------------------|-------|--------------------|-------------|-----------|--------------|
| HAWAII              | HAW   | 1 C                | 1937        | 14        | 15           |

END OF PART 2-PROJECT 1C  
STA 1383+00

BEG. OF PART 2-PROJECT 1-C  
STA 1375+50

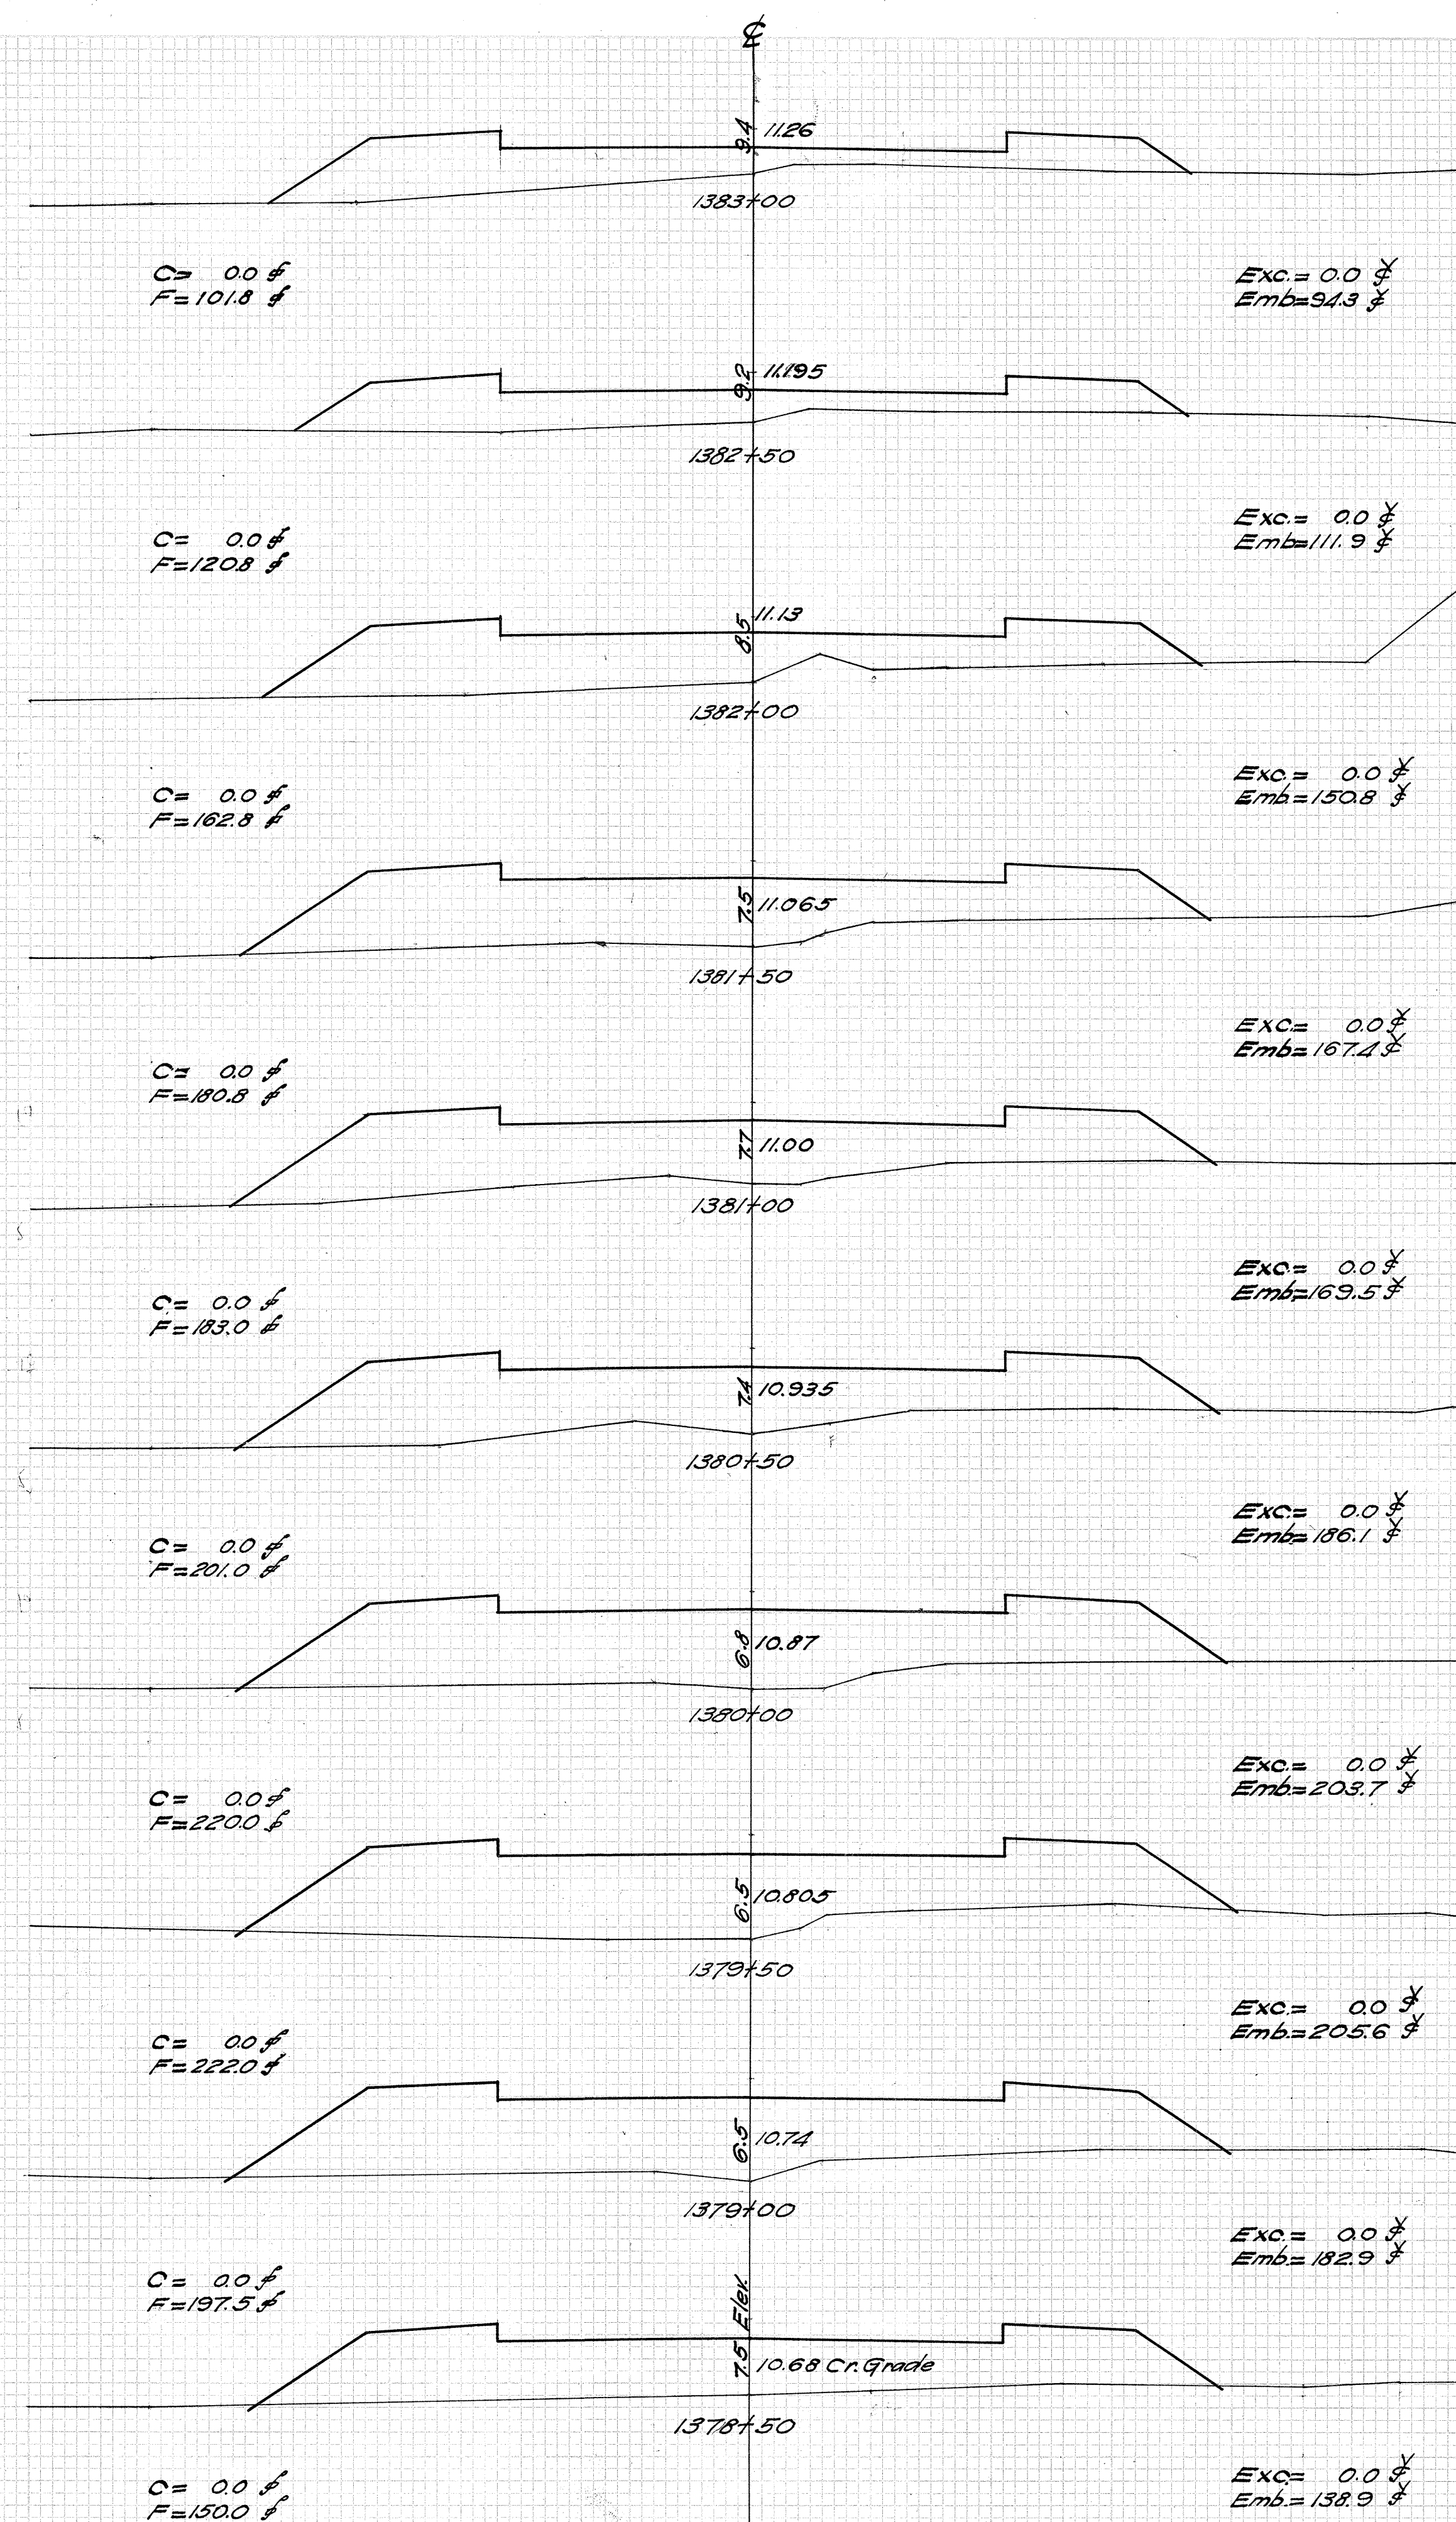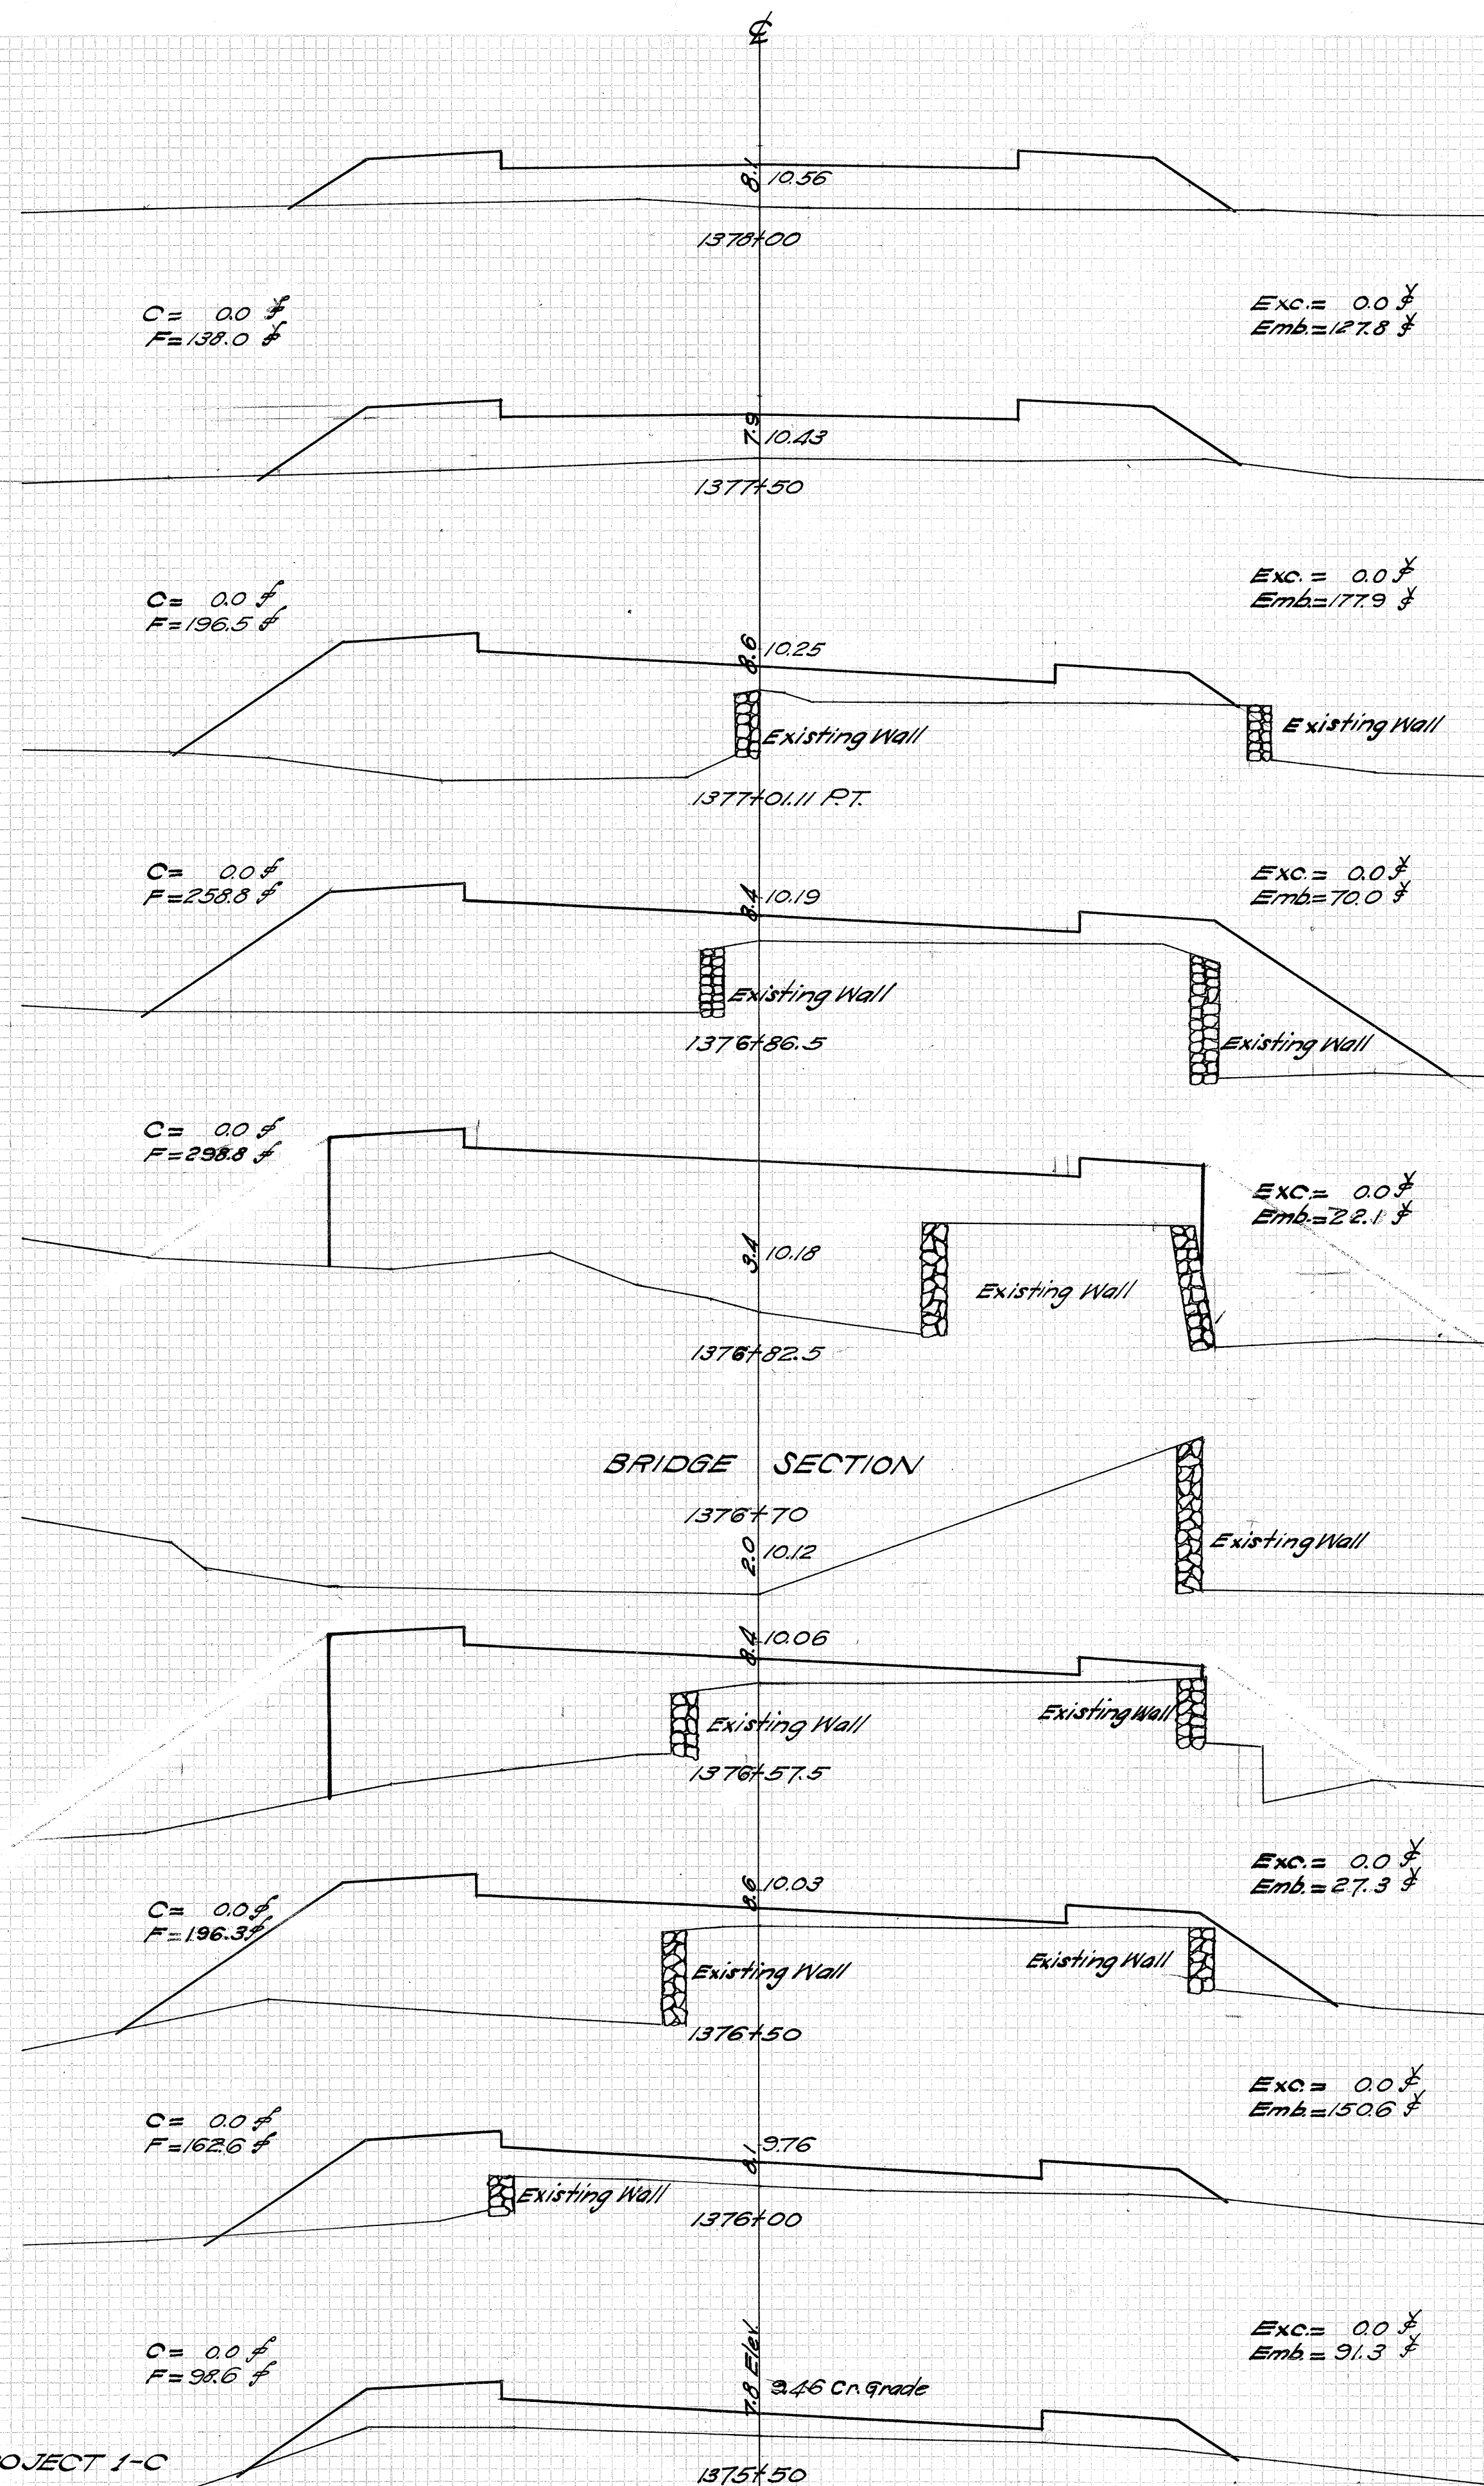

4236.14

FINAL SURVEY  
NOTE BOOK  
NO.

ORIGINAL SURVEY  
NOTE BOOK  
NO.

