

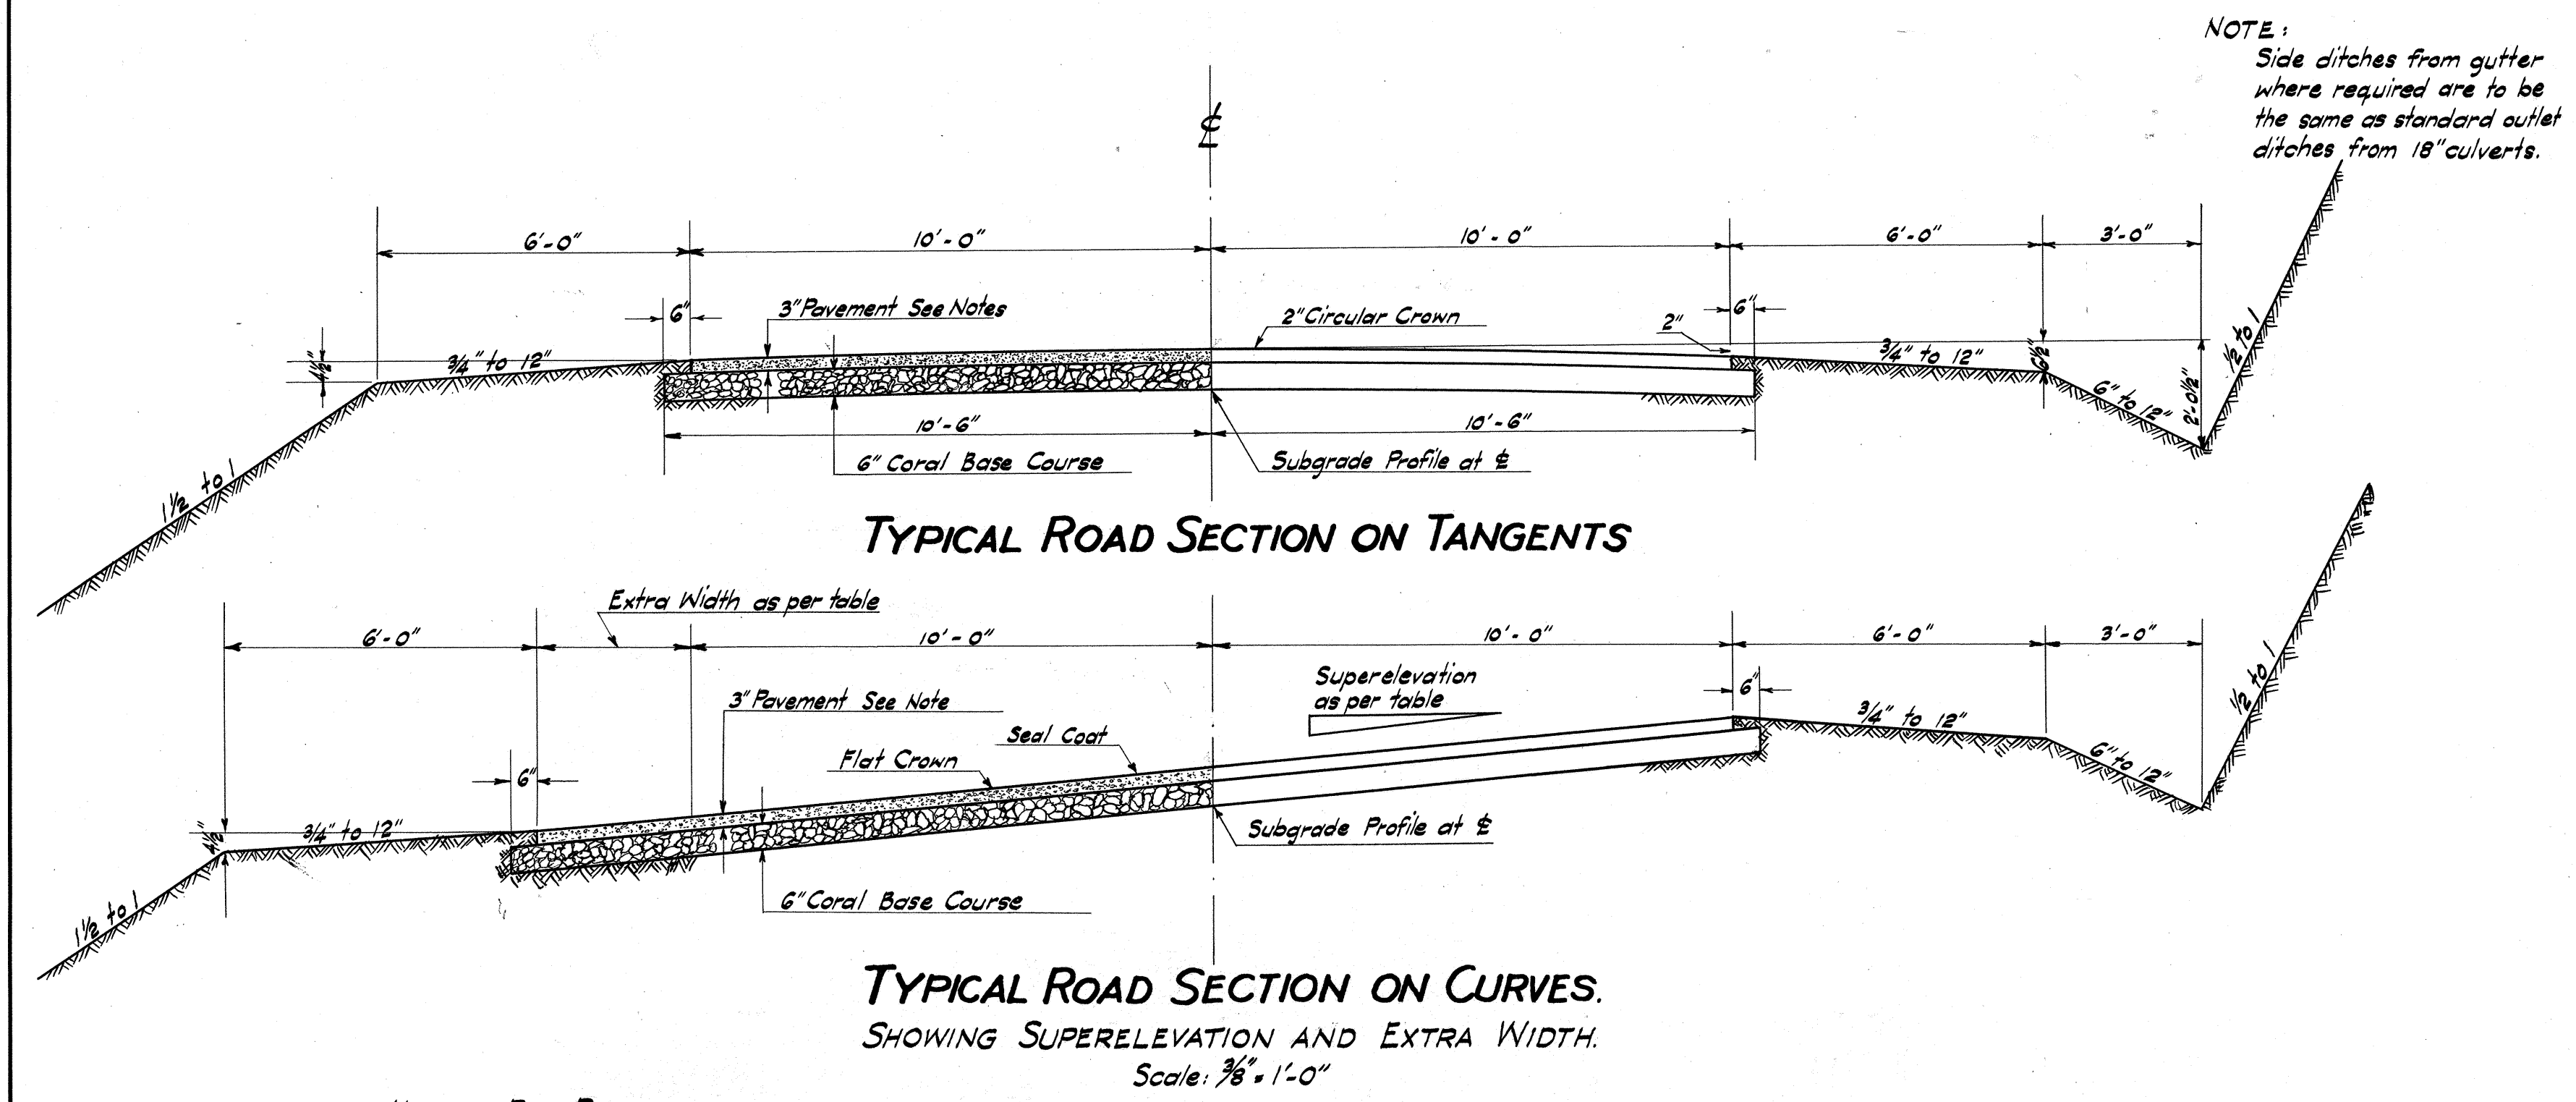


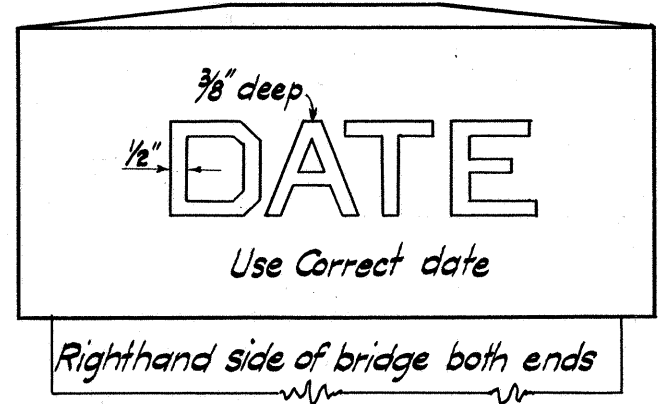


NOTES RE - PAVEMENT
The 3" Pavement shall be a 3" Asphaltic Macadam Surface Course with a Seal Coat.
The 3" Asphaltic Macadam Surface Course shall have 4" (measured loose) of No. 1 Crushed Rock (3 1/2" to 2"), 14 pounds per sq. yd. of Grade A-2 Asphalt (85-100) and sufficient No. 3 Crushed Rock (1 1/2" to 3/8") to cover. This shall have a Seal Coat of 4 to 5 pounds of Grade A-2 Asphalt and No. 4 Crushed Rock (3/8" to #10) to cover.
Particular reference is made to the Specifications covering this item of work.

APPROXIMATE QUANTITIES
FOR THE USE OF THE ENGINEER ONLY - NOT APPLICABLE TO THE PLANS

Item No.	1	2	3	4	5	6	7	8	9	10	11	12
	Unclassified Excavation	Embankment	Borrow	Excavation at Structures	Coral Base Course	Pavement	Spec. Cem. Rubble Masonry	Class 2" Concrete	Reinforcing Steel	Std. Wire Fence With Wooden Posts	Std. Castile Gate	
Unit Used	Cu. Yds.	Cu. Yds.	Cu. Yds.	Cu. Yds.	Sq. Yds.	Sq. Yds.	Cu. Yds.	Cu. Yds.	Lbs.	Lin. Ft.	Each	
Roadway Prisms												
Bridge												
Fences												
Walls												
Miscellaneous												
Totals												

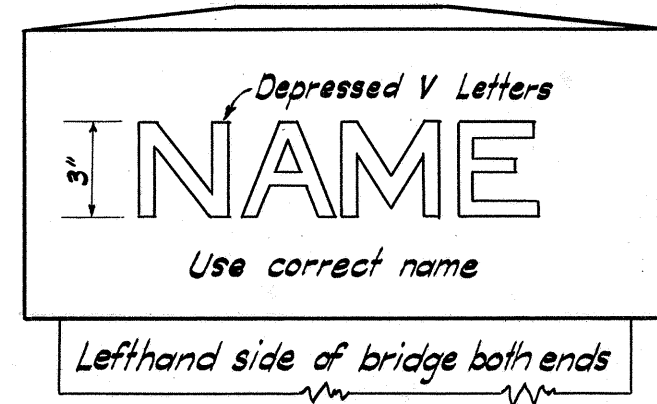

DETAIL LETTERS & FIGURES ON BRIDGE RAILINGS
Scale: 2" = 1'-0"

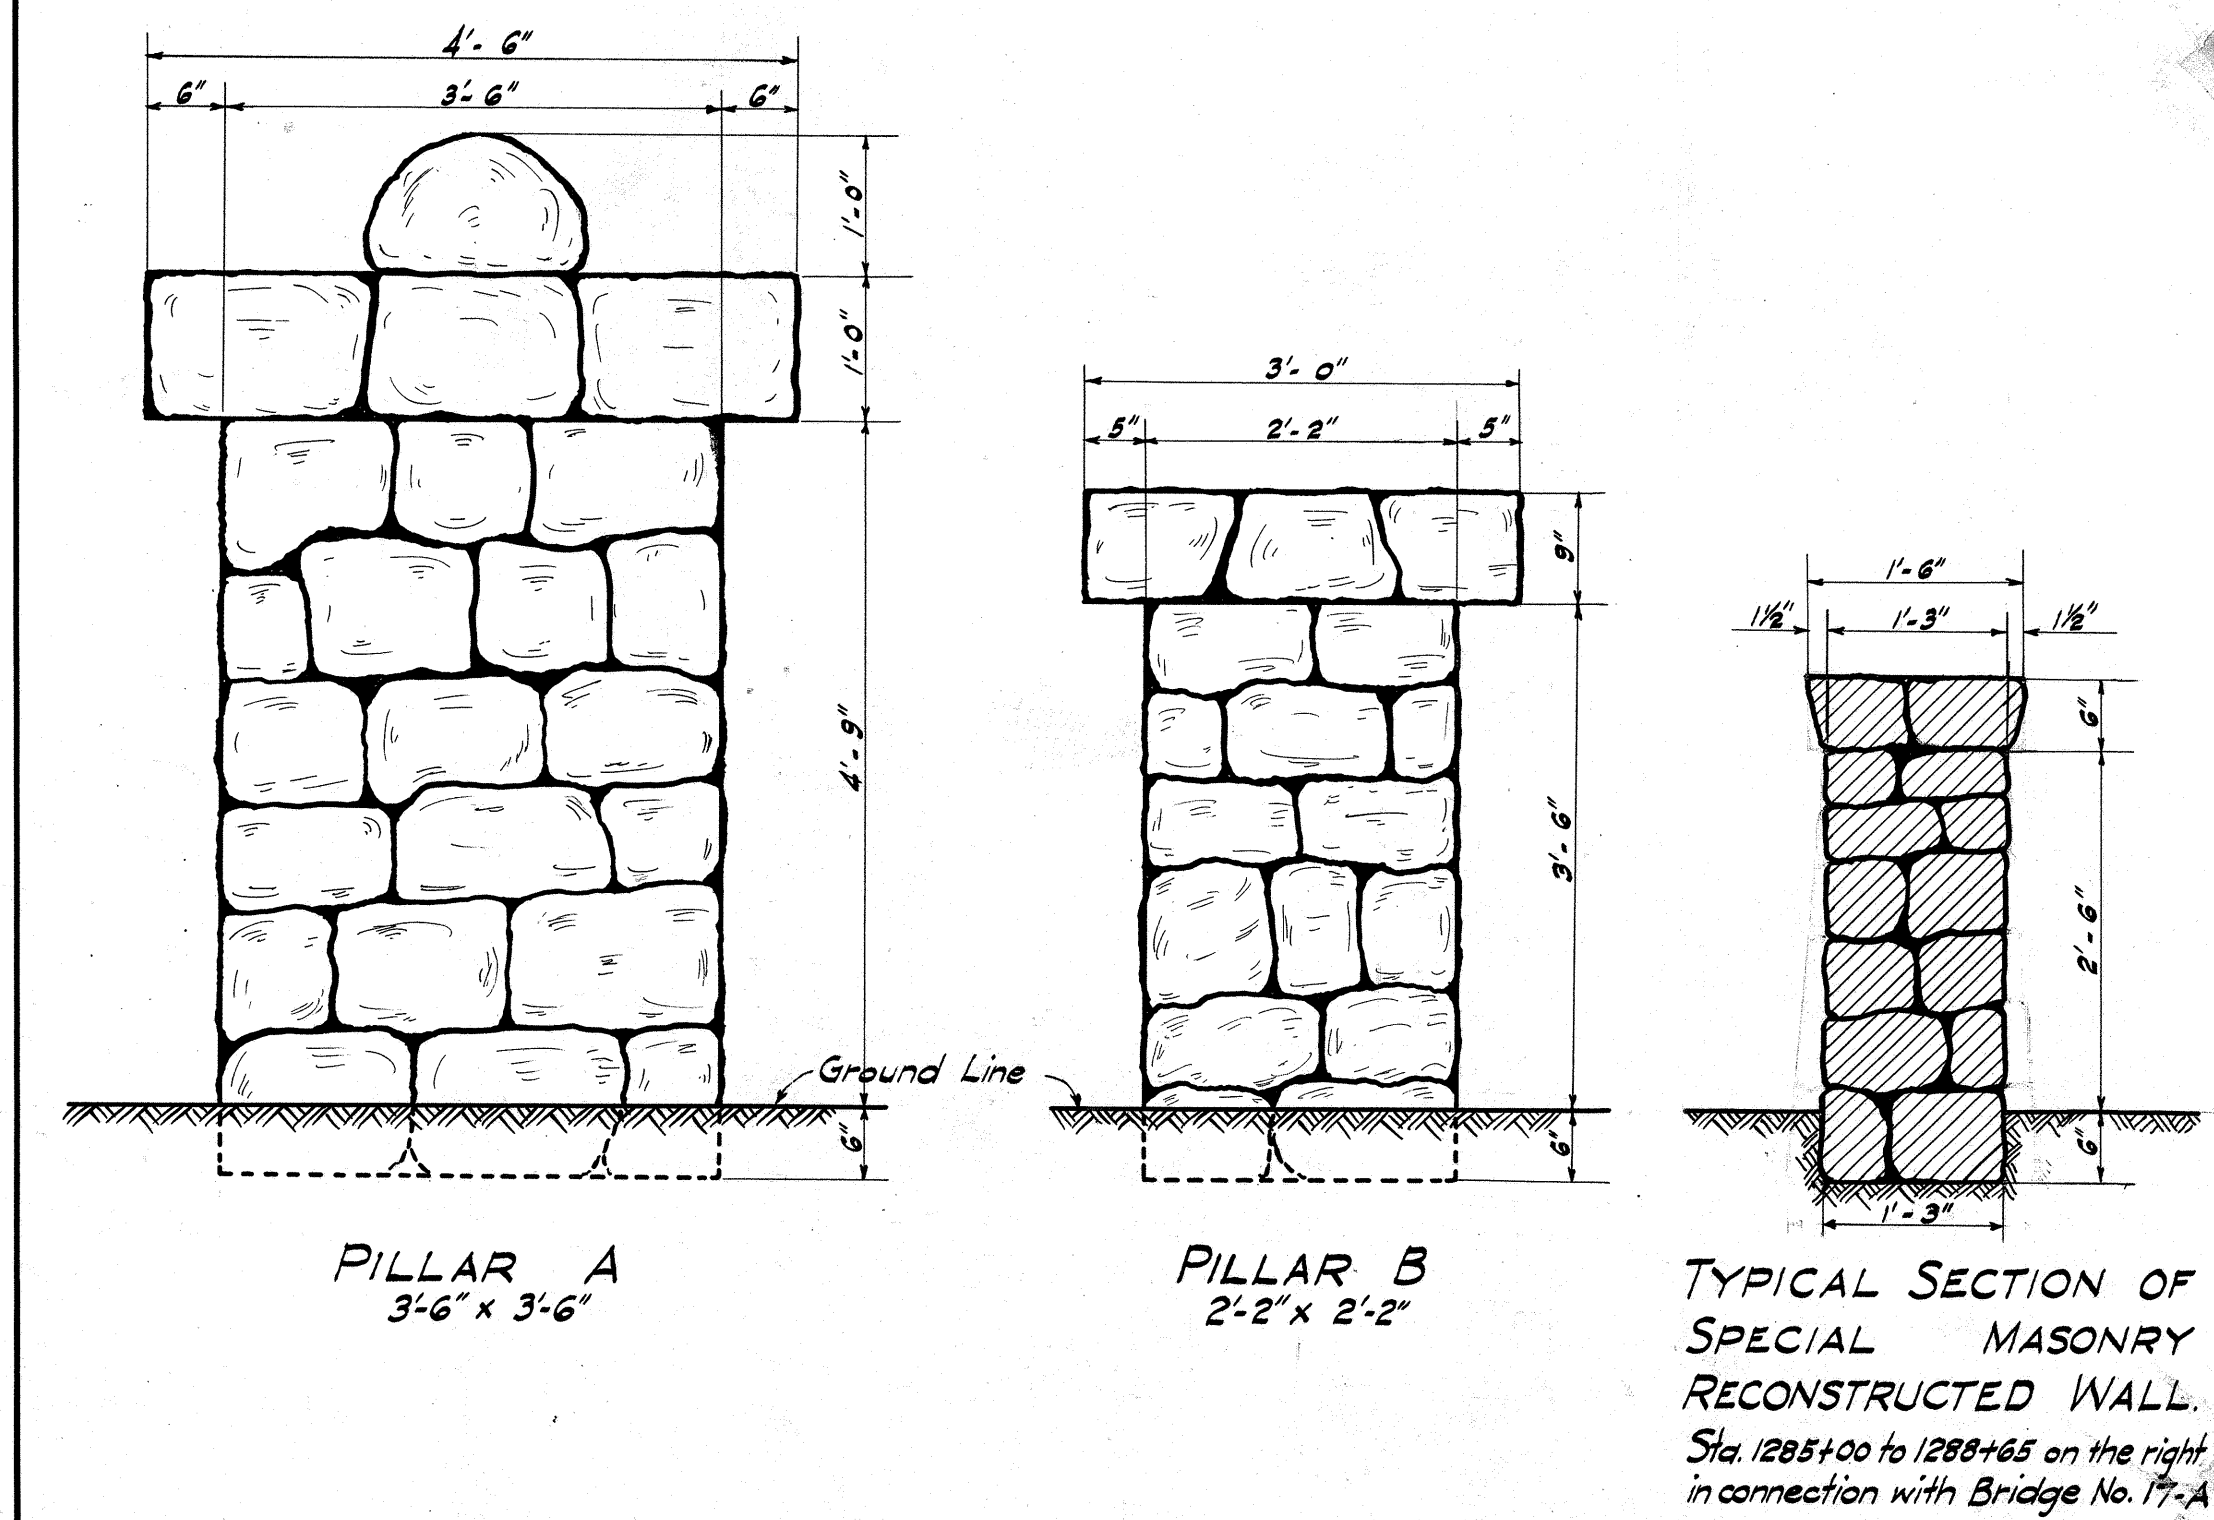

Scale: 3/4" = 1'-0"

Pavement Notes Corrected