

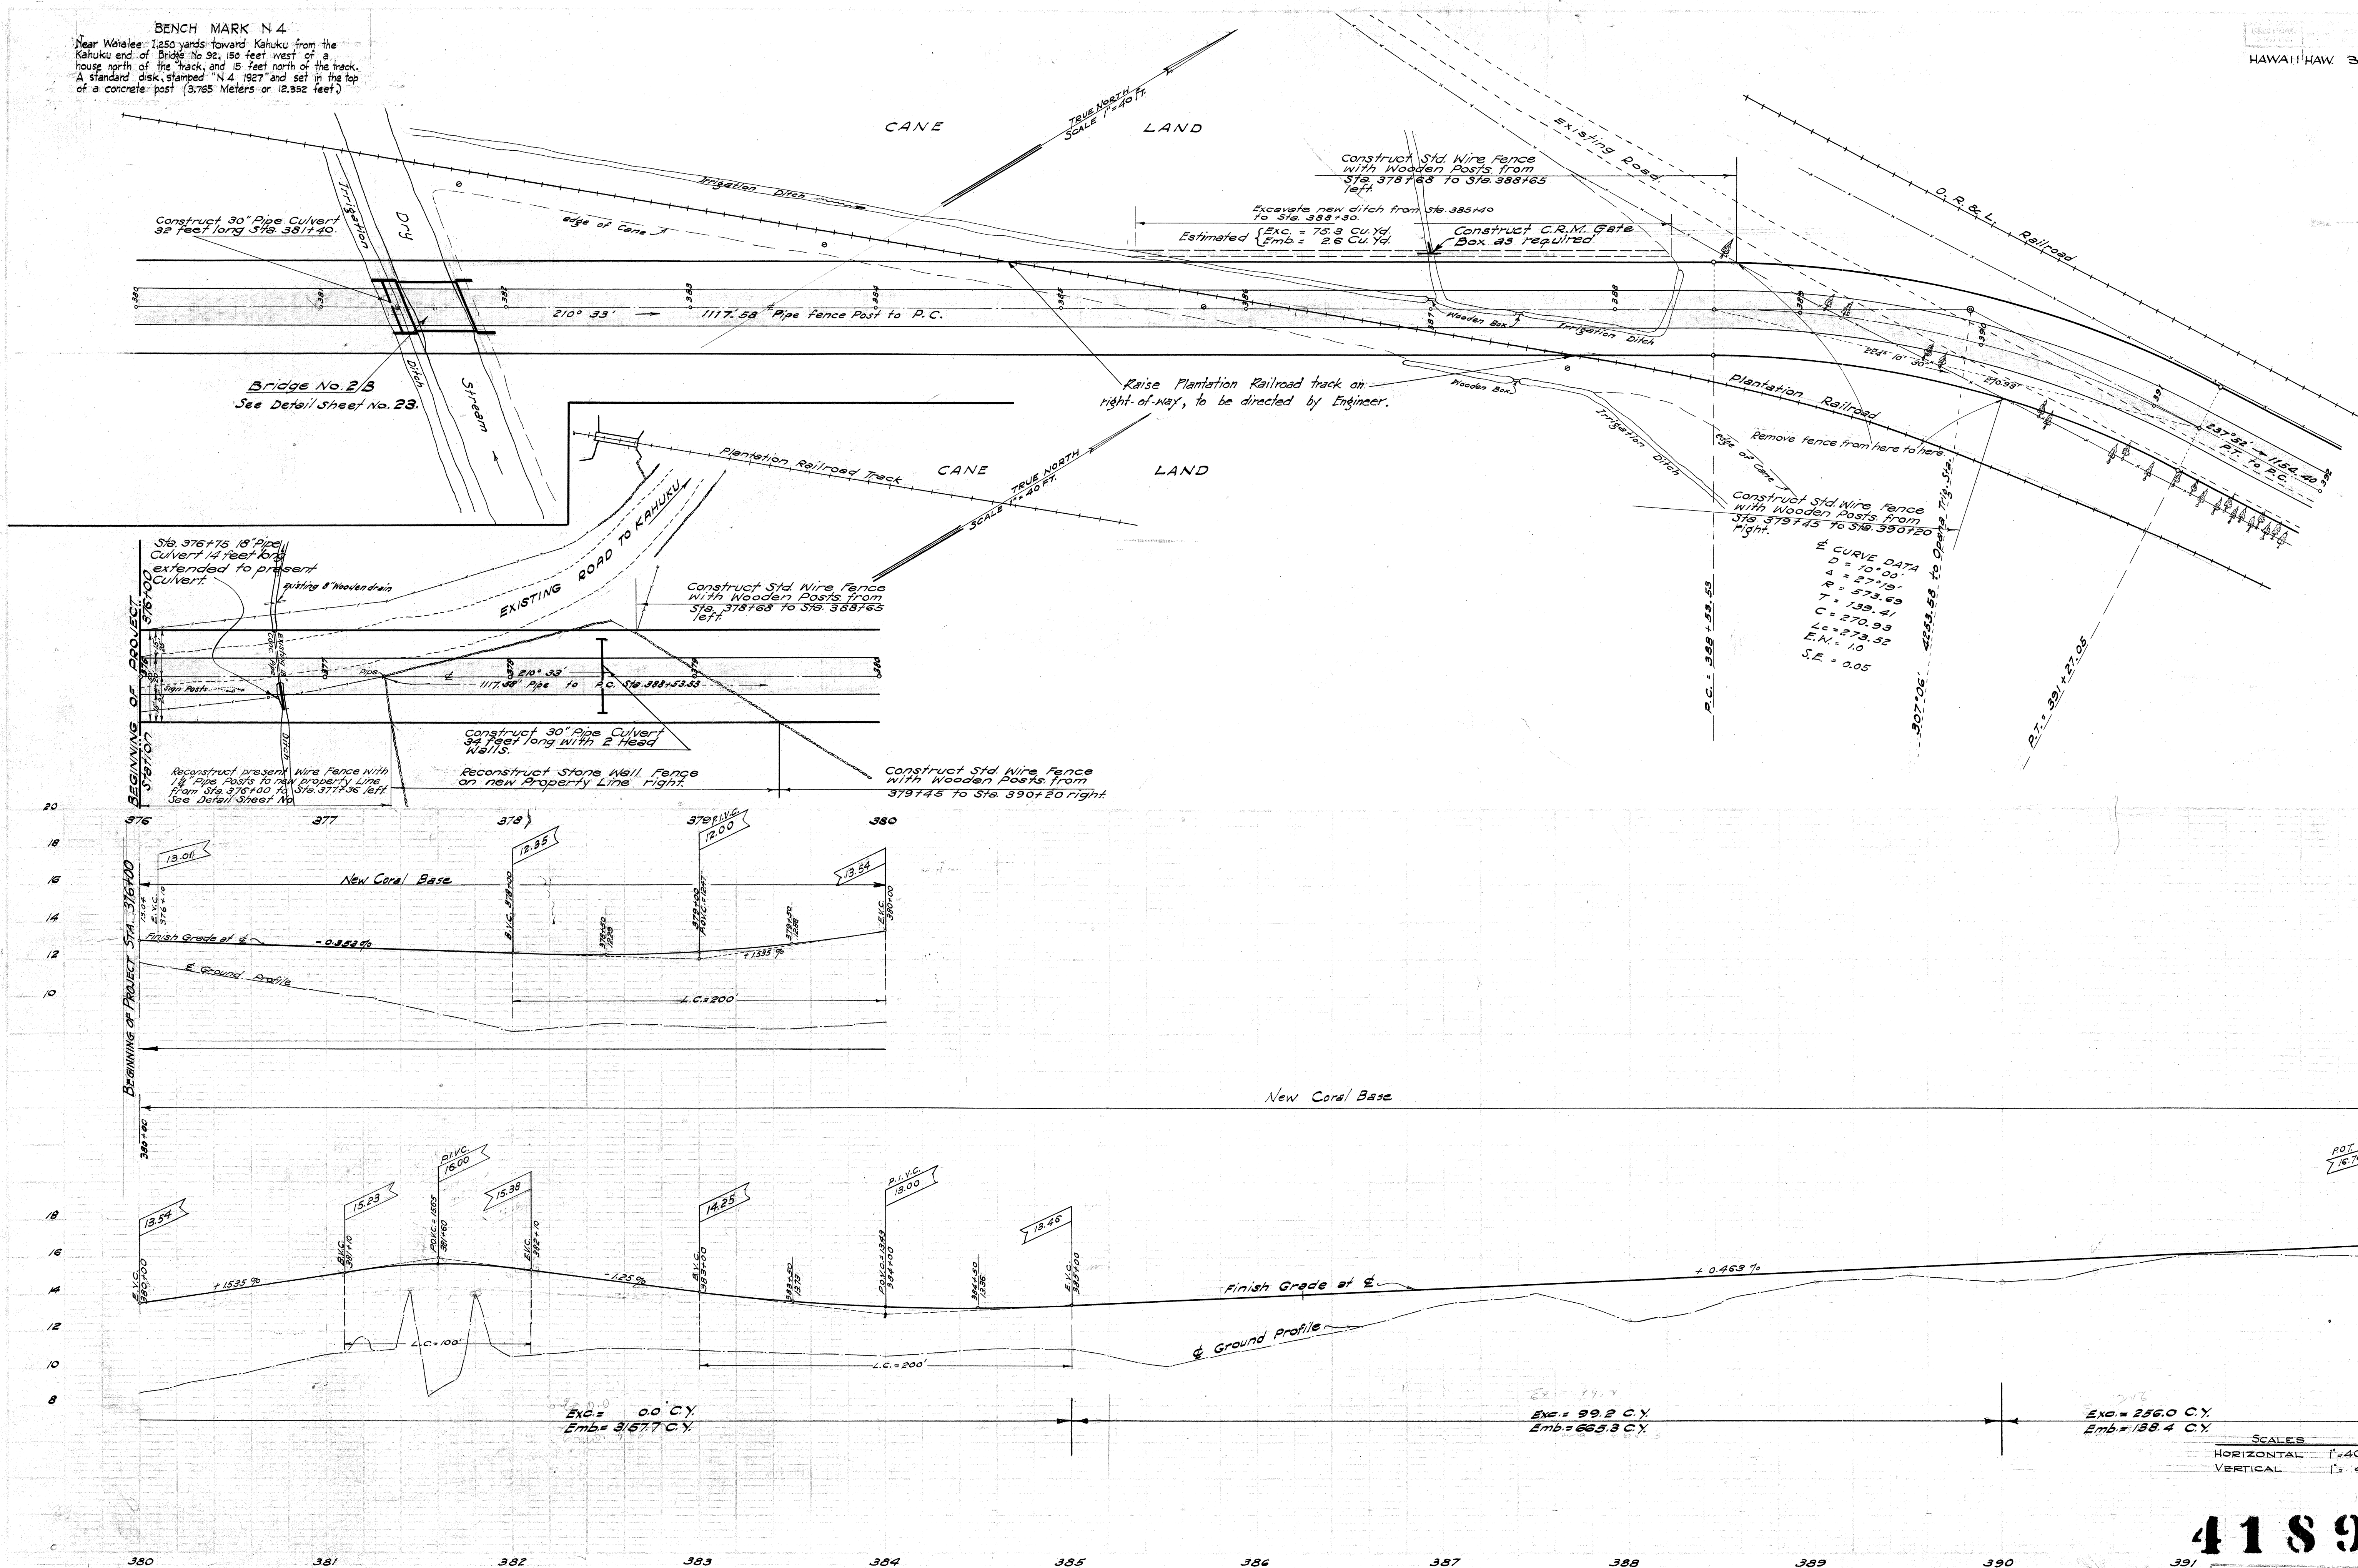


BENCH MARK N.4
Near Waialea 1.250 yards toward Kahuku from the Kahuku end of Bridge No. 92, 150 feet west of a house north of the track, and 15 feet north of the track. A standard disk, stamped "N.4 1927" and set in the top of a concrete post (3.765 Meters or 12.532 feet).


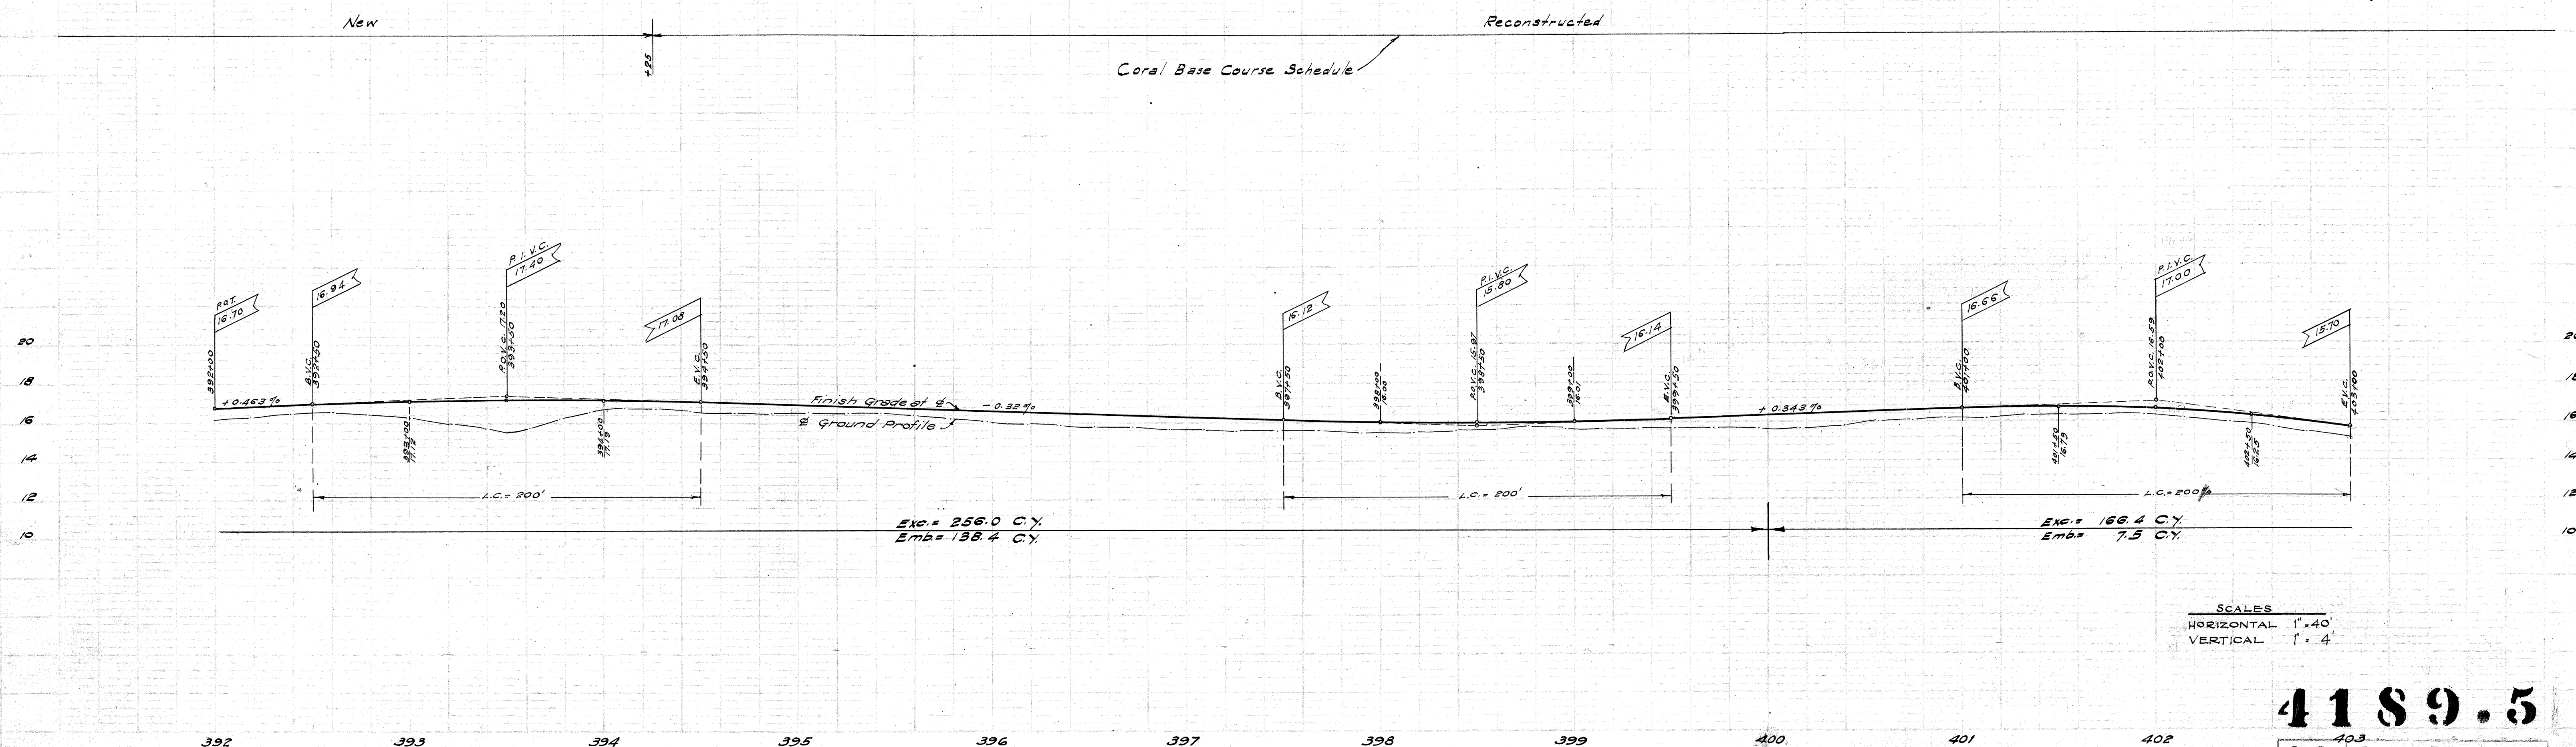


4189.4


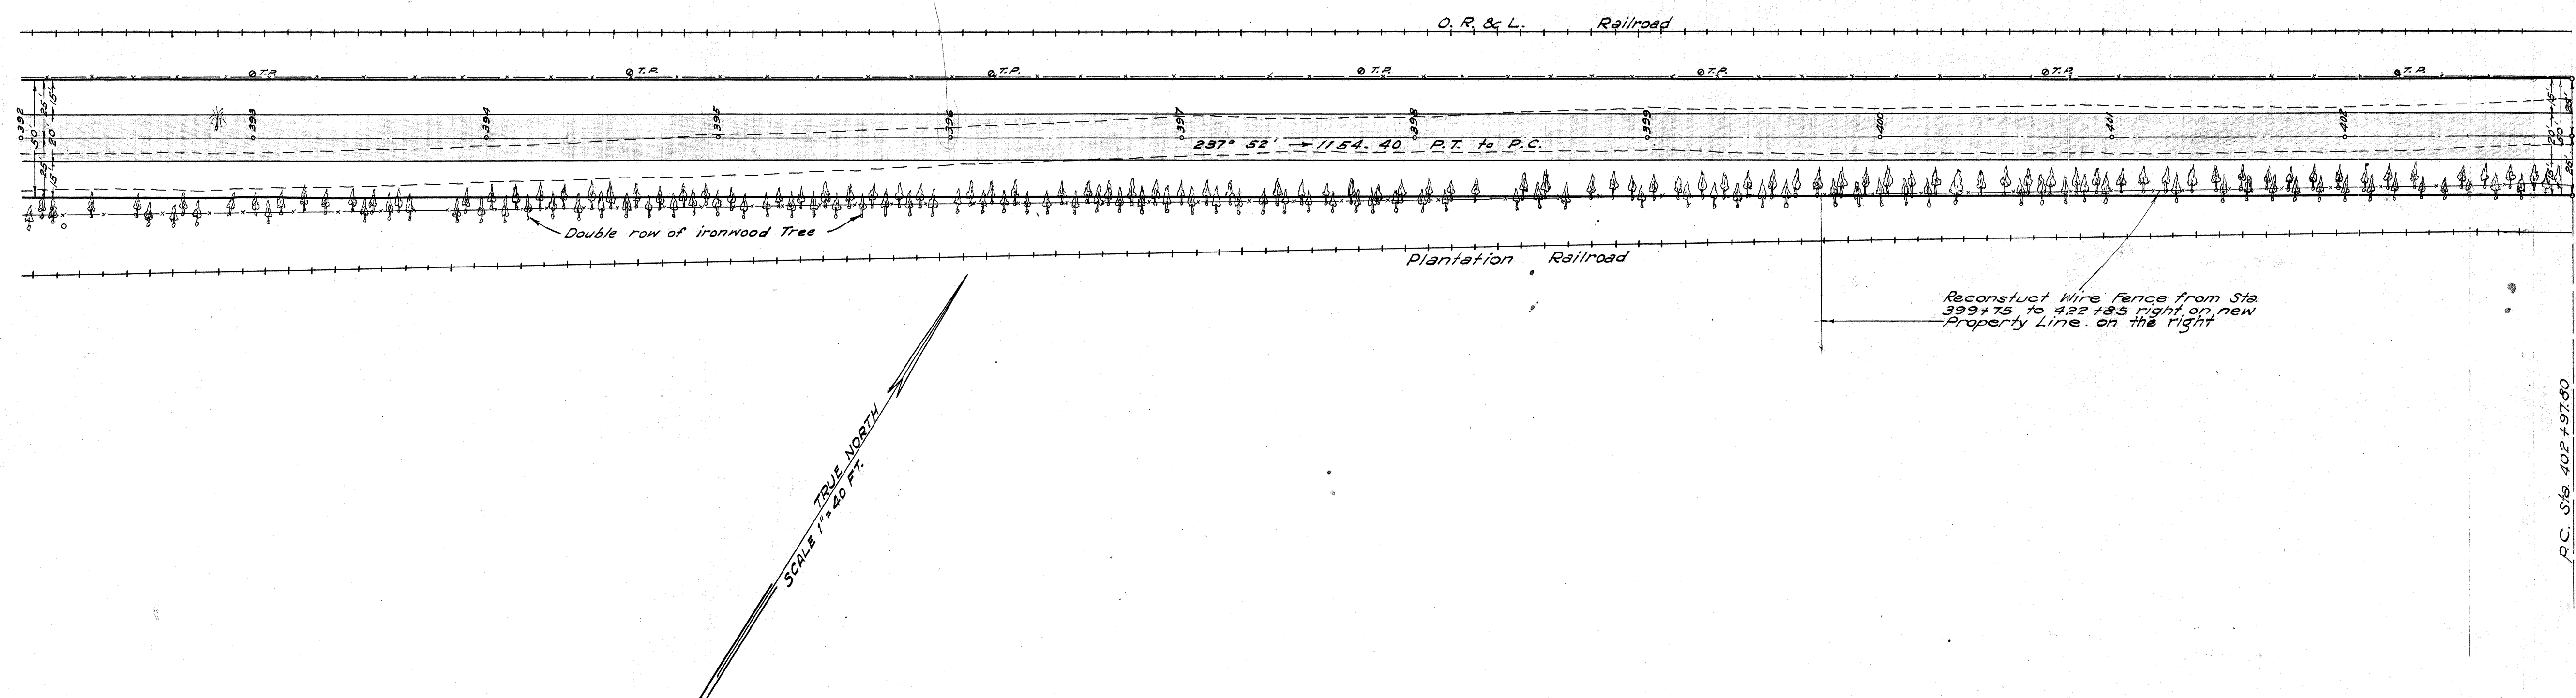





SCALES
HORIZONTAL 1"=40'
VERTICAL 1"=4'



4189.5

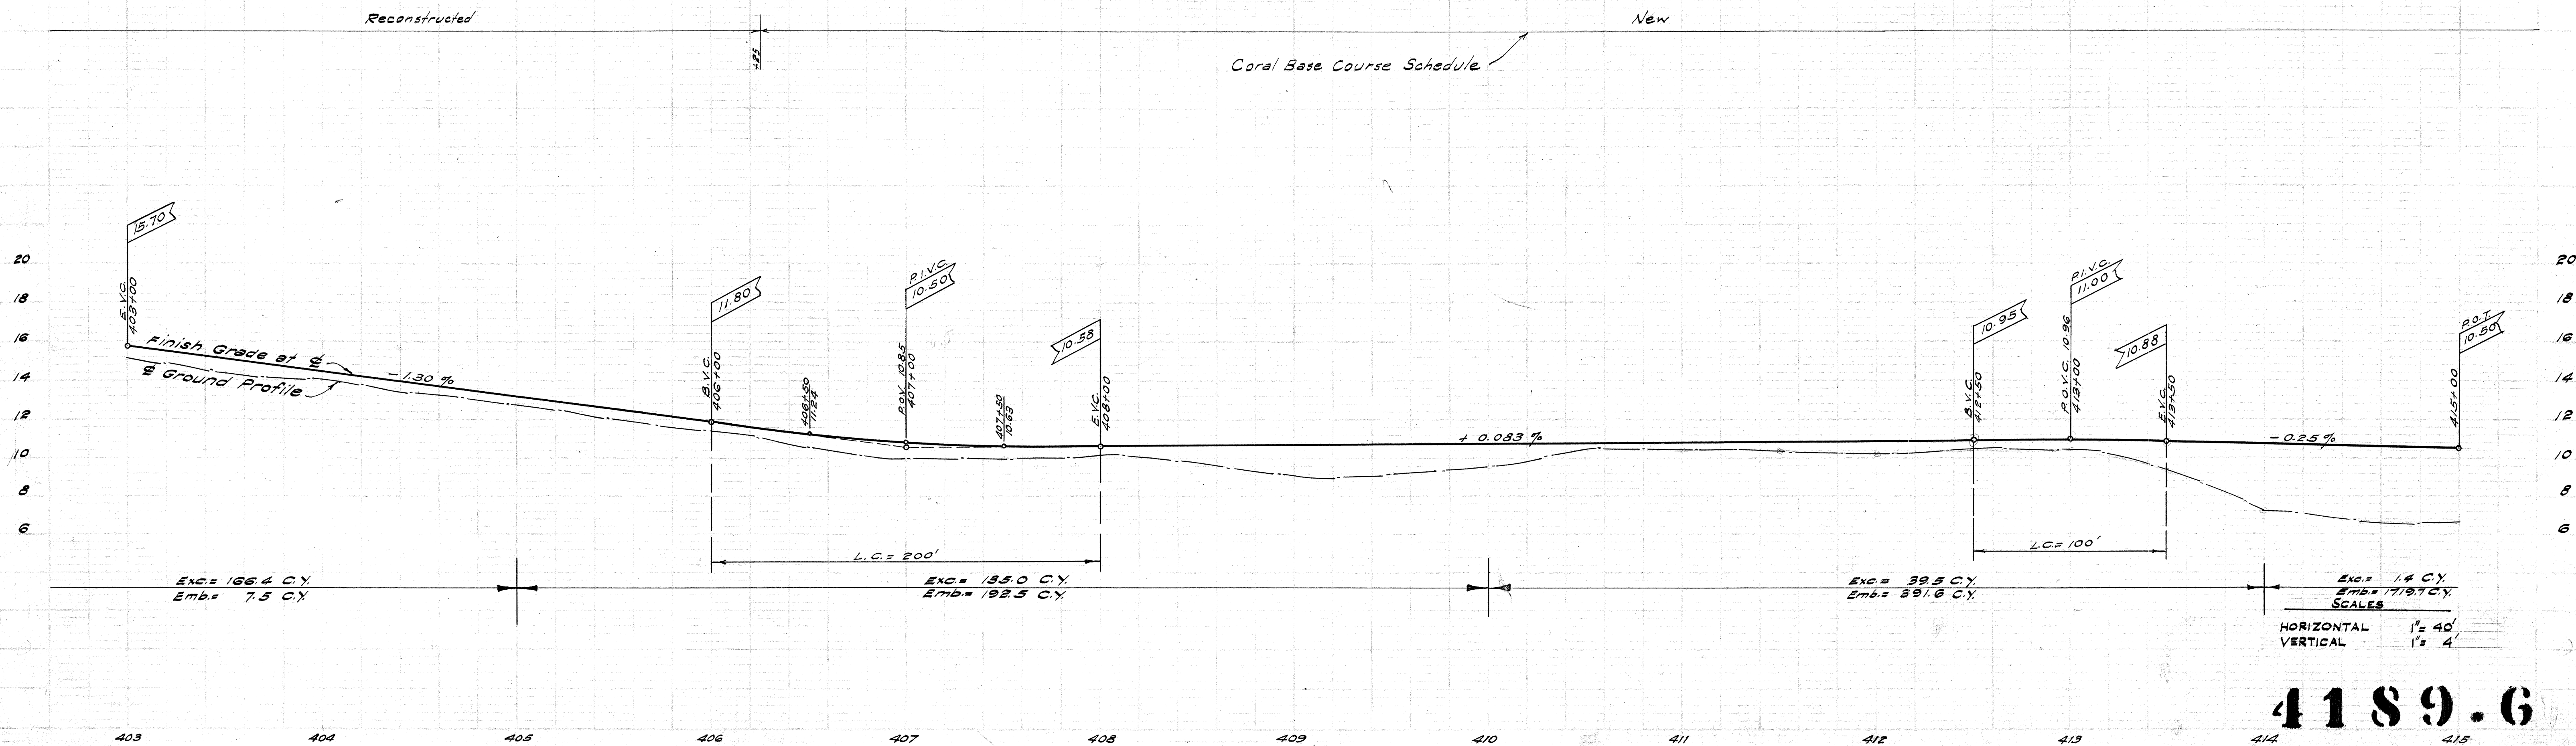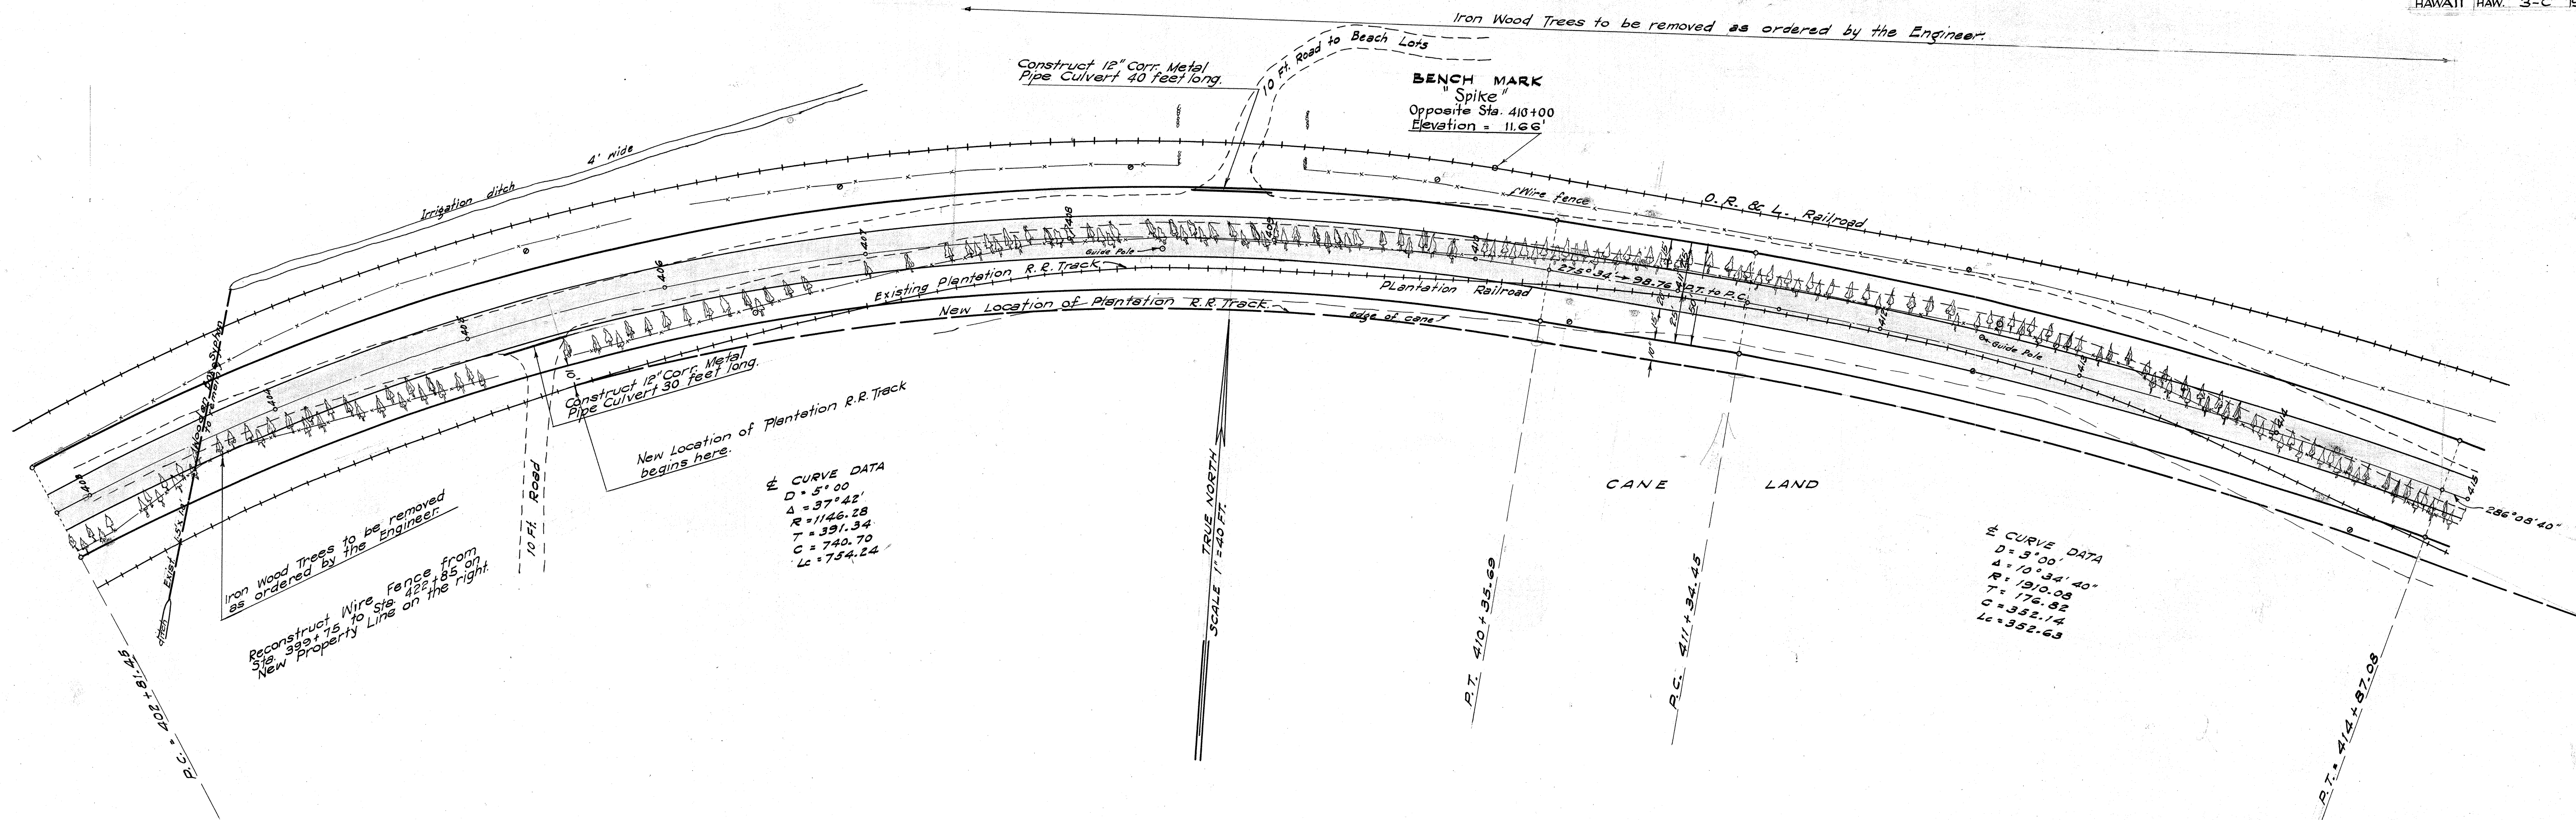

4189.6

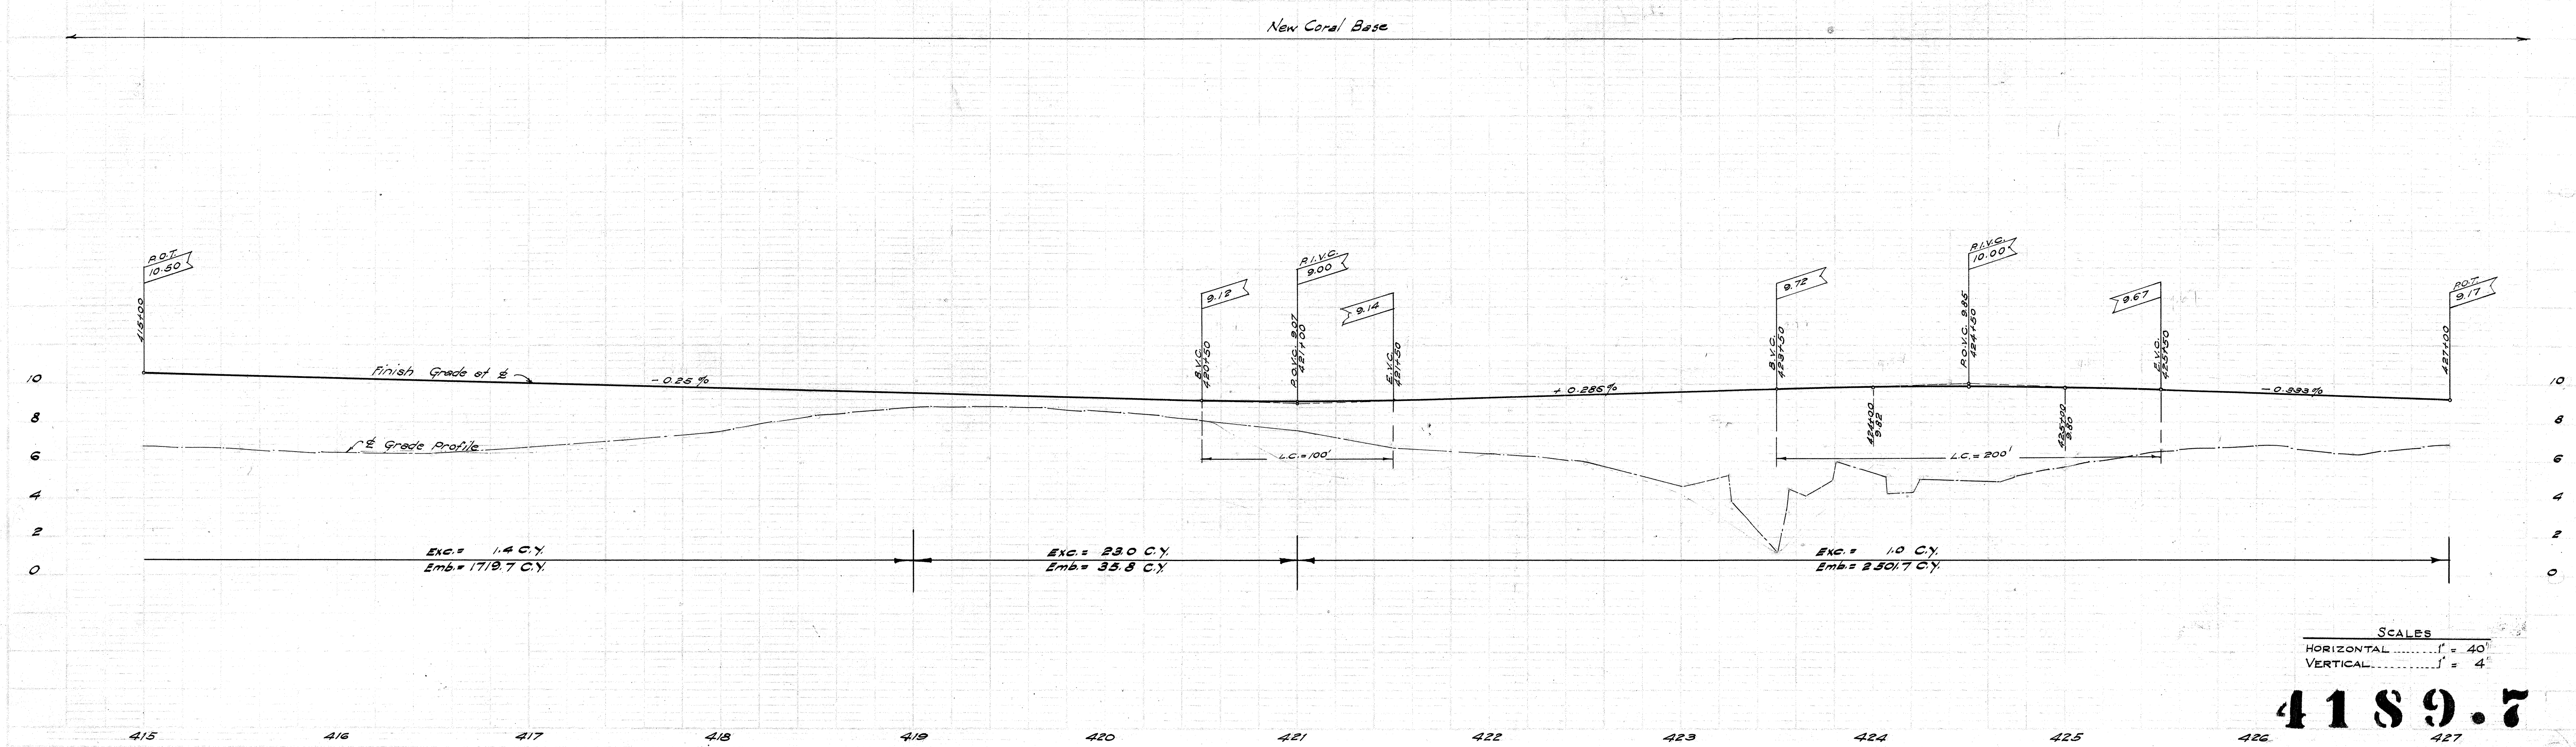
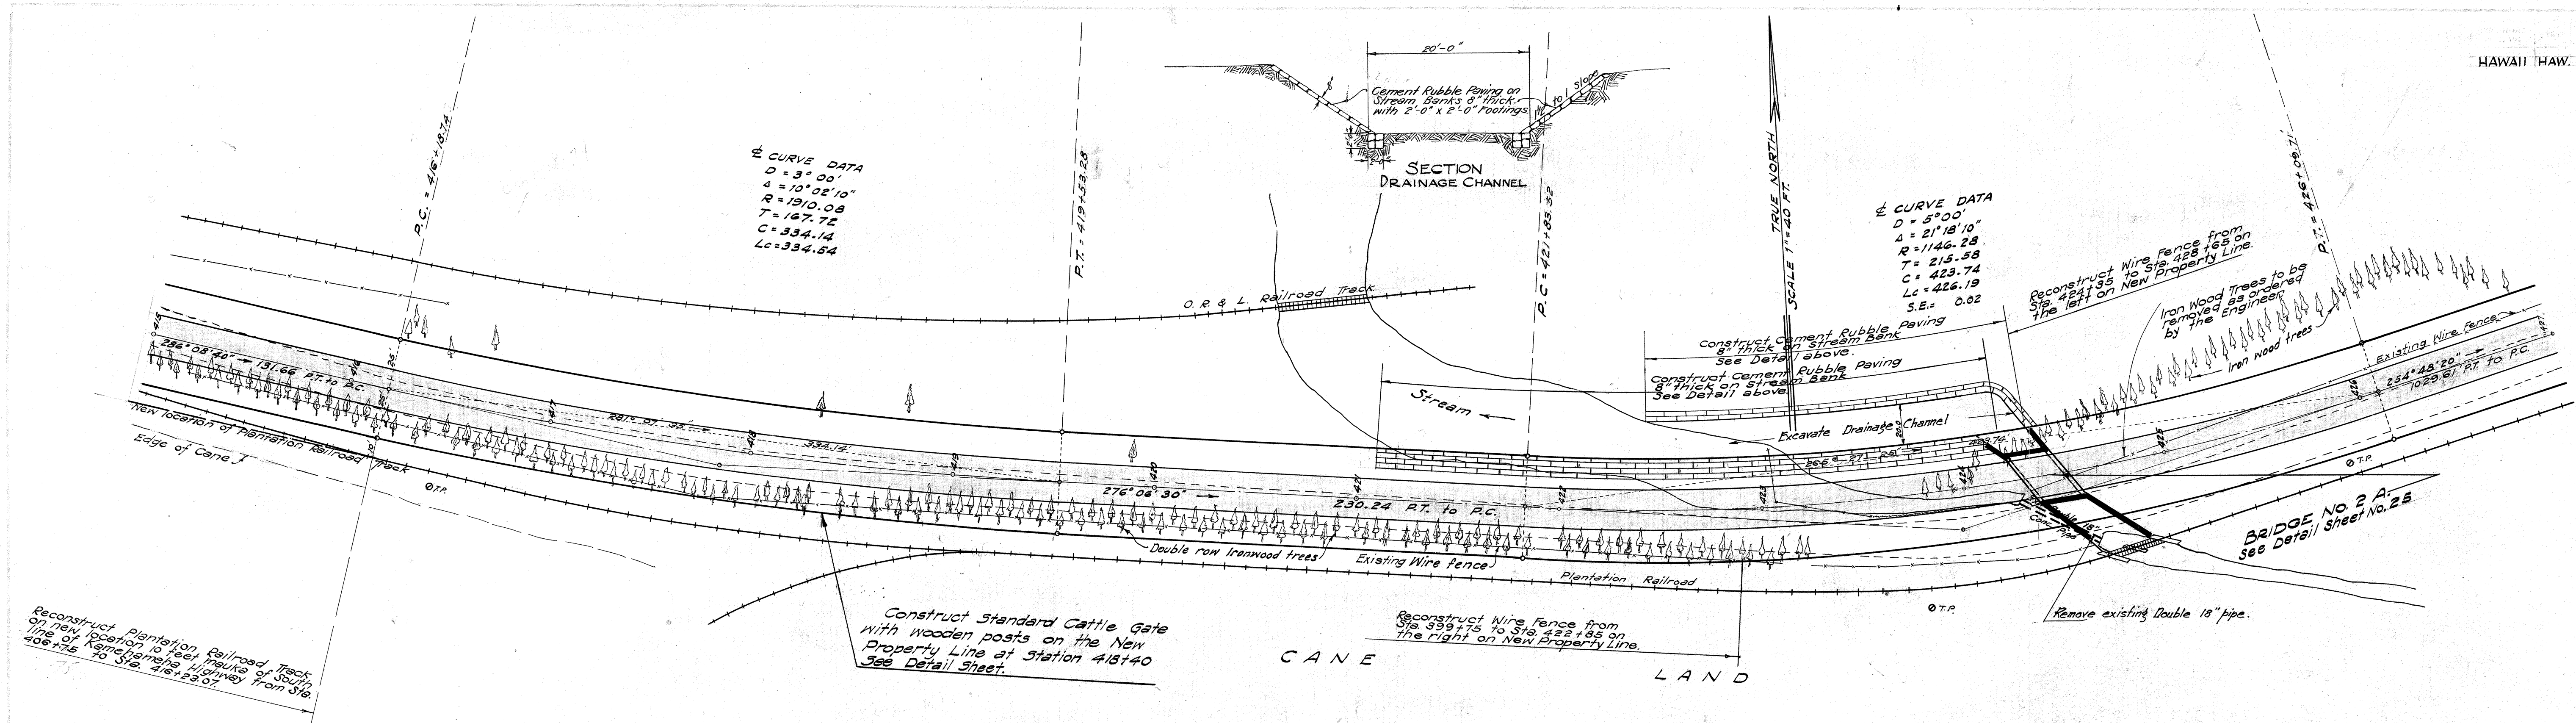


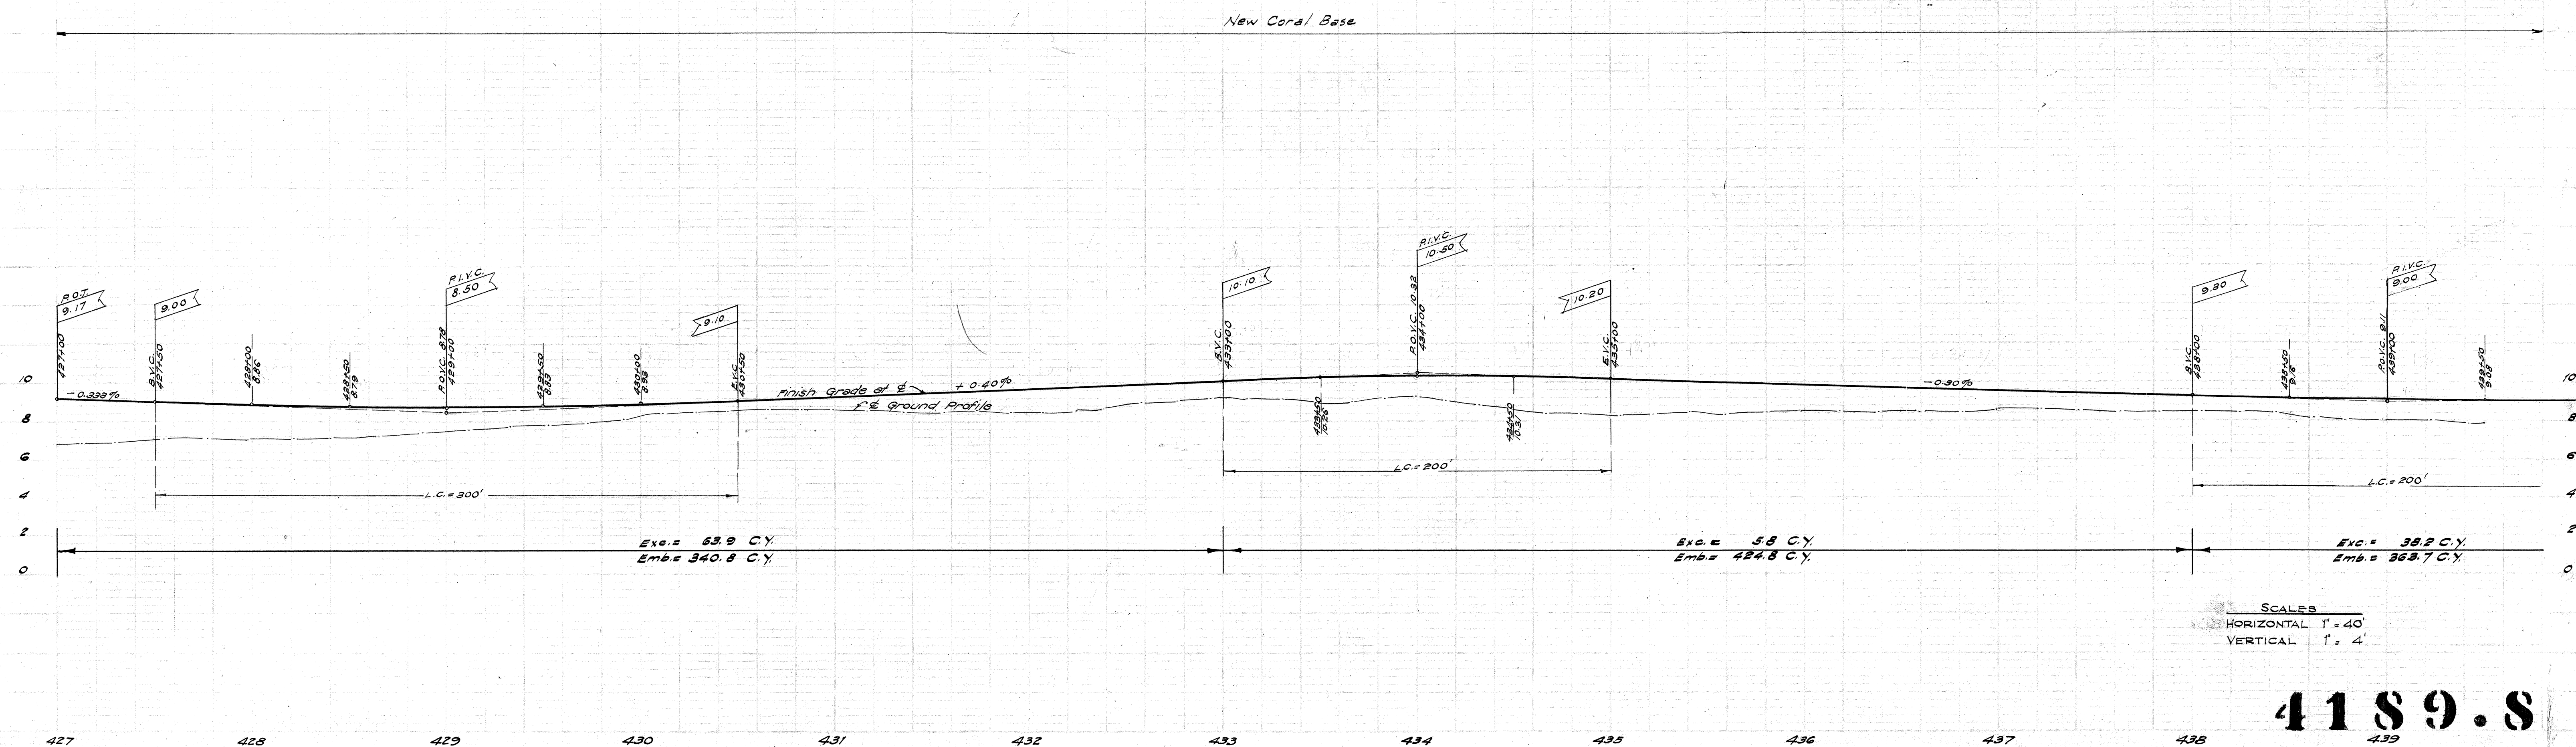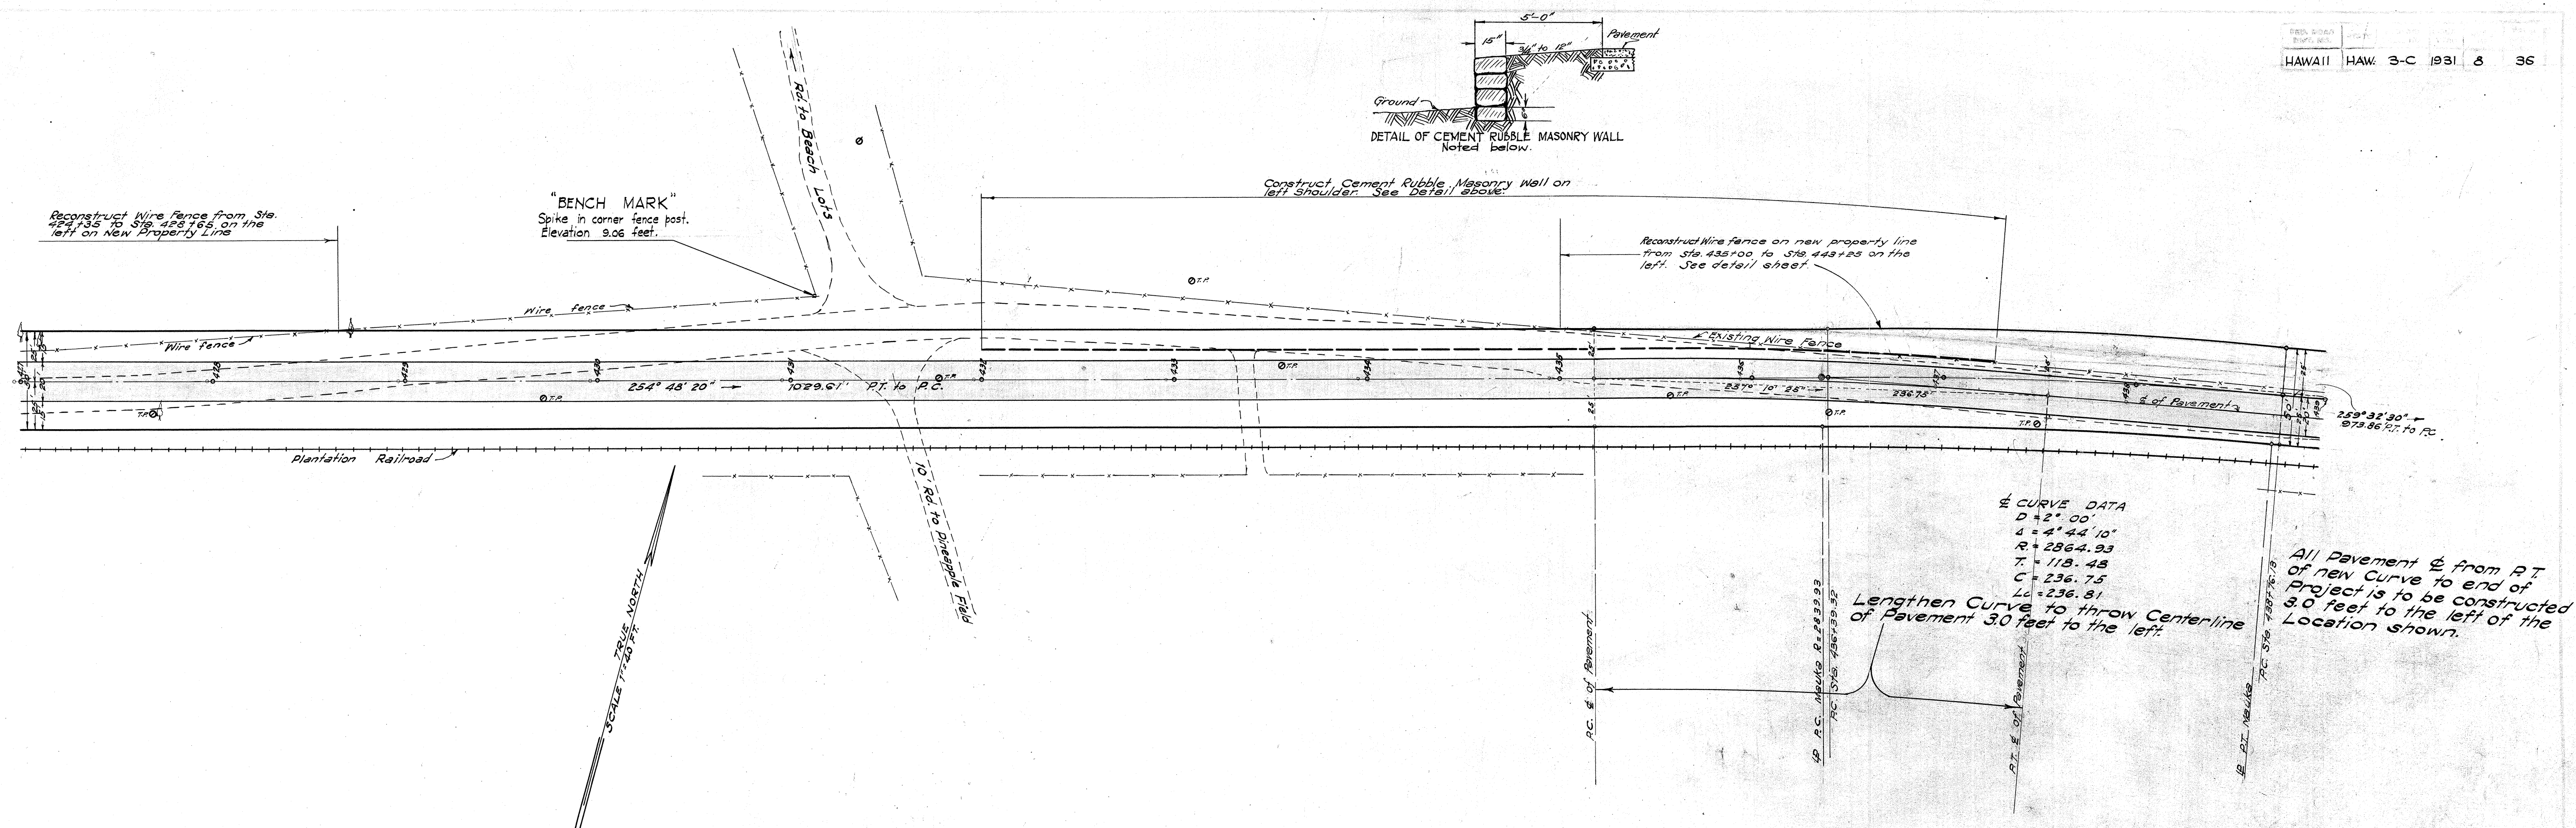
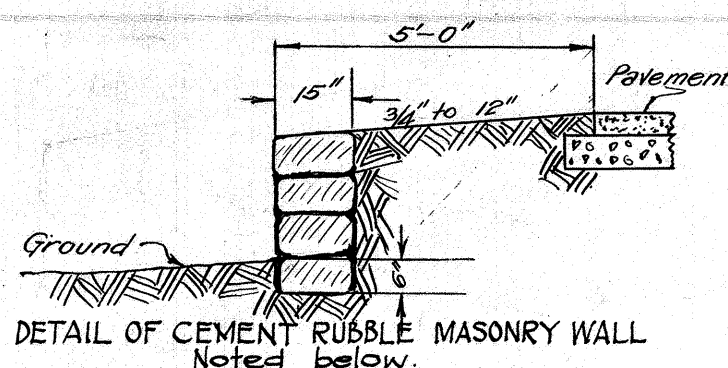


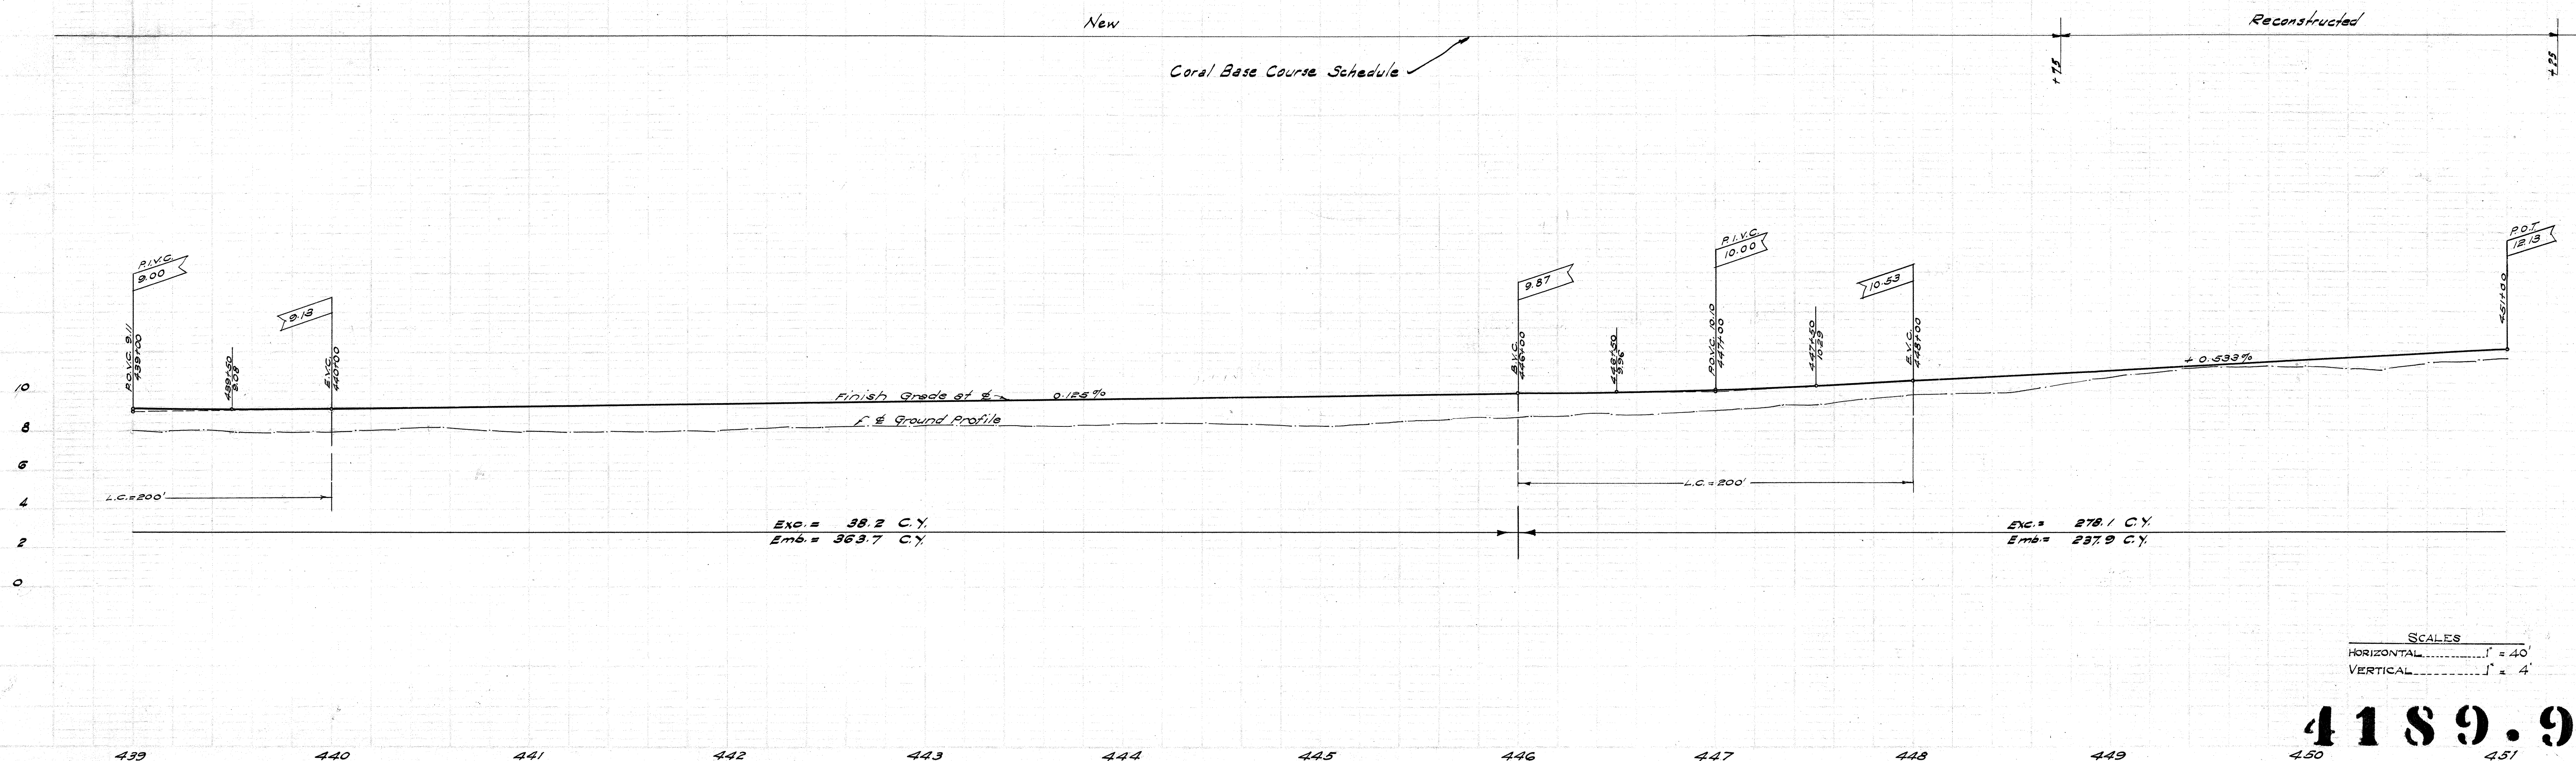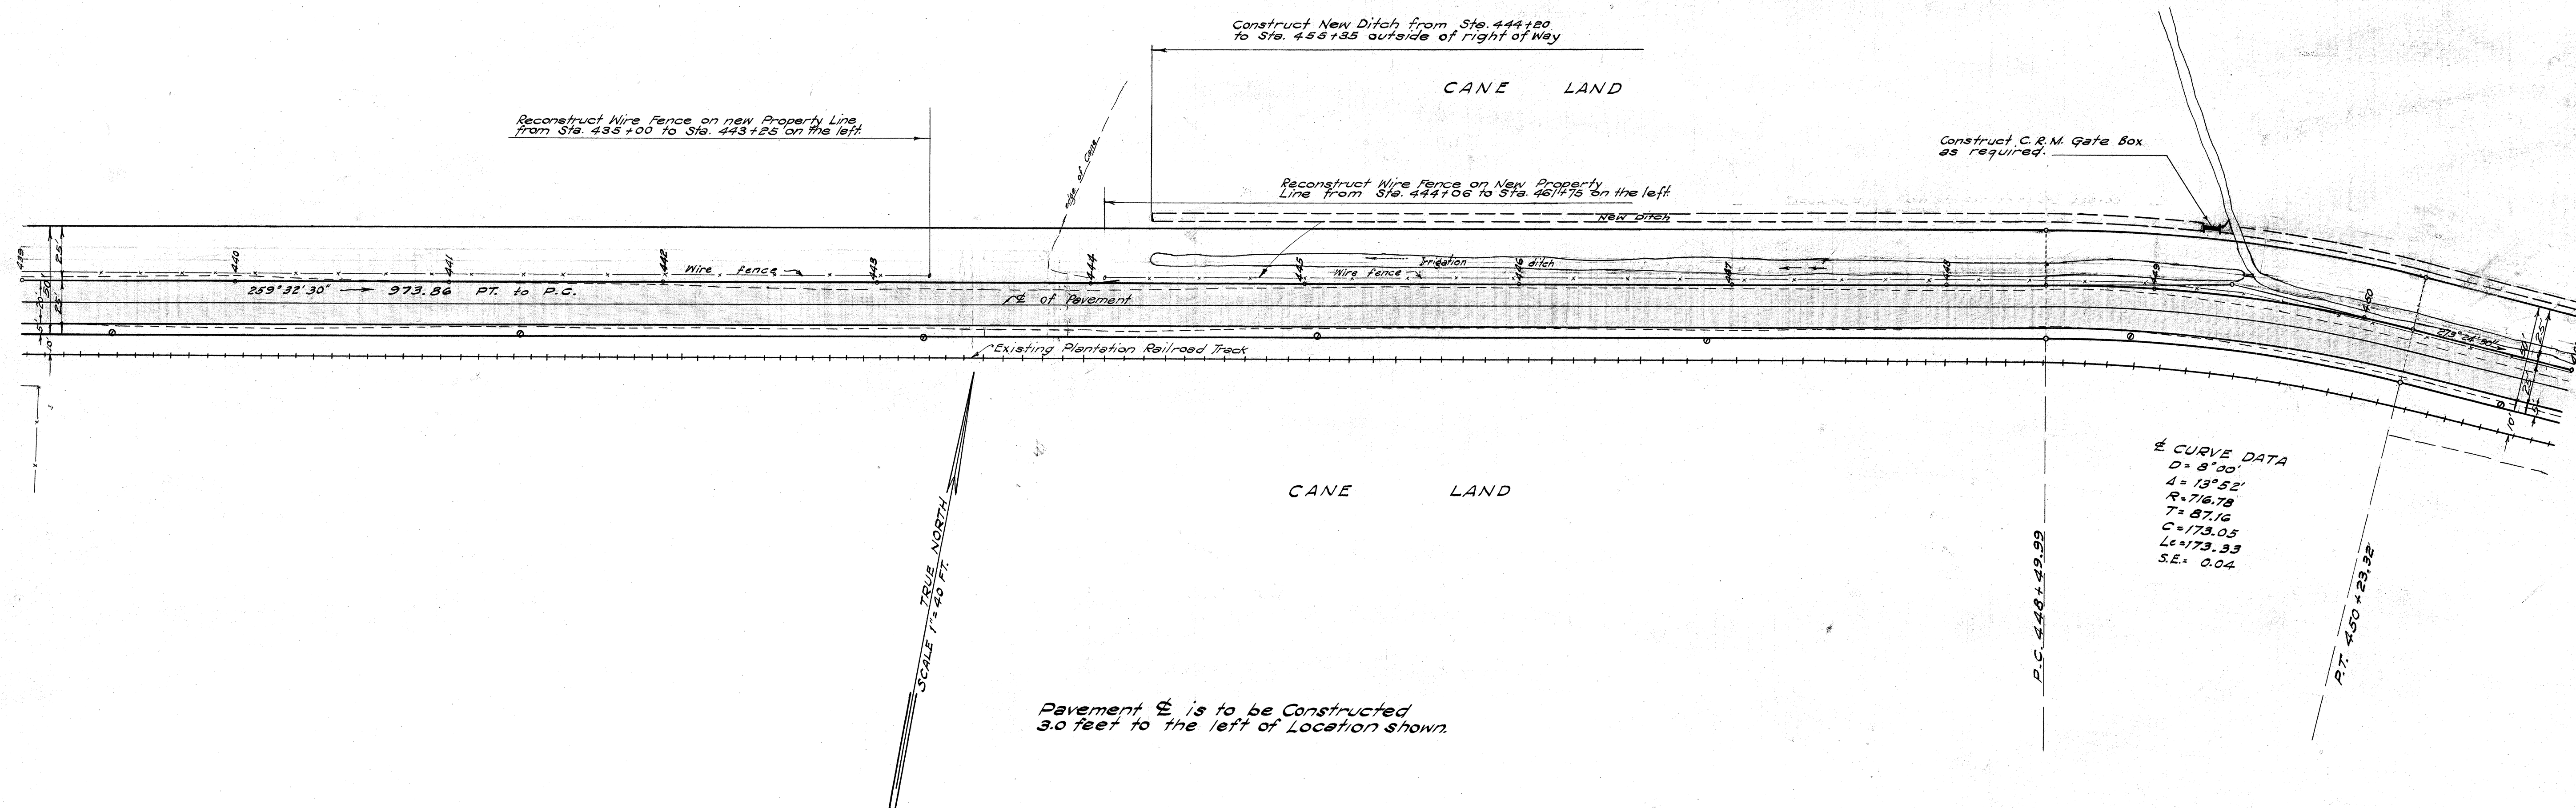

SCALES
 HORIZONTAL 1" = 40'
 VERTICAL 1" = 4'



4189.9

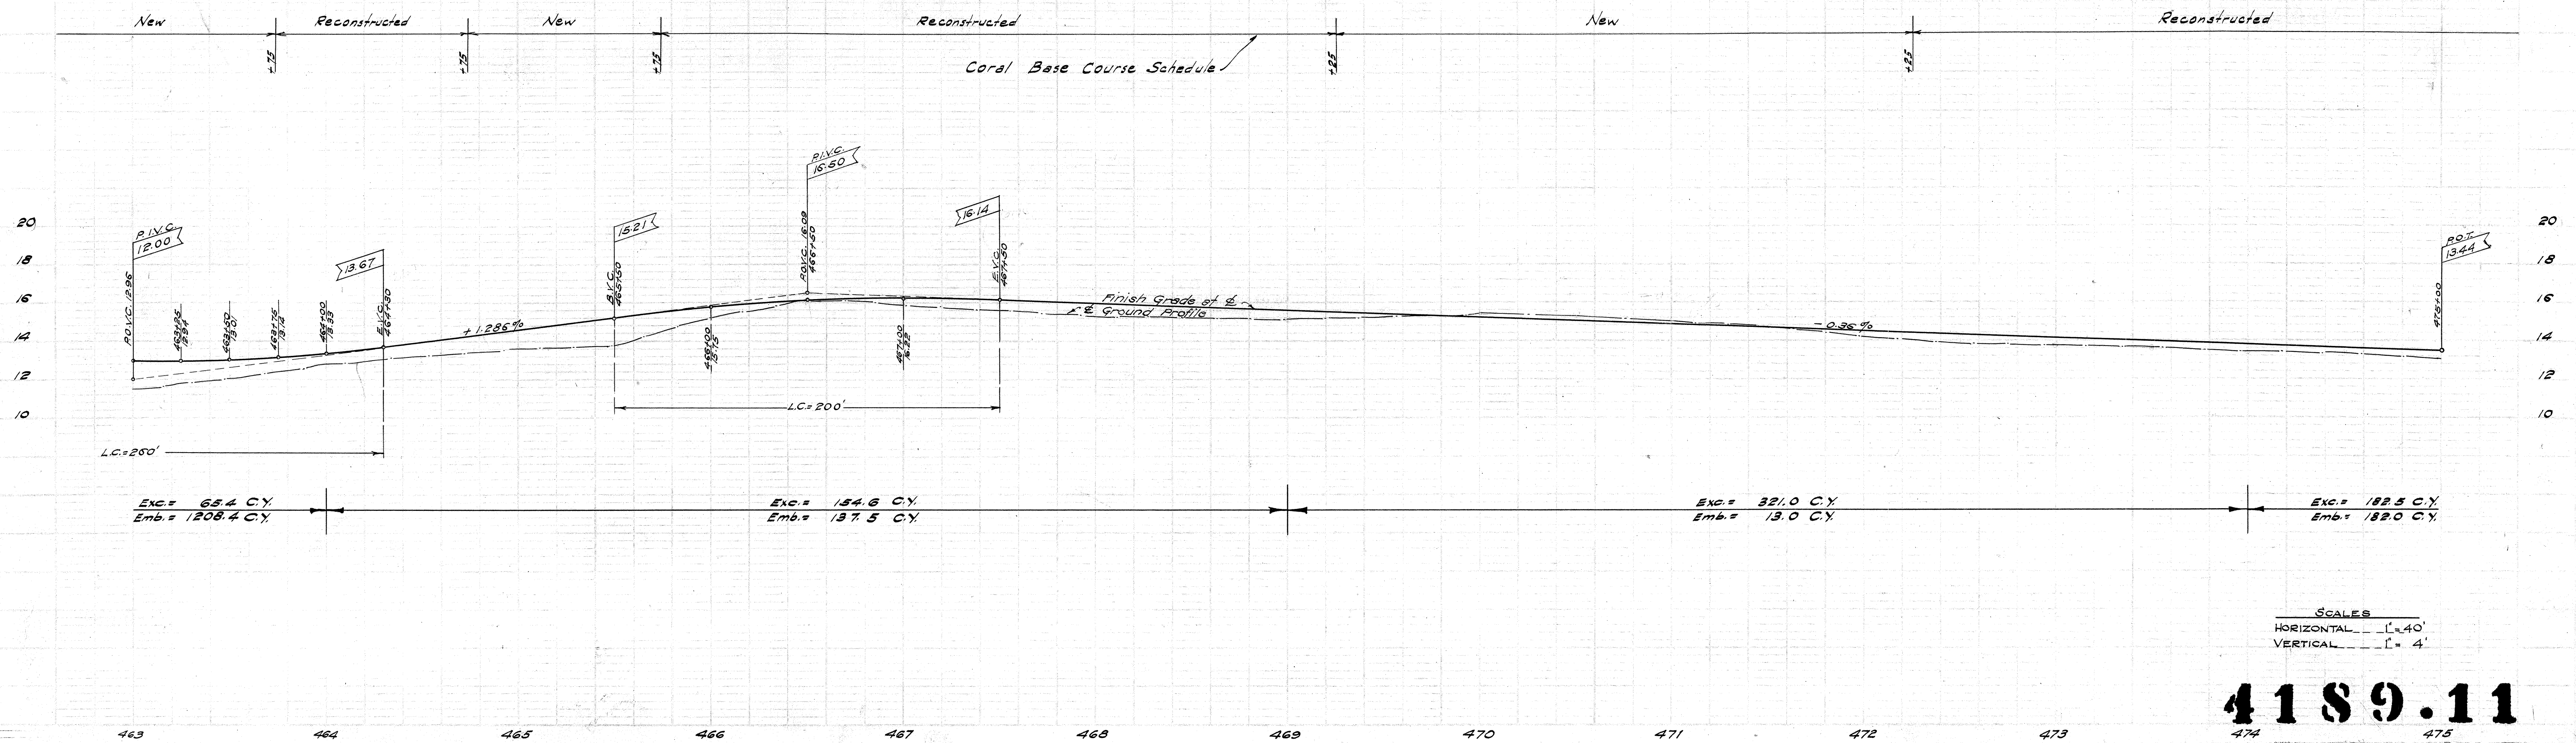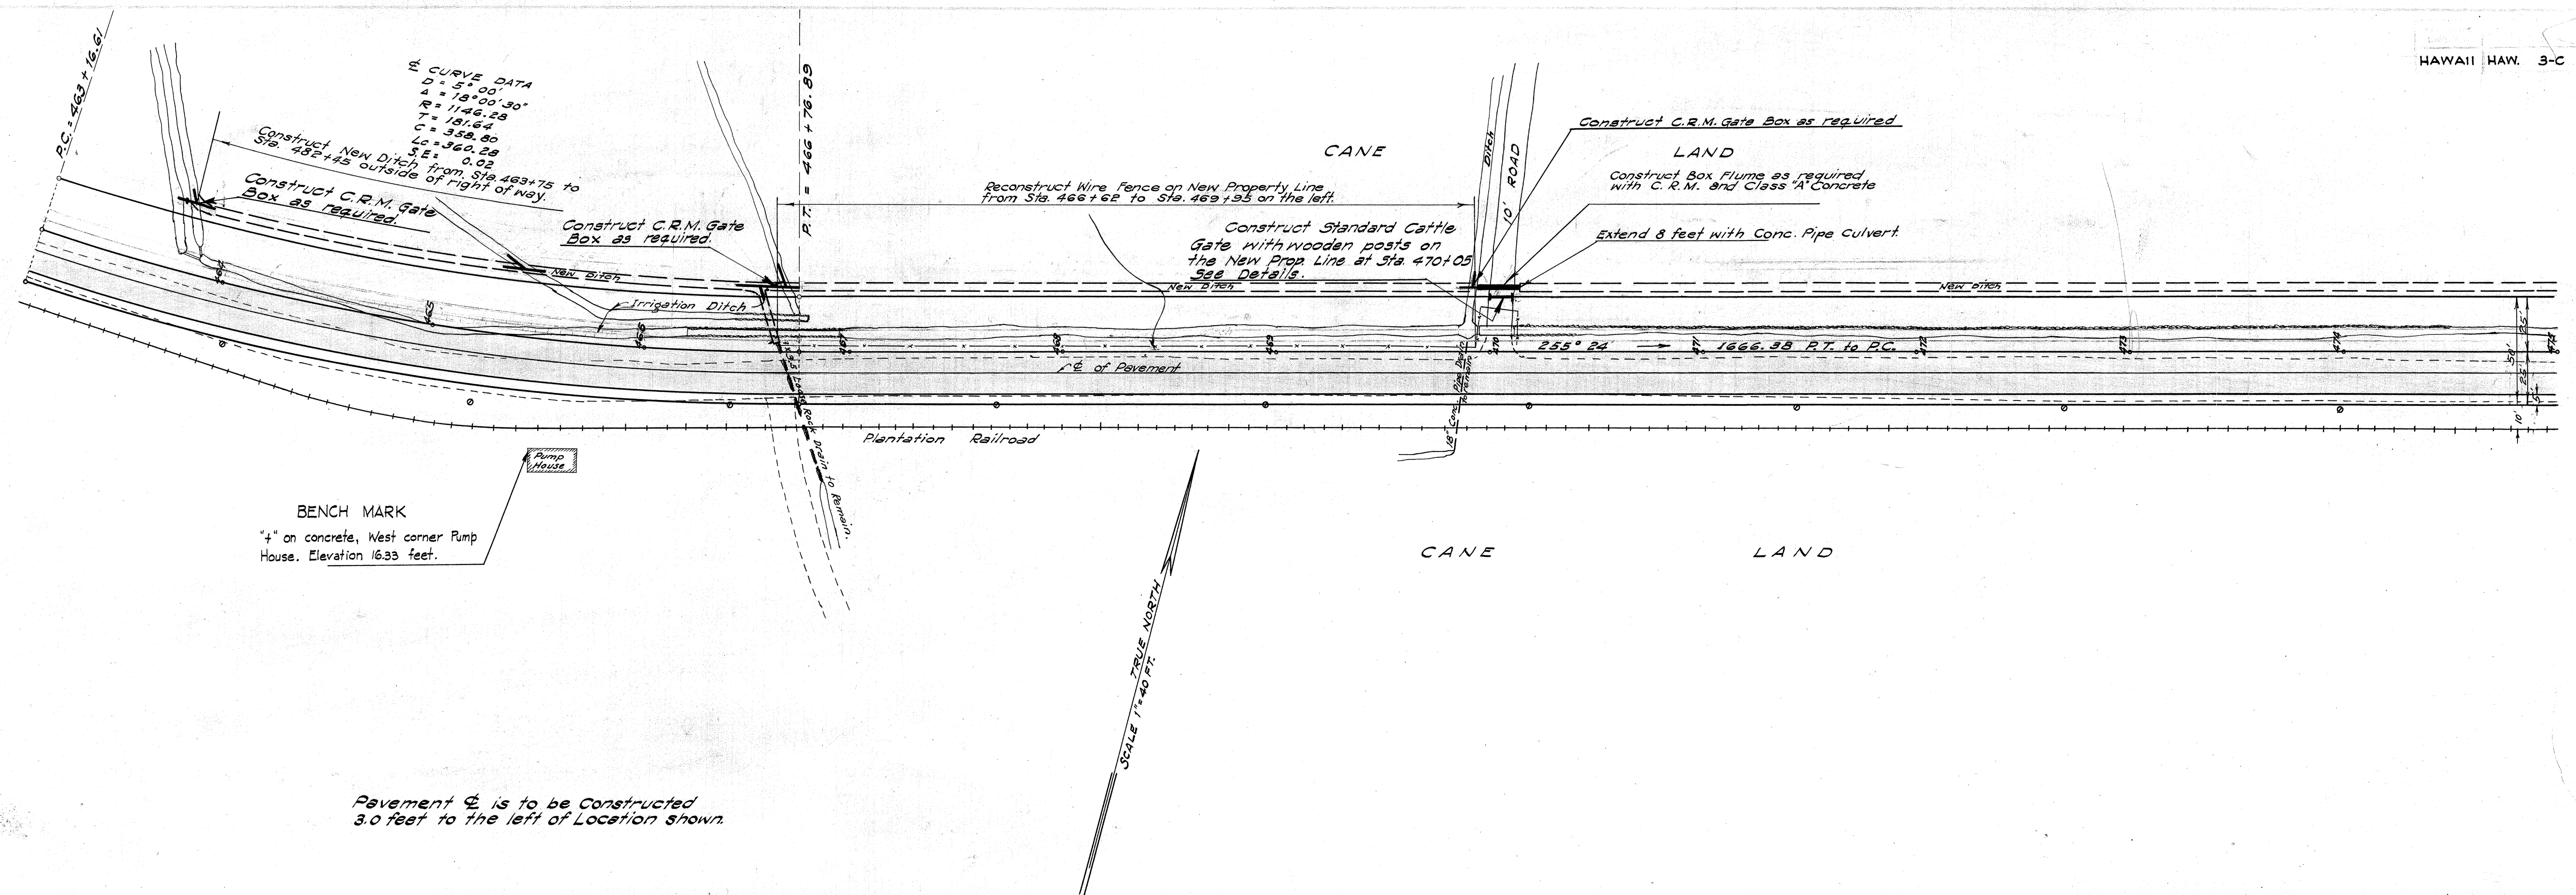

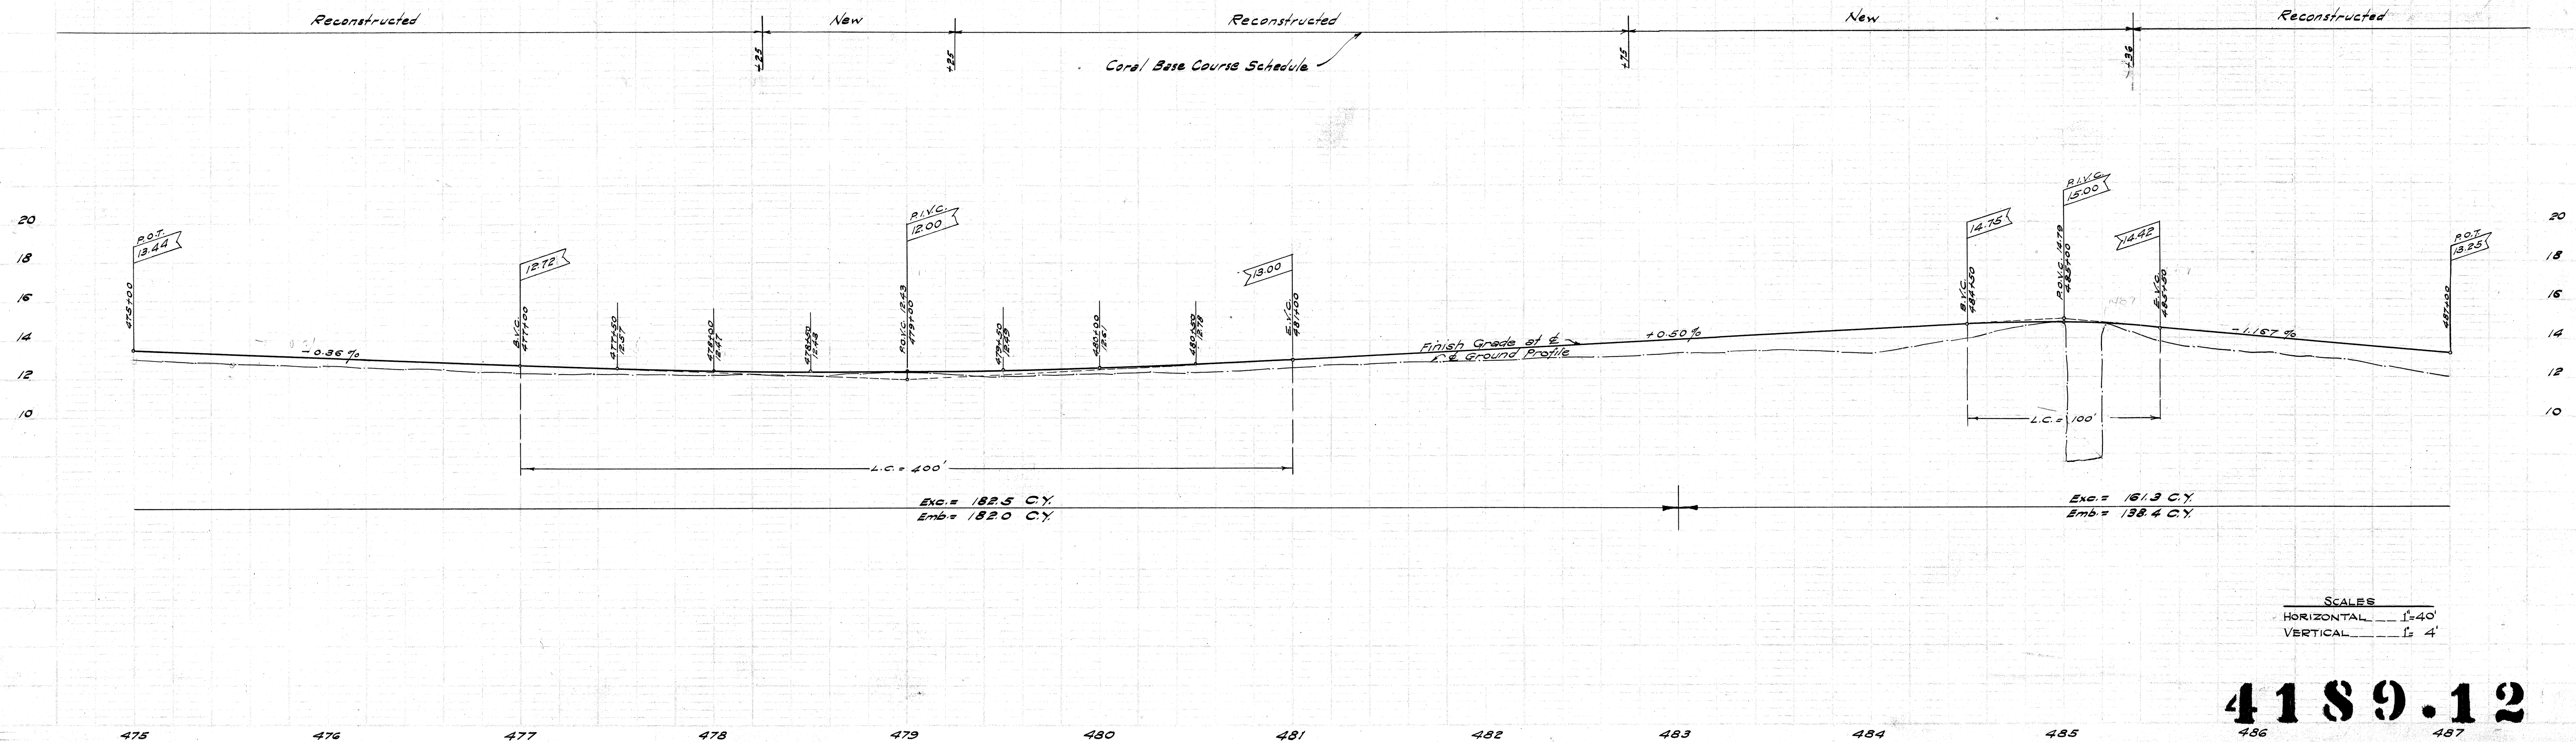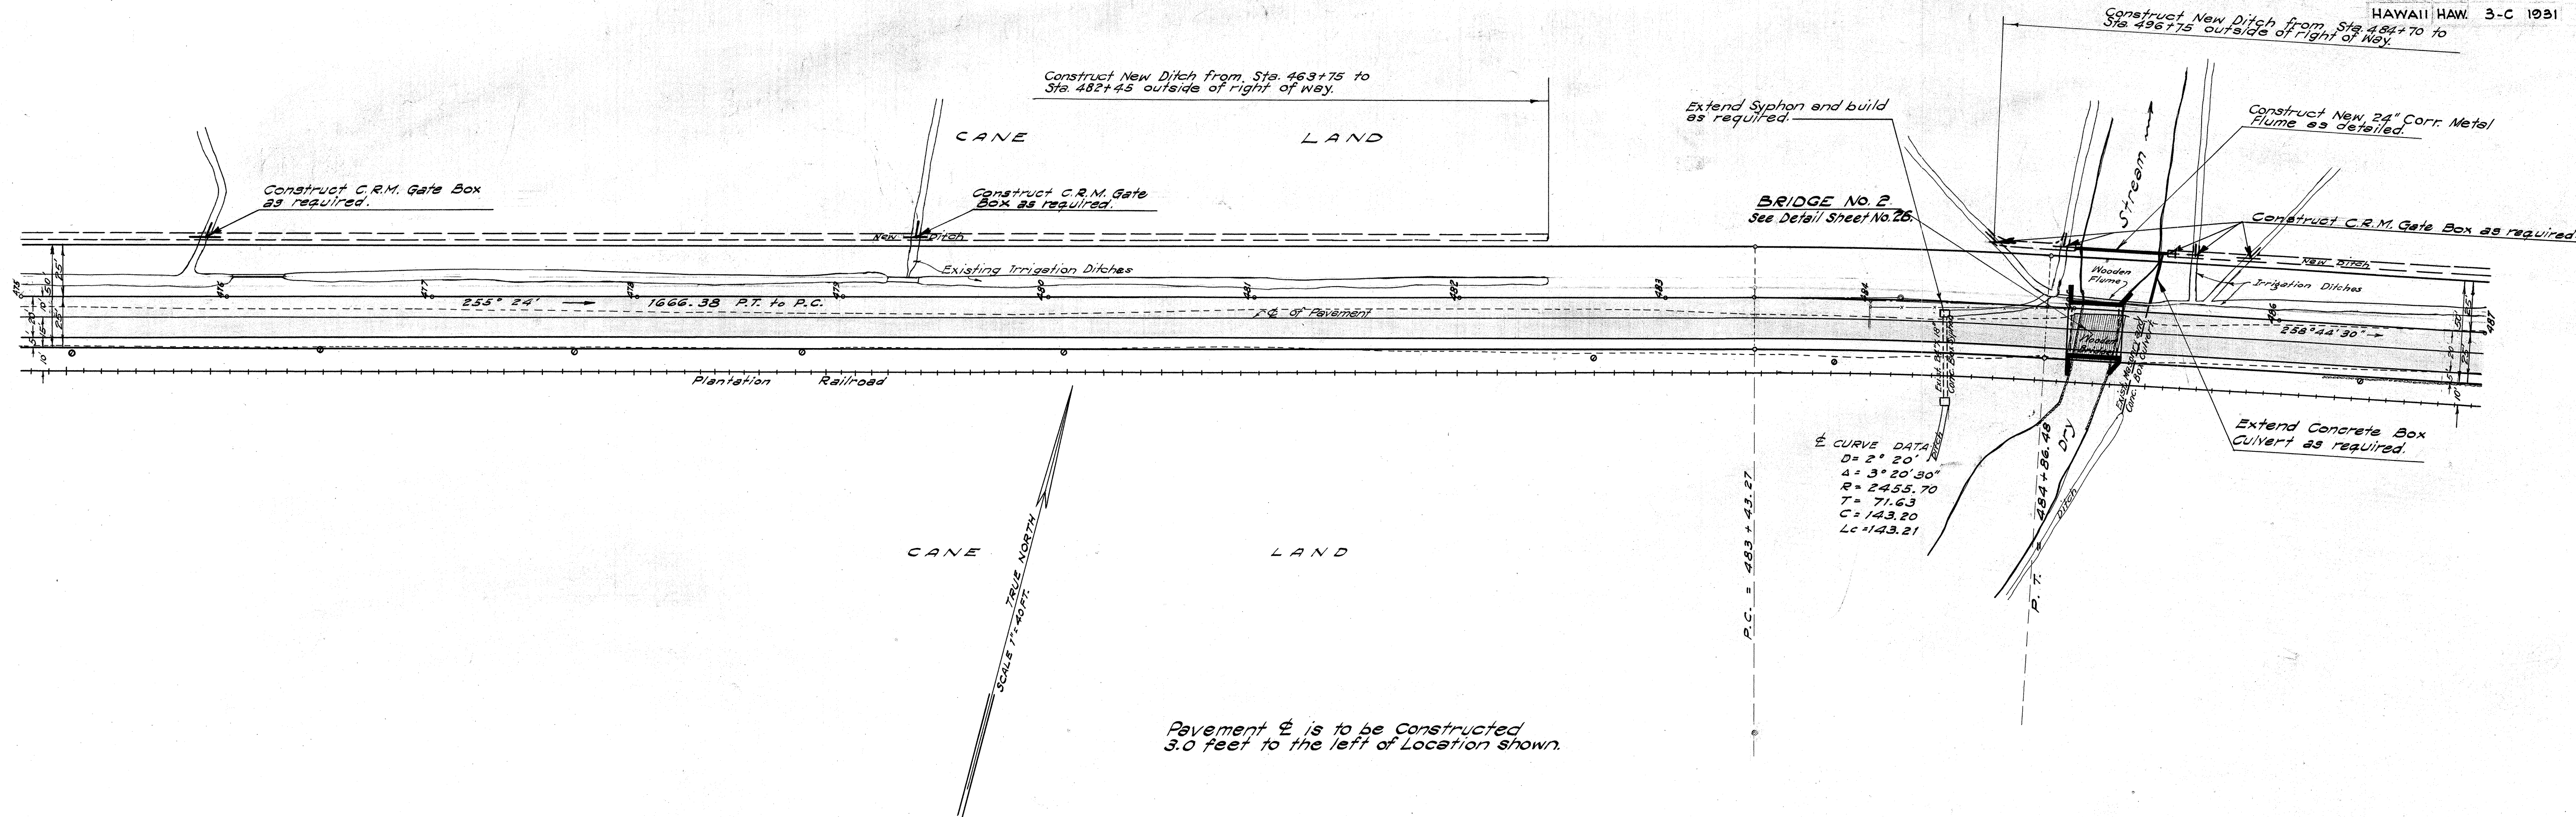



SCALES
HORIZONTAL 1" = 40'
VERTICAL 1" = 4'

4189.12

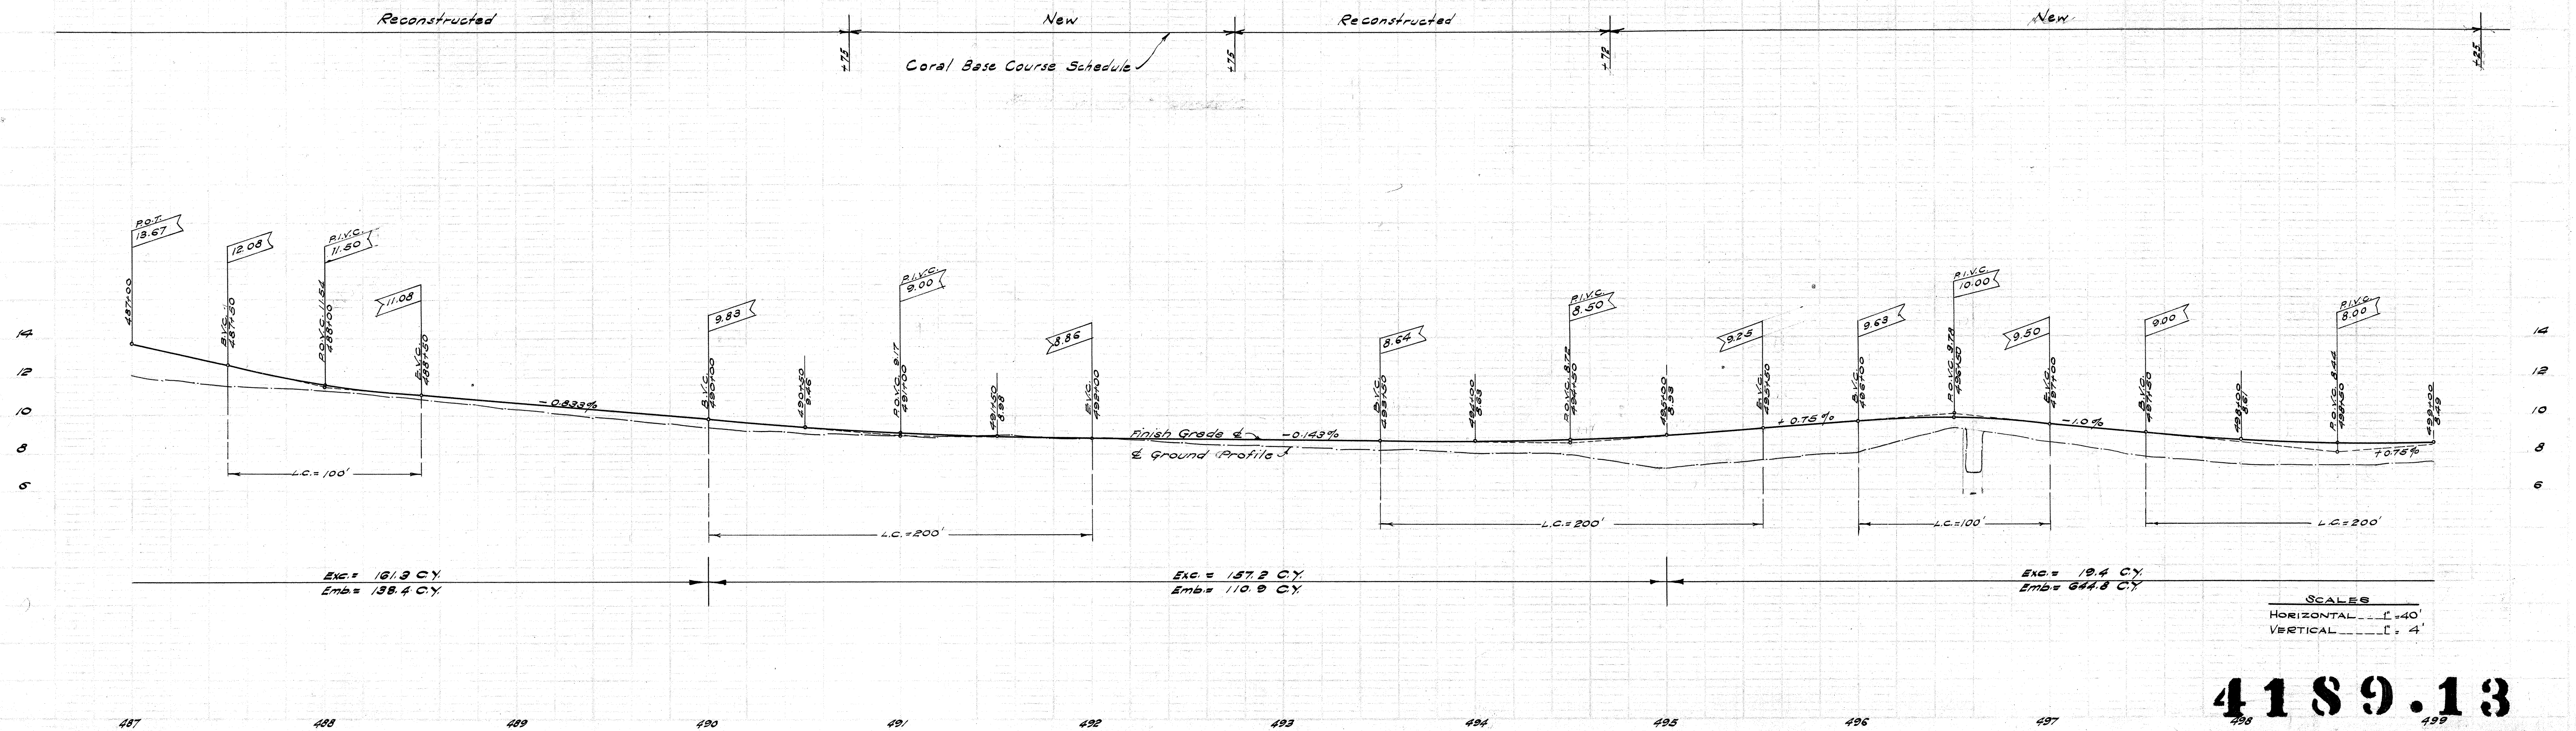
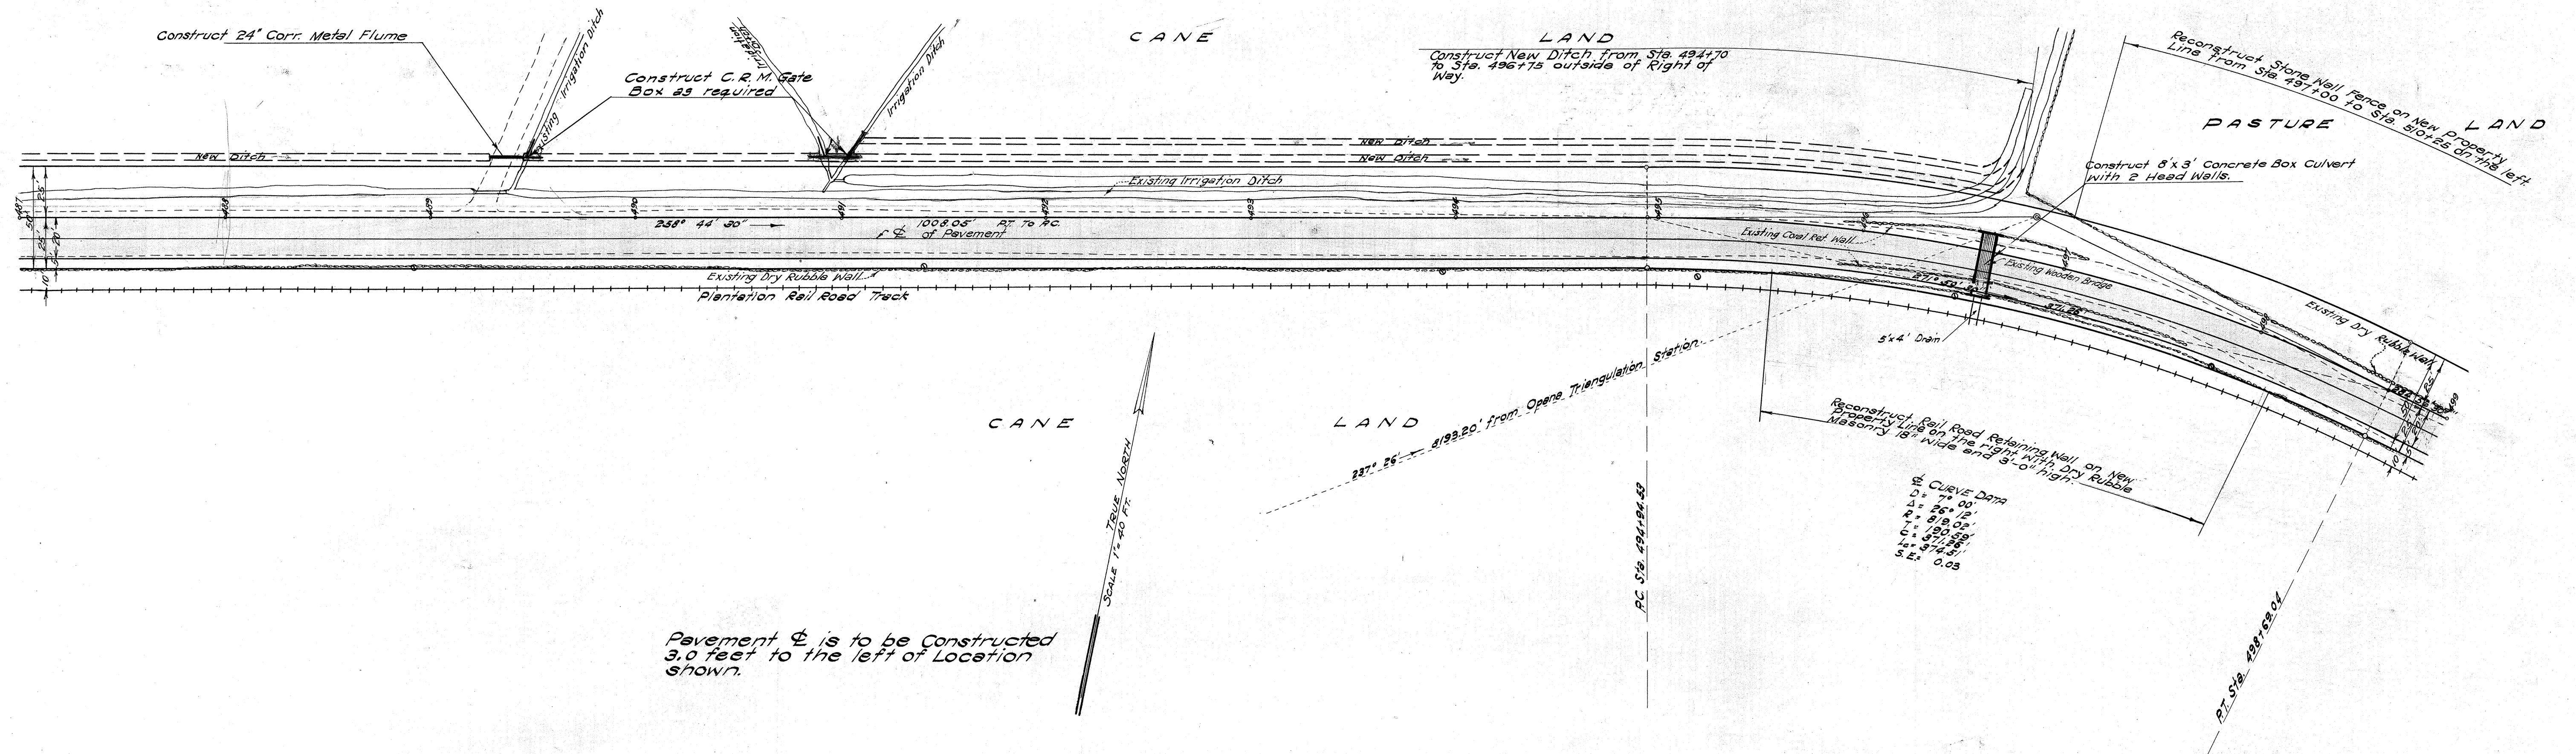



4189.13

BENCH MARK
+ on concrete slab (Guy wire slab
of Wireless Pole) about 75 feet
makai of station 507+70. Elevation 757 feet.

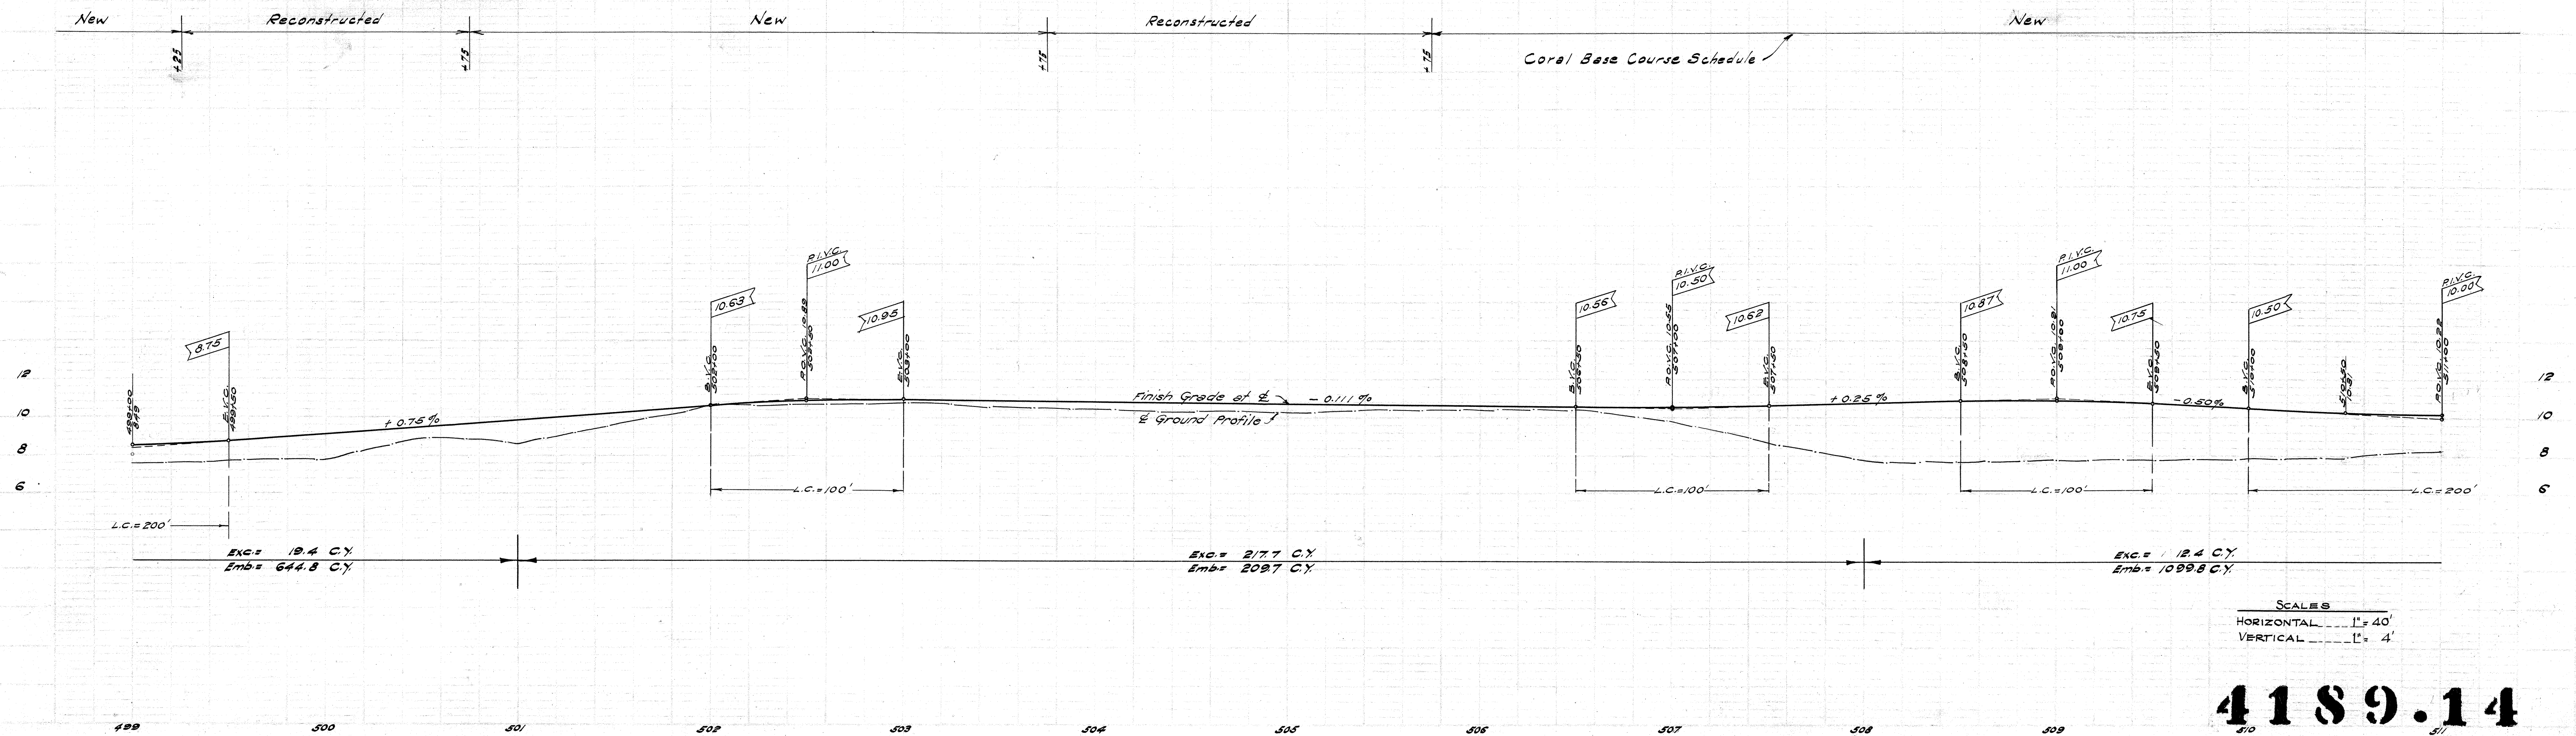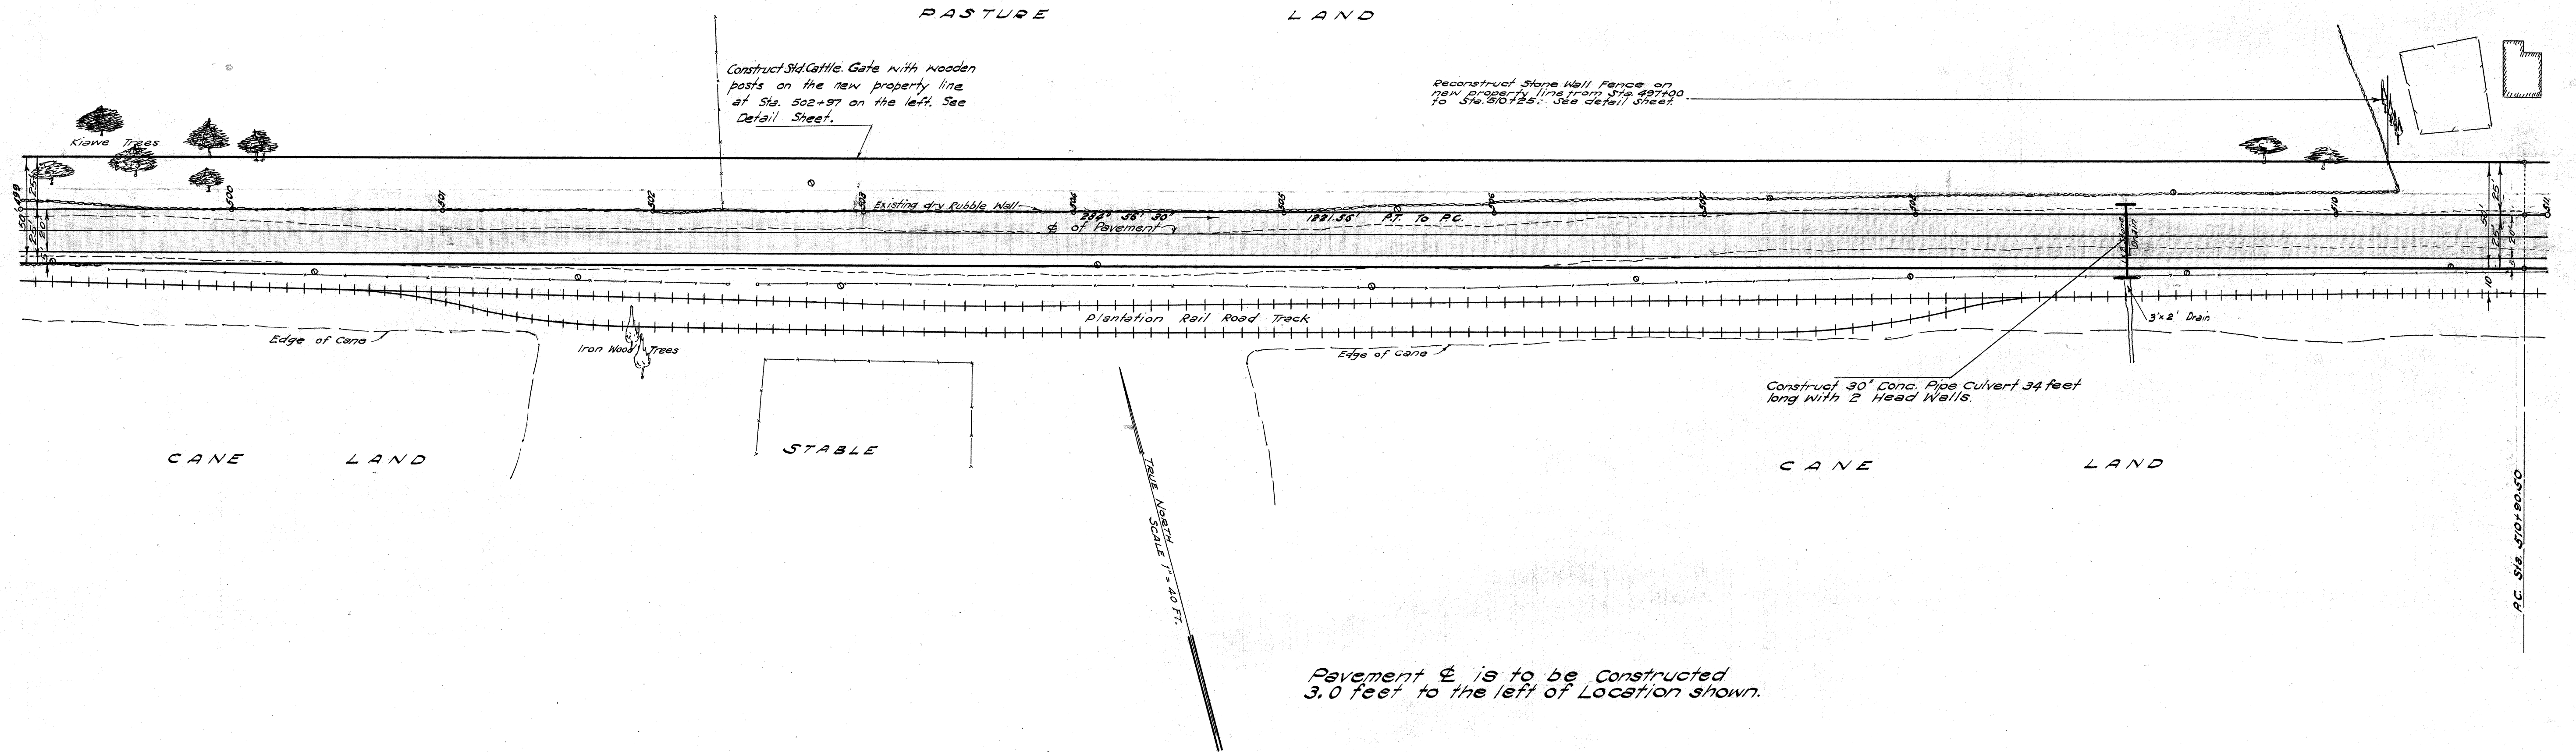


4189.14

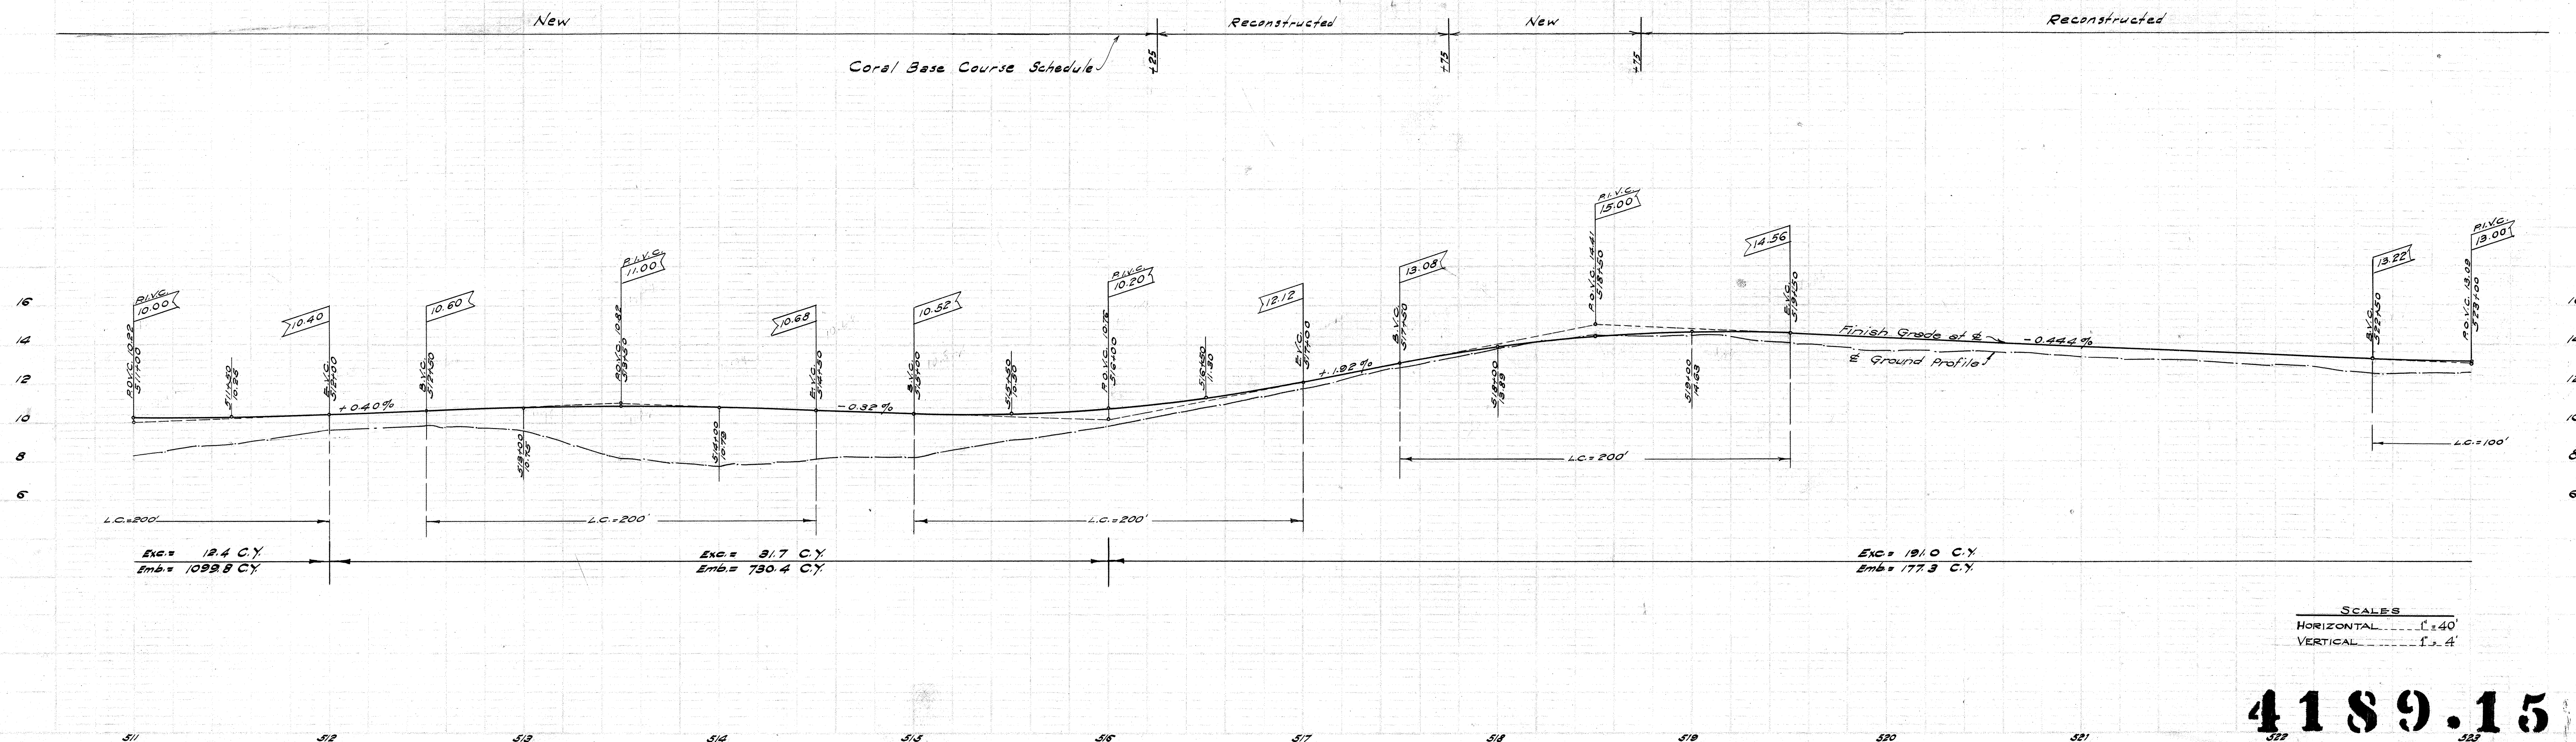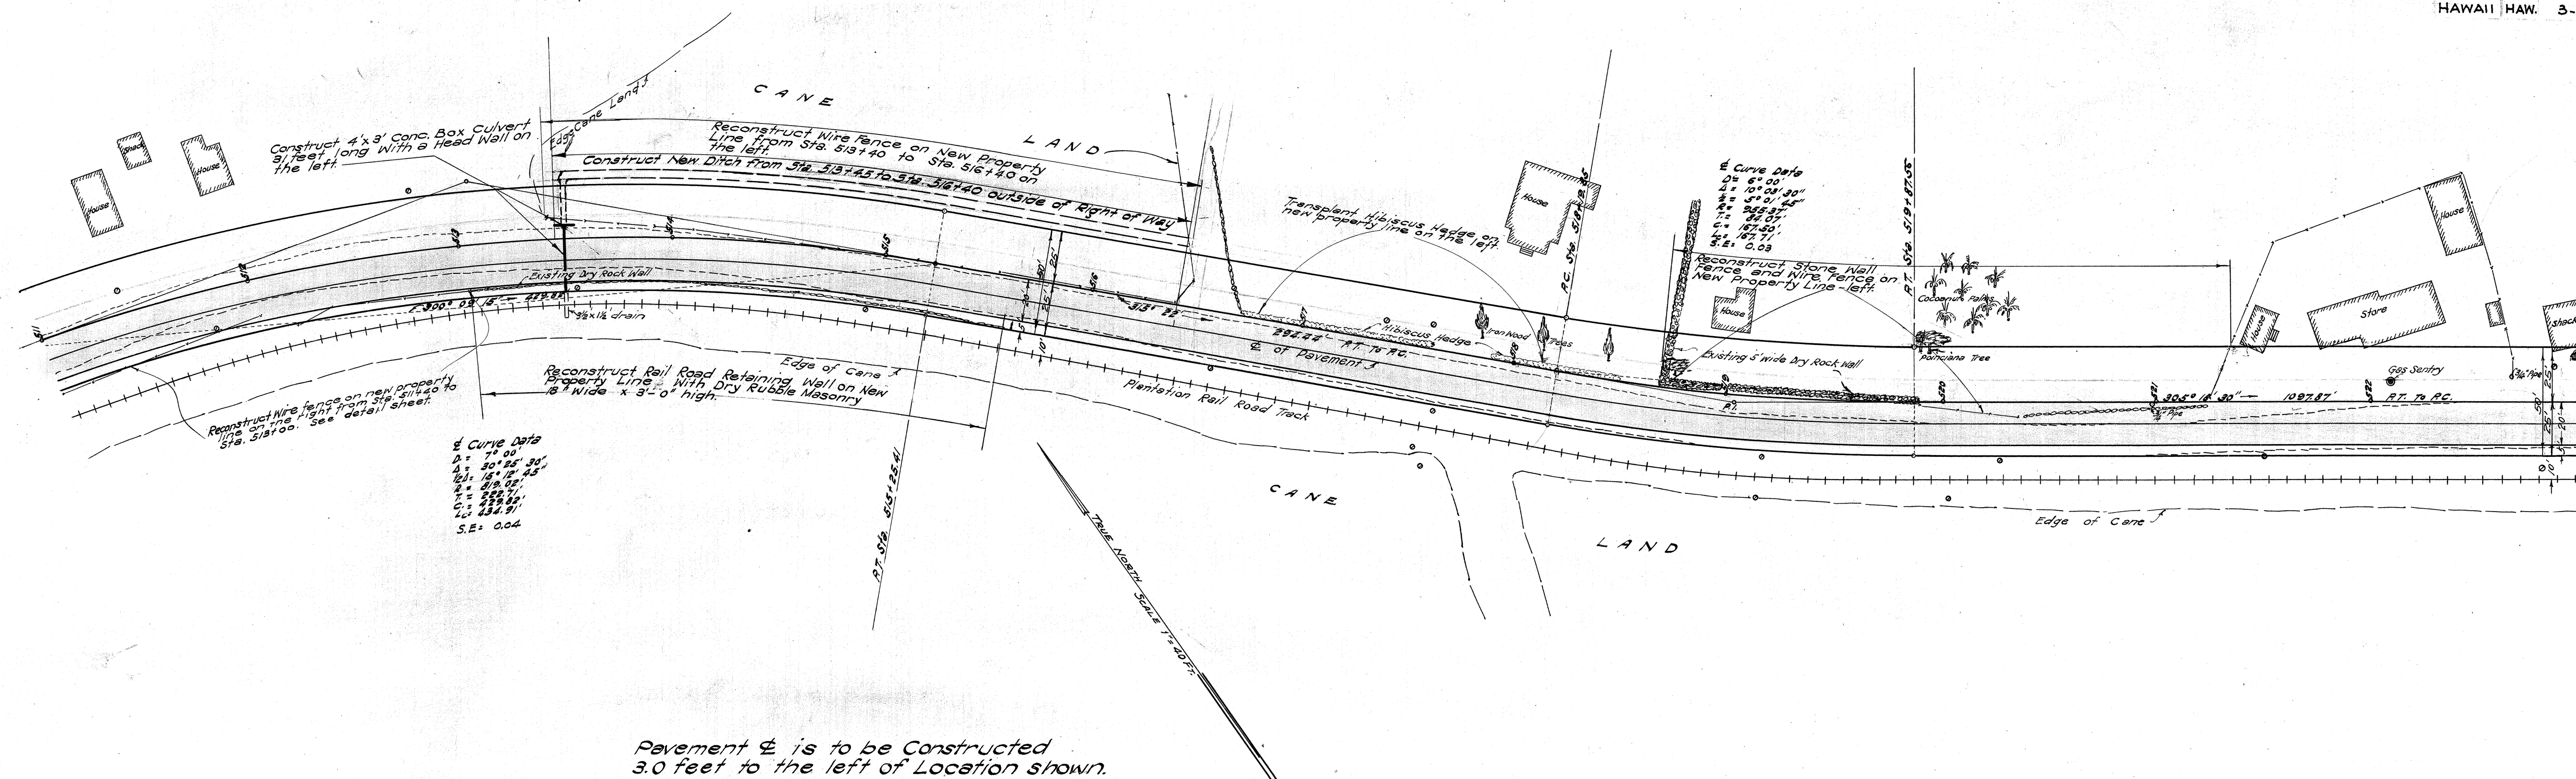


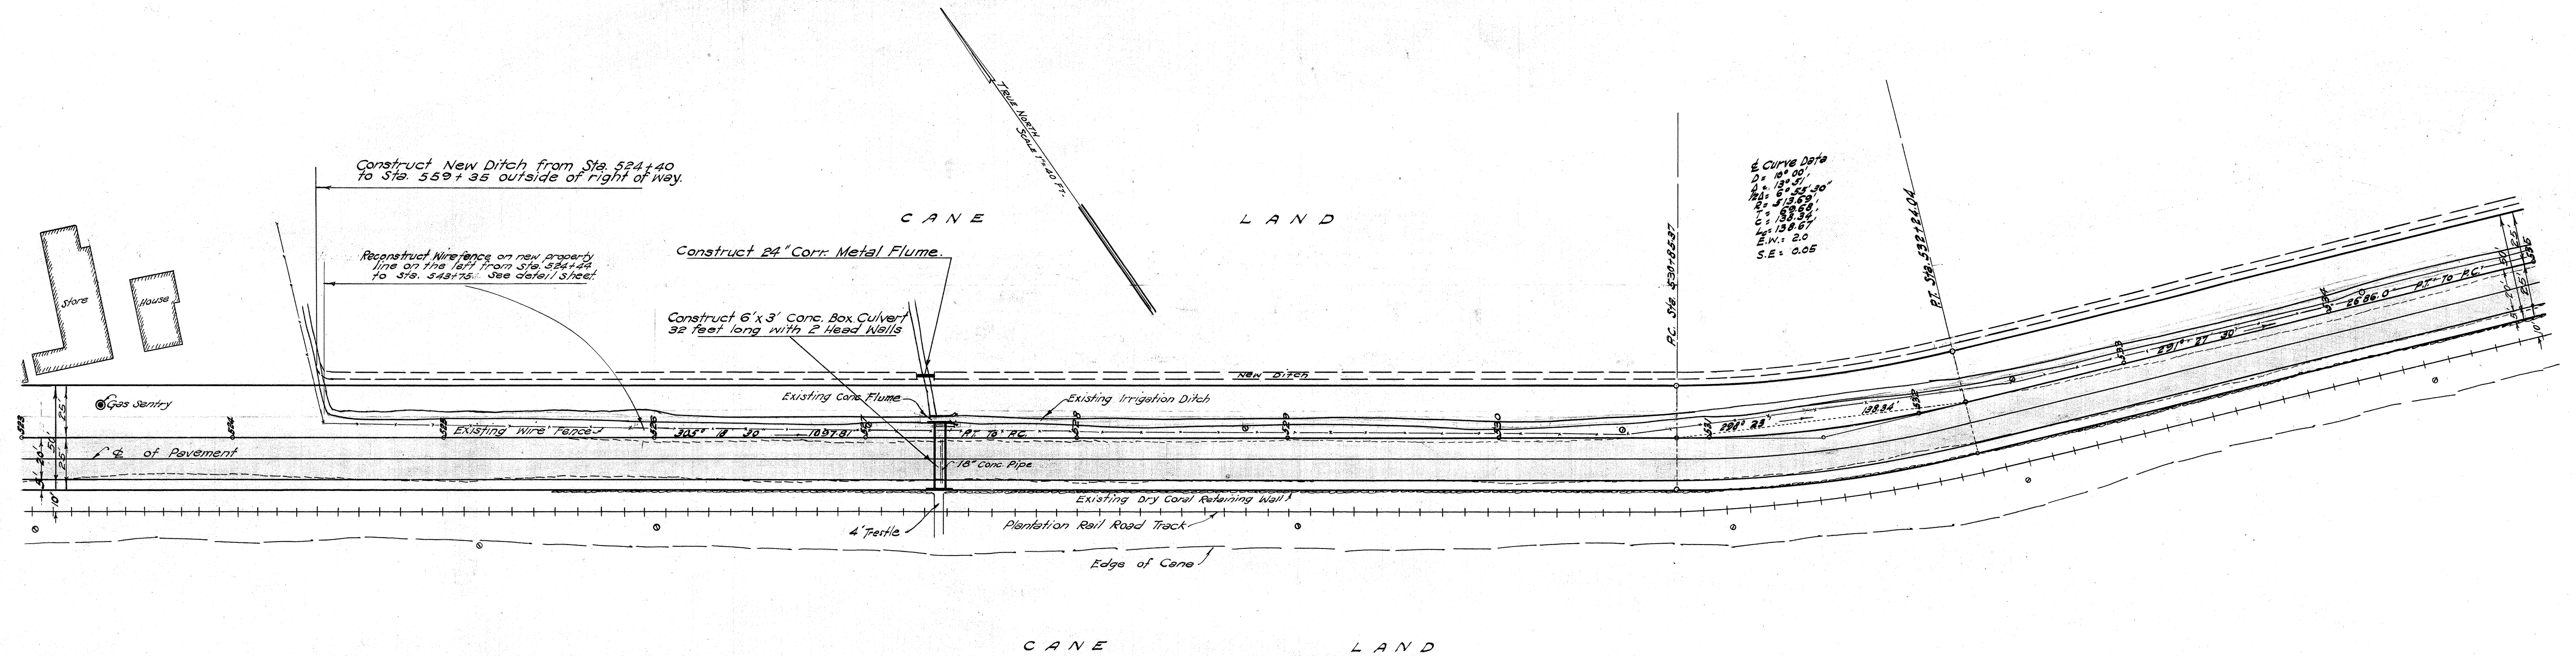


Pavement 2 is to be Constructed 3.0 feet to the left of Location shown.

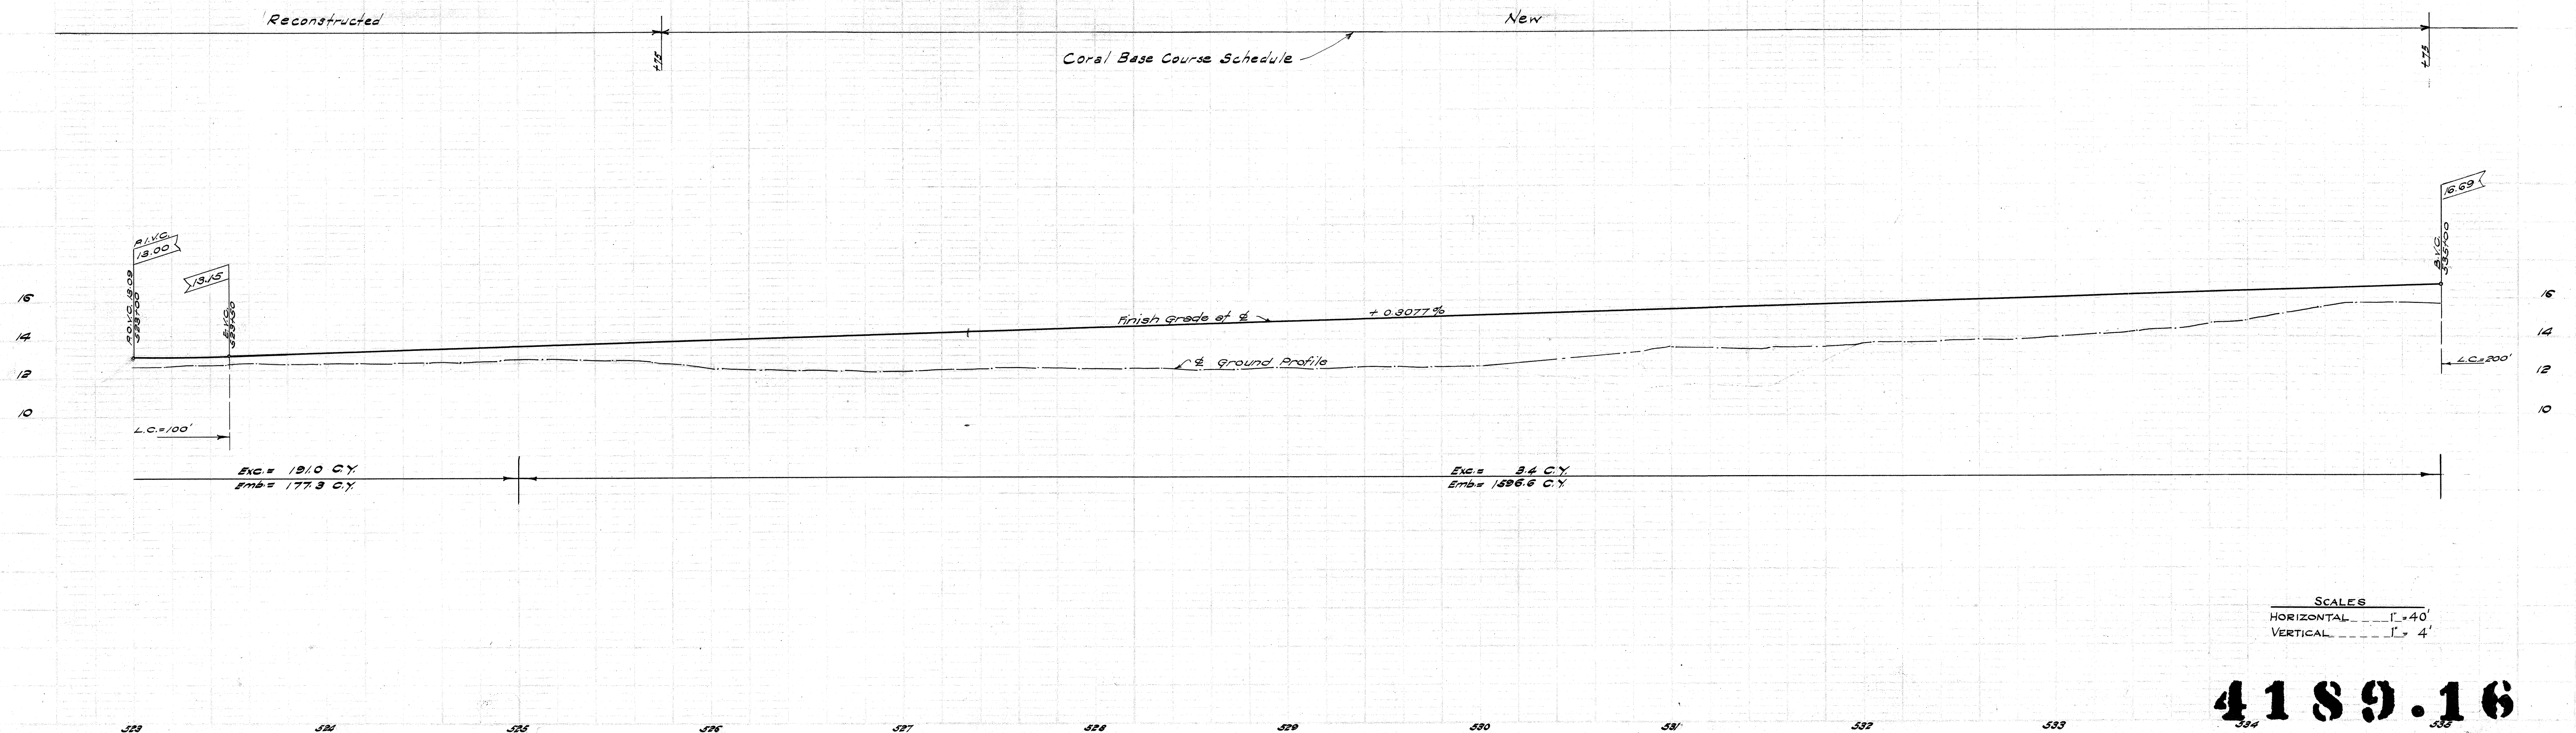



4189.16

BENCH MARK M 4
 About 22 meters toward Haleiwa from Kahuku of
 Marconi Waiting Station (Kahuku Wireless Station) of
 the Oahu Railroad and Land Co., 25 feet north of the
 track 7 feet toward Kahuku from the Station plat-
 form and 2 feet outside of the right-of-way fence.
 Stamped M. 4 1027 and set in the top of a con-
 crete dist (2.693 meters or 8.835 feet.

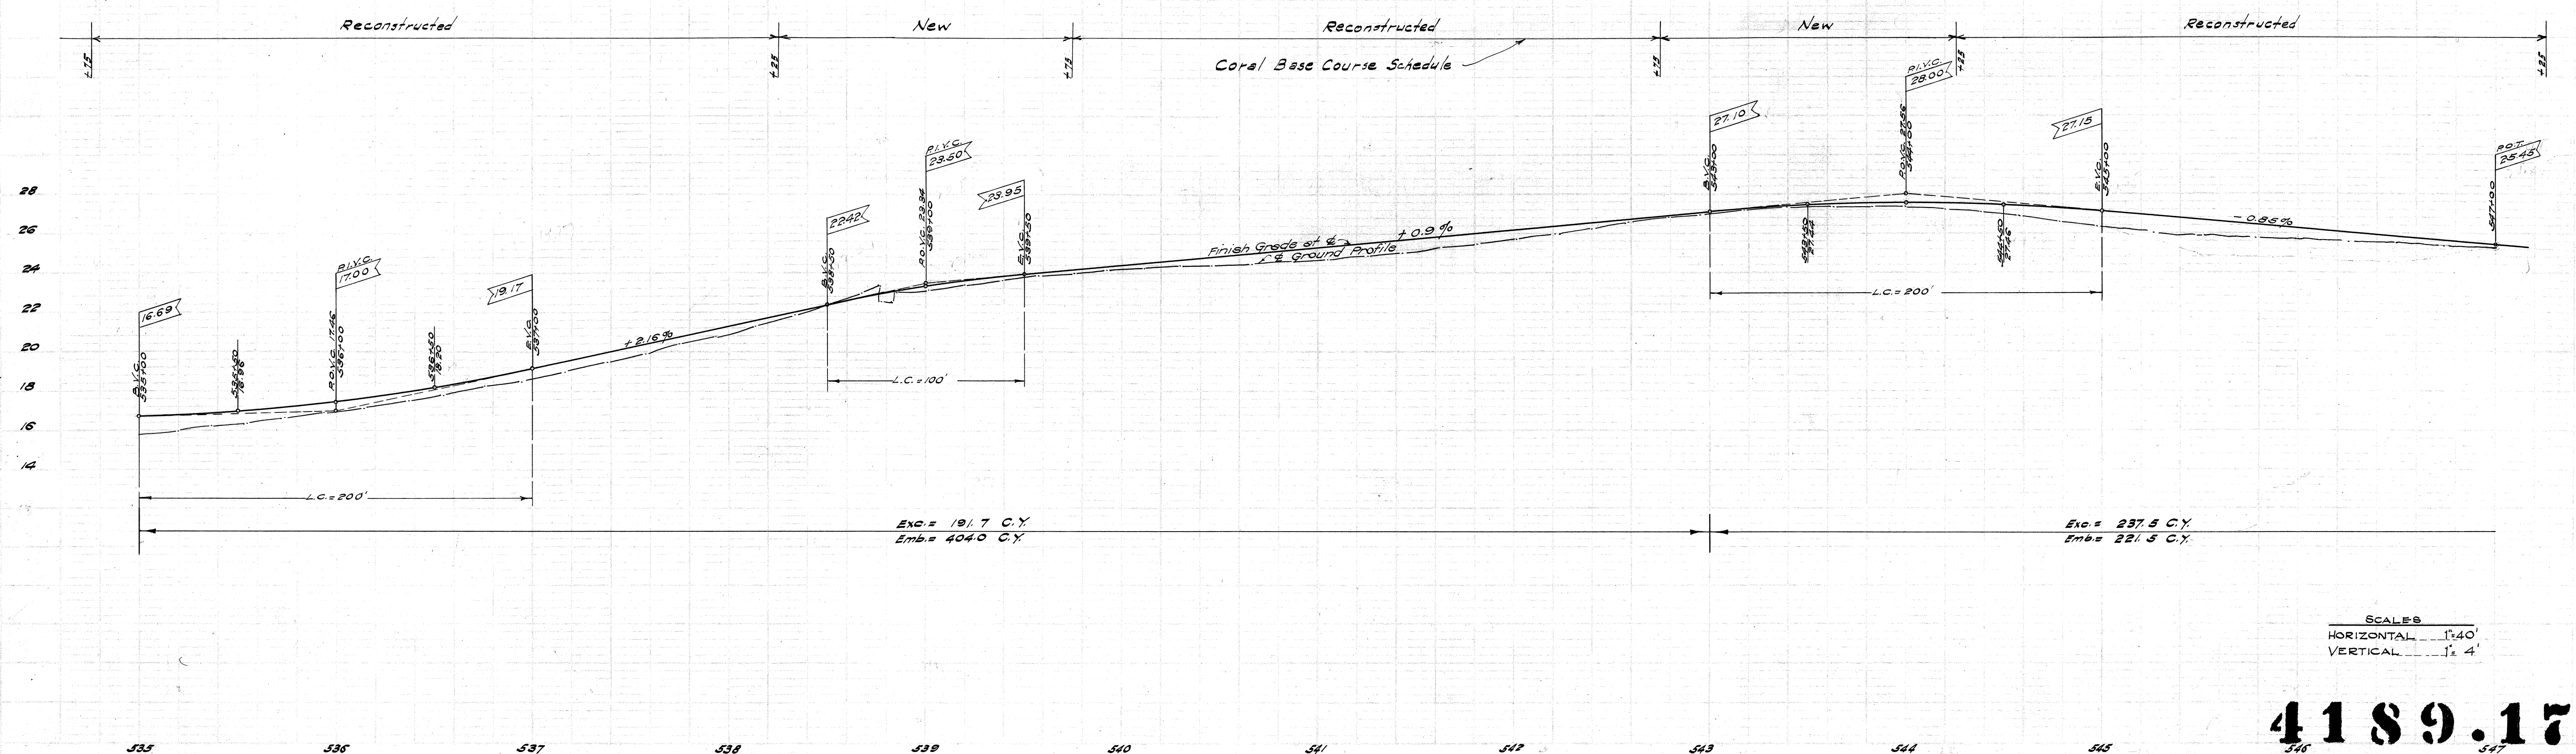
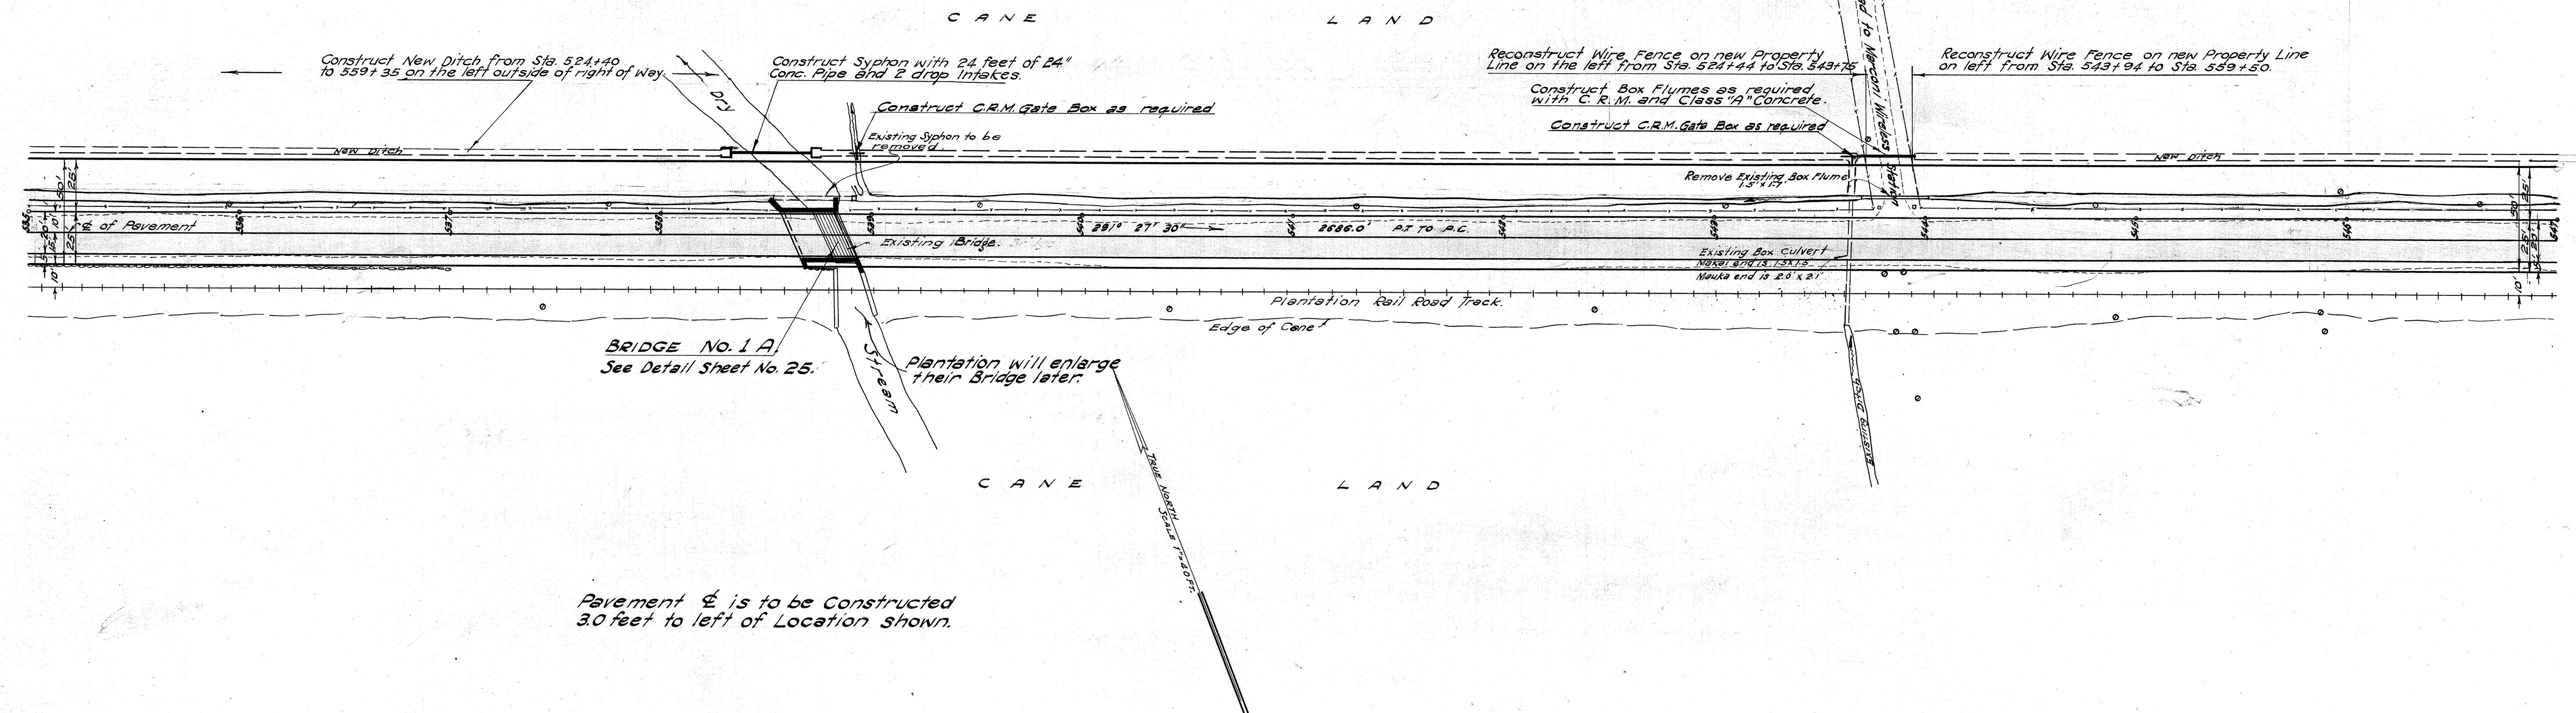


SCALES
 HORIZONTAL 1"=40'
 VERTICAL 1"=4'



4189.17

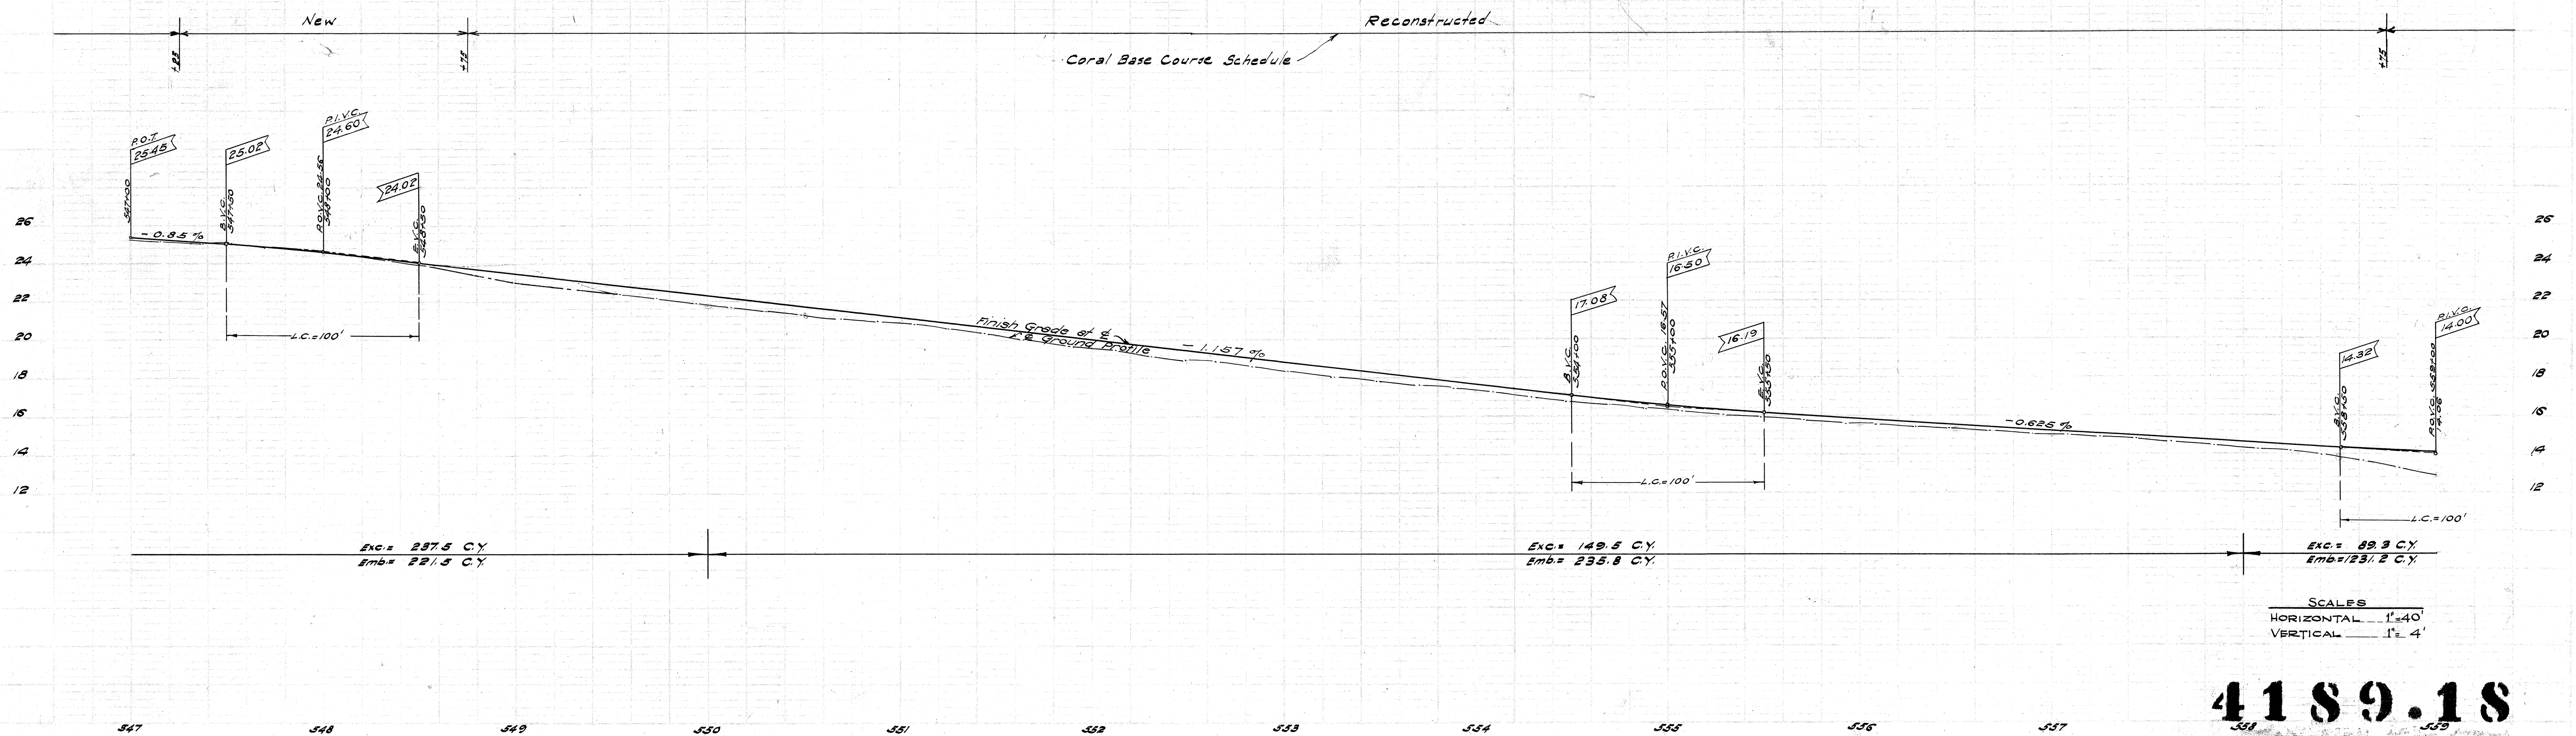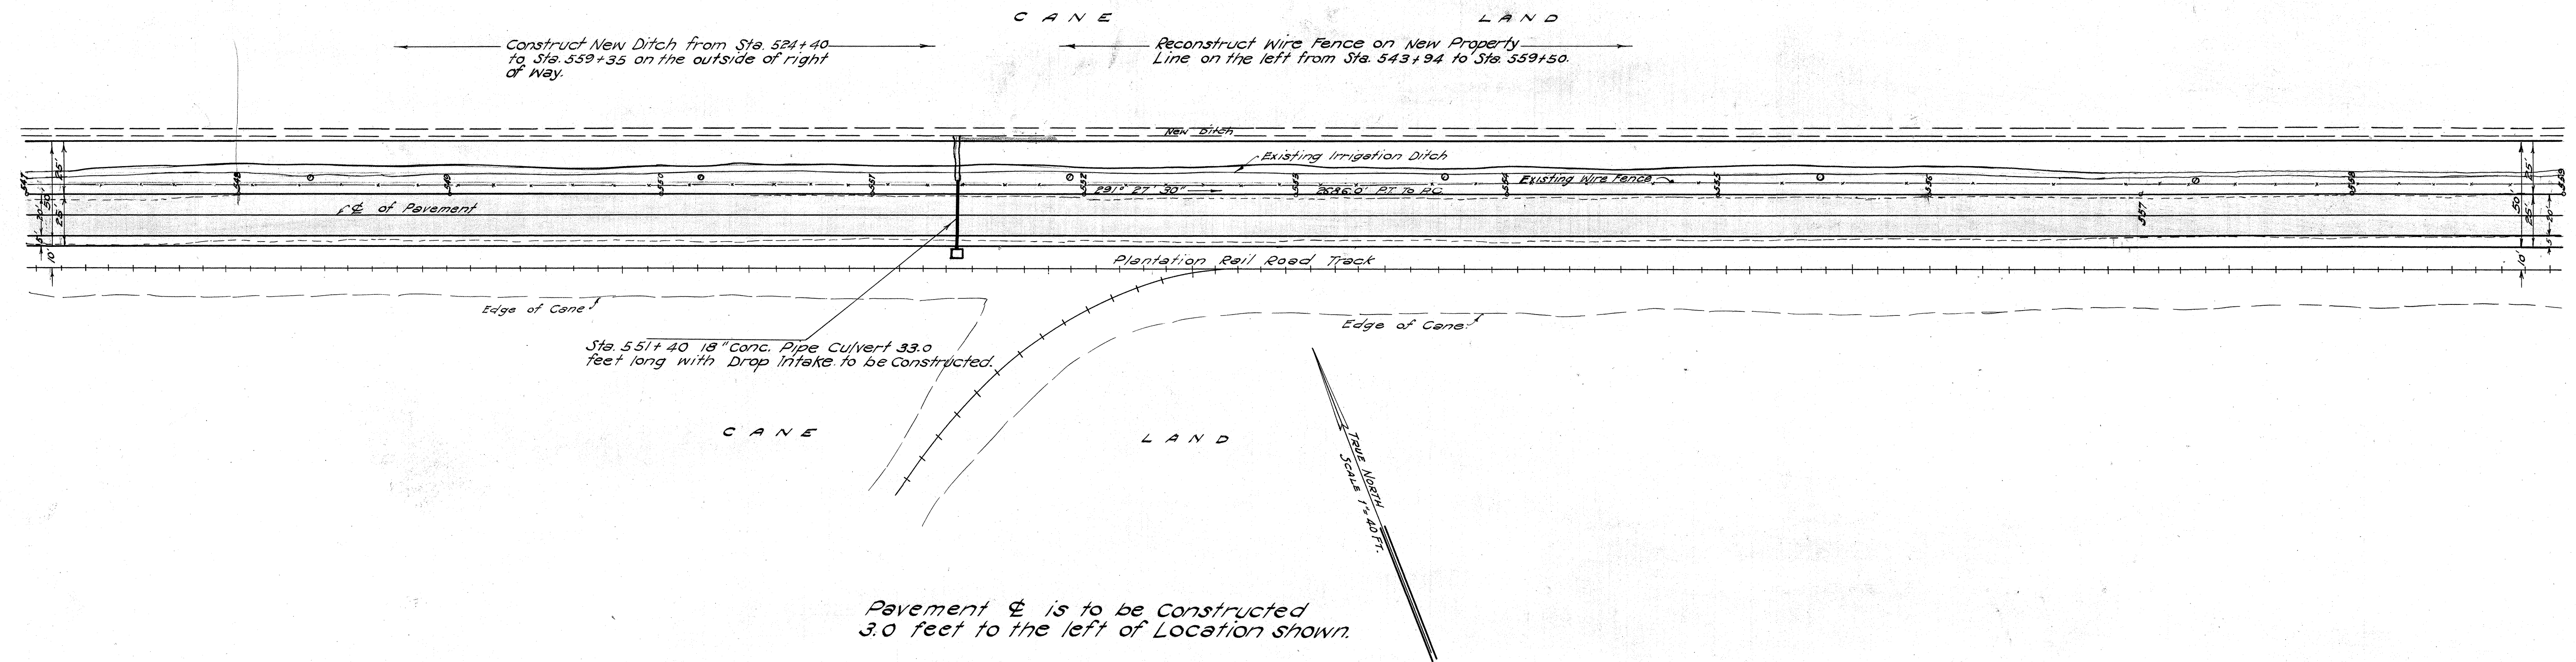

4189.18

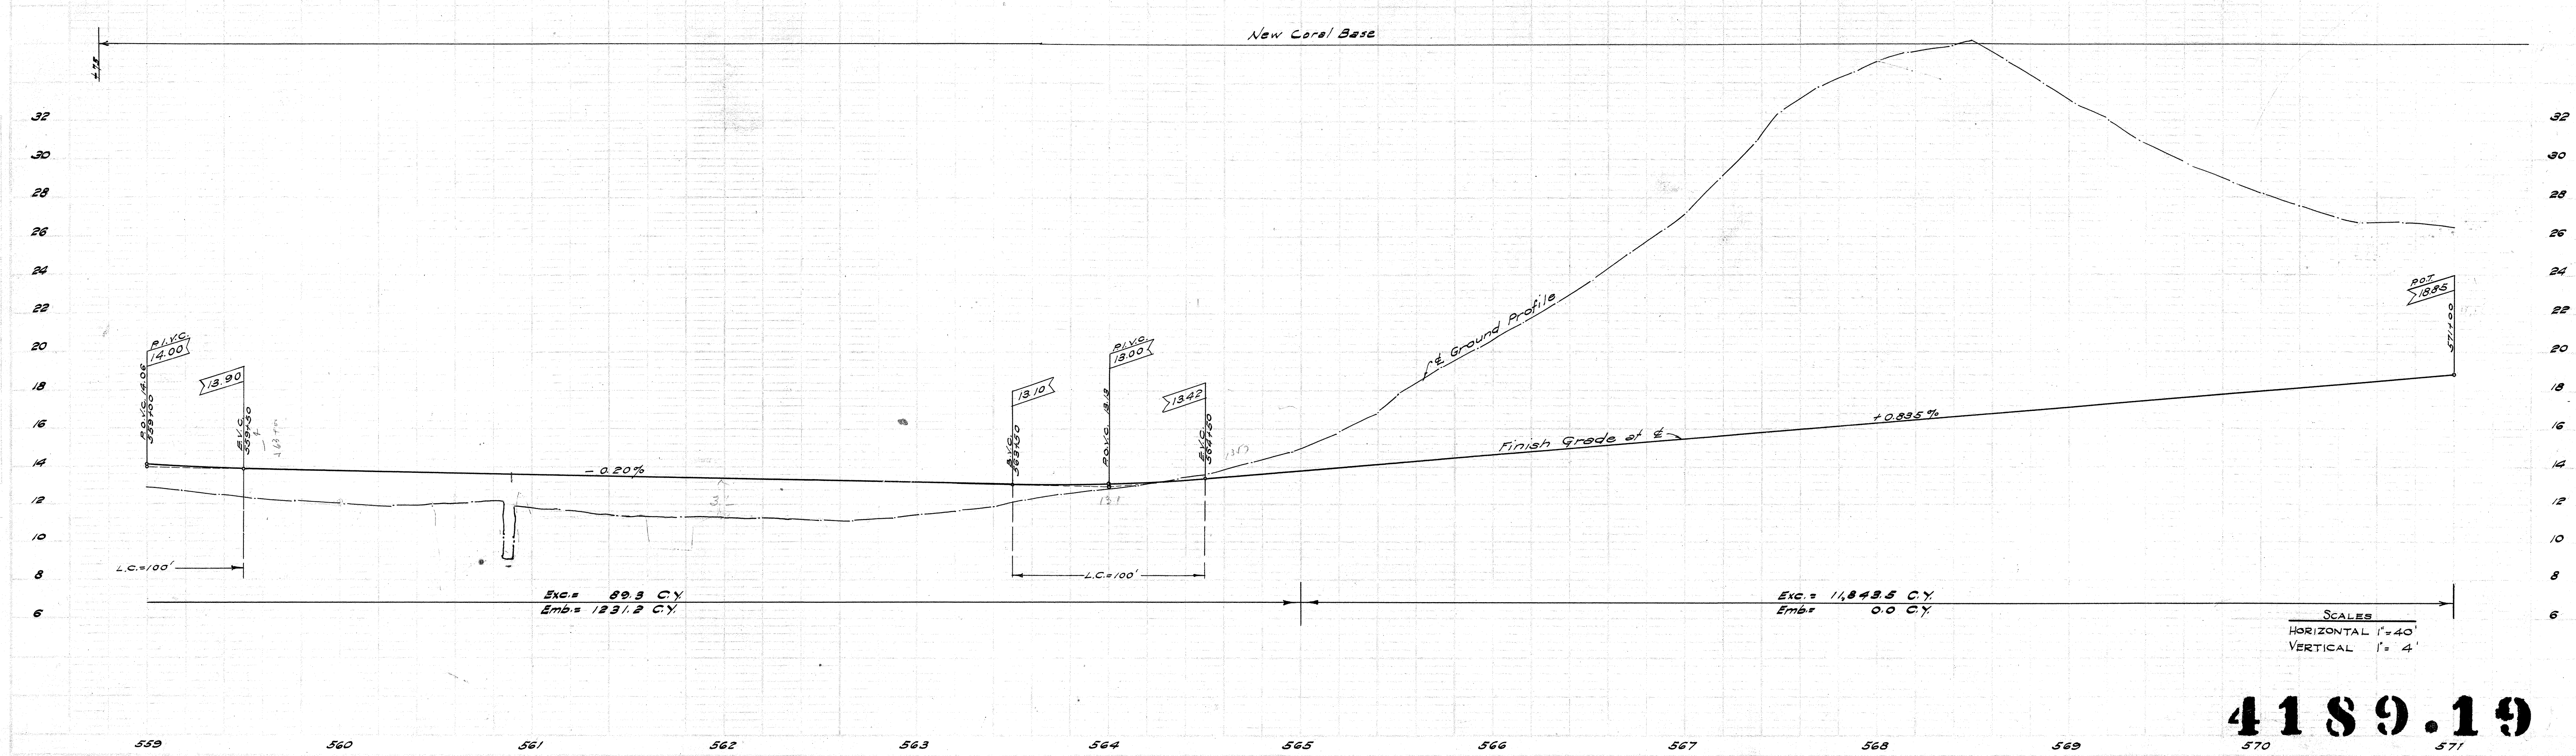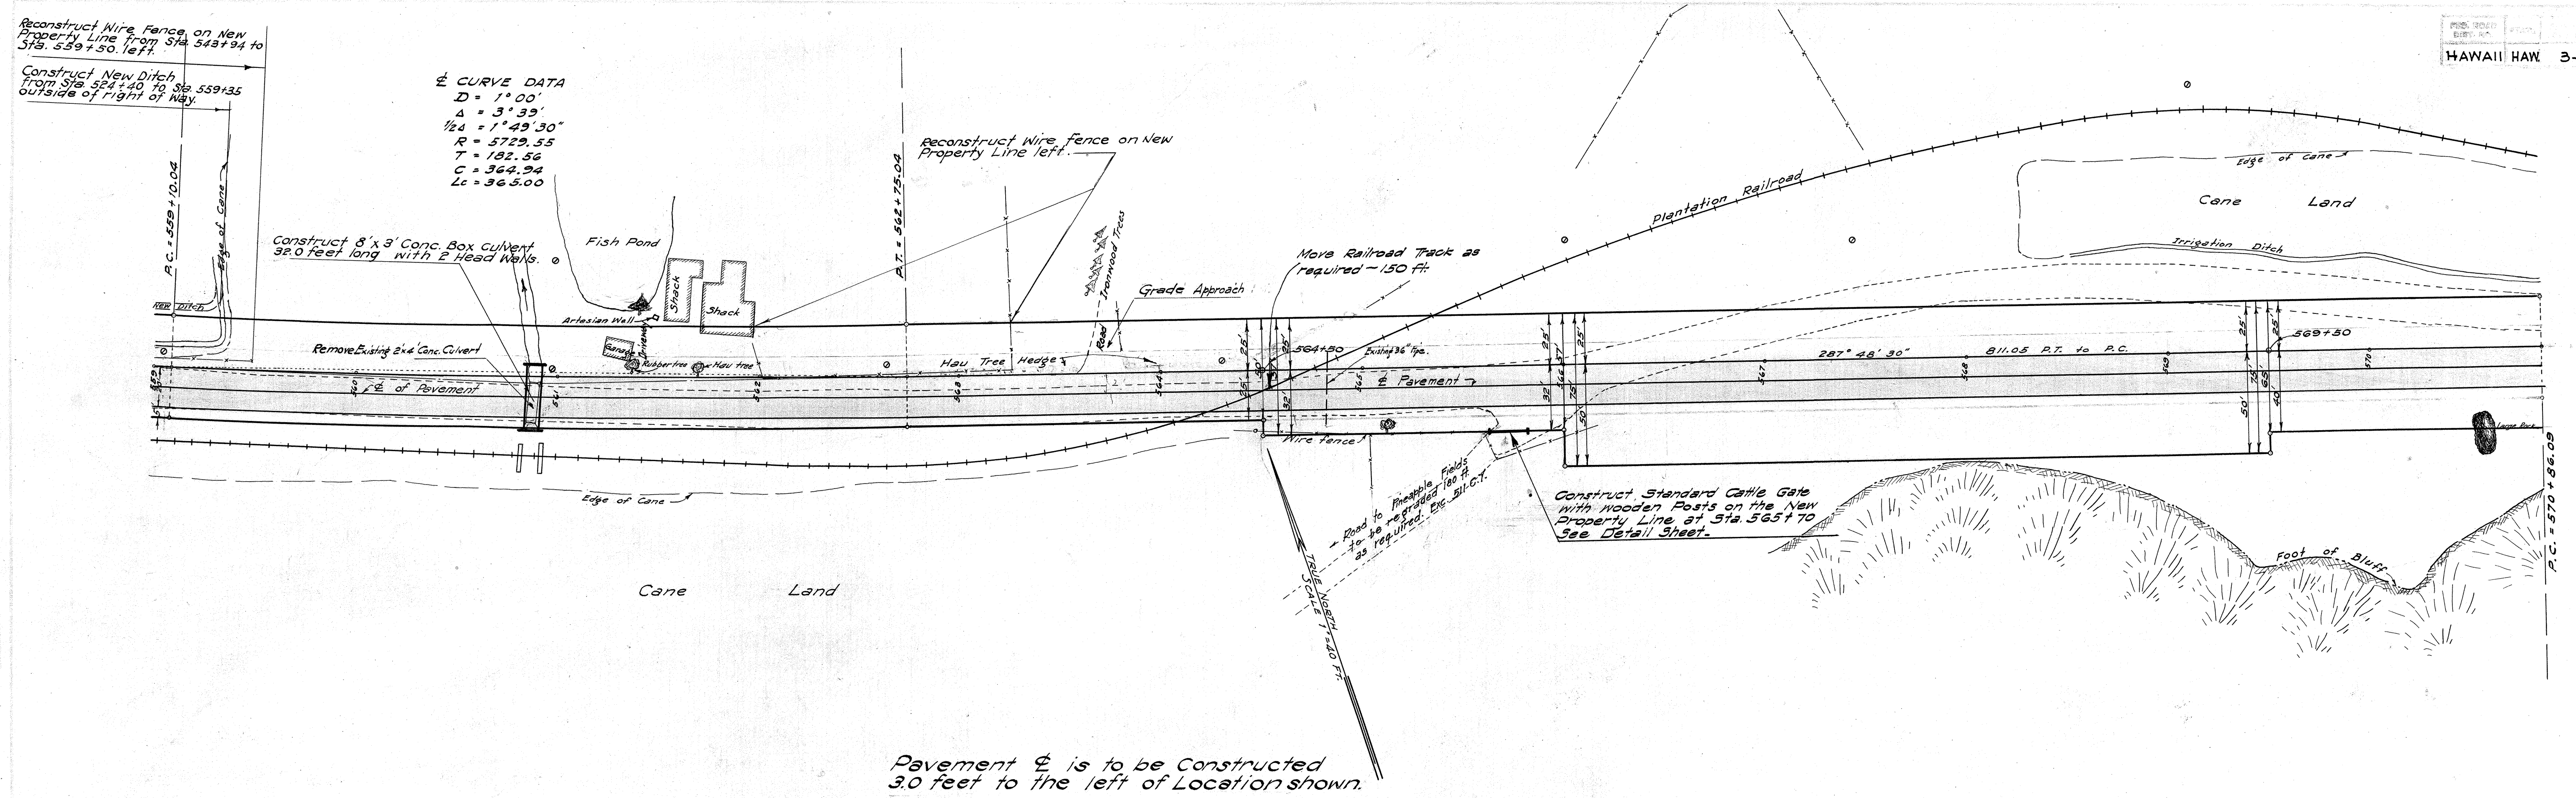

4189.19

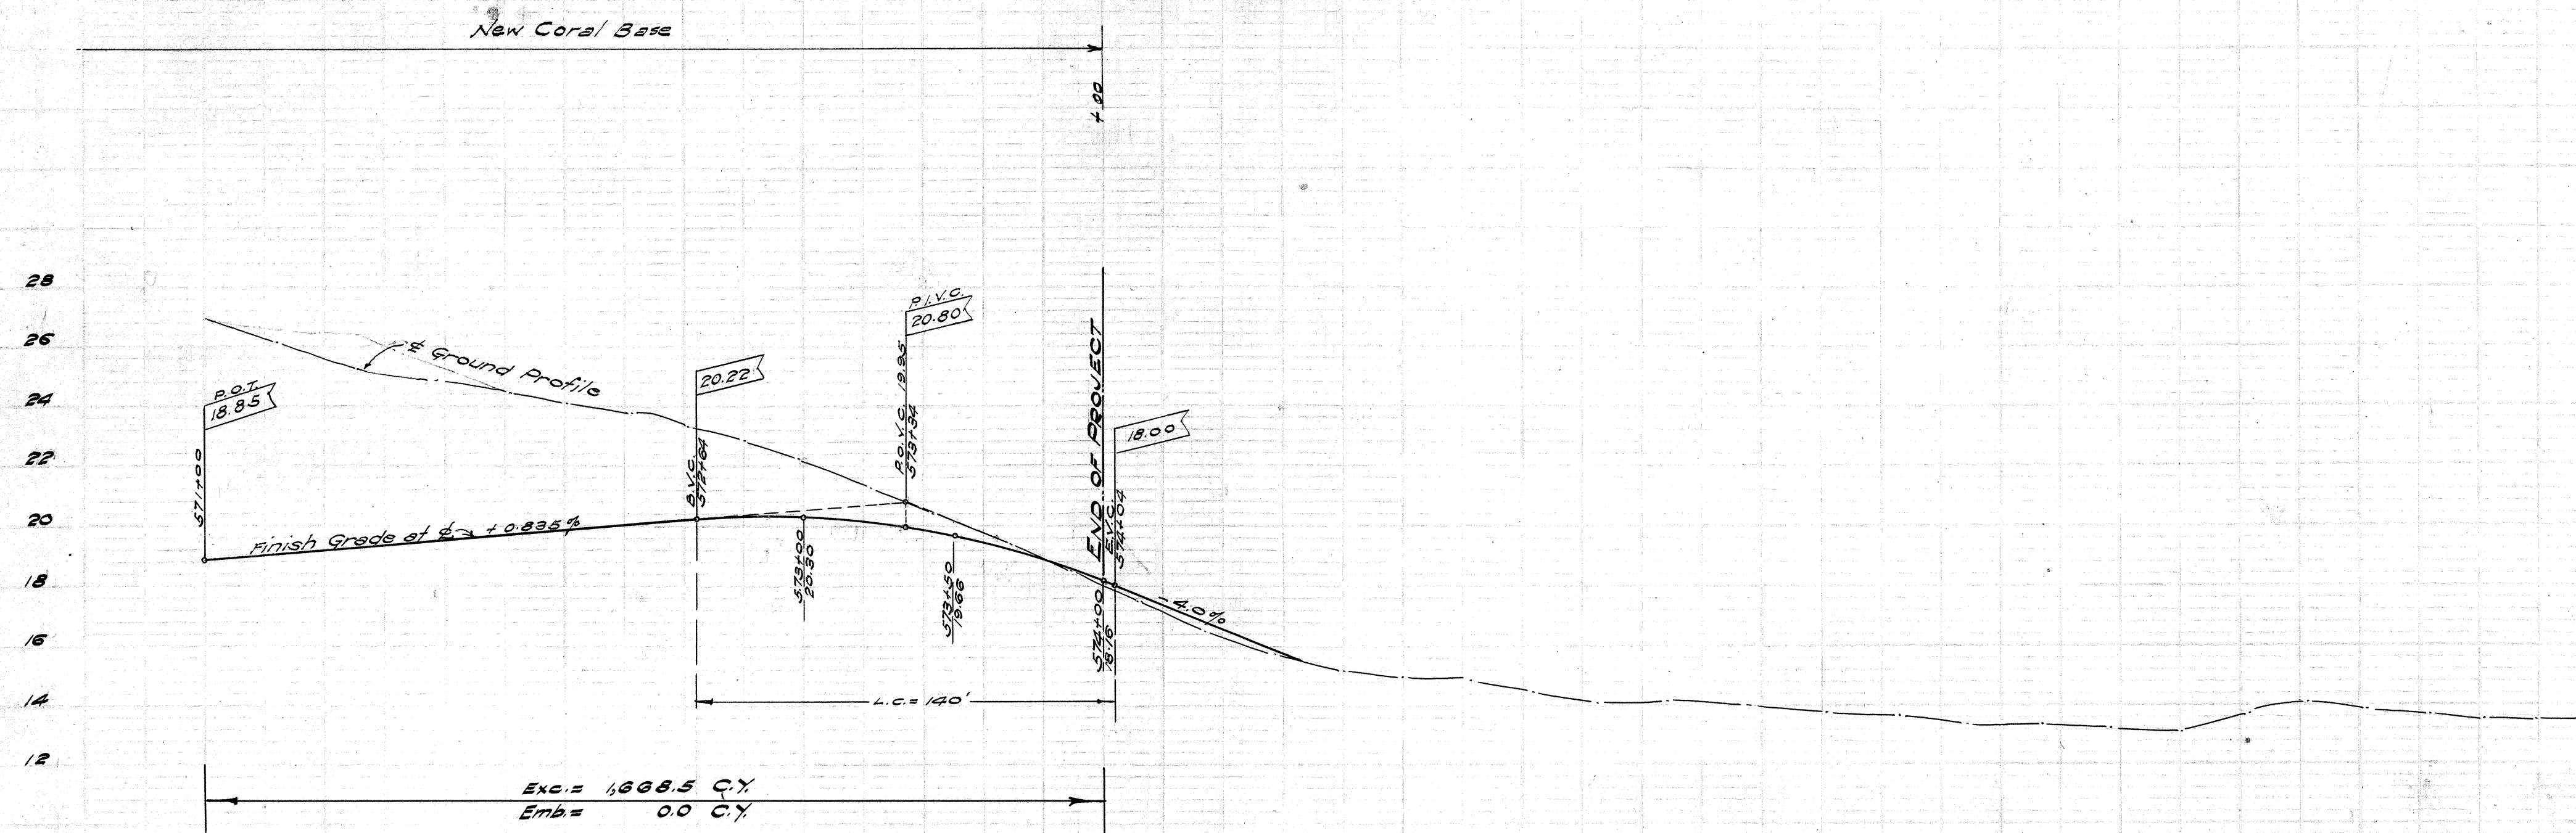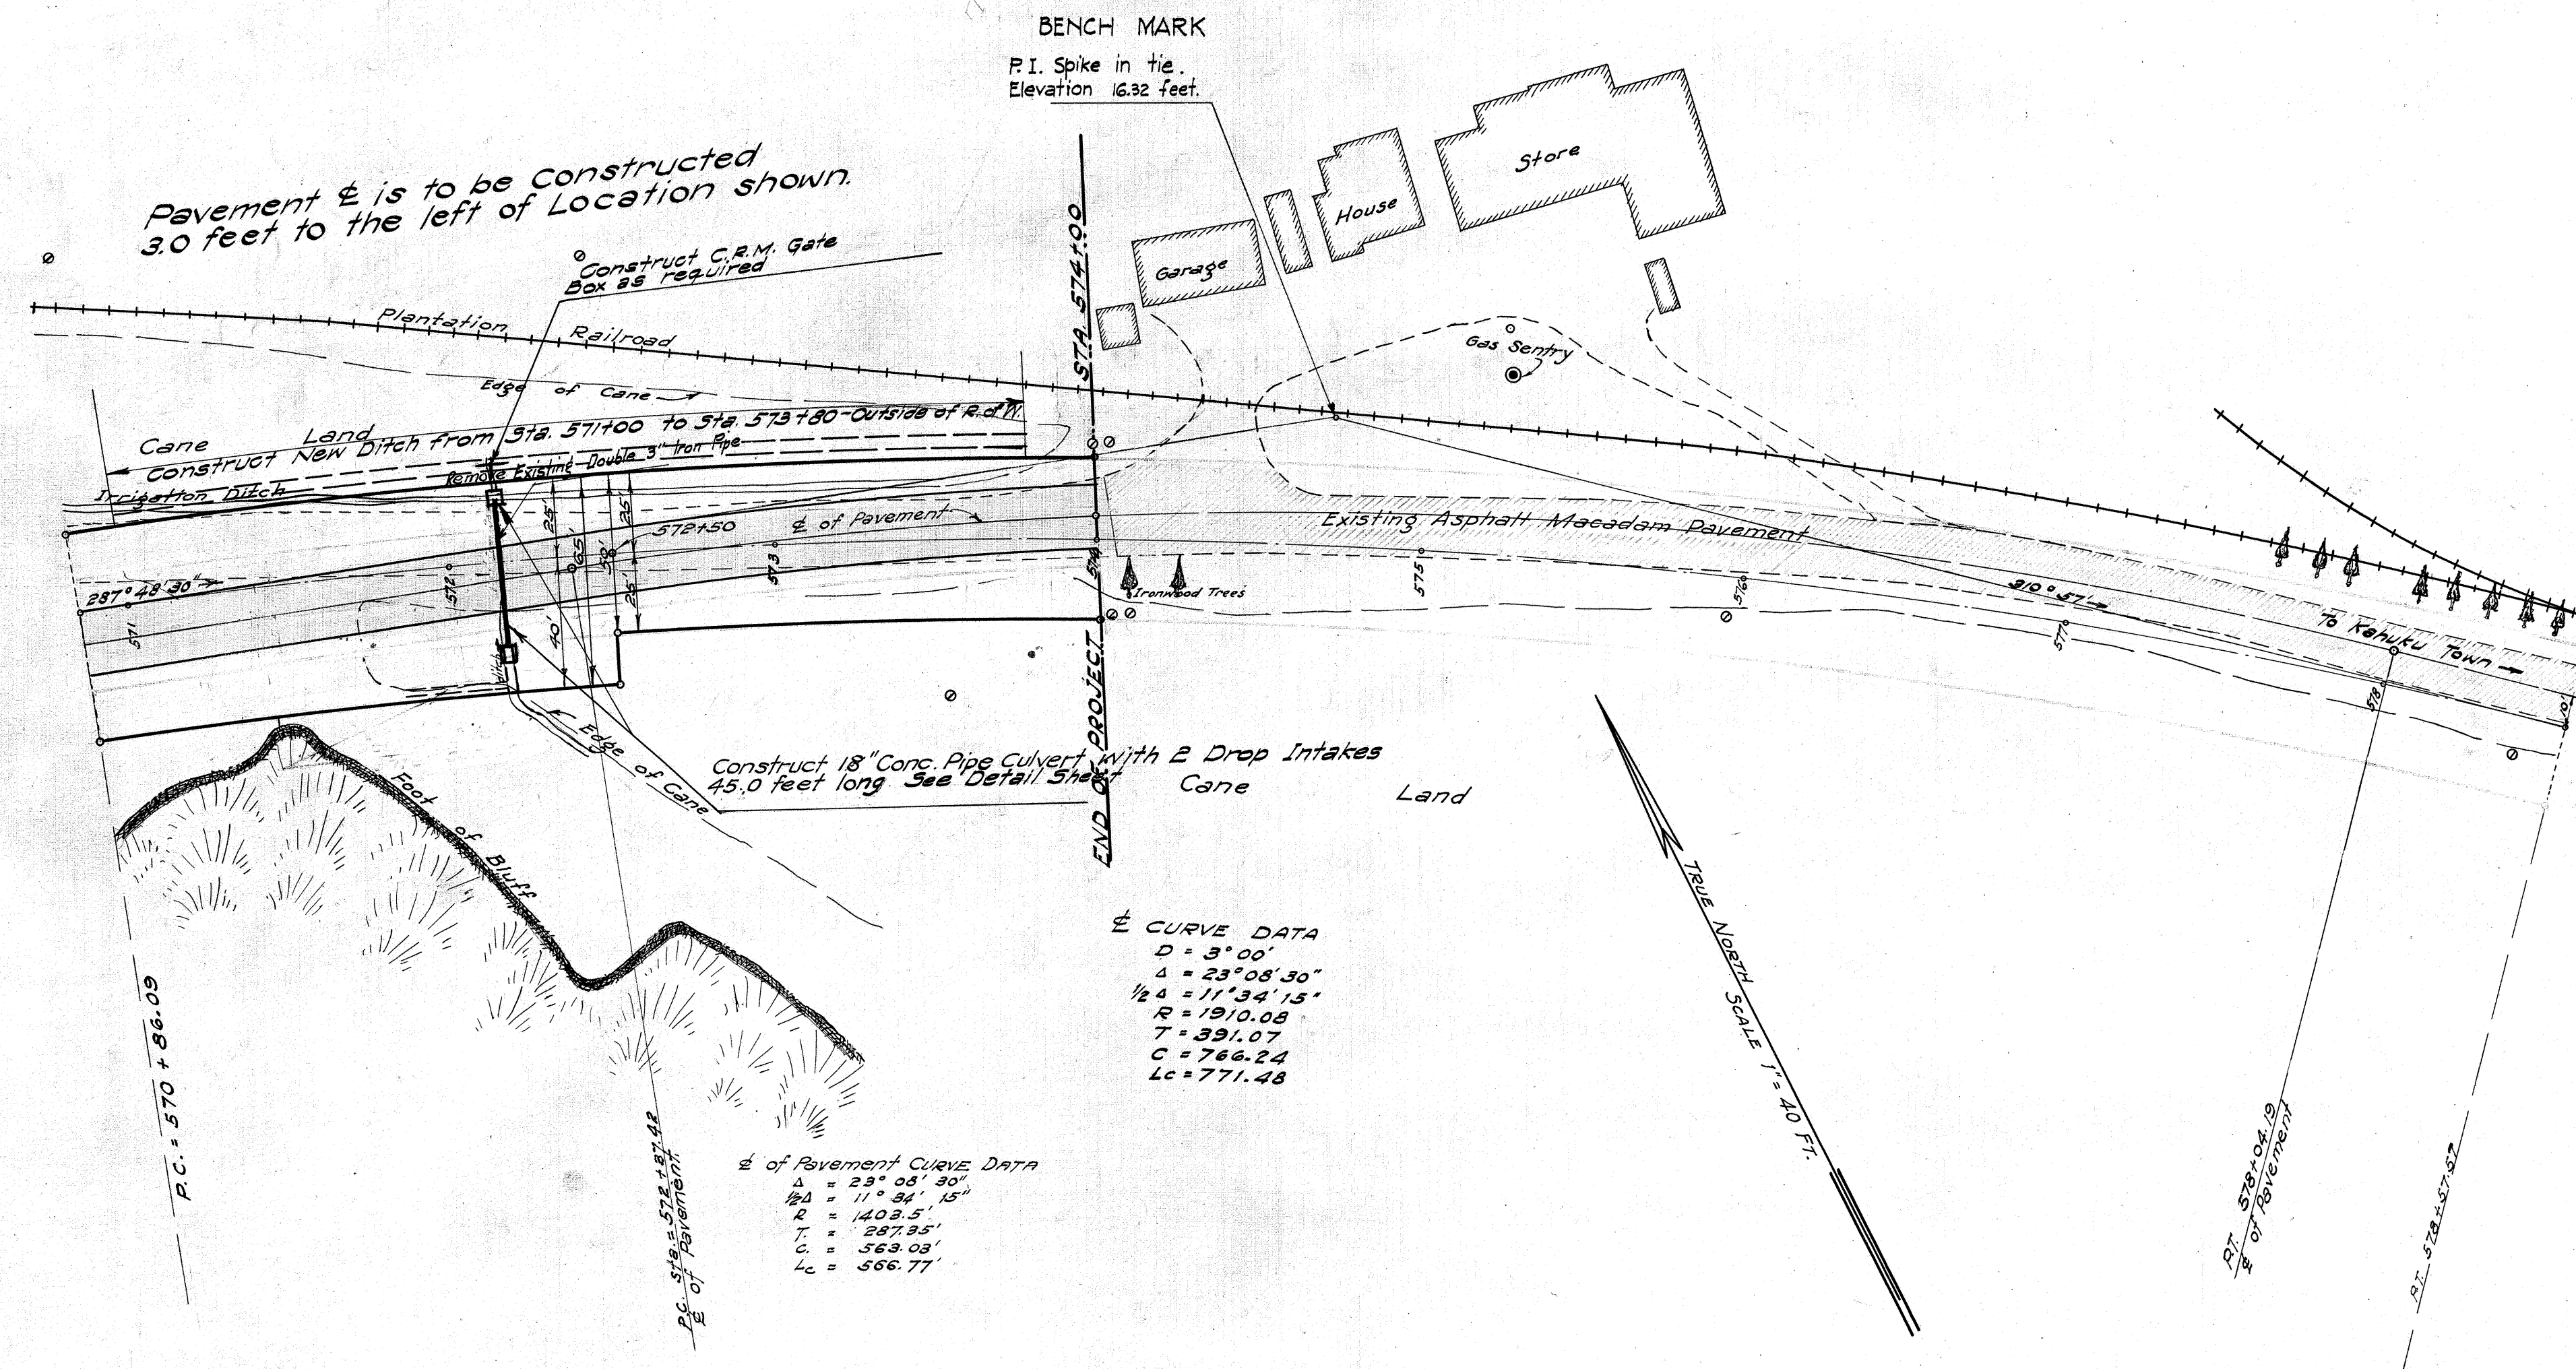

SCALES
HORIZONTAL 1" = 40'
VERTICAL 1" = 4'

4189.20